

ORDWAY CATTLE FEEDERS, LLC - PIPELINE


"AS-BUILT" DRAWINGS

19424 HWY 96
ORDWAY, COLORADO

CS
A1
C1
C2
BOOSTER
SHEET 1
SHEET 2
SHEET 3
SHEET 4
SHEET 5
SHEET 6
SHEET 7
SHEET 8
SHEET 9
SHEET 10
SHEET 11


COVER SHEET
BOOSTER & VALVE STATION
HIGHWAY BORINGS - AS BUILT
PIPELINE DETAILS
BOOSTER STATION P&P
STA: 10+00 - 36+00
STA: 36+00 - 62+00
STA: 62+00 - 88+00
STA: 88+00 - 114+00
STA: 114+00 - 140+00
STA: 140+00 - 166+00
STA: 166+00 - 192+00
STA: 192+00 - 218+00
STA: 218+00 - 244+00
STA: 244+00 - 270+00
STA: 270+00 - 296+00

SHEET 12 STA: 296+00 - 322+00
SHEET 13 STA: 322+00 - 348+00
SHEET 14 STA: 348+00 - 374+00
SHEET 15 STA: 374+00 - 400+00
SHEET 16 STA: 400+00 - 426+00
SHEET 17 STA: 426+00 - 450+00
SHEET 18 STA: 450+00 - 476+00
SHEET 19 STA: 476+00 - 502+00
SHEET 20 STA: 502+00 - 530+00
SHEET 21 STA: 530+00 - 554+00
SHEET 22 STA: 554+00 - 564+00

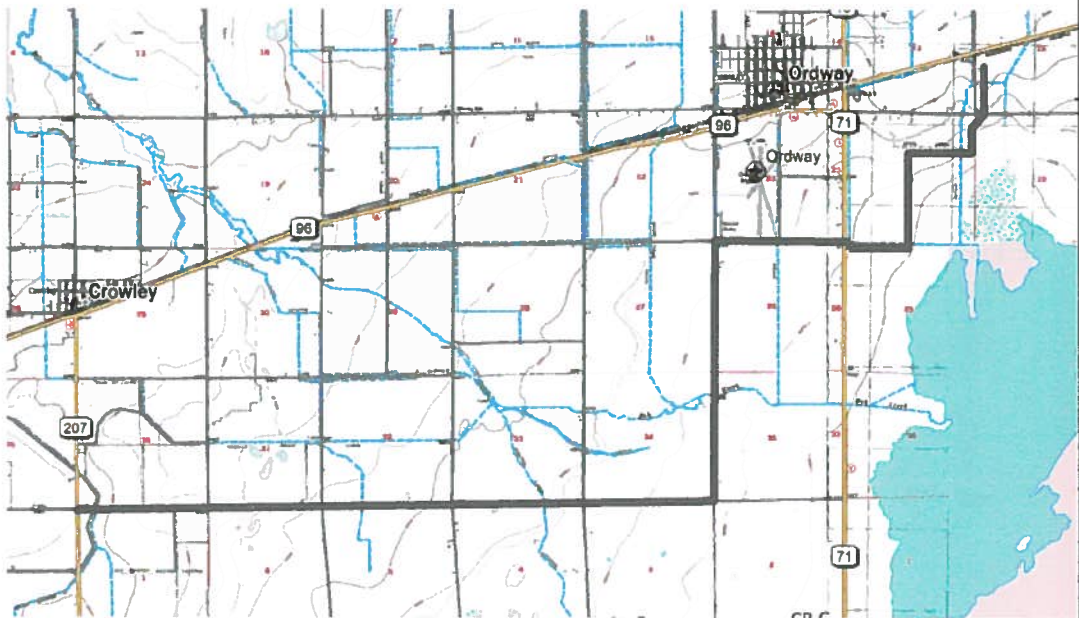

LOCATION MAP

SCALE: NTS

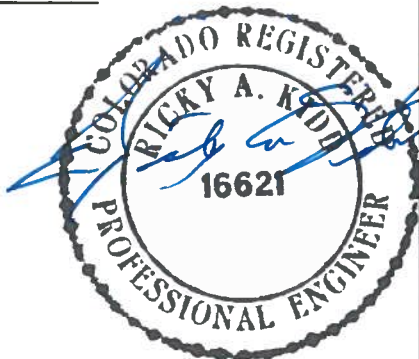

KIDD
ENGINEERING
AND
CONSTRUCTION
MANAGEMENT
SERVICES, INC

RICKY A. KIDD - PRESIDENT
44811 EAST HIGHWAY 96
AVONDALE, CO 81622
719-564-8329 (O) 719-565-1218 (F)
rickkidd@kiddengineering.com

REVISIONS:

1
2
3
4
5

COPYRIGHT 2013

ORDWAY CATTLE
FEEDERS, LLC - PIPELINE
19424 HWY 96
ORDWAY, COLORADO

DRAWN BY: JT, DJM, & RAK

CHECKED BY: RAK

SCALE: NTS

DATE: DECEMBER 28, 2013

KIDDCMS NO. 1234-2013




PROJECT NO. #####


SHEET TITLE:
Cover Sheet




ORDWAY FEEDYARD BOOSTER STATION C & VALVE STATION

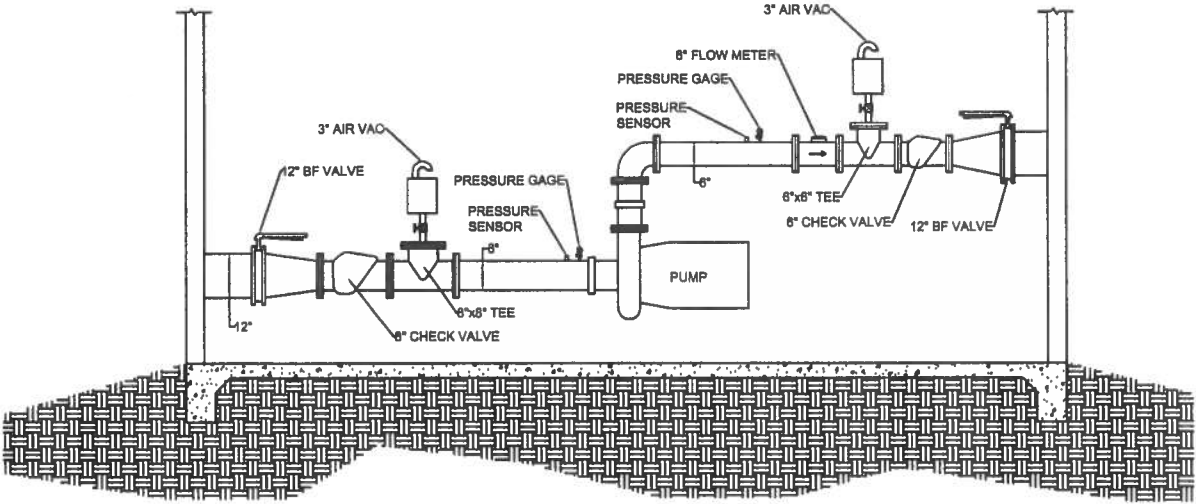


AS BUILT ELEVATION - BOOSTER STATION C
SCALE - 1/2" = 1'-0"

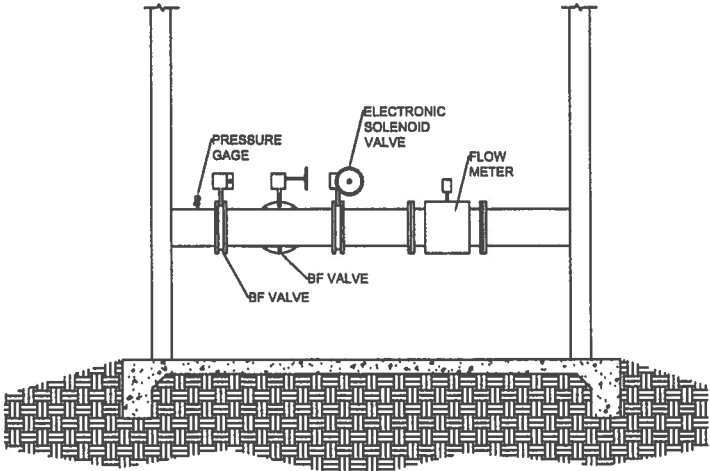

AS BUILT ELEVATION - VALVE STATION
SCALE - 1/2" = 1'-0"

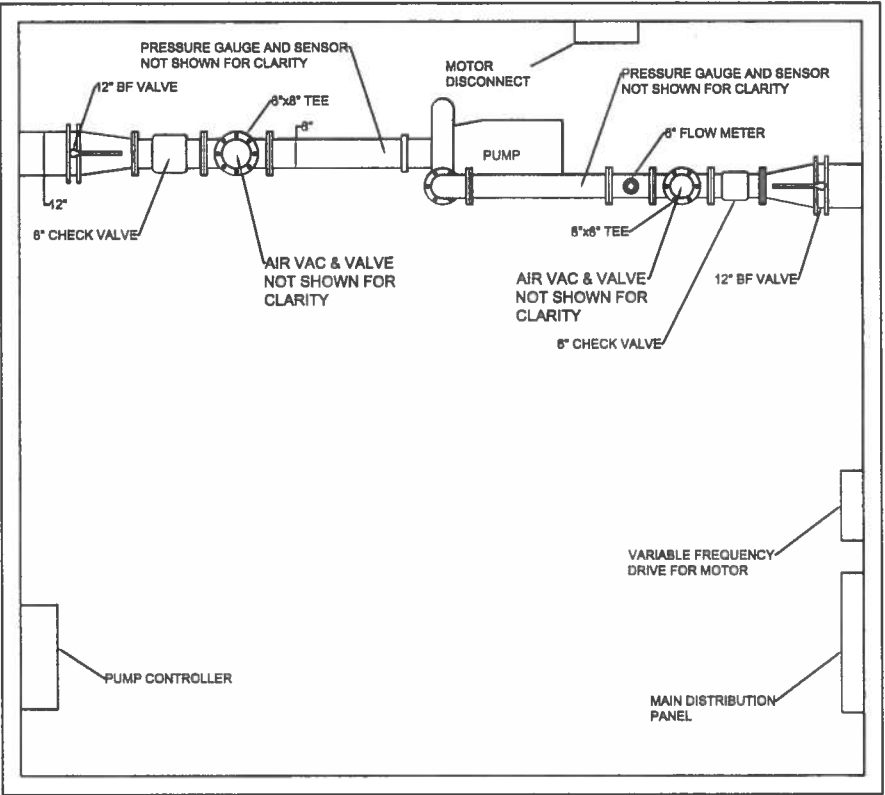

AS BUILT PLAN VIEW - BOOSTER STATION C
SCALE - 1/2" = 1'-0"

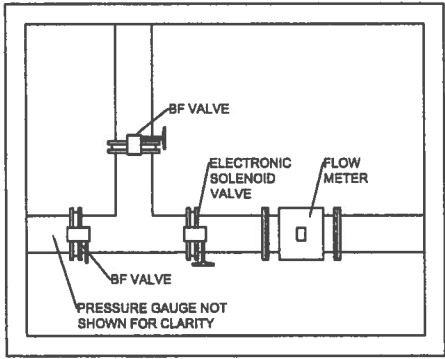

AS BUILT PLAN VIEW - VALVE STATION
SCALE - 1/2" = 1'-0"

KIDD
ENGINEERING
AND
CONSTRUCTION
MANAGEMENT
SERVICES, INC

RICKY A. KIDD - PRESIDENT
44811 EAST HIGHWAY 90
AVONDALE, CO 81022
719-844-8238 (O) 719-883-1218 (F)
rick.kidd@kiddengineering.com

REVISIONS:	
1	
2	
3	
4	
5	
COPYRIGHT 2013	

**ORDWAY FEEDYARD
WATER PIPELINE**
19424 HIGHWAY 96
ORDWAY, COLORADO 81063

DRAWN BY:	RAK
CHECKED BY:	RAK
SCALE:	NTB
DATE:	DEC 28, 2013
KIDDECMS NO.:	1234-2013




PROJECT NO
#####

SHEET TITLE
**BOOSTER STATION C
& VALVE STATION**




ORDWAY FEEDYARD

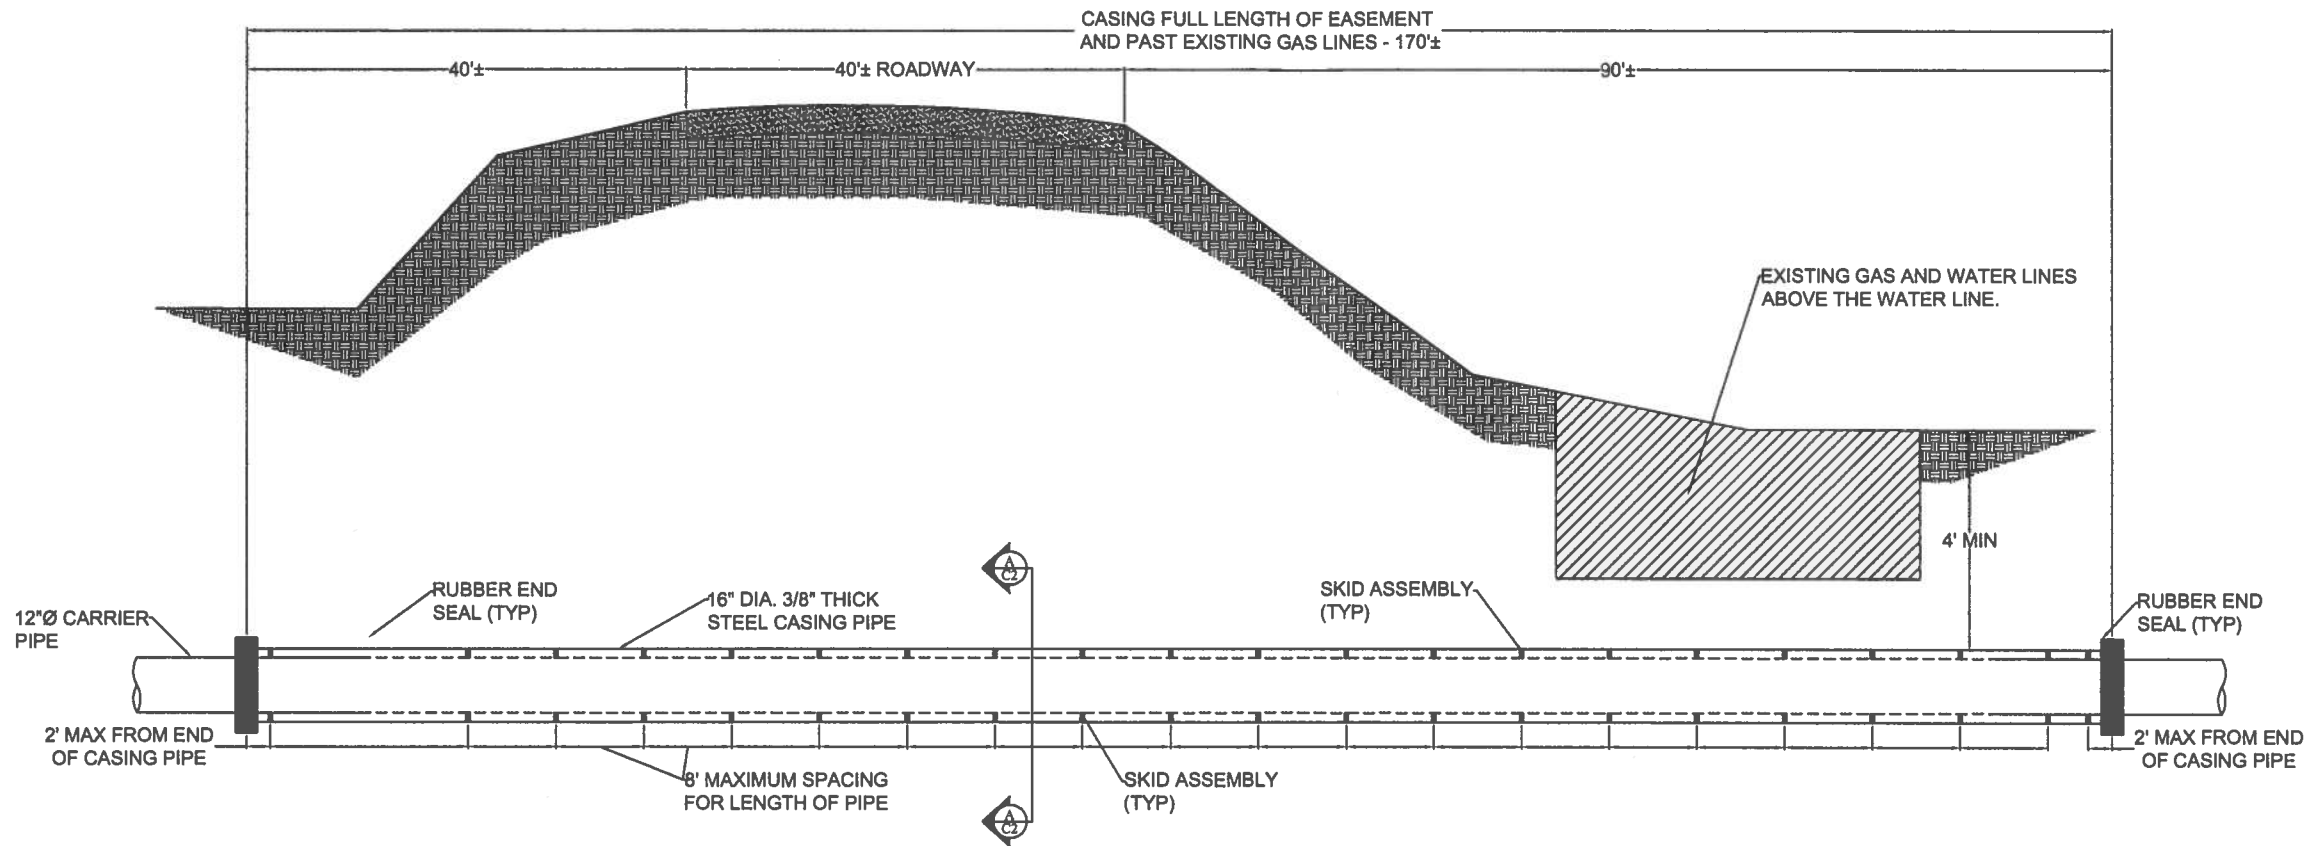

AS BUILT ROAD BORING SECTION - HWY 71

SCALE: HORZ - 1/8" = 1'-0" VERT - 5/8" = 1'-0"

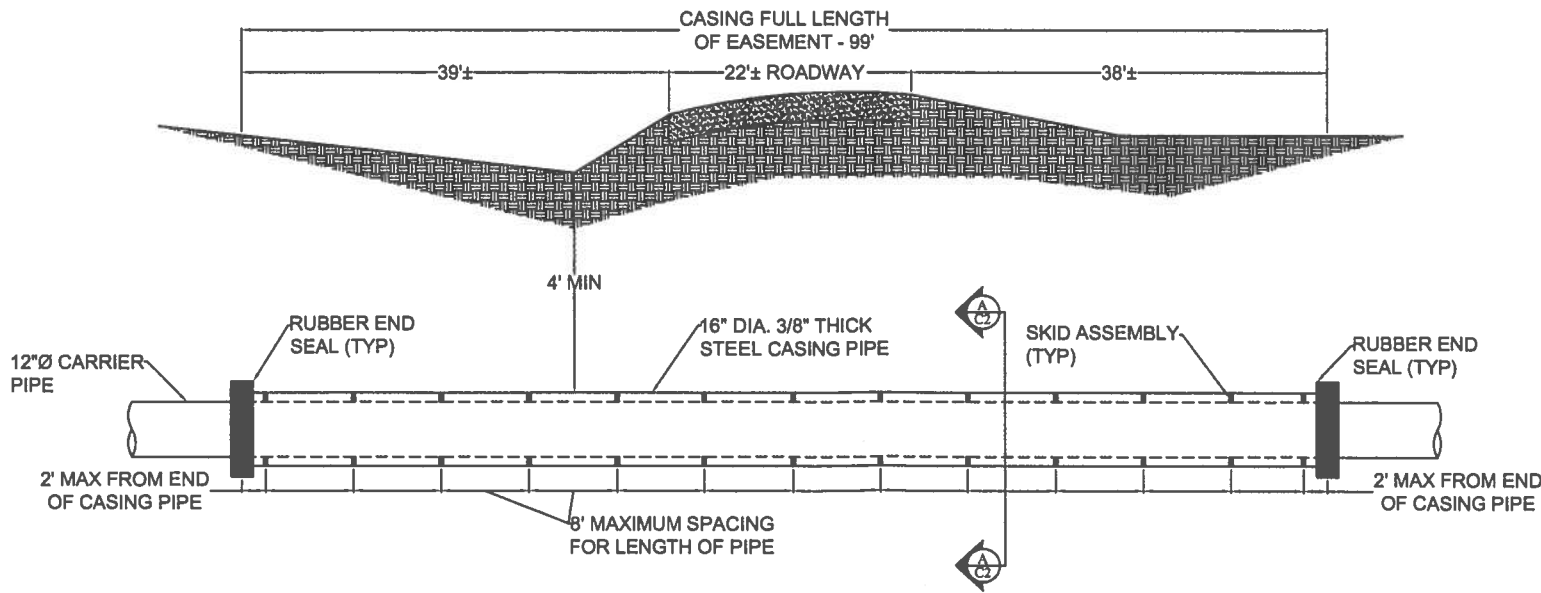

AS BUILT ROAD BORING SECTION - HWY 207

SCALE: HORZ - 1/8" = 1'-0" VERT - 5/8" = 1'-0"

KIDD
ENGINEERING
AND
CONSTRUCTION
MANAGEMENT
SERVICES, INC

RICKY A. KIDD - PRESIDENT
44811 EAST HIGHWAY 99
AVONDALE, CO 81623
719-844-8239 (C) 719-825-1216 (F)
rick.kidd@kiddengineering.com

REVISIONS:

1. _____
2. _____
3. _____
4. _____
5. _____

COPYRIGHT 2013

**ORDWAY FEEDYARD
WATER PIPELINE
19424 HIGHWAY 96
ORDWAY, COLORADO 81063**

DRAWN BY: DJM

CHECKED BY: RAK

SCALE: NTS

DATE: MAY 20, 2013

KIDDECMS NO.: 1234-2013




PROJECT NO:
####


SHEET TITLE:
**HIGHWAY BORINGS
AS BUILT**




ORDWAY FEEDYARD PIPELINE DETAIL DRAWINGS

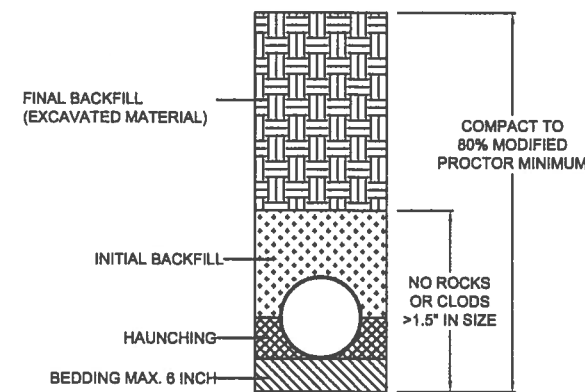


TYPICAL TRENCH
SCALE: 3/4" = 1'-0"

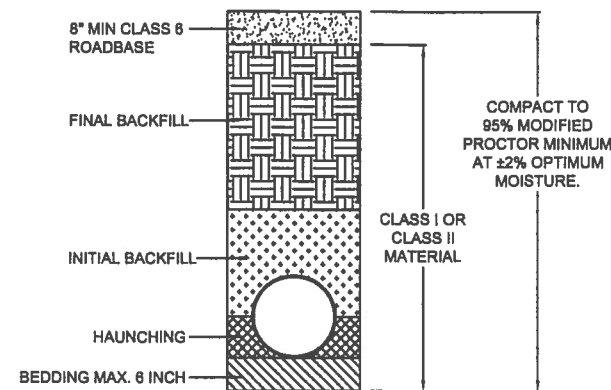


**TYPICAL AT GRAVEL
ROAD CROSSING**
SCALE 3/4" = 1'-0"

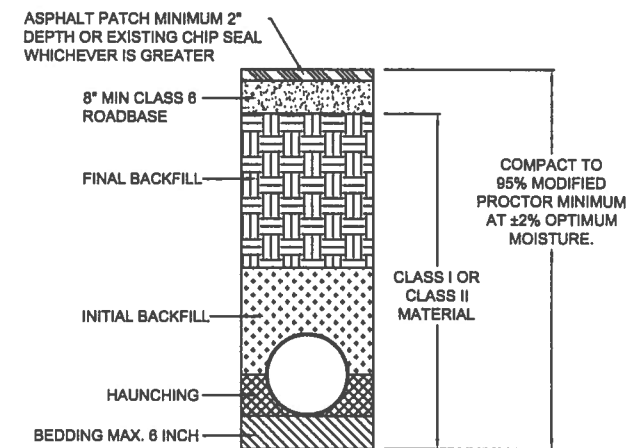

LN 16 & RD G ROAD CROSSING
SCALE 3/4" = 1'-0"

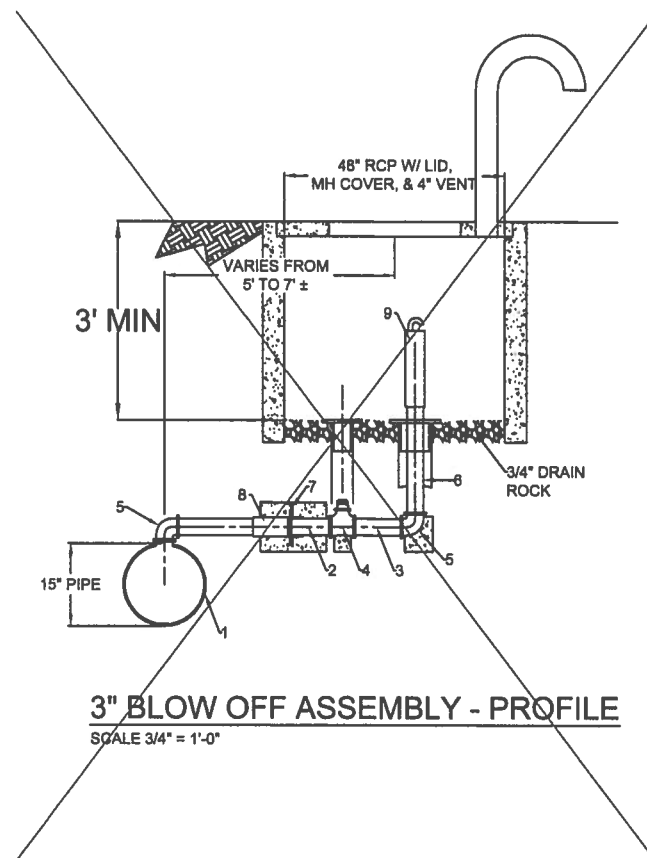


3" BLOW OFF ASSEMBLY - PROFILE
SCALE 3/4" = 1'-0"

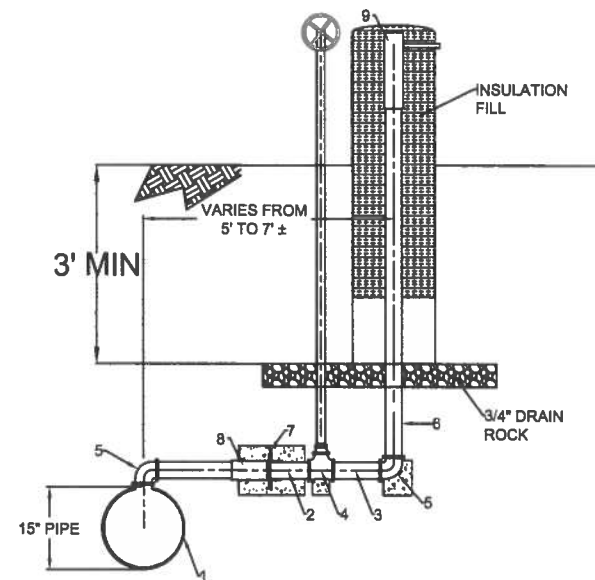


**3" AIR-VAC/BLOW OFF ASSEMBLY -
PROFILE**
SCALE 3/4" = 1'-0"

PARTS LIST	
1	15"x3" SADDLE TEE
2	3"x6" LONG NIPPLE
3	3"x12" LONG NIPPLE
4	3" GATE VALVE C.I.
5	3" 90° ELBOW
6	3" PIPE TO LENGTH
7	1/2"x2"x1/4" ANGLE IRON
8	COLLAR
9	3" AIR VAC VALVE

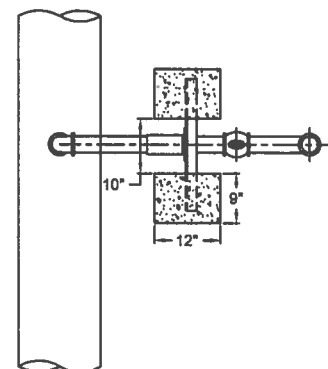

3" BLOW OFF ASSEMBLY - PLAN
SCALE 3/4" = 1'-0"

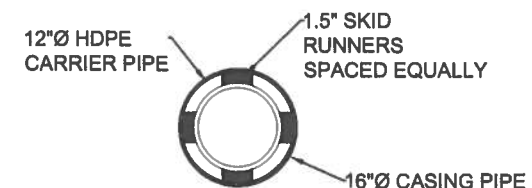

SECTION A - A
SCALE: 1" = 1'-0"

KIDD
ENGINEERING
AND
CONSTRUCTION
MANAGEMENT
SERVICES, INC

RICKY A. KIDD - PRESIDENT
44811 EAST HIGHWAY 80
AVONDALE, CO 81623
719-844-8288 (O) 719-885-1218 (F)
rick.kidd@kiddengineering.com

REVISIONS:



COPYRIGHT 2013

**ORDWAY FEEDYARD
WATER PIPELINE**
19424 HIGHWAY 96
ORDWAY, COLORADO 81063


DRAWN BY: DJM

CHECKED BY: RAK

SCALE: NTS

DATE: MAY 18, 2013

KIDDECMS NO.: 1234-2013



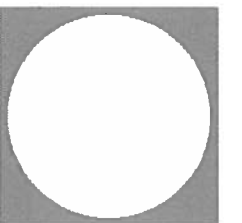


PROJECT NO: #####

SHEET TITLE: DETAILS



© 2013 KIDD ENGINEERING AND CONSTRUCTION MANAGEMENT SERVICES, INC. ALL RIGHTS RESERVED. THIS DRAWING IS THE PROPERTY OF KIDD ENGINEERING AND CONSTRUCTION MANAGEMENT SERVICES, INC. AND IS NOT TO BE REPRODUCED OR TRANSMITTED IN ANY FORM OR BY ANY MEANS, ELECTRONIC OR MECHANICAL, WITHOUT PERMISSION IN WRITING FROM KIDD ENGINEERING AND CONSTRUCTION MANAGEMENT SERVICES, INC.

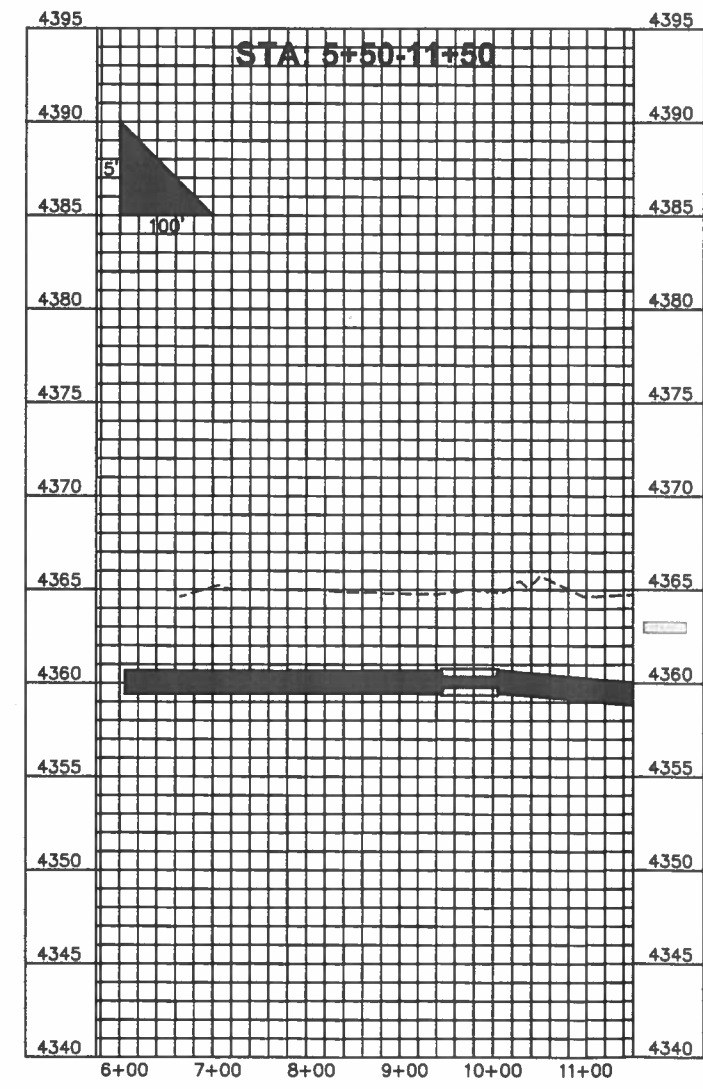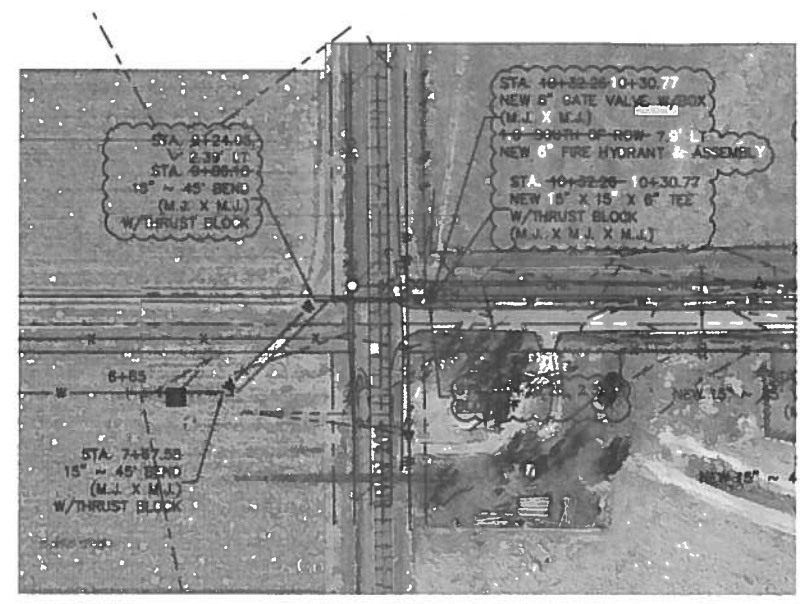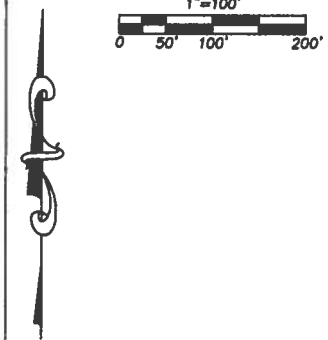

AS-BUILT
8-6-2013

KIDD
ENGINEERING
AND
CONSTRUCTION
MANAGEMENT
SERVICES, INC.



RICKY A. KIDD - PRESIDENT
44811 EAST HIGHWAY 60
AVONDALE, CO 81602
719-444-8238 (O) 719-555-1218 (F)
rickkidd@kiddengineering.com

BACKFILL IN ACCORDANCE WITH JM
EAGLE IRRIGATION IPS PRESSURE
IRRIGATION GUIDE. PAYING PARTICULAR
ATTENTION TO BEDDING, HAUNCHING,
AND INITIAL BACKFILL REQUIREMENTS

PROJECT TITLE
**ORDWAY FEEDLOT
WATERLINE**

SHEET TITLE
**ORDWAY FEEDLOT
WATERLINE
BOOSTER STATION**

Job Number: 2798	
Drawn By: JRT	Checked By: JRT
Plot Scale: AS SHOWN	Date: 4/18/13
Sheet Number: BOOSTER	

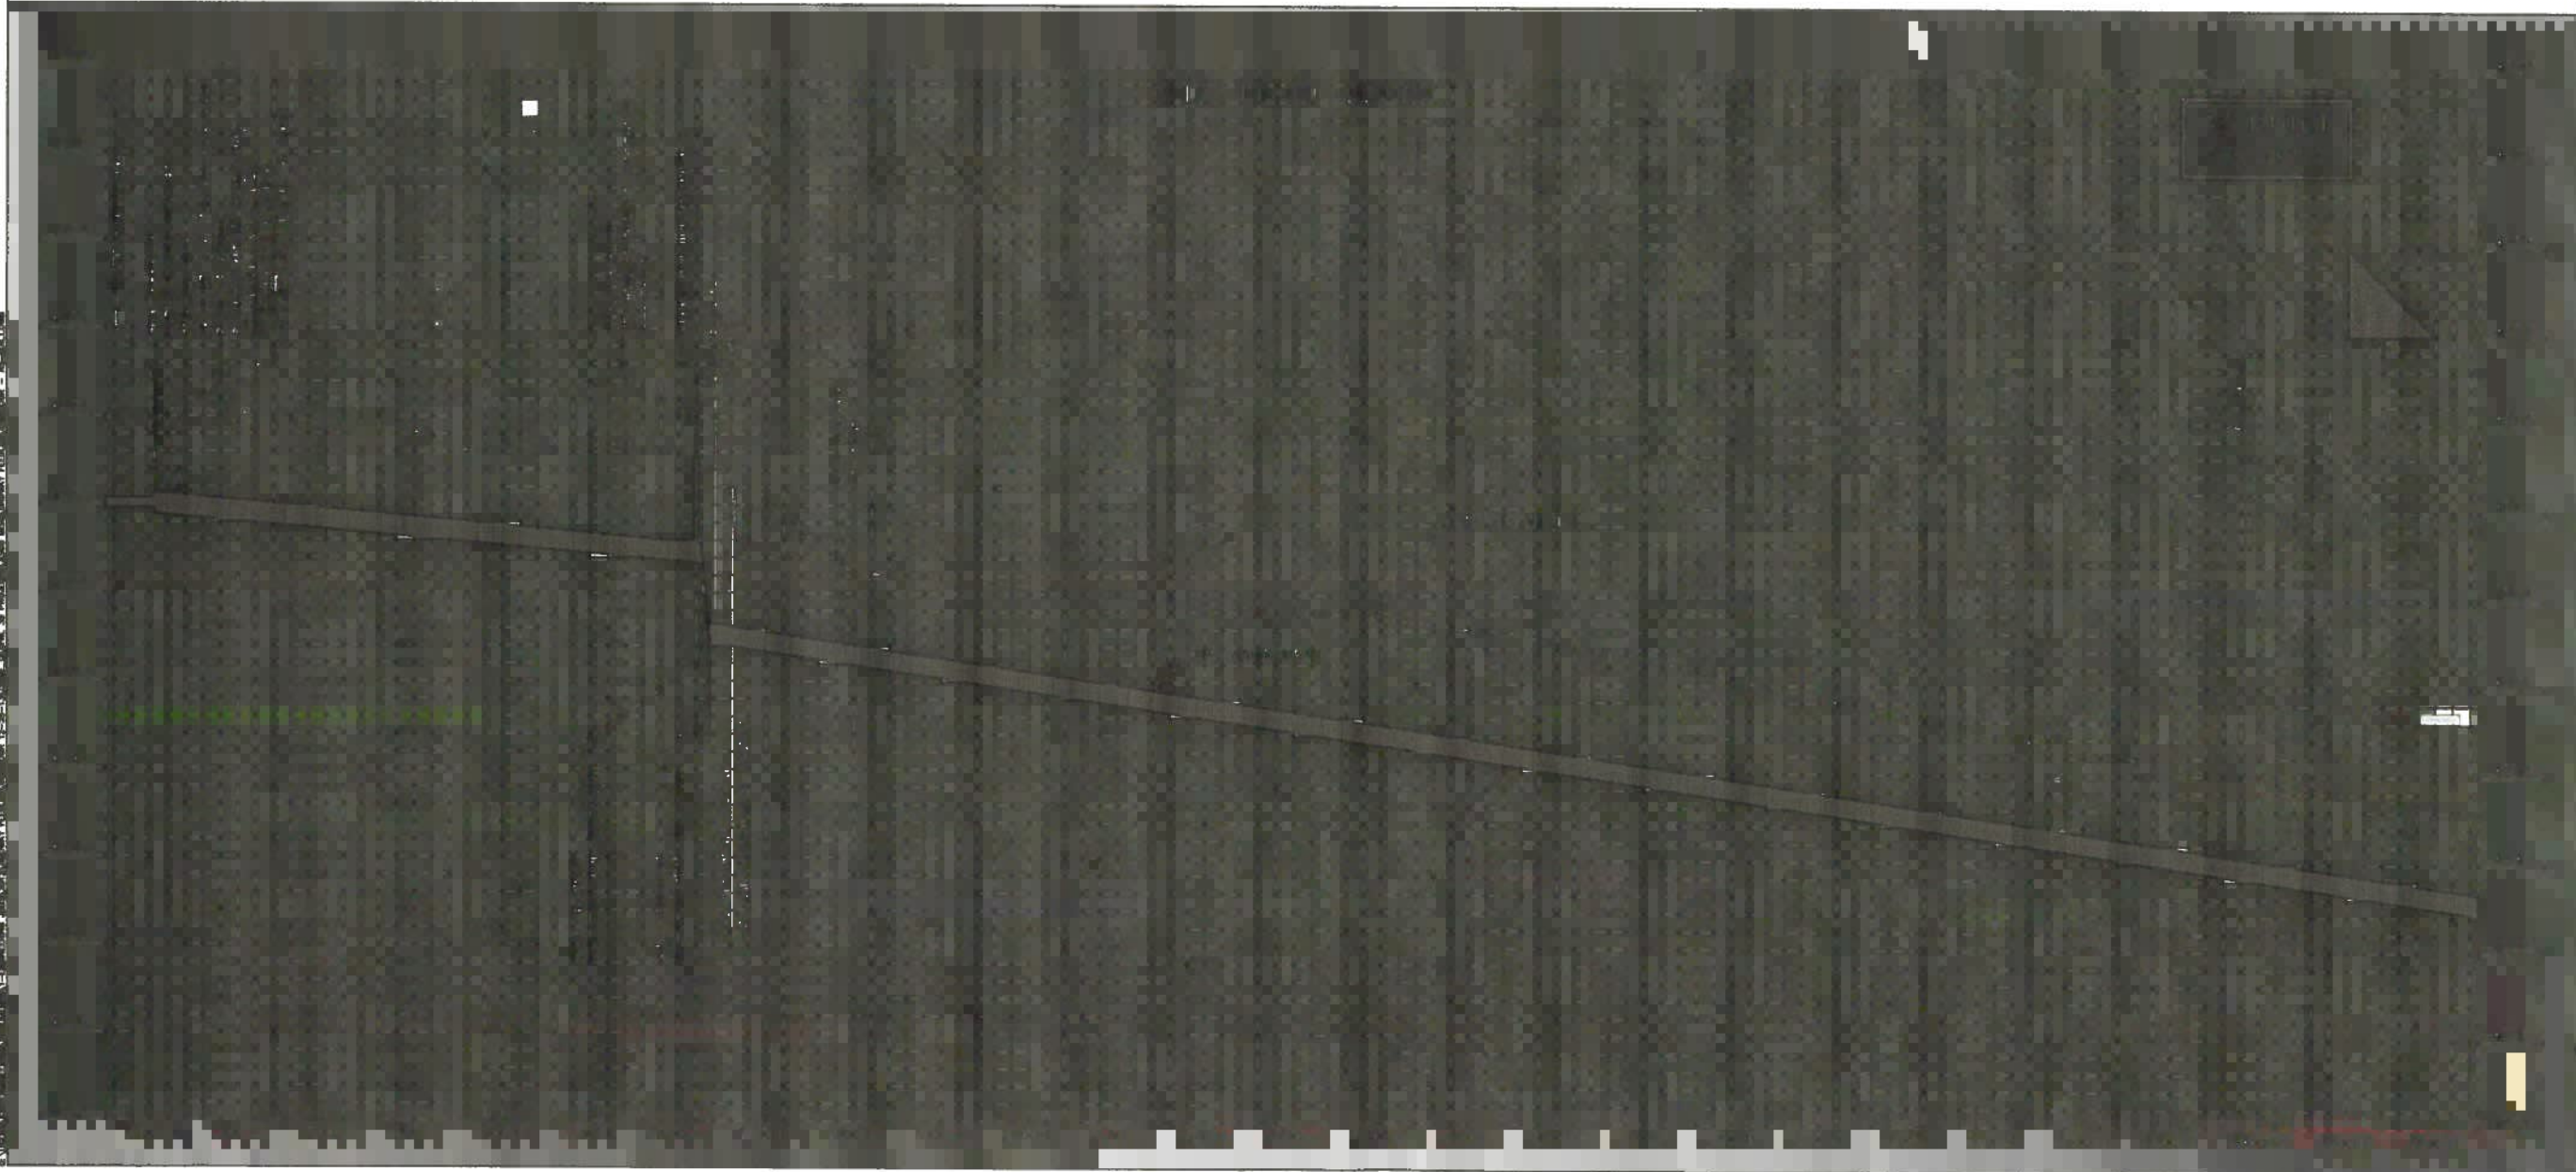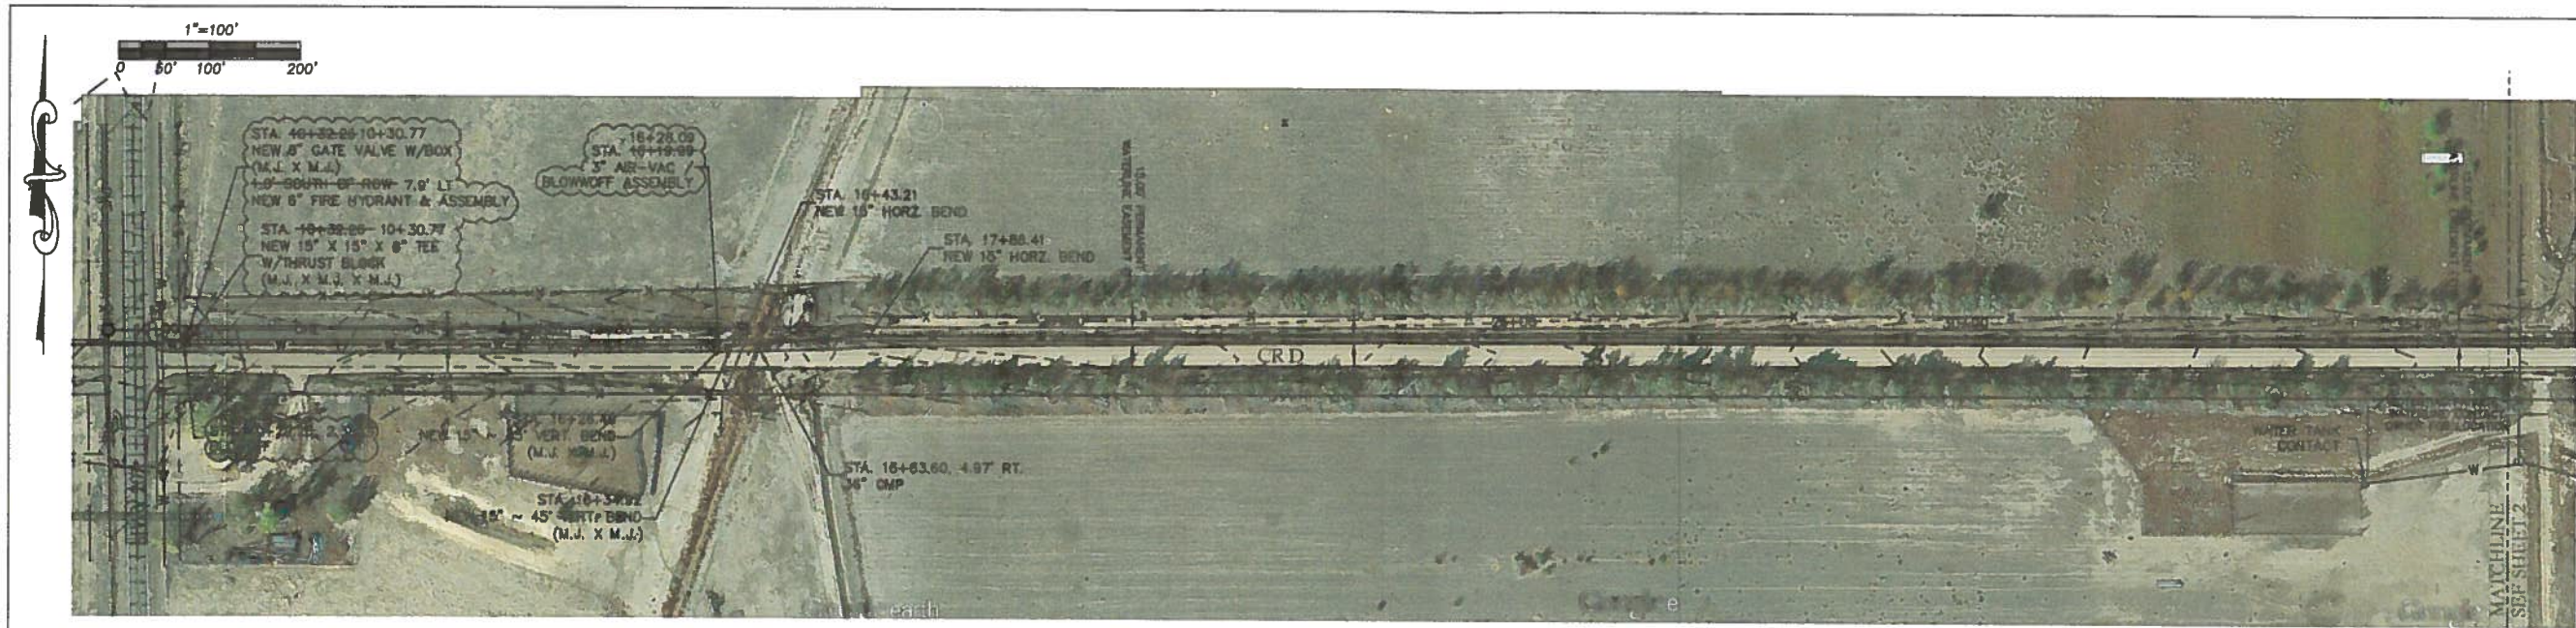

KIDD
ENGINEERING
AND
CONSTRUCTION
MANAGEMENT
SERVICES, INC




RICHY A KIDD - PRESIDENT
44811 EAST HIGHWAY 80
AVONDALE CO 81022
719-844-8238 (O) 719-885-1218 (F)
rickkidd@kiddengineering.com

BACKFILL IN ACCORDANCE WITH JM
EAGLE IRRIGATION IPS PRESSURE
IRRIGATION GUIDE. PAYING PARTICULAR
ATTENTION TO BEDDING, HAUNCHING,
AND INITIAL BACKFILL REQUIREMENTS

PROJECT TITLE
**ORDWAY FEEDLOT
WATERLINE**

SHEET TITLE
**ORDWAY FEEDLOT
WATERLINE
STA 36+00 THRU 62+00**

Job Number: W013-04	
Client: Dwyer & Dwyer	Drawn By: JHT
Design: JHT	Checked By: JHT
Plot: AS BUILT	Date: 4/18/13
Sheet Number 2	

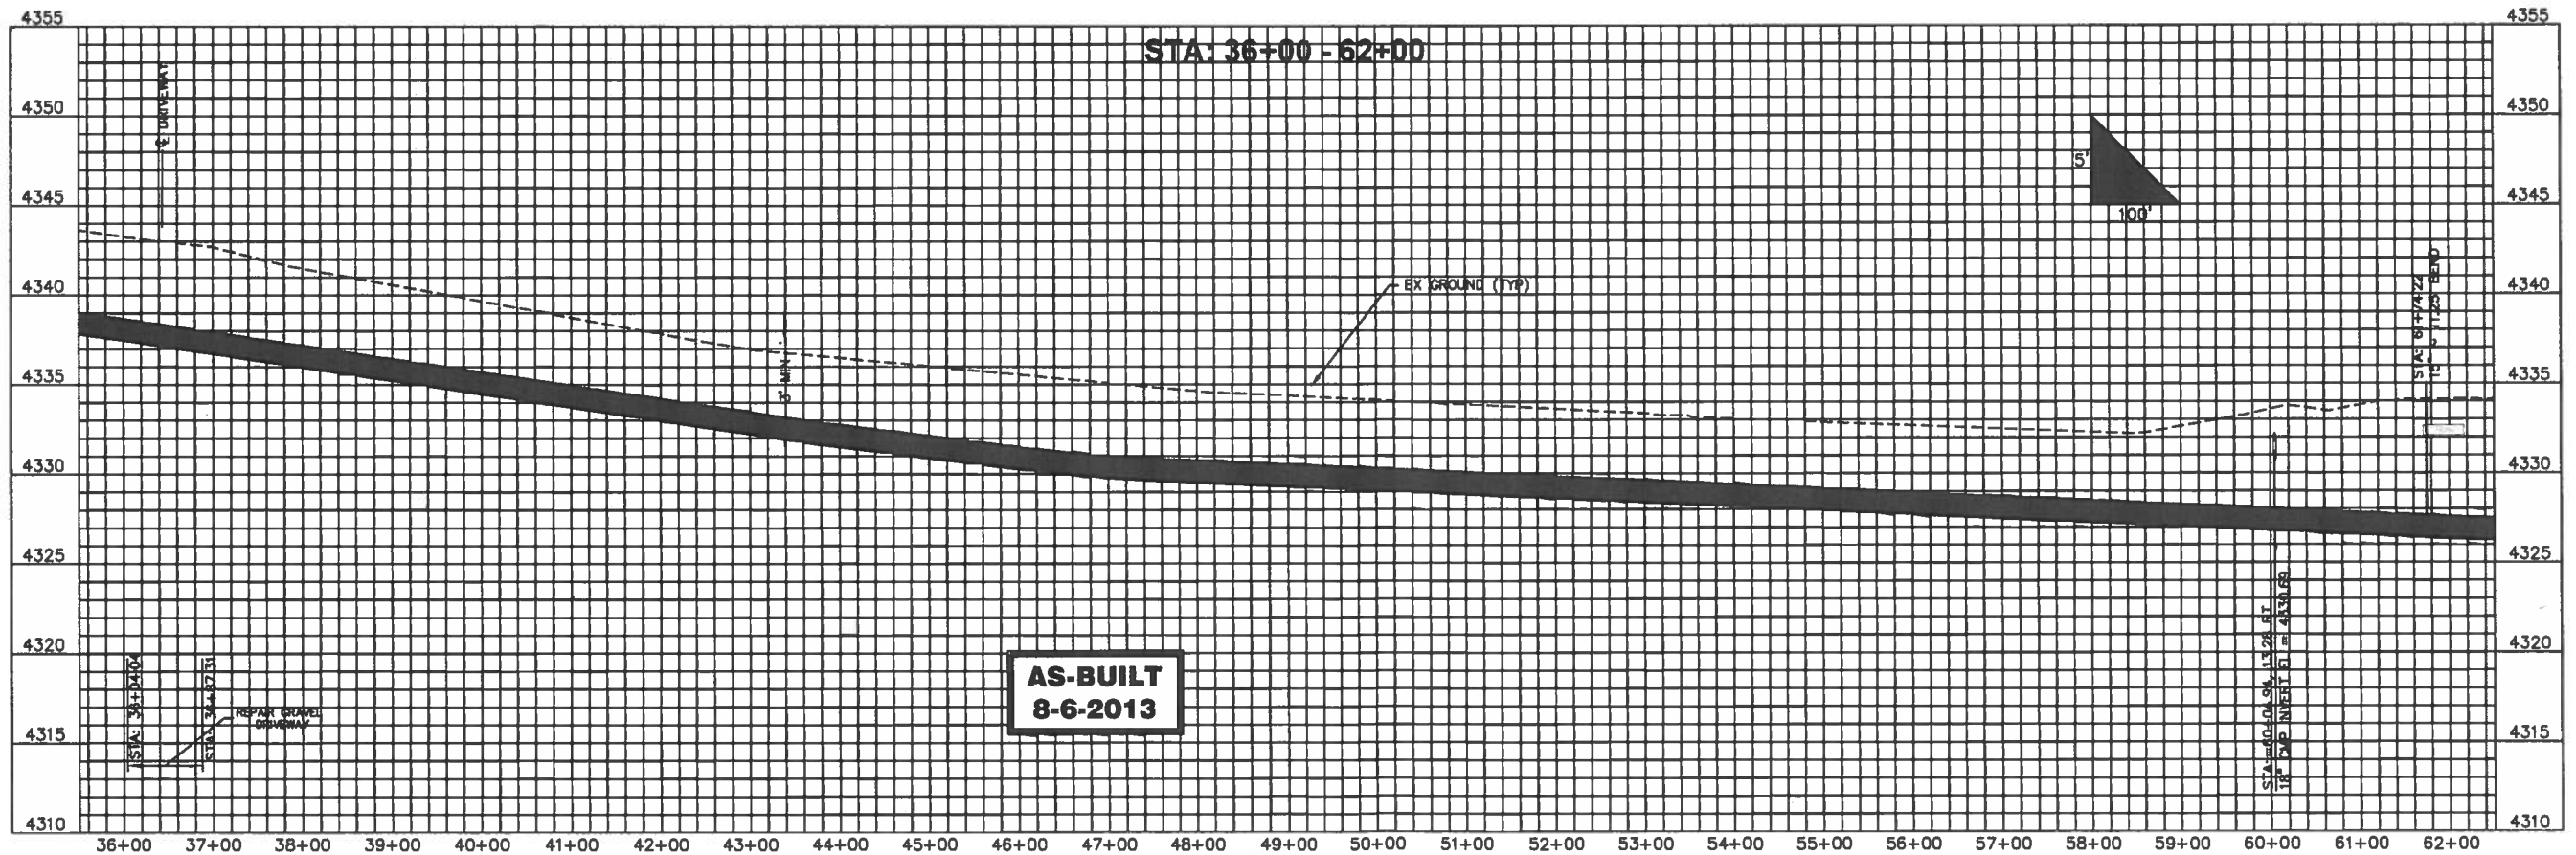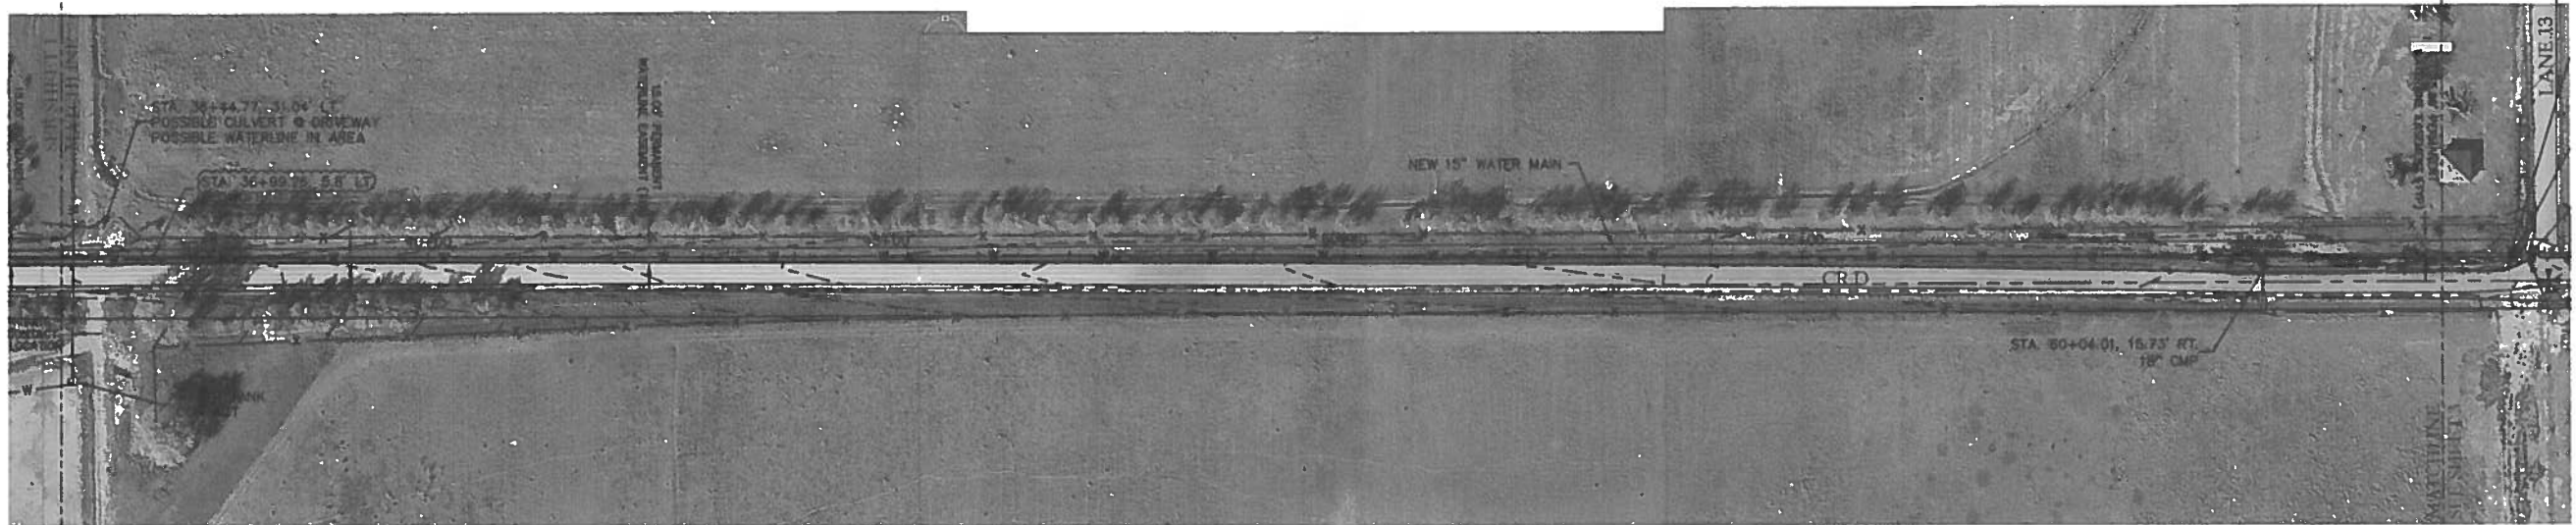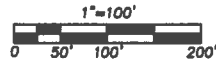

BACKFILL IN ACCORDANCE WITH JM
EAGLE IRRIGATION IPS PRESSURE
IRRIGATION GUIDE. PAYING PARTICULAR
ATTENTION TO BEDDING, HAUNCHING,
AND INITIAL BACKFILL REQUIREMENTS


ORDWAY FEEDLOT
WATERLINE

PROJECT TITLE

ORDWAY FEEDLOT
WATERLINE
STA 62+00 THRU 88+00

SHEET TITLE


Job Number: R0313-04
Created By: J. Smith
Drawn By: J. Smith
Designed By: J. Smith
Checked By: J. Smith
Plot Scale: AS SHOWN
Date: 4/18/13
Sheet Number: 3

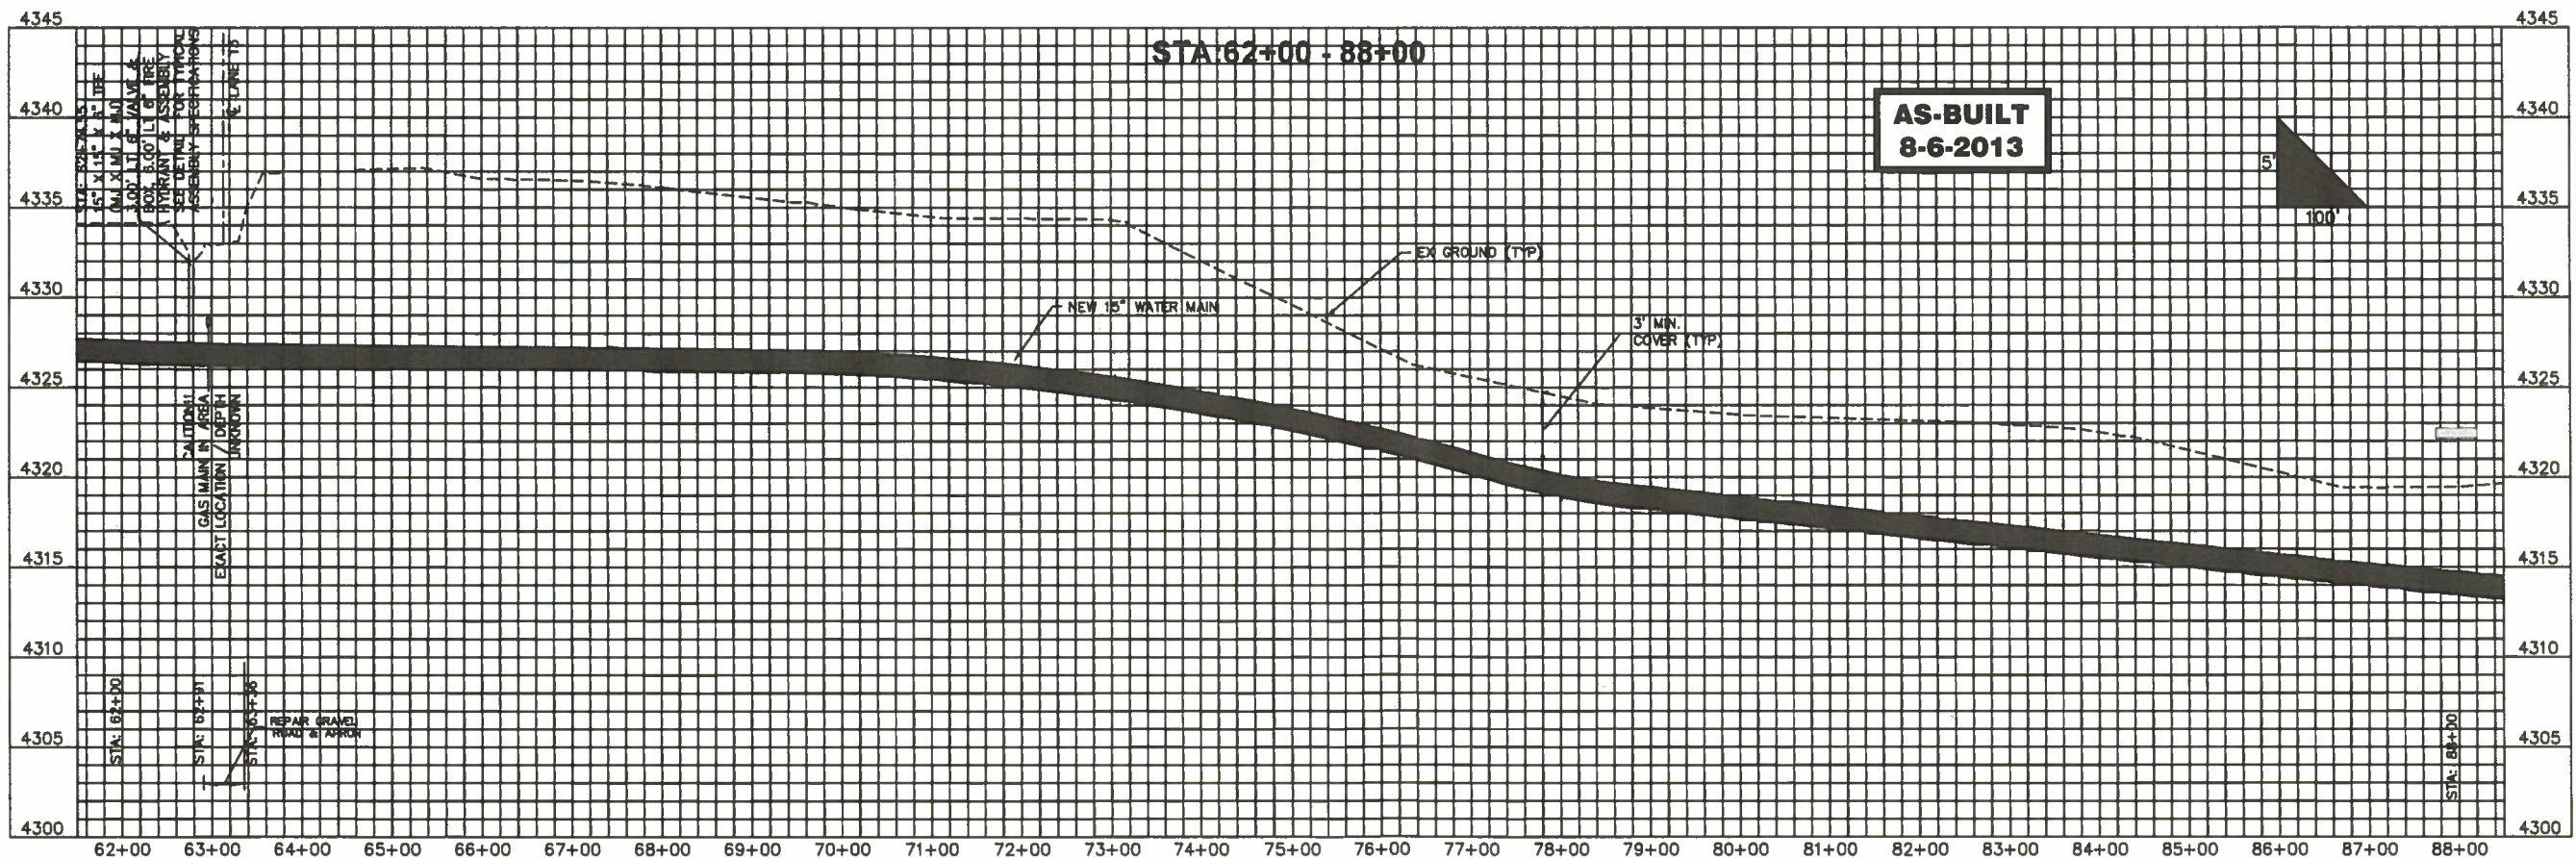

Q:\Users\jason\Documents\Projects\ORDWAY FEEDLOT WATERLINE\ORDWAY FEEDLOT WATERLINE.dwg, 3D PROJECTS\ORDWAY FEEDLOT WATERLINE - AS-BUILT.dwg



1"=100'
0 50' 100' 200'

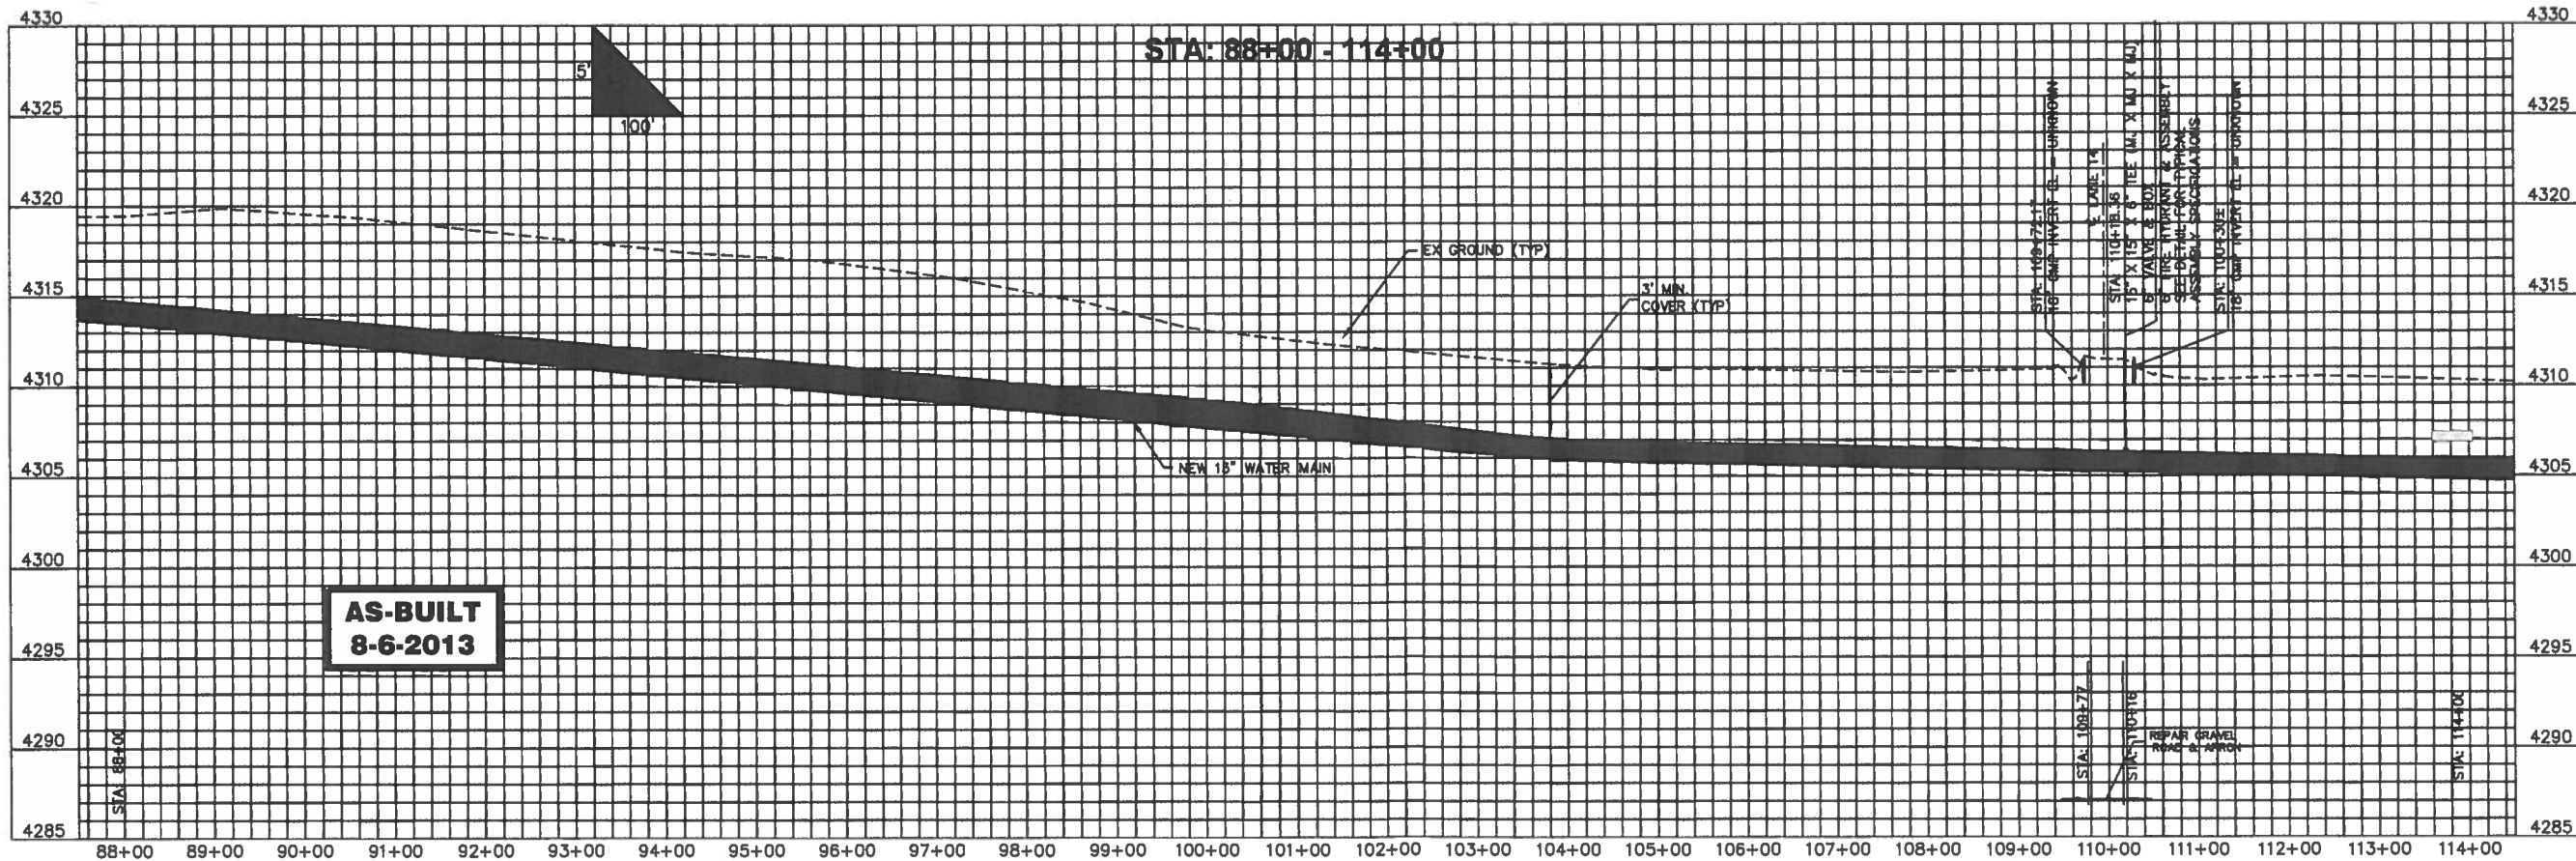

KIDD
ENGINEERING
AND
CONSTRUCTION
MANAGEMENT
SERVICES, INC.




RICKY A. KIDD - PRESIDENT
44811 EAST HIGHWAY 50
AVONDALE CO 81022
719-444-6239 (O) 719-463-1216 (F)
rickkidd@kiddengineering.com

BACKFILL IN ACCORDANCE WITH JM
EAGLE IRRIGATION IPS PRESSURE
IRRIGATION GUIDE, PAYING PARTICULAR
ATTENTION TO BEDDING, HAUNCHING,
AND INITIAL BACKFILL REQUIREMENTS

PROJECT TITLE
**ORDWAY FEEDLOT
WATERLINE**

SHEET TITLE
**ORDWAY FEEDLOT
WATERLINE
STA 88+00 THRU 114+00**

Job Number: R0313-04	
Client: Ordway	Drawn By: JAT
Designed By: RJK	Checked By: RJK
Plot Scale: AS SHOWN	Date: 4/18/13
Sheet Number 4	

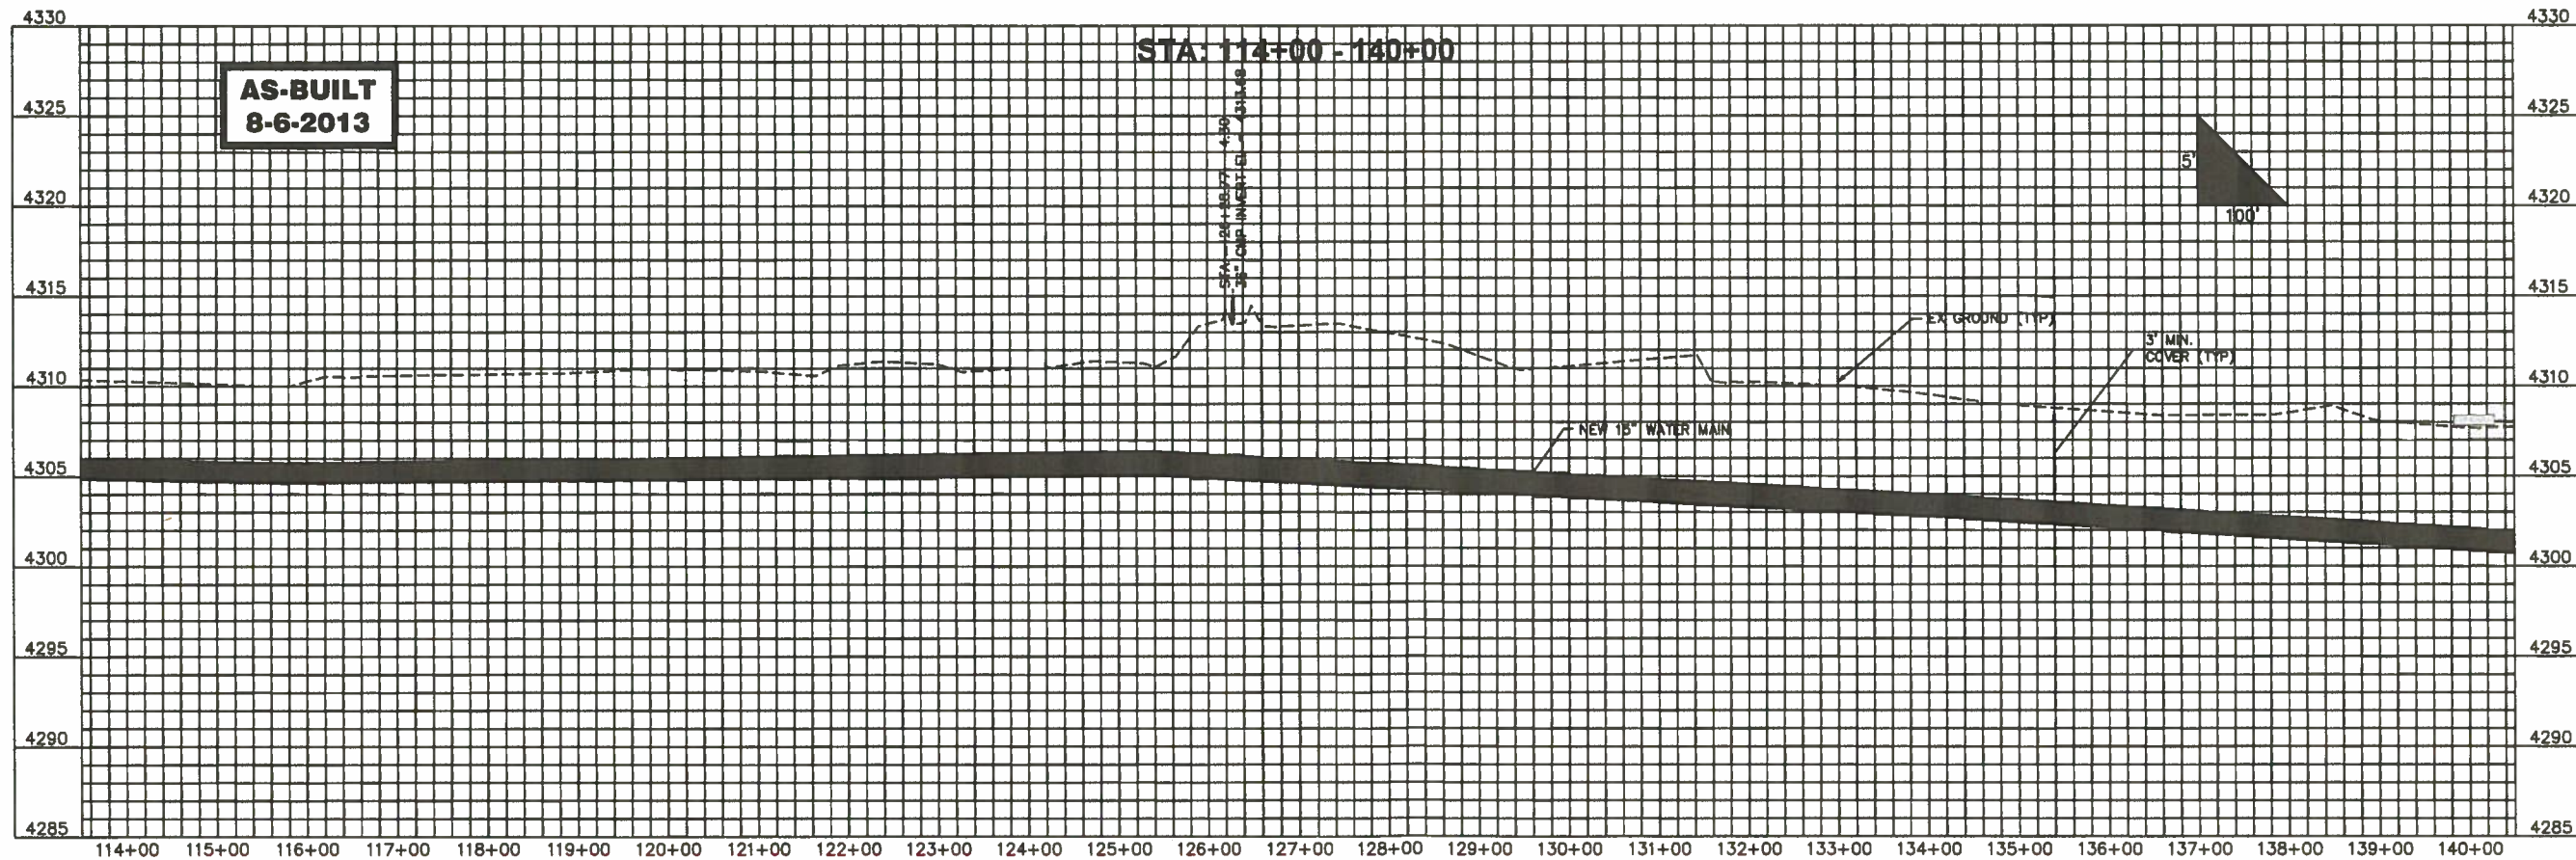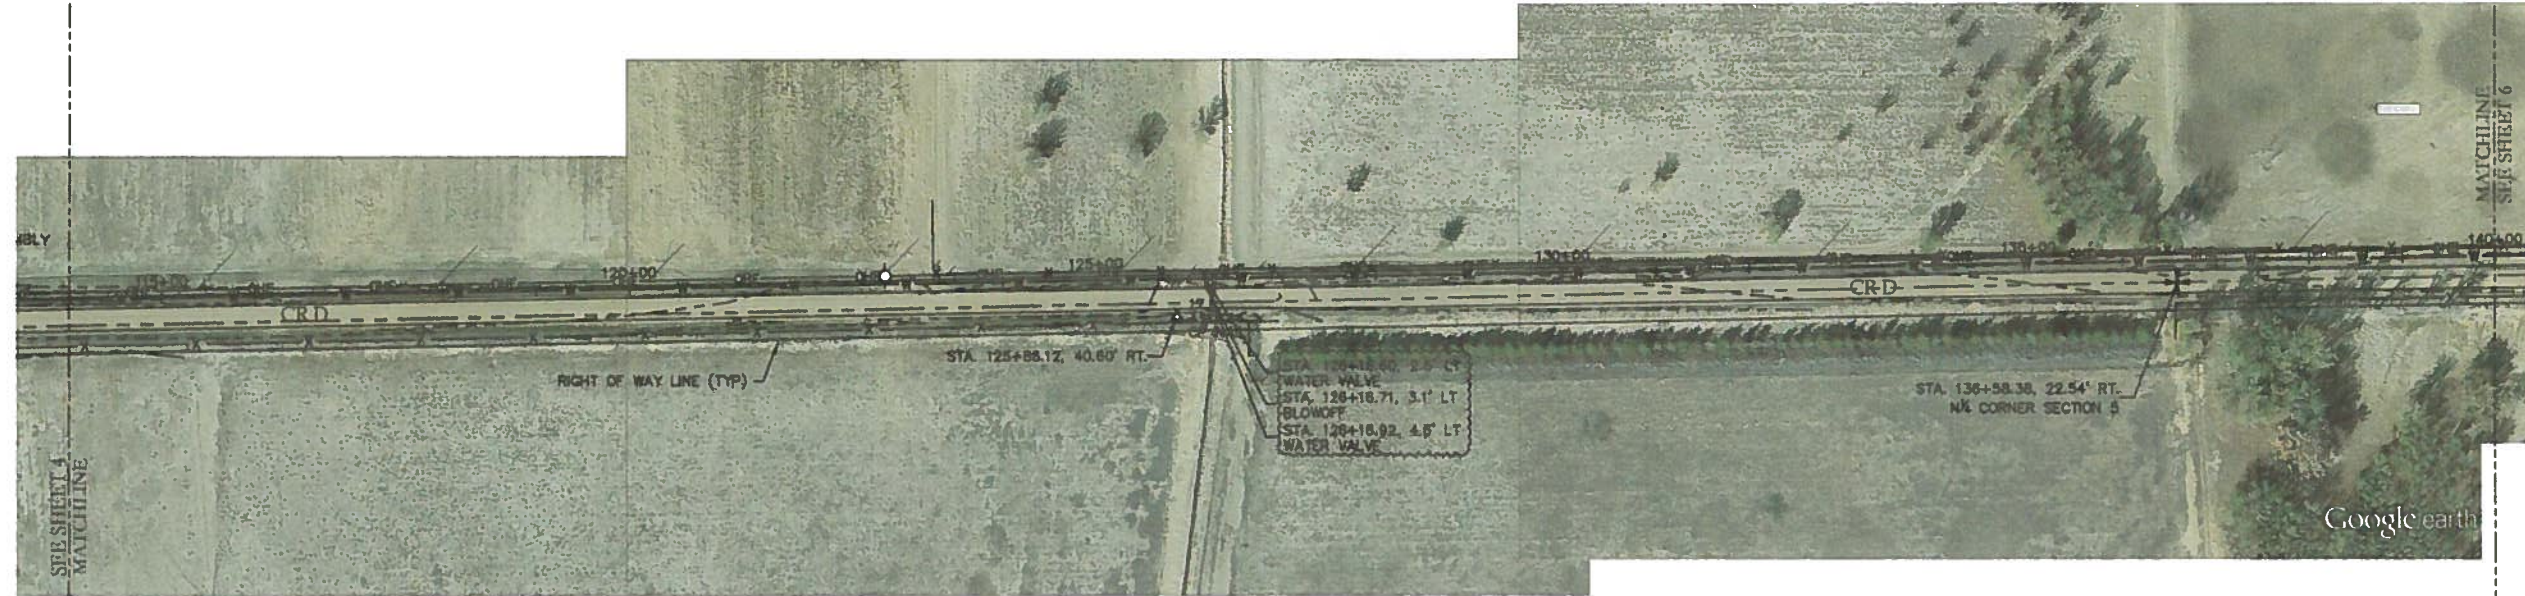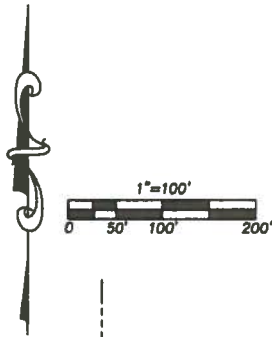

KIDD
ENGINEERING
AND
CONSTRUCTION
MANAGEMENT
SERVICES, INC.

RICKY A. KIDD - PRESIDENT
44811 EAST HIGHWAY 60
AVONDALE, CO 81622
719-844-6238 (D) 719-883-1218 (F)
rickkidd@kiddengineering.com

BACKFILL IN ACCORDANCE WITH JM
EAGLE IRRIGATION IPS PRESSURE
IRRIGATION GUIDE. PAYING PARTICULAR
ATTENTION TO BEDDING, HAUNCHING,
AND INITIAL BACKFILL REQUIREMENTS

PROJECT TITLE
**ORDWAY FEEDLOT
WATERLINE**

SHEET TITLE
**ORDWAY FEEDLOT
WATERLINE
STA 114+00 THRU 140+00**

Job Number: R0313-04	
Created By: J	Drawn By: J
Designed By: J	Checked By: J
Plot Scale: AS SHOWN	Date: 4/18/13
Sheet Number 5	



BACKFILL IN ACCORDANCE WITH JM
EAGLE IRRIGATION IPS PRESSURE
IRRIGATION GUIDE, PAYING PARTICULAR
ATTENTION TO BEDDING, HAUNCHING
AND INITIAL BACKFILL REQUIREMENTS

ORDWAY FEEDLOT
WATERLINE

ORDWAY FEEDLOT
WATERLINE
STA 140+00 THRU 166+00

Job Number: R0313-04	
Client: Ordway - AS-BUILT	Drawn By: JET
Designed By: RIK	Checked By: RIK
Plot Scale: AS SHOWN	Date: 4/18/13
Sheet Number	

6

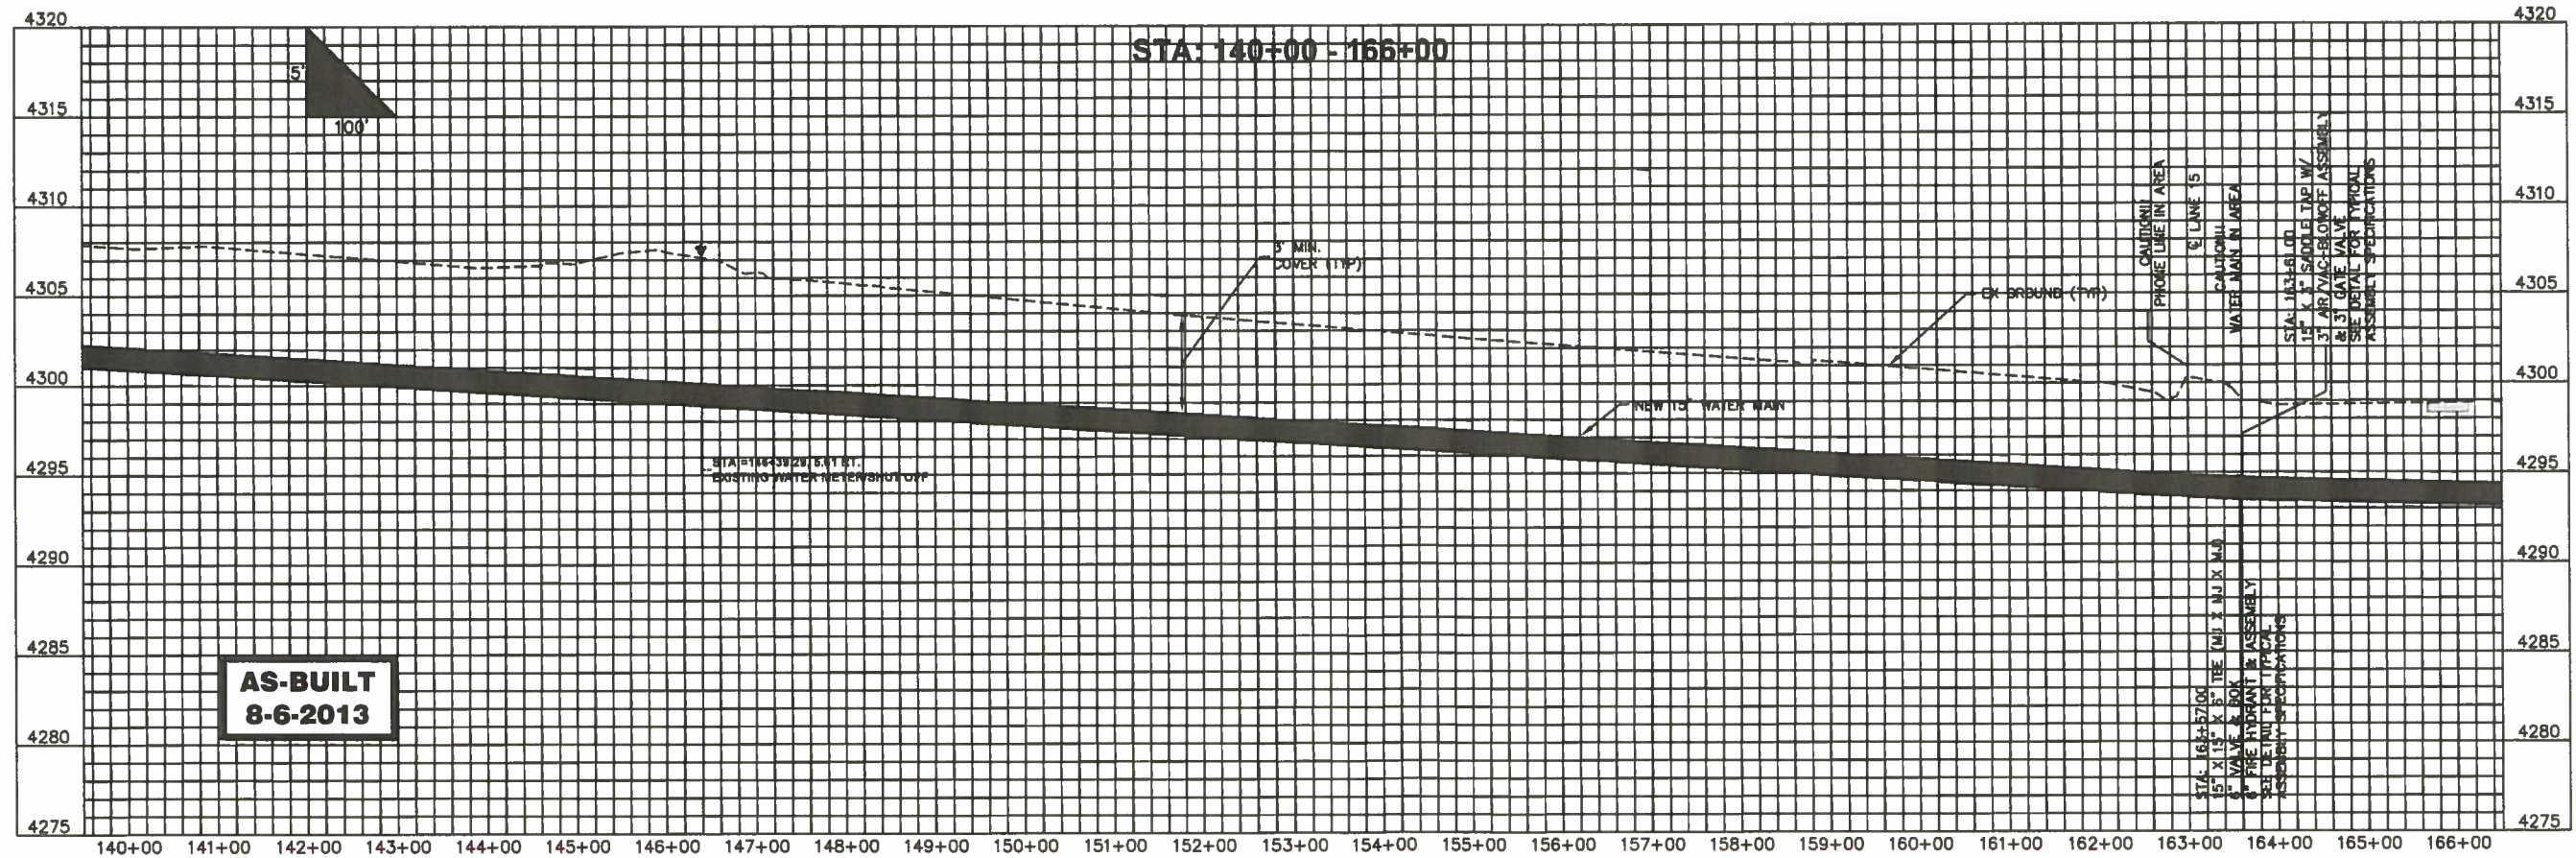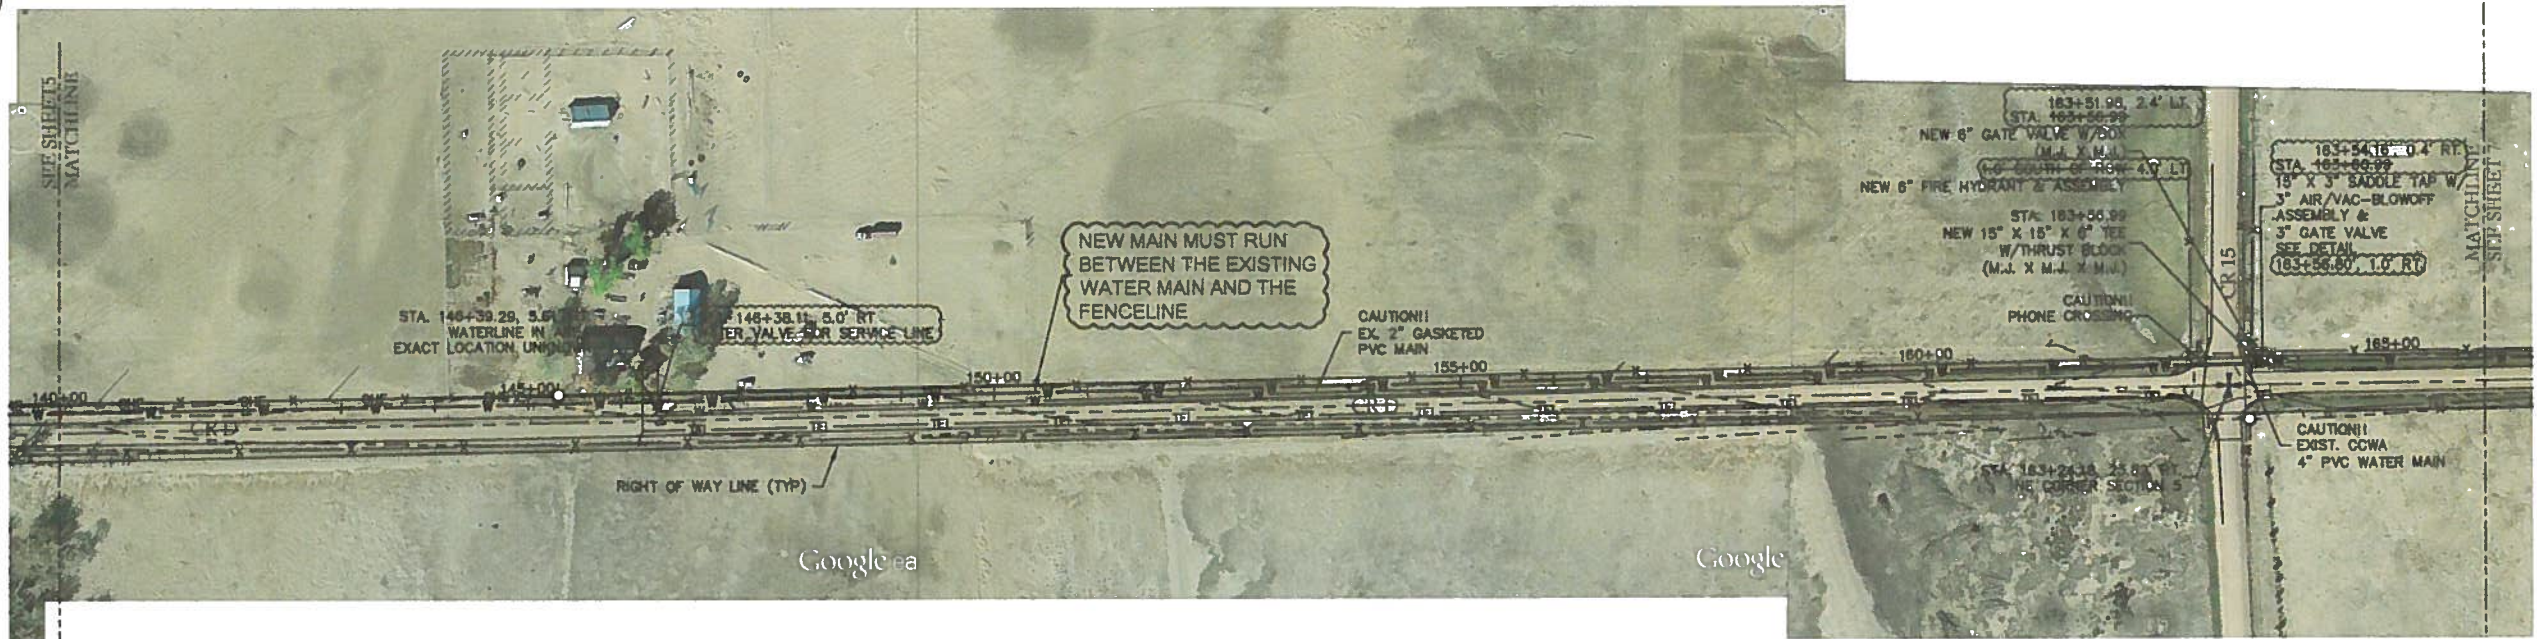

KIDD
ENGINEERING
AND
CONSTRUCTION
MANAGEMENT
SERVICES, INC.

RICKY A. KIDD - PRESIDENT
44511 EAST HIGHWAY 50
AVONDALE, CO 81022
719-544-6238 (O) 719-585-1218 (F)
rickkidd@kiddengineering.com

BACKFILL IN ACCORDANCE WITH
EAGLE IRRIGATION IPS PRESSURE
IRRIGATION GUIDE. PAYING PARTICULAR
ATTENTION TO BEDDING, HAUNCHING,
AND INITIAL BACKFILL REQUIREMENTS




ORDWAY FEEDLOT
WATERLINE



PROJECT TITLE

ORDWAY FEEDLOT
WATERLINE
STA 166+00 THRU 192+00

SHEET TITLE

Job Number: RCS13-04	
Client: Ordway	Drawn By: JMT
Designed By: RK	Checked By: RK
Plot Scale: AS SHOWN	Date: 4/18/13
Sheet Number 7	

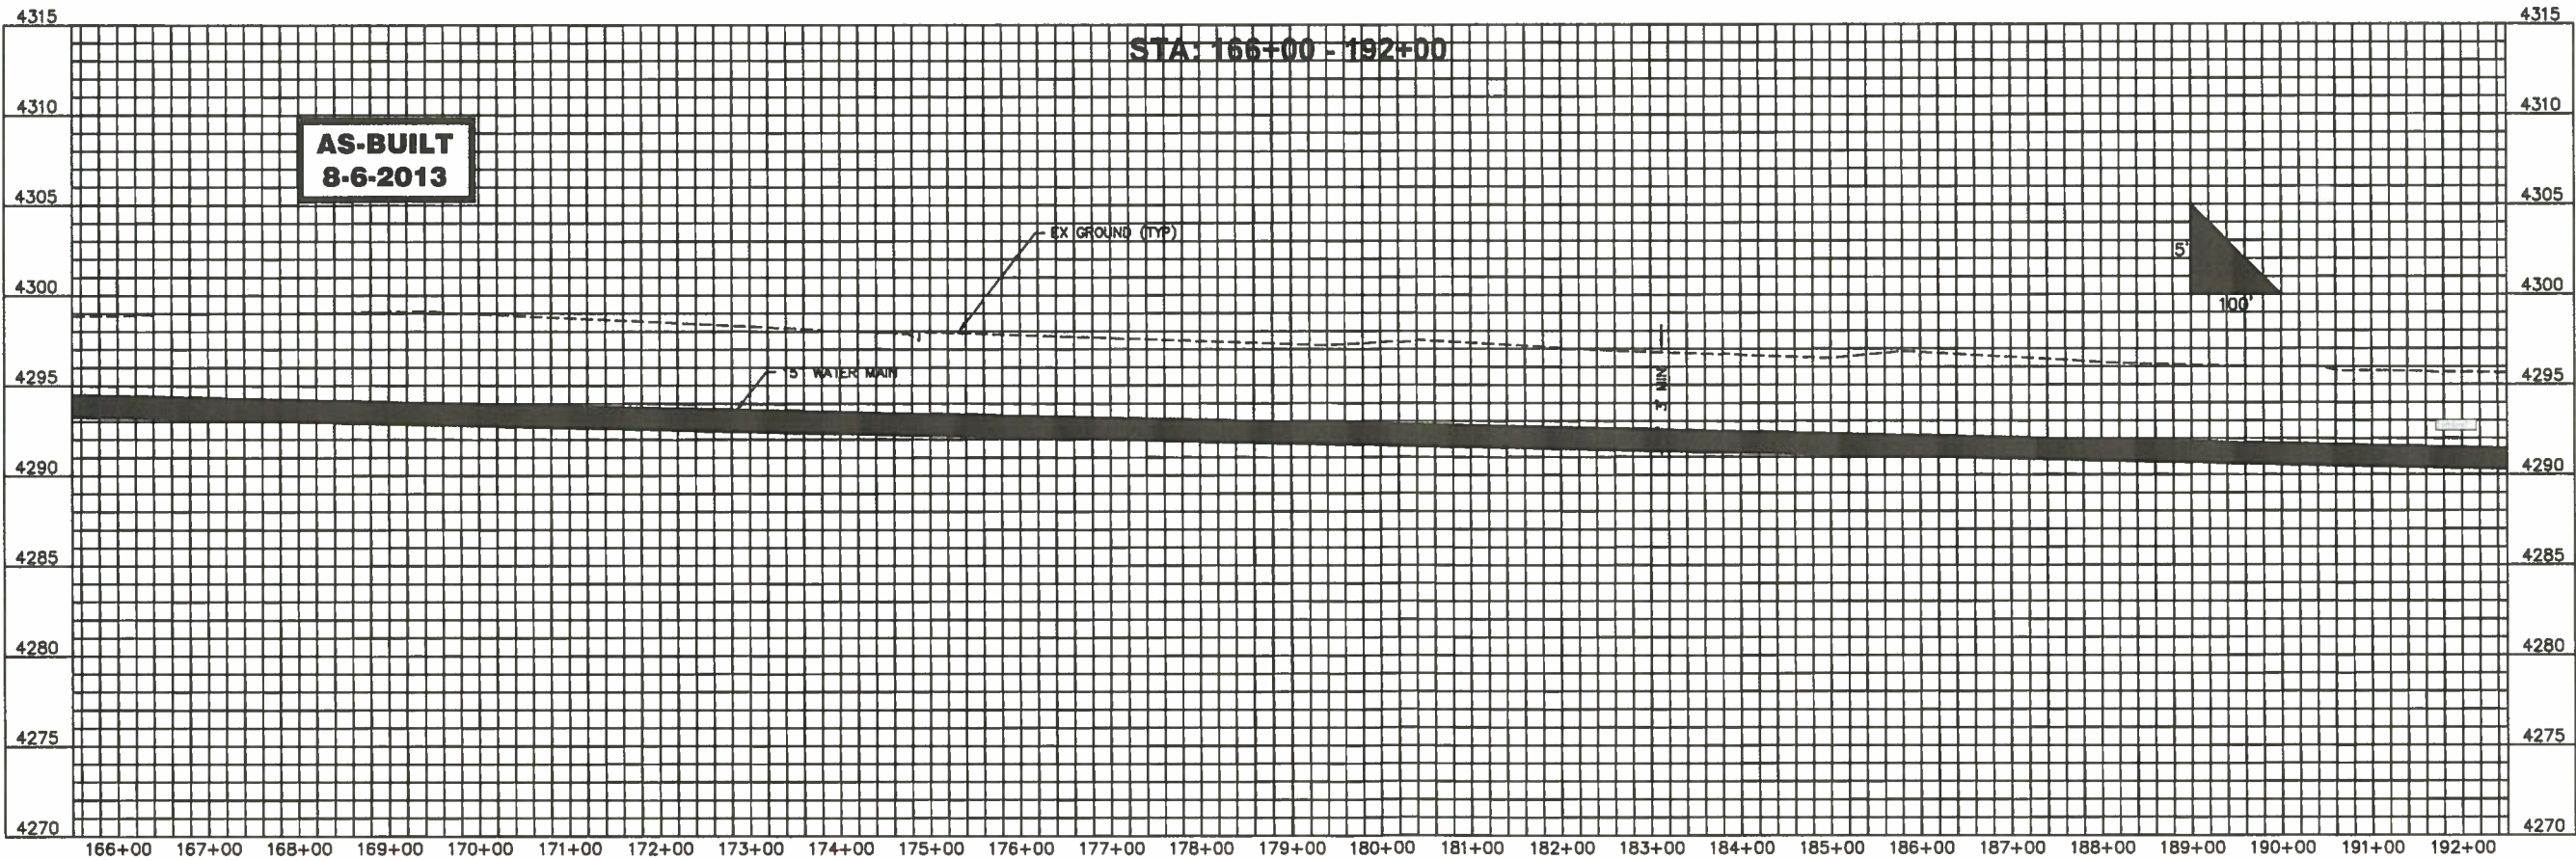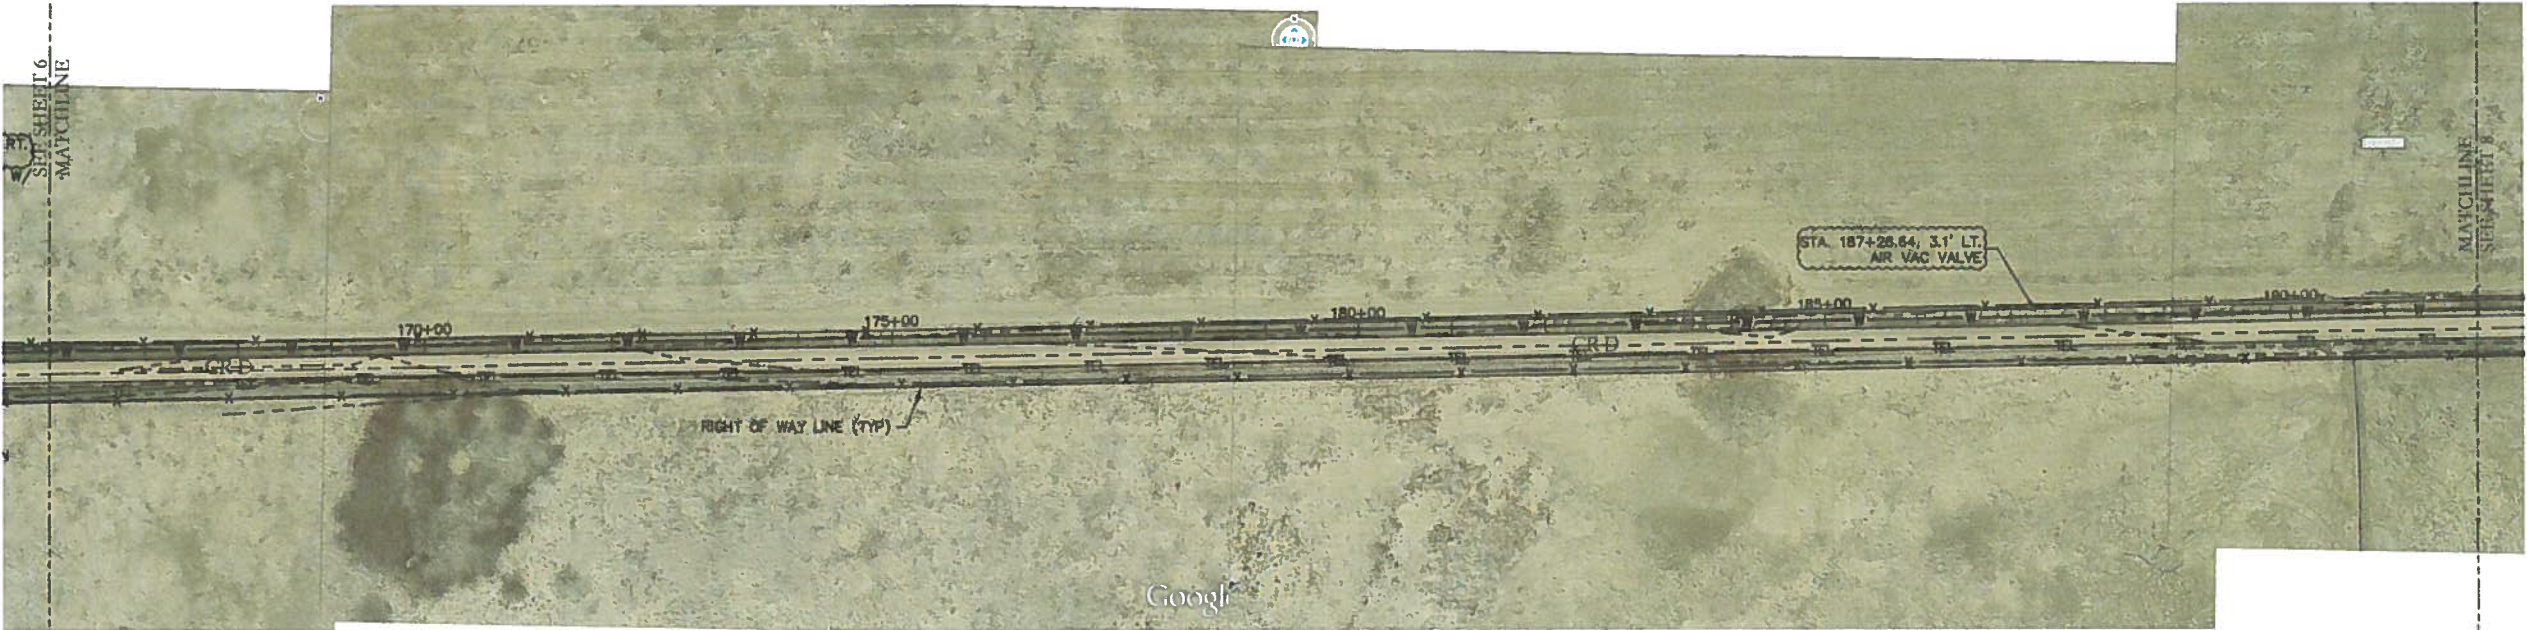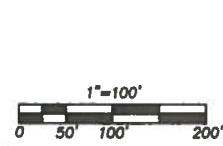

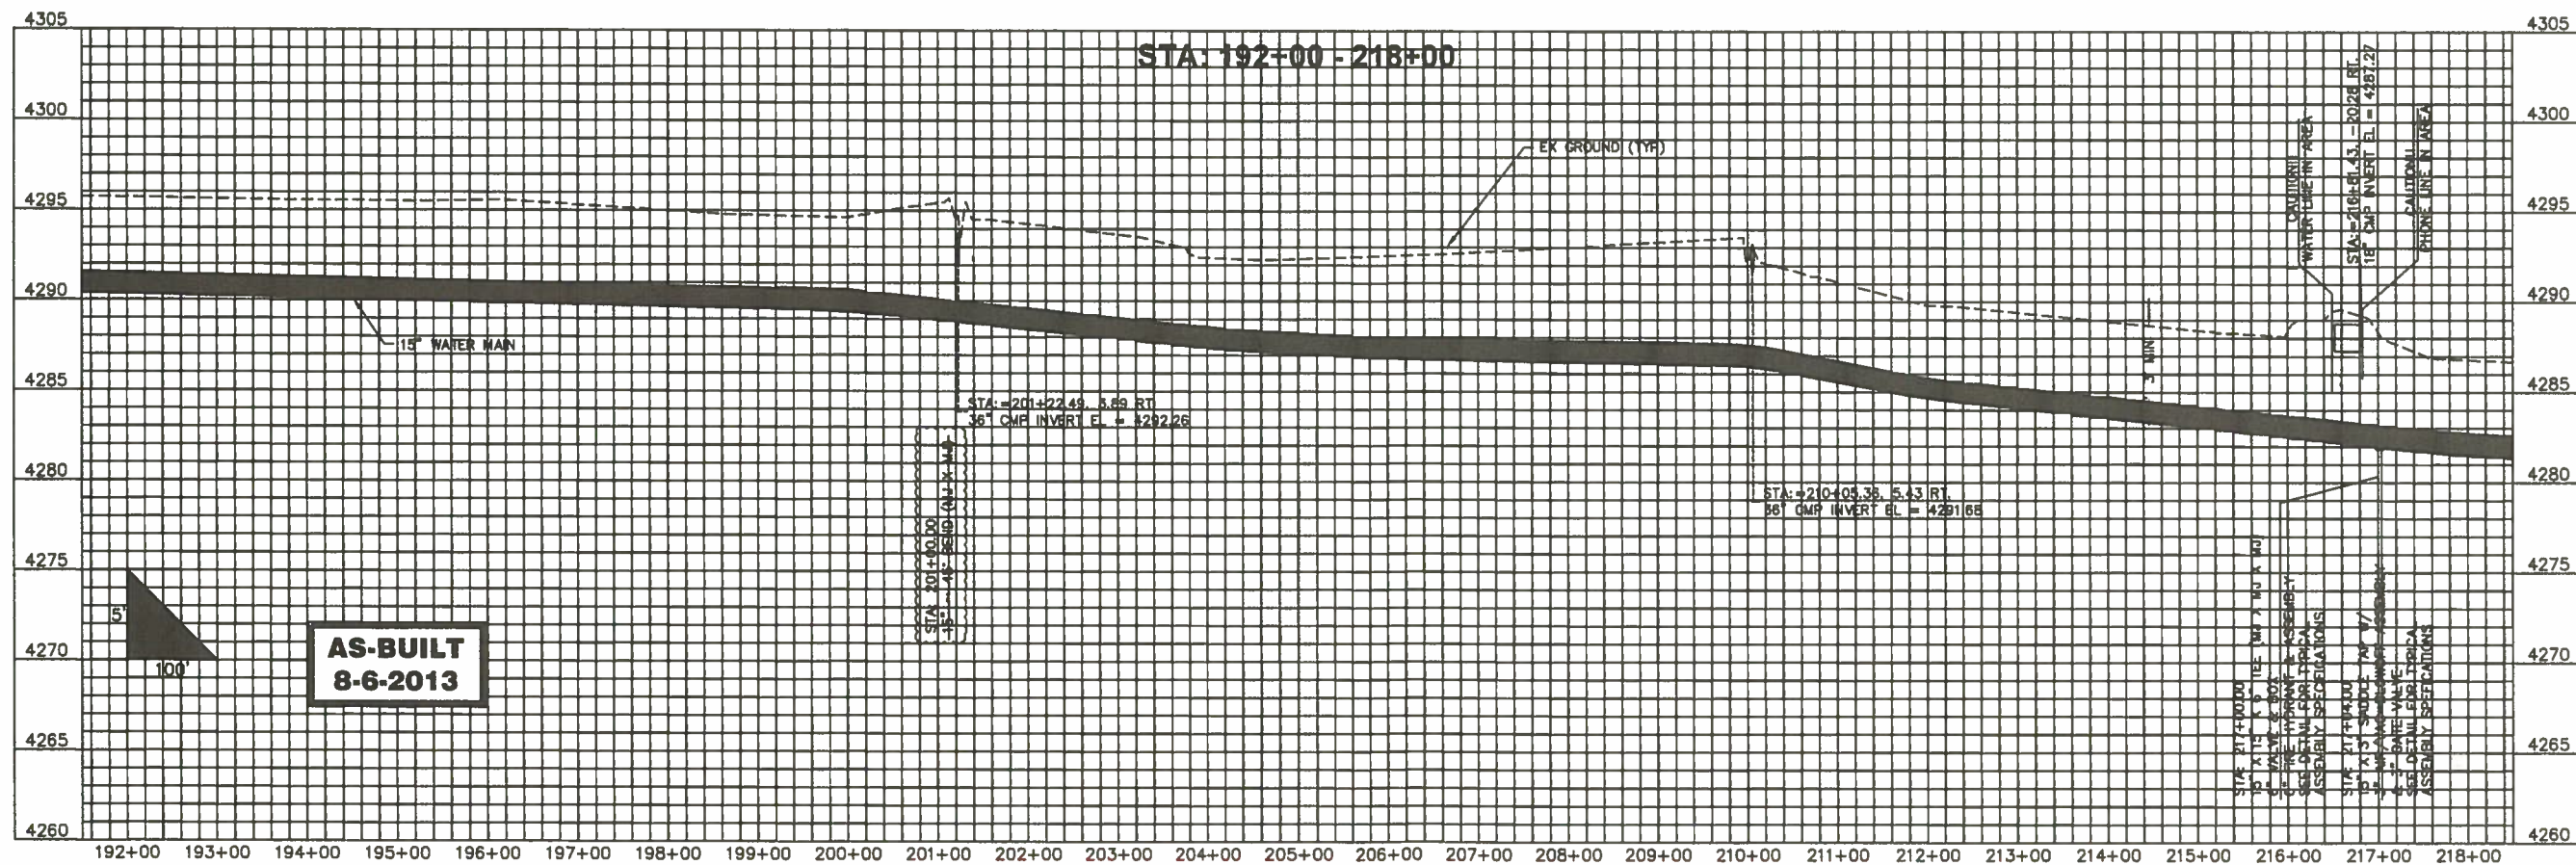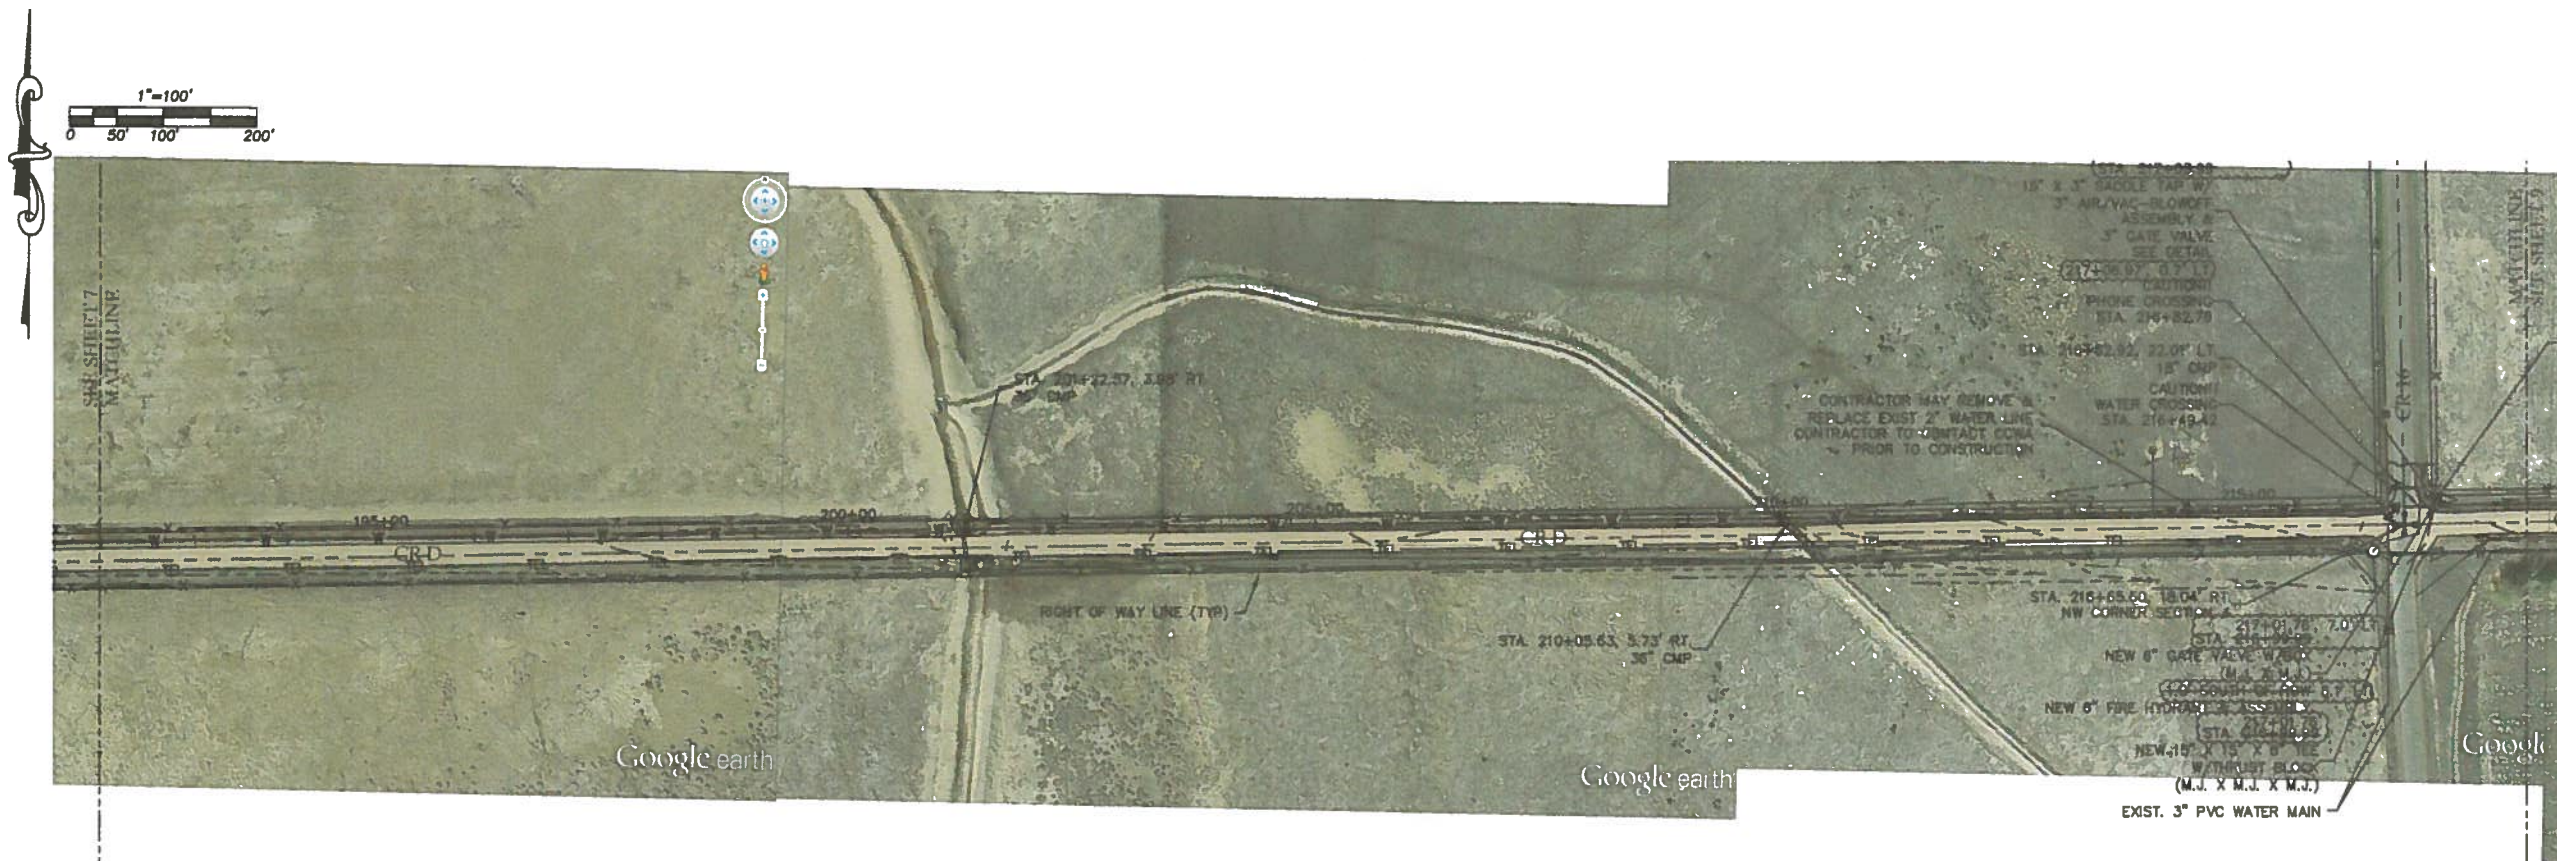

KIDD
ENGINEERING
AND
CONSTRUCTION
MANAGEMENT
SERVICES, INC.




RICKY A. KIDD - PRESIDENT
44811 EAST HIGHWAY 80
AVONDALE, CO 81622
719-844-8239 (O) 719-883-1218 (F)
rickkidd@kiddengineering.com

BACKFILL IN ACCORDANCE WITH JIM
EAGLE IRRIGATION IPS PRESSURE
IRRIGATION GUIDE, PAYING PARTICULAR
ATTENTION TO BEDDING, HAUNCHING,
AND INITIAL BACKFILL REQUIREMENTS

ORDWAY FEEDLOT WATERLINE

**ORDWAY FEEDLOT
WATERLINE
STA 192+00 THRU 218+00**

CORRIDOR	Job Number: RCE13-04	
	Cadd Draw # AS-SKILLT 12-35	Drawn By 13.SV(BDRG)
	Designed By RK	Checked By RK
	Plot Scale: AS SHOWN	Date: 4/18/13
	Sheet Number 8	

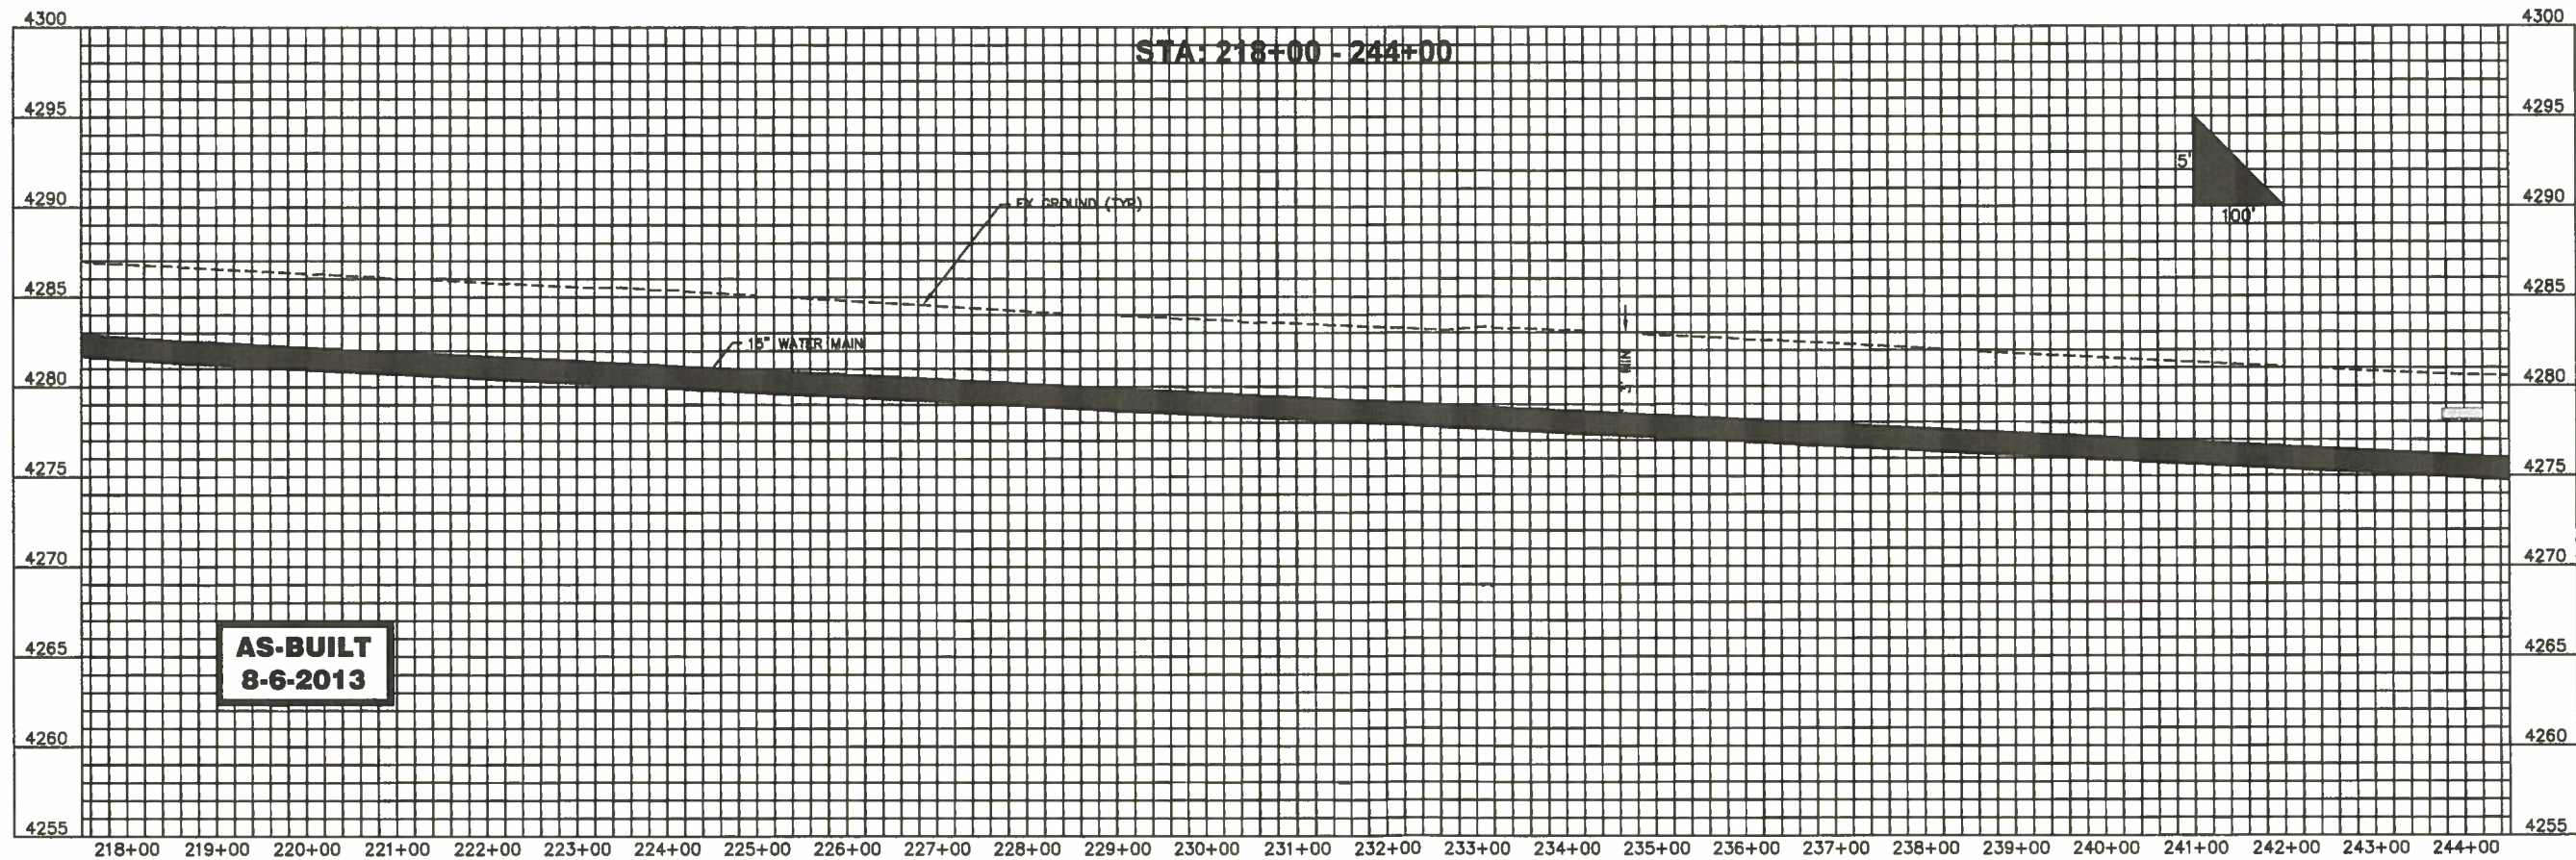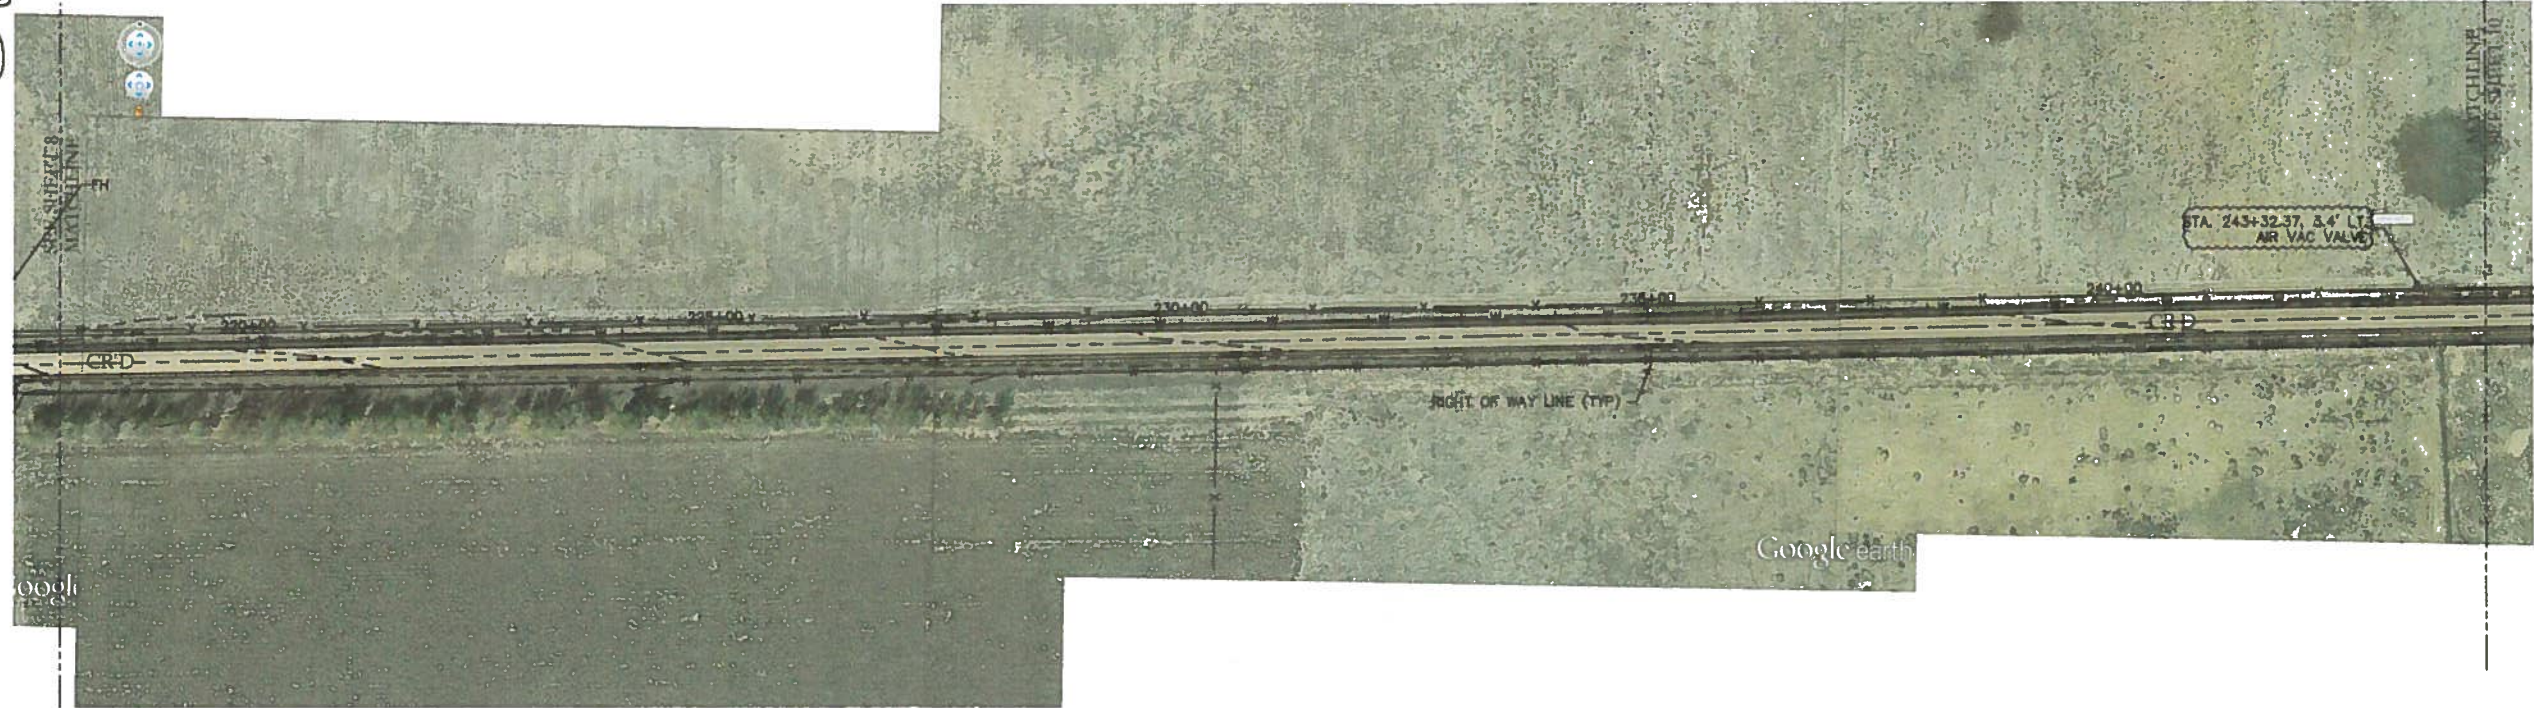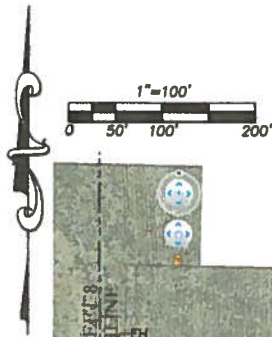

KIDD
ENGINEERING
AND
CONSTRUCTION
MANAGEMENT
SERVICES, INC.

RUCKY A. KIDD - PRESIDENT
44811 EAST HIGHWAY 80
AVONDALE, CO 81622
719-644-8238 (O) 719-685-1218 (F)
rickkidd@kiddengineering.com

BACKFILL IN ACCORDANCE WITH JM
EAGLE IRRIGATION IPS PRESSURE
IRRIGATION GUIDE. PAYING PARTICULAR
ATTENTION TO BEDDING, HAUNCHING,
AND INITIAL BACKFILL REQUIREMENTS


ORDWAY FEEDLOT
WATERLINE

PROJECT TITLE

ORDWAY FEEDLOT
WATERLINE
STA 218+00 THRU 244+00

SHEET TITLE

Job Number: 20013-04	
Coord. - AS-BUILT	Drawn By: JYT
Designed By: RC	Checked By: RC
Plot Scale: AS SHOWN	Date: 4/16/13
Sheet Number	9

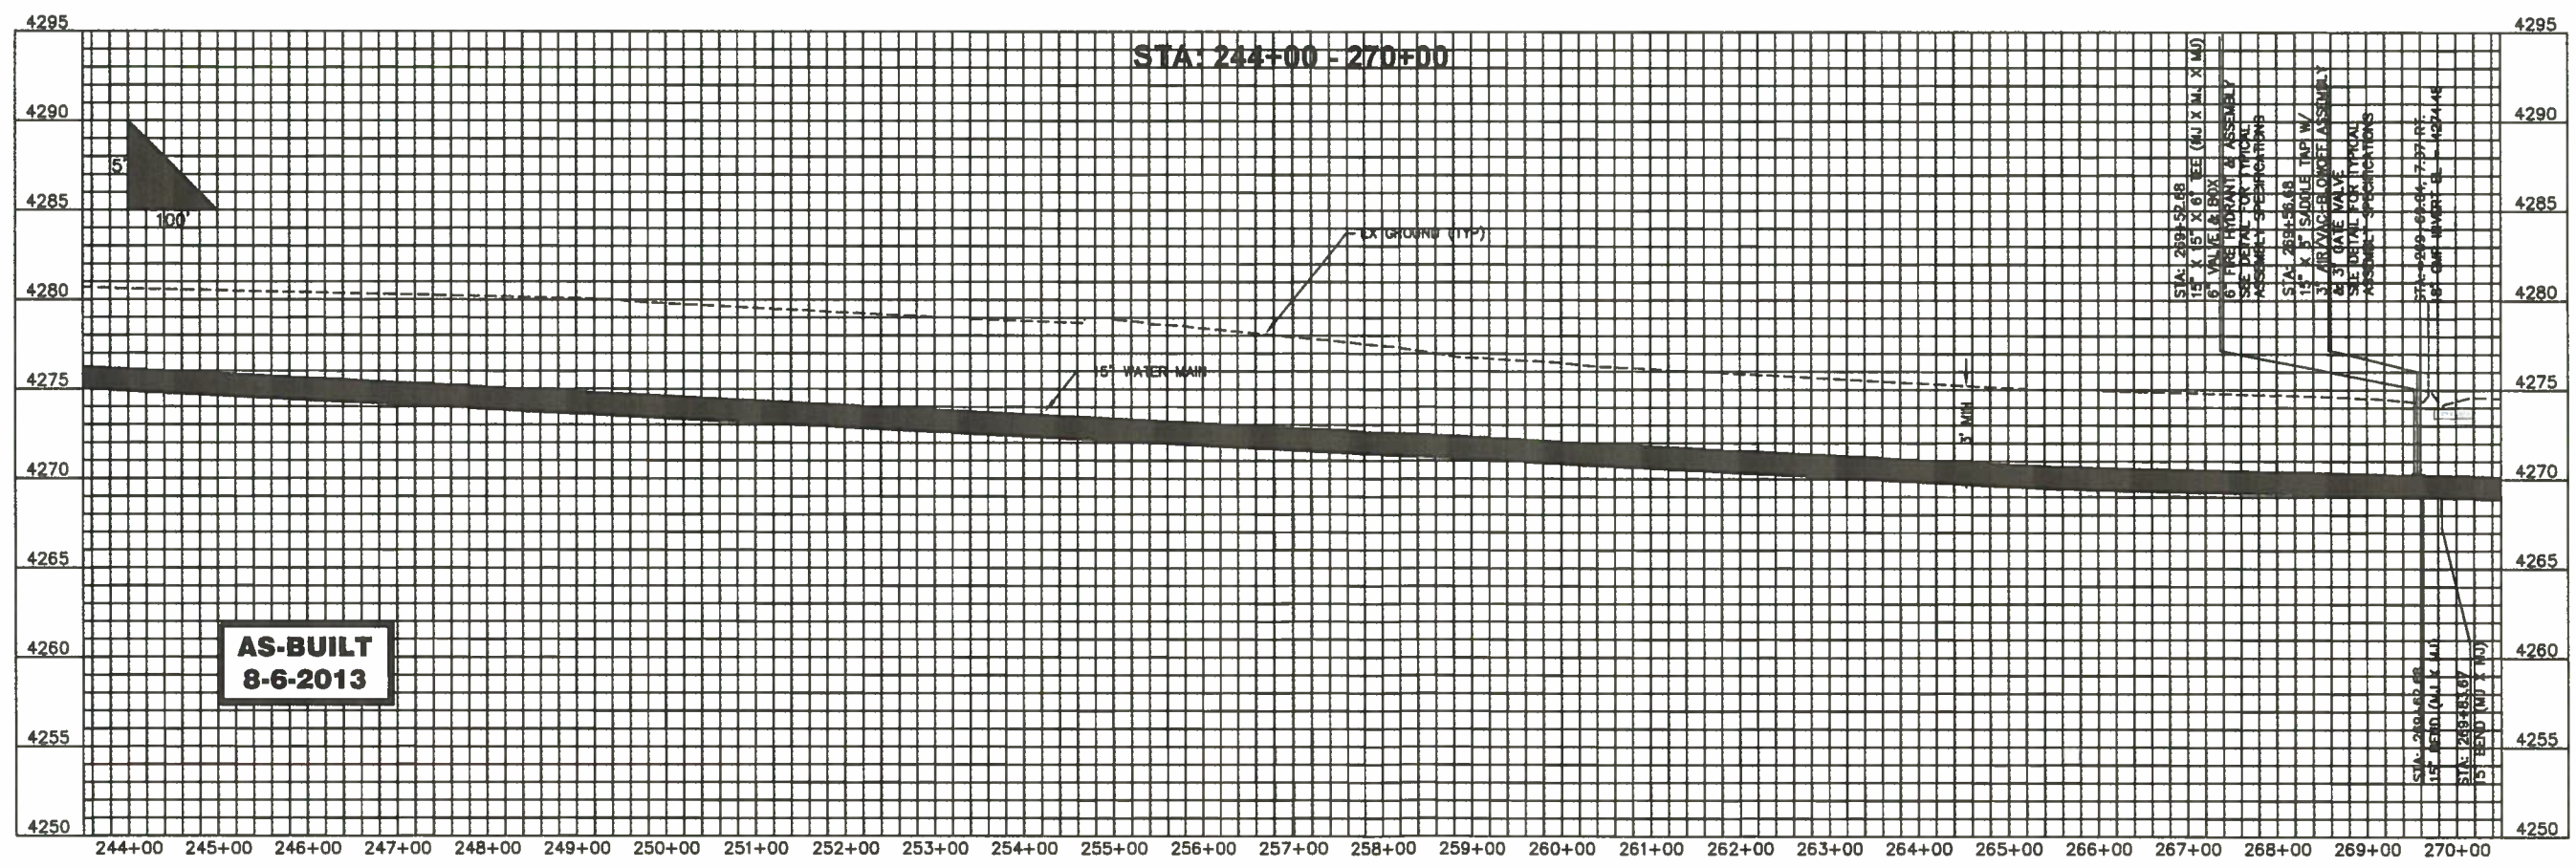

KIDD
ENGINEERING
AND
CONSTRUCTION
MANAGEMENT
SERVICES, INC

RUCKY A. KIDD - PRESIDENT
44811 EAST HIGHWAY 80
AVONDALE, CO 81622
718-644-6238 (D) 718-685-1218 (F)
rickkidd@kiddengineering.com

BACKFILL IN ACCORDANCE WITH JM
EAGLE IRRIGATION IPS PRESSURE
IRRIGATION GUIDE, PAYING PARTICULAR
ATTENTION TO BEDDING, HAUNCHING,
AND INITIAL BACKFILL REQUIREMENTS



PROJECT TITLE
**ORDWAY FEEDLOT
WATERLINE**

SHEET TITLE
**ORDWAY FEEDLOT
WATERLINE
STA 244+00 THRU 270+00**

Job Number: RCE13-04	
Check Drawn By CONDOOR - AS-BUILT/980 JNT	Drawn By JNT
Designed By RJR	Checked By RJR
Plot Scale AS SHOWN	Date 4/18/13
Sheet Number 10	



1"=100'
0 50' 100' 200'

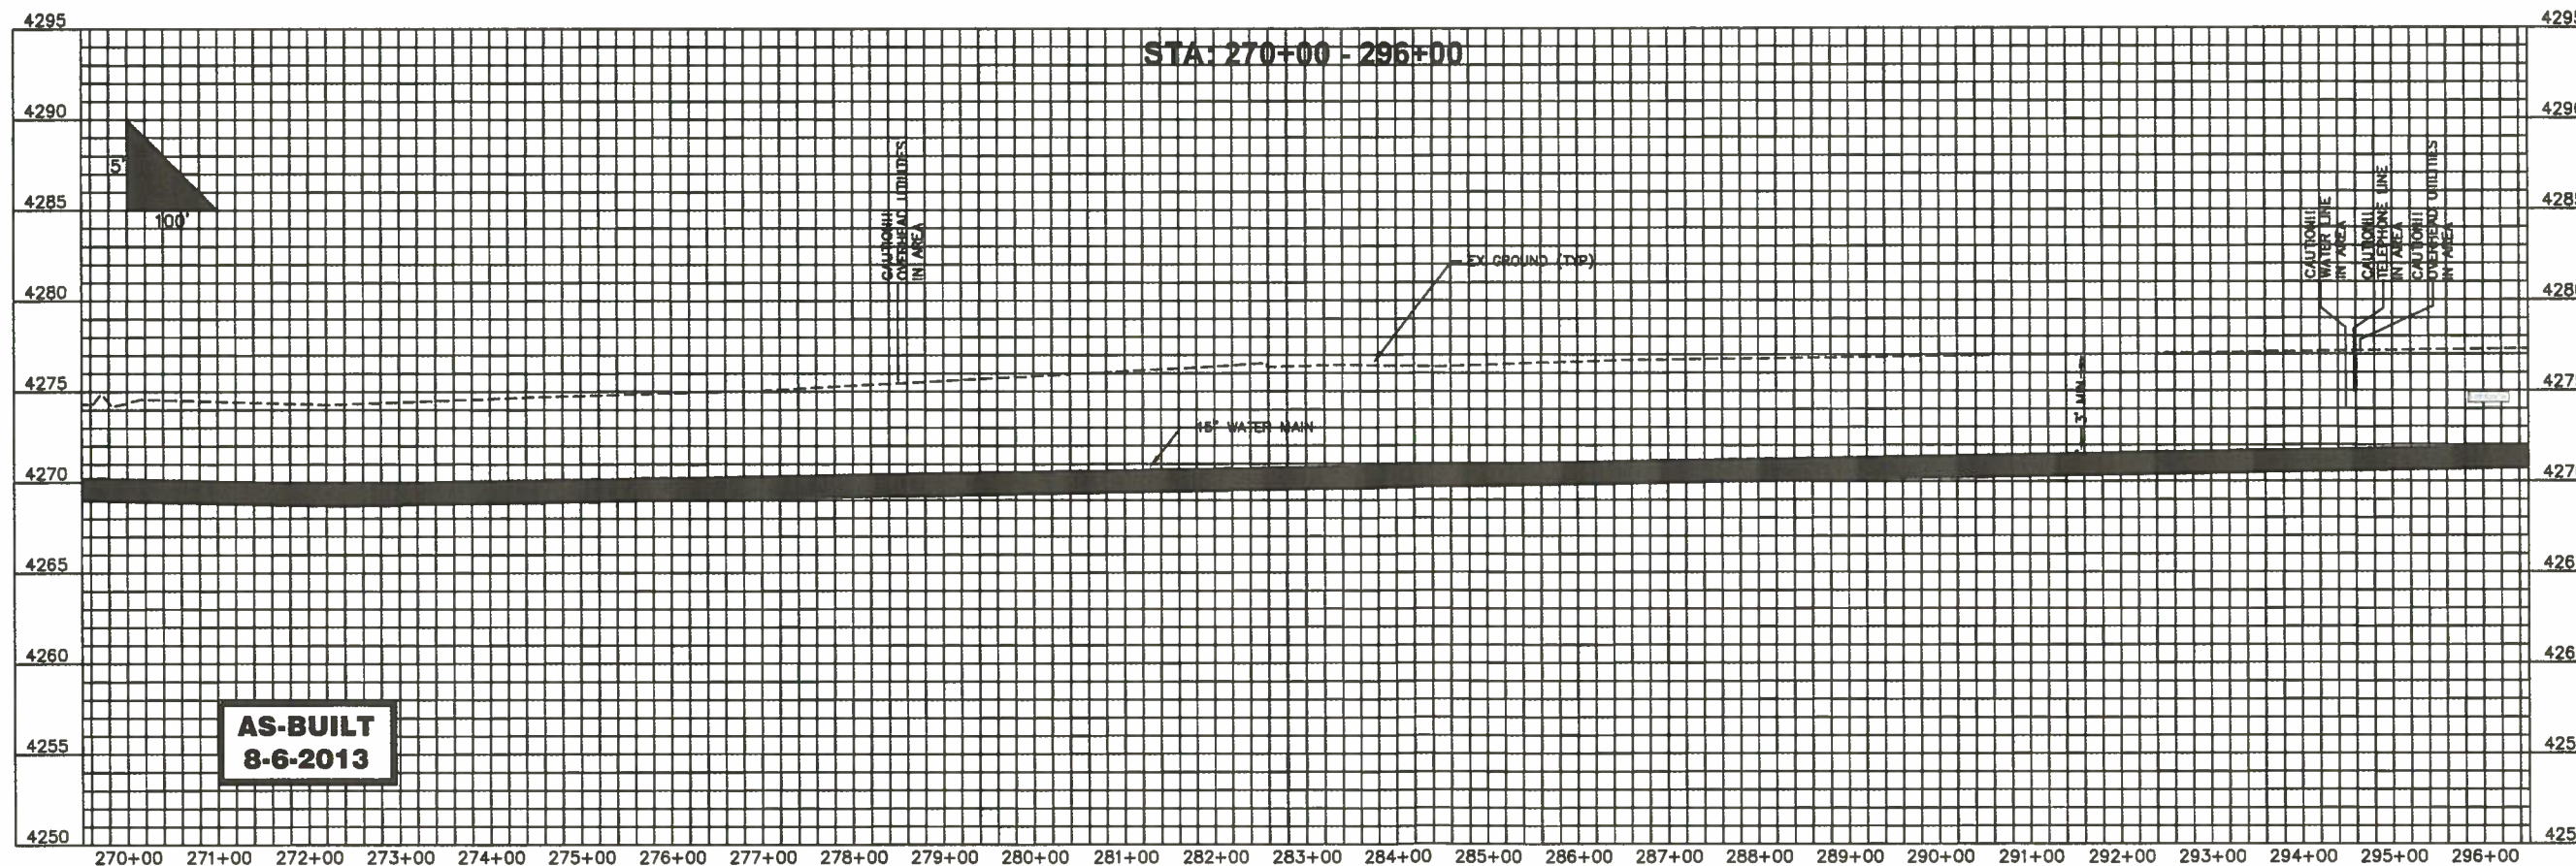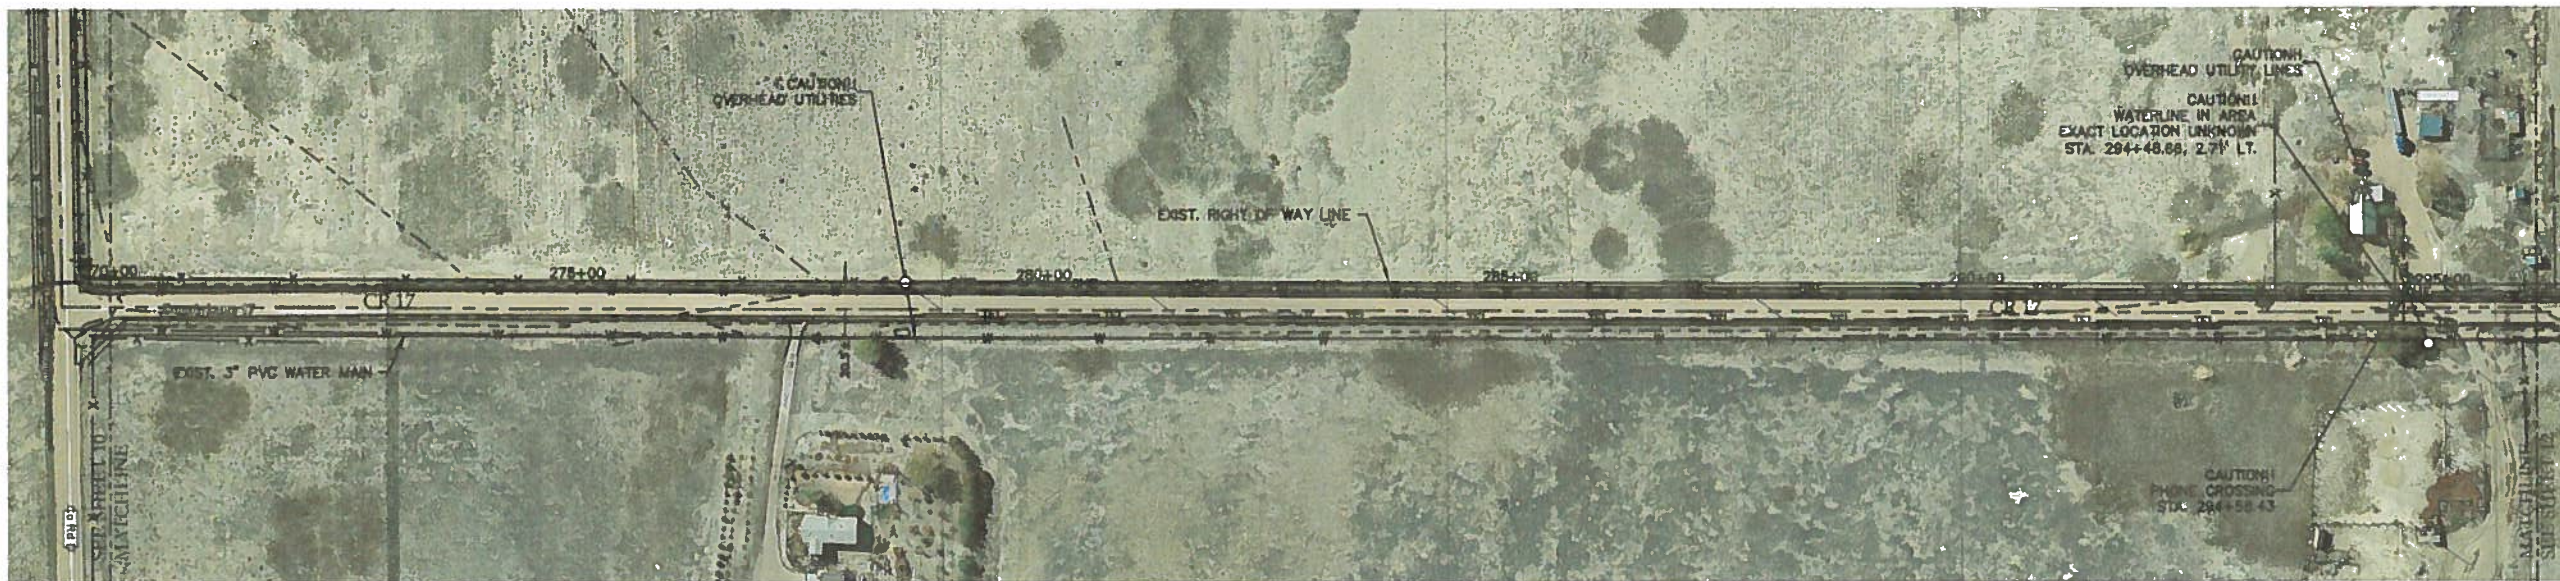

KIDD
ENGINEERING
AND
CONSTRUCTION
MANAGEMENT
SERVICES, INC



RICKY A. KIDD - PRESIDENT
44811 EAST HIGHWAY 60
AVONDALE, CO 81602
719-444-6539 (O) 719-665-1218 (F)
rickkidd@kiddengineering.com

BACKFILL IN ACCORDANCE WITH JM
EAGLE IRRIGATION IPS PRESSURE
IRRIGATION GUIDE, PAYING PARTICULAR
ATTENTION TO BEDDING, HAUNCHING
AND INITIAL BACKFILL REQUIREMENTS

PROJECT TITLE
**ORDWAY FEEDLOT
WATERLINE**

SHEET TITLE
**ORDWAY FEEDLOT
WATERLINE
STA 270+00 THRU 296+00**

Job Number: RCB13-04	
Client: Dwyer & Associates, Inc.	Drawn By: JNT
Designed By: RKT	Checked By: RKT
Plot Scale: AS SHOWN	Date: 8/28/2013
Sheet Number 1	

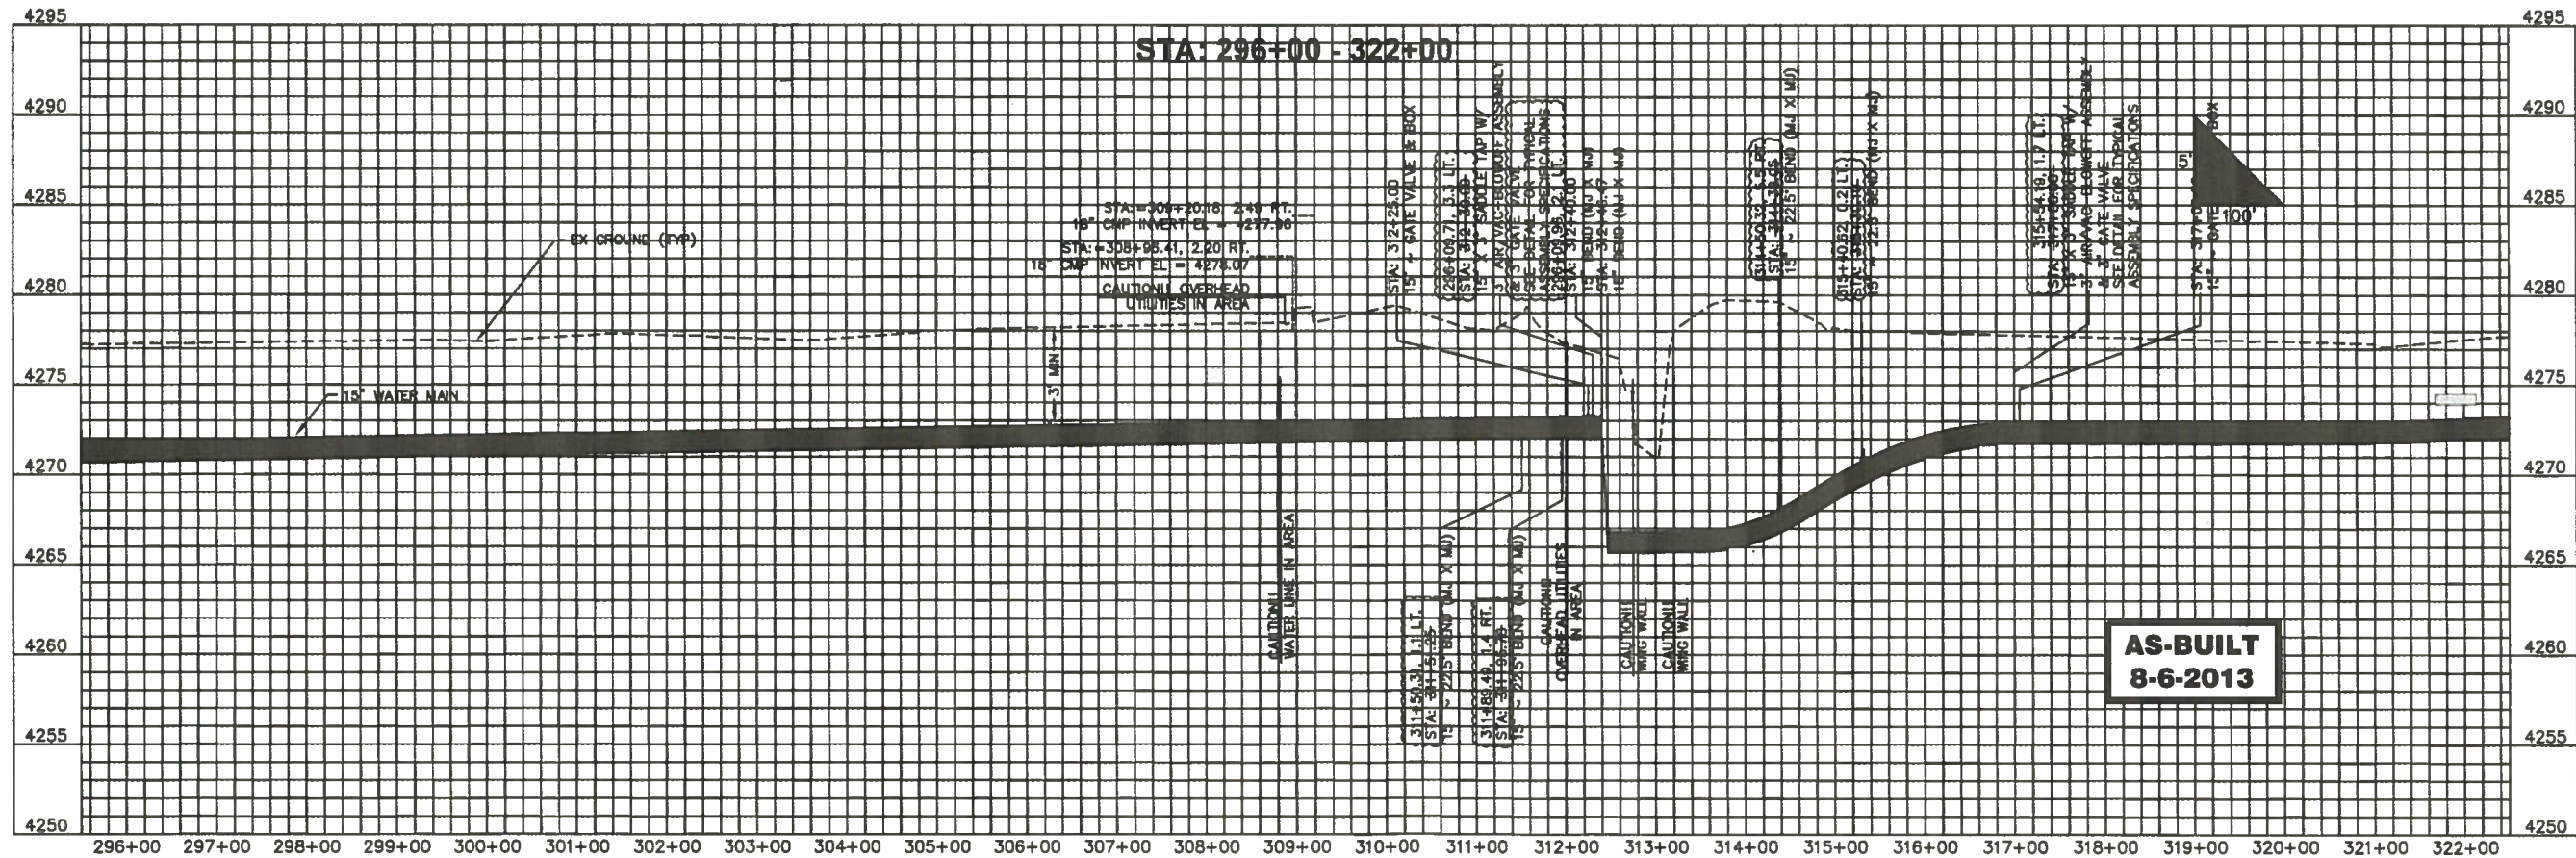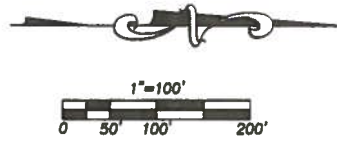

KIDD
ENGINEERING
AND
CONSTRUCTION
MANAGEMENT
SERVICES, INC.




RICKY A. KIDD - PRESIDENT
44811 EAST HIGHWAY 80
AVONDALE, CO 81022
719-644-8239 (O) 719-663-1216 (F)
rick.kidd@kiddengineering.com

BACKFILL IN ACCORDANCE WITH JM
EAGLE IRRIGATION IPS PRESSURE
IRRIGATION GUIDE. PAYING PARTICULAR
ATTENTION TO BEDDING, HAUNCHING,
AND INITIAL BACKFILL REQUIREMENTS

PROJECT TITLE
**ORDWAY FEEDLOT
WATERLINE**

SHEET TITLE
**ORDWAY FEEDLOT
WATERLINE
STA 296+00 THRU 322+00**

Job Number: R0313-04	
Drawn By: JET	Check By: JET
Designed By: JET	Checked By: JET
Plot Scale: AS SHOWN	Date: 8/28/2013
Sheet Number 12	

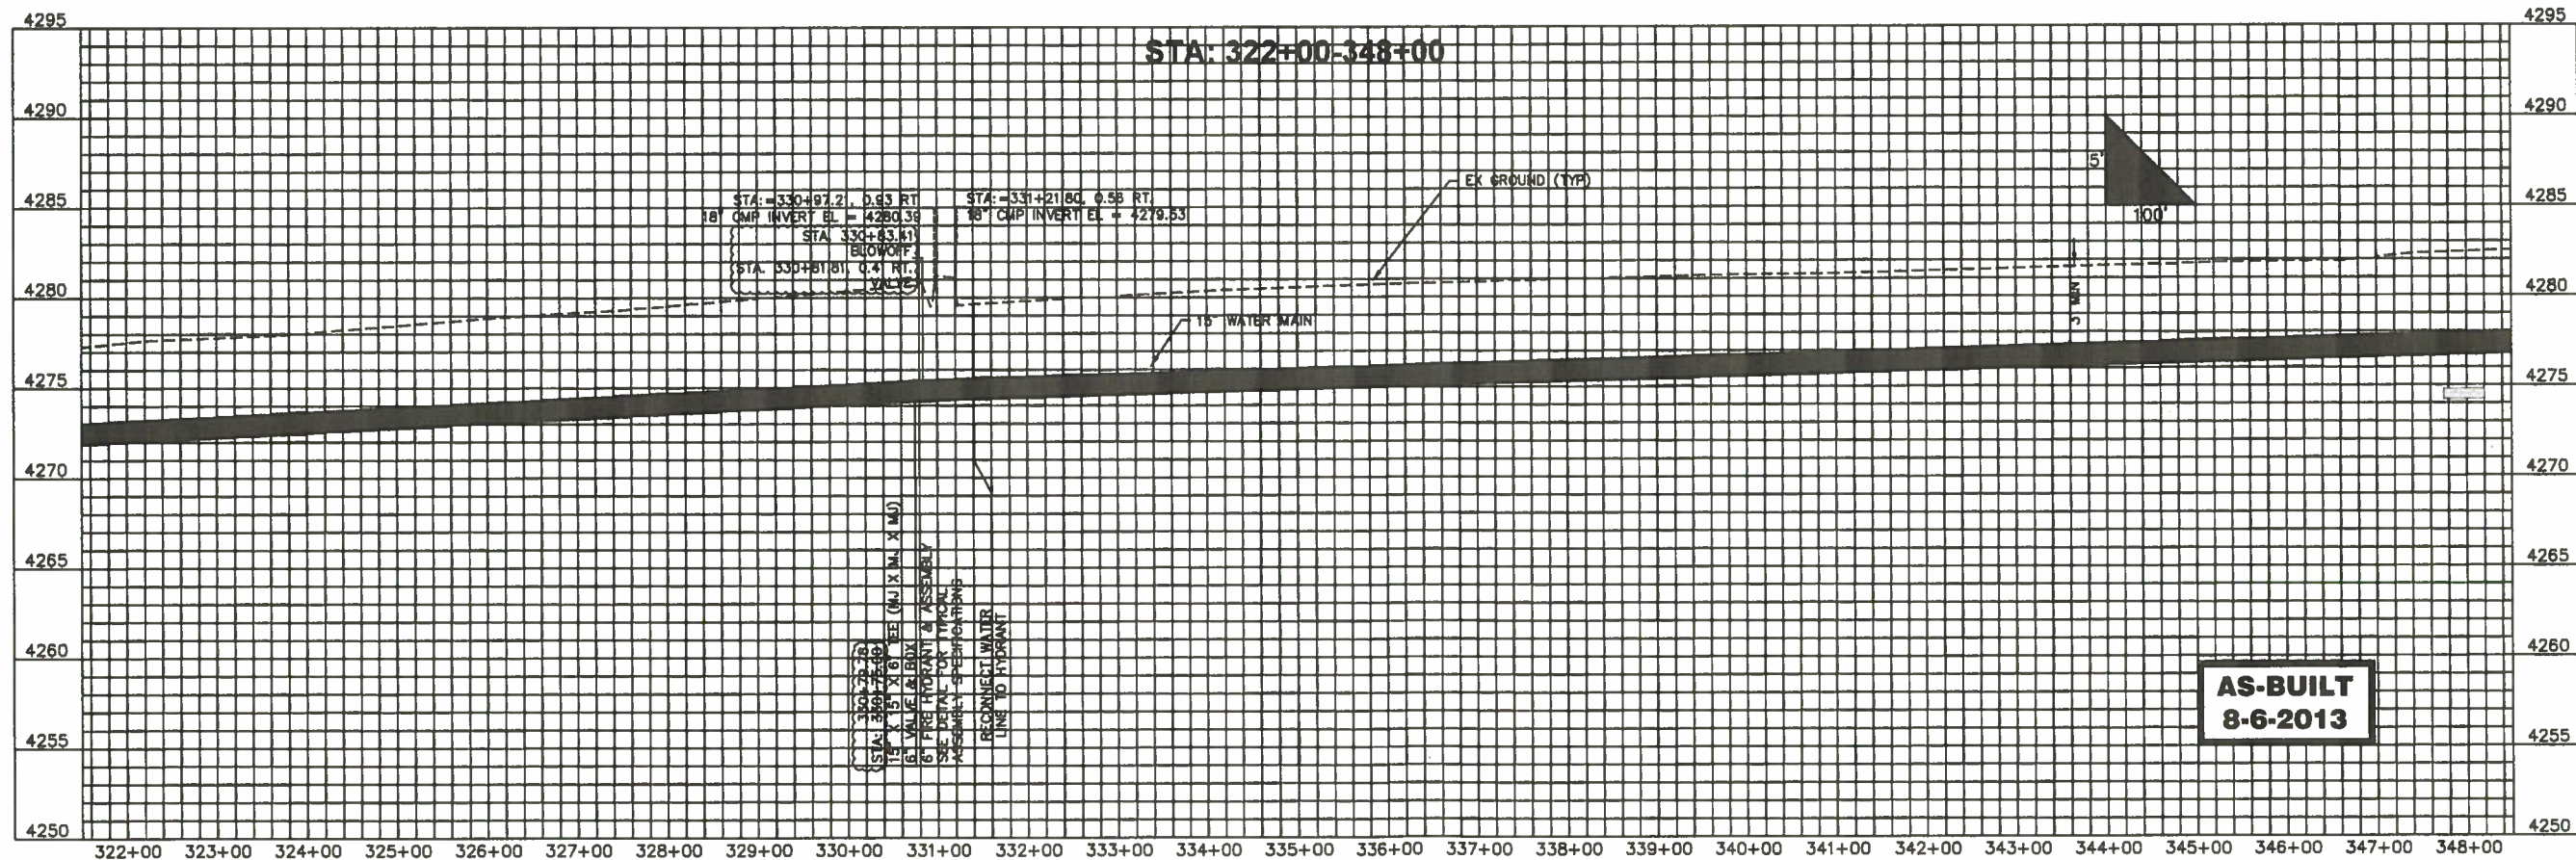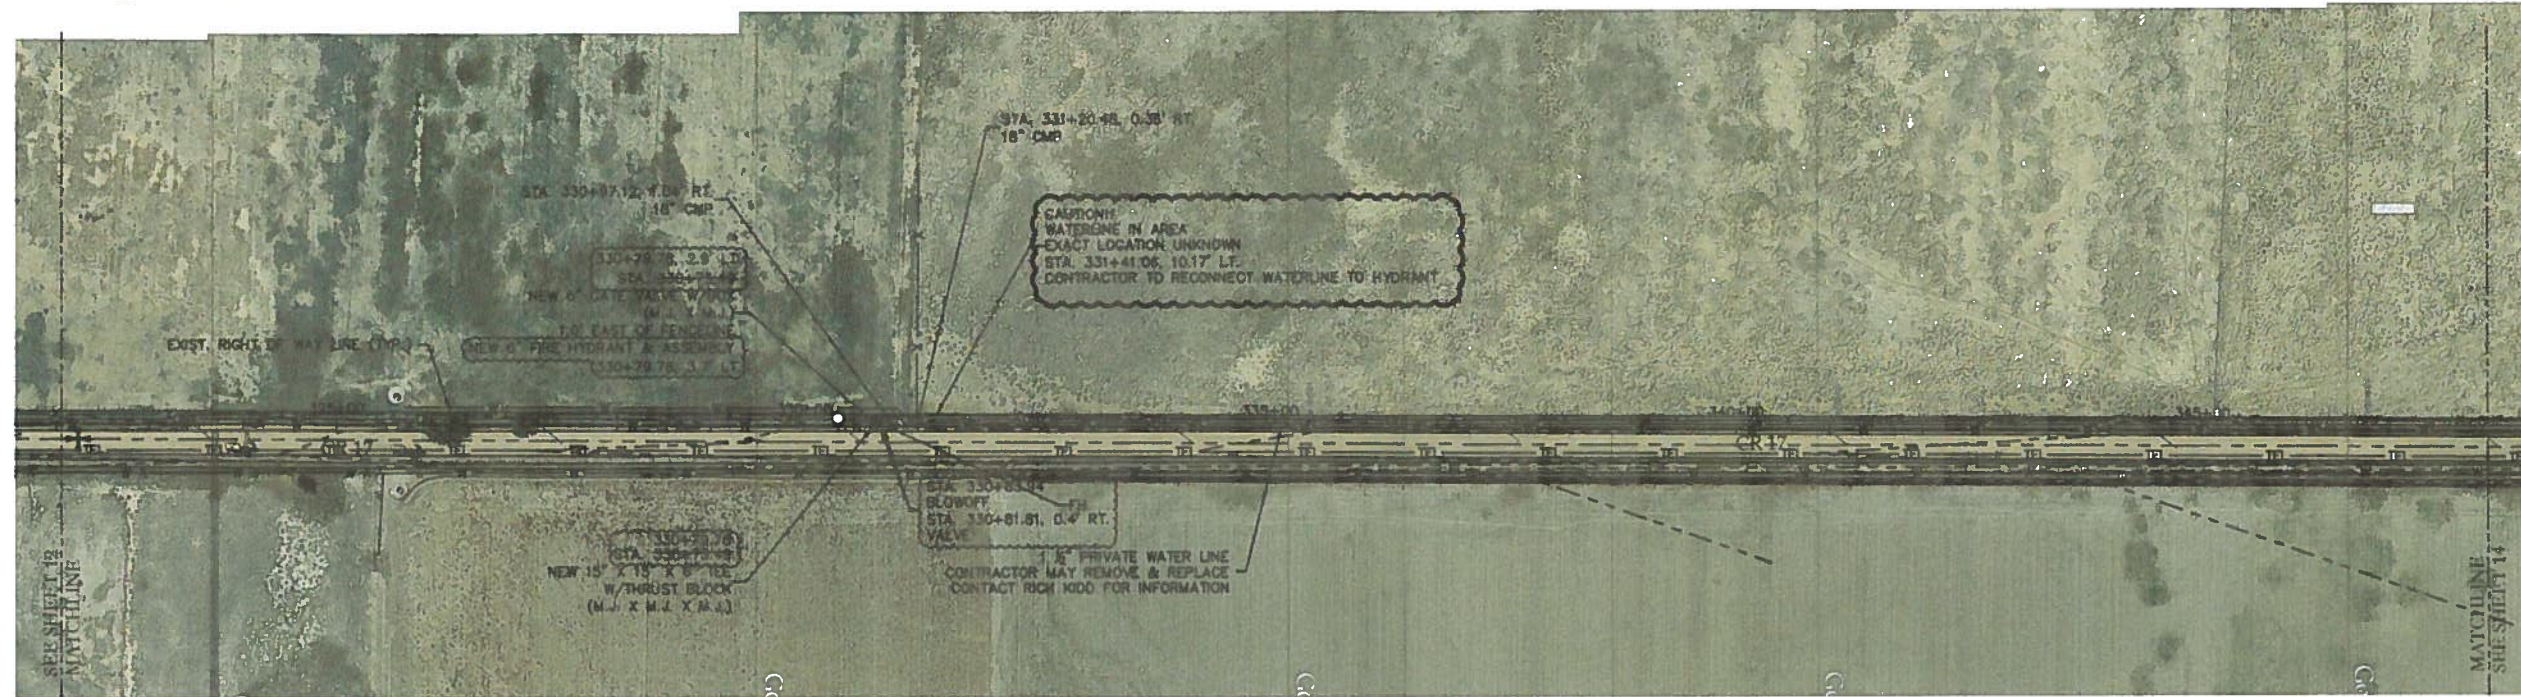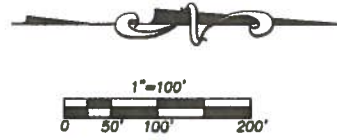

KIDD
ENGINEERING
AND
CONSTRUCTION
MANAGEMENT
SERVICES, INC.

RICKY A. KIDD - PRESIDENT
44811 EAST HIGHWAY 68
AVONDALE, CO 81622
719-444-8238 (O) 719-489-1216 (F)
rickkidd@kiddengineering.com

BACKFILL IN ACCORDANCE WITH JIM
EAGLE IRRIGATION IPS PRESSURE
IRRIGATION GUIDE. PAYING PARTICULAR
ATTENTION TO BEDDING, HAUNCHING,
AND INITIAL BACKFILL REQUIREMENTS

PROJECT TITLE


**ORDWAY FEEDLOT
WATERLINE**

SHEET TITLE

**ORDWAY FEEDLOT
WATERLINE
STA 322+00 THRU 348+00**

**AS-BUILT
8-6-2013**

Job Number: R0213-04	
Created By: JKT	Drawn By: JKT
Designed By: JKT	Checked By: JKT
Plot Date: 8/28/2013	Sheet Number: 13

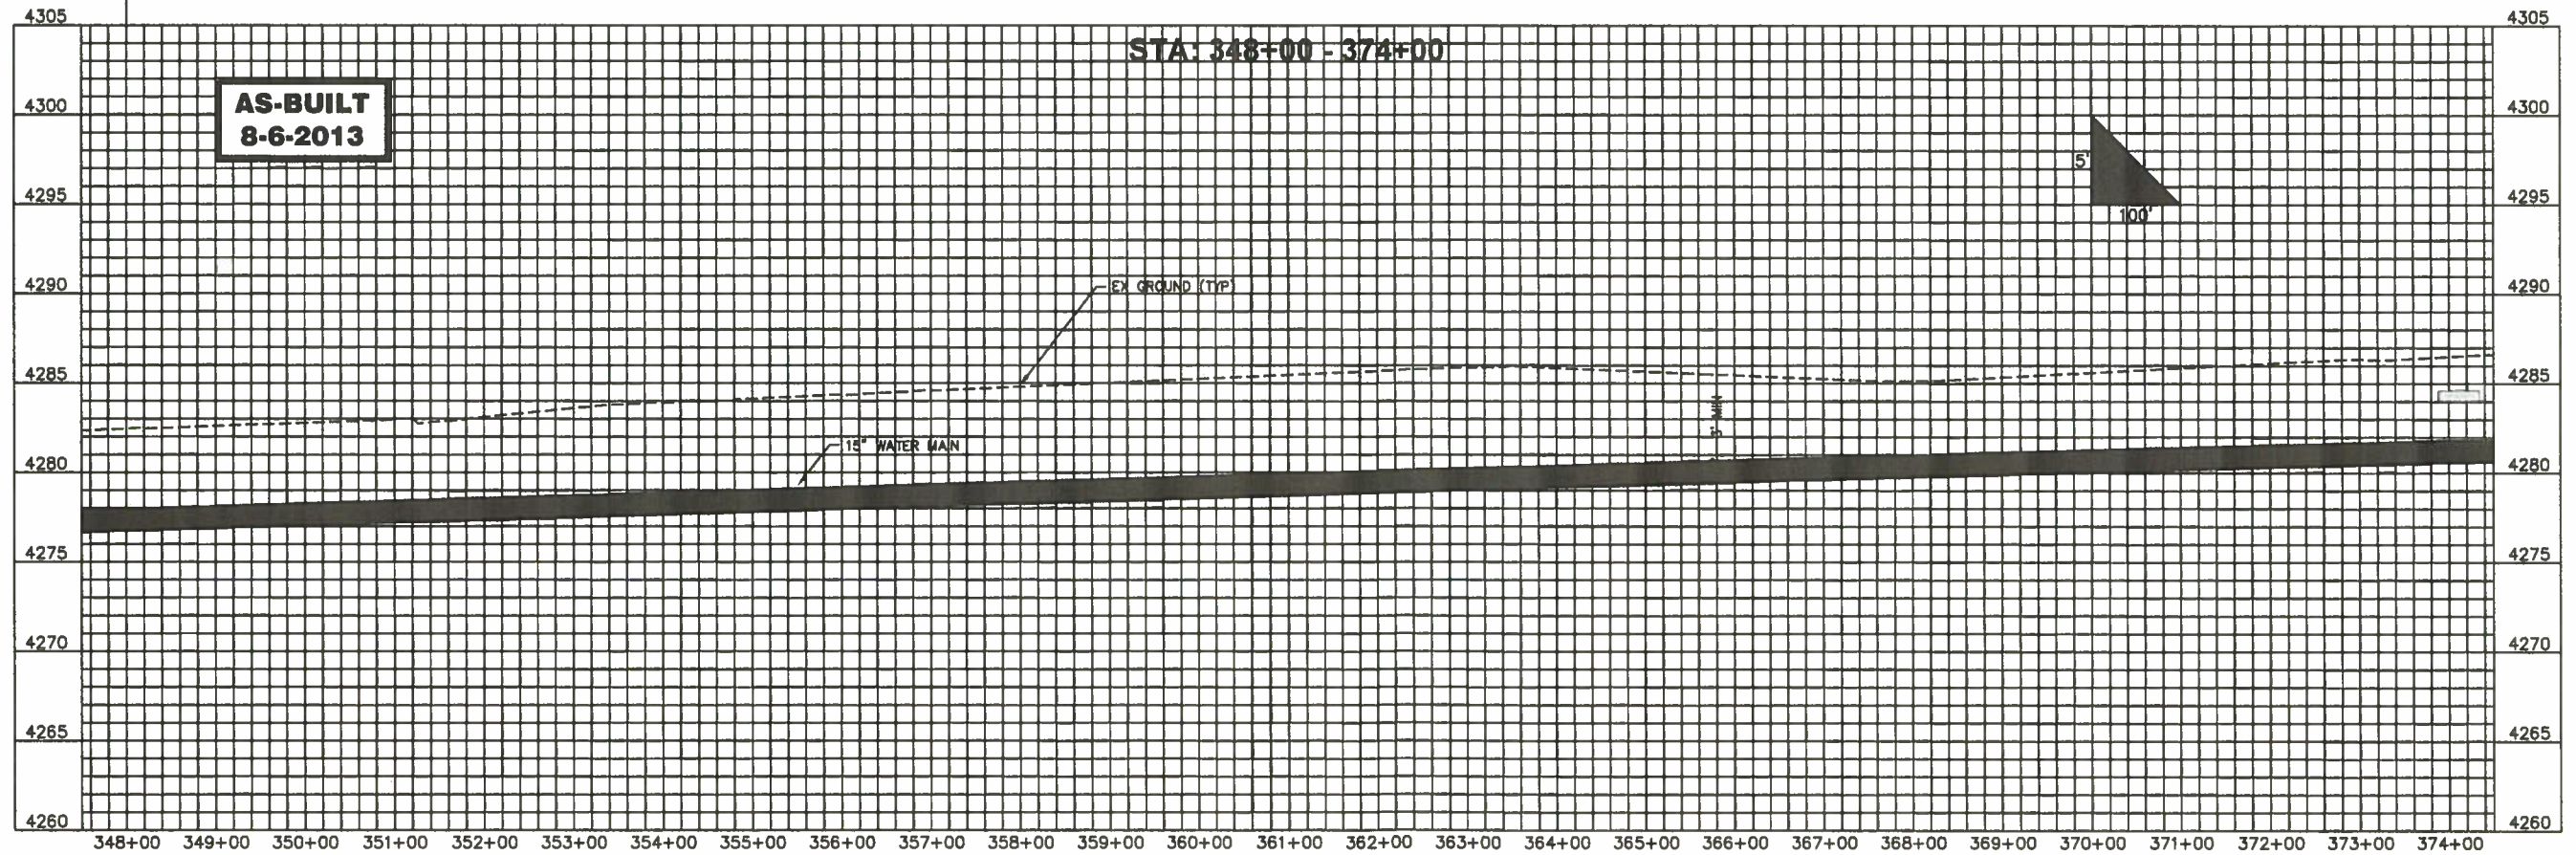

KIDD
ENGINEERING
AND
CONSTRUCTION
MANAGEMENT
SERVICES, INC.


RICKY A. KIDD - PRESIDENT
44811 EAST HIGHWAY 80
AVONDALE, CO 81822
719-844-8233 (O) 719-865-1216 (F)
rickkidd@kiddengineering.com

BACKFILL IN ACCORDANCE WITH JM
EAGLE IRRIGATION IPS PRESSURE
IRRIGATION GUIDE. PAYING PARTICULAR
ATTENTION TO BEDDING, HAUNCHING,
AND INITIAL BACKFILL REQUIREMENTS

PROJECT TITLE
**ORDWAY FEEDLOT
WATERLINE**

SHEET TITLE
**ORDWAY FEEDLOT
WATERLINE
STA 348+00 THRU 374+00**

Job Number: RCB13-04	
Drawn By: CORCORAN - AS-BUILT/DRG - JET	Checked By: JET
Designed By: JET	Checked By: JET
Plot Scale: AS SHOWN	Date: 4/18/13
Sheet Number 14	

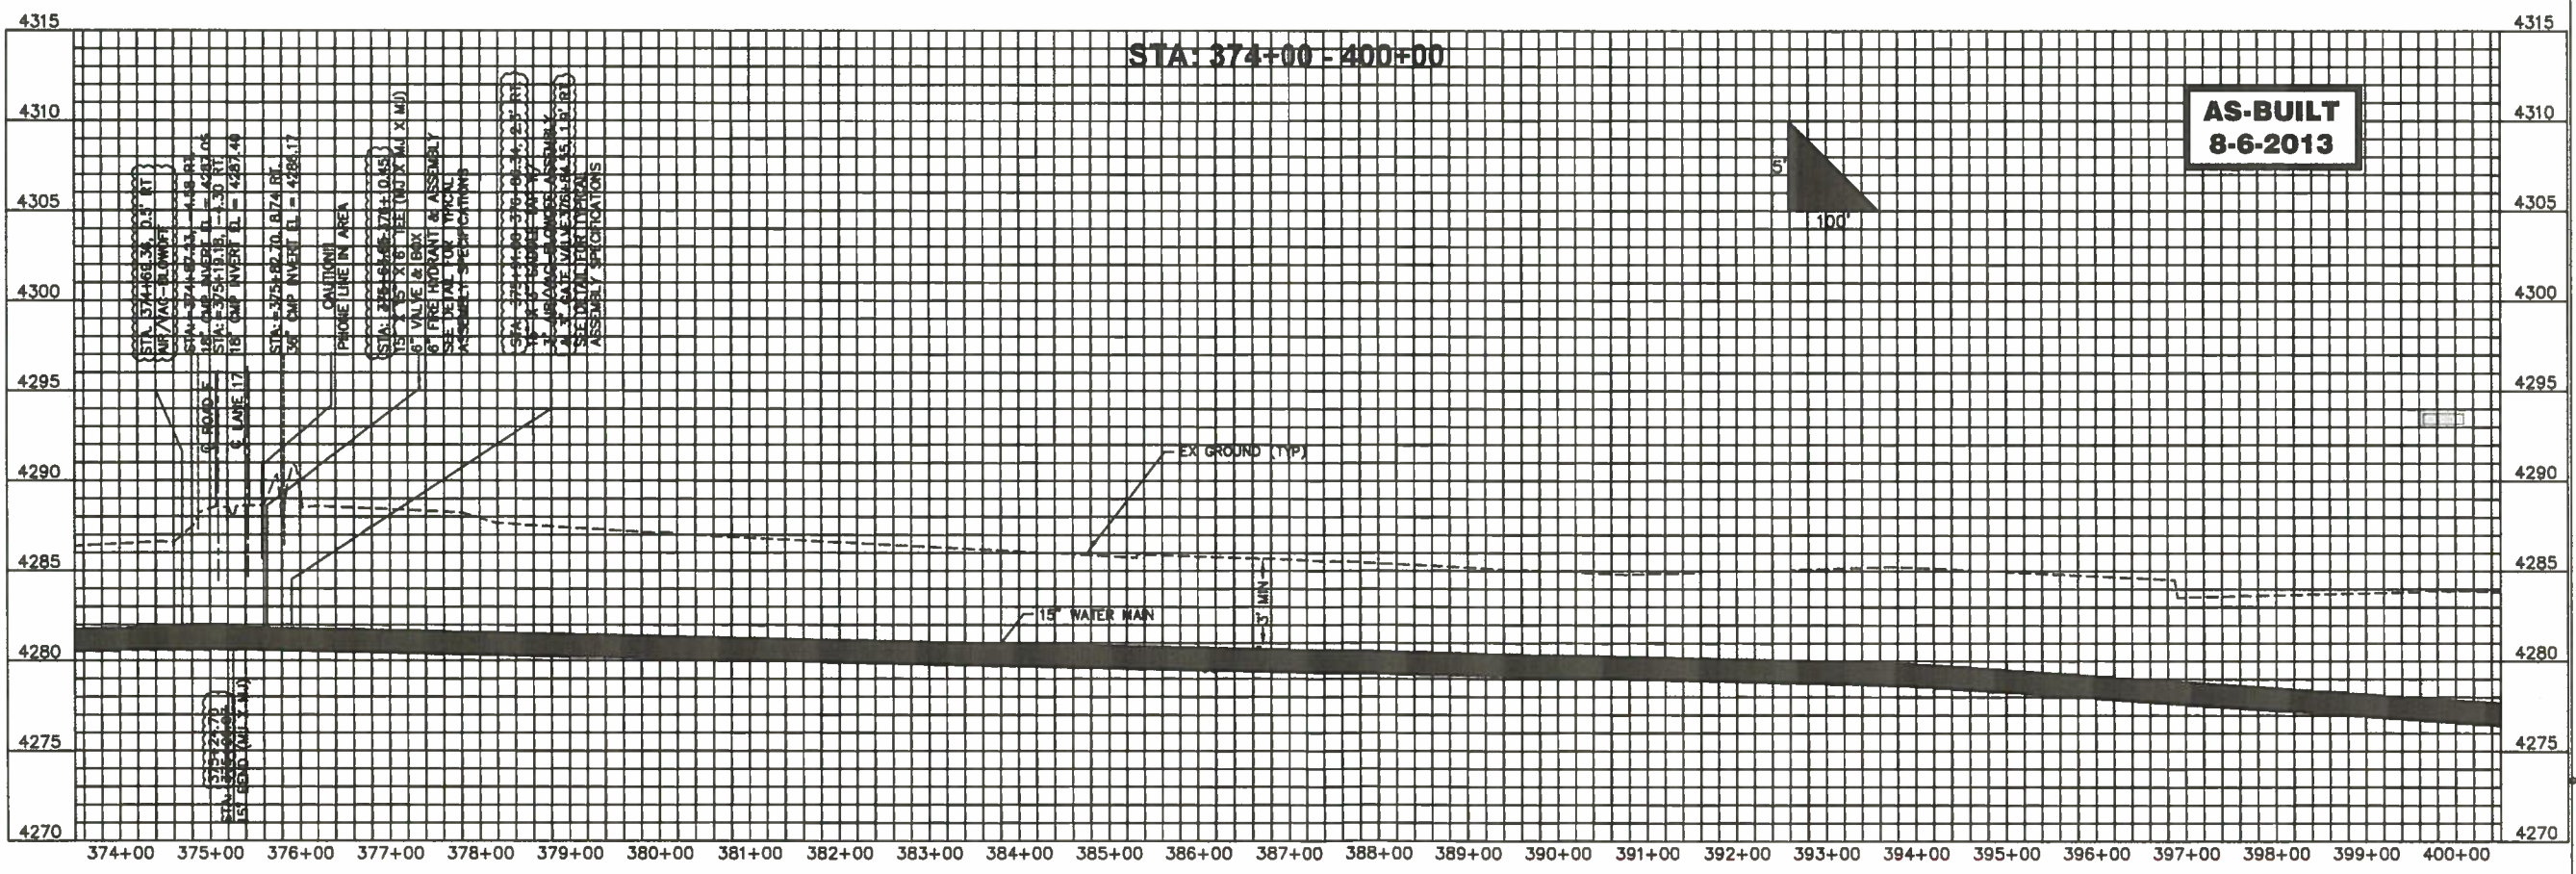

KIDD
ENGINEERING
AND
CONSTRUCTION
MANAGEMENT
SERVICES, INC



RICKY A. KIDD - PRESIDENT
44811 EAST HIGHWAY 66
AVONDALE, CO 81622
719-644-6239 (O) 719-885-1216 (F)
rickkidd@kiddengineering.com

BACKFILL IN ACCORDANCE WITH IIM
EAGLE IRRIGATION IPS PRESSURE
IRRIGATION GUIDE, PAYING PARTICULAR
ATTENTION TO BEDDING, HAUNCHING,
AND INITIAL BACKFILL REQUIREMENTS

PROJECT TITLE
**ORDWAY FEEDLOT
WATERLINE**

SHEET TITLE
**ORDWAY FEEDLOT
WATERLINE
STA 374+00 THRU 400+00**

Job Number: R0313-04	
Civil Eng. by: [Signature]	Drawn by: [Signature]
Designed by: [Signature]	Checked by: [Signature]
Plot Date: 8/28/2013	Sheet Number: 15

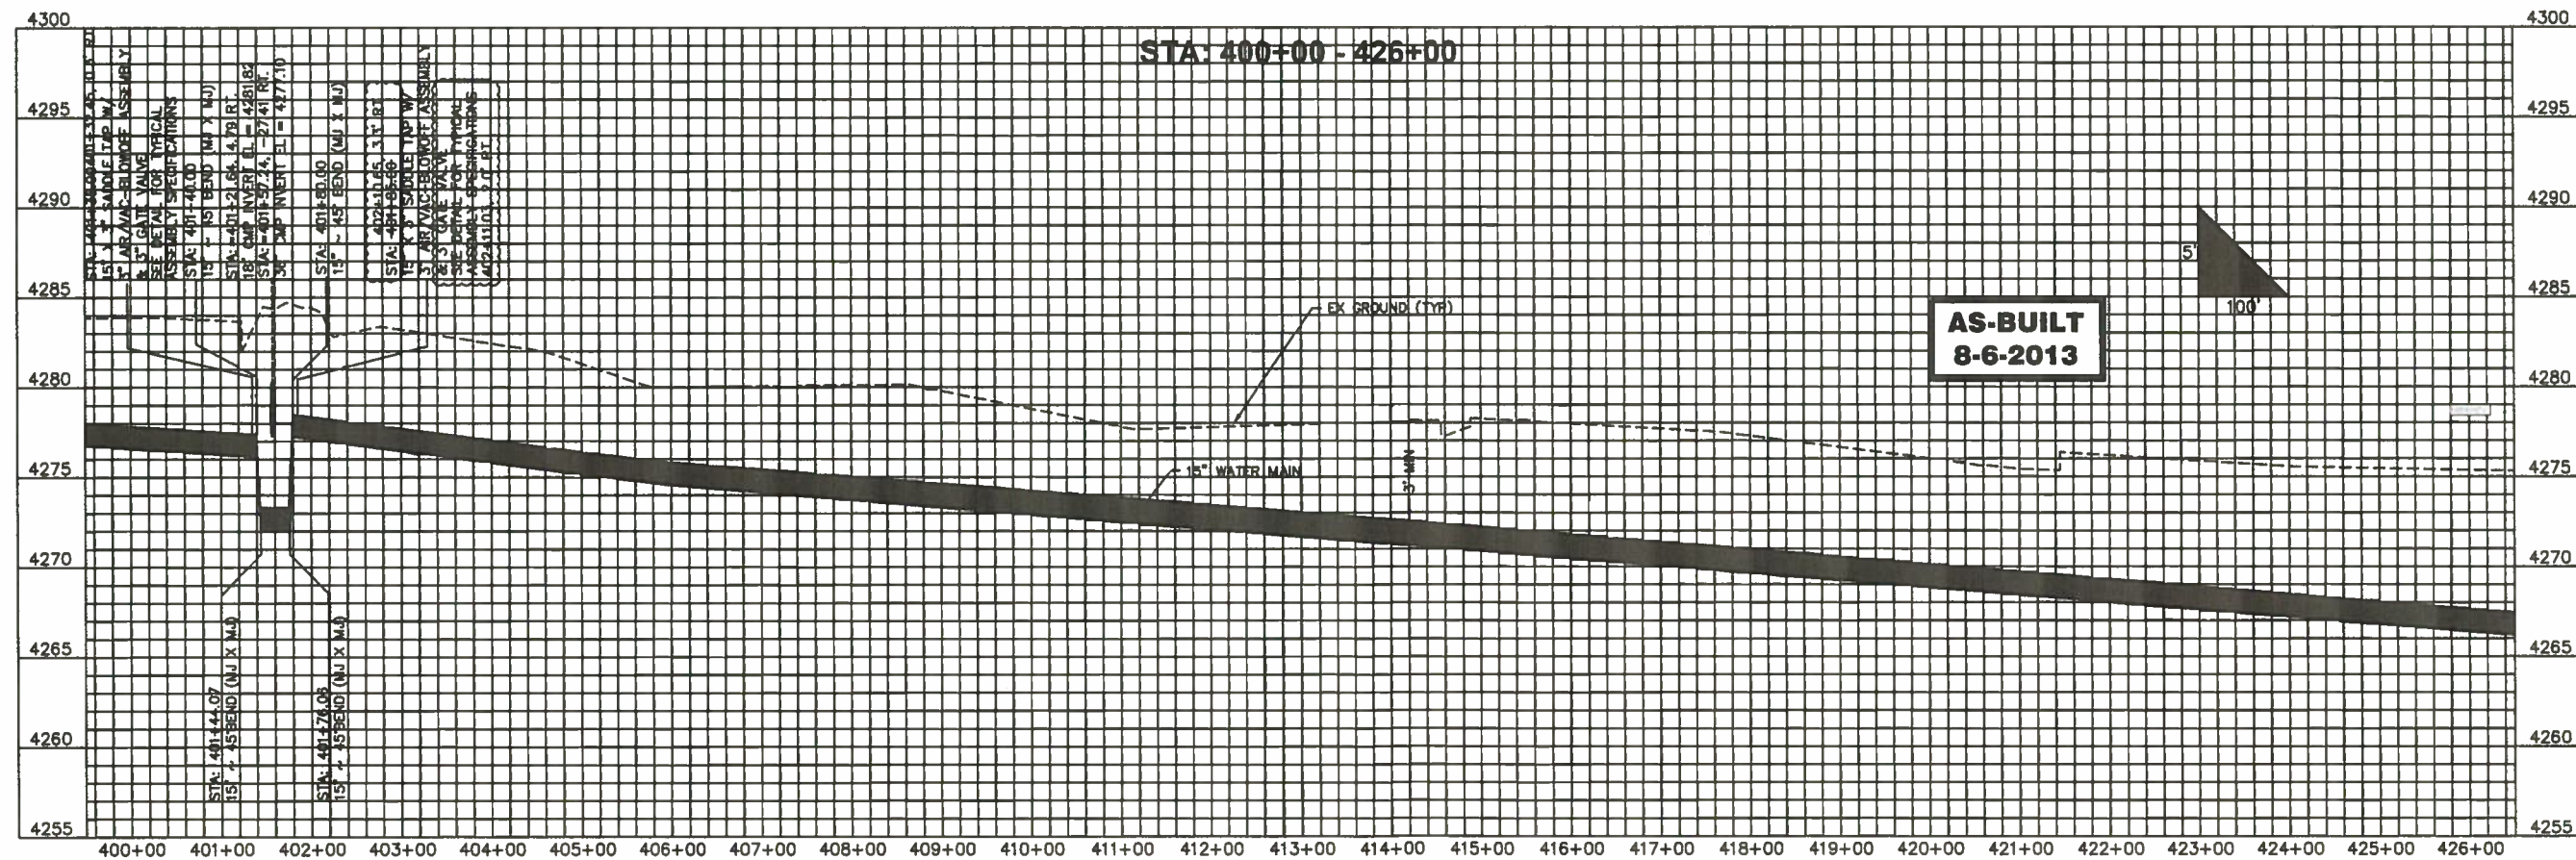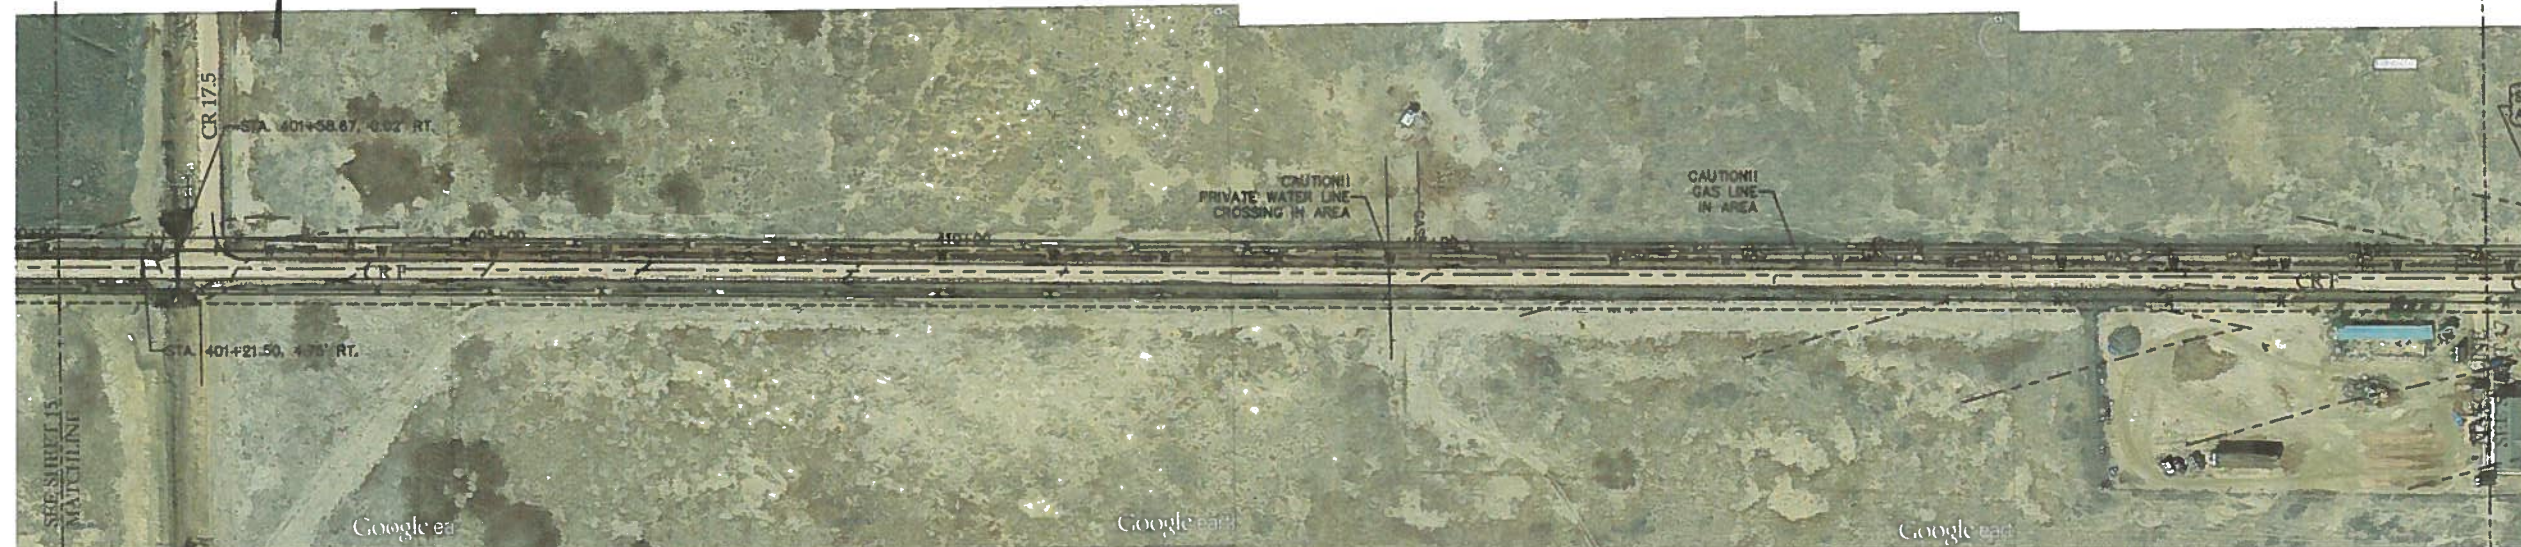

RICKY A. KIDD - PRESIDENT
44811 EAST HIGHWAY 60
AVONDALE, CO 81022
719-844-8238 (D) 719-883-1216 (F)
rickkidd@kiddengineering.com

BACKFILL IN ACCORDANCE WITH JIM EAGLE IRRIGATION IPS PRESSURE IRRIGATION GUIDE, PAYING PARTICULAR ATTENTION TO BEDDING, HAUNCHING, AND INITIAL BACKFILL REQUIREMENTS



PROJECT TITLE

ORDWAY FEEDLOT WATERLINE

3 JUL 1986

**ORDWAY FEEDLOT
WATERLINE
STA 400+00 THRU 426+00**

Job Number: RCE13-04	
Cadd Drawn By: CONDOOR - AS-BLR	Drawn By: SWG JNT
Designed By: RK	Checked By: RK
Plot Scale: AS SHOWN	Date: 4/18/13
Sheet Number 16	

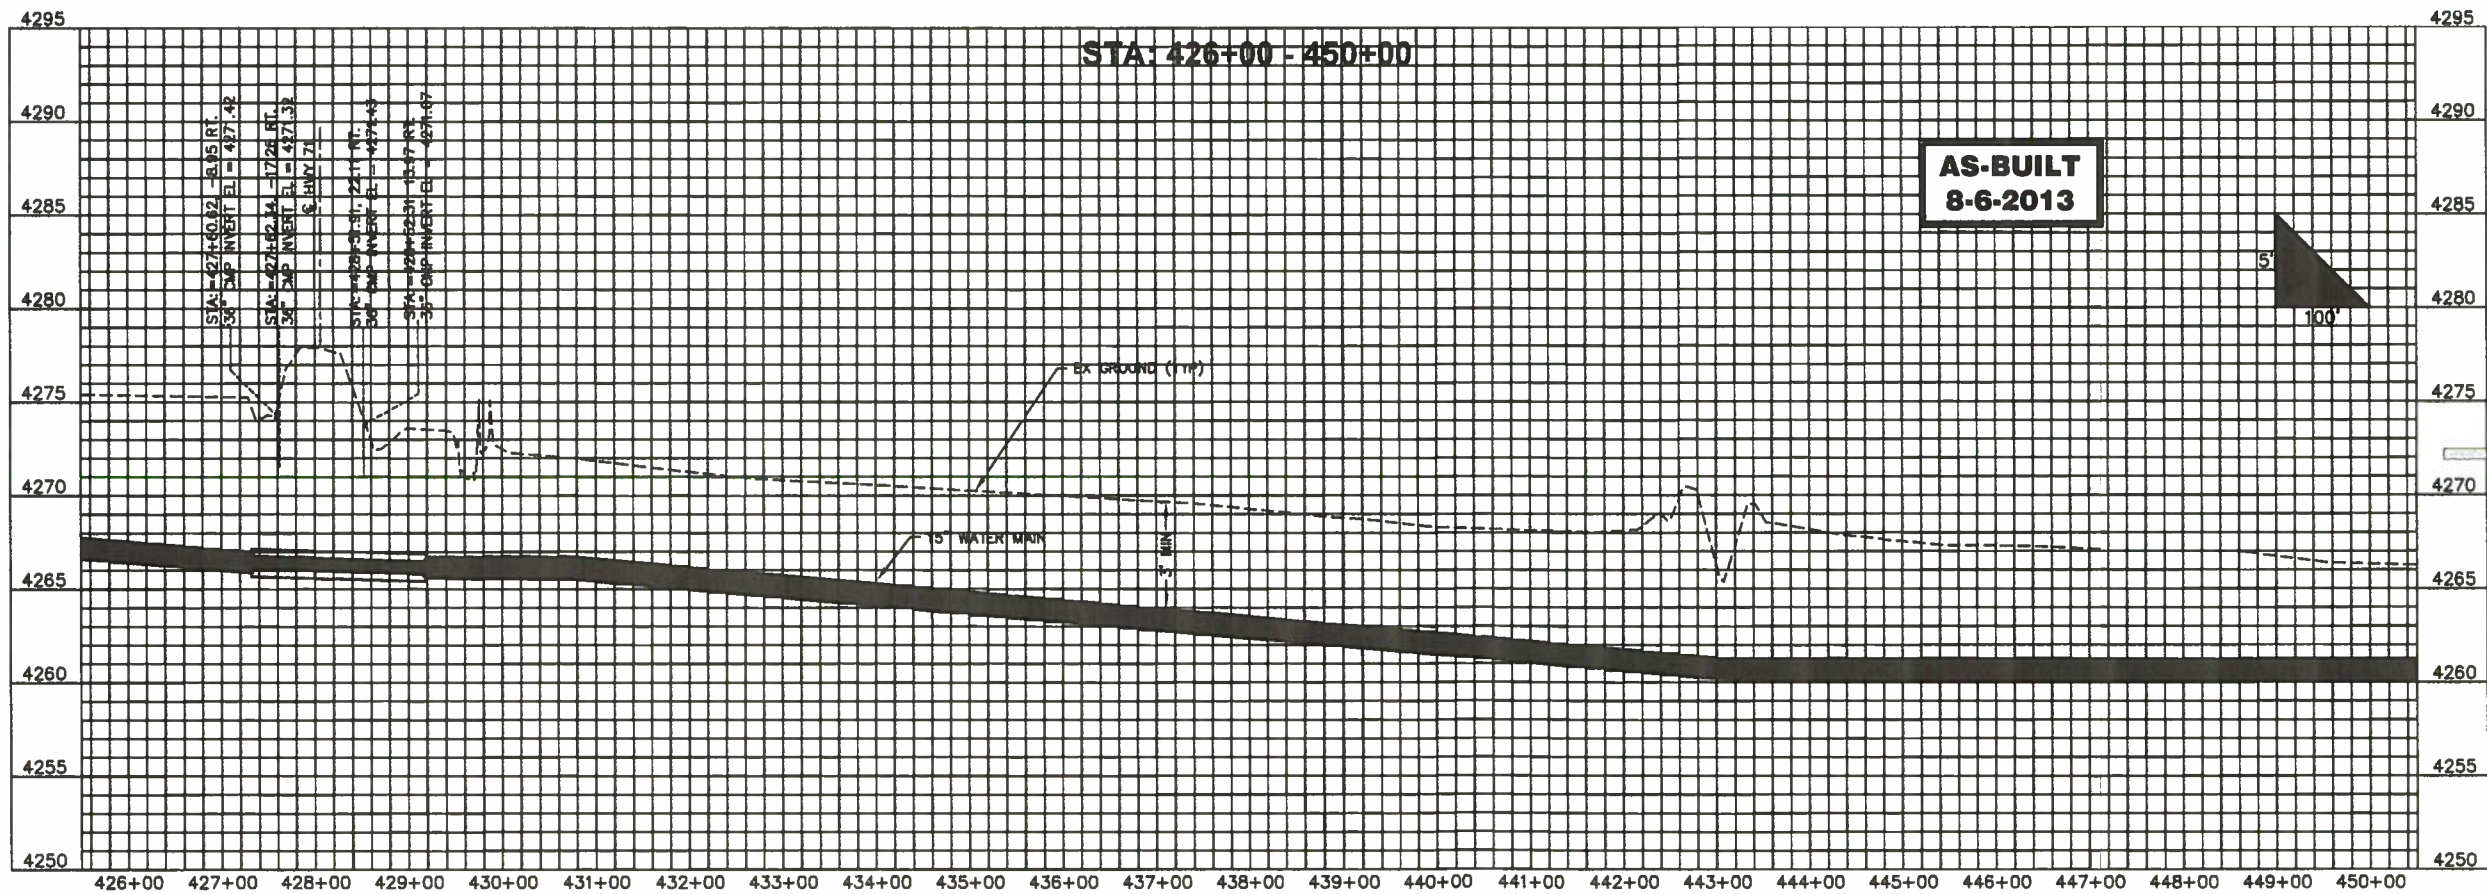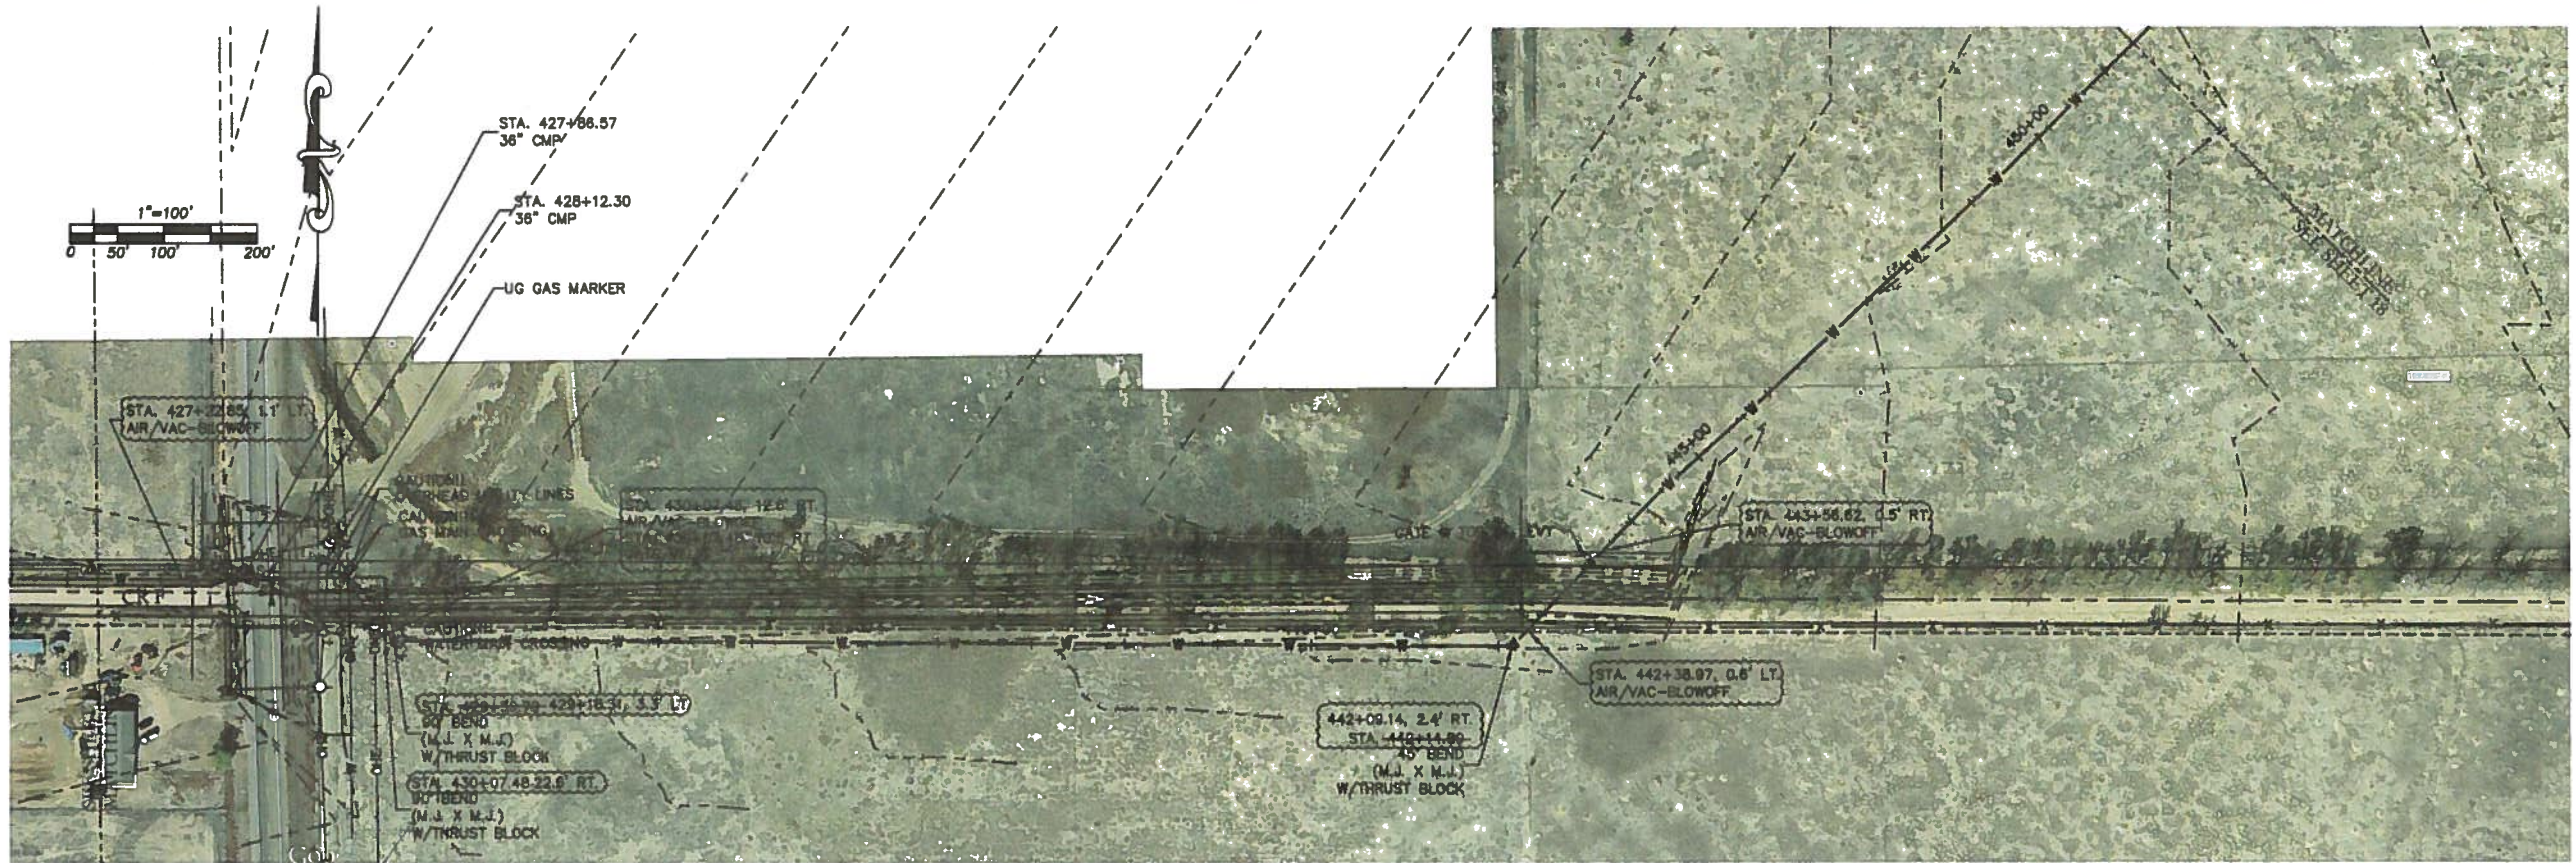

KIDD
ENGINEERING
AND
CONSTRUCTION
MANAGEMENT
SERVICES, INC.



RICKY A. KIDD - PRESIDENT
44811 EAST HIGHWAY 80
AVONDALE, CO 81622
719-666-8239 (O) 719-665-1316 (F)
rickkidd@kiddengineering.com

BACKFILL IN ACCORDANCE WITH JM
EAGLE IRRIGATION IPS PRESSURE
IRRIGATION GUIDE, PAYING PARTICULAR
ATTENTION TO BEDDING, HAUNCHING,
AND INITIAL BACKFILL REQUIREMENTS

PROJECT TITLE
**ORDWAY FEEDLOT
WATERLINE**

SHEET TITLE
**ORDWAY FEEDLOT
WATERLINE
STA 426+00 THRU 450+00**

Job Number: R0013-04	
Client: Dwg. #	Drawn By:
CONCOR - AS-BUILT/REV. JKT	
Designed By:	Checked By:
RL	RL
Plot Scale:	Date:
AS SHOWN	4/18/13
Sheet Number	
17	

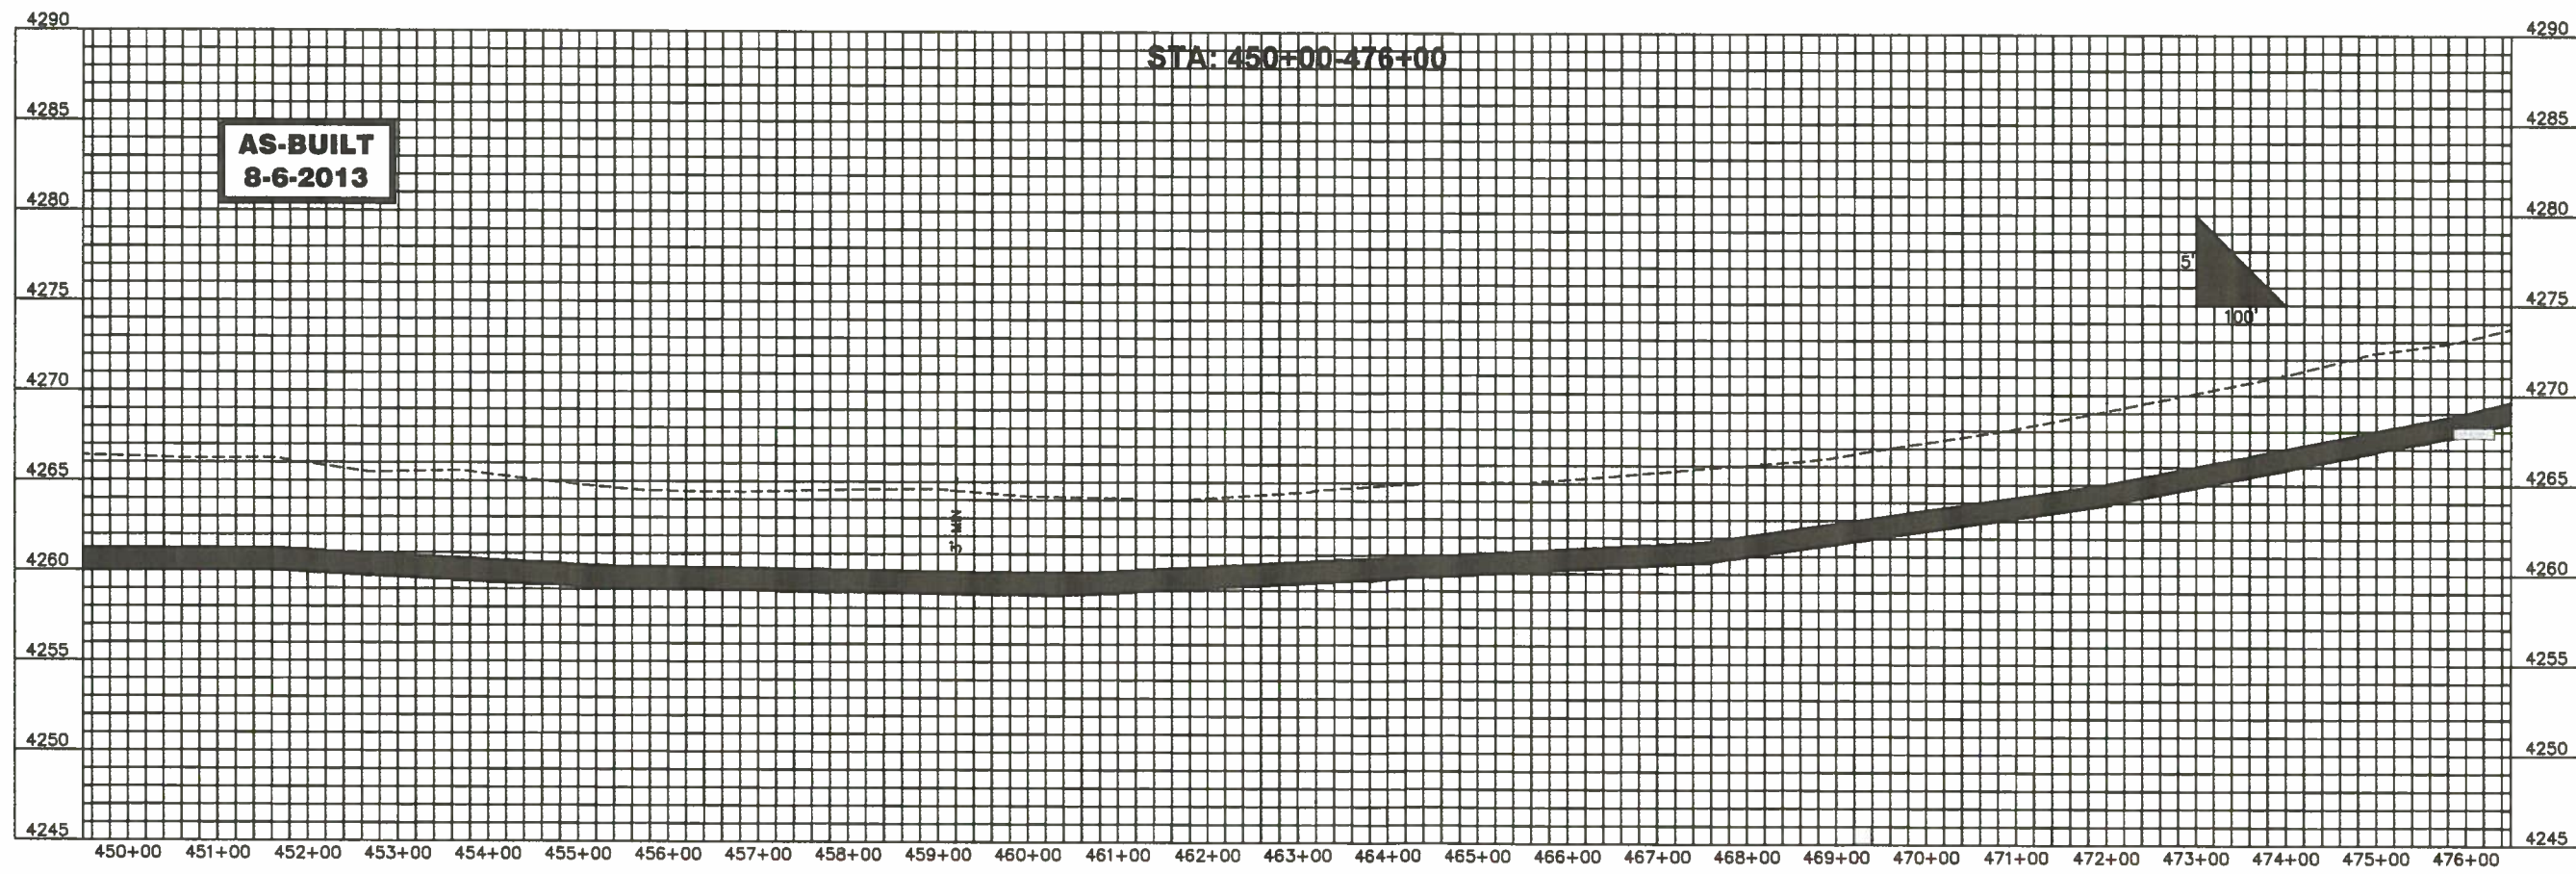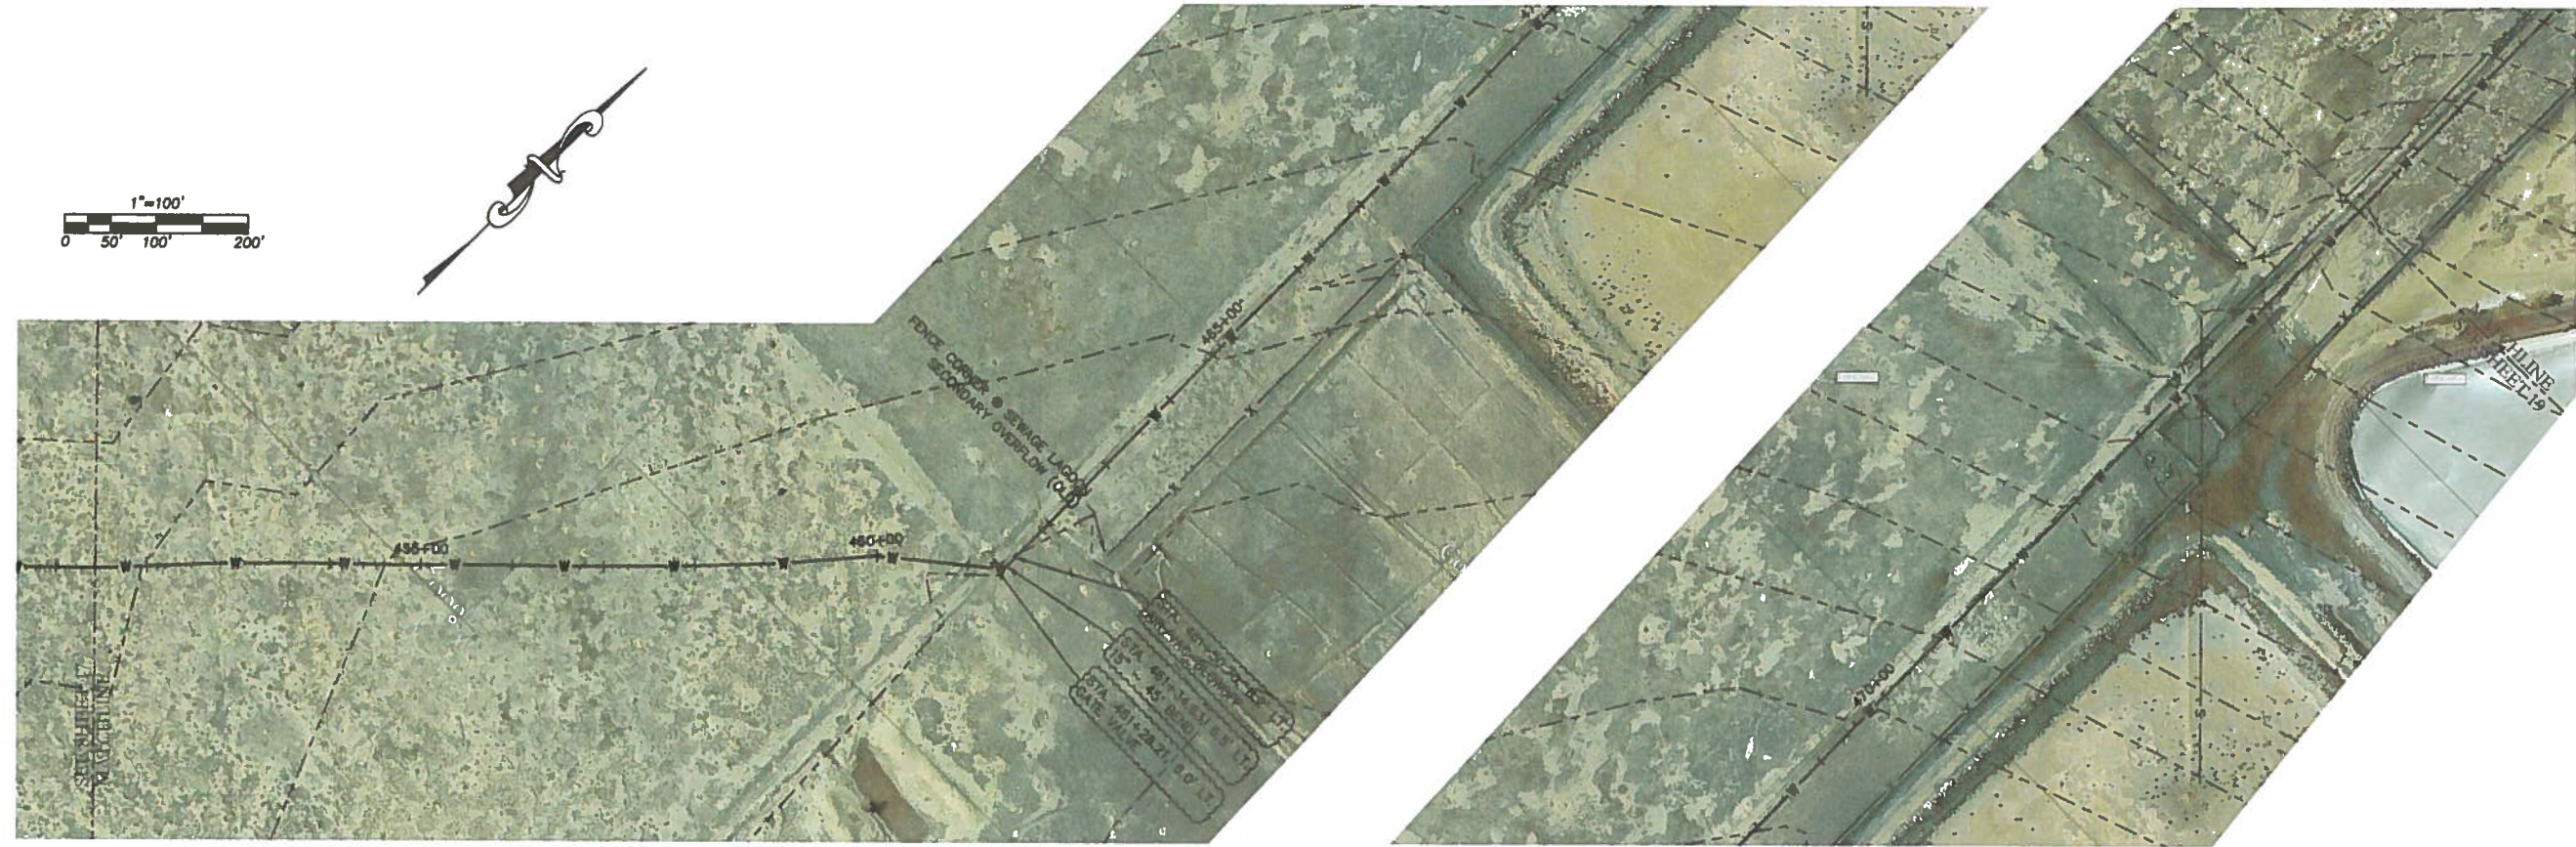

KIDD
ENGINEERING
AND
CONSTRUCTION
MANAGEMENT
SERVICES, INC.



RICKY A. KIDD - PRESIDENT
44811 EAST HIGHWAY 89
AYONDALE, CO 81622
719-644-8239 (O) 719-885-1218 (F)
rickkidd@kiddengineering.com

BACKFILL IN ACCORDANCE WITH JIM
EAGLE IRRIGATION IPS PRESSURE
IRRIGATION GUIDE, PAYING PARTICULAR
ATTENTION TO BEDDING, HAUNCHING,
AND INITIAL BACKFILL REQUIREMENTS

PROJECT TITLE
**ORDWAY FEEDLOT
WATERLINE**

SHEET TITLE
**ORDWAY FEEDLOT
WATERLINE
STA 450+00 THRU 476+00**

Job Number: R0313-04	
Client: Dwyer & Co.	Drawn By: JNT
Designed By: JNT	Checked By: JNT
Plot Date: 4/18/13	Date: 4/18/13
Sheet Number: 18	

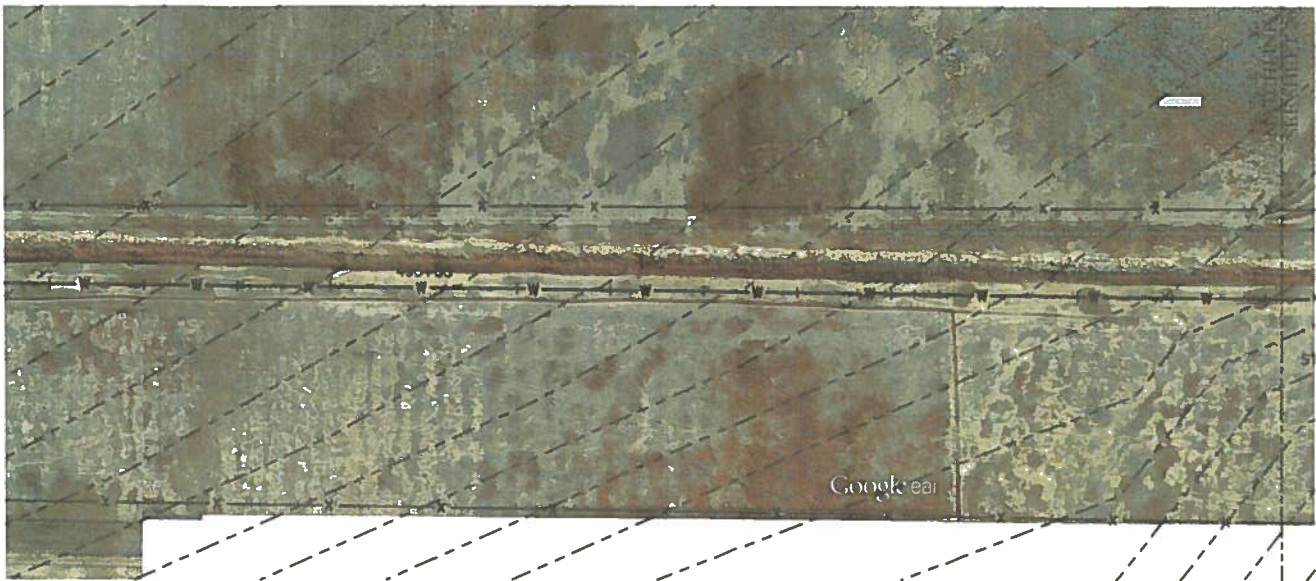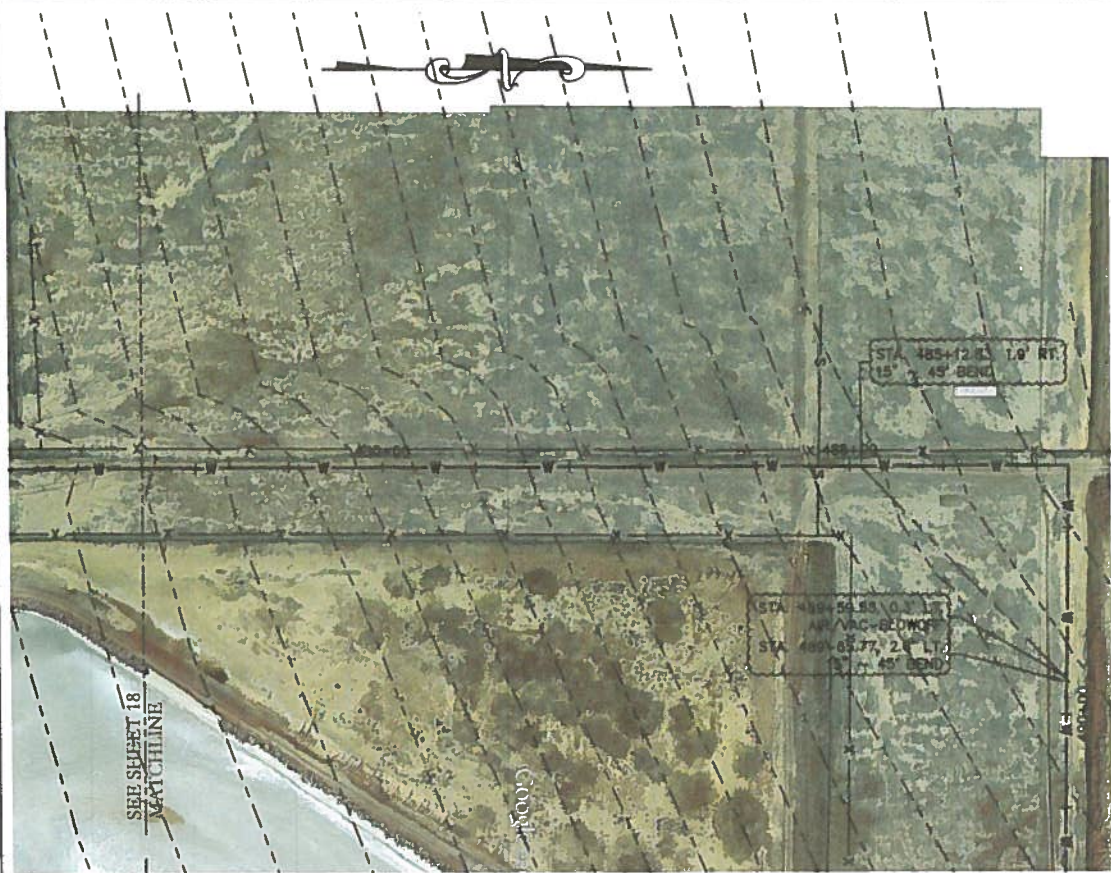

KIDD
ENGINEERING
AND
CONSTRUCTION
MANAGEMENT
SERVICES, INC

RICKY A. KIDD - PRESIDENT
44811 EAST HIGHWAY 80
AVONDALE, CO 81622
719-644-8238 (O) 719-685-1218 (F)
rickkidd@kiddengineering.com

BACKFILL IN ACCORDANCE WITH IRI
EAGLE IRRIGATION IPI'S PRESSURE
IRRIGATION GUIDE, PAYING PARTICULAR
ATTENTION TO BEDDING, HAUNCHING,
AND INITIAL BACKFILL REQUIREMENTS


ORDWAY FEEDLOT
WATERLINE




PROJECT TITLE

ORDWAY FEEDLOT
WATERLINE
STA 476+00 THRU 502+00

SHEET TITLE

Job Number: R0213-04	
Client: Dog #	Drawn By: JHT
Design: AS-BUILT	Checked By: JHT
Plot Scale: AS SHOWN	Date: 4/18/13
Sheet Number:	19

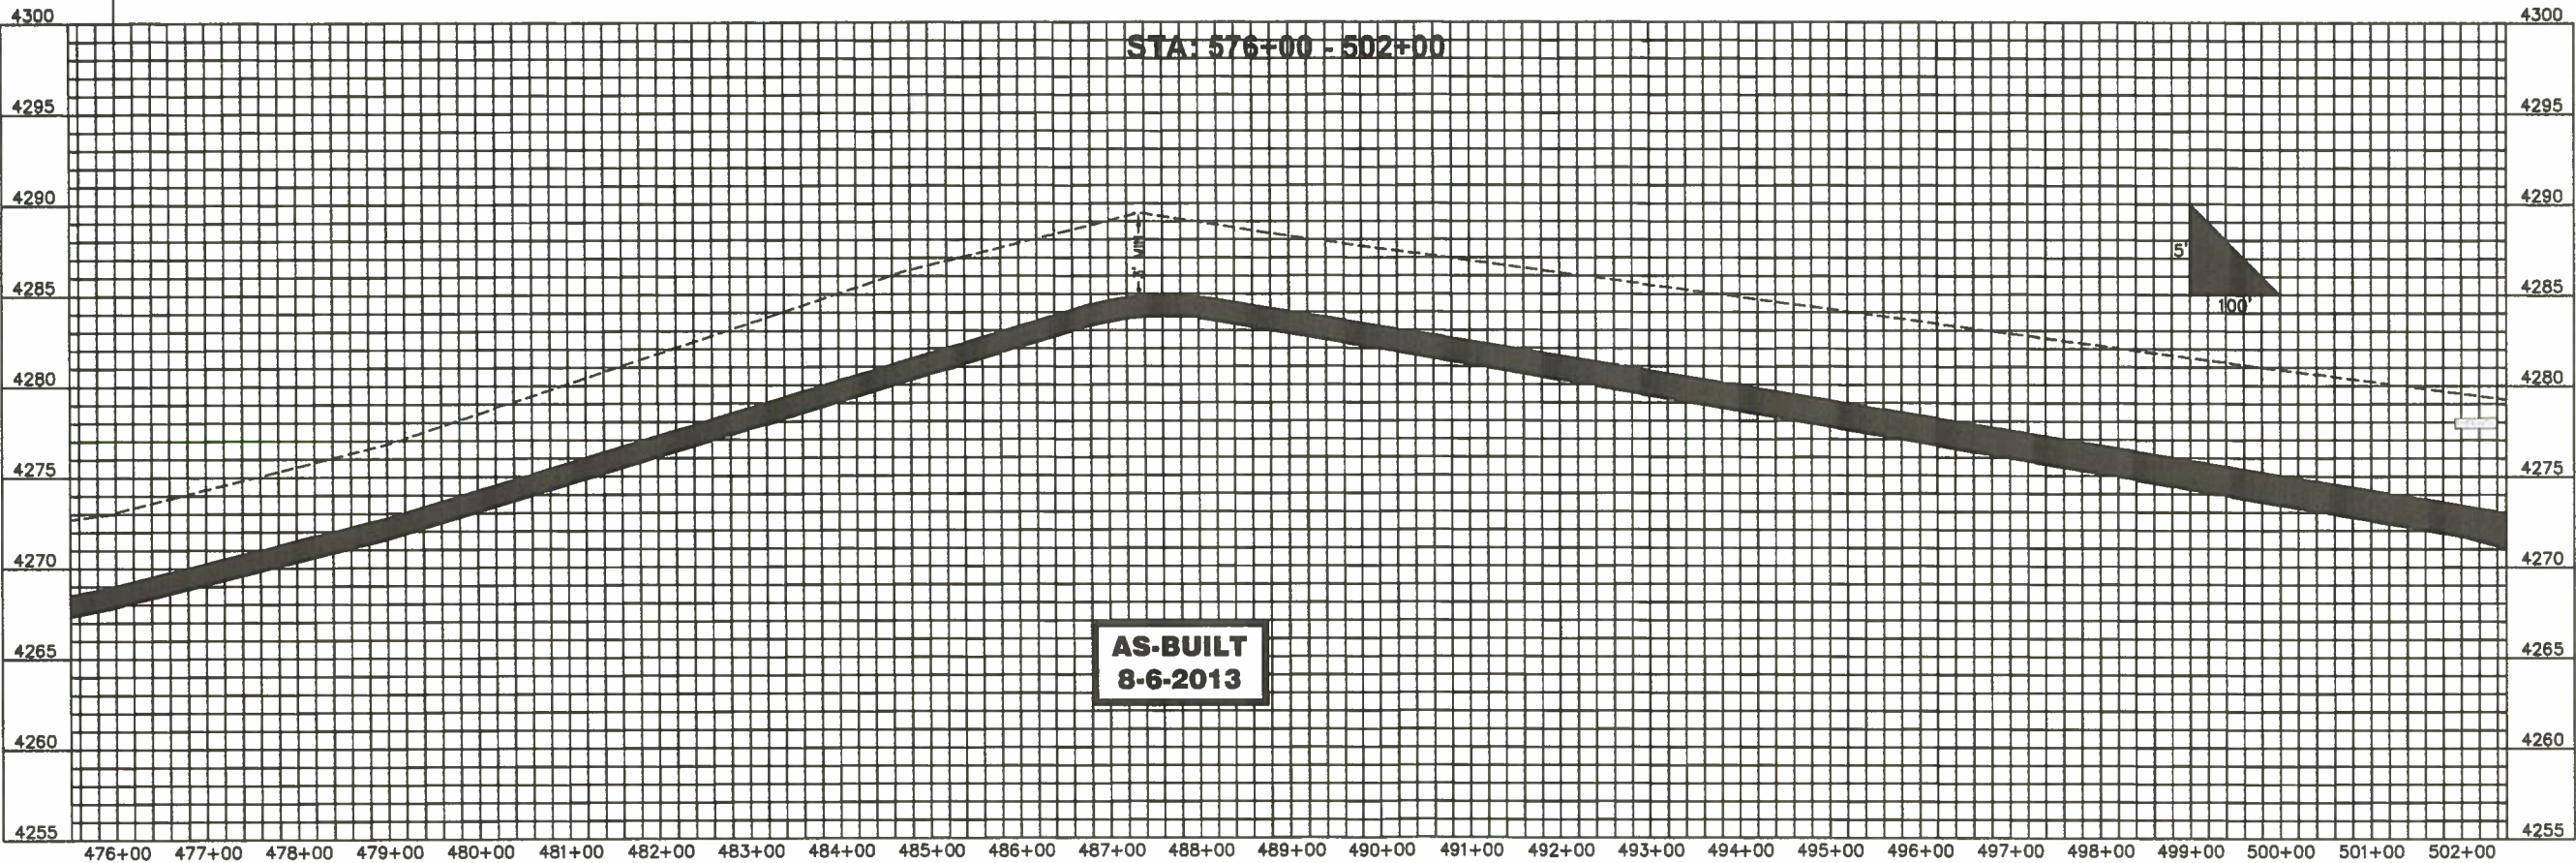

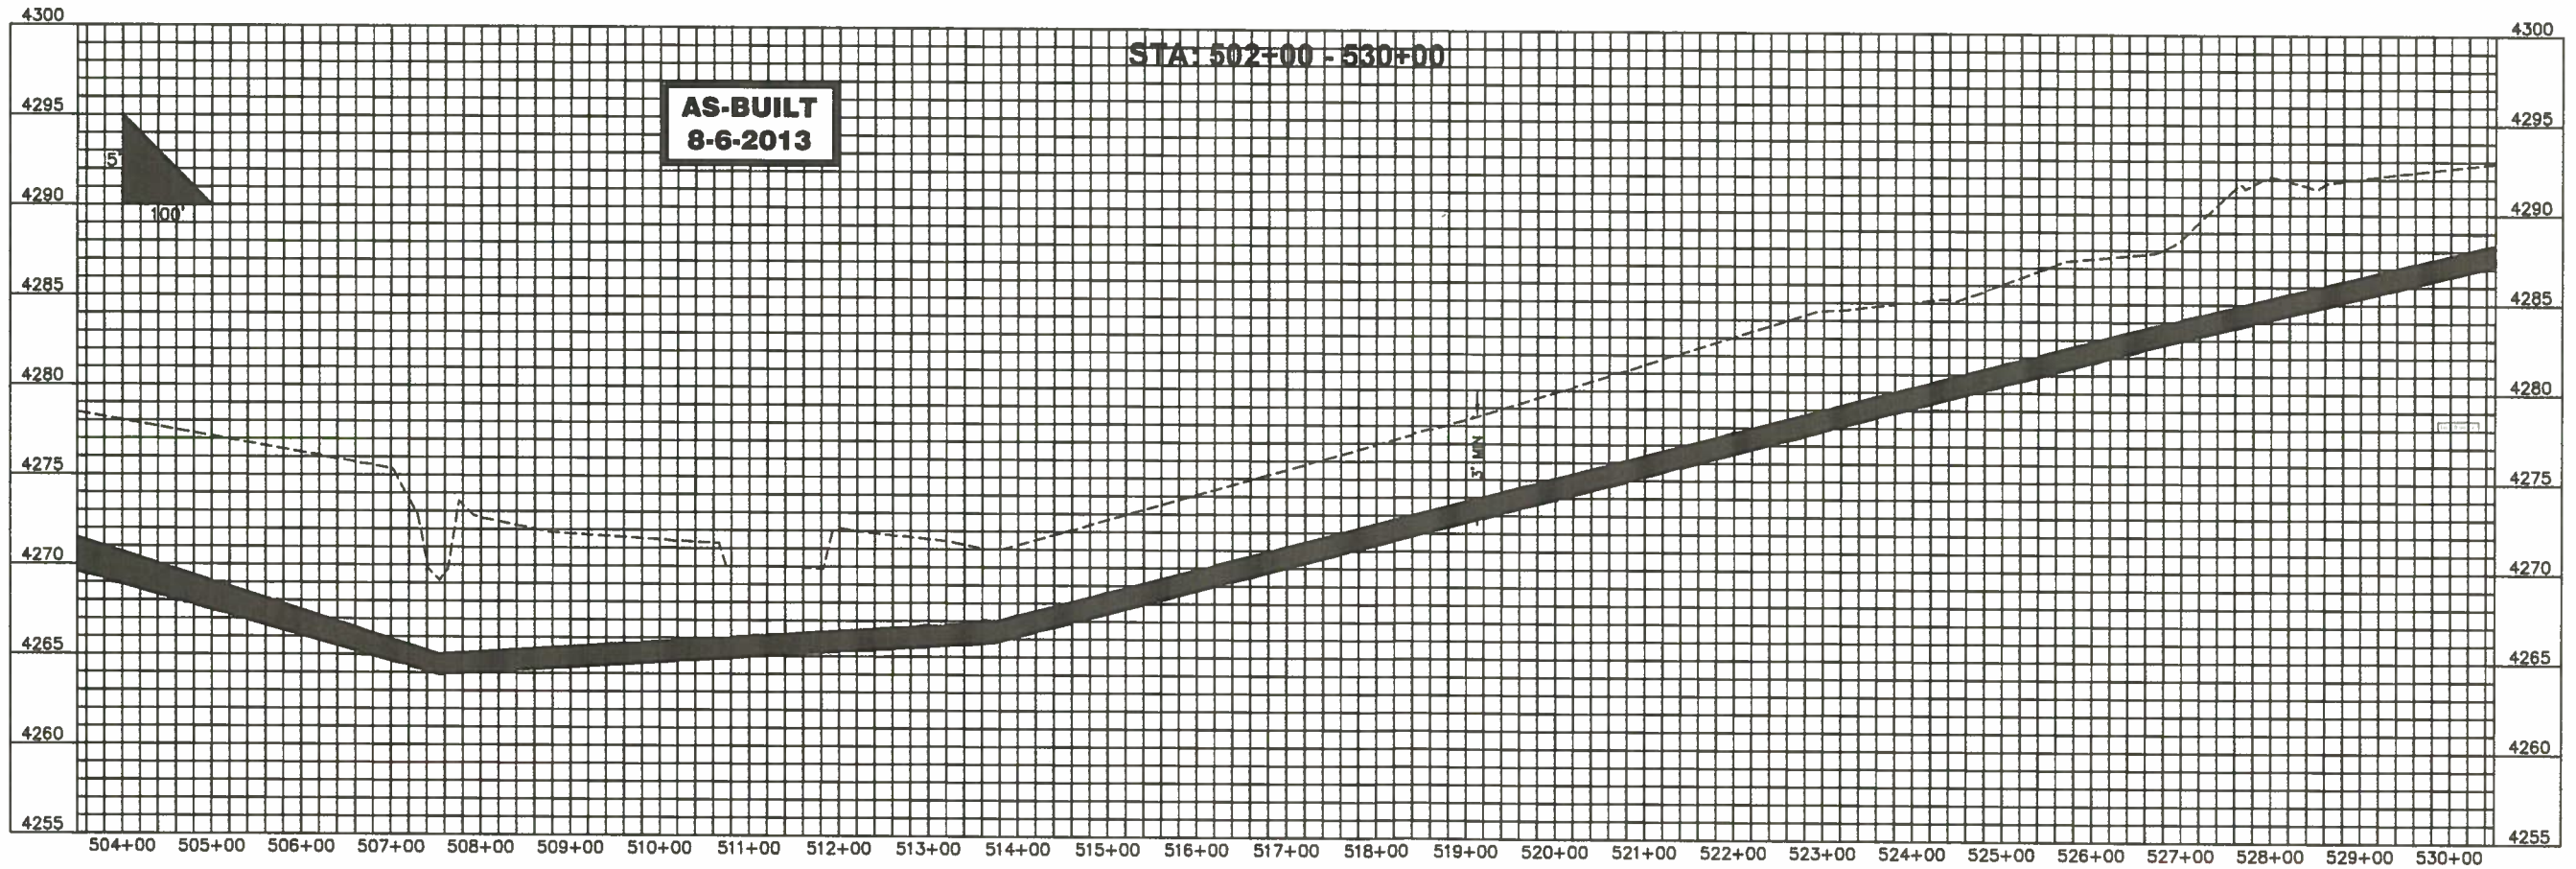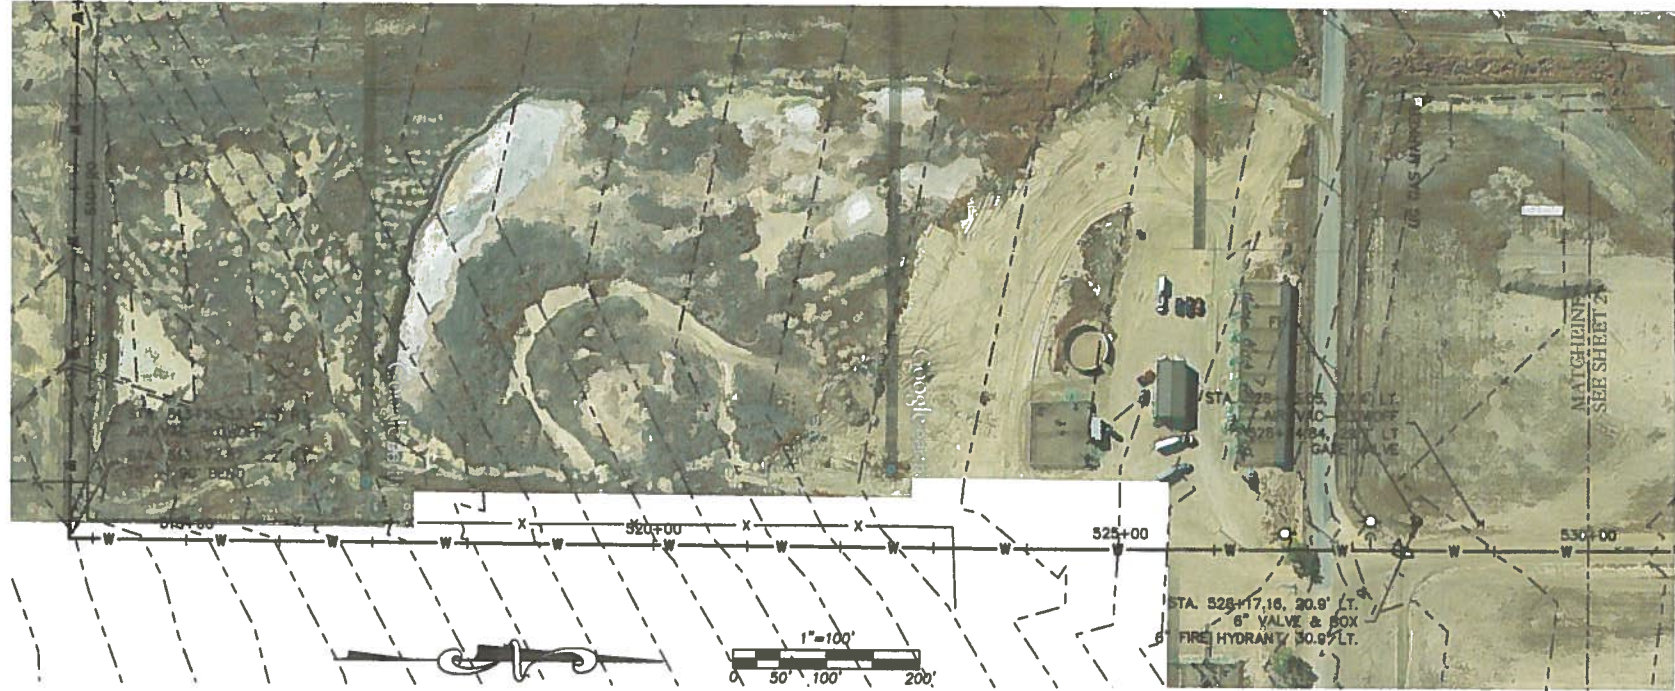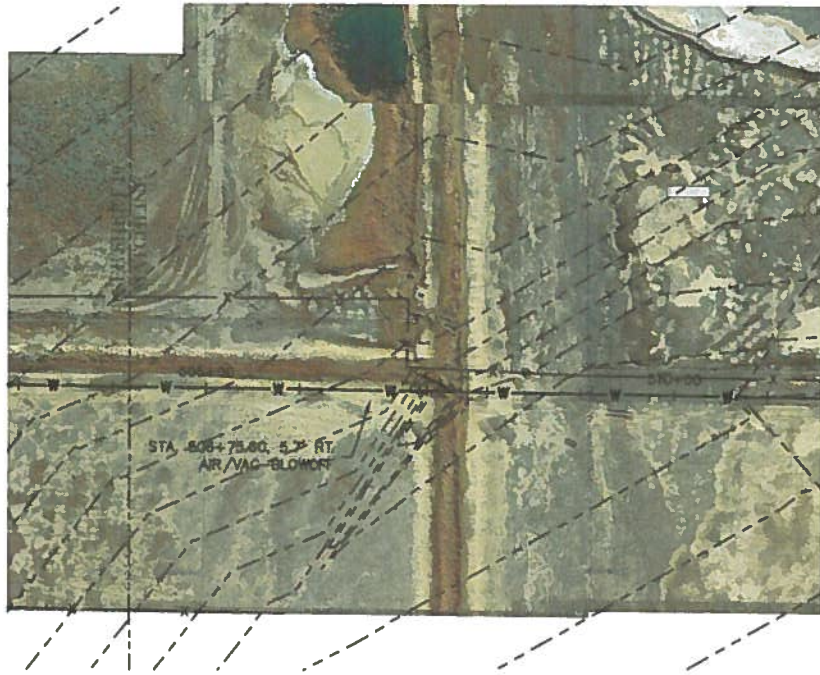

KIDD
ENGINEERING
AND
CONSTRUCTION
MANAGEMENT
SERVICES, INC

RICKY A. KIDD - PRESIDENT
44011 EAST HIGHWAY 68
AVONDALE, CO 81622
719-644-8239 (O) 719-683-1216 (F)
rickkidd@kiddengineering.com


BACKFILL IN ACCORDANCE WITH IRI
EAGLE IRRIGATION IPS PRESSURE
IRRIGATION GUIDE, PAYING PARTICULAR
ATTENTION TO BEDDING, HAUNCHING,
AND INITIAL BACKFILL REQUIREMENTS

PROJECT TITLE
**ORDWAY FEEDLOT
WATERLINE**

SHEET TITLE
**ORDWAY FEEDLOT
WATERLINE
STA 502+00 THRU 530+50**

Job Number: RCB13-04	Drawn By: JNT
Check Drawn By: JNT	Checked By: JNT
Designated By: JNT	Date: 4/18/13
Plot Scale: AS SHOWN	Sheet Number: 20

C:\Users\jacob\Documents\PROJECTS\ORDWAY FEEDLOT WATERLINE\ORDWAY FEEDLOT WATERLINE.dwg 30 PROJECTS\ORDWAY FEEDLOT WATERLINE\ORDWAY FEEDLOT WATERLINE.dwg - 10-2-2013

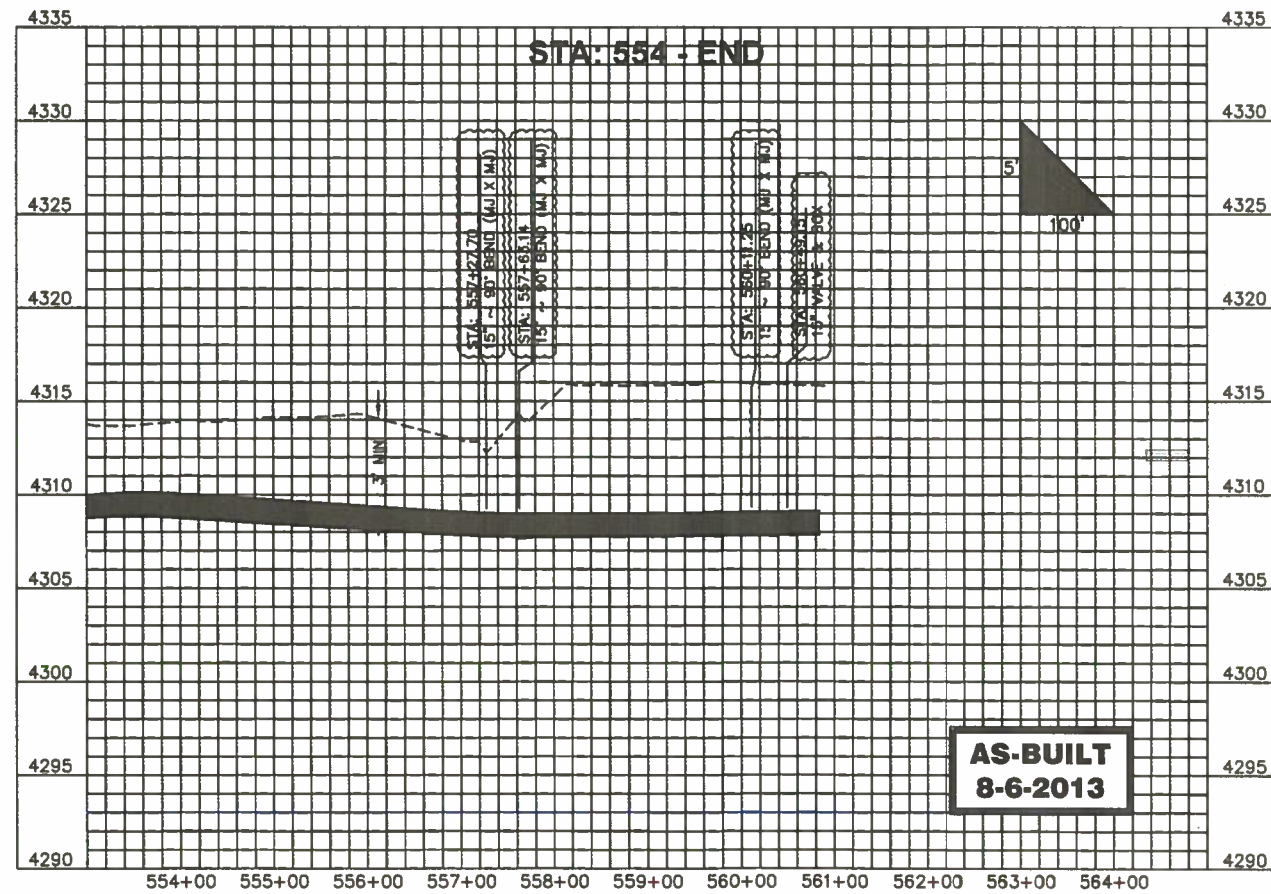

KIDD
ENGINEERING
AND
CONSTRUCTION
MANAGEMENT
SERVICES, INC

RICHY A. KIDD - PRESIDENT
44811 EAST HIGHWAY 60
AYONDALE, CO 81622
719-644-8238 (O) 719-683-1218 (F)
rickkidd@kiddengineering.com

BACKFILL IN ACCORDANCE WITH JM
EAGLE IRRIGATION IPS PRESSURE
IRRIGATION GUIDE; PAYING PARTICULAR
ATTENTION TO BEDDING, HAUNCHING,
AND INITIAL BACKFILL REQUIREMENTS

PROJECT TITLE

ORDWAY FEEDLOT
WATERLINE

SHEET TITLE

ORDWAY FEEDLOT
WATERLINE
STA 528+00 THRU 554+00

Job Number: R0213-04
Client: Ordway Feedlot
Drawn By: JKT
Designed By: JKT
Plot Scale: AS SHOWN
Date: 4/18/13
Sheet Number: 22