
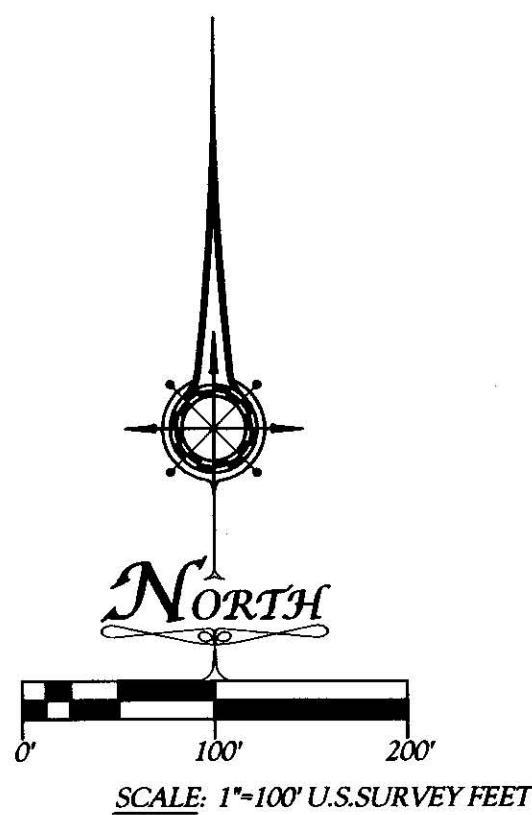


As Built
for a portion of the underground pipe North Delta Canal
Section 3, Township 15 South, Range 95 West, of the 6th Principal Meridian
Delta County, Colorado

VICINITY and CONTROL MAP

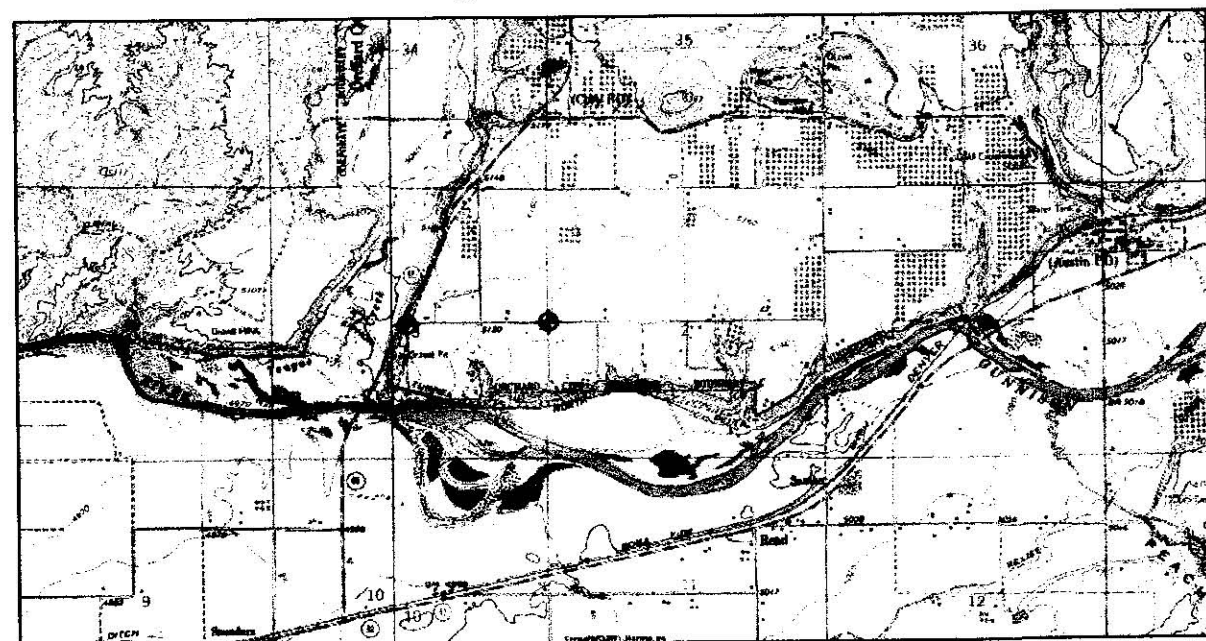


LINE	BEARING	DISTANCE
L1	S 45°56'01" E	22.00
L2	S 63°56'01" E	6.00
L3	S 89°56'01" E	6.00
L4	N 10°01'59" E	4.65
L5	S 66°52'28" W	3.20
L6	N 66°52'28" E	3.50
L7	N 43°54'46" E	22.00
L8	S 41°54'46" W	7.00
L9	N 10°21'48" E	11.50
L10	N 03°25'48" E	97.00
L11	N 23°25'48" E	49.50
L12	N 69°25'48" E	45.50
L13	N 77°25'48" E	49.00
L14	S 89°54'12" E	150.00
L15	S 89°54'12" E	177.21
L16	S 77°58'59" E	23.10
L17	S 77°03'52" E	8.76
L18	S 32°24'32" E	50.17
L19	S 32°24'32" E	50.00
L20	S 45°24'32" E	50.00
L21	S 68°24'32" E	50.00
L22	S 78°24'32" E	50.00
L23	N 84°24'32" W	50.00
L24	S 84°24'32" E	50.00
L25	N 84°24'32" W	50.00
L26	S 84°24'32" E	50.00
L27	S 84°24'32" E	50.00
L28	S 84°24'32" E	50.00
L29	N 84°24'32" W	50.00
L30	S 81°24'32" E	50.00
L31	S 81°24'32" E	50.00
L32	N 81°24'32" W	50.00
L33	S 80°24'32" E	50.00
L34	N 80°24'32" W	50.00
L35	S 80°24'32" E	50.00
L36	S 85°24'32" E	50.00
L37	S 77°24'32" E	50.00
L38	S 77°24'32" E	50.00
L39	S 81°24'32" E	50.00
L40	S 81°24'32" E	50.00
L41	N 81°24'32" W	50.00
L42	N 68°24'32" W	50.00
L43	S 70°24'32" E	50.00
L44	S 68°24'32" E	50.00
L45	S 68°24'32" E	50.00
L46	S 70°24'32" E	50.00
L47	S 62°24'32" W	46.51
L48	N 62°24'32" W	6.50
L49	S 44°24'32" E	9.90

LEGEND

- Found Private Survey Cap & Rebar - as noted
- Aliquot Lines
- Pipe
- N.T.S. Not to Scale

Note:

- Bar Graphs are not to scale
- All elevation shown are at bottom of structures and or pipe.

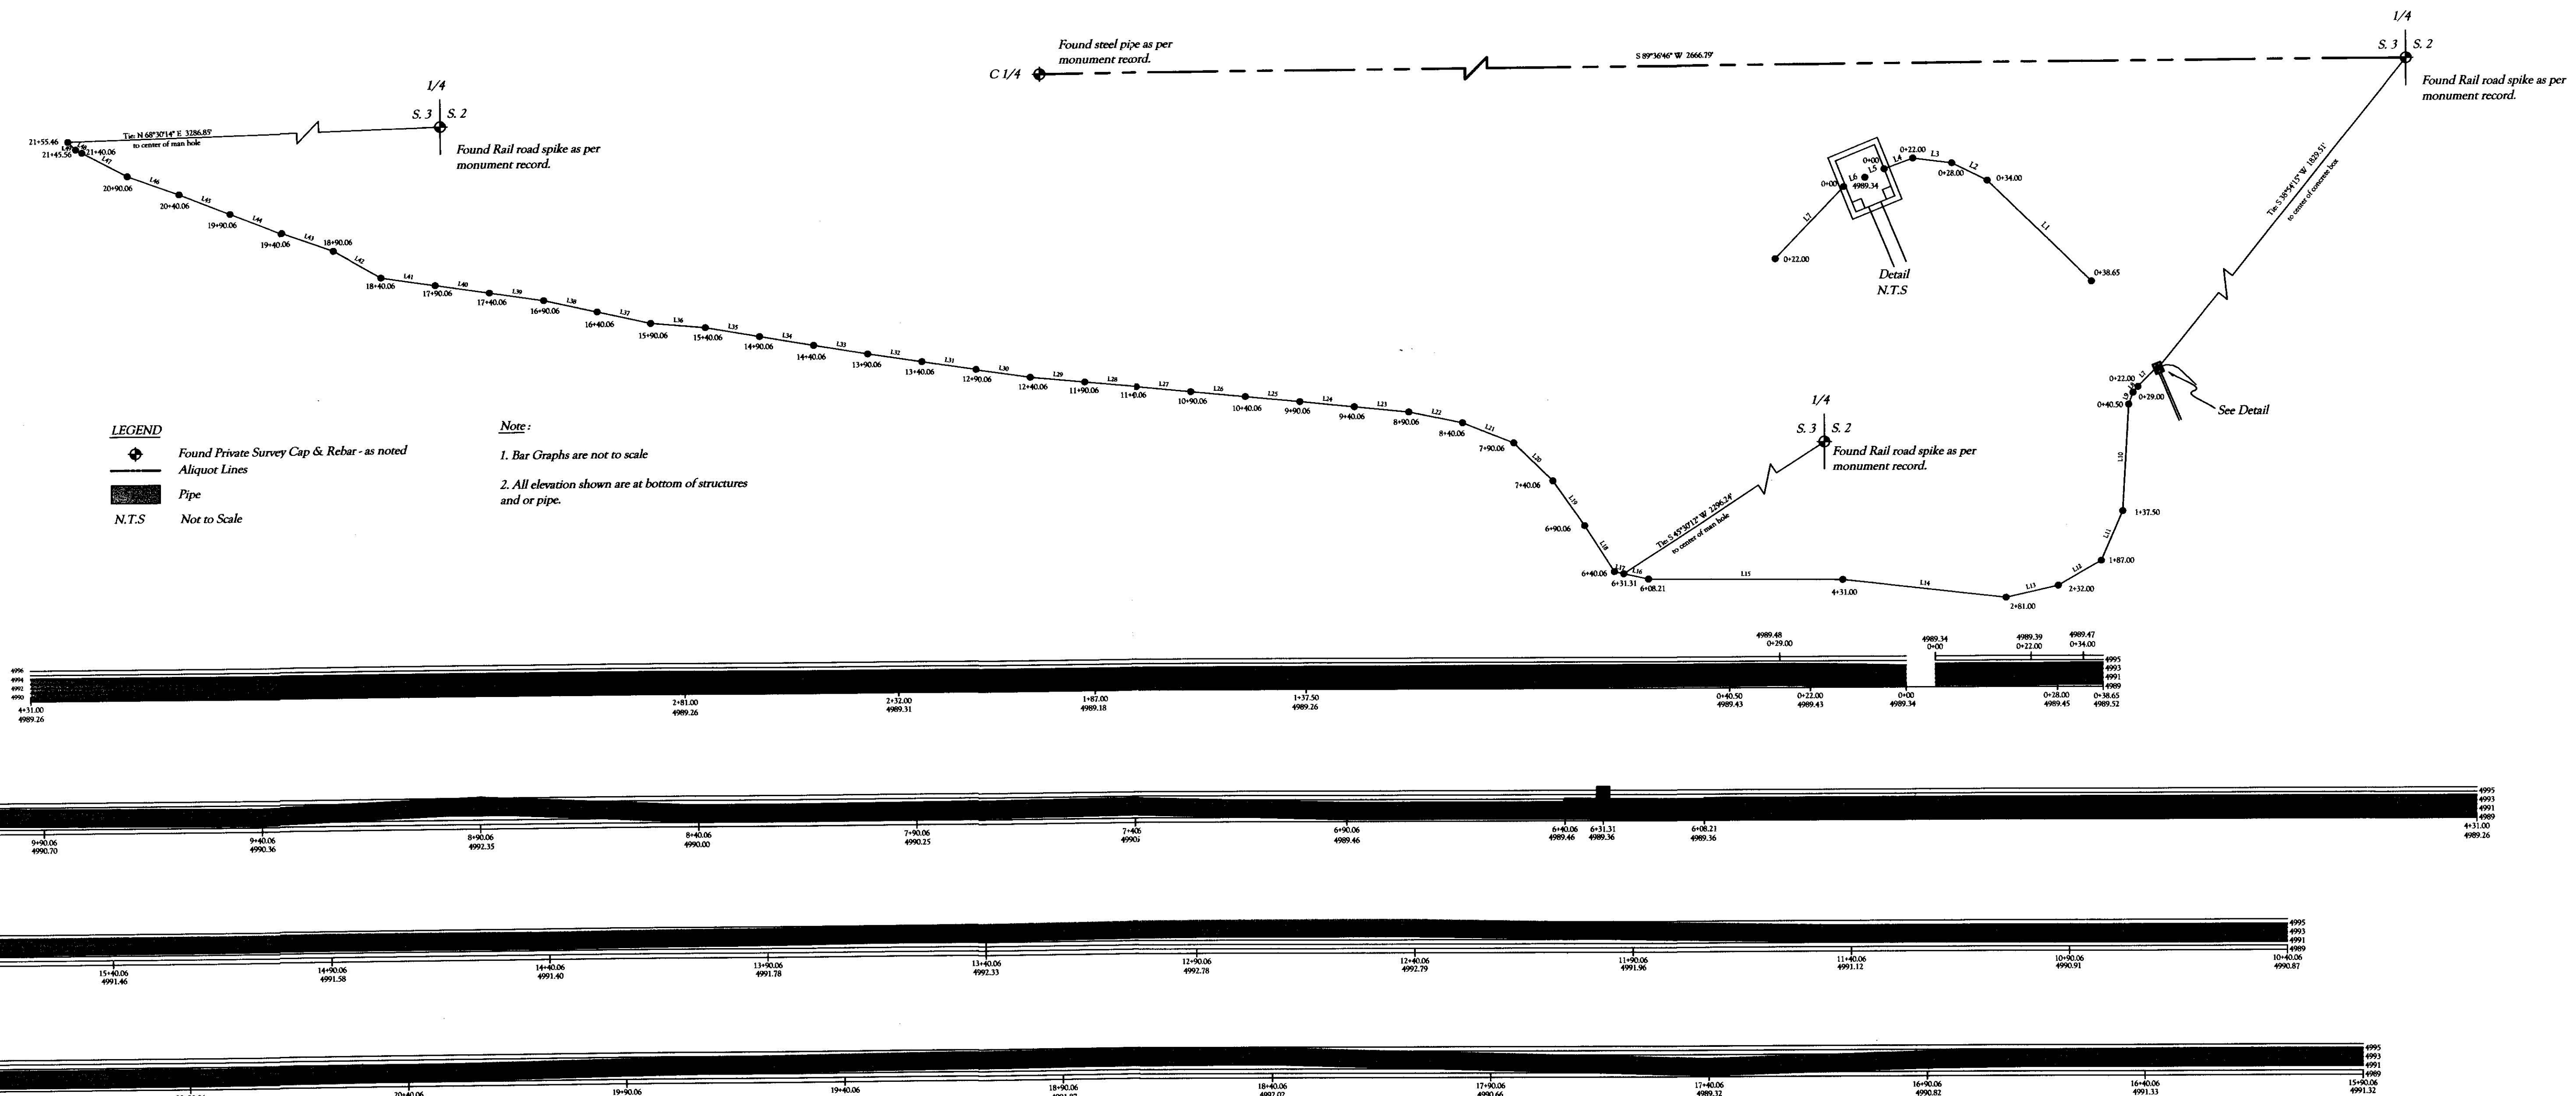

BASIS OF BEARING:
The North line of the SE 1/4 of section 3 is assumed to bear S. 89°36'46" W. and is monumented as shown hereon. All other bearings are relative thereto.

NOTICE: IN ACCORDANCE WITH C.R.S. 1-1-101, THE SURVEYOR'S LIABILITY FOR ANY DEFECT IN THIS SURVEY WITHIN THREE YEARS AFTER YOU FIRST DISCOVERED SUCH DEFECT, IN NO EVENT MAY ANY ACTION BE BASED UPON ANY DEFECT IN THIS SURVEY BE COMMENCED MORE THAN TEN YEARS FROM THE DATE OF THE CERTIFICATION SHOWN HEREON.

CERTIFICATE OF SURVEY:

I, Kenneth E. Schaaf, a Registered Land Surveyor in the State of Colorado, do hereby certify that this plat accurately represents that the surveying services addressed herein have been performed by the professional land surveyor or under the professional land surveyor in charge.

Signature
PLS No. 38114

Date
4/25/14

U.S. MINERAL SURVEYORS
REGISTERED LAND SURVEYORS
IN COLORADO

SOUTHWEST LAND SURVEYING LLC

1315 Snowden St., Silverton, CO 81433
(970) 387-0600...Silverton (970) 874-2880...Delta
(970) 874-0883...fax EMAIL: kennsch@aol.com

PLAN SCALE:
1"=100' U.S.S.F.

REVISIONS:

FIELD CREW:
K.E.S., T.T.S.

DRAFTER:
KES

SHEET 1 of 1

As Built
for a portion of underground pipe

North Delta Irrigation Company
P.O. Box 804
Delta, Colorado, 81416

FW: 4/24/14 JOB #: 07-14