

# ROXBOROUGH WATER AND SANITATION DISTRICT


AS BUILT DRAWINGS  
ACP 11/22/2019

## RAVENNA PHASE II WATER CONNECTION INFRASTRUCTURE

ROXBOROUGH WATER AND SANITATION DISTRICT  
6222 NORTH ROXBOROUGH PARK ROAD  
LITTLETON, CO 80125  
PHONE: 303-979-7286  
FAX: 303-933-3649

AS BUILT DRAWINGS  
ACP 11/22/2019


TST INFRASTRUCTURE, LLC  
61 INVERNESS DRIVE EAST, SUITE 100  
ENGLEWOOD, CO 80112  
PH: 303-799-5197 FAX: 303-768-0441  
JOB#: 001.335.01  
DATE: NOVEMBER 22, 2019

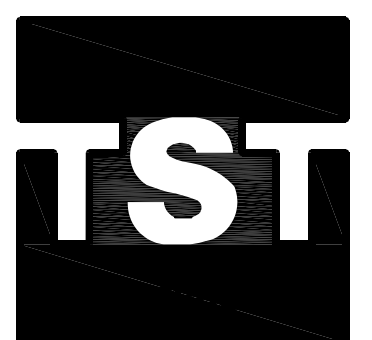

Consulting Engineers

AS-BUILTS

H:\Drawings\Roxborough\001.335.00 - Ravenna WS Impr Design\Sheets\Front End\INDEX.dwg, INDEX - 11x17, 12/10/2019 10:09 AM

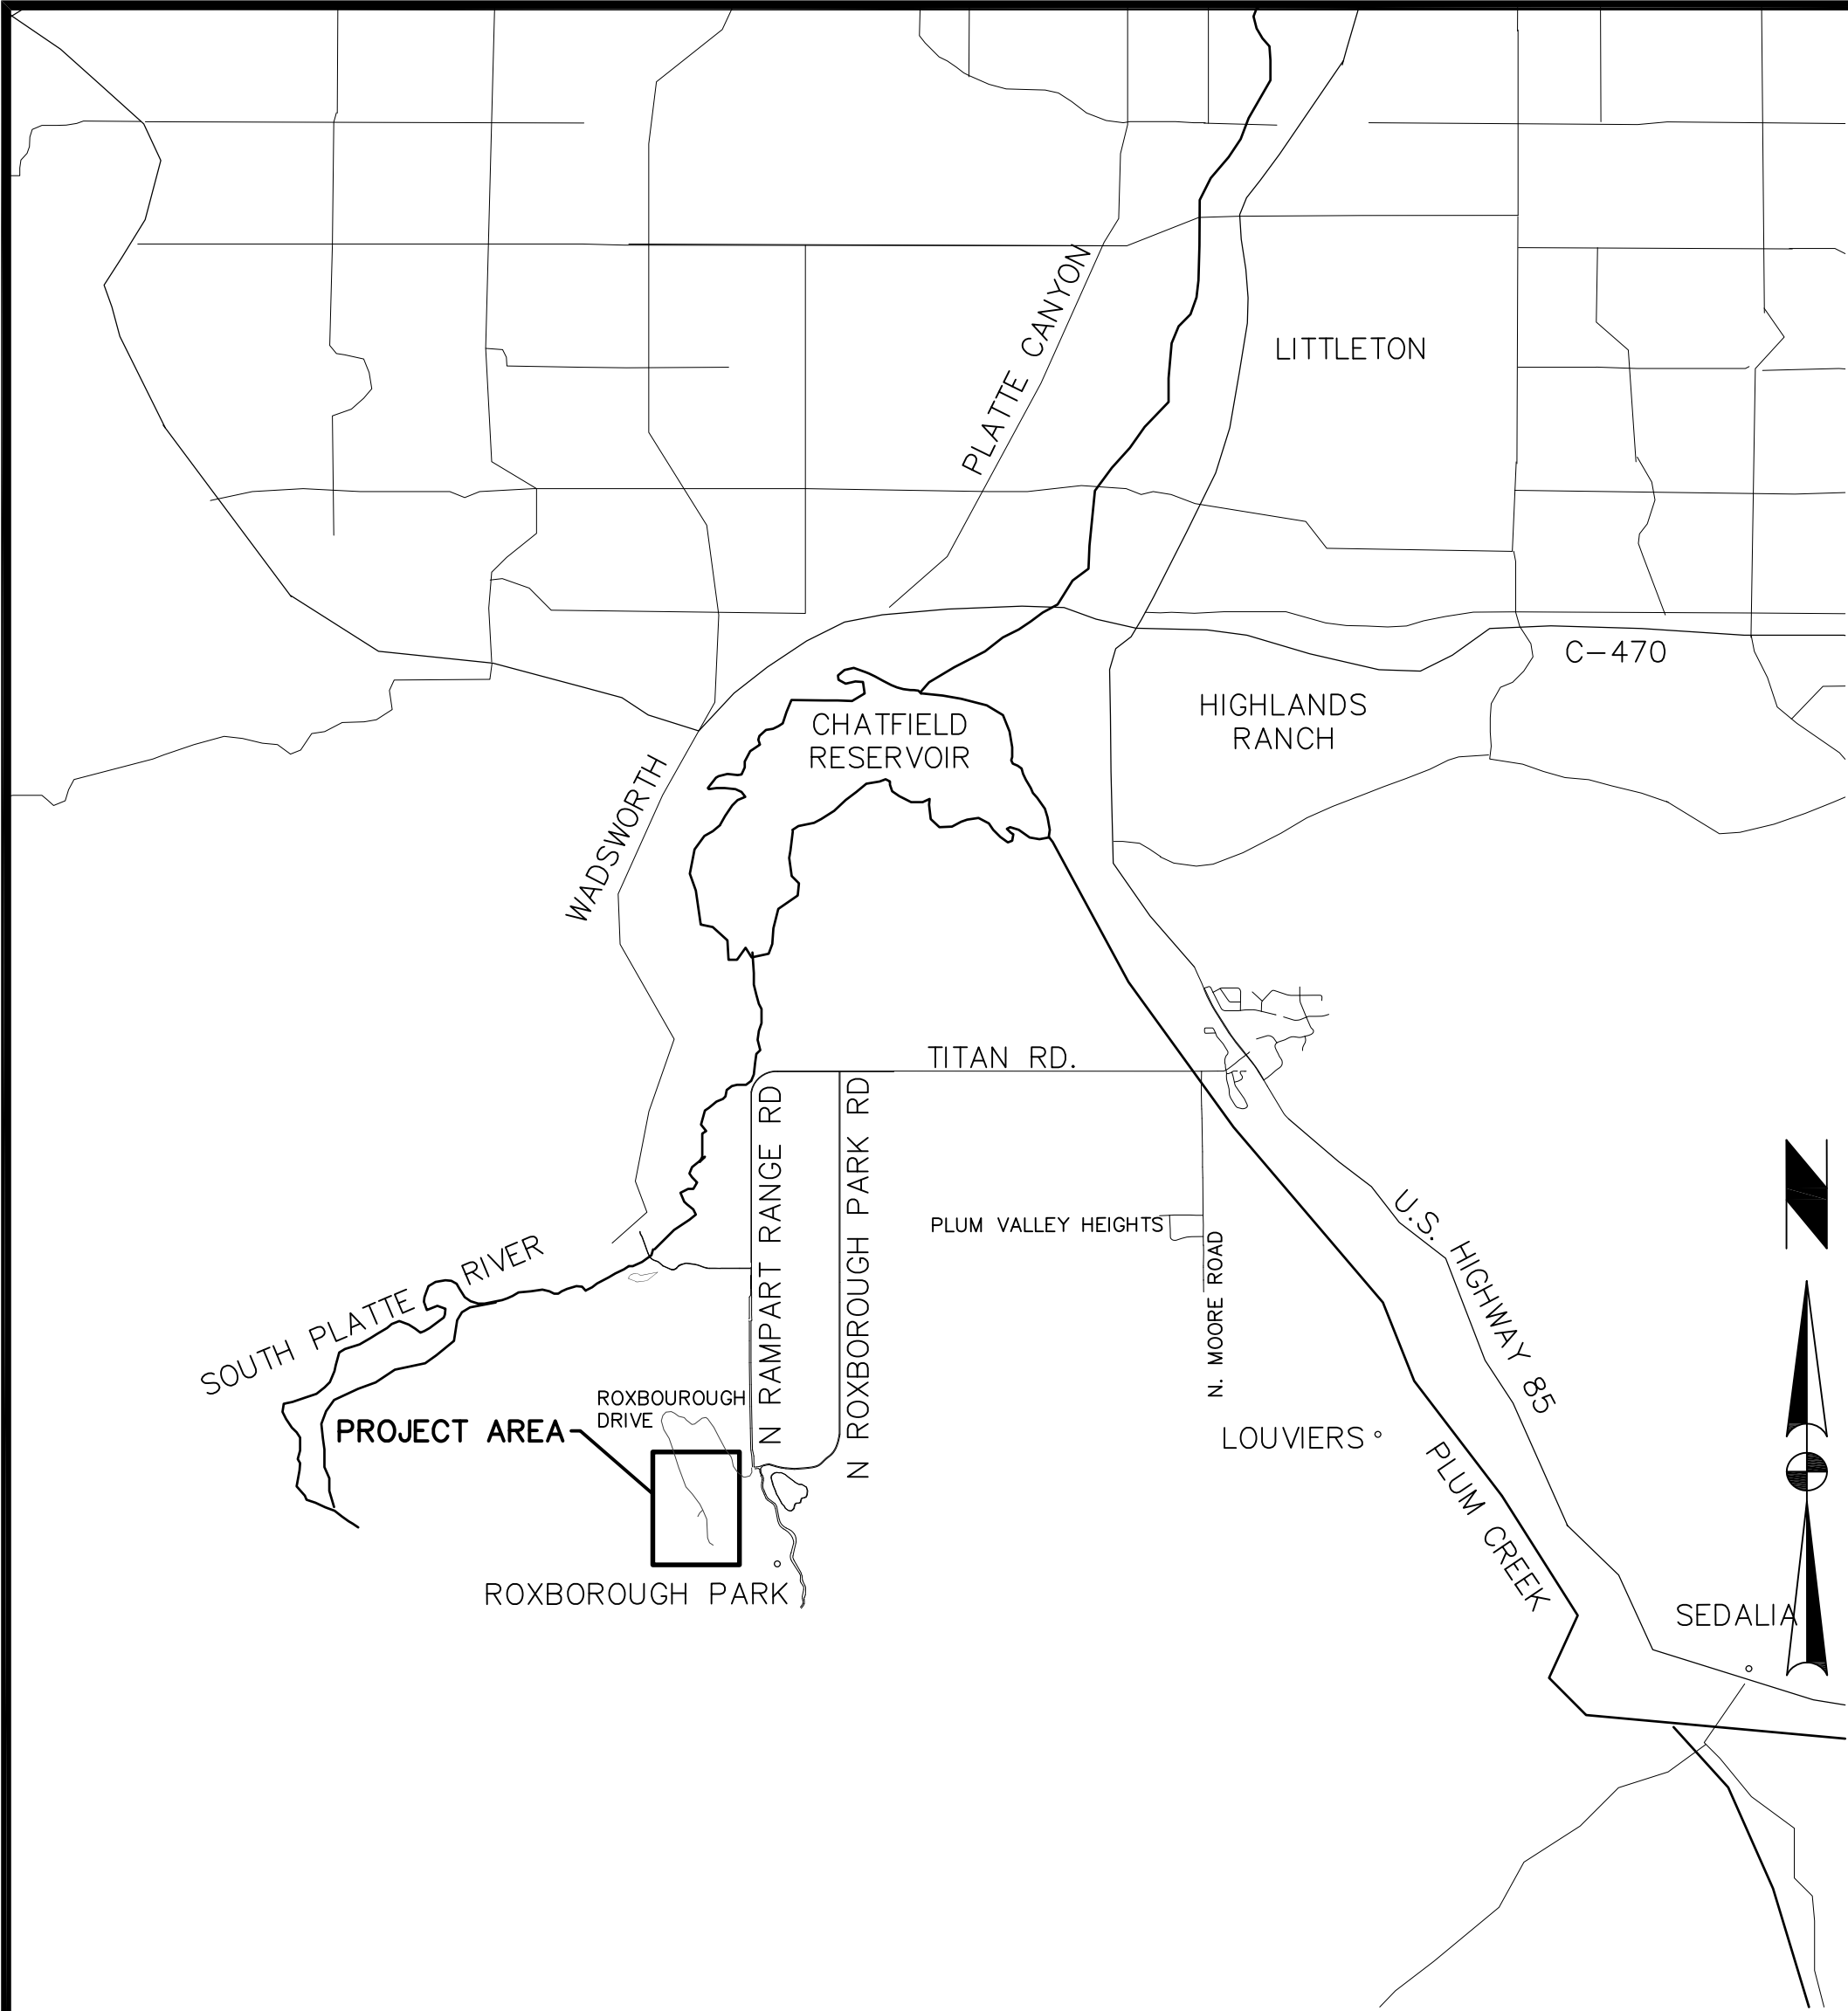

VICINITY MAP  
FULL SIZE SCALE: 1" = 10,000'

SYMBOL LEGEND

EXISTING	NEW
EX WATER LINE FITTING	GEOTECHNICAL BORE
EX WATER LINE VALVE	SAMPLE LOCATION
EX SS CLEANOUT	POTHOLE
EX SS MANHOLE	WATER LINE FITTING
EX BOLLARD	WATER LINE VALVE
EX. LIGHT POLE	ASPHALT SURFACE (MILL AND OVERLAY)
EX. CARSONITE MARKER	ASPHALT SURFACE (FULL DEPTH)
EX. FIRE HYDRANT	CONCRETE PATH
EX. ROAD SIGNS	TEMP PATH
EX. TELE/ELEC UTILITY BOX	
EX. GAS UTILITY BOX	
EX POWER POLE	
EX GRAVEL DRIVE	
EX ASPHALT ROAD	
EX CONCRETE PATH	
RECYCLED ASPHALT	
EX CONIFEROUS TREE	
EX DECIDUOUS TREE	

DRAWING INDEX

CIVIL

KEY	PROJECT KEY MAP
SCD	SURVEY CONTROL DIAGRAM
C1	TRANSMISSION LINE PLAN & PROFILE – SHEET 1 OF 2
C2	TRANSMISSION LINE PLAN & PROFILE – SHEET 2 OF 2
C3	NORTH CONNECTION PLAN – SHEET 1 OF 1
C4	NORTH CONNECTION PROFILE – SHEET 1 OF 1
C5	EAST CONNECTION PLAN AND PROFILE – SHEET 1 OF 1
C6	WATER LINE CONNECTION DETAILS – SHEET 1 OF 4
C7	WATER LINE CONNECTION DETAILS – SHEET 2 OF 4
C8	WATER LINE CONNECTION DETAILS – SHEET 3 OF 4
C9	WATER LINE CONNECTION DETAILS – SHEET 4 OF 4
C10	CIVIL DETAILS – SHEET 1 OF 1
C11	STANDARD CIVIL DETAILS – SHEET 1 OF 2
C12	STANDARD CIVIL DETAILS – SHEET 2 OF 2
C13	NORTH CONNECTION PRV VAULT – SHEET 1 OF 1
C14	EAST CONNECTION PRV VAULT – SHEET 1 OF 1
C15	EX PRV RELOCATION PLAN – SHEET 1 OF 1
C16	EX PRV RELOCATION DETAILS – SHEET 1 OF 1
C17	EMERGENCY INTERCONNECT VAULT PAINTING PLAN – SHEET 1 OF 1
C18	TYPICAL VAULT DETAILS – SHEET 1 OF 1
C19	TANK RESTORATION DETAILS – SHEET 1 OF 1
C20	SURFACE RESTORATION AND FLATWORK DETAILS – SHEET 1 OF 1
C21	NEW PRESSURE REDUCING VALVE INSTALLATION
C22	PRV DETAILS AND HDPE WATER LINE DETAILS

ELECTRICAL

E1	ELECTRICAL GENERAL LEGEND AND ABBREVIATIONS
E2	NORTH AND EAST VAULT ONE LINE DIAGRAMS
E3	EMERGENCY INTERCONNECT VAULT ONE LINE DIAGRAMS
E4	EMERGENCY INTERCONNECT TANK & VAULT SITE ELECTRICAL PLAN
E5	NORTH VAULT ELECTRICAL SITE PLAN
E6	EAST VAULT ELECTRICAL SITE PLAN
E7	NORTH VAULT ELECTRICAL PLAN
E8	EAST VAULT ELECTRICAL PLAN
E9	ELECTRICAL GENERAL DETAILS

INSTRUMENTATION AND CONTROLS

I1	EMERGENCY INTERCONNECTION PLC POWER DISTRIBUTION
I2	EMERGENCY INTERCONNECTION PLC DIGITAL INPUTS AND OUTPUTS
I3	EMERGENCY INTERCONNECTION PLC ANALOG INPUTS
I4	EMERGENCY INTERCONNECTION PLC PANEL LAYOUT
I5	NORTH VAULT PLC POWER DISTRIBUTION
I6	NORTH VAULT PLC DIGITAL INPUTS AND OUTPUTS
I7	NORTH VAULT PLC PANEL LAYOUT
I8	COMMUNICATION DIAGRAM

GESC

<del>GESC1</del>	<del>TRANSMISSION LINE GESC PLAN</del>
GESC2	NORTH AND EAST CONNECTION GESC PLAN
GESC3	TRANSMISSION LINE GESC PLAN
GESC4	GESC STANDARD DETAILS – SHEET 1 OF 3
GESC5	GESC STANDARD DETAILS – SHEET 2 OF 3
GESC6	GESC STANDARD DETAILS – SHEET 3 OF 3

LINE TYPE LEGEND

EXISTING	
SAN	EXISTING SEWER LINE
PW	EXISTING WATER LINE
UGE	EXISTING UNDERGROUND ELECTRIC
GAS	EXISTING GAS
PH	EXISTING UNDERGROUND TELEPHONE
RWL	EXISTING RAW WATER LINE
STM	EXISTING STORM SEWER
6220	EXISTING MAJOR CONTOUR
	EXISTING MINOR CONTOUR
X	EXISTING FENCELINE
	EXISTING EASEMENT BOUNDARY
	EXISTING PROPERTY BOUNDARY
AWL	EXISTING ABANDONED WATER LINE
FO	EXISTING FIBER OPTIC LINE


NEW	
	LIMITS OF CONSTRUCTION
X+XX	WATER LINE

ABBREVIATIONS

&	AND	MIN	MINIMUM
@	AT	MJ	MECHANICAL JOINT
°	DEGREE	MNPT	MALE NATIONAL PIPE THREAD
Δ	DELTA	MNST	MALE NATIONAL STANDARD THREAD
∅	DIAMETER	MP	METER PIT
"	INCH	N/A	NOT APPLICABLE
#	NUMBER	N.	NORTH
%	PERCENT	N:	NORTHING
ABAND	ABANDON(ED)	NPT	NATIONAL PIPE THREAD
AC	ASBESTOS CEMENT	NAVD	NORTH AMERICAN VERTICAL DATUM
ASSY	ASSEMBLY	NTS	NOT TO SCALE
ASTM	AMERICAN SOCIETY FOR TESTING & MATERIALS	O.D.	OUTSIDE DIAMETER
AWG	AMERICAN WIRE GAUGE	OHE	OVERHEAD ELECTRIC
AWWA	AMERICAN WATER WORKS ASSOCIATION	PCF	POUNDS PER CUBIC FOOT
APPROX	APPROXIMATE(LY)	PE	POLYETHYLENE
BMP	BEST MANAGEMENT PRACTICE	PH	PHONE
CLSM	CONTROLLED LOW STRENGTH MATERIAL	PL	PROPERTY LINE
CL	CENTERLINE	PNT	POINT
CDOT	COLORADO DEPARMENT OF TRANSPORTATION	POLY	POLYETHYLENE
CI	CAST IRON	PSF	POUNDS PER SQUARE FOOT
COMBO	COMBINATION	PSI	POUNDS PER SQUARE INCH
CONC	CONCRETE	PVC	POLYVINYL CHLORIDE
CONN	CONNECTION	PVMT	PAVEMENT
CY	CUBIC YARD	PW	POTABLE WATER
DC	DOUGLAS COUNTY	RCP	REINFORCED CONCRETE PIPE
DI	DUCTILE IRON	RDCR	REDUCER
DIA	DIAMETER	RMD	RAVENNA METROPOLITAN DISTRICT
DIP	DUCTILE IRON PIPE	ROW	RIGHT OF WAY
E	EAST	RWSD	ROXBOROUGH WATER AND SANITATION DISTRICT
E:	EASTING		
E.I.C.	EMERGENCY INTERCONNECT	SCHED	SCHEDULE
ELEC	ELECTRICAL	SS	SANITARY SEWER
EL	ELEVATION	S.	SOUTH
ELL	ELBOW	SQ	SQUARE
ESMT.	EASEMENT	SAN	SANITARY SEWER
EX	EXISTING	SF	SQUARE FEET
FF	FINISHED FLOOR	SHT	SHEET
FH	FIRE HYDRANT	SST	STAINLESS STEEL
FLG	FLANGE	STA	STATION
FNPT	FEMALE NATIONAL PIPE THREAD	STD	STANDARD
FO	FIBER OPTIC	STL	STEEL
GEN	GENERATOR	SY	SQUARE YARD
GV	GATE VALVE	TB	THRUST BLOCK
H	HEIGHT	TEMP	TEMPORARY
HDD	HORIZONTAL DIRECTION DRILL	THK	THICK
HORIZ	HORIZONTAL	TOP	TOP OF PIPE
HWL	HIGH WATER LEVEL	TYP	TYPICAL
ID	INSIDE DIAMETER	TRANS	TRANSFORMER
IPS	INTERNATIONAL PIPE SIZE	TWTS	TRACER WIRE TEST STATION
INV.	INVERT	UGE	UNDERGROUND ELECTRIC
IR	IRRIGATION	VERT	VERTICAL
JTS	JOINTS	VTC	VEHICLE TRACKING CONTROL
L	LENGTH	W	WEST
LF	LINEAR FEET	WL	WATERLINE
LOC	LIMITS OF CONSTRUCTION	WTP	WATER TREATMENT PLANT
LWL	LOW WATER LEVEL	W/	WITH
MAX	MAXIMUM	W/O	WITHOUT
MATL	MATERIAL	XING	CROSSING

ROXBOROUGH WATER AND SANITATION DISTRICT  
RAVENNA PHASE II WATER CONNECTION INFRASTRUCTURE

VICINITY MAP AND INDEX SHEET

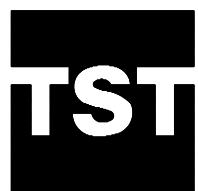

TST INFRASTRUCTURE, LLC  
Consulting Engineers

DATE: **NOVEMBER 2019**

JOB NO. **001.335.01**

**RWSD**

DRAWING NO.

AS-BUILTS

INDEX

H:\Drawings\Roxborough\001.335.00 - Ravenna WS Impr Design\Sheets\Front\_End\KEY.dwg, KEY 1, 12/10/2019 10:09 AM

LEGEND


EX WATER LINE

PROJECT WATER LINE


LOT / RIGHT-OF-WAY LINES

SHEETS

PRV MANHOLES

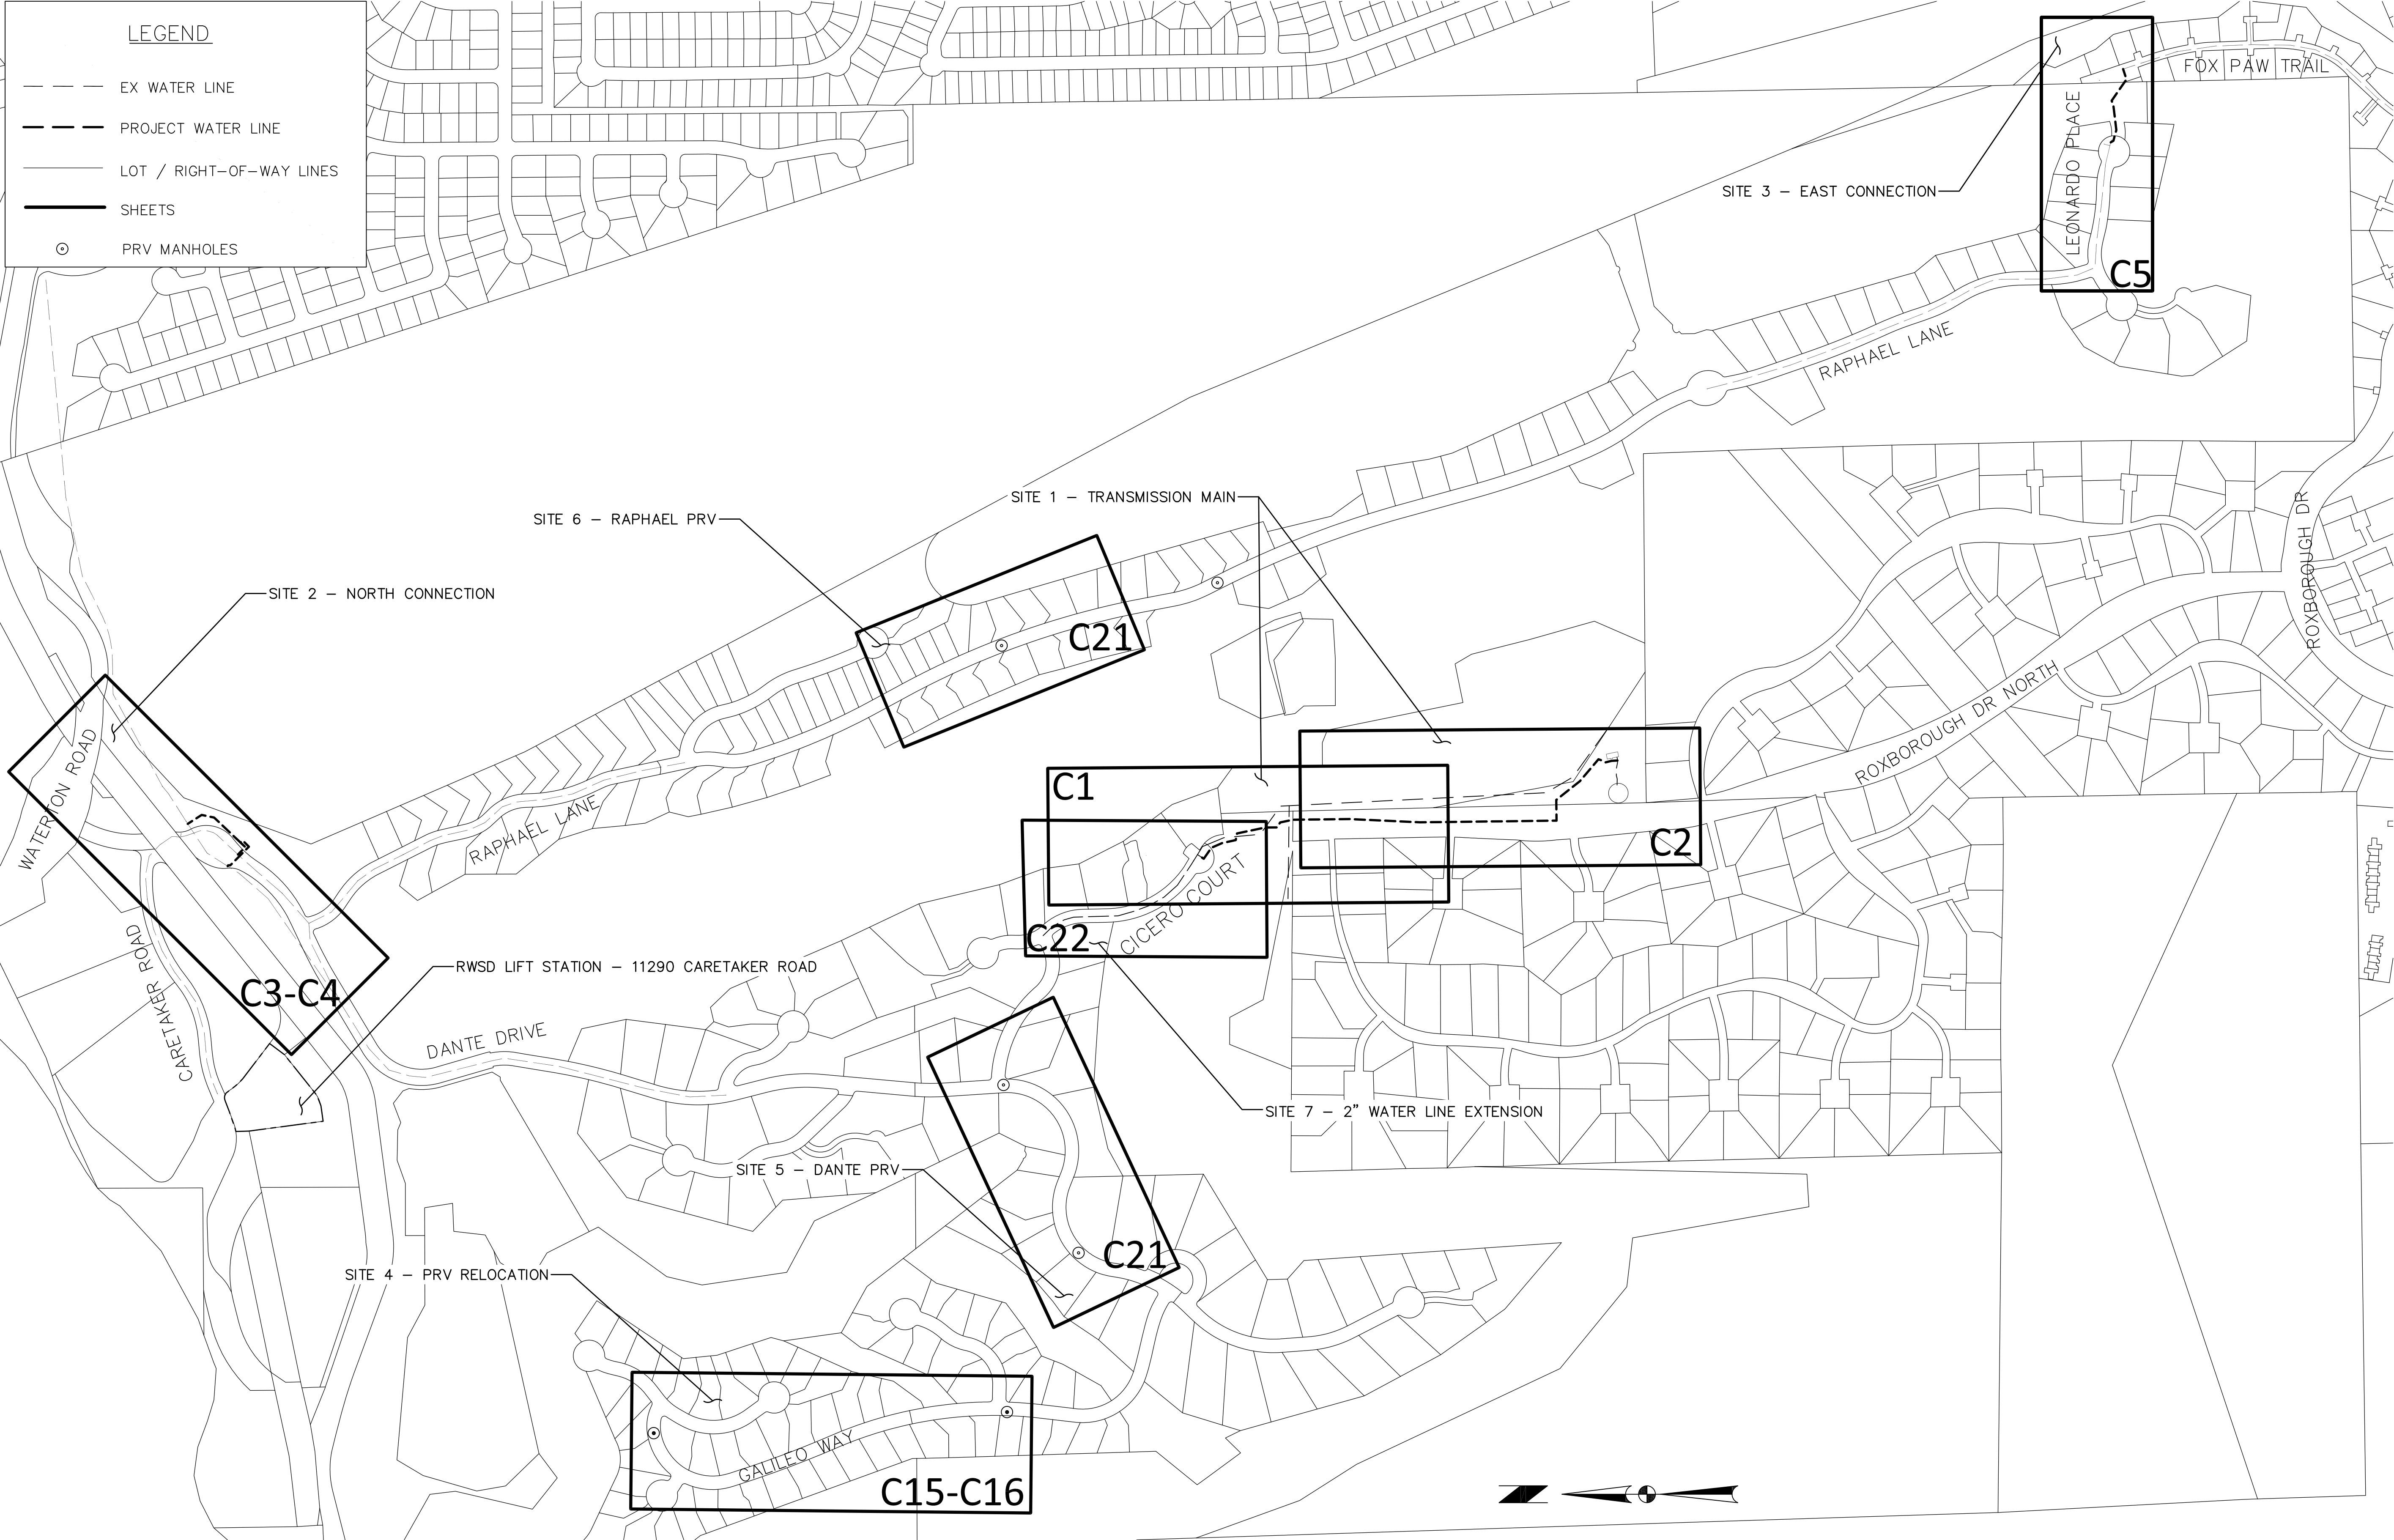

PROJECT KEY MAP  
1" = 300"

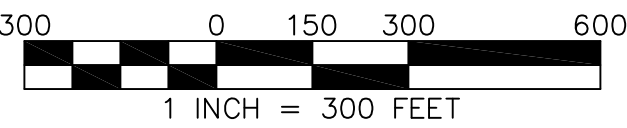

AS-BUILTS

REVISIONS

Rev	Description	By	Date
1	AS-BUILT	ACP	11/22/2019

DESIGNED:

JDB

CHECKED:

MKM

DRAWN:

SDH

1 INCH

1 INCH

1 INCH

BARS PLOT  
1 INCH x 1 INCH  
AT FULL SCALE

ROXBOROUGH WATER AND SANITATION DISTRICT

RAVENNA PHASE II WATER CONNECTION INFRASTRUCTURE

PROJECT KEY MAP

TST

TST INFRASTRUCTURE, LLC

Consulting Engineers

DATE

NOVEMBER 2019

JOB NO.


001.335.01

RWSD

DRAWING NO.

KEY

H:\Drawings\Roxborough\001.335.00 - Ravenna WS Impr\Design\Sheets\Front End\SCD.dwg, SCD, 12/10/2019 10:09 AM

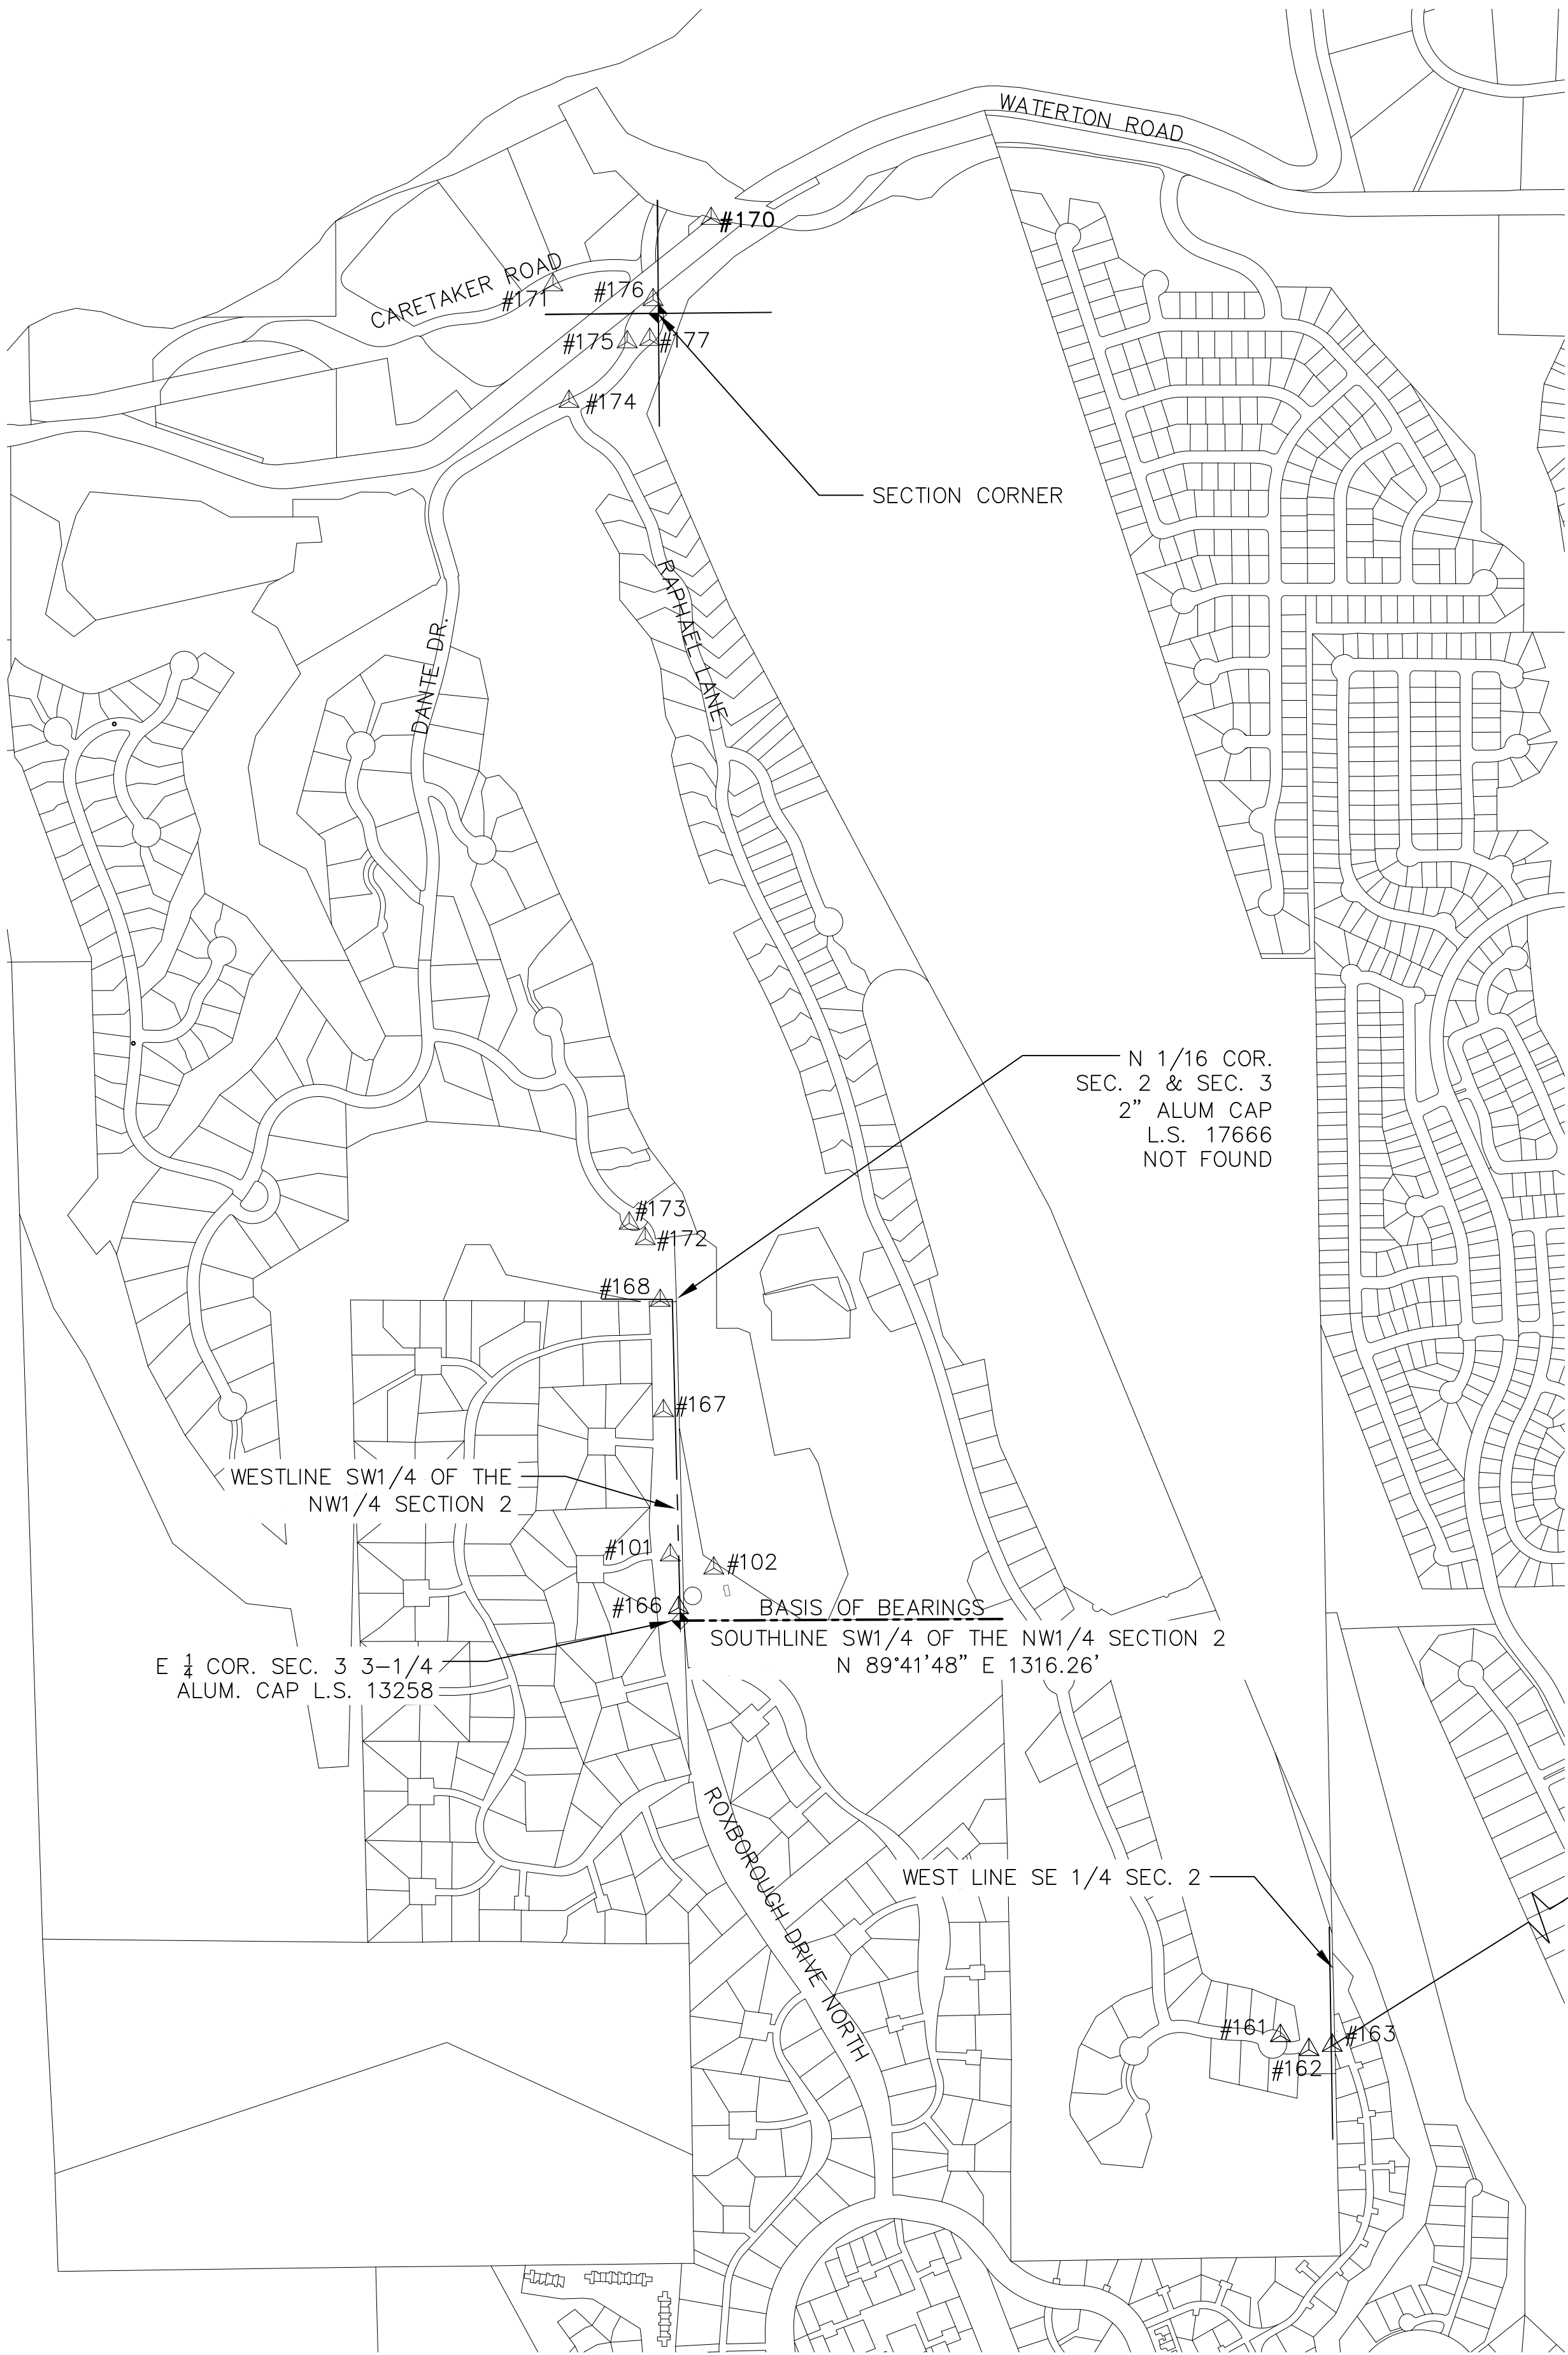

GENERAL NOTES

1. BASIS OF BEARINGS: BEARINGS ARE BASED UPON GRID BEARINGS AS ESTABLISHED ON THE COLORADO STATE PLANE COORDINATES "CENTRAL" SYSTEM WHEREAS THE SOUTHLINE OF SW1/4 OF THE NW1/4 SECTION 2 BEARS N 89°41'48" E 1316.26'.
2. ALL DIMENSIONS ARE SHOWN IN U.S. SURVEY FEET. BEARINGS ARE SHOWN AS DEGREES, MINUTES AND SECONDS.
3. HORIZONTAL AND VERTICAL DATUM – SEE COORDINATES AND NOTE 5.
4. BASIS OF ELEVATIONS: ELEVATIONS ARE BASED UPON DOUGLAS COUNTY CONTROL POINT, BEING A 3" ALUMINUM CAP STAMPED "DC 2.056130 ". ELEVATION = 5745.84 FEET NAVD 88. (SURVEY CONTROL POINT #11)
5. TO CONVERT THE SHOWN GROUND COLORADO MODIFIED STATE PLANE COORDINATES (TRUNCATED) (ZONE CENTRAL 0502) TO GRID COLORADO STATE PLANE COORDINATES (NOT TRUNCATED) (ZONE CENTRAL 0502)

EXAMPLE:

GROUND COLORADO MODIFIED STATE PLANE COORDINATES (TRUNCATED) (ZONE CENTRAL 0502)		EASTING		ELEVATION		DESCRIPTION	
PNT	NORTHING						
11	597376.809	121548.531		5745.843		DC 2056310	

$597376.809 + 1,000,000 = 1597376.809 \times 0.999685342 = 1596874.182$   
 $121548.531 + 3,000,000 = 3121548.531 \times 0.999685342 = 3120566.311$

GRID COLORADO STATE PLANE COORDINATES (ZONE CENTRAL 0502)		EASTING		ELEVATION		DESCRIPTION	
PNT	NORTHING						
11	1596874.182	3120566.311		5745.843		DC 2056310	

GROUND SCALE FACTOR EQUALS 1.000314757  
GRID SCALE FACTOR EQUALS 0.999685342  
NORTHING TRUNCATED BY 1,000,000  
EASTING TRUNCATED BY 3,000,000

POINT OF ORIGIN: 0,0

NAD 83 (92)  
NAVD 88  
GEOID 96 (USED PER EXISTING DOUGLAS COUNTY CONTROL)

NOTE:  
HORIZONTAL LOCATIONS SHOWN FOR WATER LINES AND RELATED APPURTENACNES AND STRUCTURES ARE BASED SOLELY ON RECEIVED SURVEY FROM REDLINE PIPELINE

PRIMARY CONTROL DOUGLAS COUNTY / NGS (LAT/LONG):

PNT	LATITUDE	LONGITUDE	DESCRIPTION
10	39D27'12.35993"	-105D04'04.47409"	ROMANSKI
11	39D28'17.08156"	-105D04'22.48045"	DC 2056310
12	39D30'25.60794"	-105D04'20.30184"	COPP
13	39D27'22.54679"	-105D03'16.24950"	DC 2044120
14	39D28'11.80167"	-105D05'13.37423"	DC 2052137
15	39D26'44.21872"	-105D01'44.91540"	DC 2037106
17	39D26'09.54531"	-105D03'44.26712"	DC 2031125
18	39D30'26.60909"	-105D02'35.04502"	J305
21	39D28'40.08760"	-105D03'16.86375"	DC 2059120

PRIMARY CONTROL DOUGLAS COUNTY / NGS (GRID):

PNT	NORTHING	EASTING	DESCRIPTION
10	1590332.610	3122009.435	ROMANSKI
11	1596874.182	3120566.311	DC 2056310
12	1609878.818	3120675.927	COPP
13	1591381.538	3125786.901	DC 2044120
14	1596321.532	3116577.874	DC 2052137
15	1587539.824	3132970.542	DC 2037106
17	1583984.926	3123624.999	DC 2031125
18	1610020.277	3128924.995	J305
21	1599226.542	3125700.268	DC 2059120

SURVEY CONTROL


SITE CONTROL:

PNT	NORTHING	EASTING	ELEVATION	DESCRIPTION
101	597382.288	116179.950	5841.184	SURVEY POINT WITH 1" PLASTIC WASHER
102	597328.601	116357.919	5839.621	NAIL
166	597166.776	116213.327	5853.159	NO.5 REBAR WITH 1" BLUE PLASTIC CAP
167	597971.769	116152.228	5800.098	NO.5 REBAR WITH 1" BLUE PLASTIC CAP
168	598422.727	116138.627	5772.397	NAIL
172	598675.417	116077.513	5754.520	NAIL
173	598738.349	116012.221	5745.386	PK NAIL WITH 1" PLASTIC WASHER
170	602845.98	116347.02	5551.52	SURVEY POINT NAIL WITH 1" PLASTIC WASHER
171	602574.39	115700.31	5538.45	NO.5 REBAR WITH 1" BLUE PLASTIC CAP "TRUE NORTH"
174	602098.19	115765.92	5563.07	1" BRASS PLUG STAMPED TRUE NORTH
175	602341.65	116003.86	5558.14	CUT CROSS
176	602513.84	116109.46	5557.75	CUT CROSS
177	602351.32	116095.96	5557.53	CUT CROSS
161	595417.580	118674.720	5861.834	CUT CROSS
162	595360.470	118791.002	5854.675	NO.5 REBAR WITH 1" BLUE PLASTIC CAP STAMPED TRUE NORTH
163	595377.045	118886.509	5842.337	NO.5 REBAR WITH 1" BLUE PLASTIC CAP STAMPED TRUE NORTH

SURVEY LEGEND

- ◆ INDICATES SECTION CORNER/QUARTER CORNER  
△ INDICATES SURVEY CONTROL POINT  
● INDICATES BENCHMARK


SURVEY CONTROL DIAGRAM  
1" = 500'

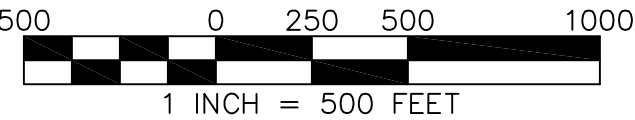

AS-BUILTS

ROXBOROUGH WATER AND SANITATION DISTRICT  
RAVENNA PHASE II WATER CONNECTION INFRASTRUCTURE

SURVEY CONTROL DIAGRAM

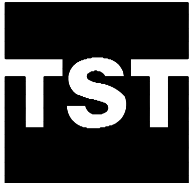

TST INFRASTRUCTURE, LLC  
Consulting Engineers

DATE: **NOVEMBER 2019**



JOB NO. **001.335.01**

RWSD

DRAWING NO.

SCD



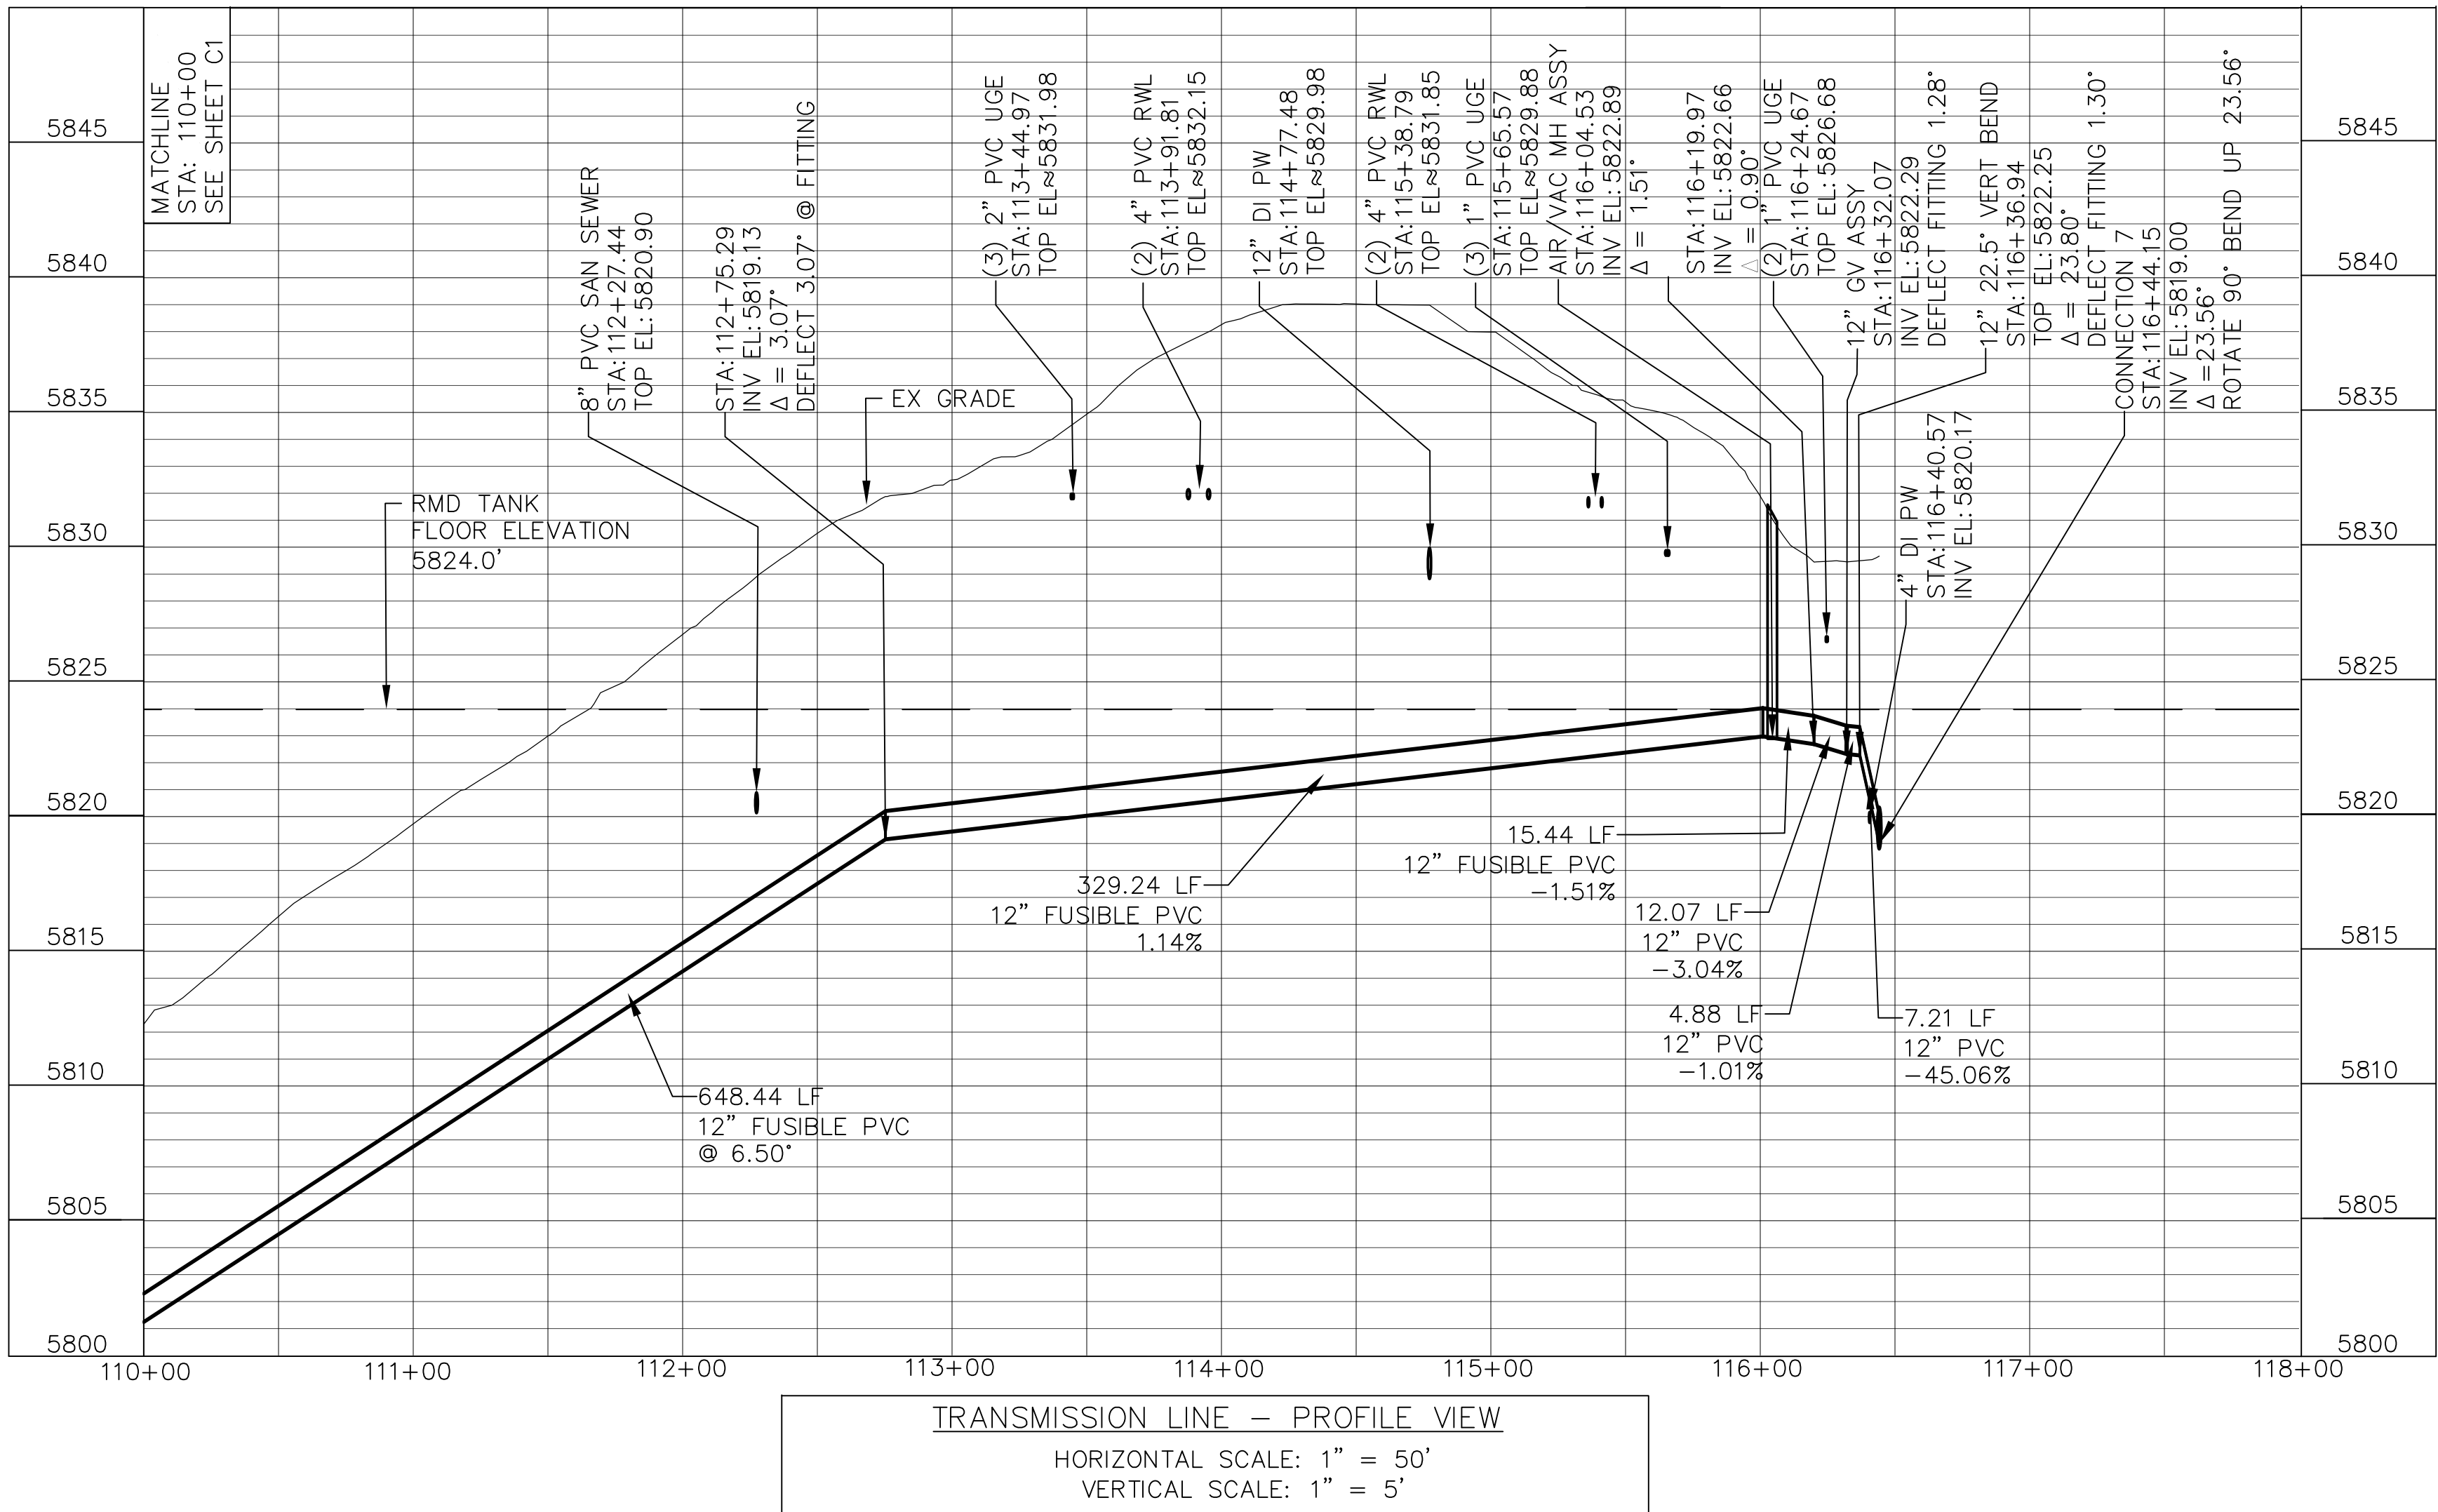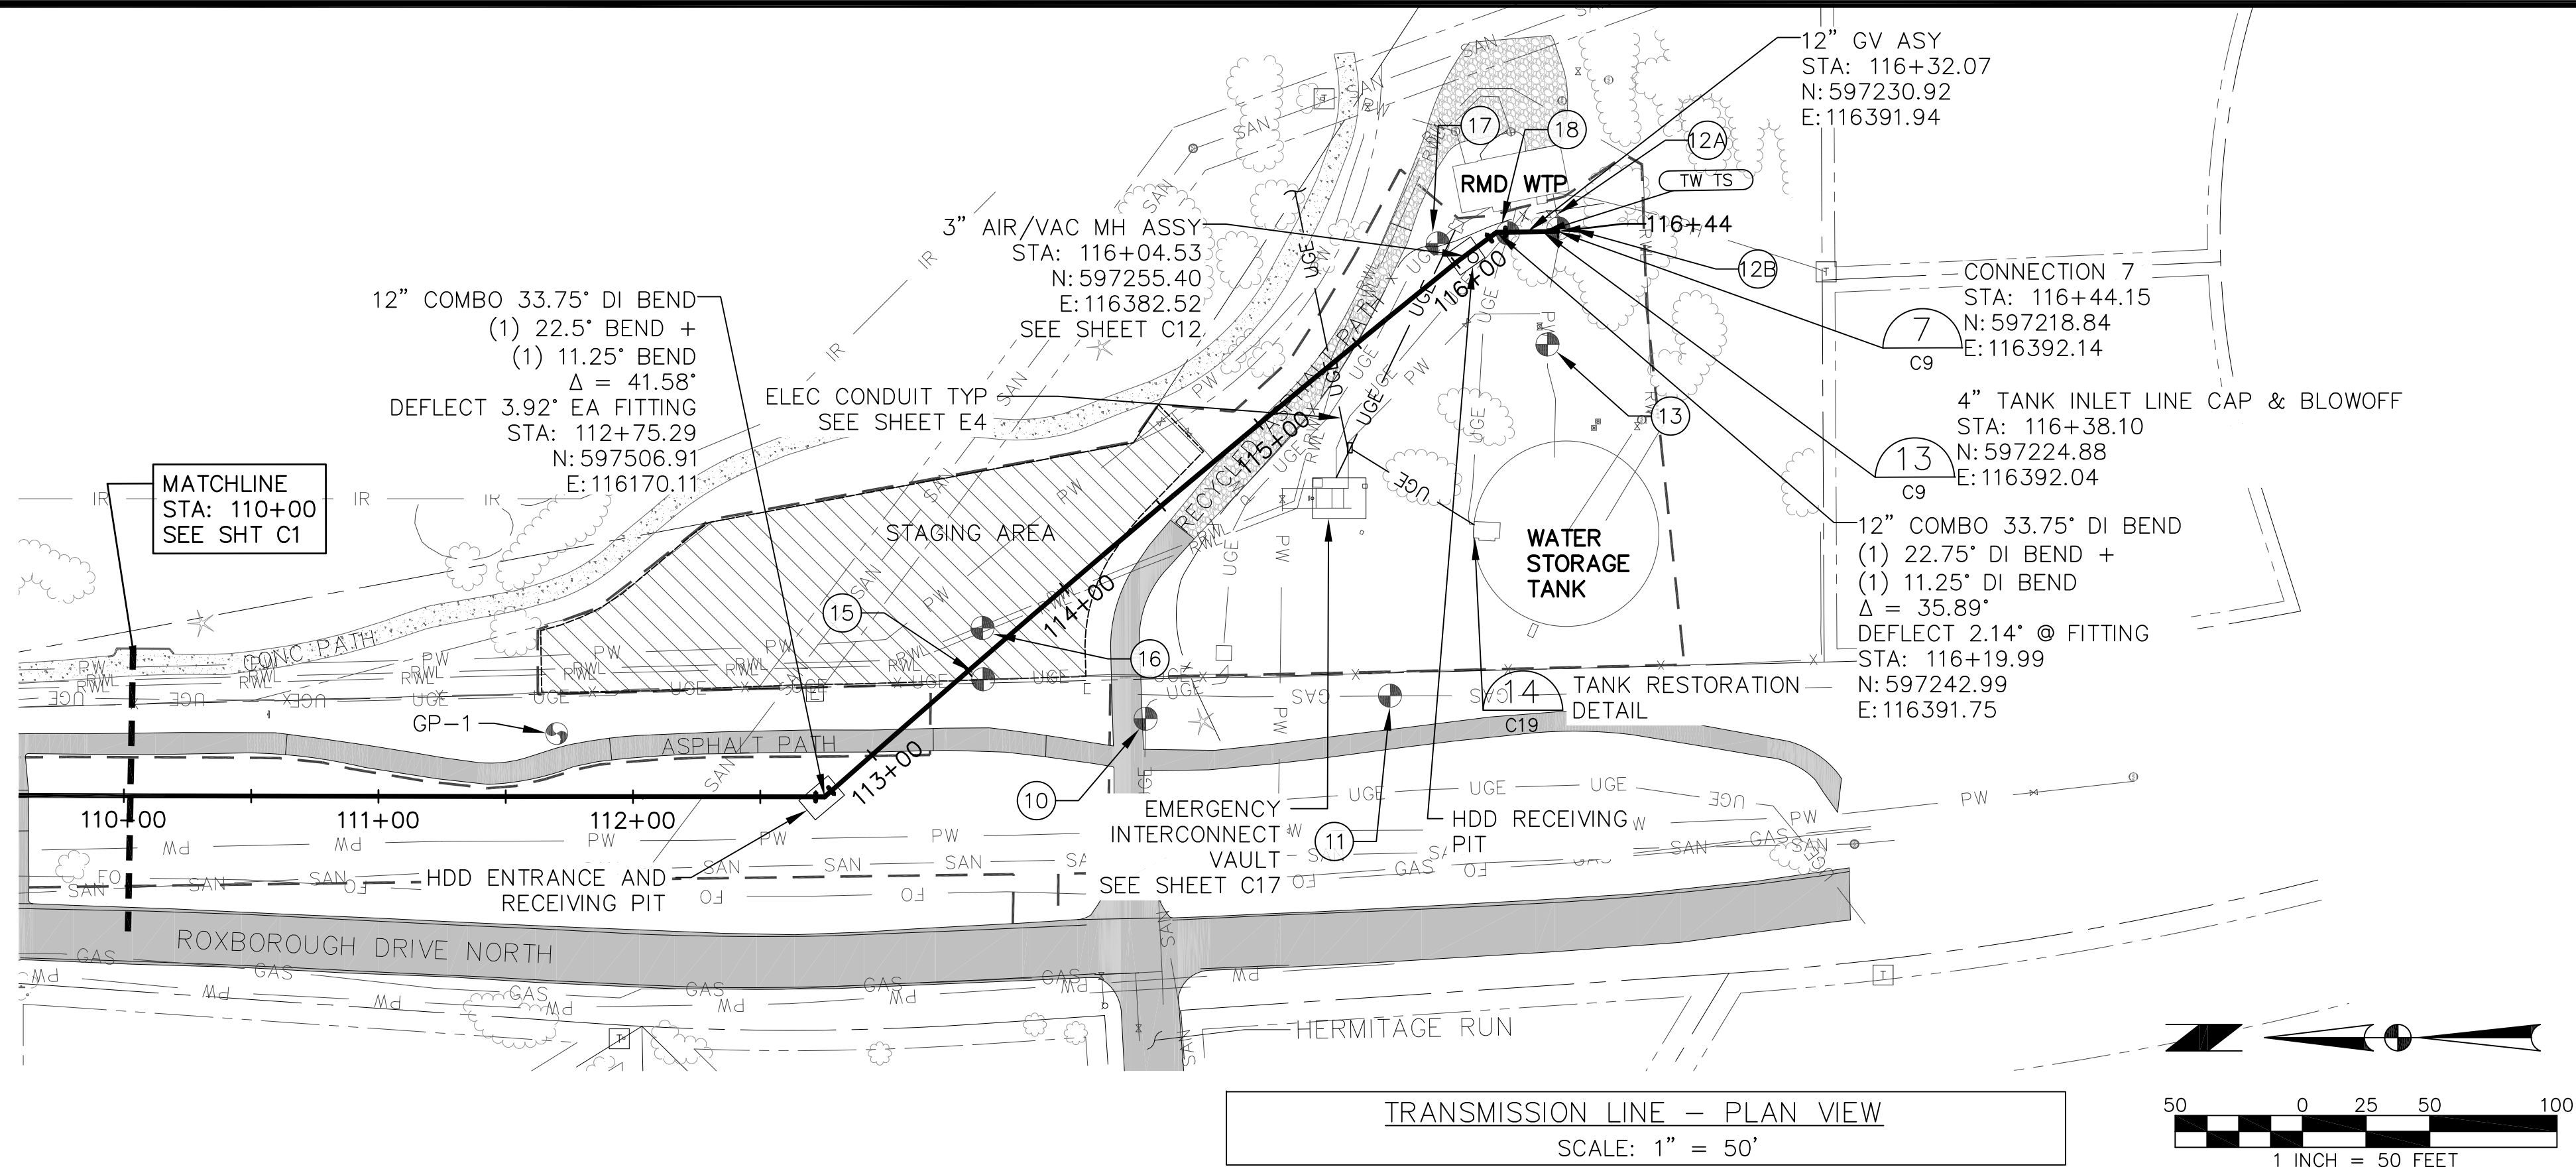


POTHOLE INFORMATION				
POTHOLE	UTILITY	DEPTH TOP	UTILITY TOP EL	DIA/MATL
10	UGE	41"	±5837.10	(2) 8" PVC
11	GAS	39"	±5843.10	2" PE
12A	PW	113"	±5820.13	4" DI
12B	PW	113"	±5820.24	16" DI
13	PW	108"	±5820.20	16" DI
15	UGE	45"	±5831.98	(3) 2" PVC
16	RWL	84"	±5832.15	(2) 4" PVC
17	UGE	65"	±5829.88	(3) 1" PVC
18	UGE	34"	±5826.68	(2) 1" PVC


- NOTES:
- CONTRACTOR SHALL VERIFY LOCATION, SIZE, AND MATERIAL OF WATER LINES PRIOR TO MAKING CONNECTIONS.
  - AT BEGINNING AND END OF BID ALTERNATE CONNECT HDD BORE TO PVC OPEN CUT CONSTRUCTION.
  - CONTRACTOR TO COORDINATE OPERATION OF EXISTING GATE VALVES WITH RWSO FOR SHUTDOWNS AND TIE-INS TO SYSTEM.
  - WATER STORAGE TANK REQUIRES CLEANING, DISINFECTION, & PLACED INTO SERVICE. SEE SPECIFICATION 02676 FOR DETAILS.
  - THE MAXIMUM HDD BORE DEPTH SHALL BE 15 FEET EXCEPT BETWEEN STA 113+50 AND STA 115+50 WHERE THE DEPTH SHALL BE A MAXIMUM OF 18 FEET.

1. CONTRACTOR SHALL VERIFY LOCATION, SIZE, AND MATERIAL OF WATER LINES PRIOR TO MAKING CONNECTIONS.
2. CONTRACTOR TO COORDINATE OPERATION OF EXISTING GATE VALVES WITH RWSD FOR SHUTDOWNS AND TIE-INS TO SYSTEM.
3. DO NOT DISTURB EXISTING BLOCK PAVER ROADWAY.
4. EXISTING IRRIGATION UTILITIES WILL BE PUT OUT OF SERVICE BY OWNER PRIOR TO EXCAVATION BY CONTRACTOR AND REPAIRED BY OWNER. CONTRACTOR TO CLEARLY MARK LOCATION + DEPTH OF ENCOUNTERED IRRIGATION LINES.

POTHOLE INFORMATION				
POTHOLE	UTILITY	DEPTH TOP	UTILITY TOP EL	DIA/MATL
(10)	WL	115"	±5549.00	12" DI
(11)	FO	17"	±5556.90	3" PVC
(12)	FO	65"	±5552.60	2" PVC
(13)	FO	88"	±5550.80	2" PVC
(13B)	FO	90"	±5550.70	4" PVC
(14)	WL	60"	±5553.00	8" PVC
(15)	ABND WL	85"	±5550.60	12" DI
(16)	UGE	27"	±5555.90	(3) 1" PVC
(17)	UGE	54"	±5552.30	(3) 1" PVC
(18)	GAS	35"	±5553.40	4" PE
(19)	UGE	36"	±5555.20	(2) 2" PVC
(20)	UGE	23"	±5555.30	(3) 1" PVC
(21)	FO	70"	±5550.40	2" PVC
(22)	FO	40"	±5553.00	4" PVC

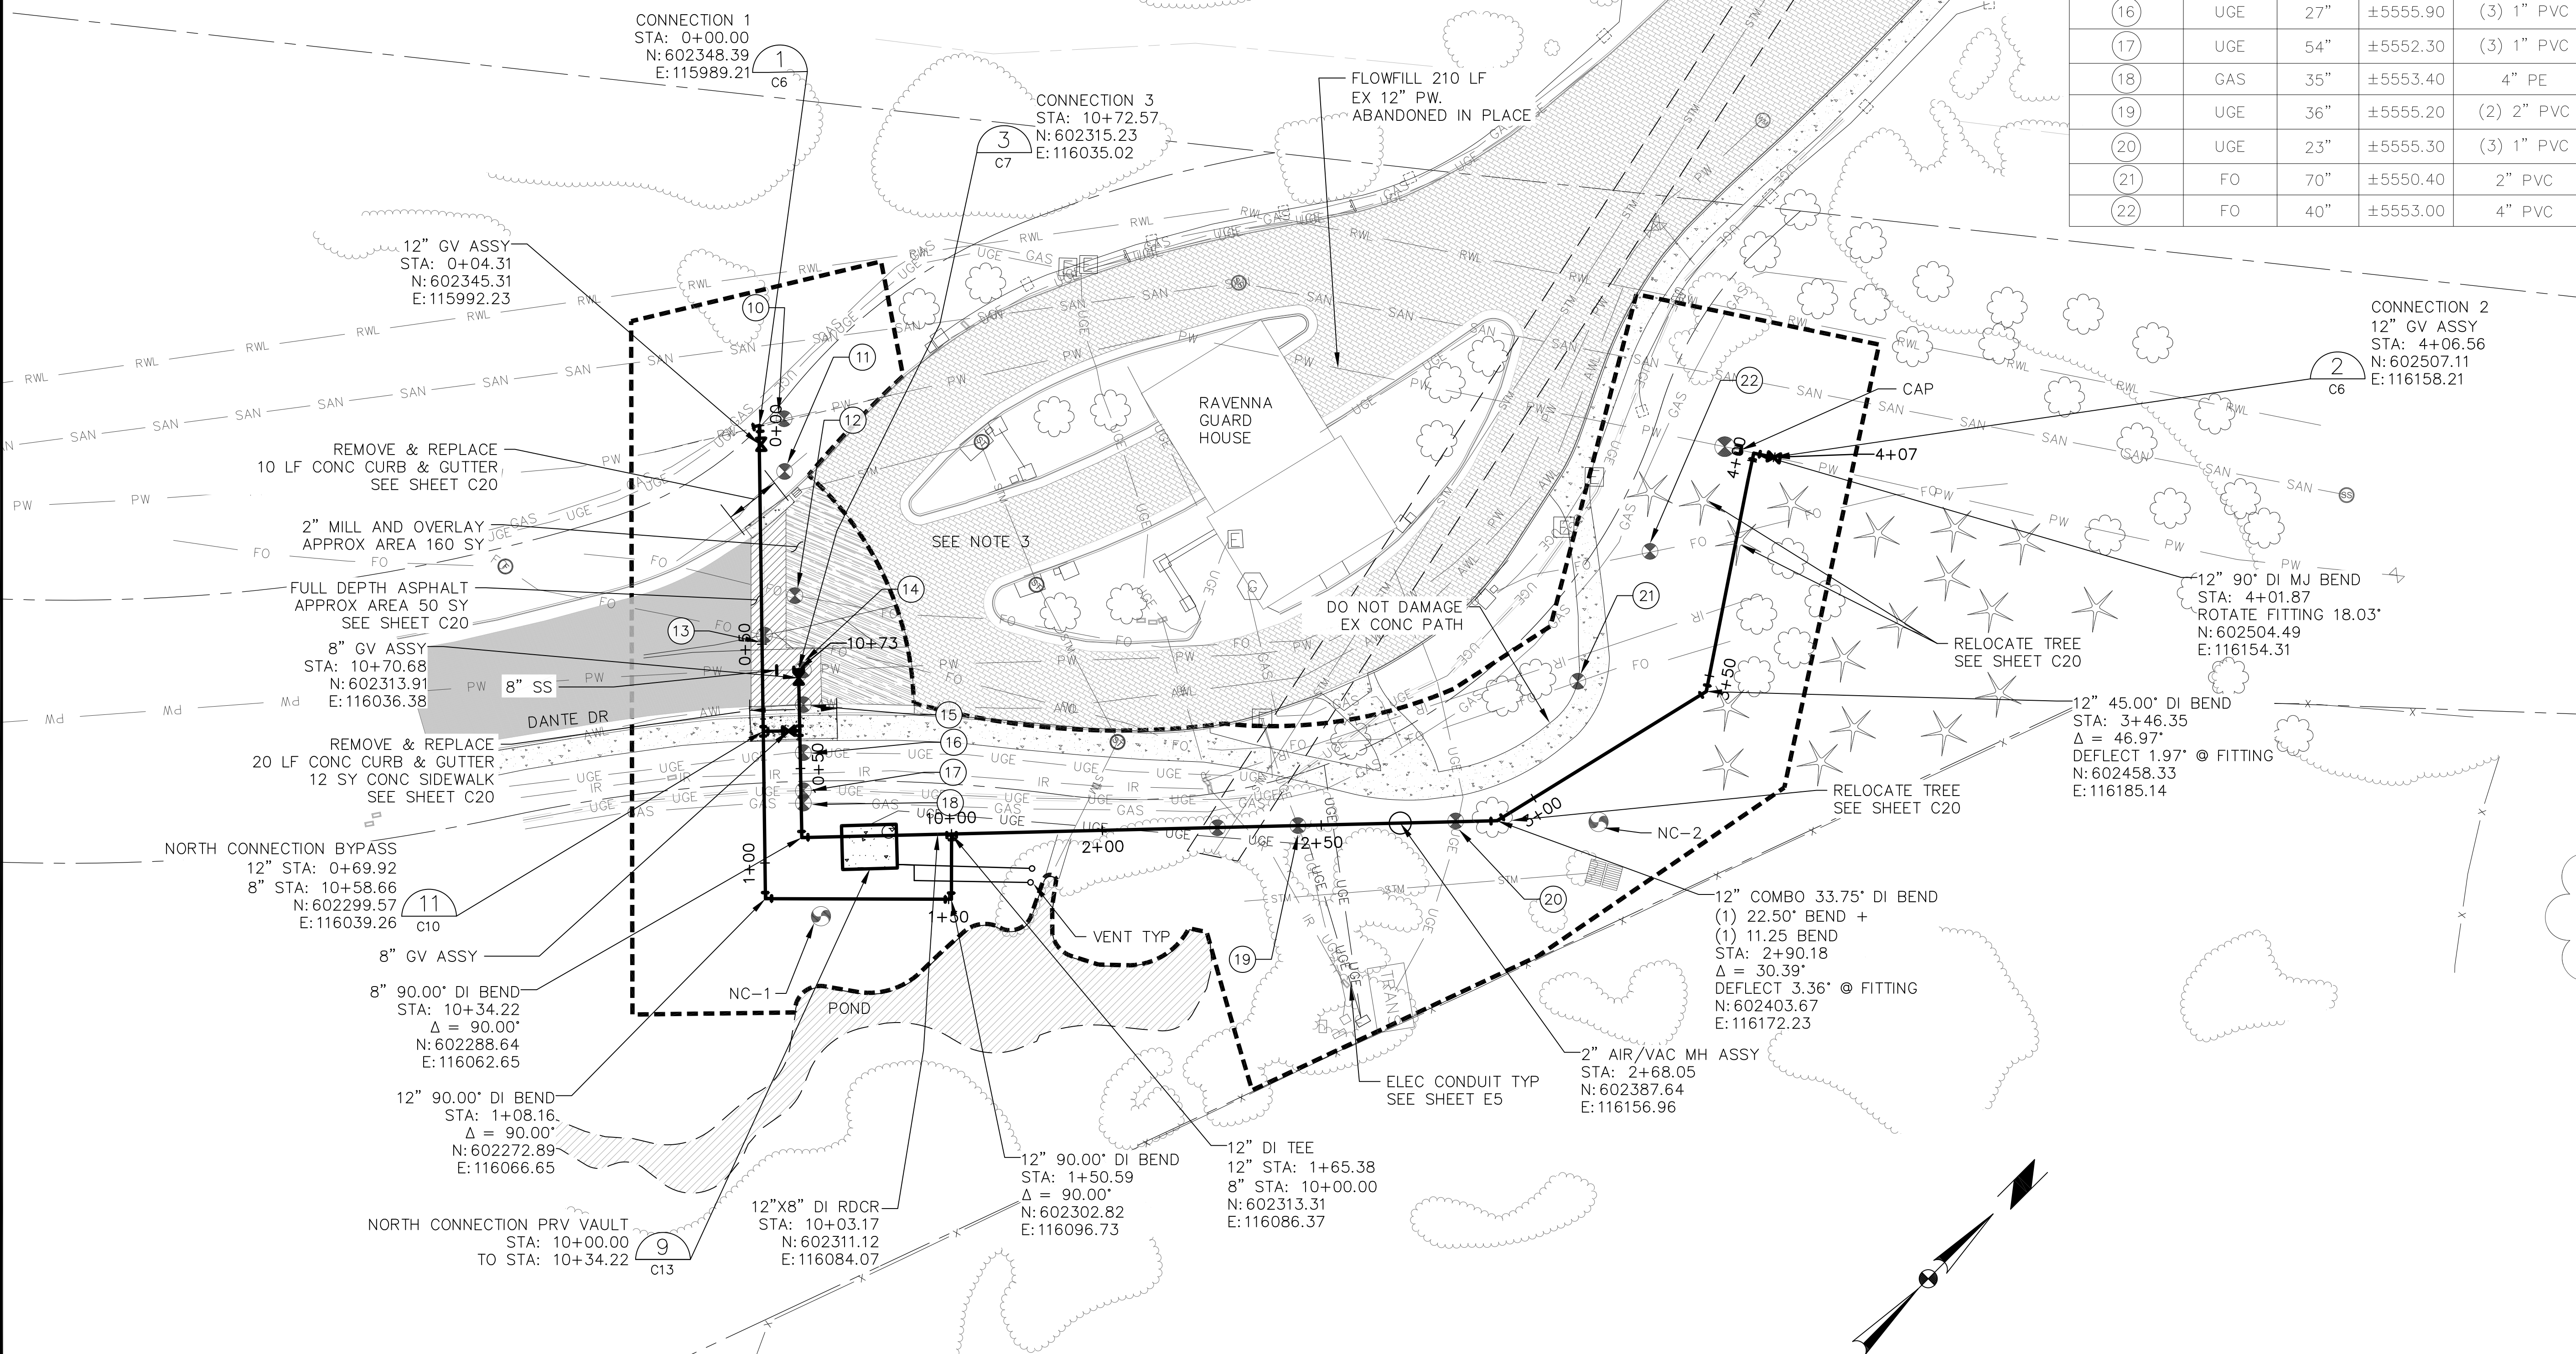

NORTH CONNECTION WATER LINE – PLAN VIEW  
SCALE: 1" = 20'

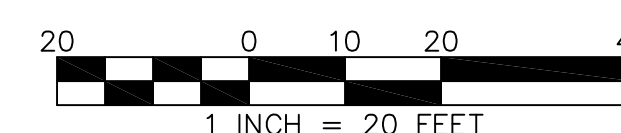

AS-BUILTS

ROXBOROUGH WATER AND SANITATION DISTRICT  
RAVENNA PHASE II WATER CONNECTION INFRASTRUCTURE

NORTH CONNECTION PLAN - SHEET 1 OF 1



**TST INFRASTRUCTURE, LLC**  
Consulting Engineers

DATE **NOVEMBER 2019**

JOB NO. 001.335.01


RWSD

DRAWING NO.


# C3

H:\Drawings\Roxborough\Civil\Design\Sheets\Civil\C3 And C4.dwg, C4, 12/10/2019 10:10 AM

PIPE XING LEGEND					
#	TOP EL	STA	UT	SIZE	MATL
A	5556.90	0+15.45	FO	2"	PVC
B	5552.60	0+36.96	FO	2"	PVC
C	5550.80	0+47.90	FO	2"	PVC
D	5550.70	0+48.18	FO	4"	PVC
E	5553.00	0+56.14	PW	8"	PVC
F	5555.90	0+75.95	UGE	(3) 1"	PVC
G	5552.30	0+83.63	UGE	(3) 1"	PVC
H	5553.40	0+86.35	GAS	4"	PE
I	5553.68	1+93.39	STM	18"	RCP
J	5547.70	2+16.10	STM	120"x72"	RCP
K	5555.20	2+44.82	UGE	(2) 2"	PVC
L	5555.30	2+81.24	UGE	(3) 1"	PVC
M	5547.76	3+57.00	FO	2"	PVC
N	5552.60	3+83.25	FO	4"	PVC

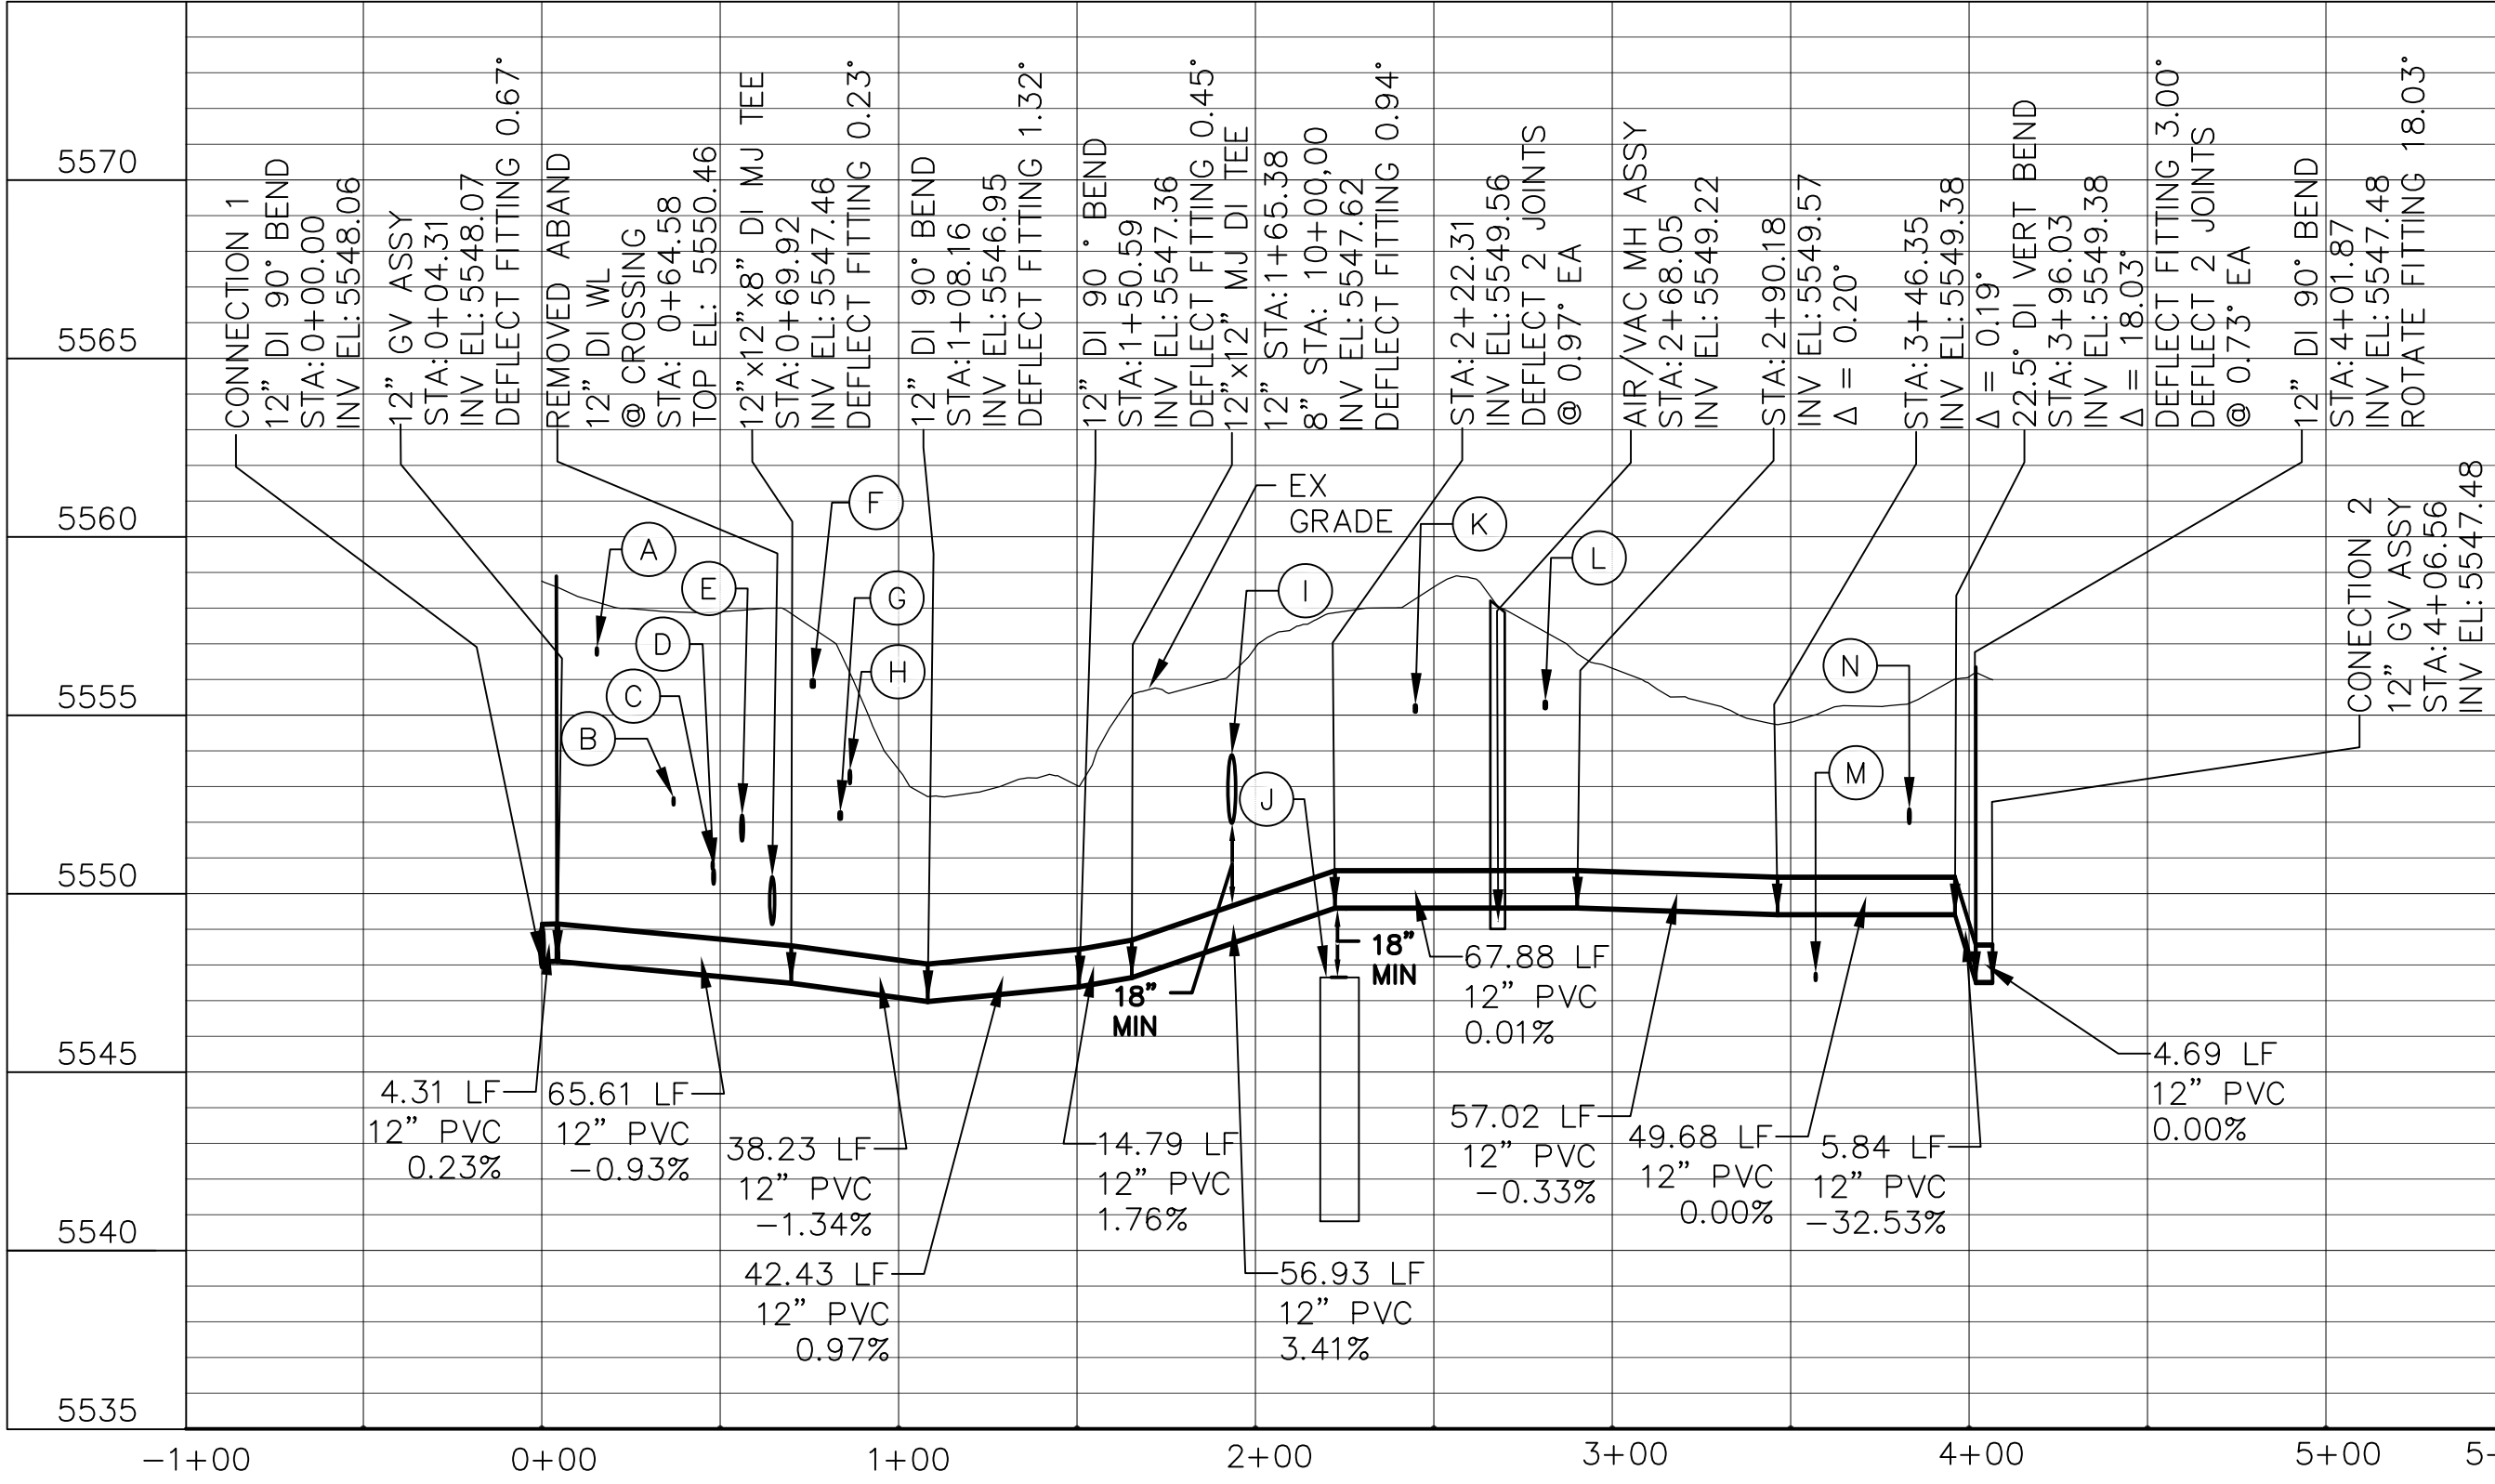

NORTH CONNECTION 12" WATER LINE – PROFILE VIEW  
HORIZONTAL SCALE: 1" = 50'  
VERTICAL SCALE: 1" = 5'

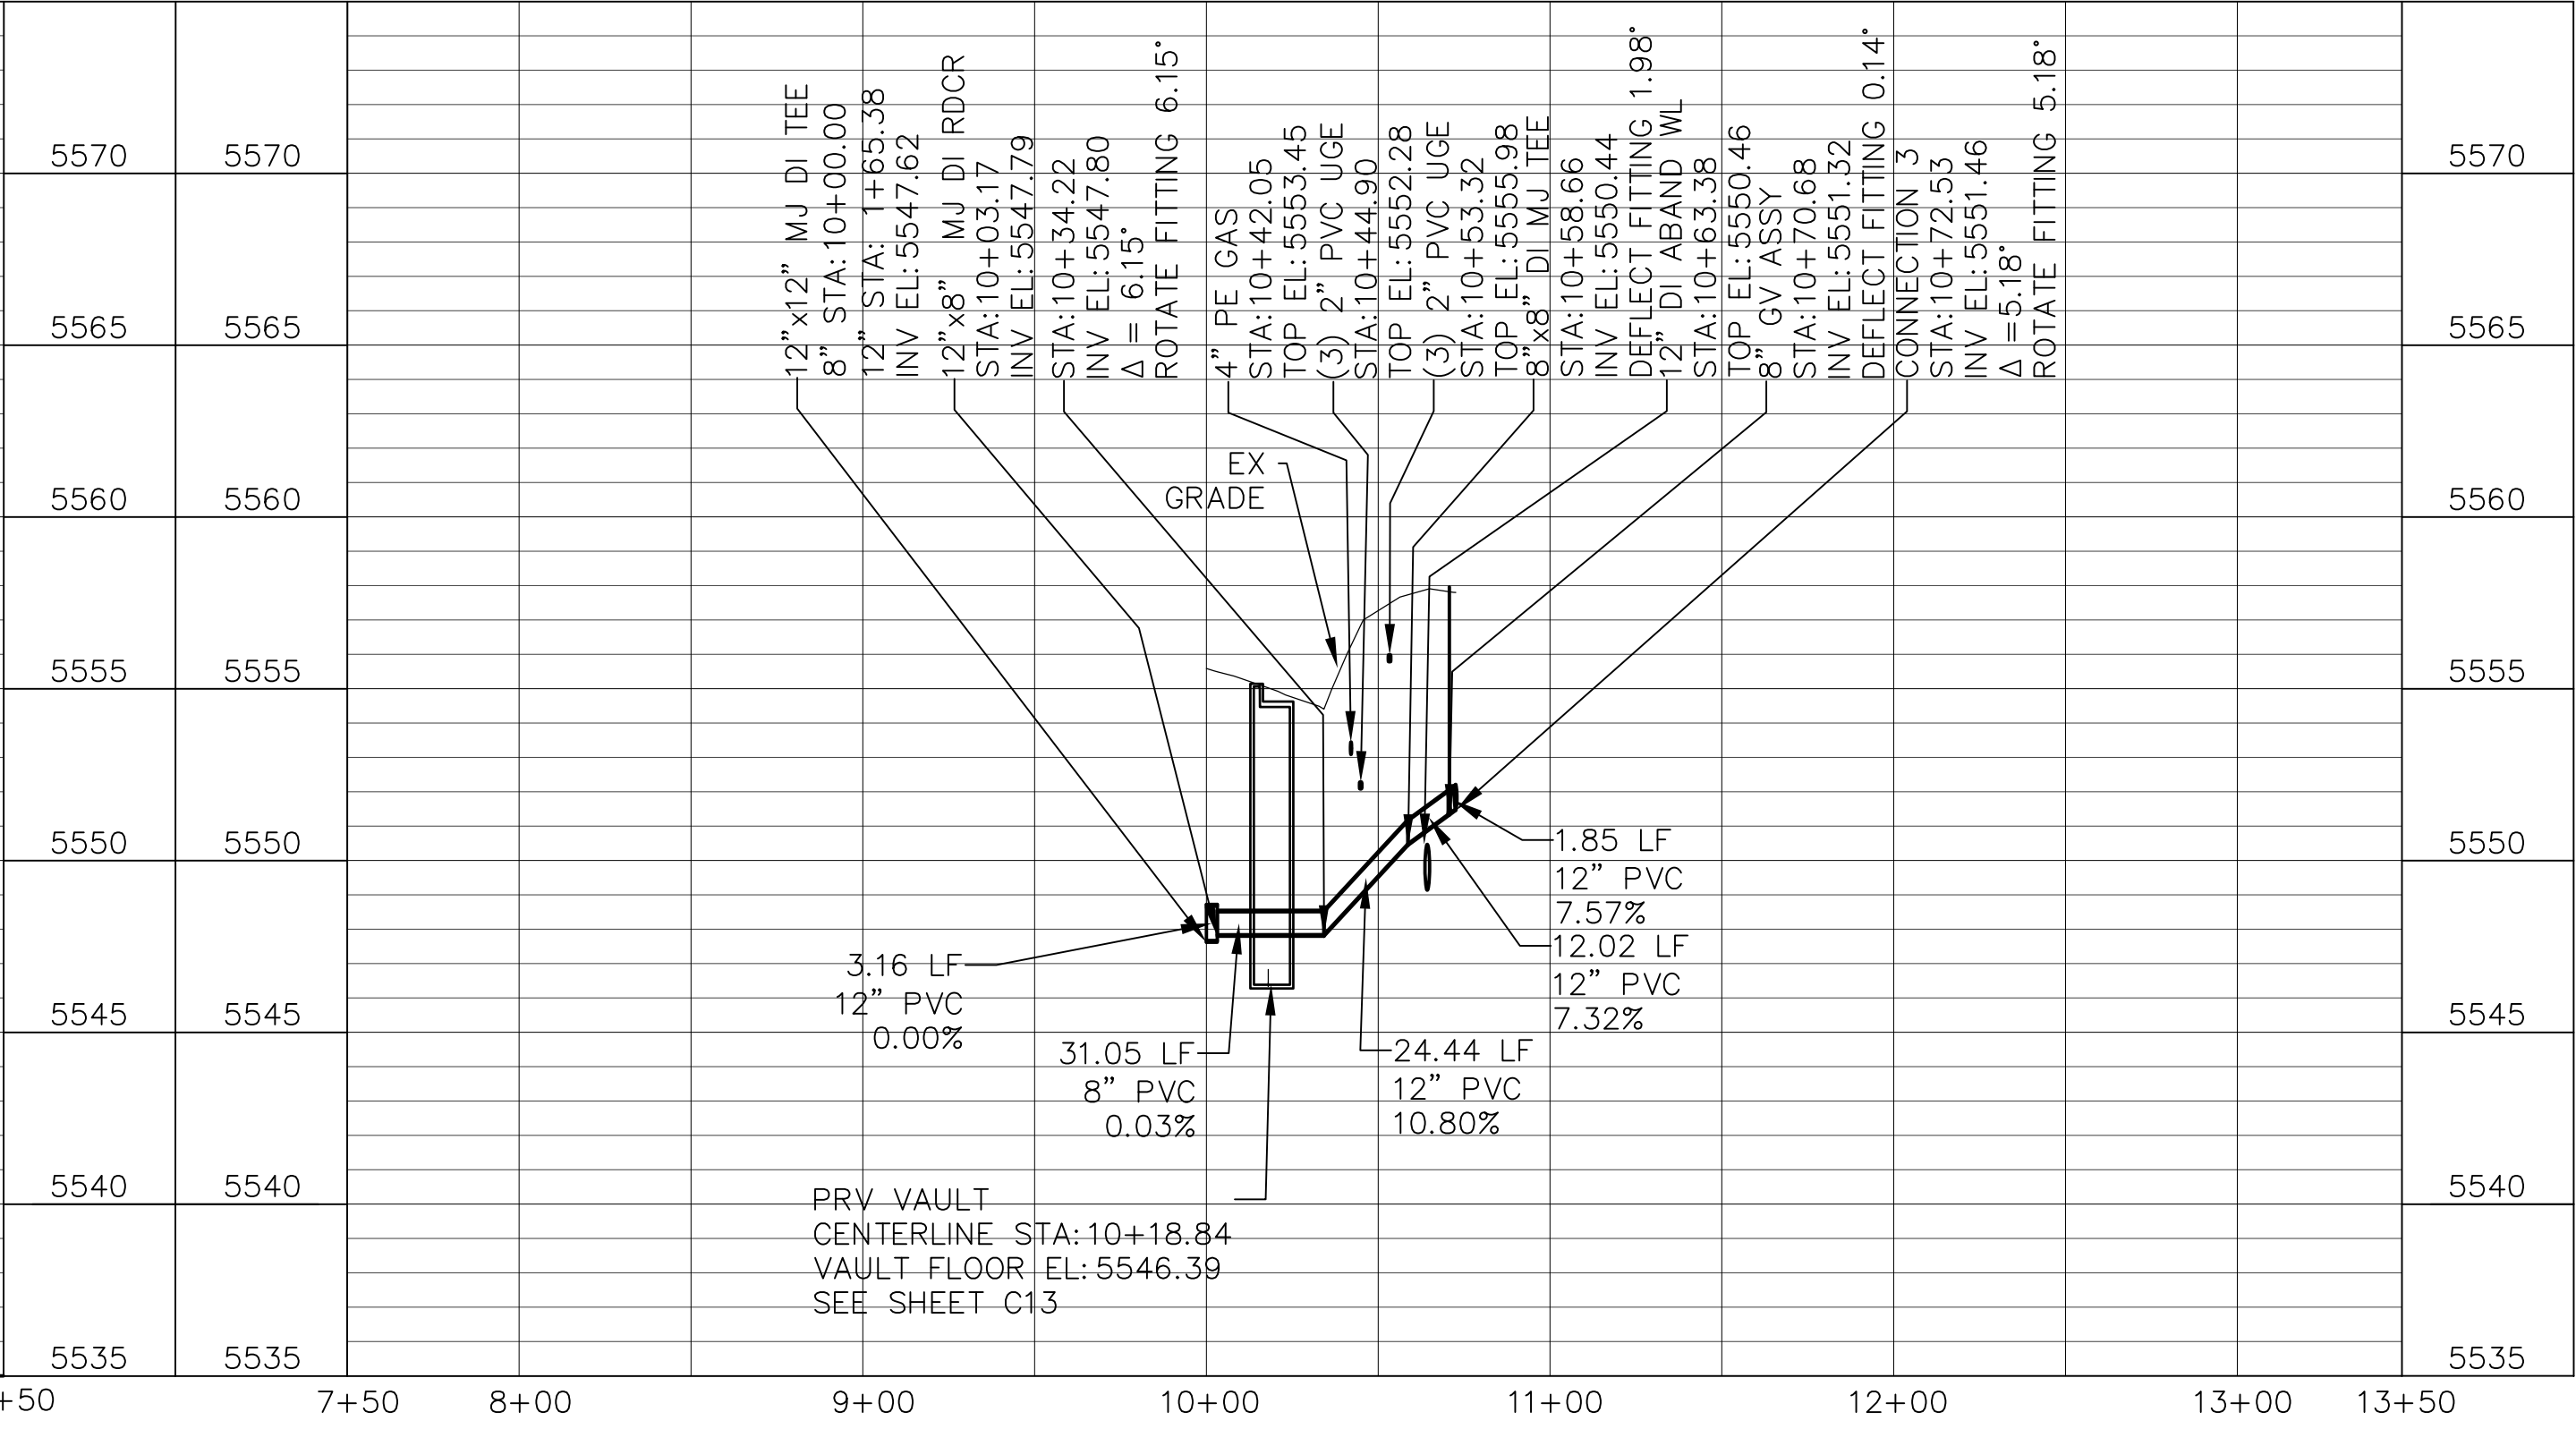


NORTH CONNECTION 8" WATER LINE – PROFILE VIEW  
HORIZONTAL SCALE: 1" = 50'  
VERTICAL SCALE: 1" = 5'

AS-BUILTS

ROXBOROUGH WATER AND SANITATION DISTRICT  
RAVENNA PHASE II WATER CONNECTION INFRASTRUCTURE

NORTH CONNECTION PROFILE - SHEET 1 OF 1

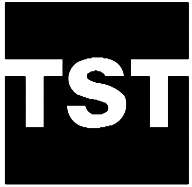

TST INFRASTRUCTURE, LLC  
Consulting Engineers

DATE: **NOVEMBER 2019**

JOB NO. **001.335.01**

**RWSD**

DRAWING NO.

**C4**

DESIGNED: **JDB**

CHECKED: **MKM**

DRAWN: **SDH**

1 INCH  
1 INCH x 1 INCH  
AT FULL SCALE  
1 INCH

REVISIONS



AS-BUILT

DATE  
11/22/2019

BY  
ACP


H:\Drawings\Roxborough\001.335.00 - Ravenna WS Impr Design\Sheets\Civil\C5.dwg, C5, 12/10/2019 10:10 AM

- NOTES:
1. AVOID DISTURBANCE OF GOLF TEE BOX, TRAIL, & STAIRS.
  2. EXISTING IRRIGATION UTILITIES WILL BE PUT OUT OF SERVICE BY OWNER PRIOR TO EXCAVATION BY CONTRACTOR AND REPAIRED BY OWNER. CONTRACTOR TO CLEARLY MARK LOCATION + DEPTH OF ENCOUNTERED IRRIGATION LINES.
  3. CONTRACTOR SHALL VERIFY LOCATION, SIZE, AND MATERIAL OF WATER LINES PRIOR TO MAKING CONNECTIONS.
  4. CONTRACTOR TO COORDINATE OPERATION OF EXISTING GATE VALVES WITH RWSD FOR SHUTDOWNS AND TIE-INS TO EXISTING SYSTEM.

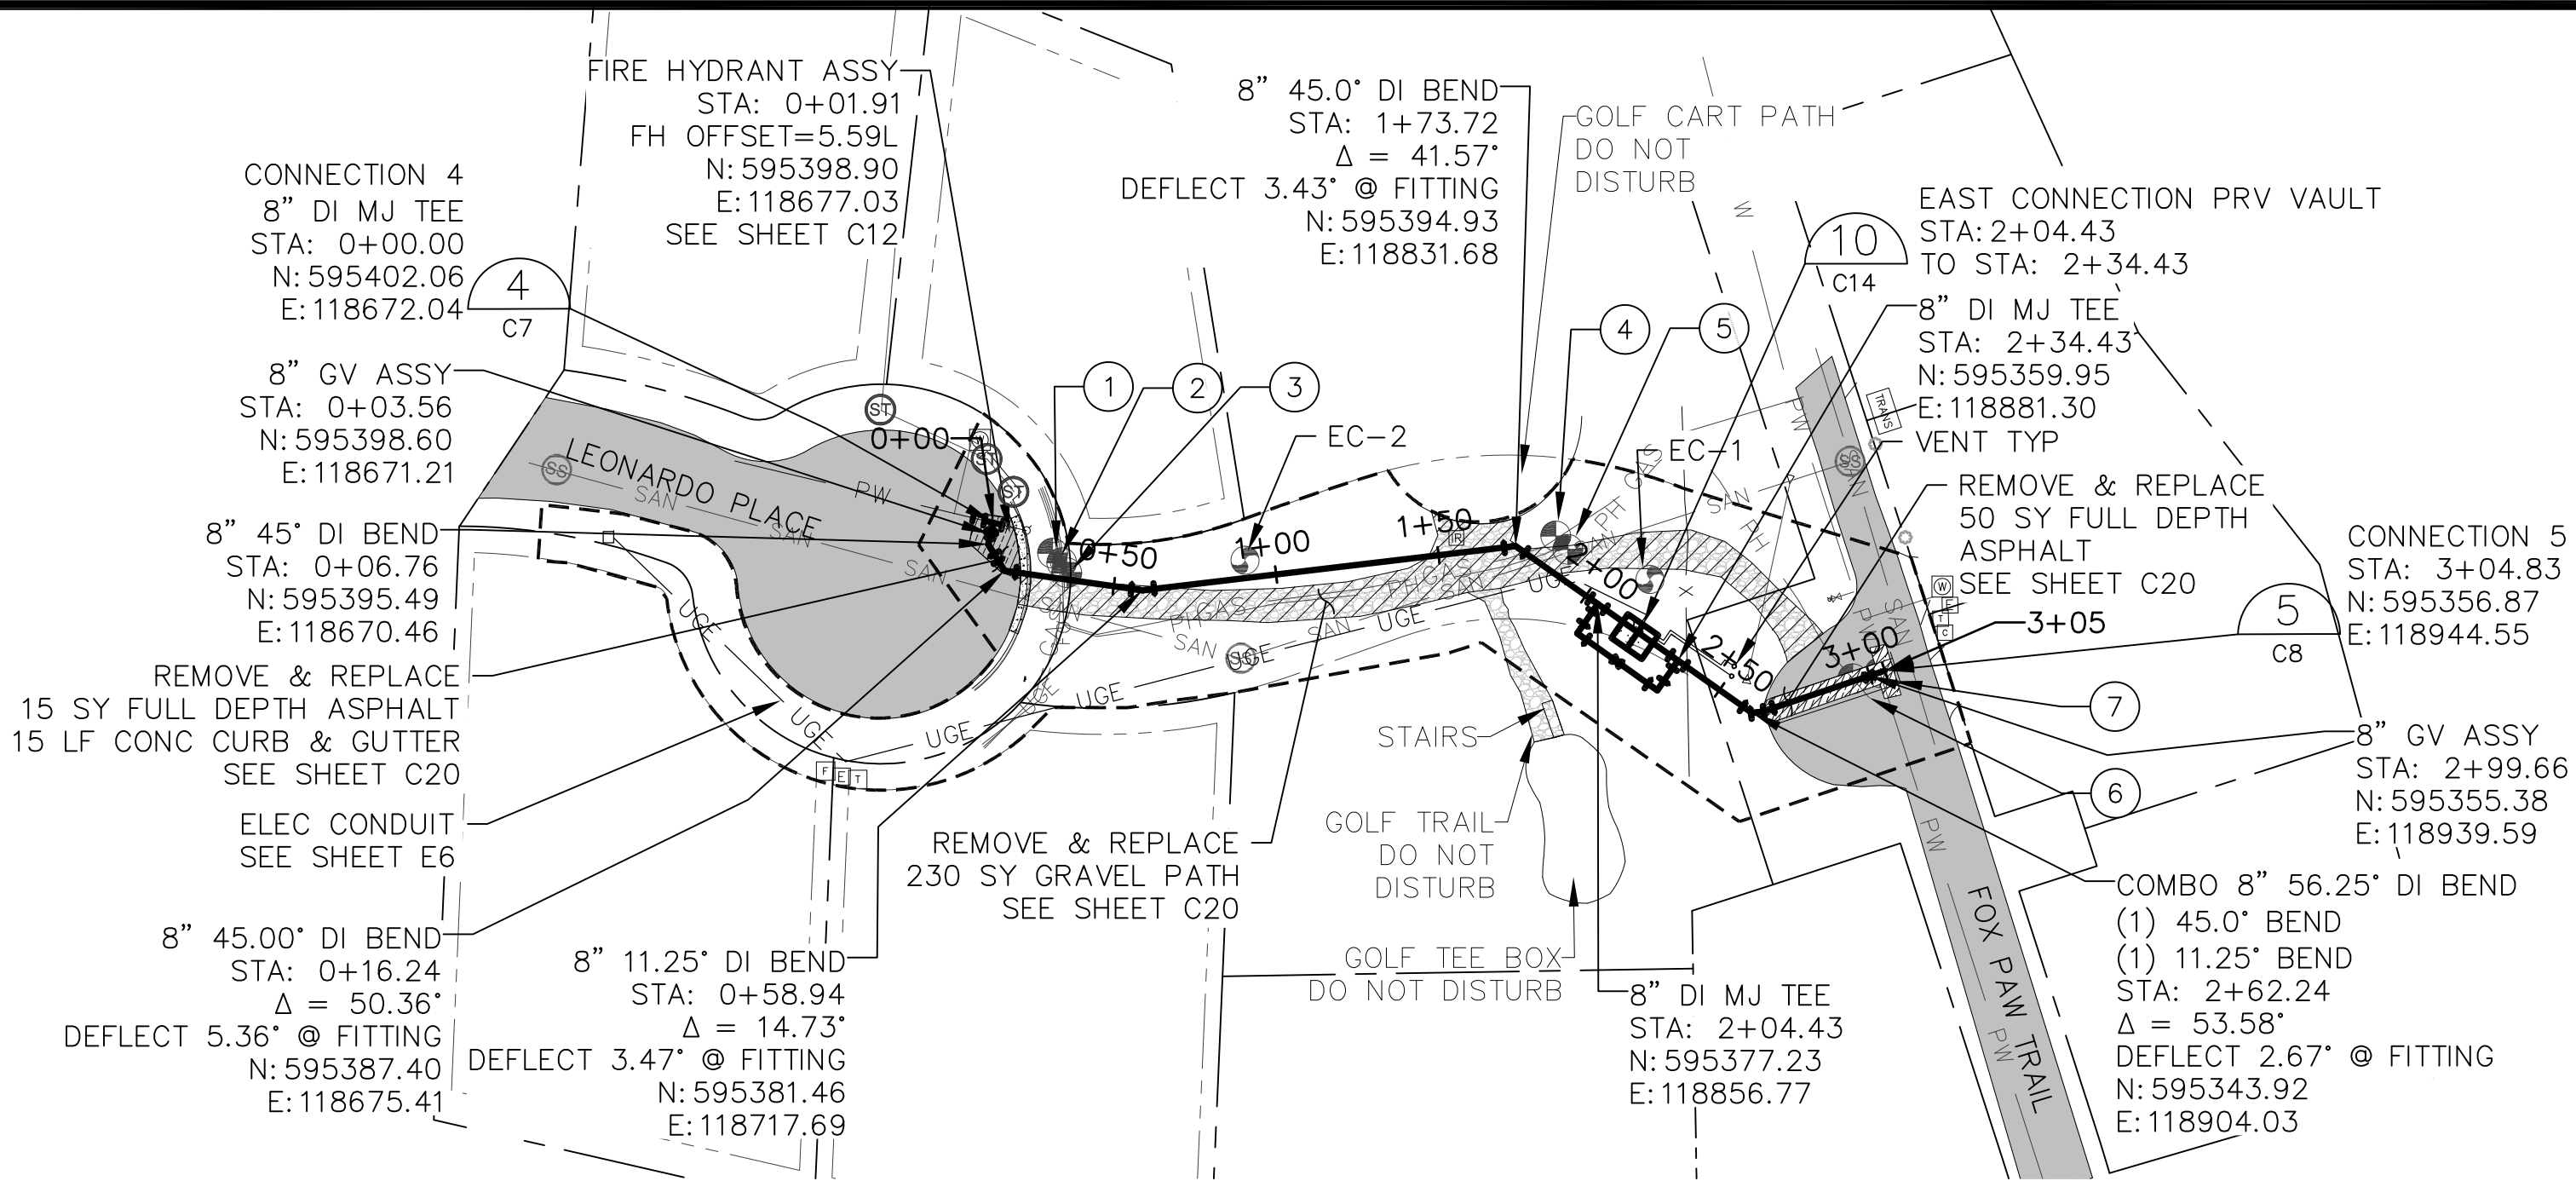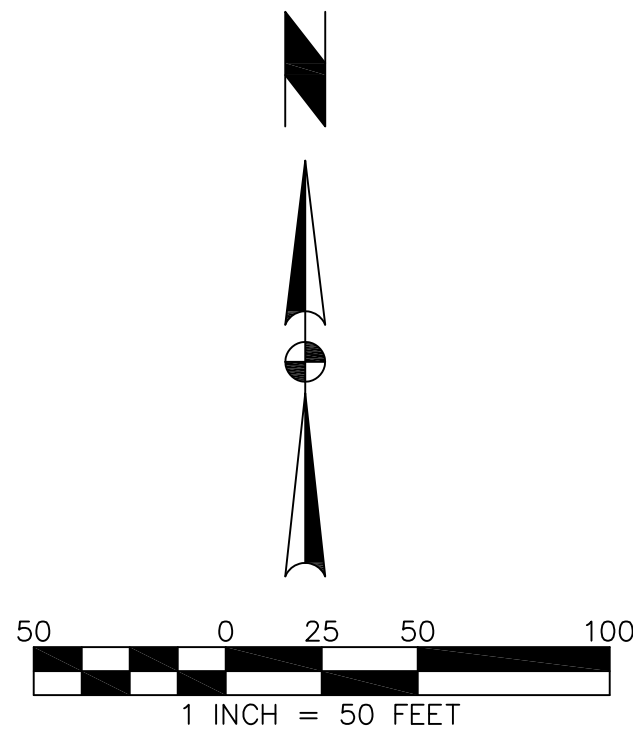

EAST CONNECTION WATER LINE – PLAN VIEW  
SCALE: 1" = 50'

POTHOLE INFORMATION				
POTHOLE	UTILITY	DEPTH TOP	UTILITY TOP EL	DIA/MATL
①	UGE	49"	±5858.38	2" PVC
②	TELE	50"	±5858.17	(2) 4" PVC
③	GAS	36"	±5859.28	2" PE
④	GAS	45"	±5841.90	1" PE
⑤	PH	46"	±5841.60	2" PVC
⑥	CTV	23"	±5835.88	2" PVC
⑦	WL	67"	±5832.30	6" AC

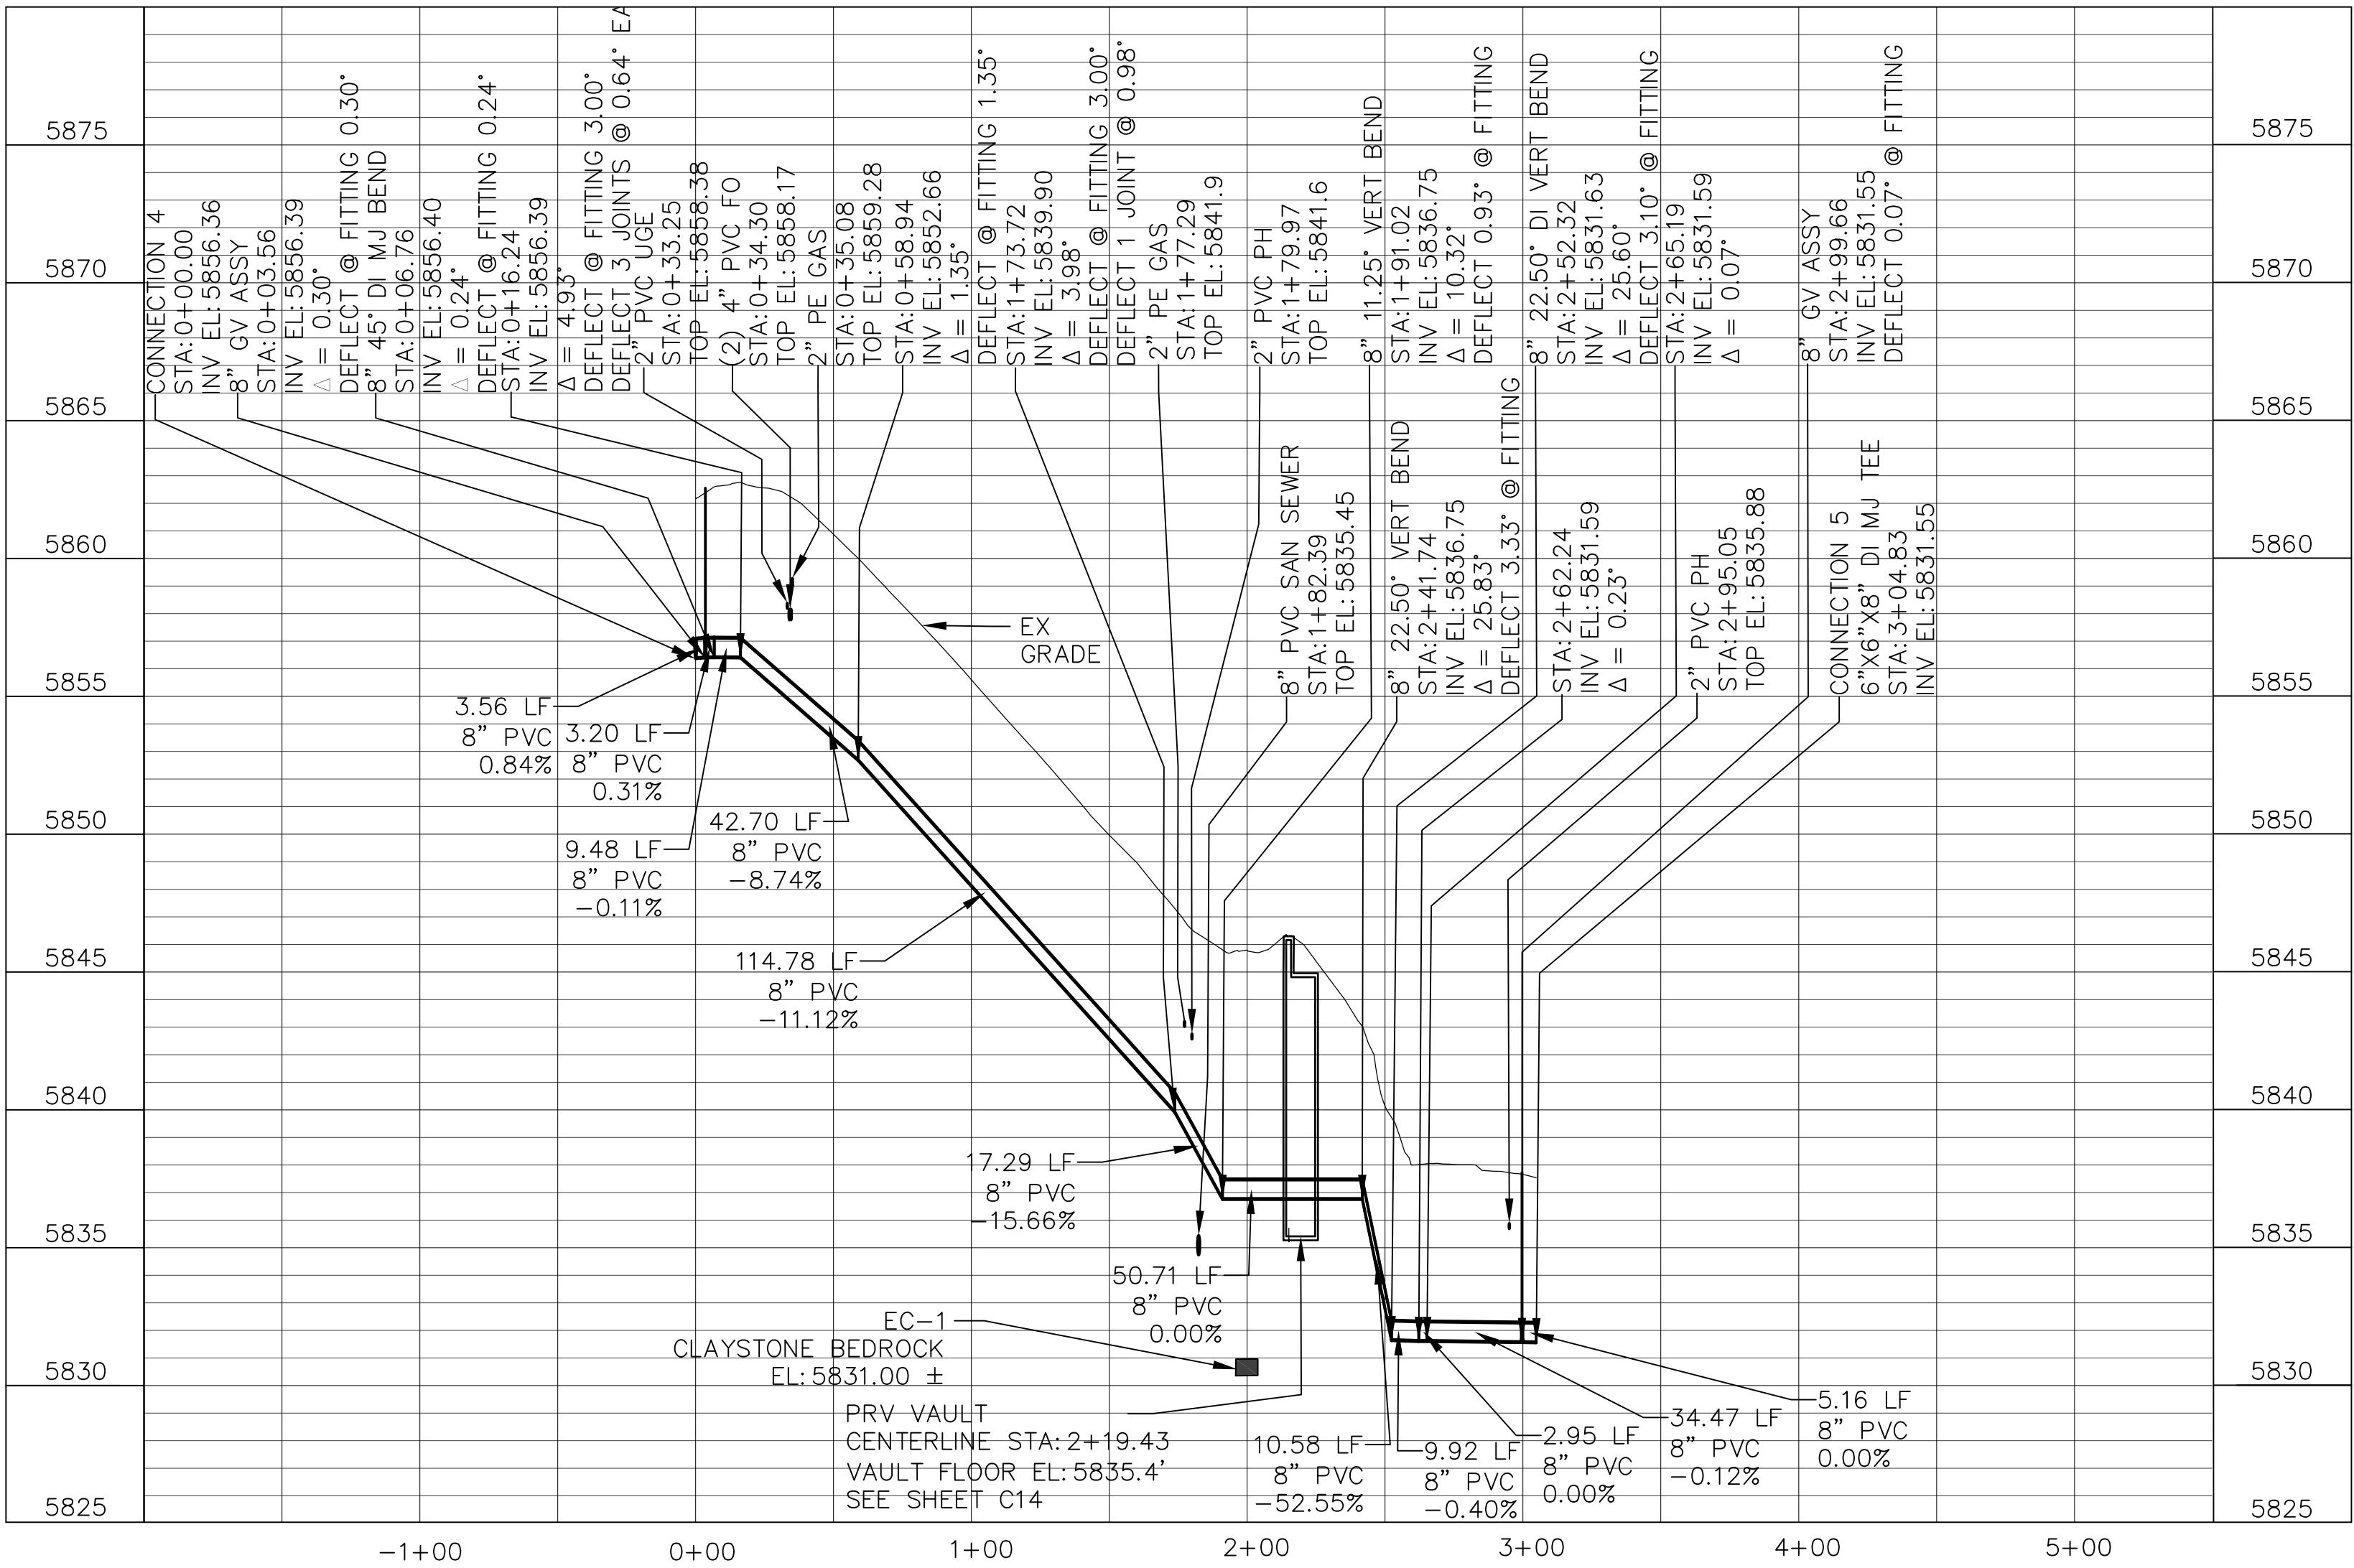

EAST CONNECTION WATER LINE – PROFILE VIEW  
HORIZONTAL SCALE: 1" = 50'  
VERTICAL SCALE: 1" = 5'

AS-BUILTS

ROXBOROUGH WATER AND SANITATION DISTRICT  
RAVENNA PHASE II WATER CONNECTION INFRASTRUCTURE

EAST CONNECTION PLAN AND PROFILE - SHEET 1 OF 1



TST INFRASTRUCTURE, LLC  
Consulting Engineers

DATE: NOVEMBER 2019


JOB NO. 001.335.01

RWSD


DRAWING NO.

C5


H:\Drawings\Roxborough\001.335.00 - Ravenna WS Impr Design\Sheets\Civil\Civil Details In Progress.dwg, C6, 12/10/2019 10:10 AM

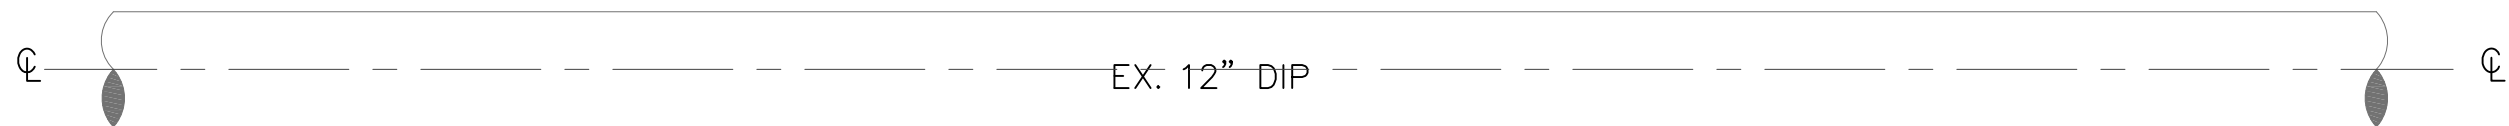

EXISTING CONFIGURATION

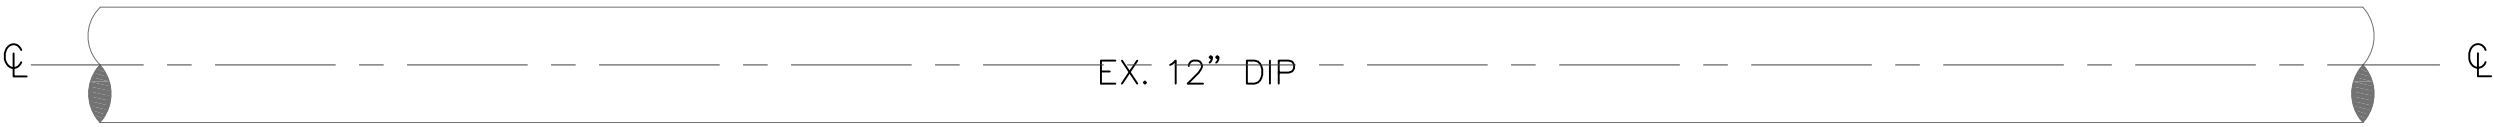


EXISTING CONFIGURATION

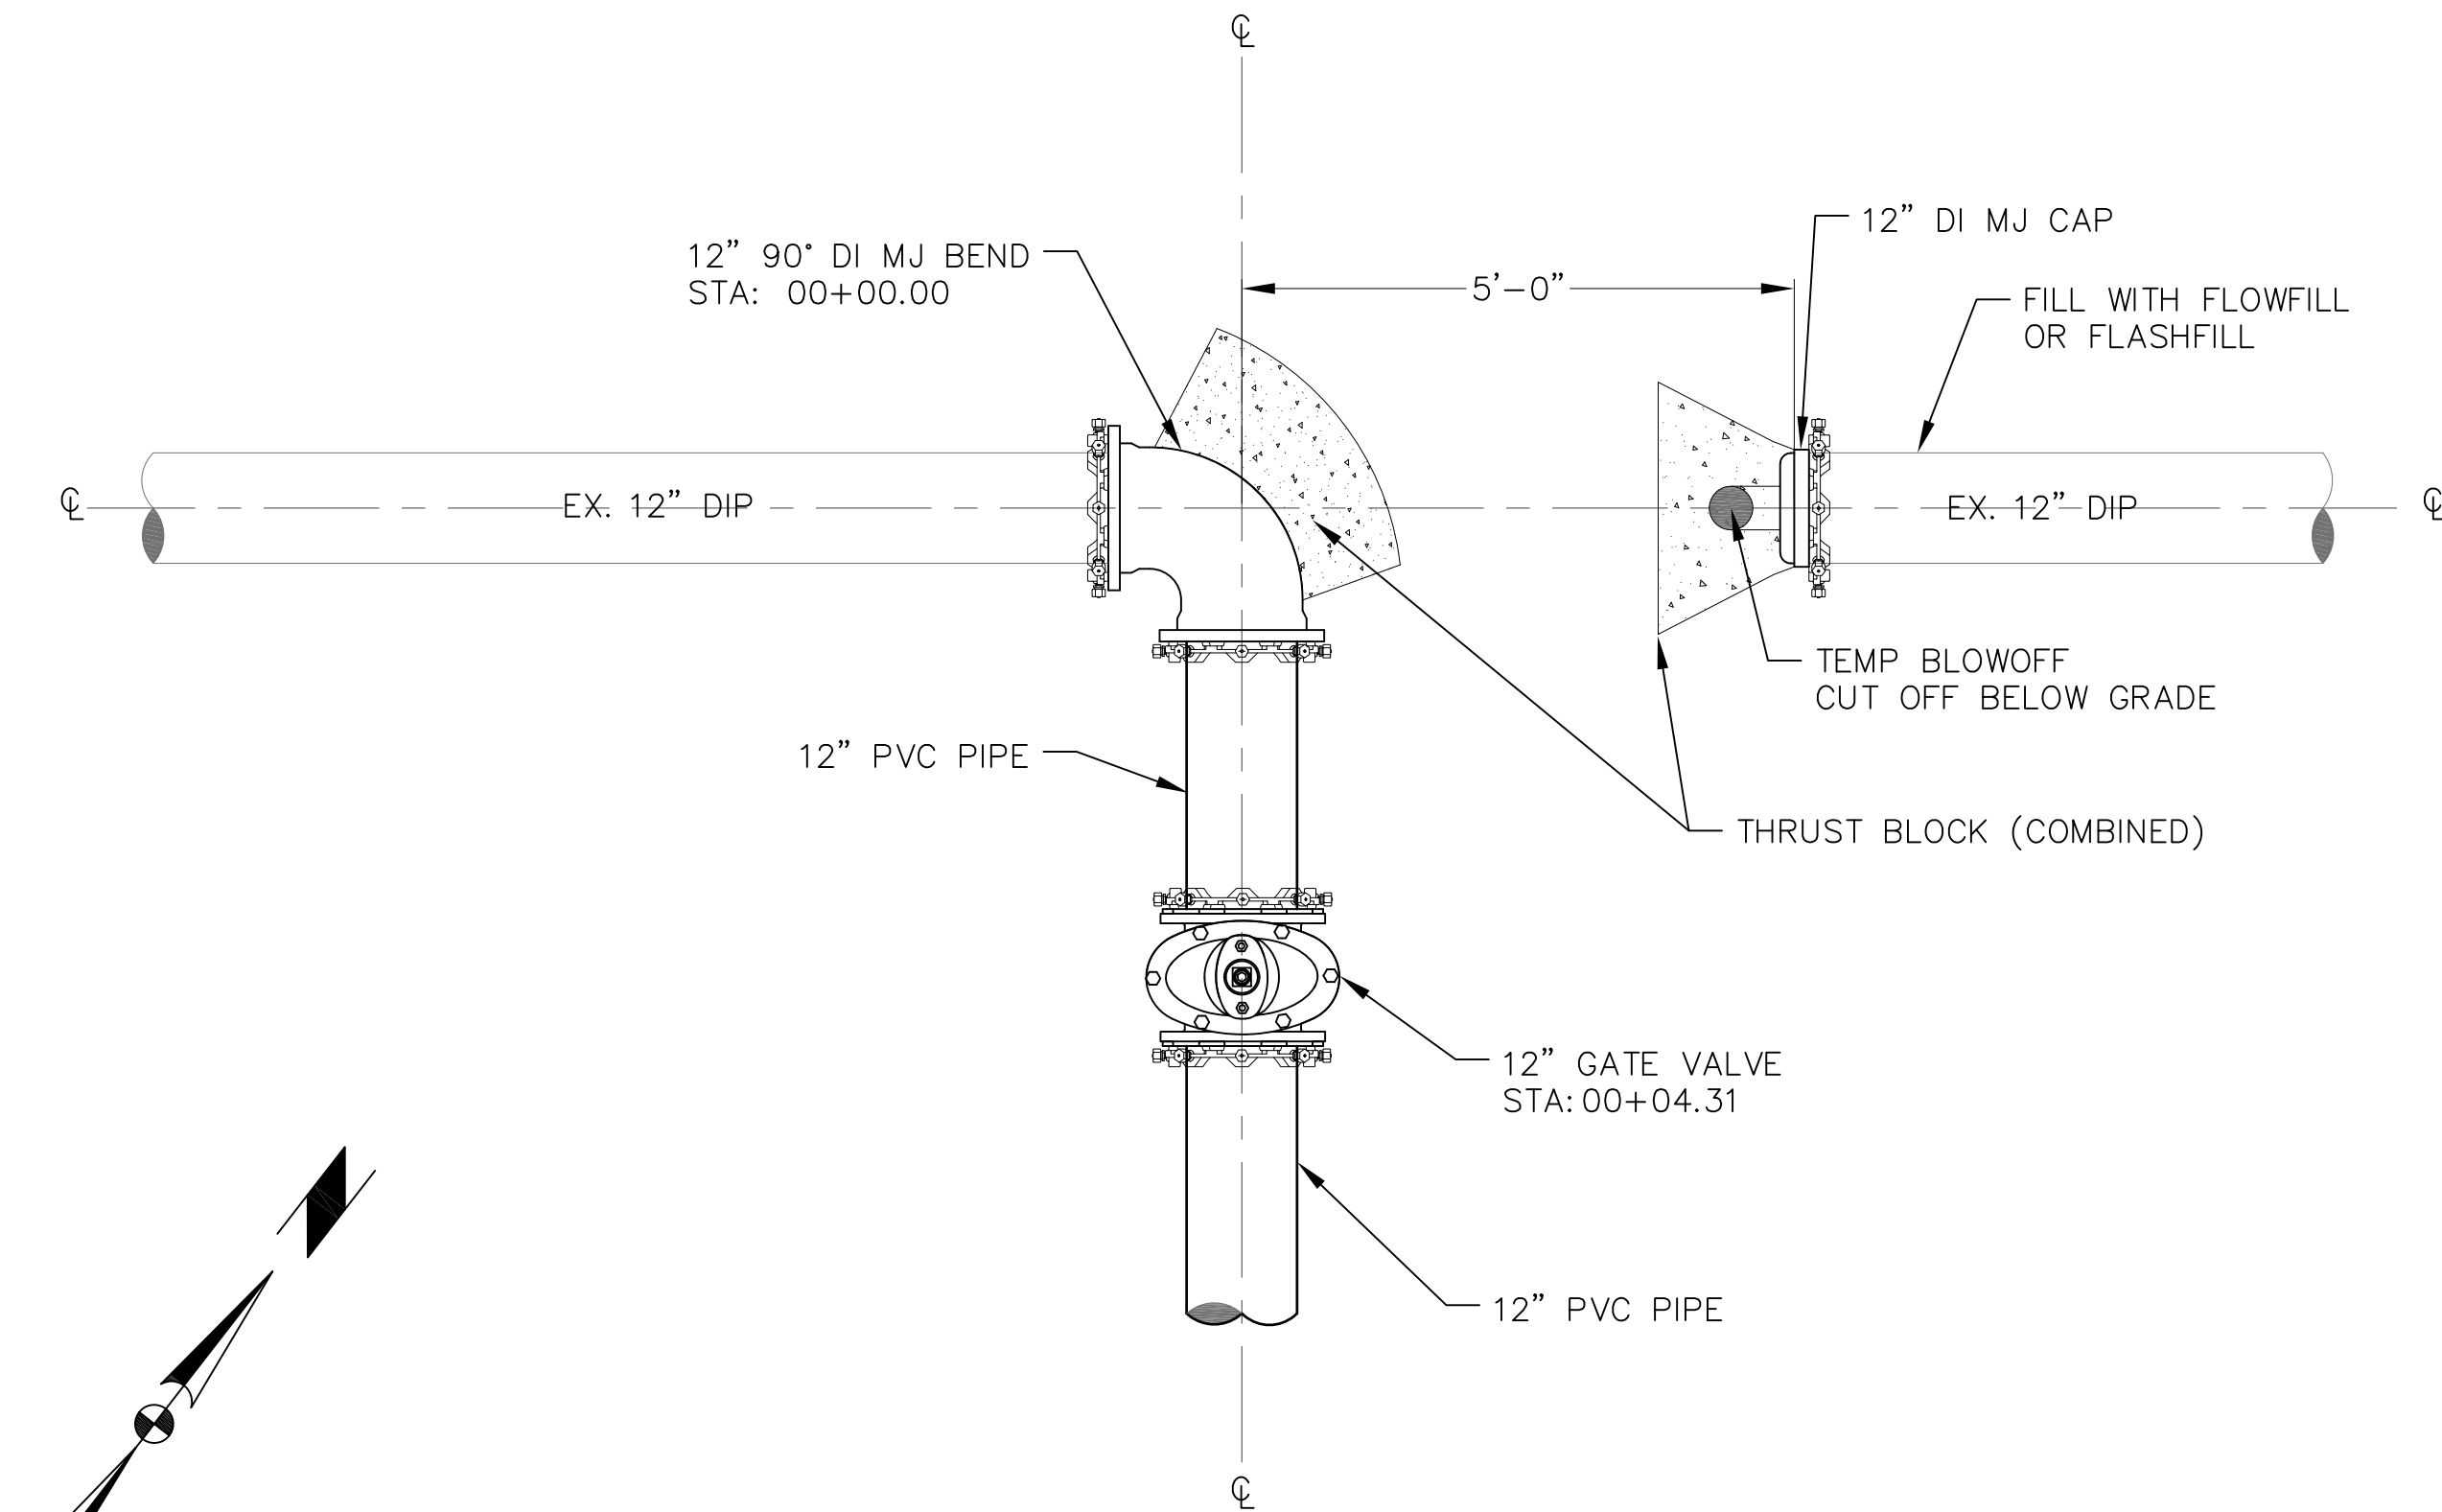

FINAL CONFIGURATION

1 CONNECTION 1 DETAIL  
C3 1" = 20'

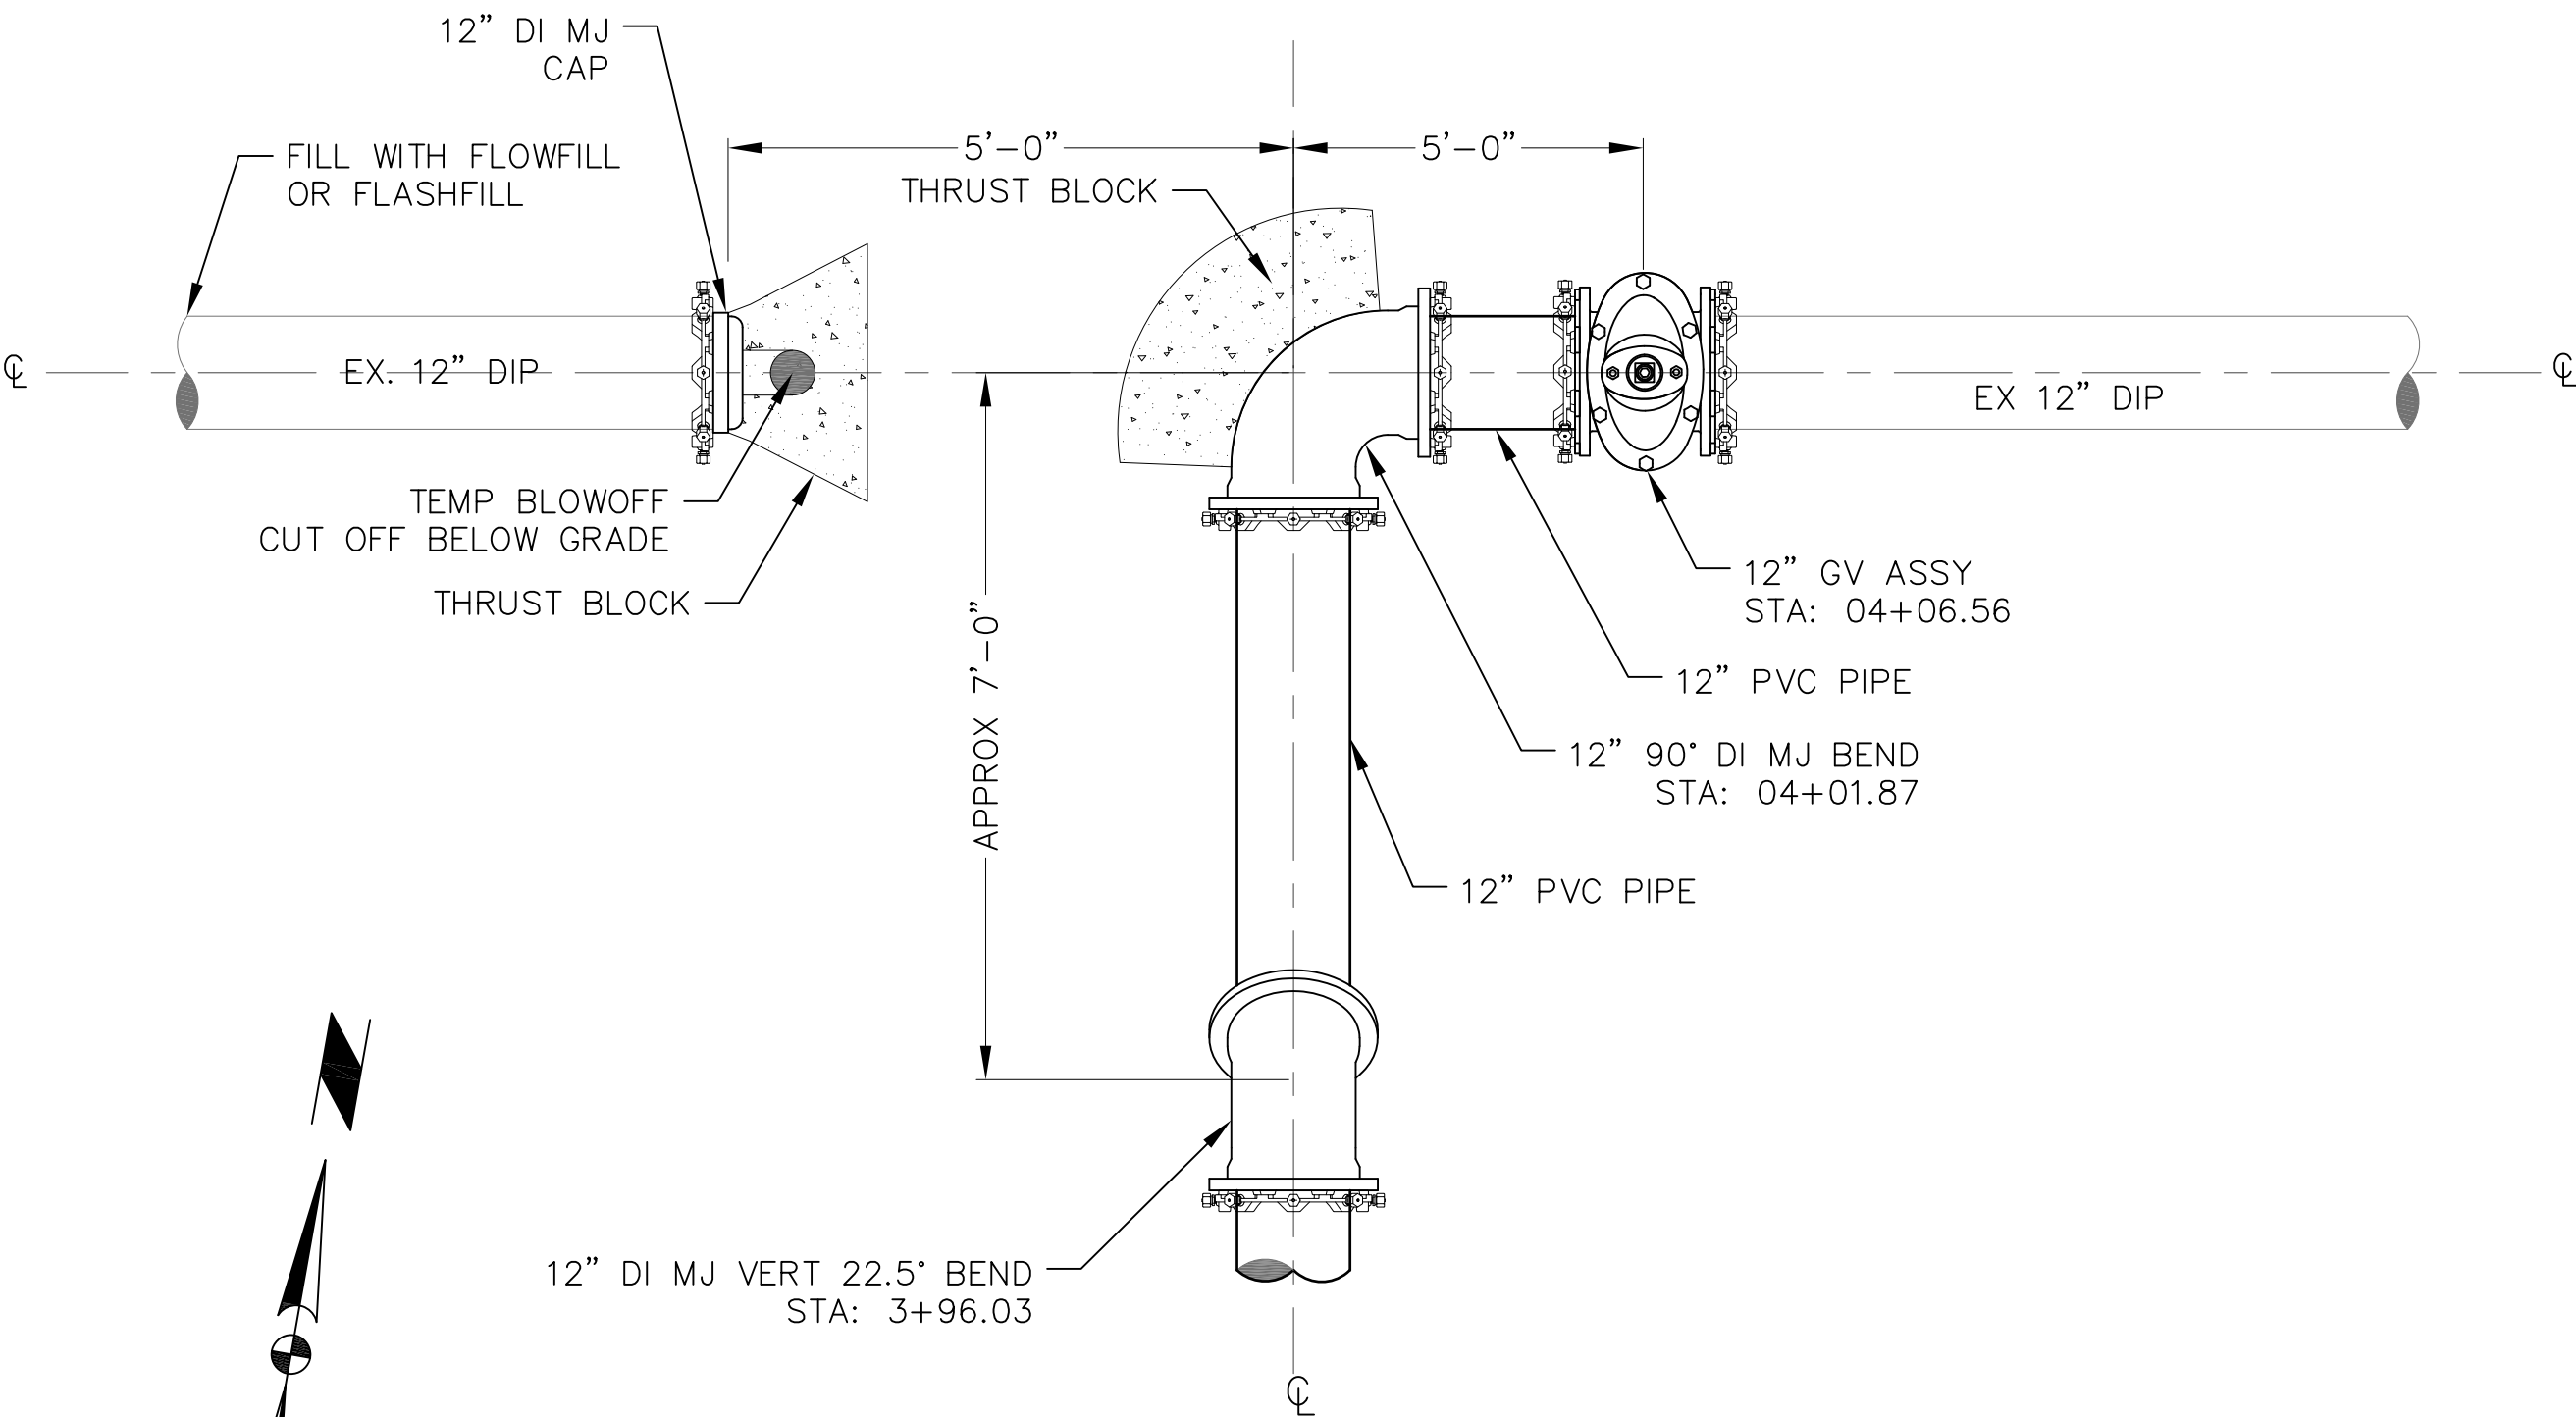

FINAL CONFIGURATION

2 CONNECTION 2 DETAIL  
C3 1" = 20'

AS-BUILTS

REVISIONS	DESCRIPTION	DATE	BY
AS-BUILT		11/22/2019	ACP

DESIGNED:	JDB
CHECKED:	MKM
DRAWING:	SDH

1 INCH	BARS PLOT
1 INCH	1 INCH x 1 INCH
1 INCH	AT FULL SCALE

ROXBOROUGH WATER AND SANITATION DISTRICT  
RAVENNA PHASE II WATER CONNECTION INFRASTRUCTURE  
WATER LINE CONNECTION DETAILS - SHEET 1 OF 4


TST

TST INFRASTRUCTURE, LLC  
Consulting Engineers


DATE	NOVEMBER 2019
JOB NO.	001.335.01
	RWSD

DRAWING NO.  
C6

H:\Drawings\Roxborough\001.335.00 - Ravenna WS Impr Design\Sheets\Civil\Civil Details In Progress.dwg, C7, 12/10/2019 10:11 AM

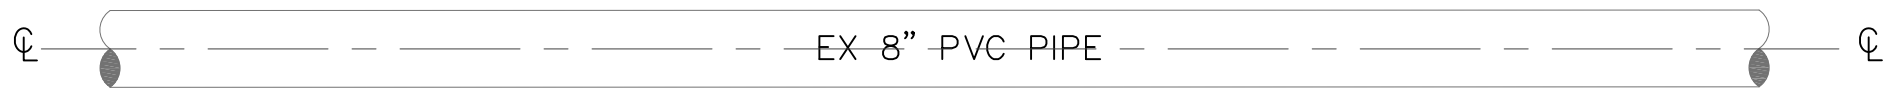


EXISTING CONFIGURATION

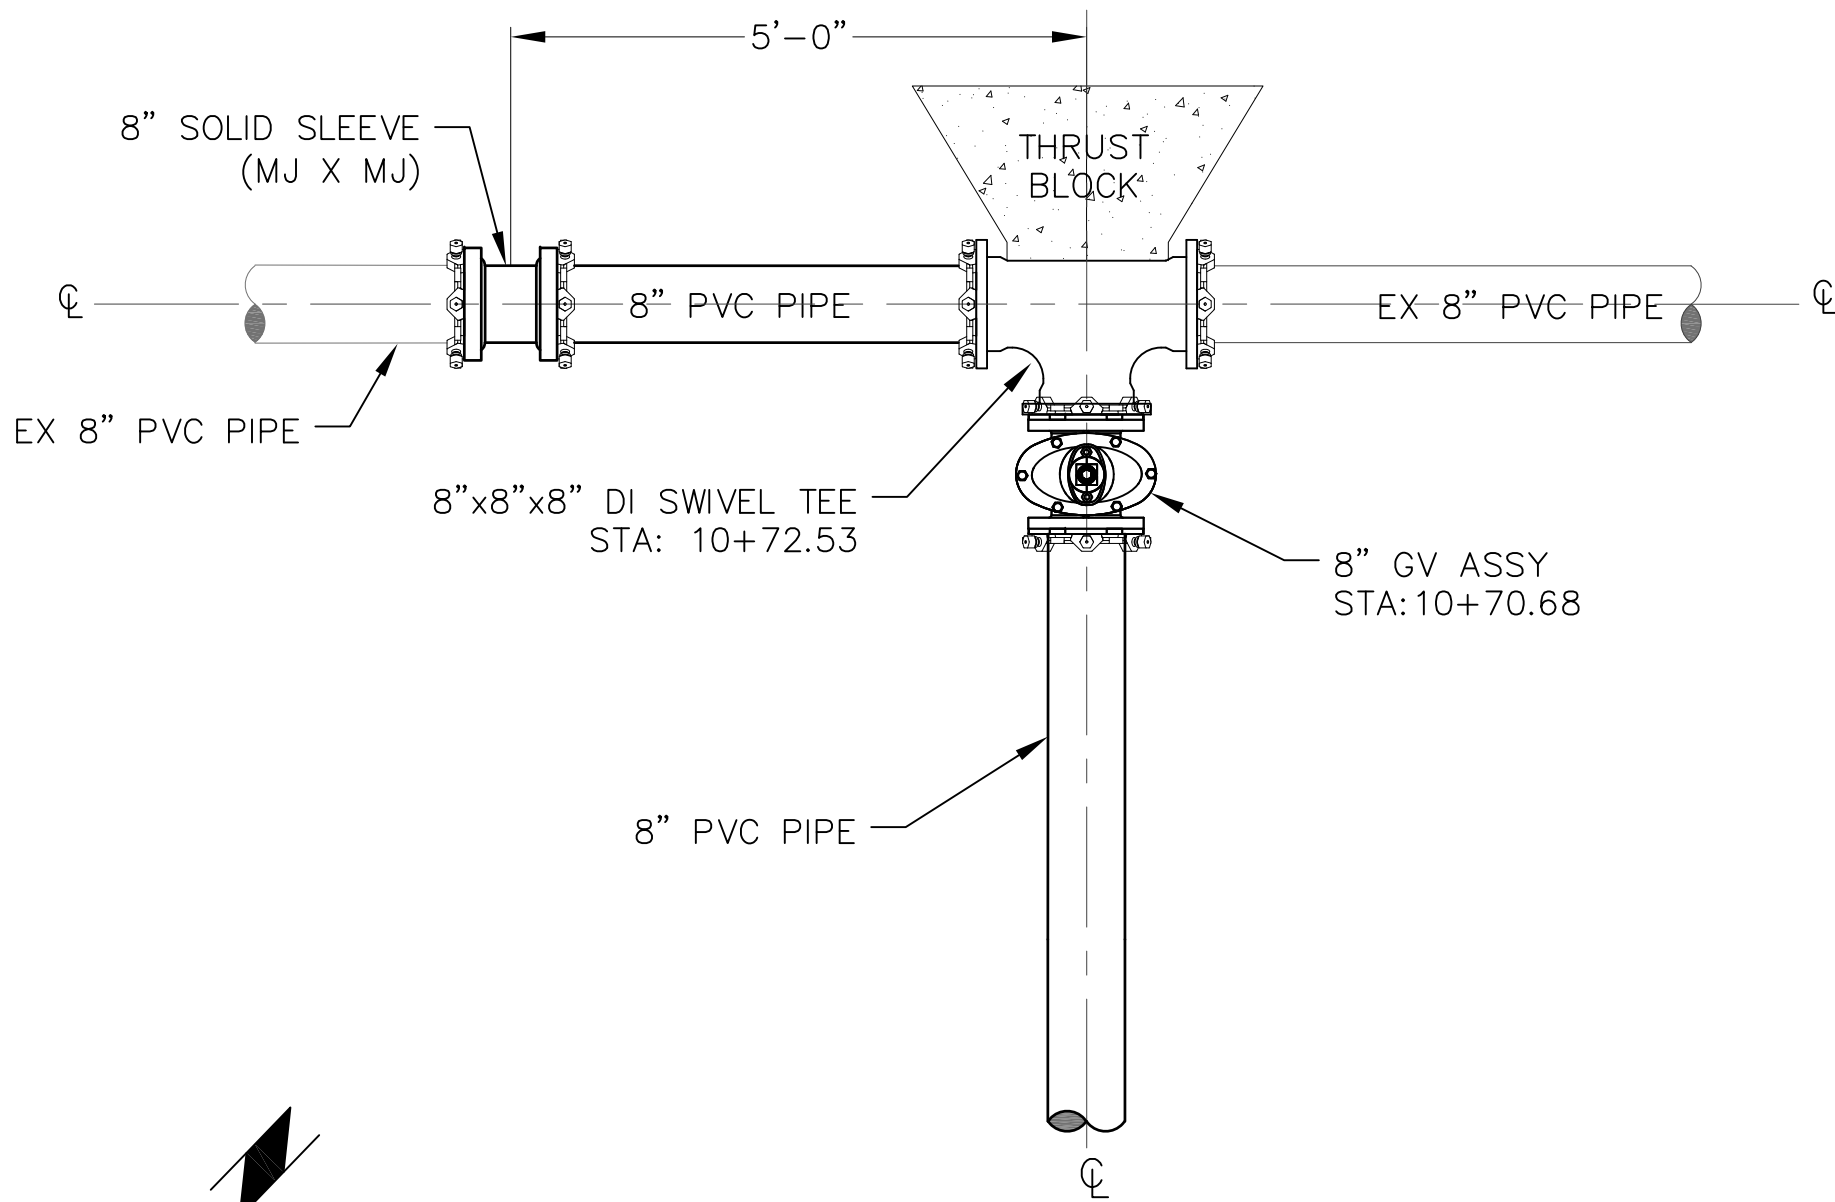


FINAL CONFIGURATION

**3**  
C3 CONNECTION 3 DETAIL  
1" = 20'

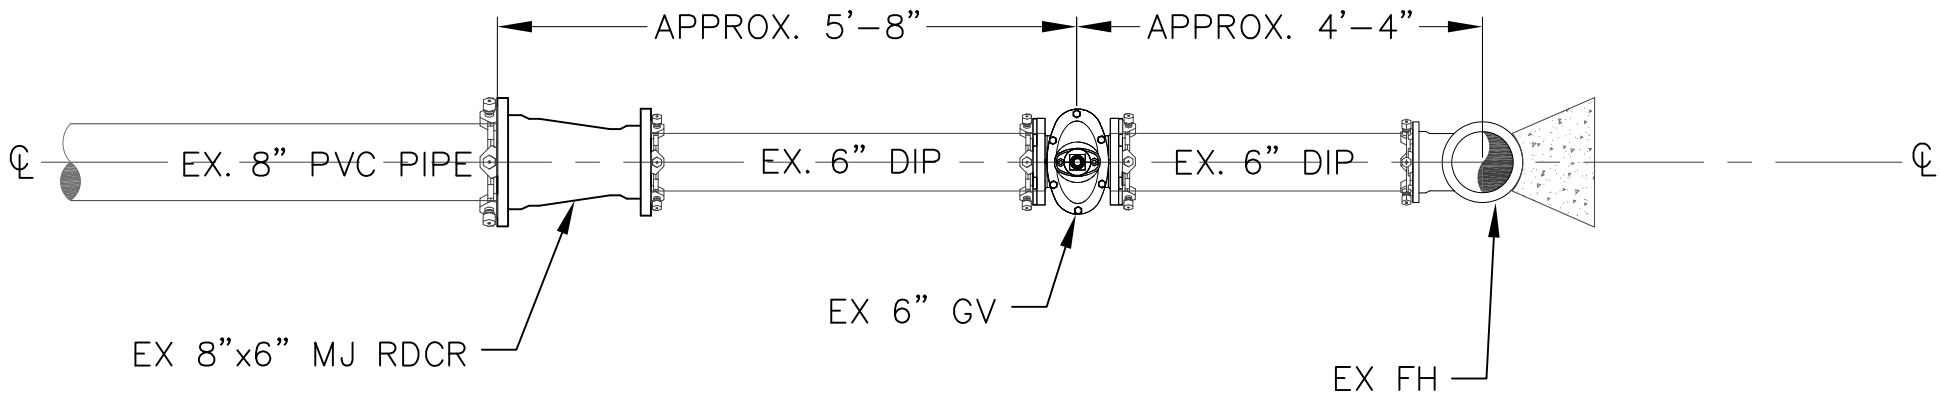

EXISTING CONFIGURATION

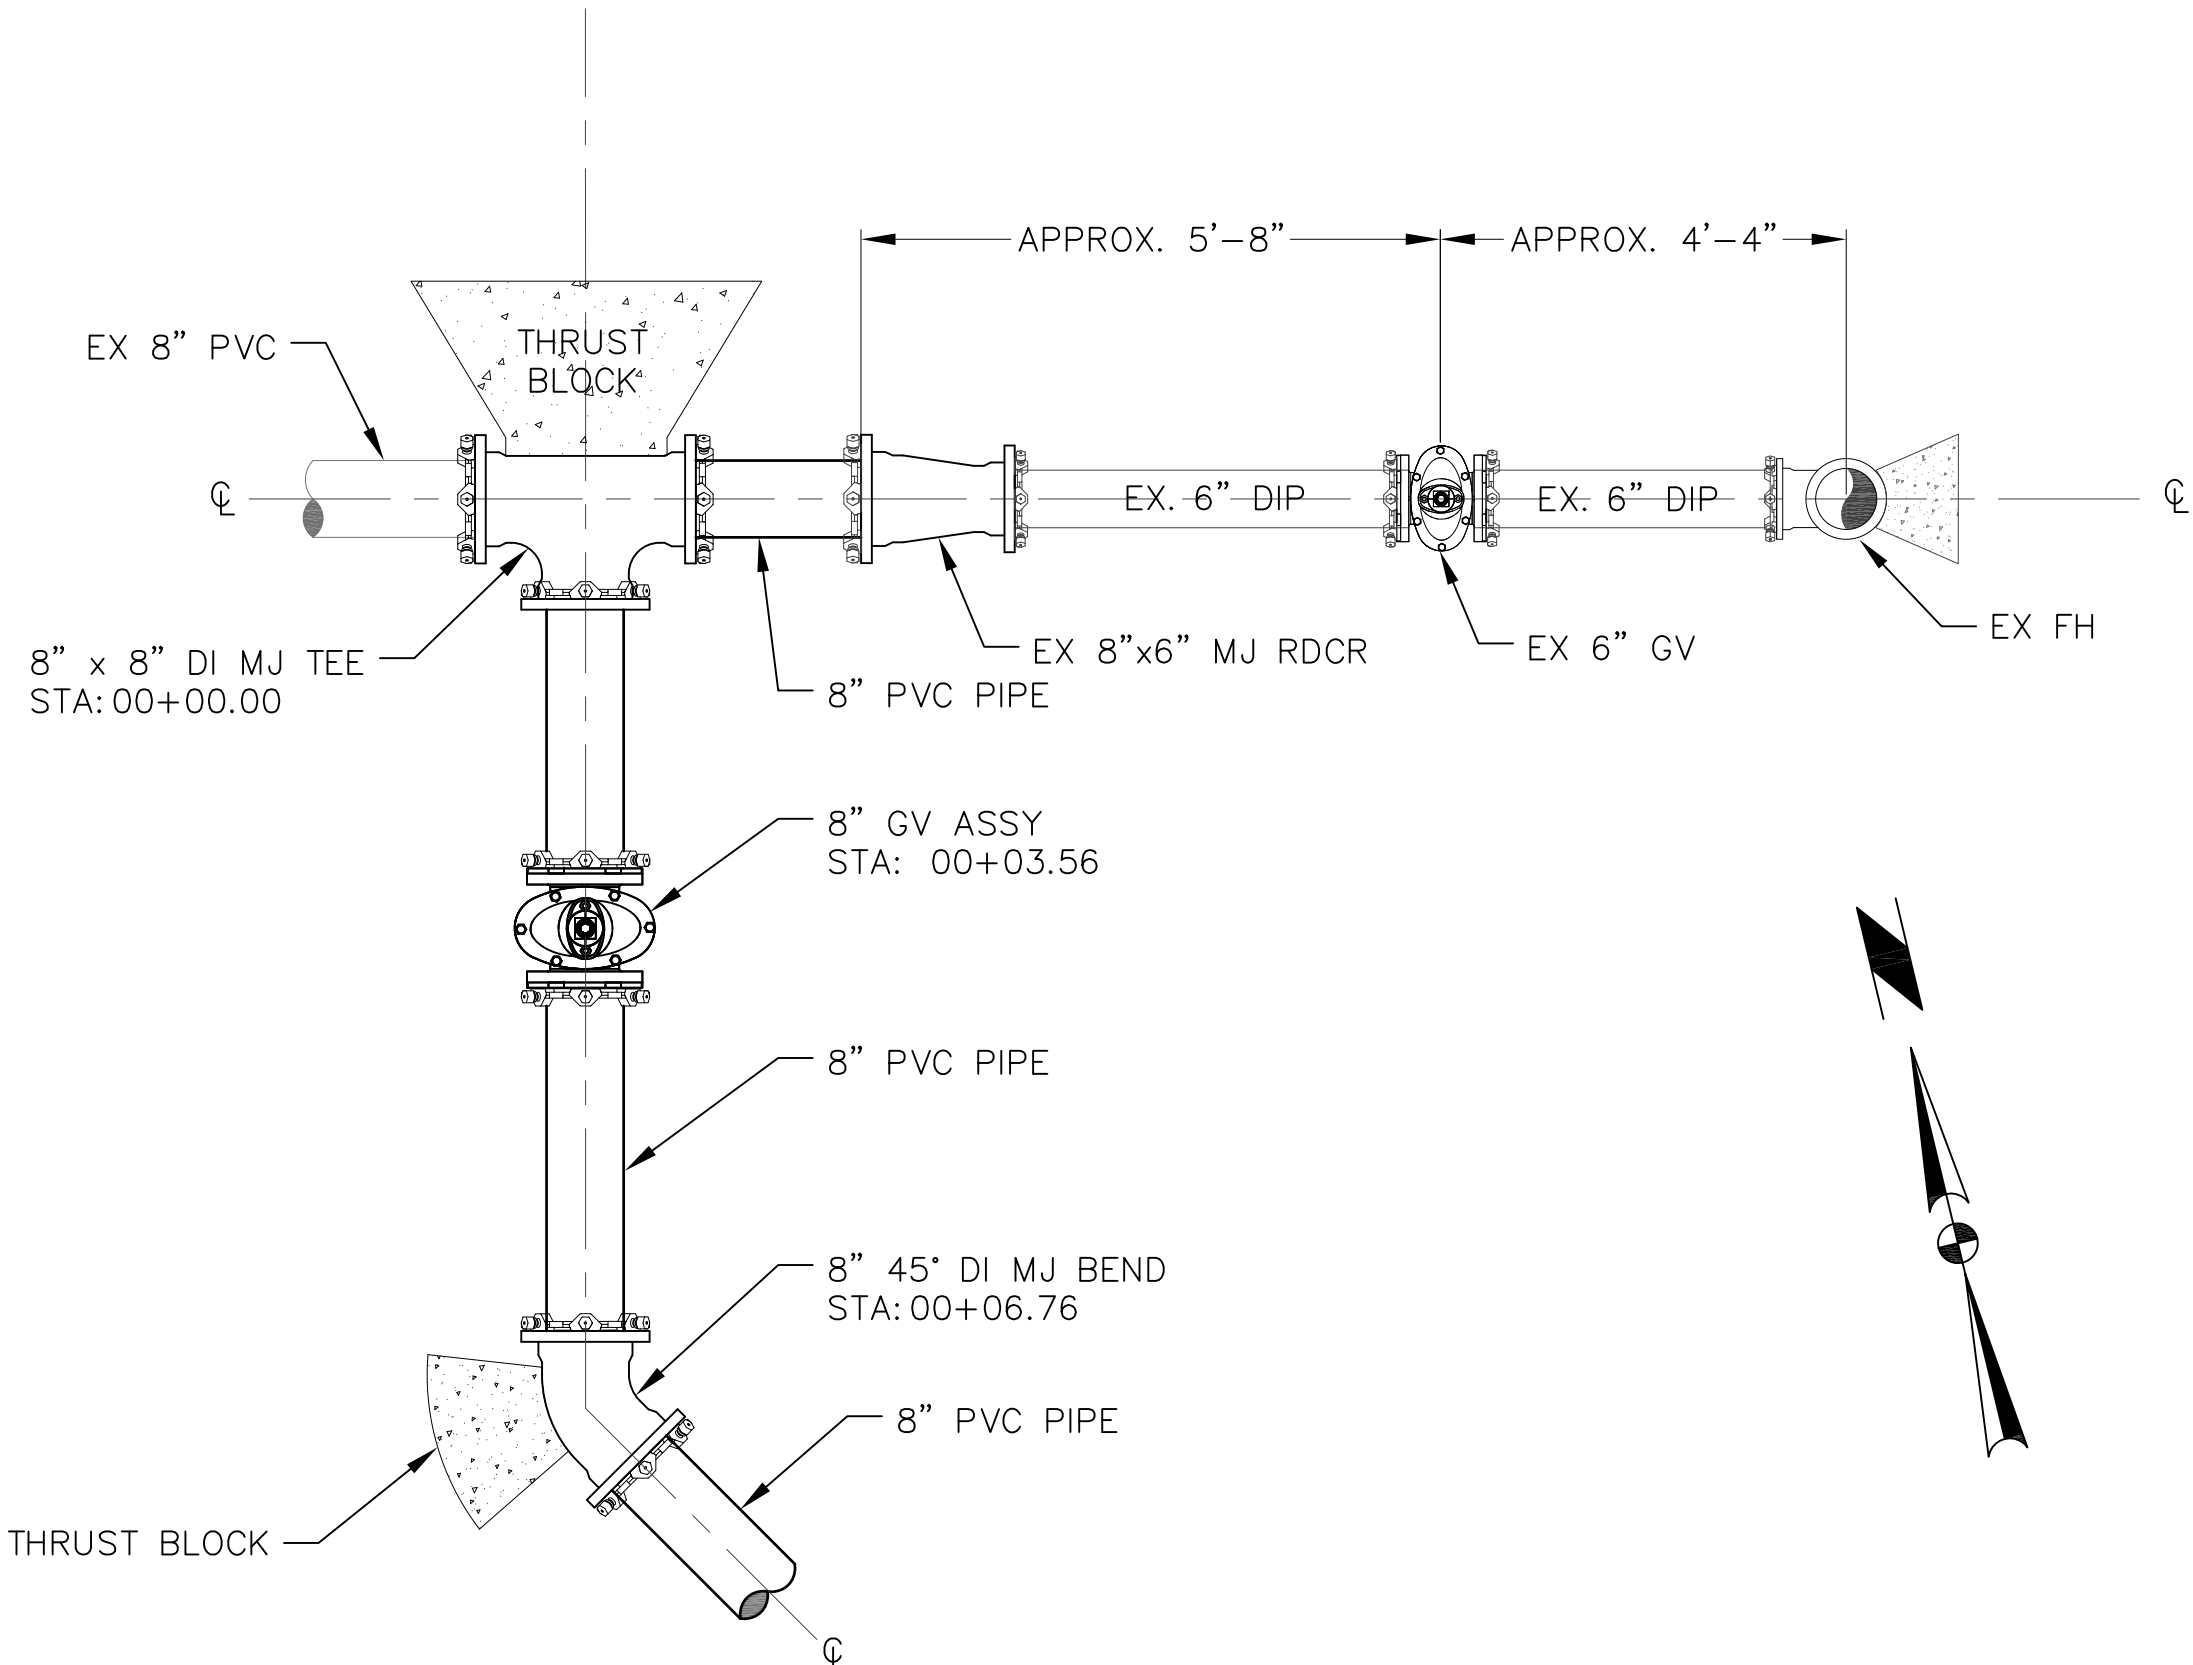

FINAL CONFIGURATION

**4**  
C5 CONNECTION 4 DETAIL  
1" = 20'

AS-BUILTS

ROXBOROUGH WATER AND SANITATION DISTRICT  
RAVENNA PHASE II WATER CONNECTION INFRASTRUCTURE

WATER LINE CONNECTION DETAILS - SHEET 2 OF 4



TST INFRASTRUCTURE, LLC  
Consulting Engineers

DATE: **NOVEMBER 2019**

JOB NO. **001.335.01**

RWSD

DRAWING NO.

**C7**

REVISIONS

AS-BUILT

DATE  
11/22/2019

BY  
ACP

DESIGNED: **JDB**


CHECKED: **MKM**

DRAWING: **SDH**


1 INCH  
1 INCH x 1 INCH  
AT FULL SCALE  
1 INCH

BARS PLOT  
1 INCH x 1 INCH  
AT FULL SCALE

H:\Drawings\Roxborough\001.335.00 - Ravenna WS Impr Design\Sheets\Civil\Civil Details In Progress.dwg, C8, 12/10/2019 10:11 AM

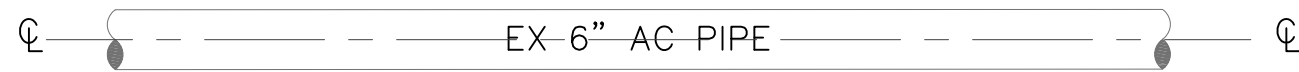


EXISTING CONFIGURATION

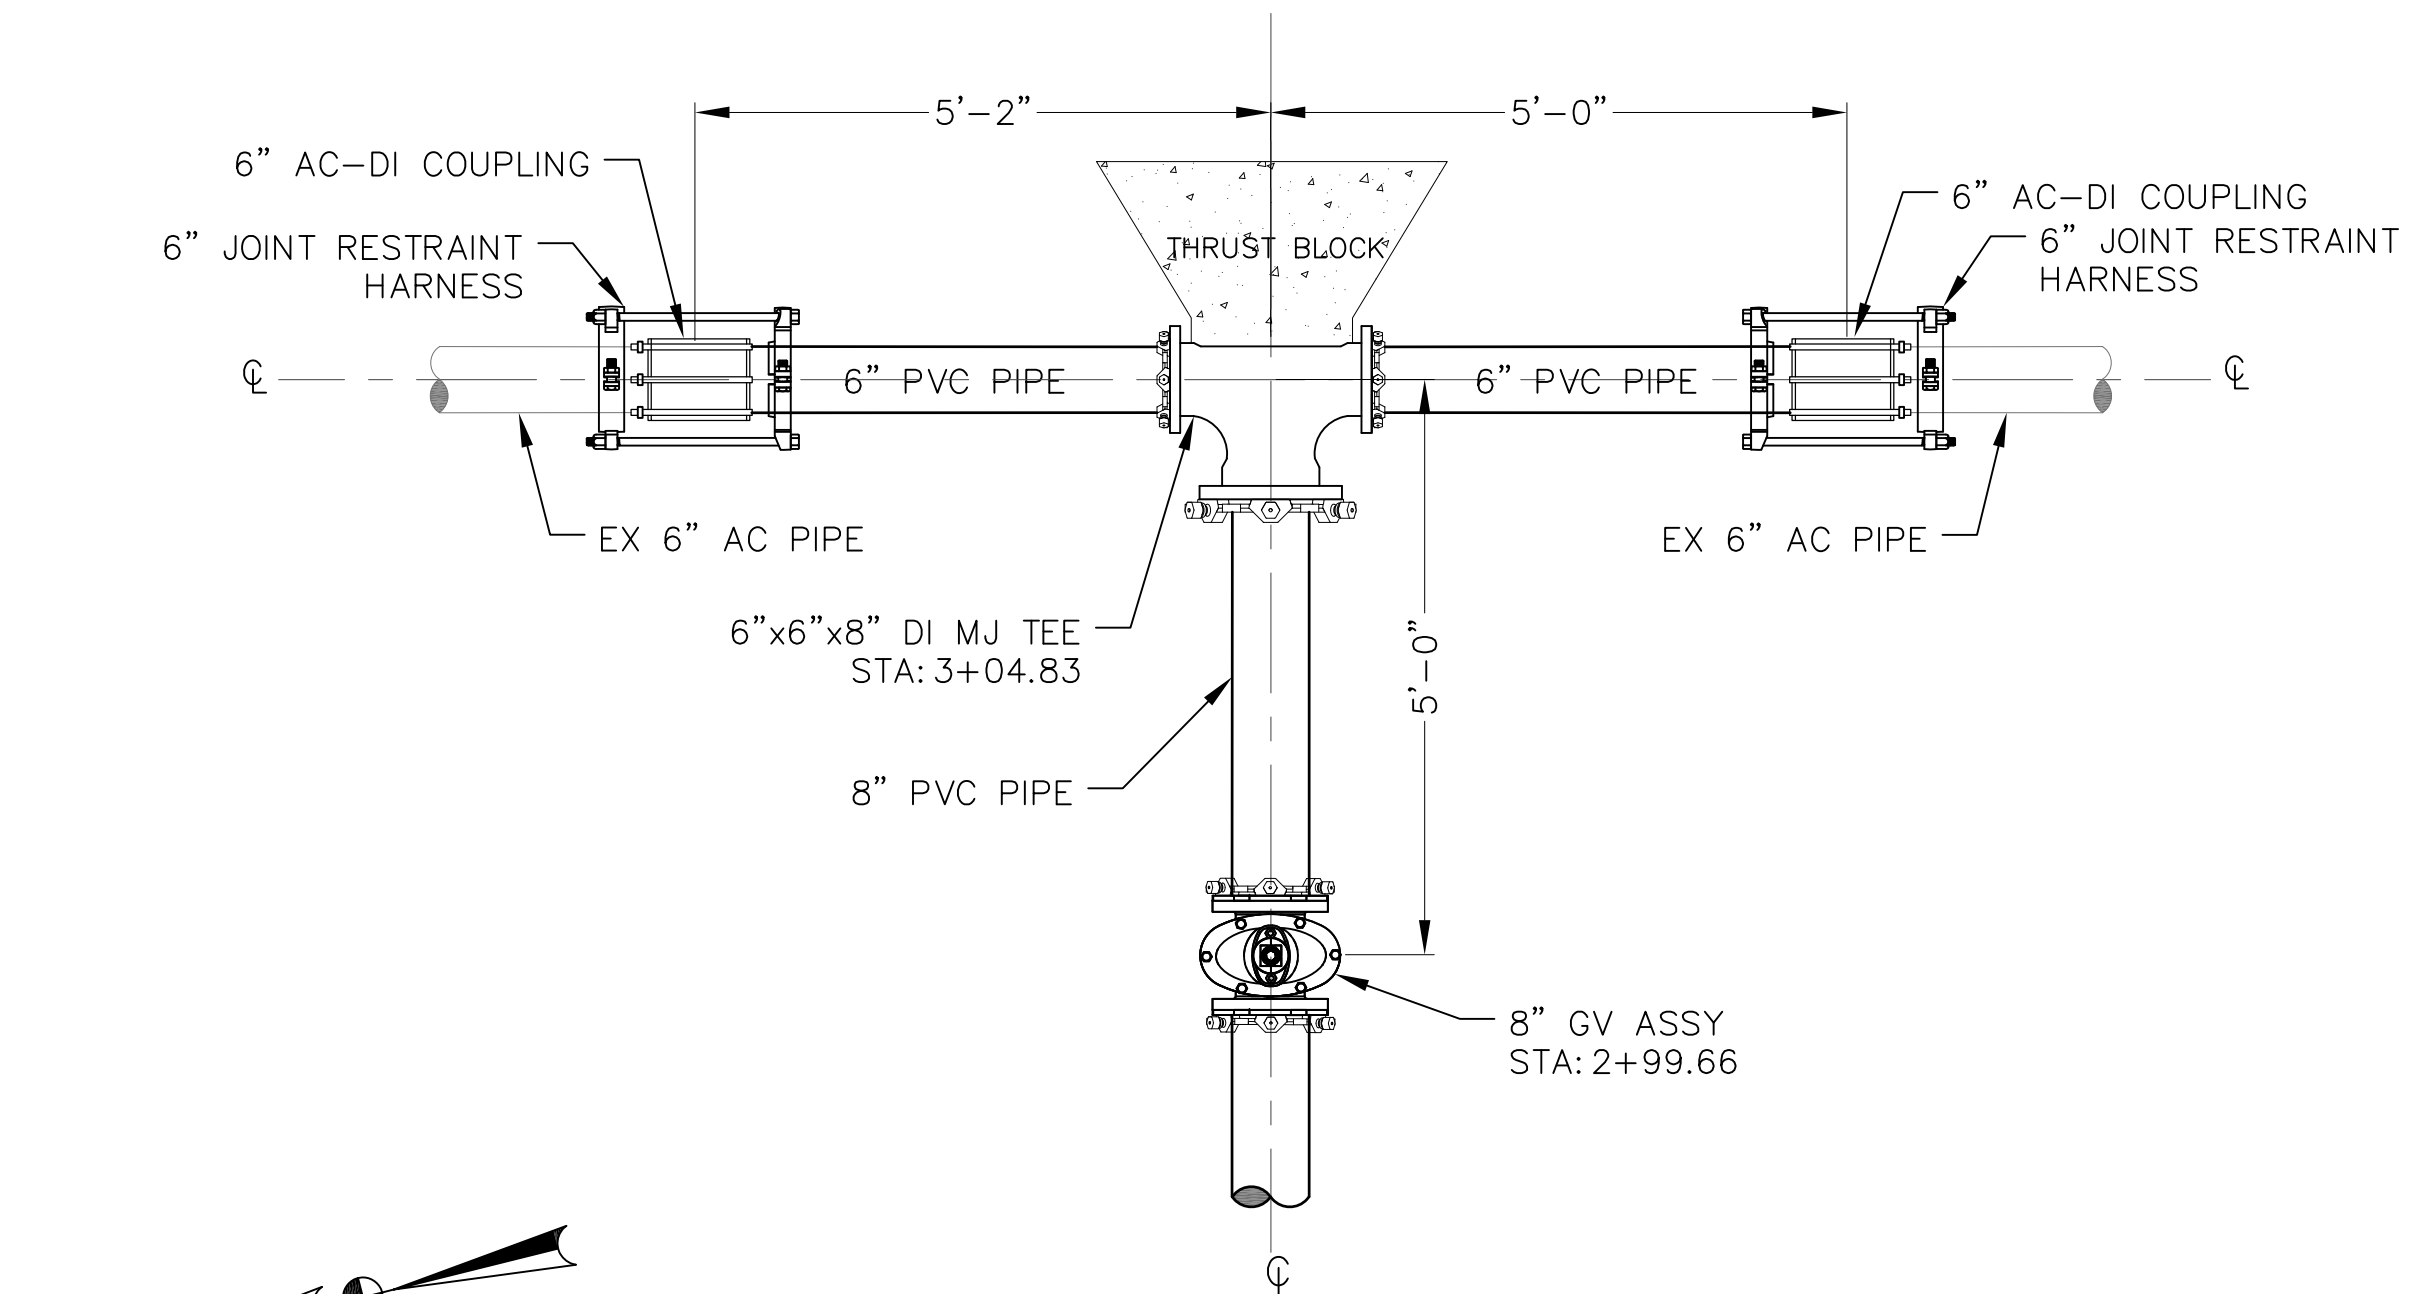


FINAL CONFIGURATION

5  
C5 CONNECTION 5 DETAIL  
1" = 20'

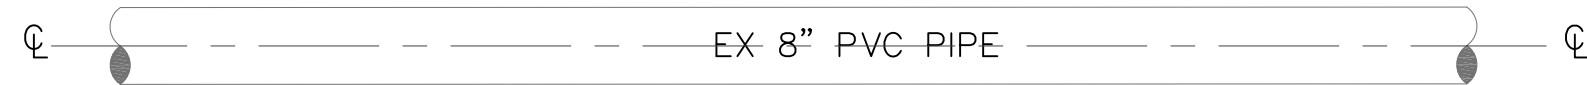

EXISTING CONFIGURATION

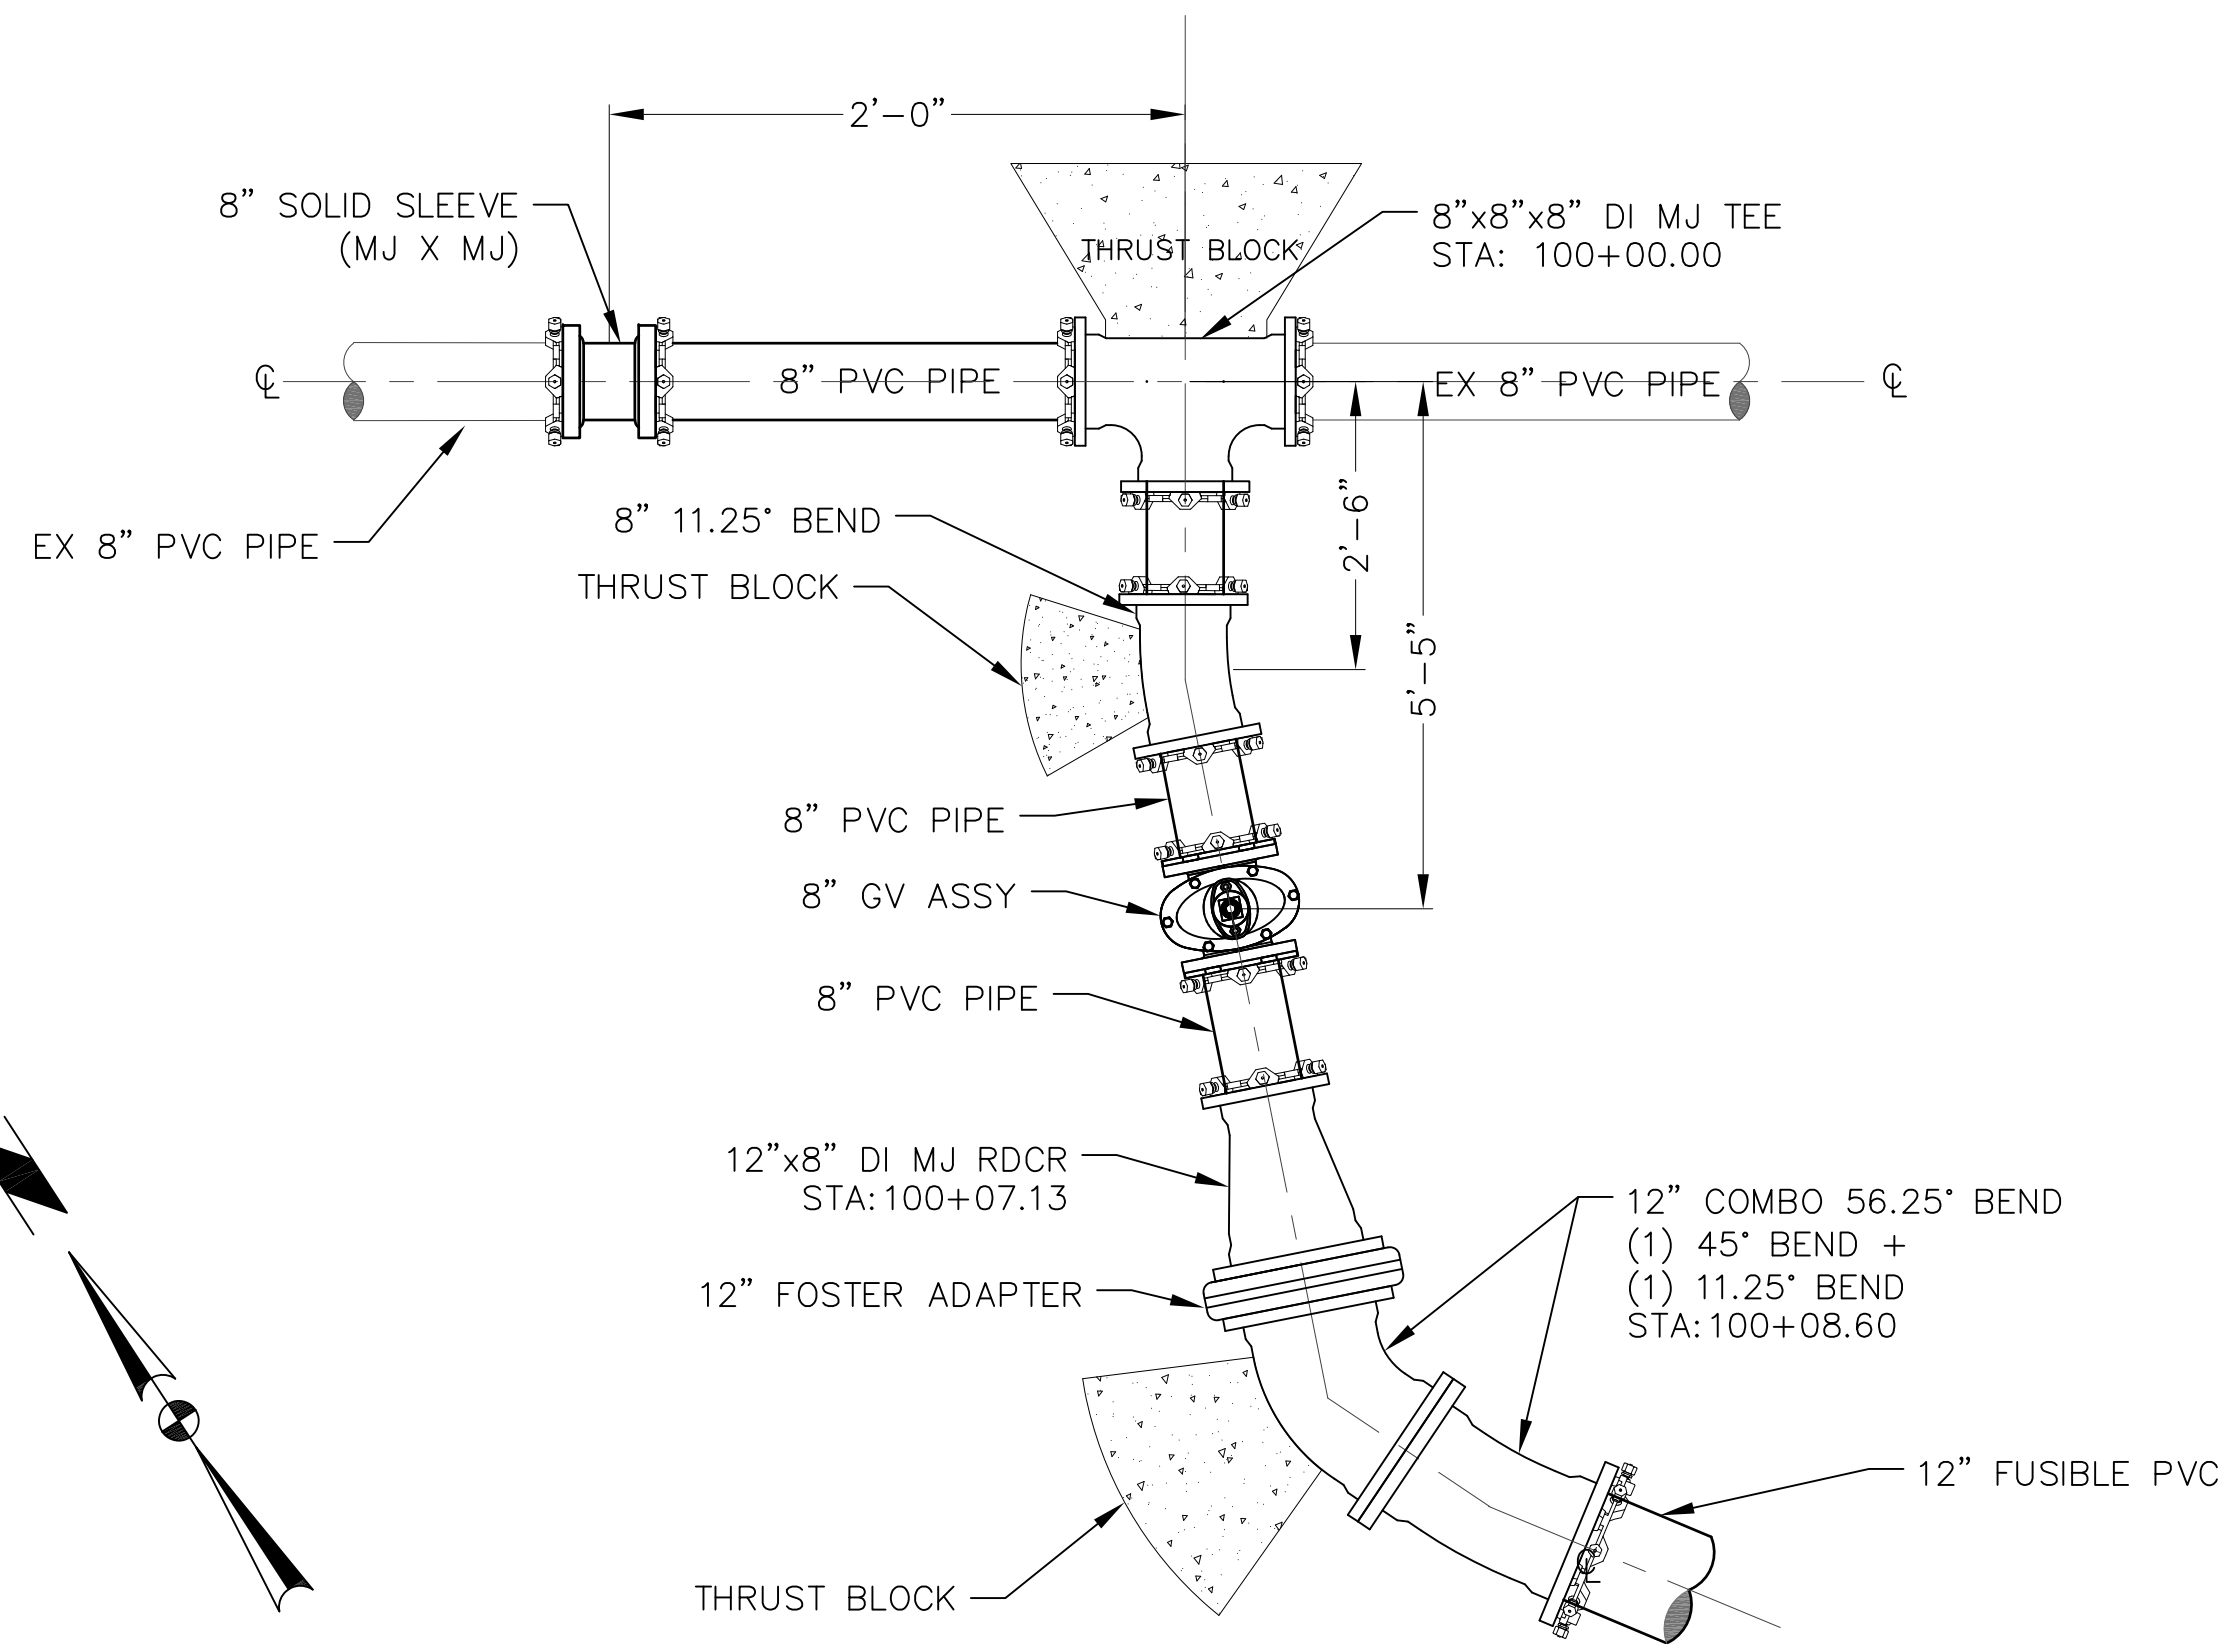

FINAL CONFIGURATION

6  
C1 CONNECTION 6 DETAIL  
1" = 20'


AS-BUILTS

REVISIONS	By	Date	Description
AS-BUILT	ACP	11/22/2019	

DESIGNED: JDB


CHECKED: MKM

DRAWING: SDH

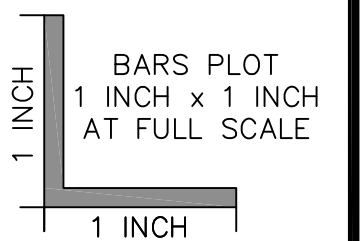

ROXBOROUGH WATER AND SANITATION DISTRICT  
RAVENNA PHASE II WATER CONNECTION INFRASTRUCTURE

WATER LINE CONNECTION DETAILS - SHEET 3 OF 4

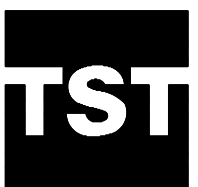

TST INFRASTRUCTURE, LLC  
Consulting Engineers

DATE: NOVEMBER 2019


JOB NO. 001.335.01

RWSD


DRAWING NO.

C8

H:\Drawings\Roxborough\001.335.00 - Ravenna WS Impr Design\Sheets\Civil Details In Progress.dwg, C9, 12/10/2019 10:11 AM

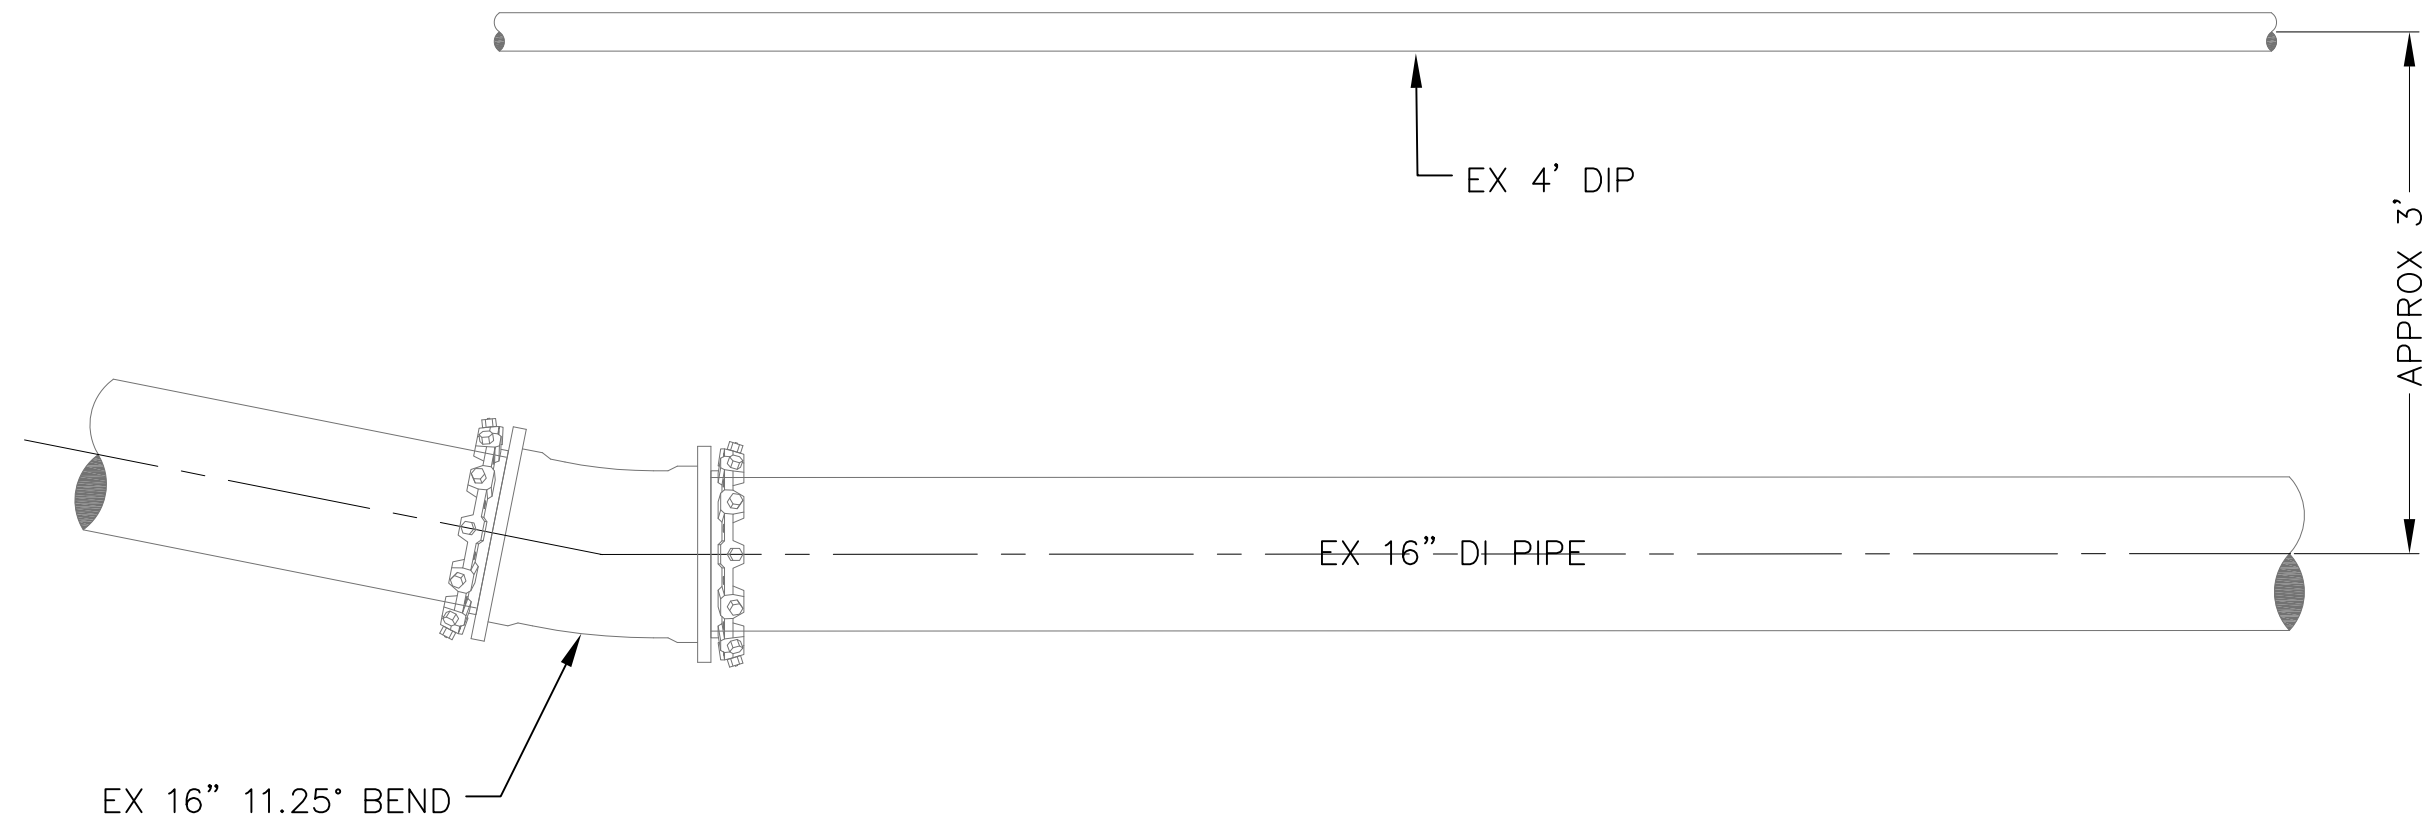


EXISTING CONFIGURATION

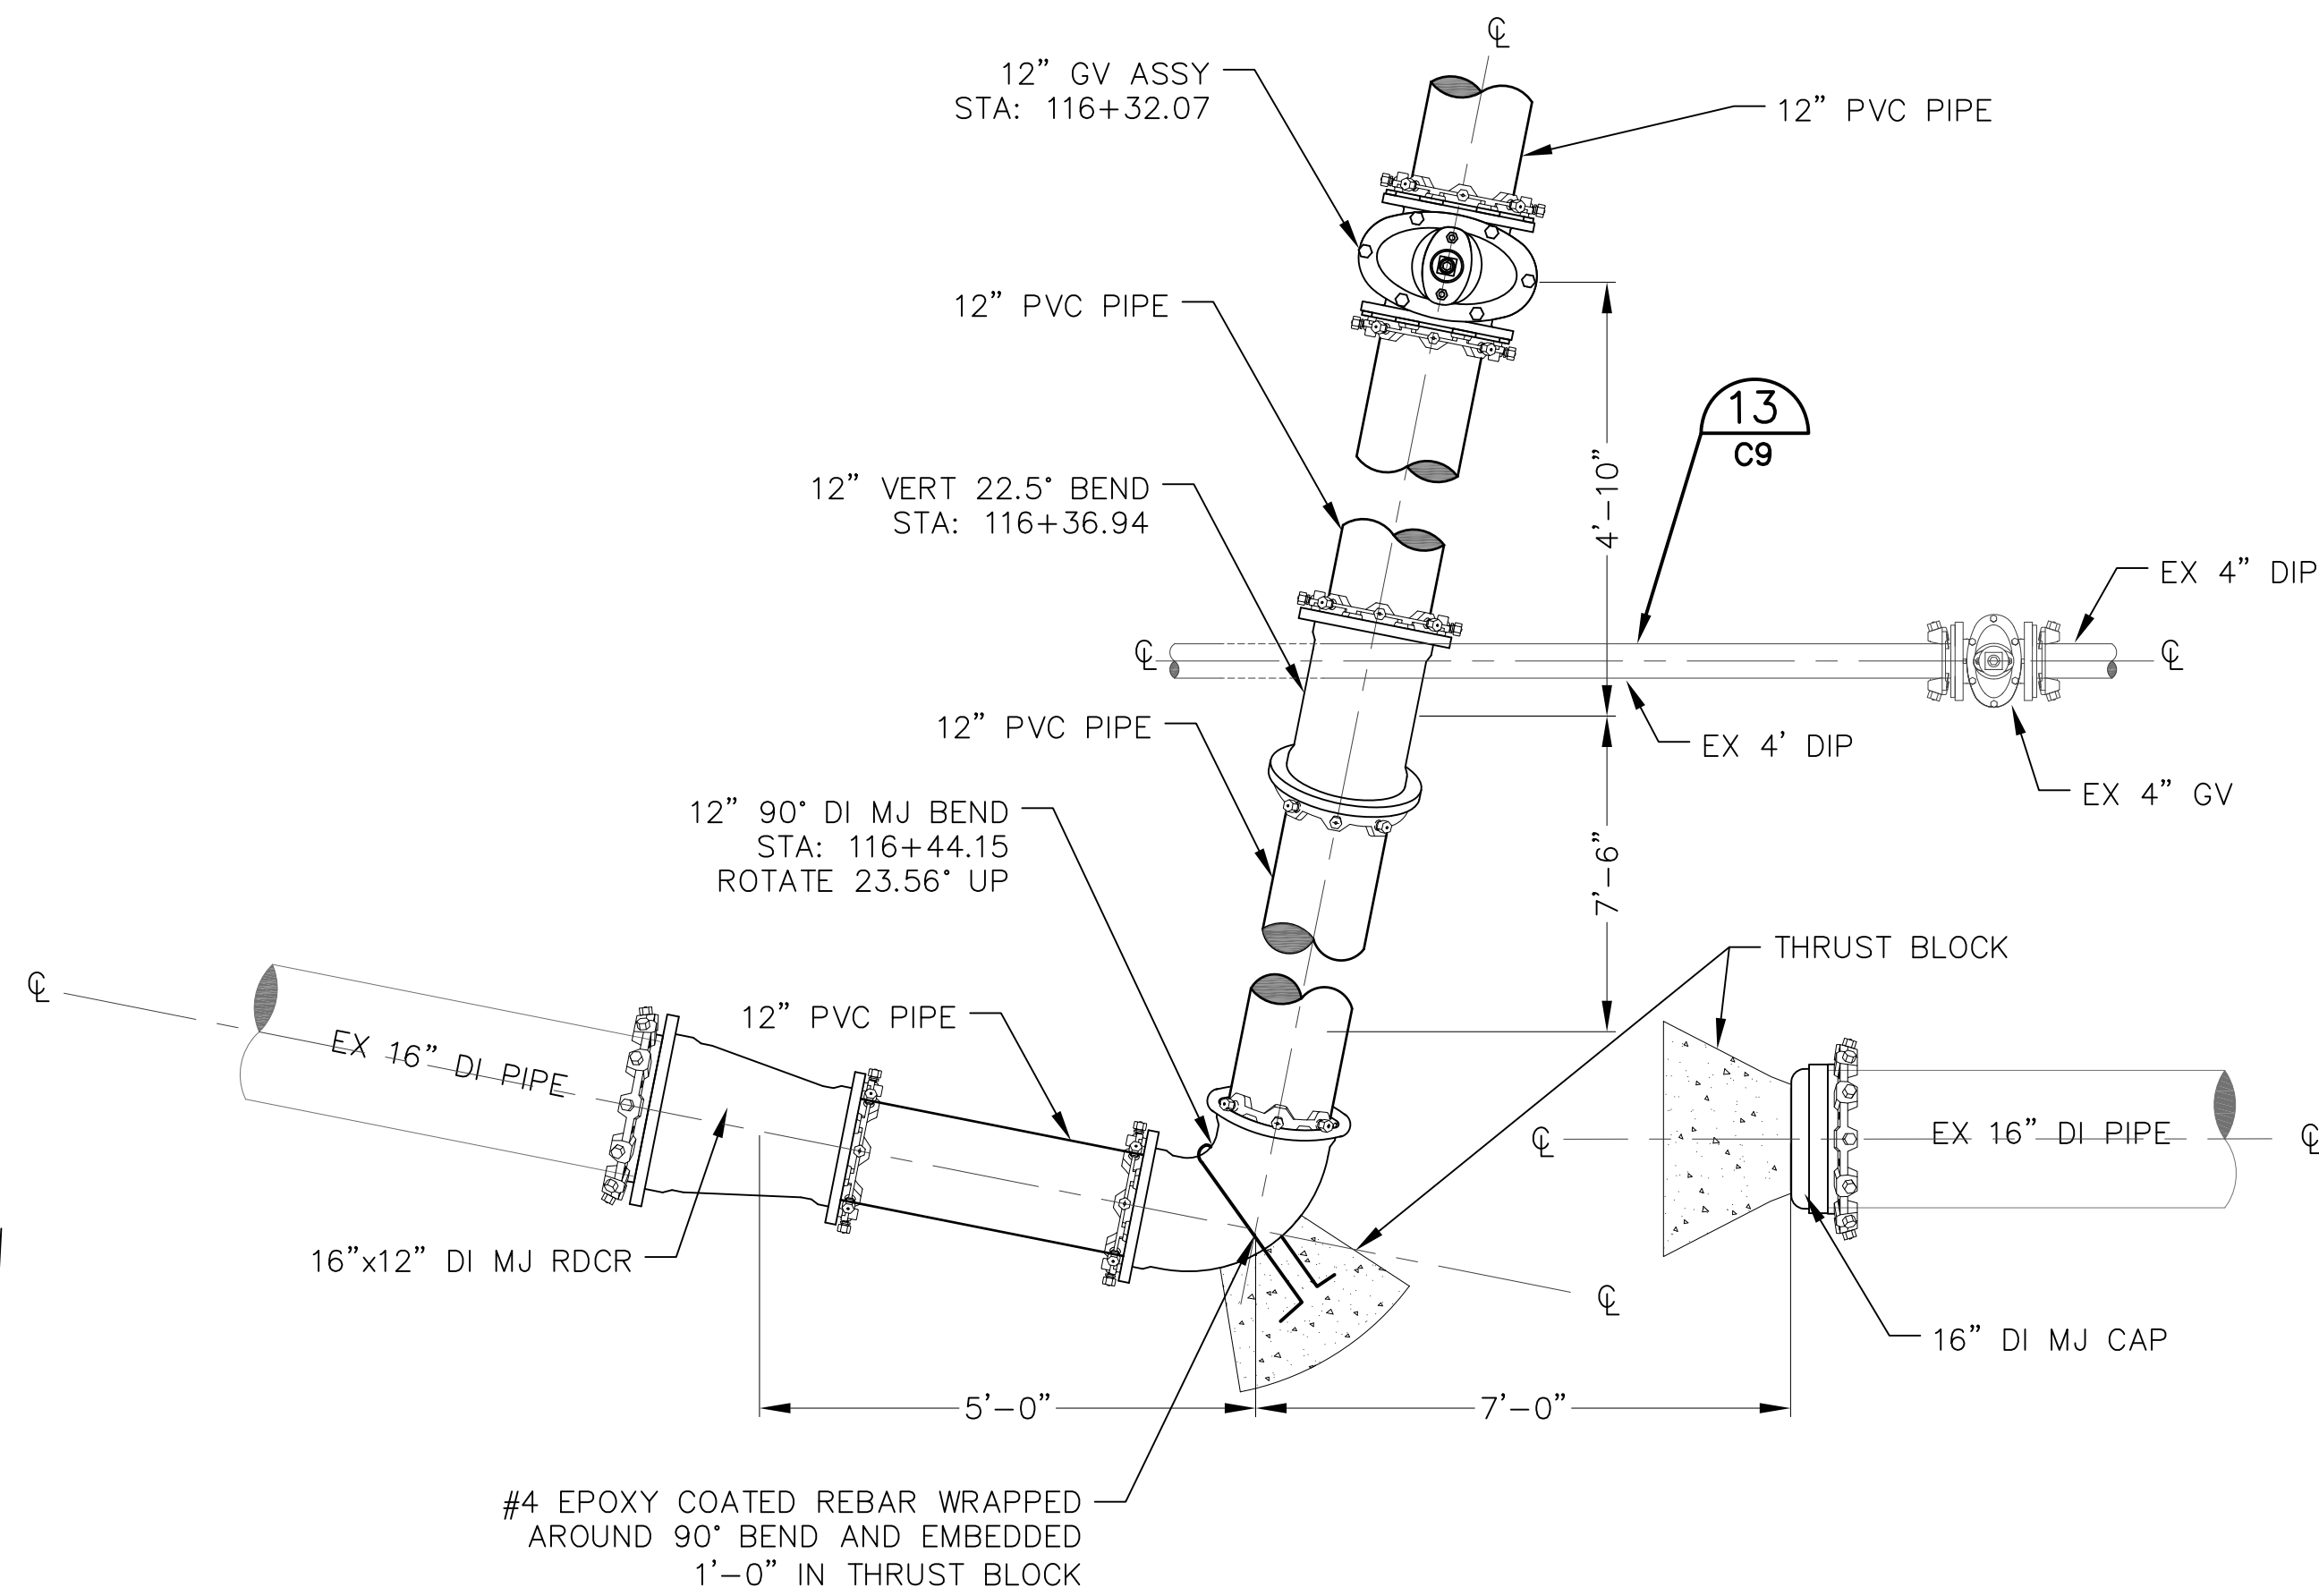


FINAL CONFIGURATION

7 CONNECTION 7 DETAIL  
C2 1" = 20'

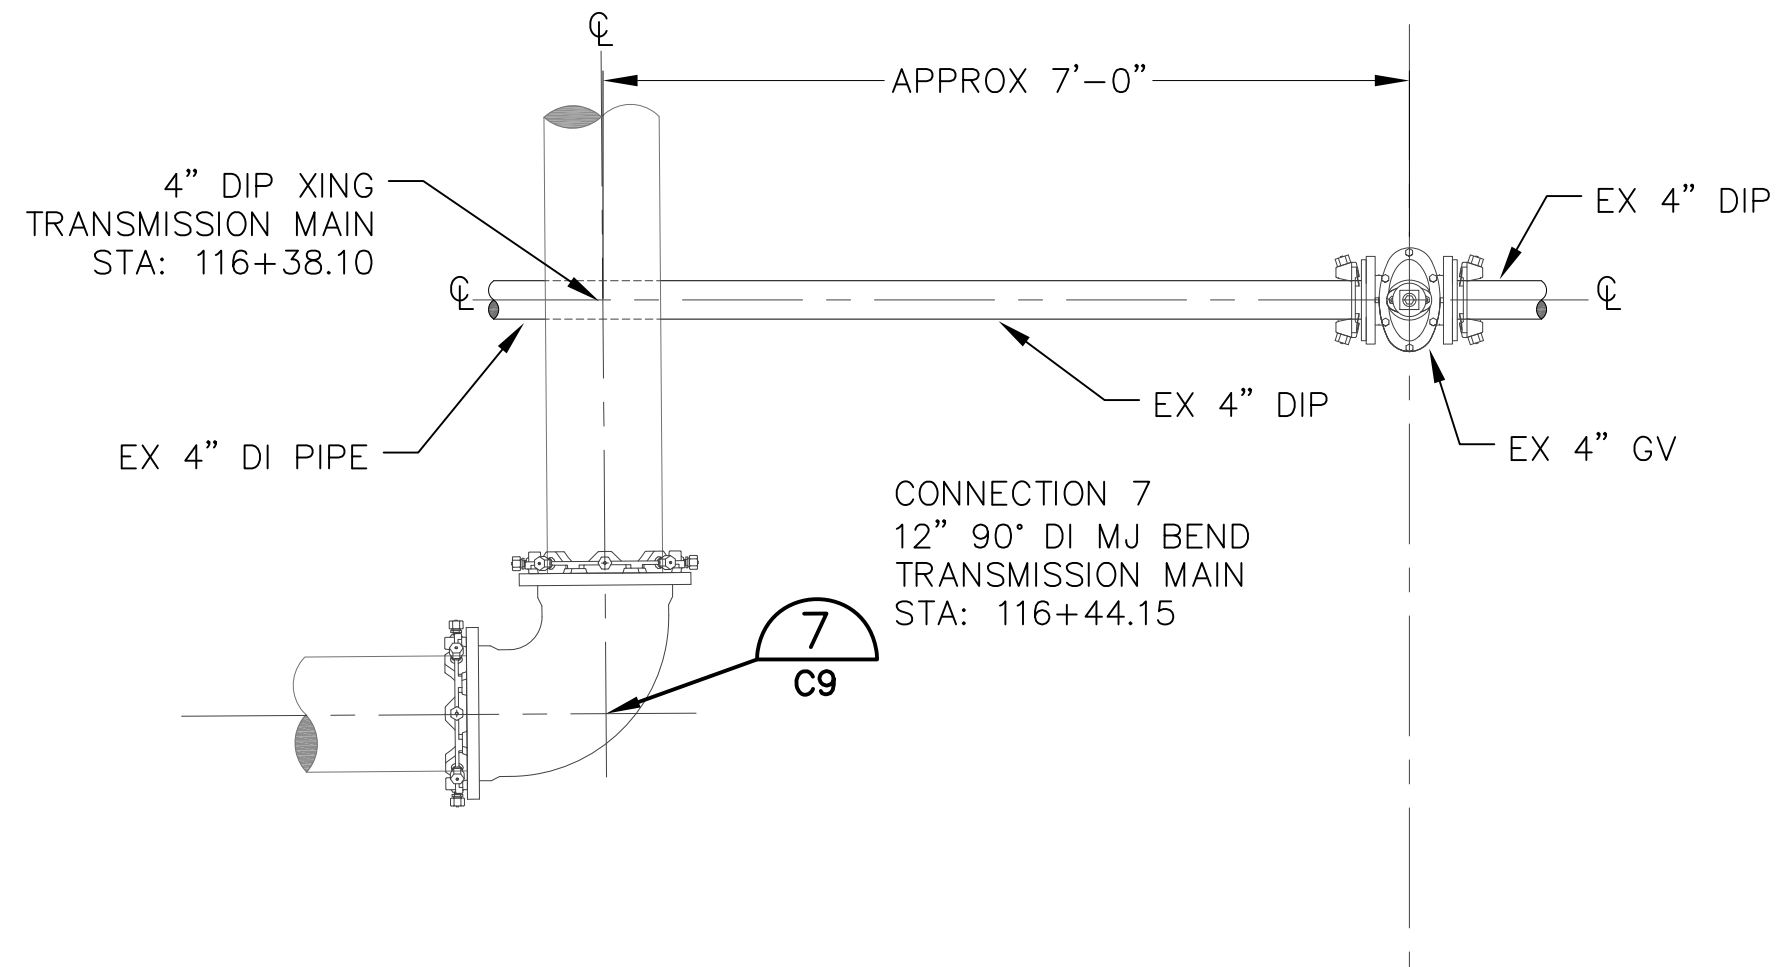

EXISTING CONFIGURATION

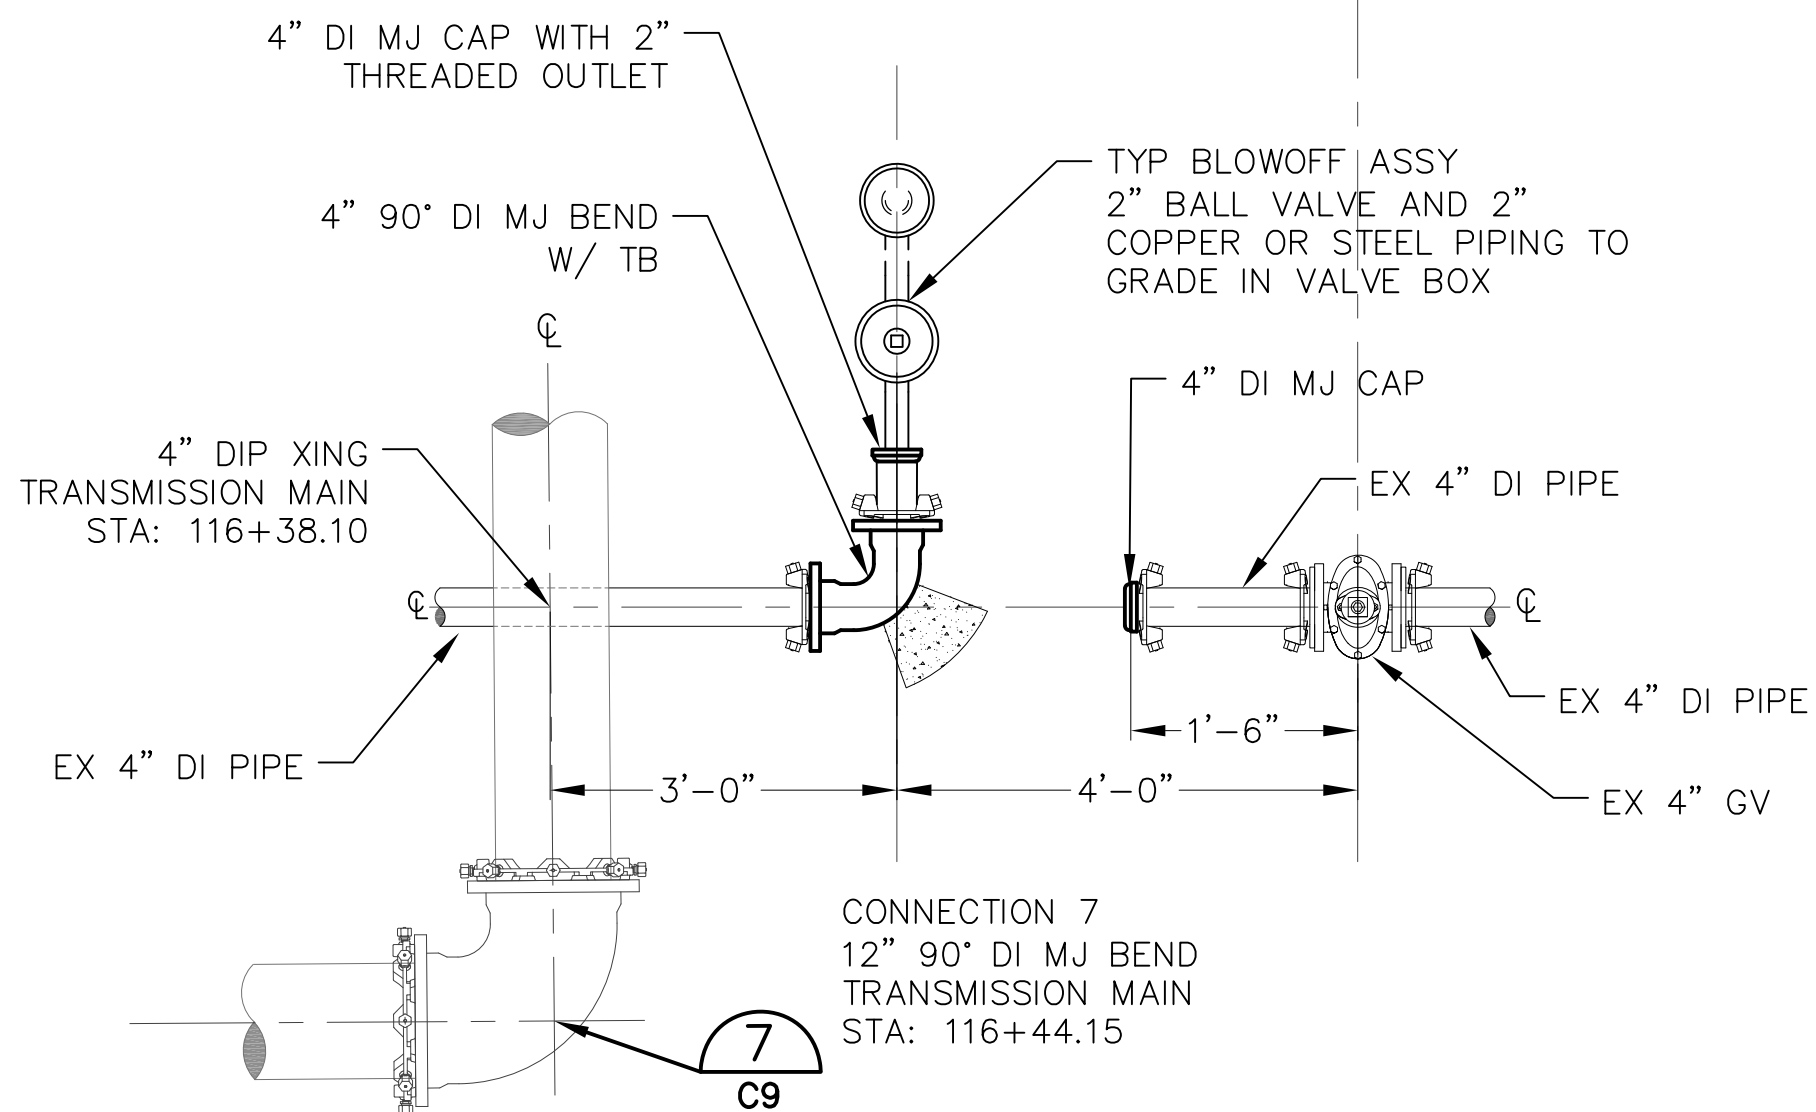

FINAL CONFIGURATION

13 4" TANK INLET LINE CAP & BLOWOFF DETAIL  
C2 1" = 20'

AS-BUILTS

ROXBOROUGH WATER AND SANITATION DISTRICT  
RAVENNA PHASE II WATER CONNECTION INFRASTRUCTURE

WATER LINE CONNECTION DETAILS - SHEET 4 OF 4



TST INFRASTRUCTURE, LLC  
Consulting Engineers

DATE: NOVEMBER 2019


JOB NO. 001.335.01

RWSD



DRAWING NO.

C9

- NOTE:
1. DEFLECT PIPES AT FITTINGS AS NECESSARY.
  2. ROTATE TEES AS NECESSARY TO MAKE CONNECTION.

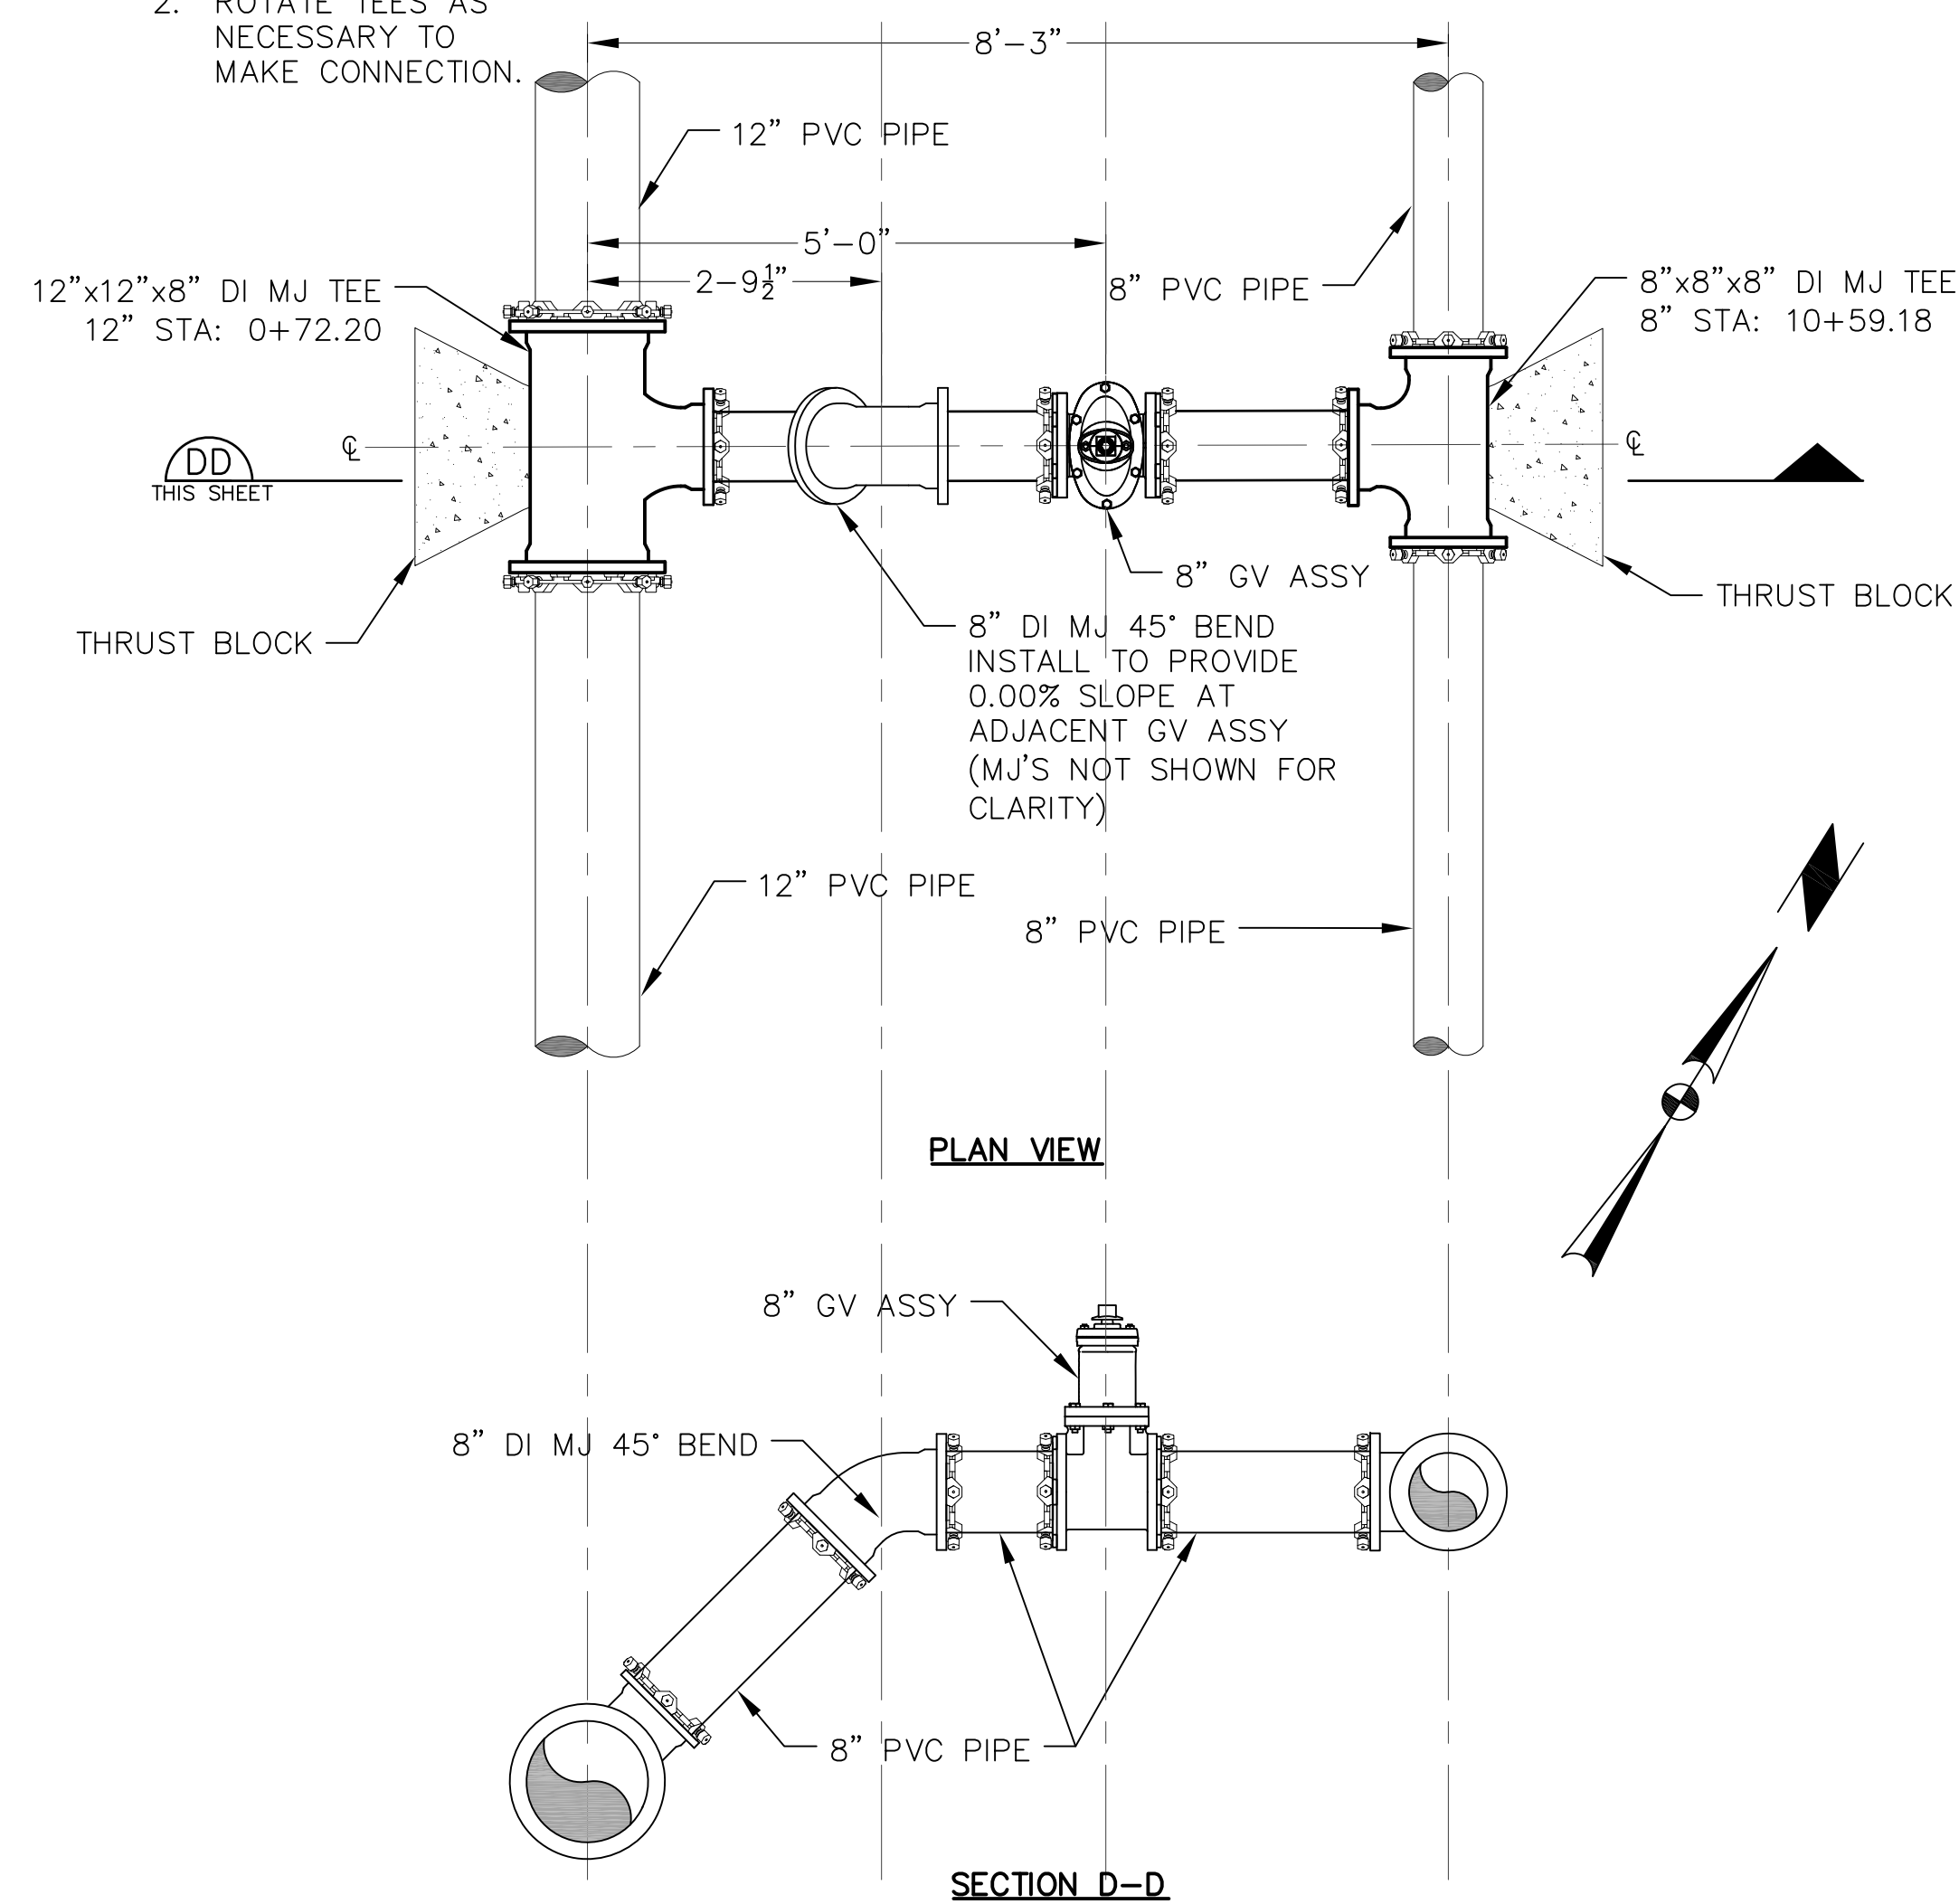

11 NORTH CONNECTION BYPASS DETAIL  
C3 1" = 20'

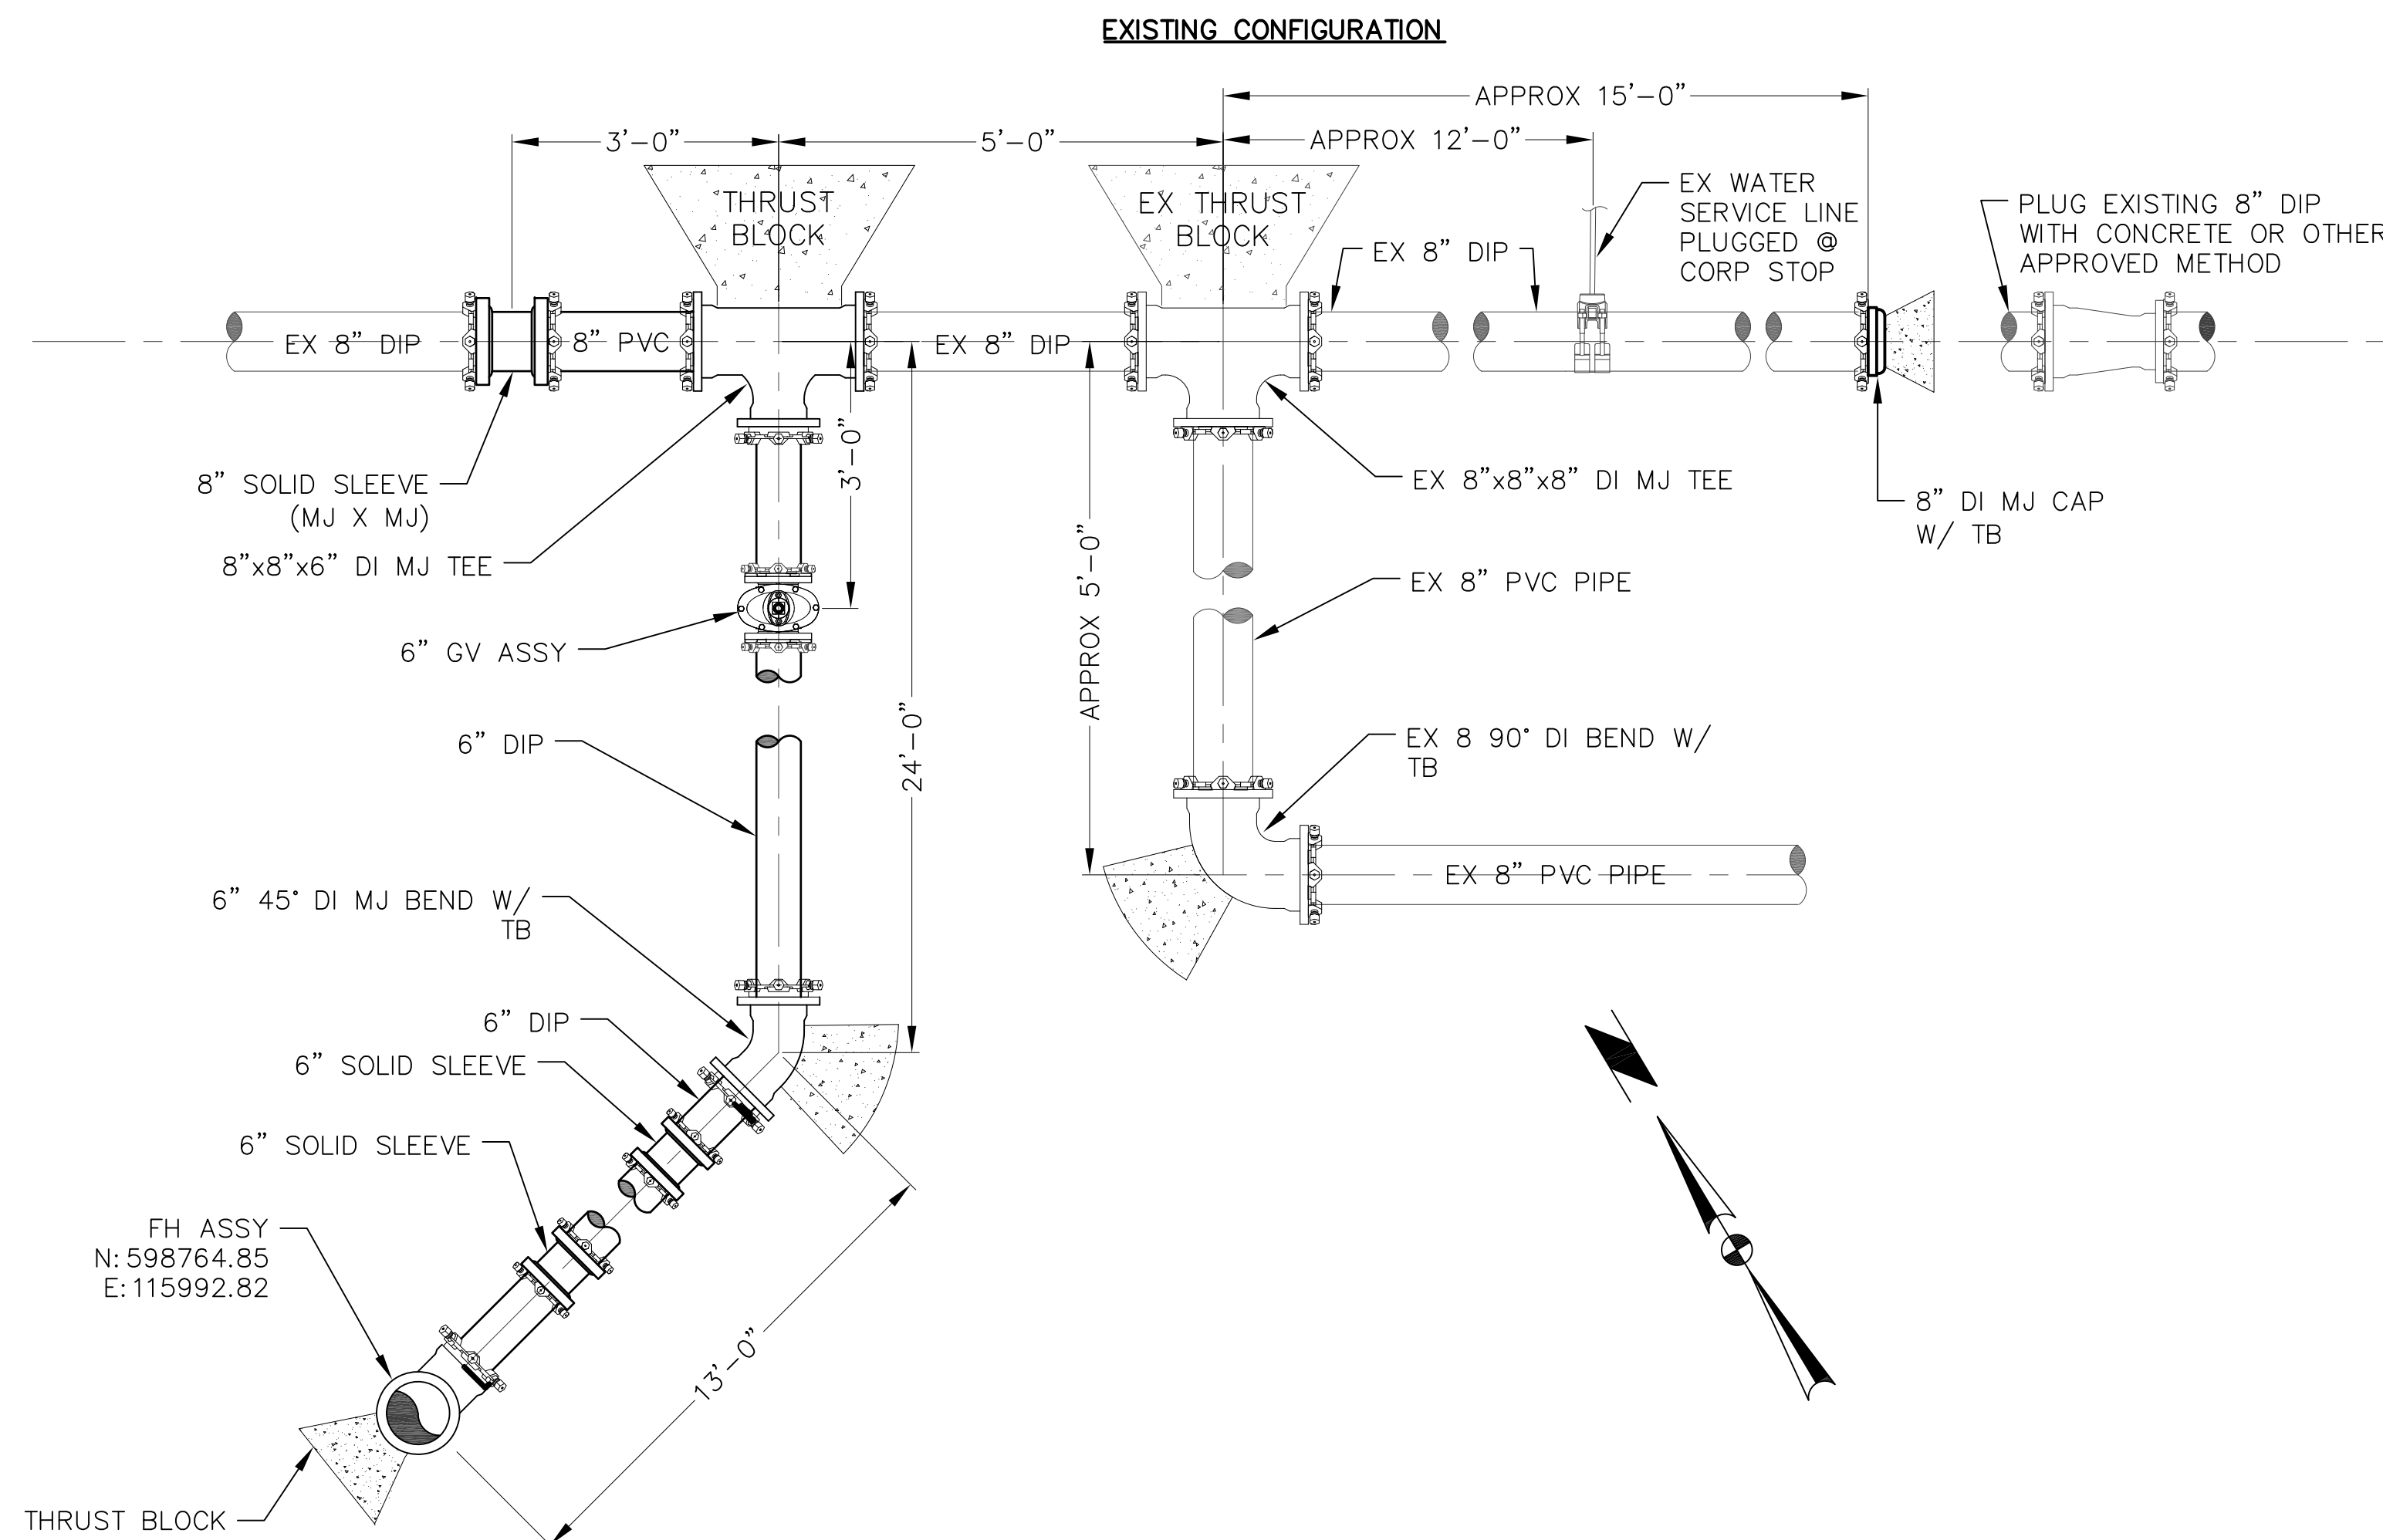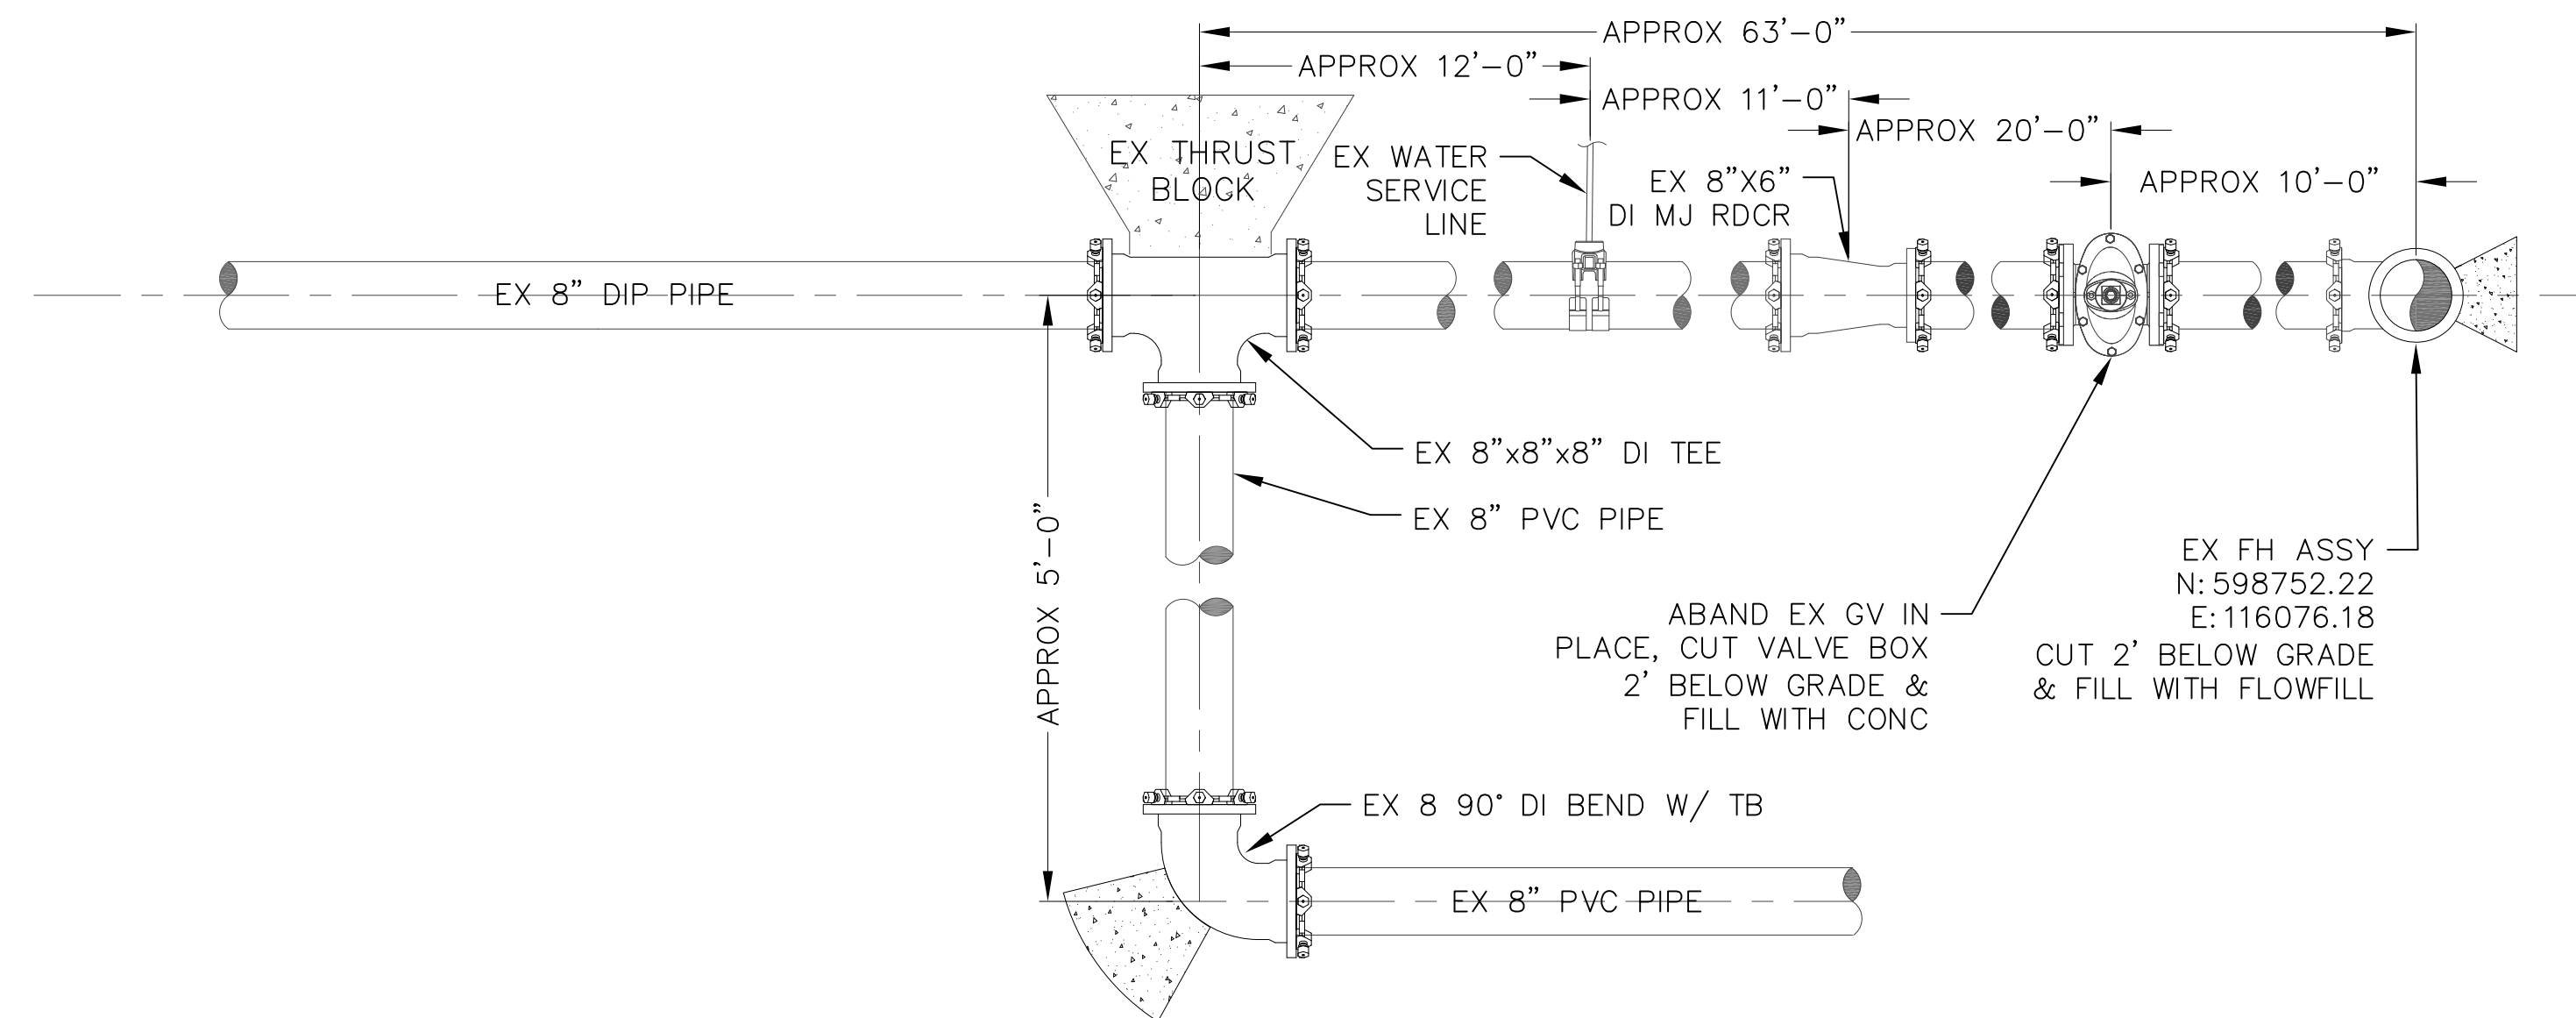

12 TRANSMISSION MAIN FH REMOVAL / NEW FH DETAIL  
C1 1" = 20'

## AS-BUILTS

ROXBOROUGH WATER AND SANITATION DISTRICT RAVENNA PHASE II WATER CONNECTION INFRASTRUCTURE
--

CIVIL DETAILS - SHEET 1 OF 1



TST INFRASTRUCTURE, LLC  
Consulting Engineers

DATE **NOVEMBER 2019**


JOB NO. 001.335.01

RWSD

DRAWING NO.

# C10

H:\Drawings\Roxborough\001.335.00 - Ravenna WS Impr. Design\Sheets\Civil Details In Progress.dwg, C11, 12/10/2019 10:13 AM

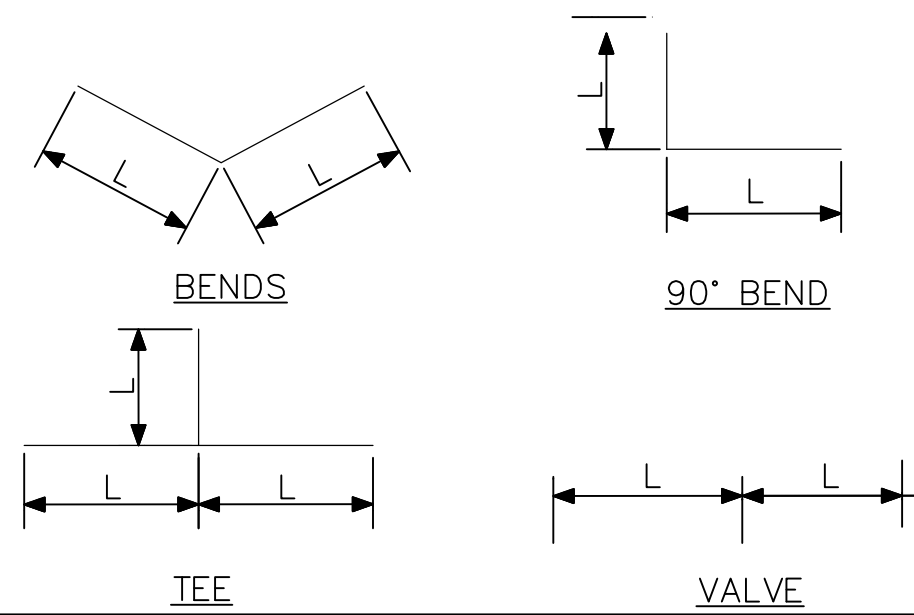


LENGTH OF RESTRAINED PIPE AT FITTINGS					
PIPE SIZE	4"	6"	8"	10"	12"
FITTING	LENGTH	LENGTH	LENGTH	LENGTH	LENGTH
TEE (BRANCH ONLY)	0'-0"	0'-0"	18'-0"	42'-0"	52'-0"
VALVE, PLUG OR 90 BEND	15'-0"	21'-0"	28'-0"	33'-0"	39'-0"
45 BEND	7'-0"	9'-0"	12'-0"	14'-0"	16'-0"
22-1/2 BEND	3'-0"	5'-0"	6'-0"	7'-0"	8'-0"
11-1/4 BEND	2'-0"	3'-0"	3'-0"	4'-0"	4'-0"
REDUCER (16"x12")	117'-0"				
REDUCER (12"x8")	84'-0"				
REDUCER (10"x8")	45'-0"				
ALL VERTICAL BENDS	72'-0"	72'-0"	96'-0"	114'-0"	134'-0"

NOTES:

- USE MECHANICAL RESTRAINTS ON ALL BENDS, TEES, VALVES, AND WHERE SPECIFICALLY INSTRUCTED ON THE PLANS
- L = LENGTH OF RESTRAINED PIPE MEASURED EACH WAY FROM VALVES AND FITTINGS.
- RESTRAINT LENGTH ASSUMES MINIMUM GROUND COVER OF 5' FOR ALL WATERLINES.
- BASED ON 160 P.S.I., INTERNAL PRESSURE PLUS 110 P.S.I. HAMMER.
- COMBINATION FITTINGS ALLOW FOR ADDITION OF INDIVIDUAL RESTRAINED LENGTH VALUES TO ACHIEVE COMBINATION VALUE.

TYPICAL MECHANICAL JOINT RESTRAINT


NOT TO SCALE

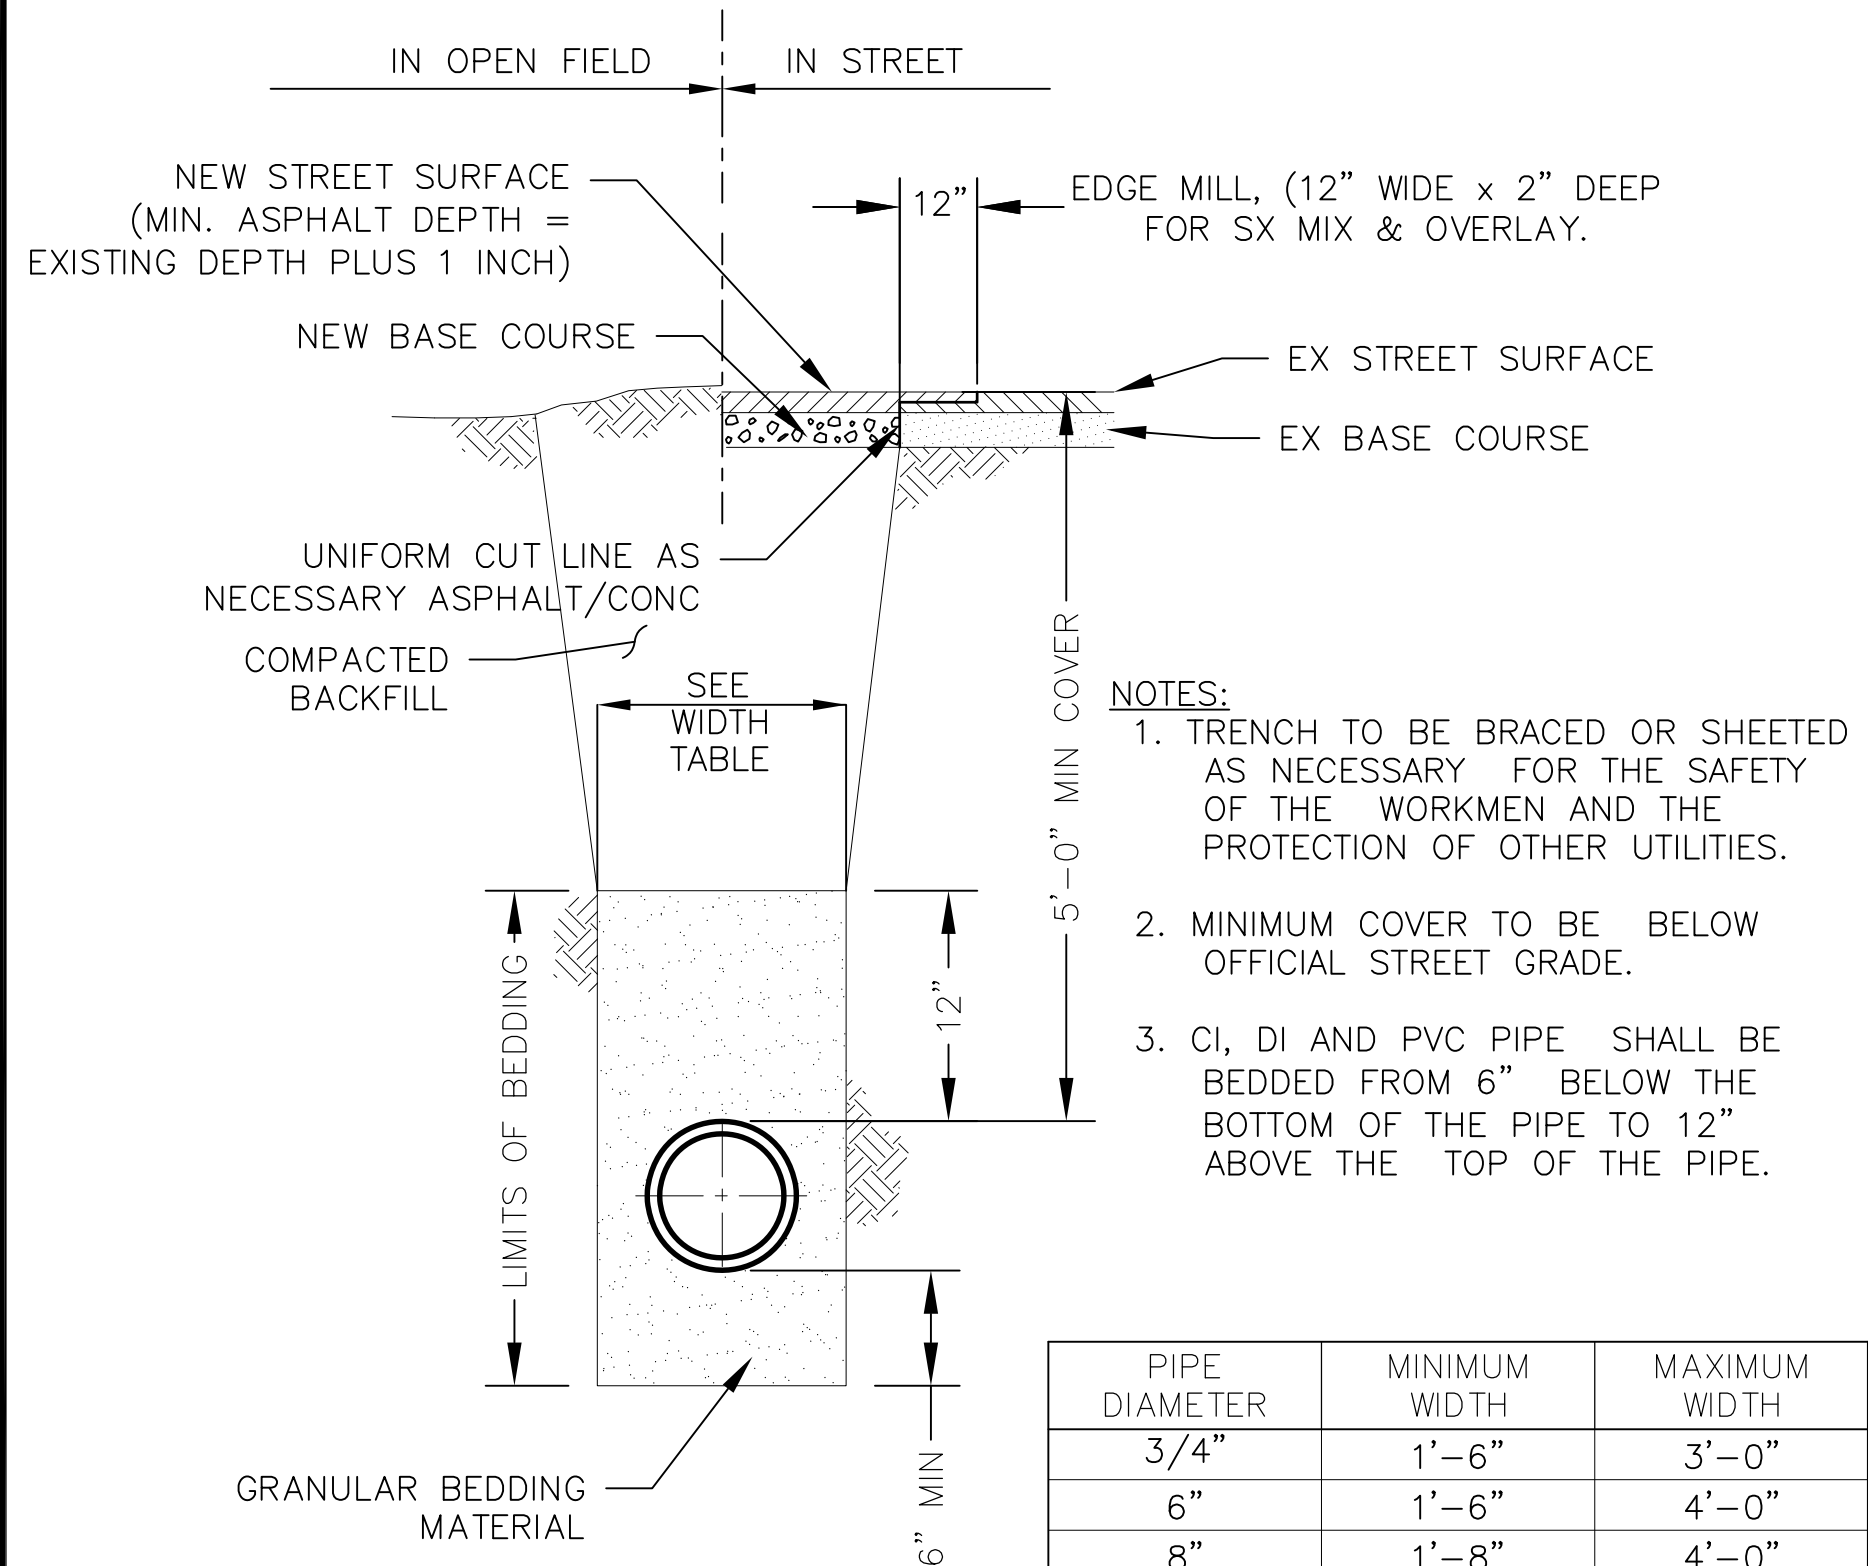

PIPE DIAMETER	MINIMUM WIDTH	MAXIMUM WIDTH
3/4"	1'-6"	3'-0"
6"	1'-6"	4'-0"
8"	1'-8"	4'-0"
10"	1'-10"	4'-0"
12"	2'-0"	4'-0"

TYPICAL TRENCH SECTION DETAIL

NOT TO SCALE

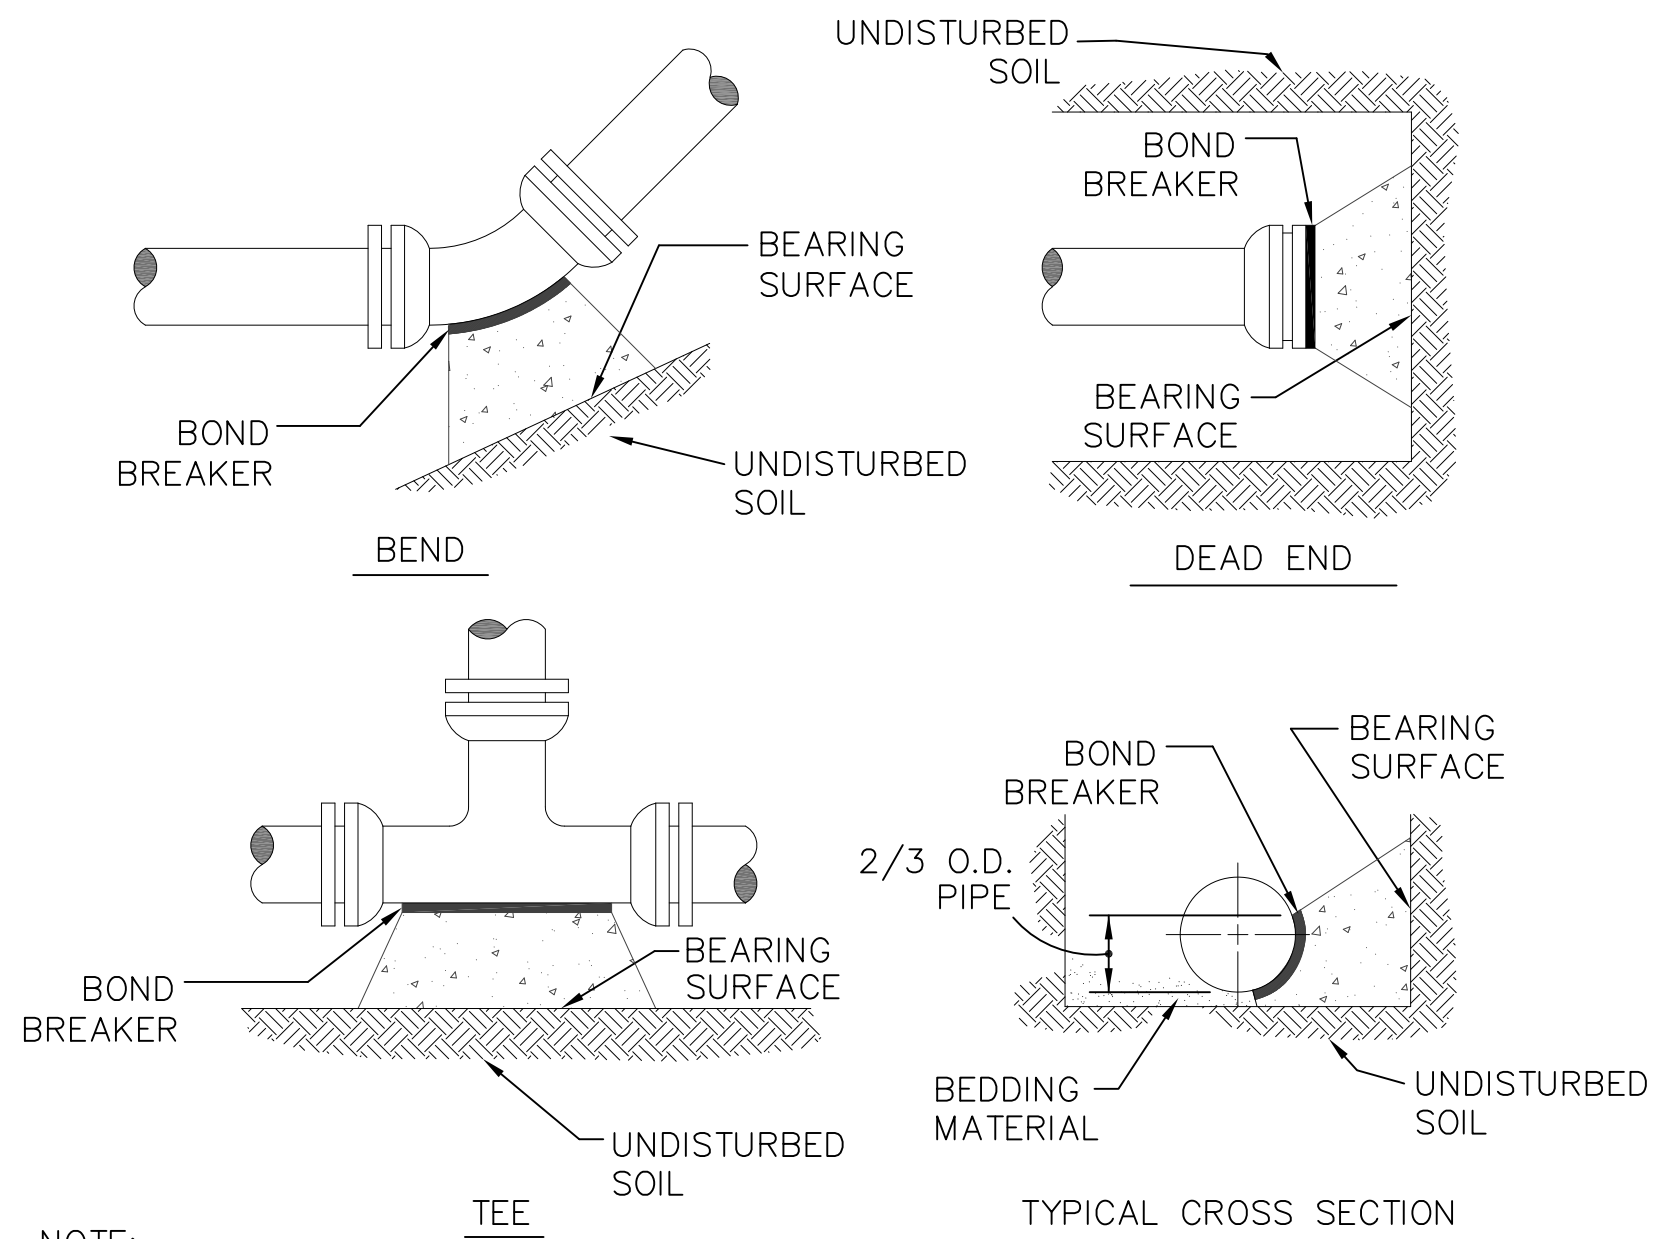


NOTE:

- THE MINIMUM BEARING SURFACE AREAS SHOWN IN THE TABLE FOR OUTLET PIPING ARE BASED ON 160 PSI INTERNAL PIPE PRESSURE PLUS 110 PSI WATER HAMMER & AN ALLOWABLE SOIL BEARING CAPACITY EQUAL TO 250 PCF 5.5 DEPTH BELOW GRADE (TO MID-POINT OF THRUST BLOCK FACE). FOR DEPTH EQUAL TO 10 FEET OR MORE, USE 2500 PSF.
- COMBINATION FITTINGS ALLOW FOR ADDITION OF INDIVIDUAL BEARING SURFACE VALUES TO ACHIEVE COMBINATION VALUE.

MINIMUM BEARING SURFACE AREA (SF)					
Ø OF PIPE	FITTING				
	11 1/4"	22 1/2"	45"	90"	TEE
4"	0.50	1.00	1.96	3.61	3.61
6"	1.04	2.07	4.05	7.49	7.49
8"	1.78	3.55	6.96	12.86	12.86
12"	3.79	7.55	14.81	27.36	27.36

TYPICAL THRUST BLOCK DETAIL

NOT TO SCALE

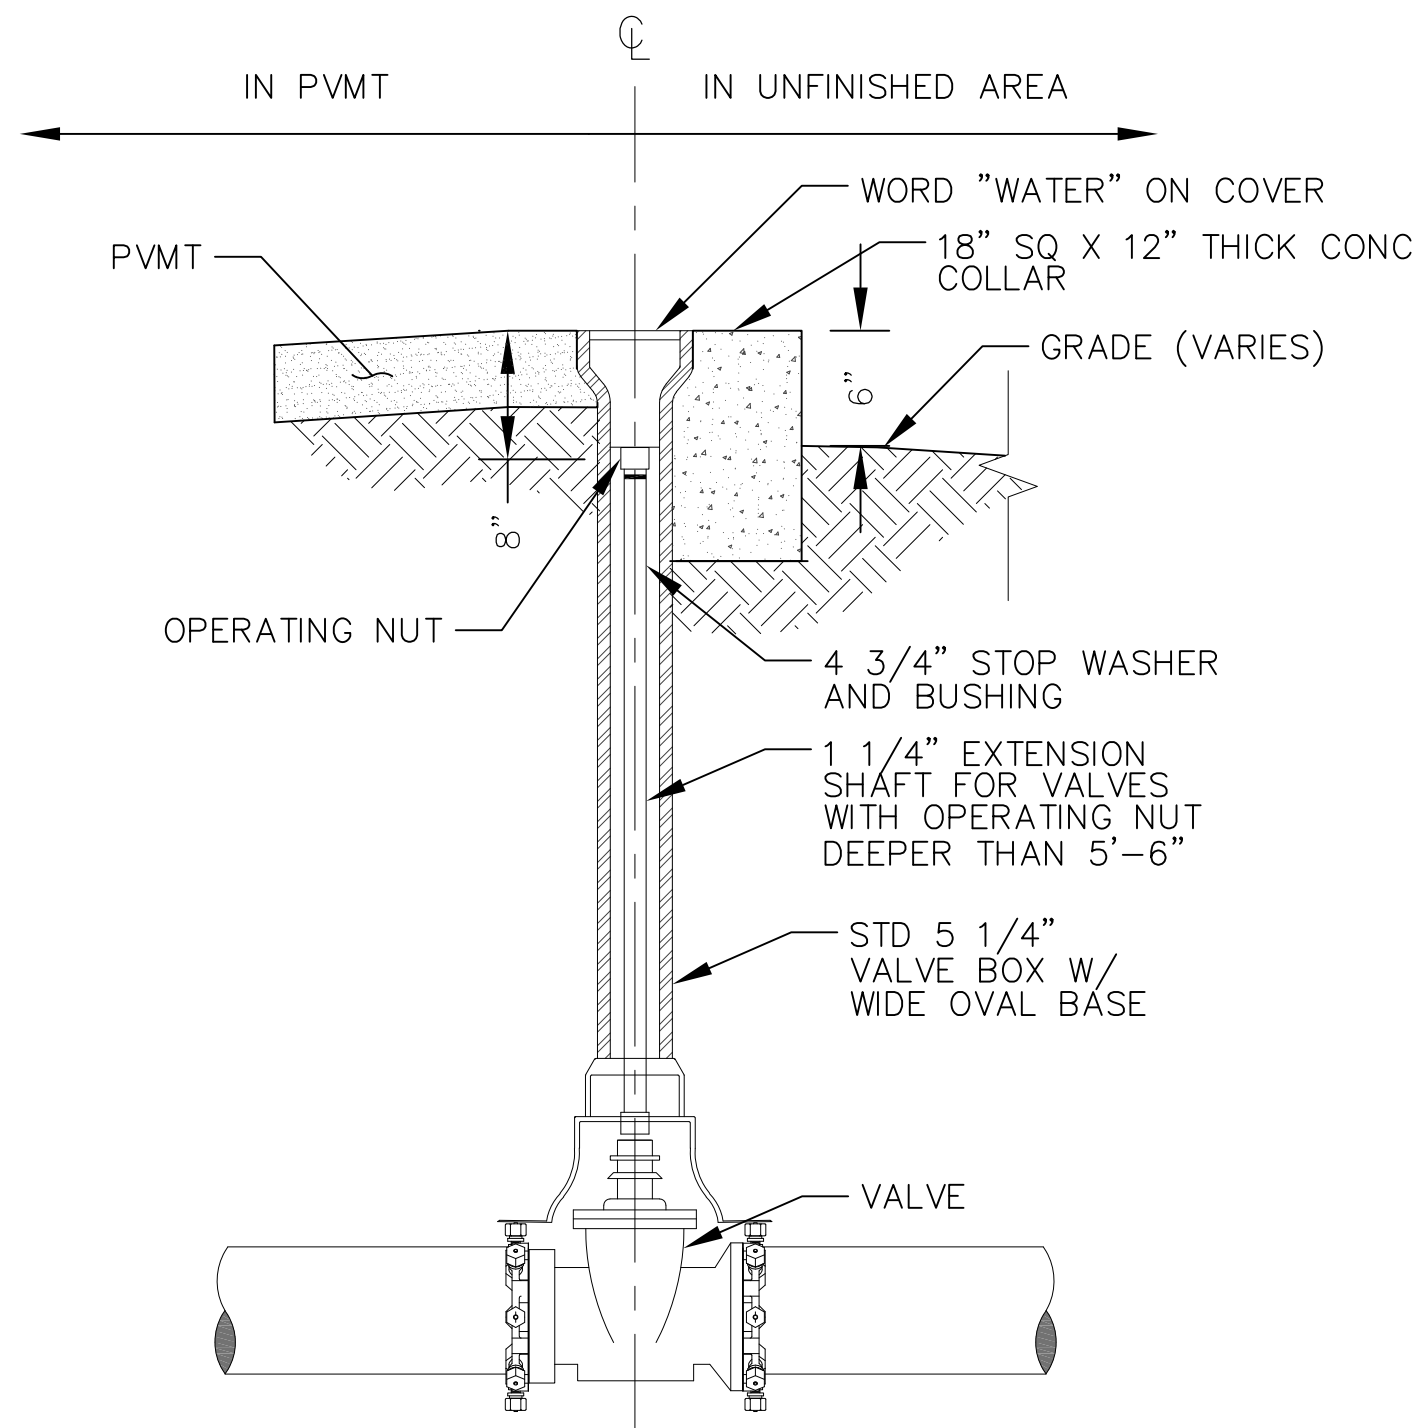


NOTES:

- IF THE DEPTH OF THE OPERATING NUT IS DEEPER THAN 5'-6", AN OPERATING NUT EXTENSION SHALL BE ATTACHED TO THE OPERATING NUT. THE EXTENSION SHALL TERMINATE 8" BELOW FINISHED GRADE.
- PROVIDE VALVE MARKER FOR ALL VALVE COVERS INSTALLED IN UNIMPROVED SURFACES.
- ALL VALVES SHALL CONNECT TO NEW AND EXISTING PIPING WITH MECHANICAL JOINT RESTRAINTS.

TYPICAL GATE VALVE DETAIL

NOT TO SCALE

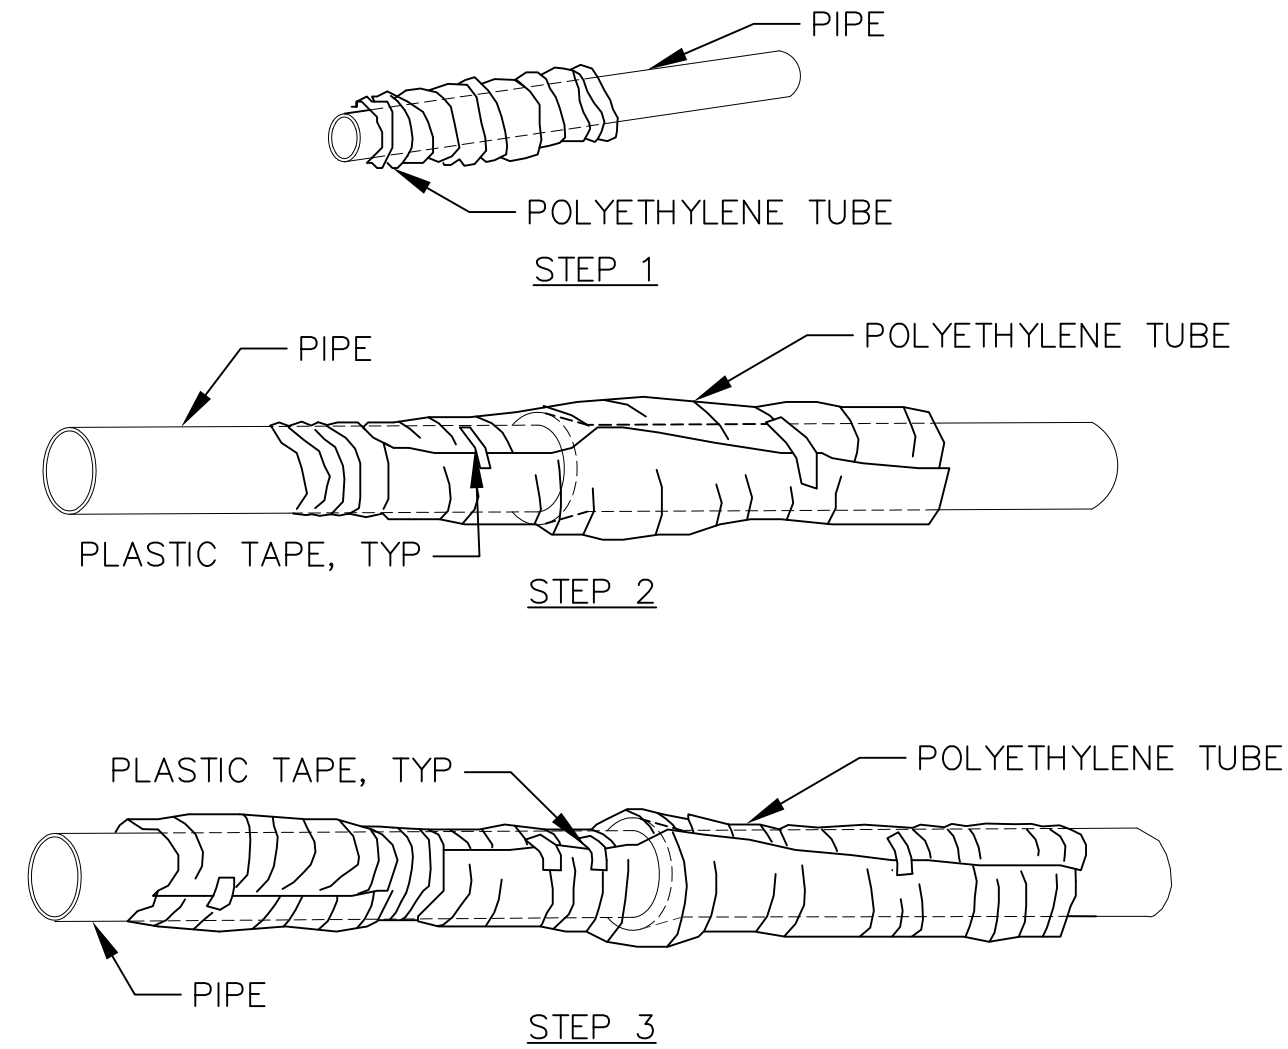

STEPS:


- PLACE TUBE OF POLYETHYLENE MATERIAL ON PIPE PRIOR TO LOWERING IT INTO TRENCH.
- PULL THE TUBE OVER THE LENGTH OF THE PIPE. TAPE TUBE TO PIPE AT JOINT. FOLD MATERIAL AROUND THE ADJACENT SPIGOT END AND WRAP WITH TAPE TO HOLD THE PLASTIC TUBE IN PLACE.
- OVERLAP FIRST TUBE WITH ADJACENT TUBE AND SECURE WITH PLASTIC ADHESIVE TAPE. THE POLYETHYLENE TUBE MATERIAL COVERING THE PIPE SHALL BE LOOSE. EXCESS MATERIAL SHALL BE NEATLY DRAWN UP AROUND THE PIPE BARREL, FOLDED ON TOP OF PIPE AND TAPED IN PLACE.

POLYETHYLENE ENCASEMENT DETAIL

NOT TO SCALE

NOTE:

- ALL 2" PIPING SHALL BE THREADED COPPER
- ALL VALVES SHALL BE BRASS
- PROVIDE 12" OF SLACK TRACE WIRE IN BOX

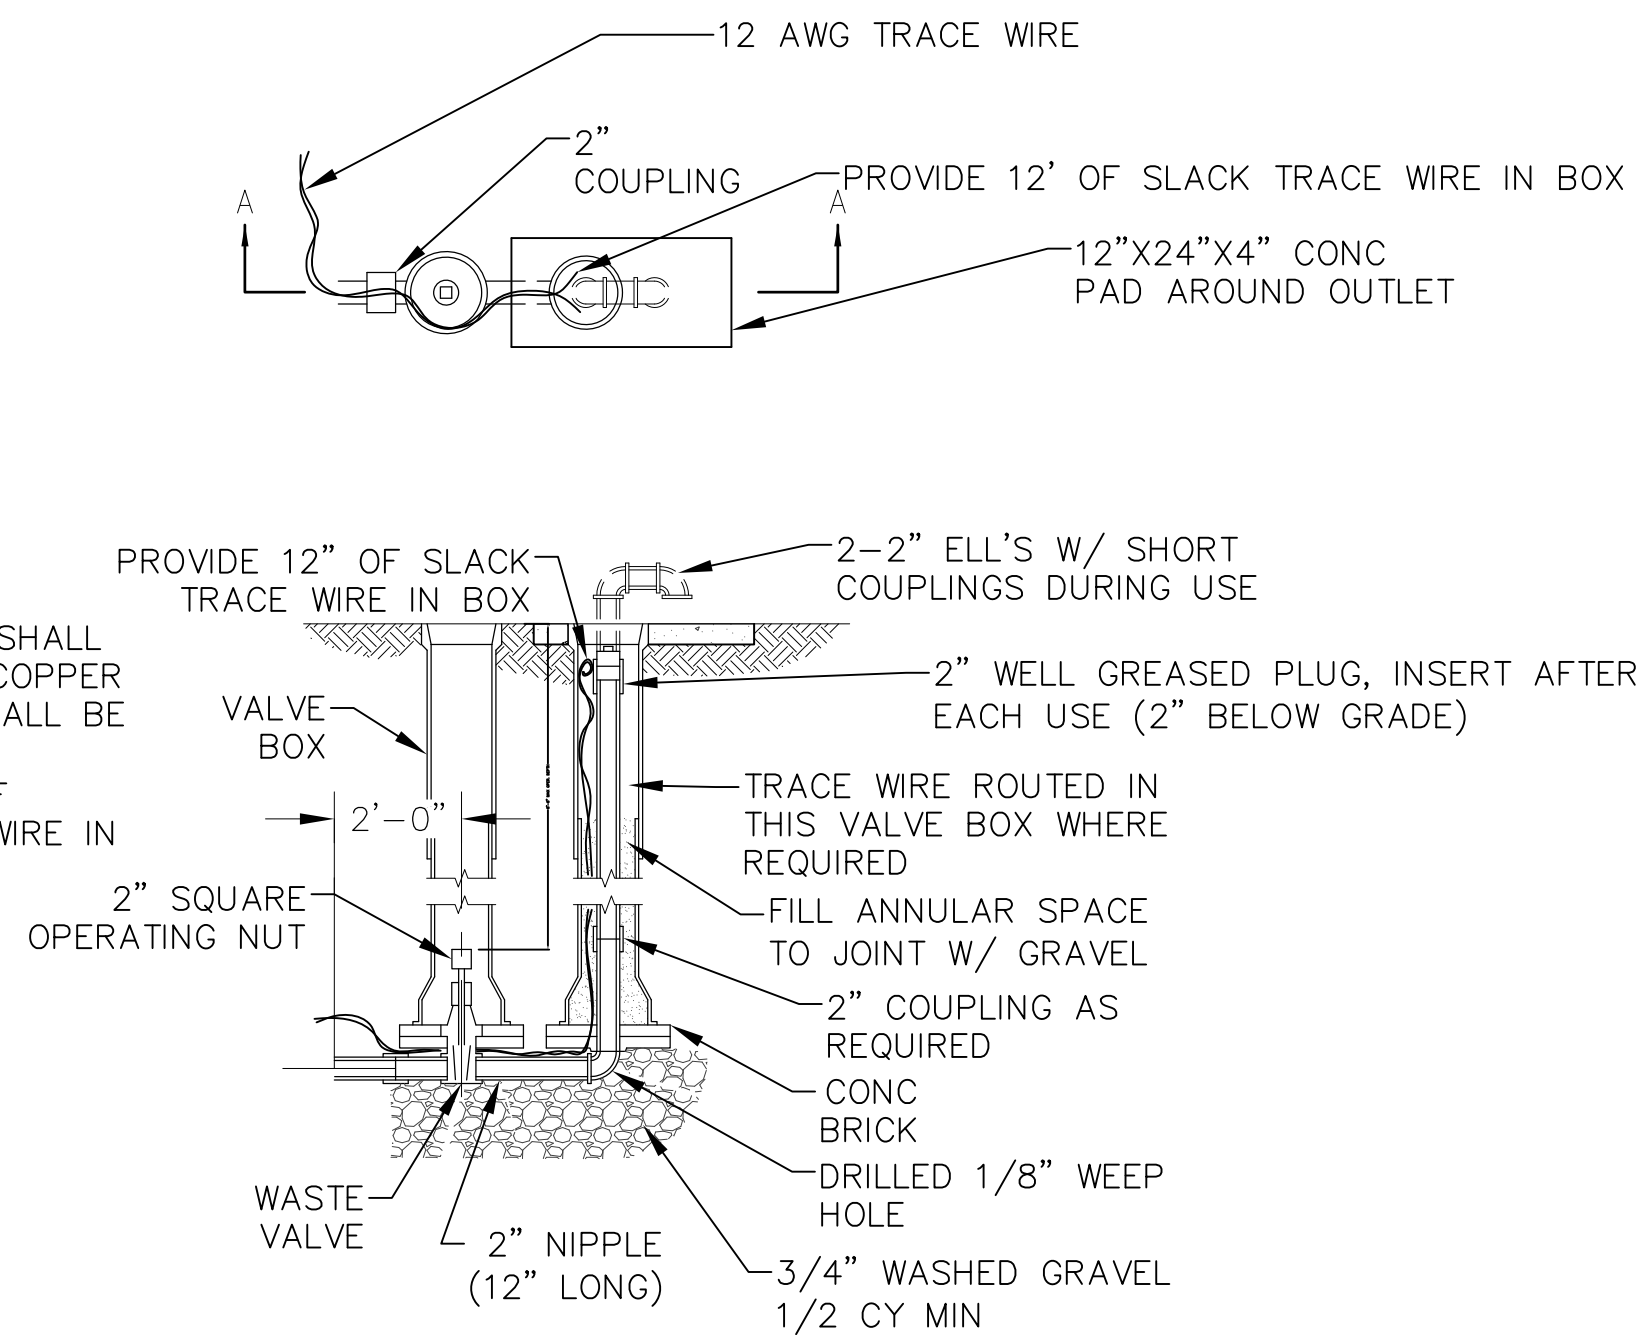

SECTION A-A

TYPICAL BLOWOFF DETAIL

NOT TO SCALE

AS-BUILTS

ROXBOROUGH WATER AND SANITATION DISTRICT  
RAVENNA PHASE II WATER CONNECTION INFRASTRUCTURE

STANDARD CIVIL DETAILS - SHEET 1 OF 2

TST

TST INFRASTRUCTURE, LLC  
Consulting Engineers

DATE: **NOVEMBER 2019**

JOB NO. **001.335.01**


RWSD

DRAWING NO.

C11




H:\Drawings\Roxborough\001.335.00 - Ravenna WS Impr Design\Sheets\Civil\New PRV Vault Detail.dwg, PRV - NORTH CONNECTION - C13, 12/10/2019 10:14 AM

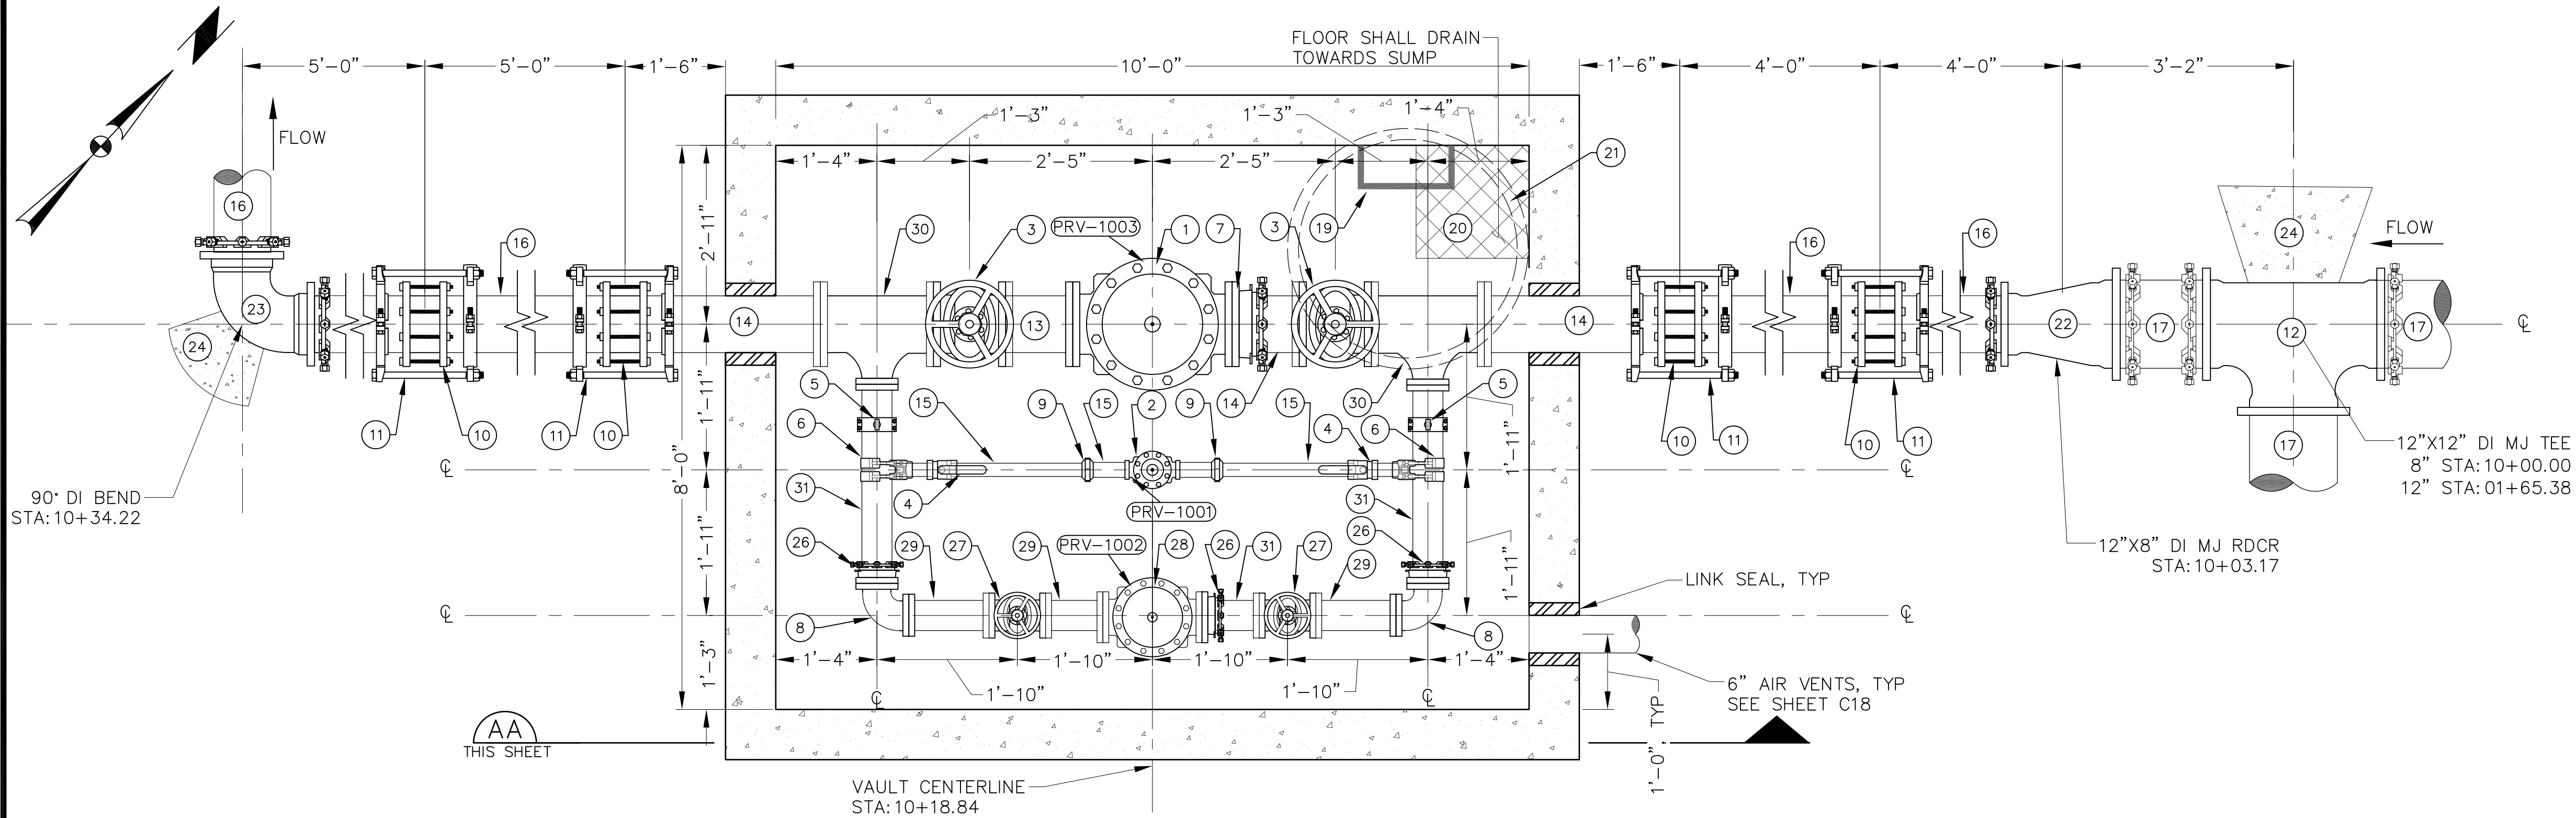

9 NORTH CONNECTION PRV PLAN  
SCALE: 3/4" = 1'-0"

NOTES:  
1. SEE SHEET C18 FOR VAULT DETAILS

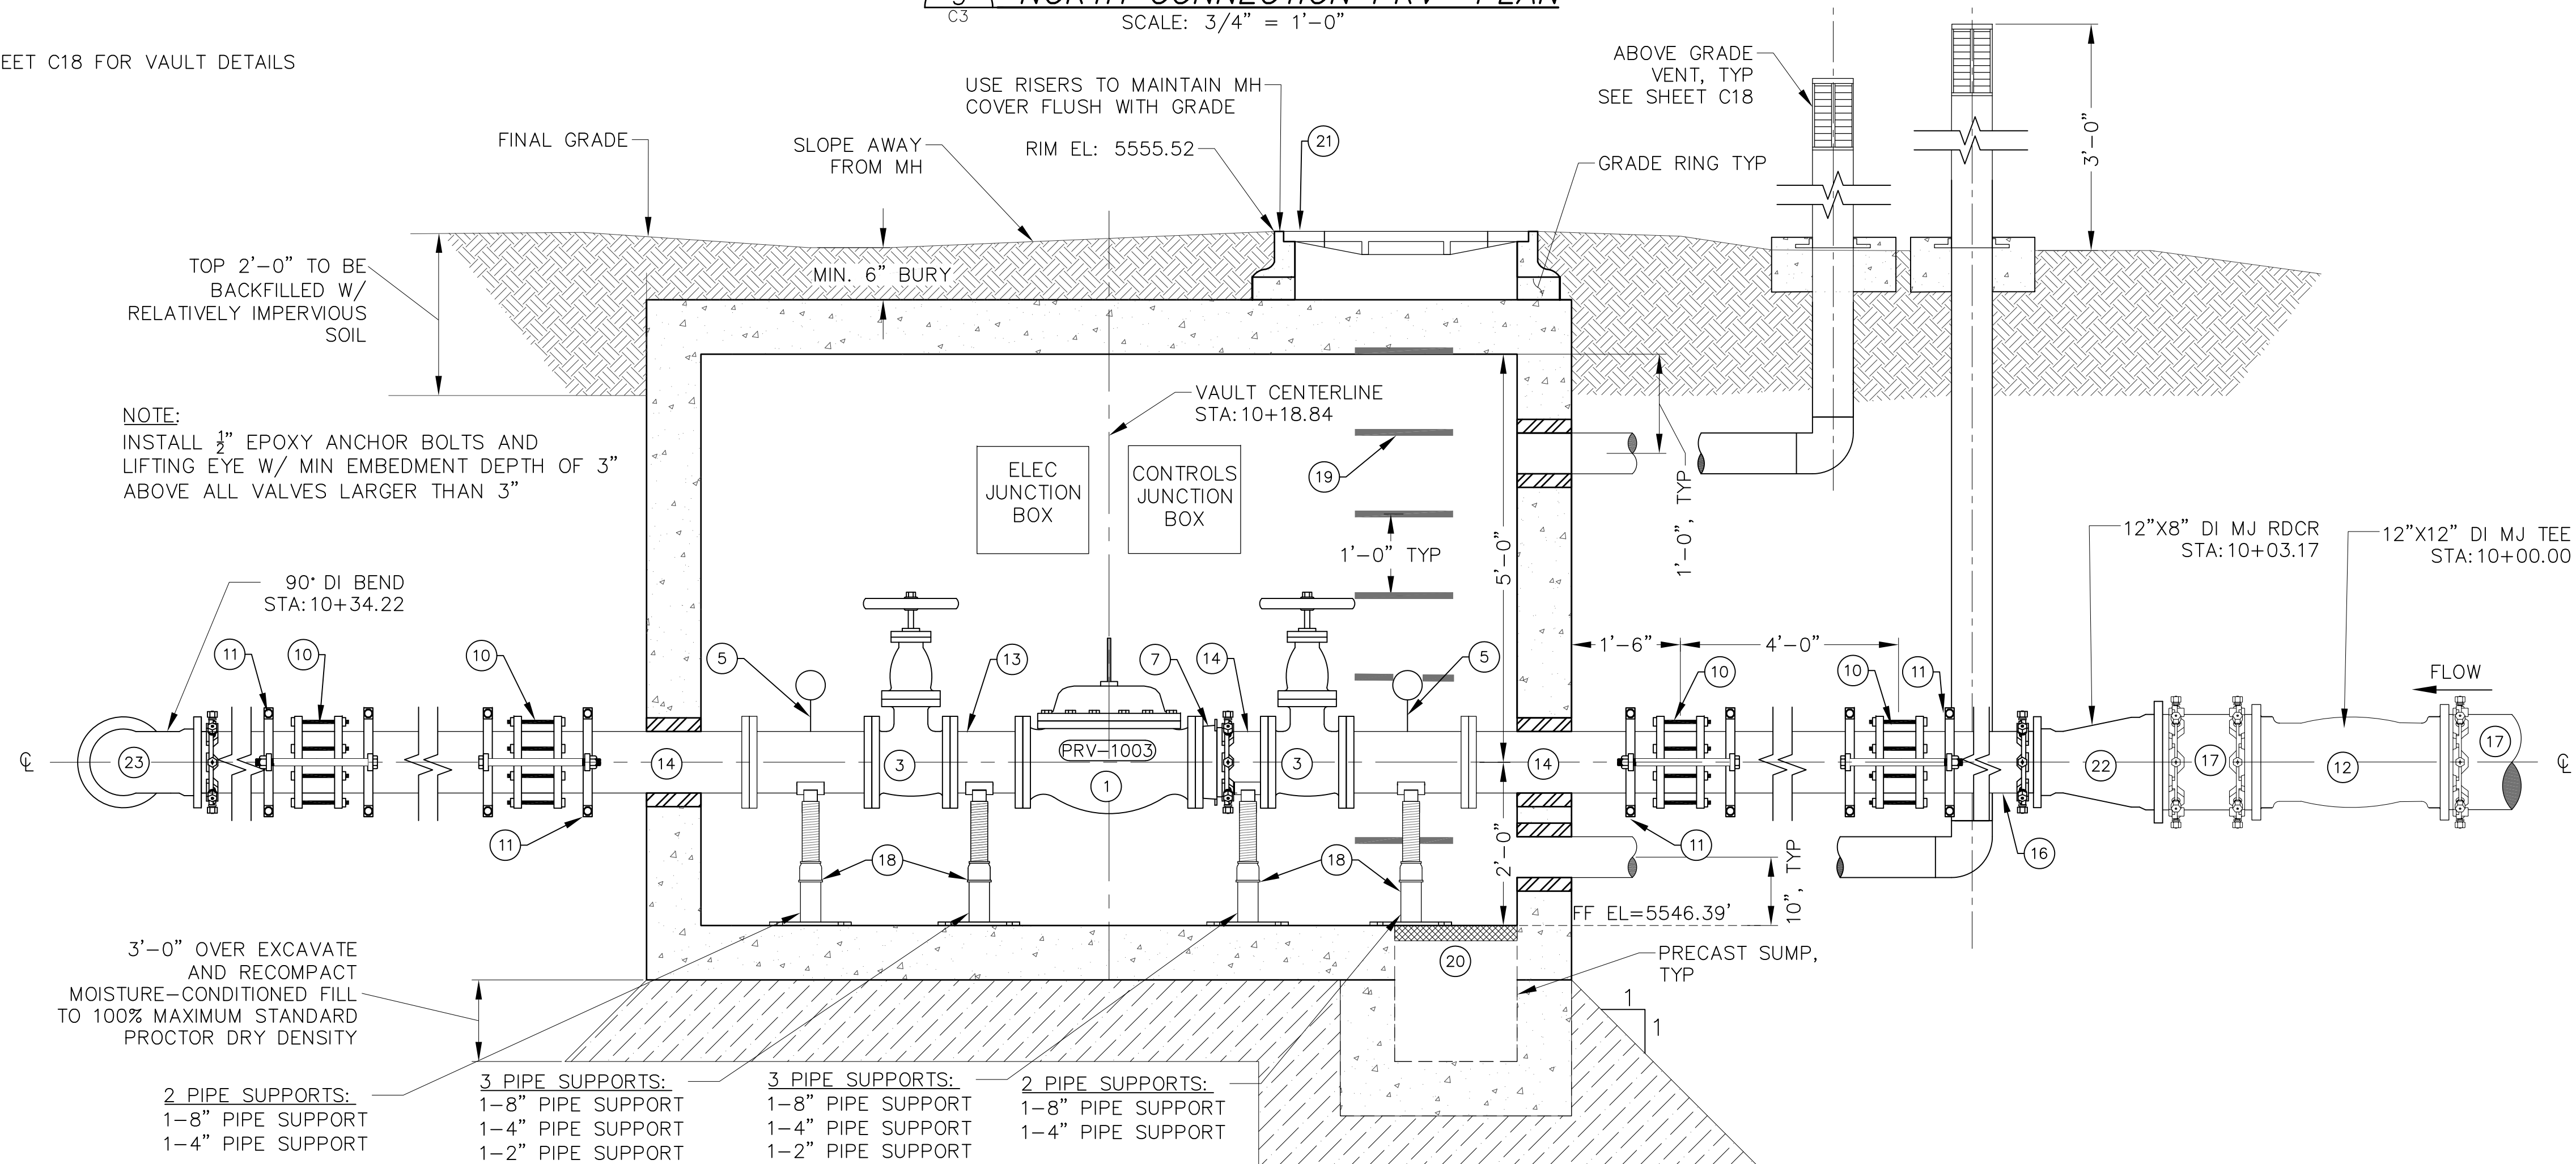

AA NORTH CONNECTION PRV SECTION  
SCALE: 3/4" = 1'-0"

ITEM	DESCRIPTION
1	PRV 1003 - 8" FLG
2	PRV 1001 - 2" NPT
3	8" FLG GV ASSY
4	2" SOLDER JOINT BRASS BALL VALVE
5	PRESSURE GAUGE ASSY
6	4" x 2" SERVICE SADDLE
7	8" RFCA
8	4" DI 90° FLG BEND
9	2" UNION
10	8" COUPLING
11	MIDSPAN PIPE RESTRAINT W/ RESTRAINT LUGS AND (2) 3/4" SST RODS
12	12"X12"X12" DI MJ TEE
13	8" FLG DIP SPOOL
14	8" FLG x PE DIP
15	2" COPPER PIPE
16	8" C-900 PVC
17	12" C-900 PVC
18	ADJUSTABLE PIPE SUPPORT
19	VAULT STEP
20	18" x 18" x 12" SUMP W/ FRP 1.5" x 1.5" MESH GRATE
21	24" IN 36" MANHOLE COVER
22	12"X8" MJ REDUCER
23	8" DI 90° MJ BEND
24	THRUST BLOCK
25	NOT USED
26	4" RFCA
27	4" FLG GV ASSY
28	PRV 1002 - 4" FLG
29	4" FLG DIP SPOOL
30	8"X8"X4" DI FLG TEE
31	4" FLG X PE DIP
32	2"X1" TEE

ROXBOROUGH WATER AND SANITATION DISTRICT  
RAVENNA PHASE II WATER CONNECTION INFRASTRUCTURE

NORTH CONNECTION PRV VAULT - SHEET 1 OF 1



TST INFRASTRUCTURE, LLC  
Consulting Engineers

DATE: NOVEMBER 2019

JOB NO. 001.335.01


RWSD

DRAWING NO.

AS-BUILTS


C13

H:\Drawings\Roxborough\001.335.00 - Ravenna WS Impr Design\Sheets\Civil\New PRV Vault Detail.dwg, PRV- EAST CONNECTION - C14, 12/10/2019 10:14 AM

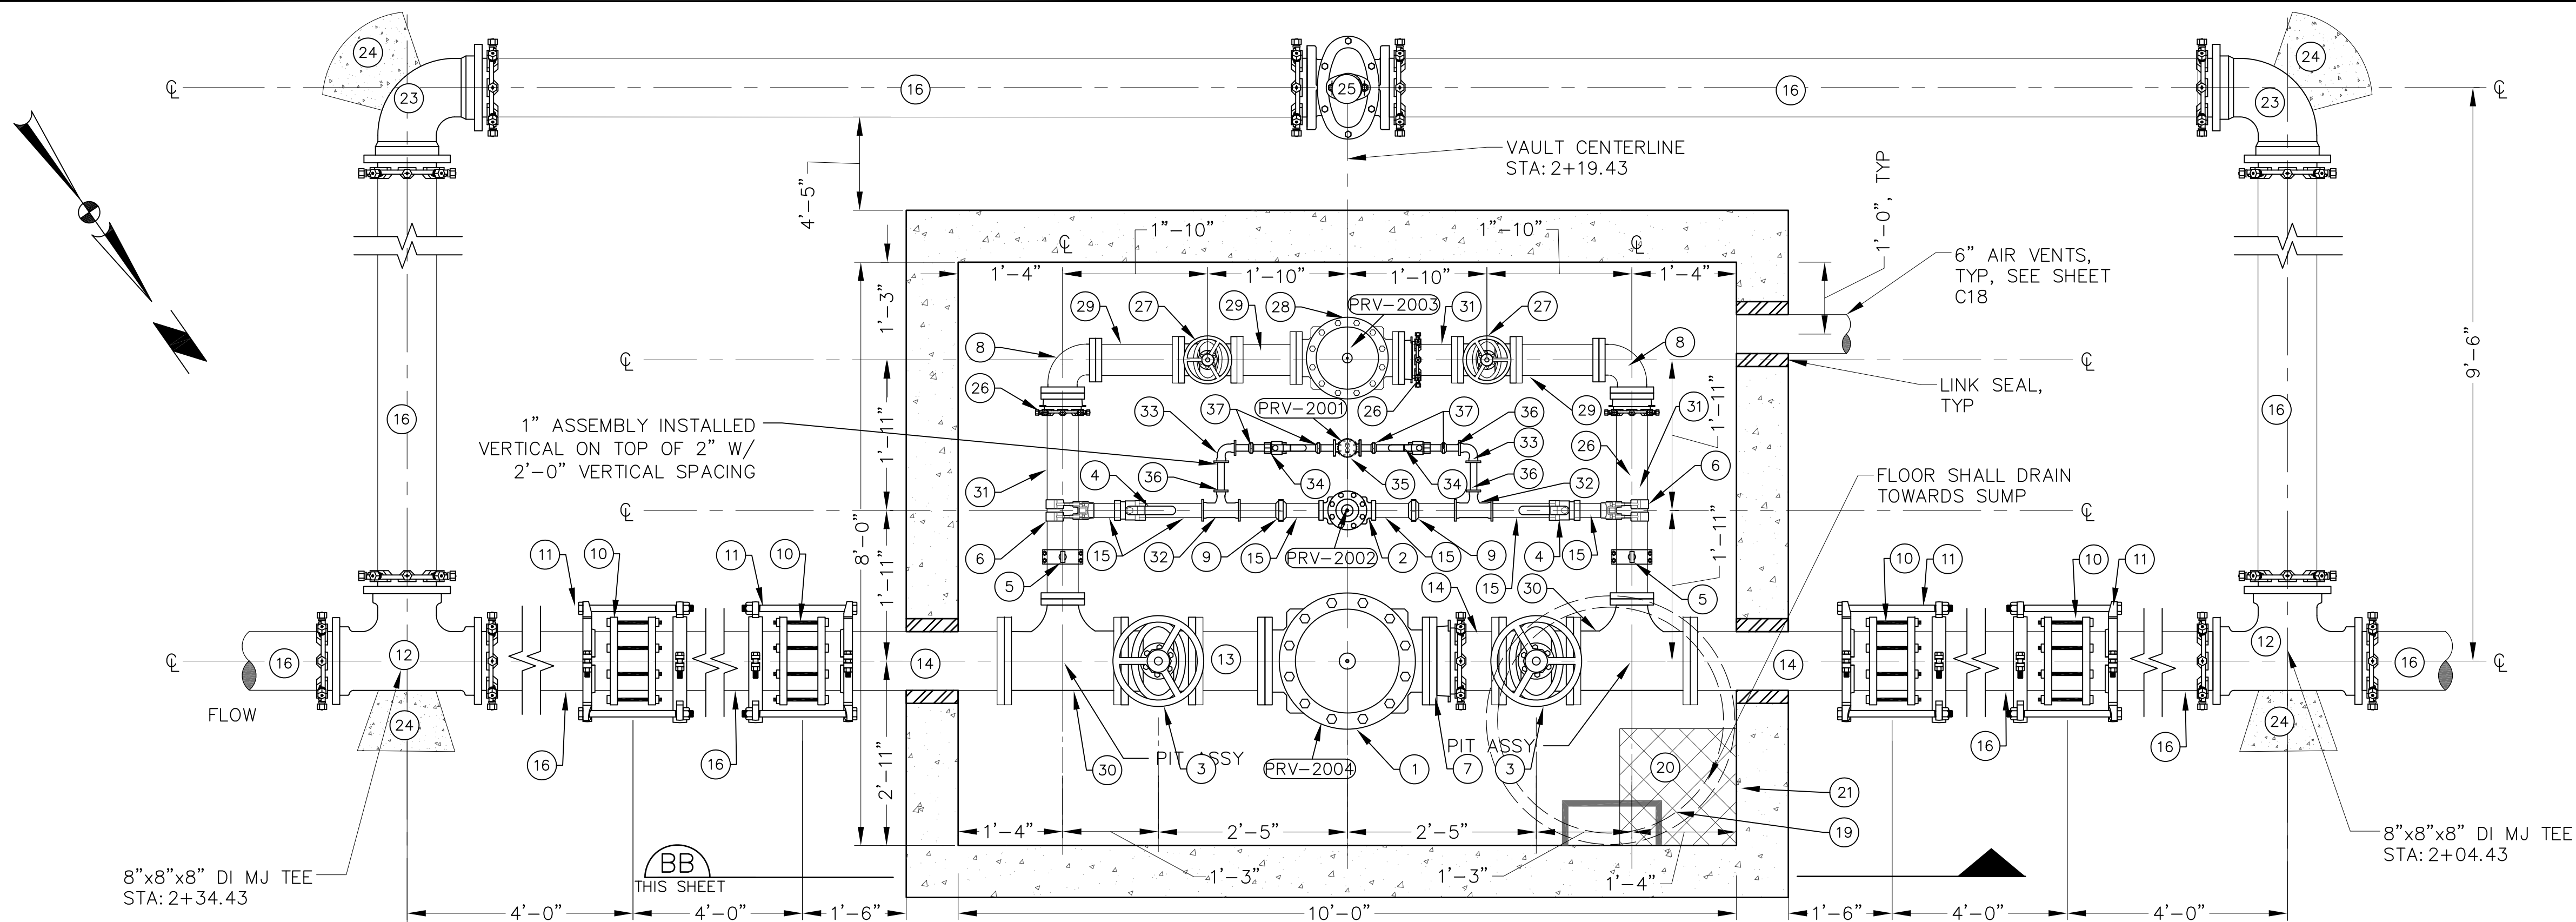

NOTES:  
1. SEE SHEET C18 FOR VAULT DETAILS

10 EAST CONNECTION PRV PLAN  
SCALE: 3/4" = 1'-0"

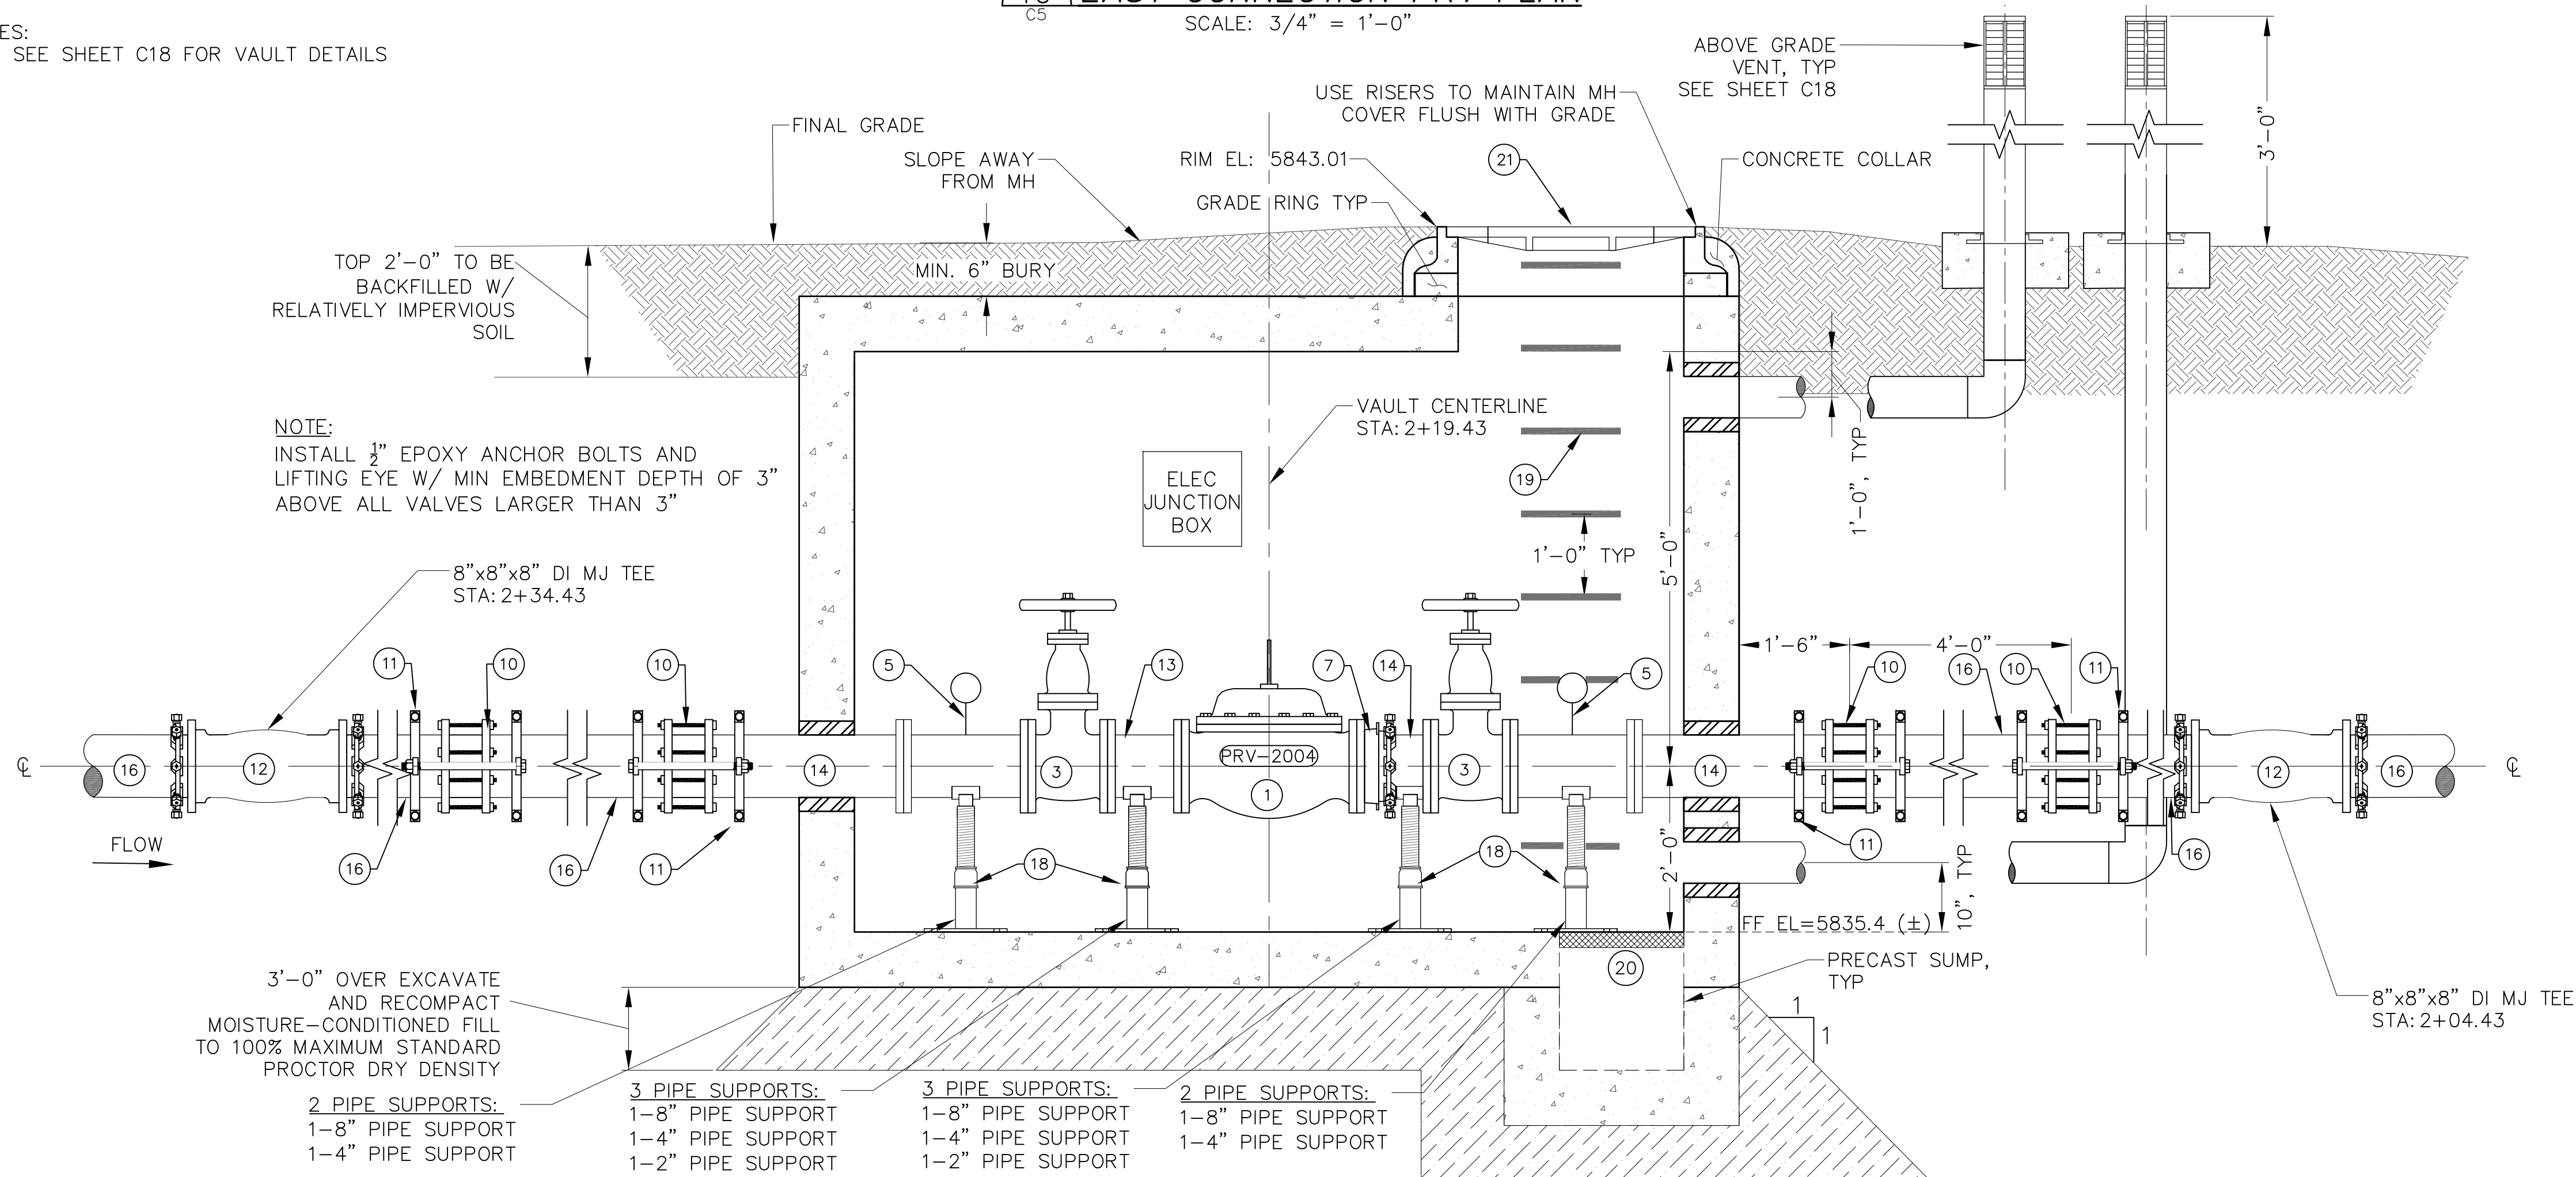

BB EAST CONNECTION PRV PROFILE  
SCALE: 3/4" = 1'-0"

ITEM	DESCRIPTION
1	PRV 2004 - 8" FLG
2	PRV 2002 - 2" NPT
3	8" FLG GV ASSY
4	2" SOLDER JOINT BRASS BALL VALVE
5	PRESSURE GAUGE ASSY
6	4" x 2" SERVICE SADDLE
7	8" RFCA
8	4" DI 90° FLG BEND
9	2" UNION
10	8" COUPLING
11	MIDSPAN PIPE RESTRAINT W/ RESTRAINT LUGS AND (2) 3/4" SST RODS
12	8"x8"x8" DI MJ TEE
13	8" FLG DIP SPOOL
14	8" FLG x PE DIP
15	2" COPPER PIPE
16	8" C-900 PVC
17	NOT USED
18	ADJUSTABLE PIPE SUPPORT
19	VAULT STEP
20	18" x 18" x 12" SUMP W/ FRP 1.5" x 1.5" MESH GRATE
21	24" IN 36" MANHOLE COVER
22	NOT USED
23	8" DI 90° MJ BEND
24	THRUST BLOCK
25	BURIED 8" MJ GV ASSY
26	4" RFCA
27	4" FLG GV ASSY
28	PRV 2003 - 4" FLG
29	4" FLG SPOOL
30	8"x8"x4" DI FLG TEE
31	4" FLG X PE DIP
32	2"x1" TEE (SOLDER)
33	1" 90° BEND (SOLDER)
34	1" SOLDER JOINT BRASS BALL VALVE
35	PRV 2001 - 1" NPT
36	1" COPPER PIPE
37	1" SOLDER UNION

AS-BUILTS

ROXBOROUGH WATER AND SANITATION DISTRICT  
RAVENNA PHASE II WATER CONNECTION INFRASTRUCTURE

EAST CONNECTION PRV VAULT - SHEET 1 OF 1

TST

TST INFRASTRUCTURE, LLC  
Consulting Engineers

DATE: NOVEMBER 2019

JOB NO. 001.335.01

RWSD


DRAWING NO.

C14

H:\Drawings\Roxborough\001.335.00 - Ravenna WS Impr. Design\Sheets\Civil\PRV Relocation.dwg, C15, 12/10/2019 10:14 AM



EX PRV RELOCATION  
SCALE: 1" = 50'

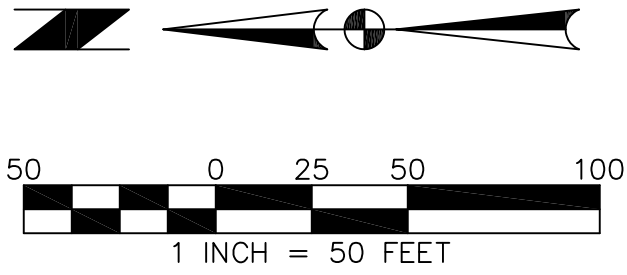


AS-BUILTS


REVISIONS		Description	
By	Date	AS-BUILT	
ACP	11/22/2019		
DESIGNED:		JDB	
CHECKED:		MKM	
DRAWING:		SDH	
1 INCH		BARS PLOT 1 INCH x 1 INCH AT FULL SCALE	
ROXBOROUGH WATER AND SANITATION DISTRICT			
RAVENNA PHASE II WATER CONNECTION INFRASTRUCTURE			
DRAWING			
EX PRV RELOCATION PLAN - SHEET 1 OF 1			
TST			
TST INFRASTRUCTURE, LLC Consulting Engineers			
DATE: NOVEMBER 2019			
JOB NO. 001.335.01			
RWSD			
DRAWING NO. C15			

H:\Drawings\Roxborough\001.335.00 - Ravenna WS Impr\Design\Sheets\Civil\New PRV Vault Detail.dwg, PRV RELOCATION - C16, 12/10/2019 10:14 AM


- NOTES:
1. CONTRACTOR TO COORDINATE CLOSING OF ISOLATION VALVES W/ RWSD
  2. PROVIDE AND INSTALL NEW BOLT AND GASKETS FOR INSTALLATION OF EX PRV & DIP IN NEW LOCATIONS

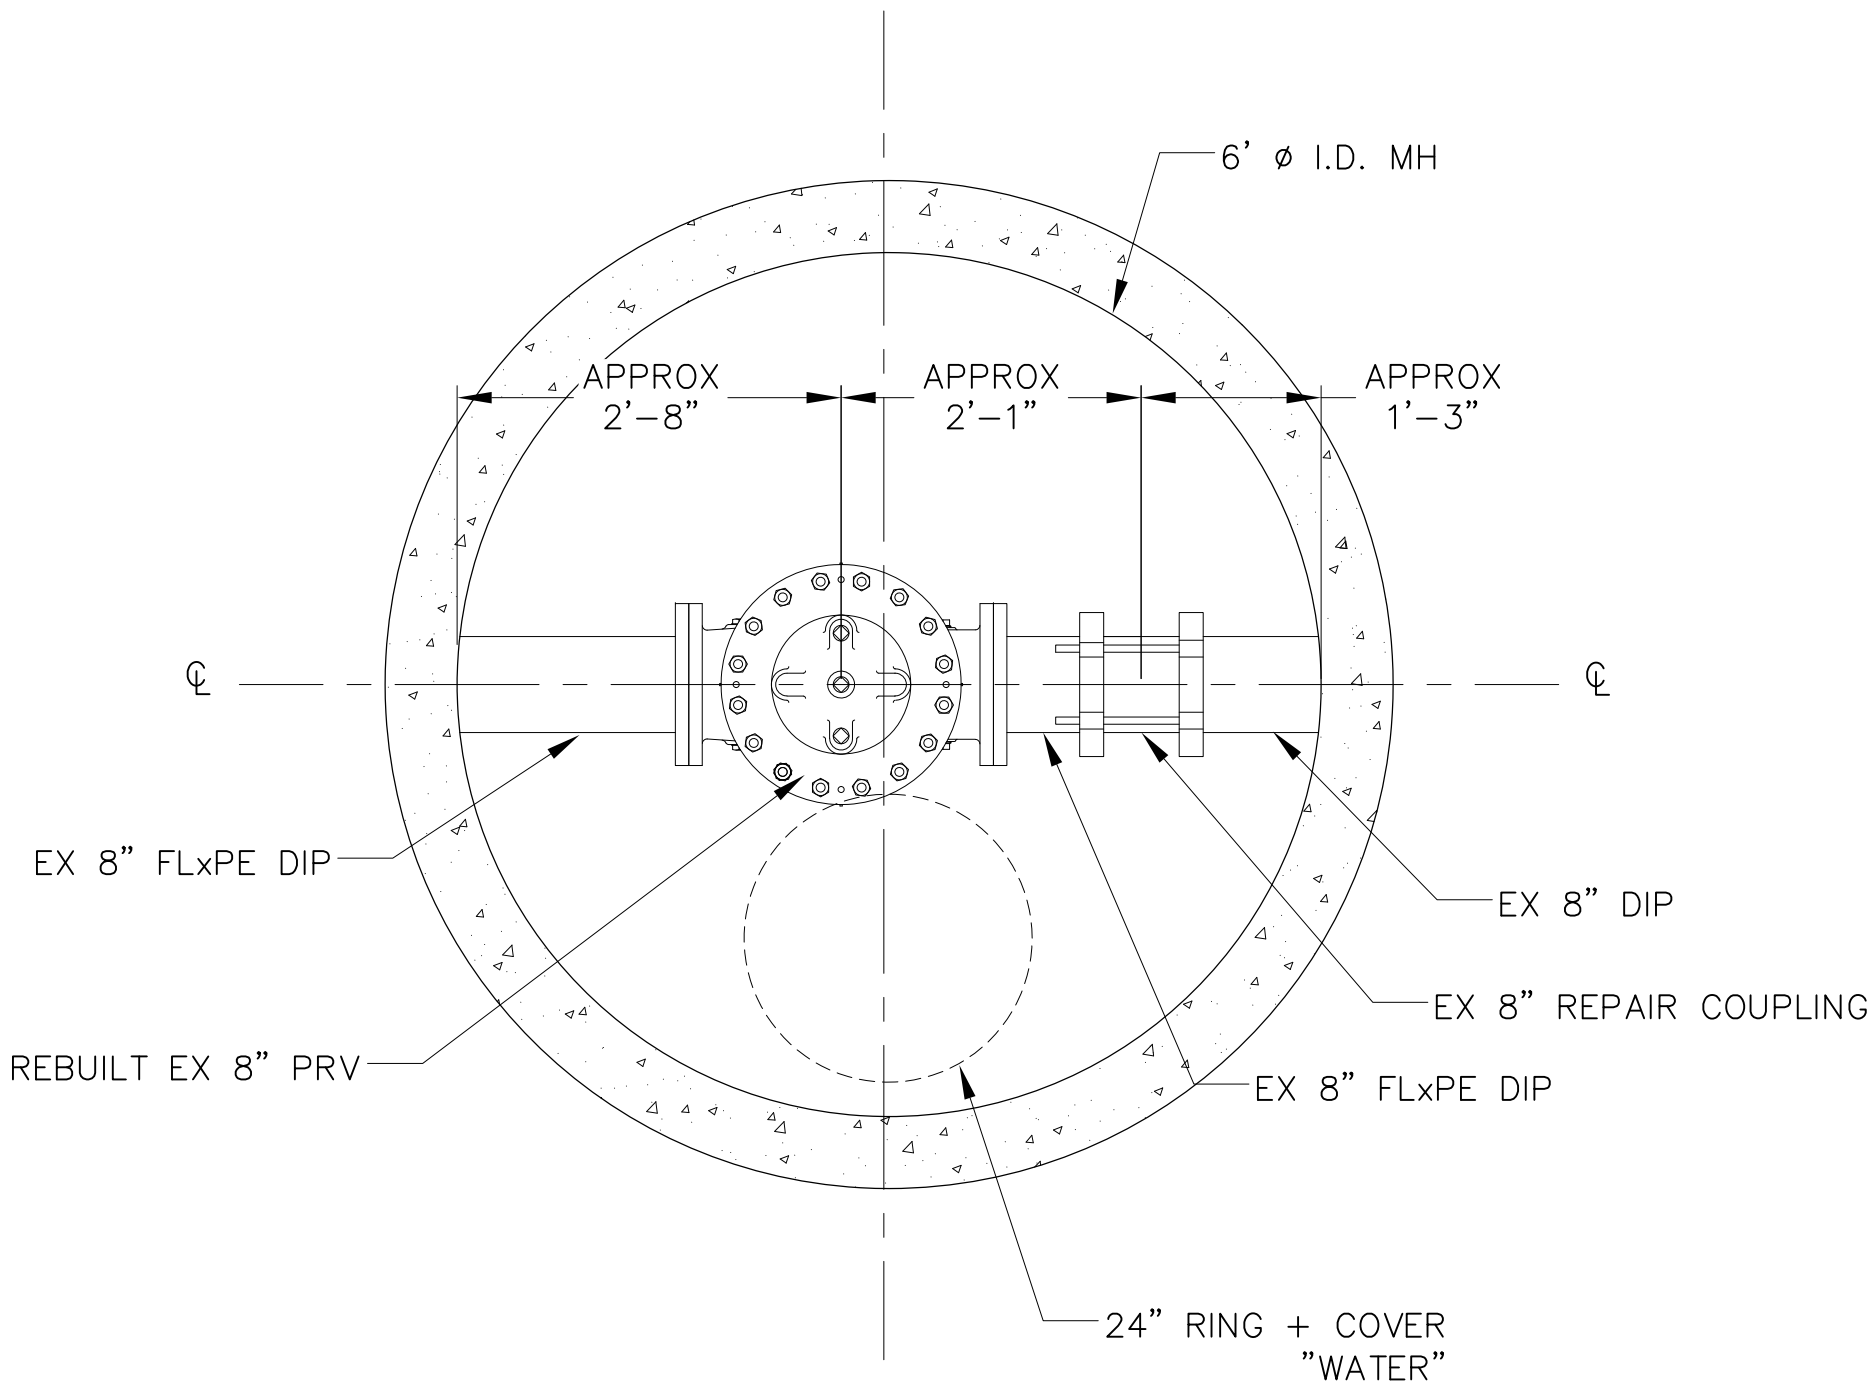

**14** EXISTING PRV LOCATION PLAN  
C15 3/4" = 1'-0"

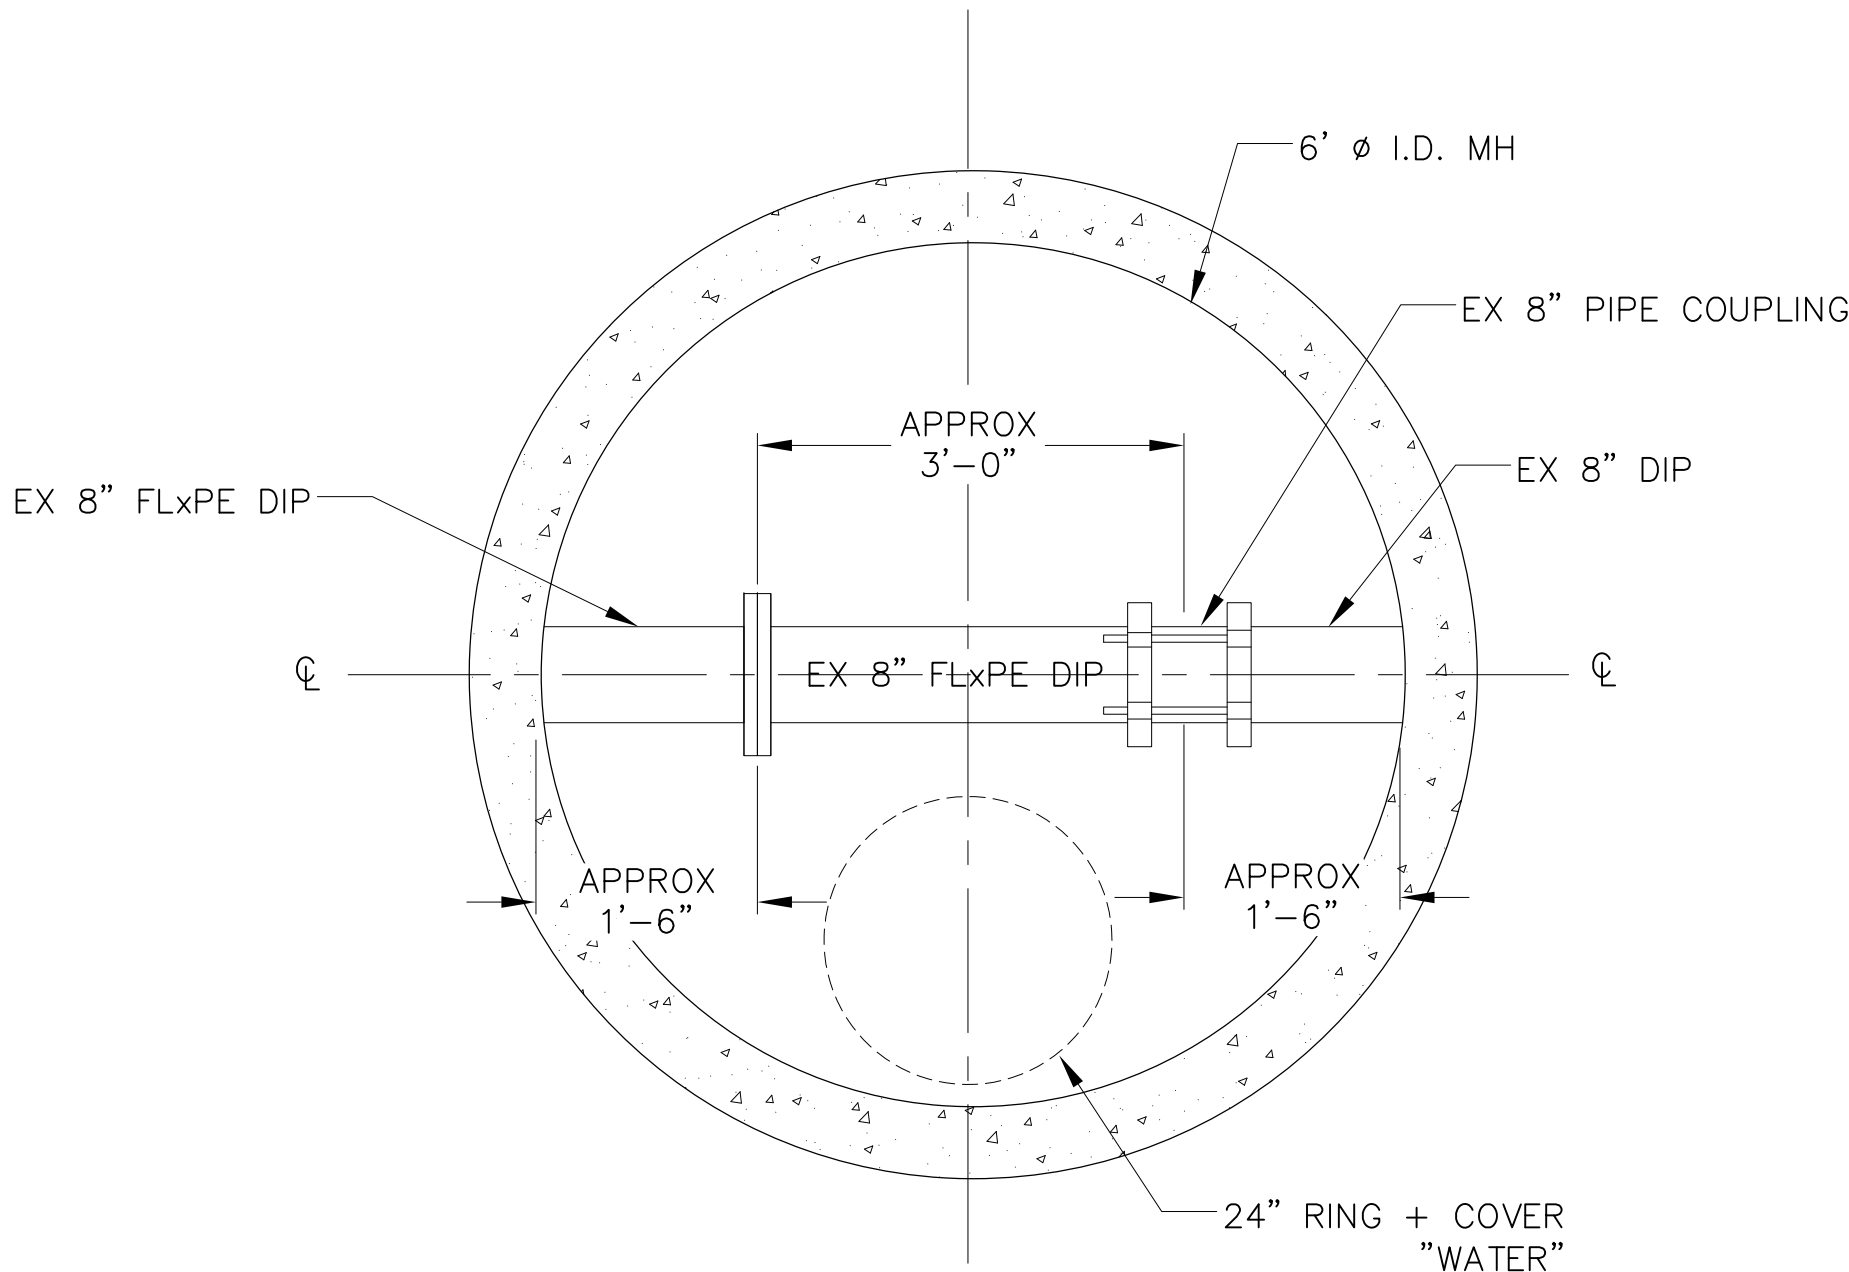

**EXISTING CONFIGURATION**

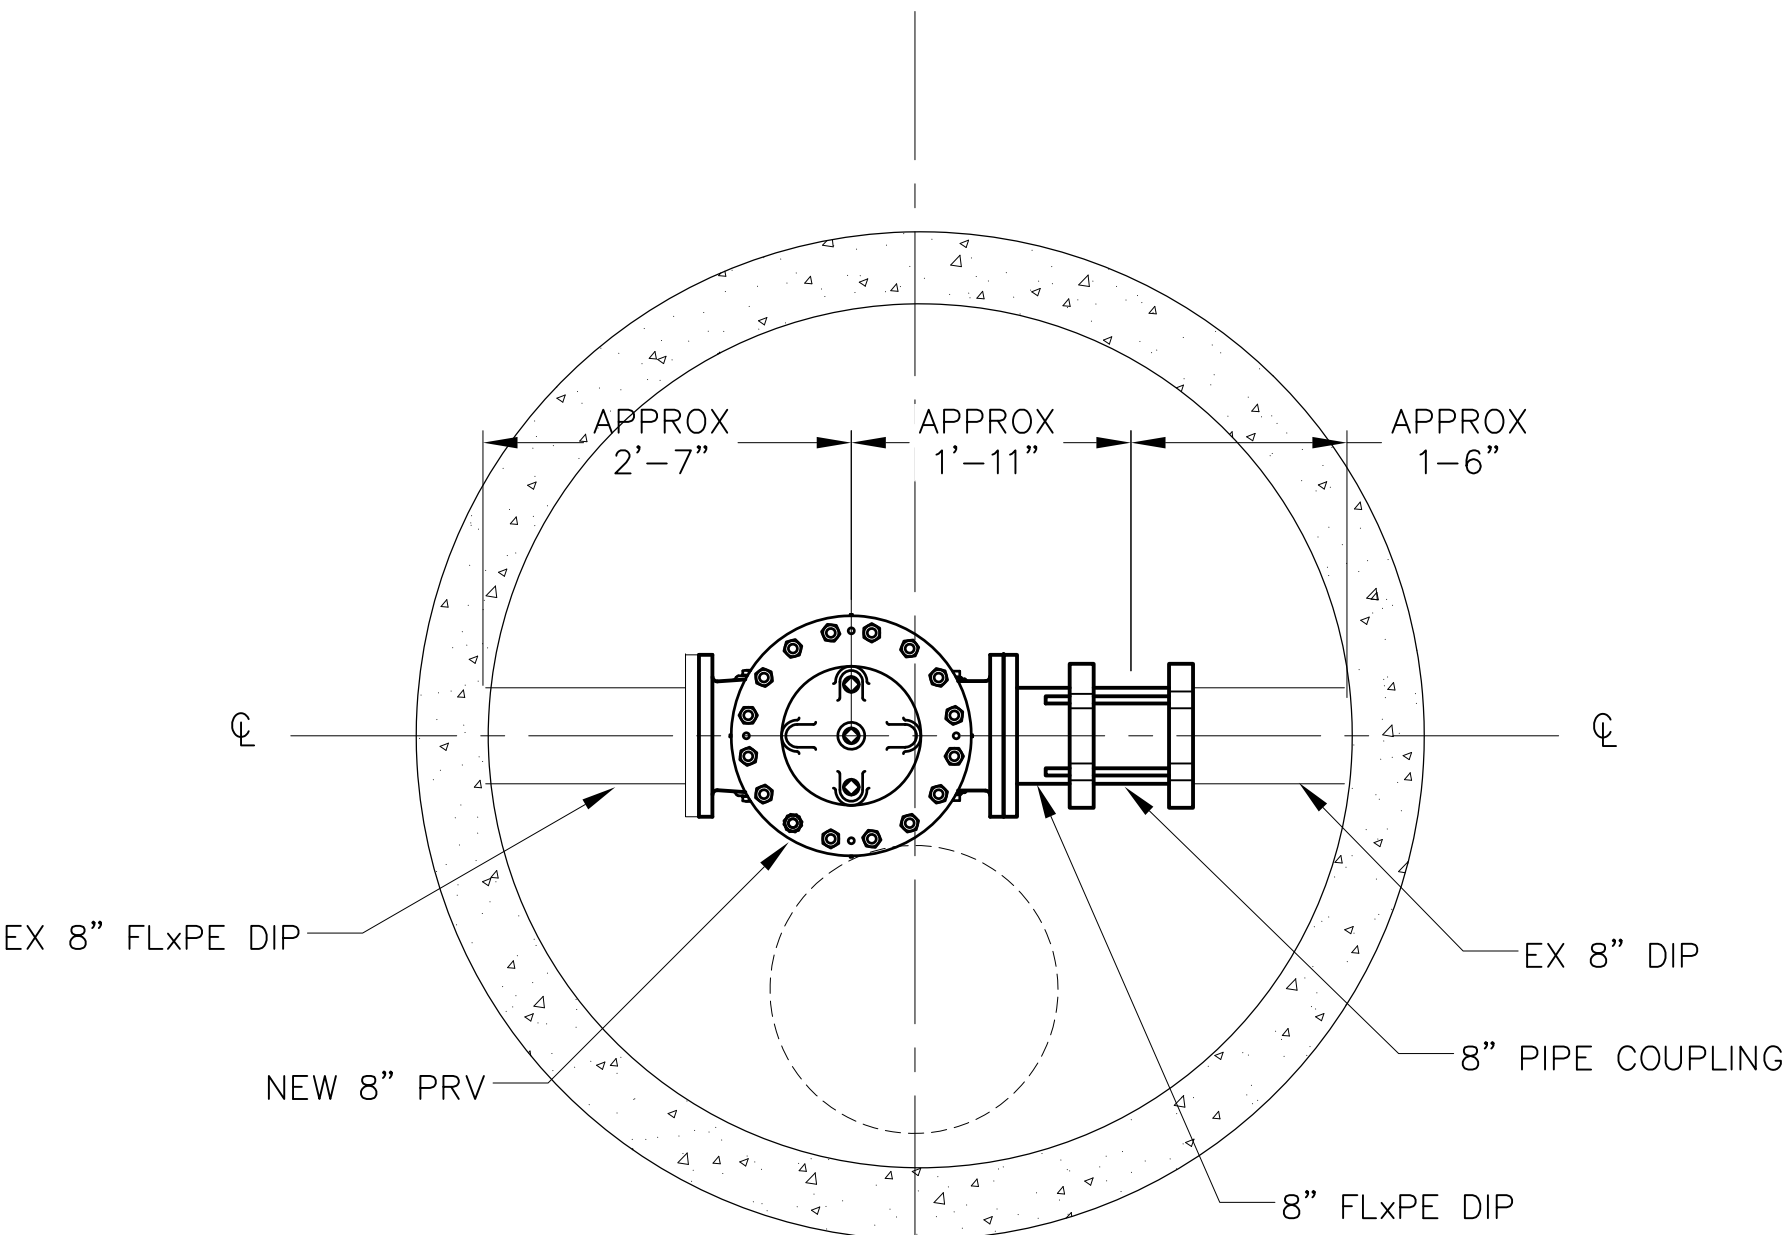




**FINAL CONFIGURATION**

**15** NEW PRV LOCATION PLAN  
C15 3/4" = 1'-0"

AS-BUILTS

REVISIONS	Description	By	Date	AS-BUILT
		ACP	11/22/2019	
DESIGNED:	JDB	CHECKED:	MKM	DRAWN:
			SDH	
1 INCH 1 INCH x 1 INCH AT FULL SCALE				BARS PLOT 1 INCH x 1 INCH AT FULL SCALE
ROXBOROUGH WATER AND SANITATION DISTRICT				
RAVENNA PHASE II WATER CONNECTION INFRASTRUCTURE				
EX PRV RELOCATION DETAILS - SHEET 1 OF 1				
TST				
TST INFRASTRUCTURE, LLC Consulting Engineers				
DATE: NOVEMBER 2019				
JOB NO. 001.335.01				
RWSD				
DRAWING NO. C16				

H:\Drawings\Roxborough\001.335.00 - Ravenna WS Impr Design\Sheets\Civil\EIC PRV Vault Detail.dwg, C17, 12/10/2019 10:14 AM

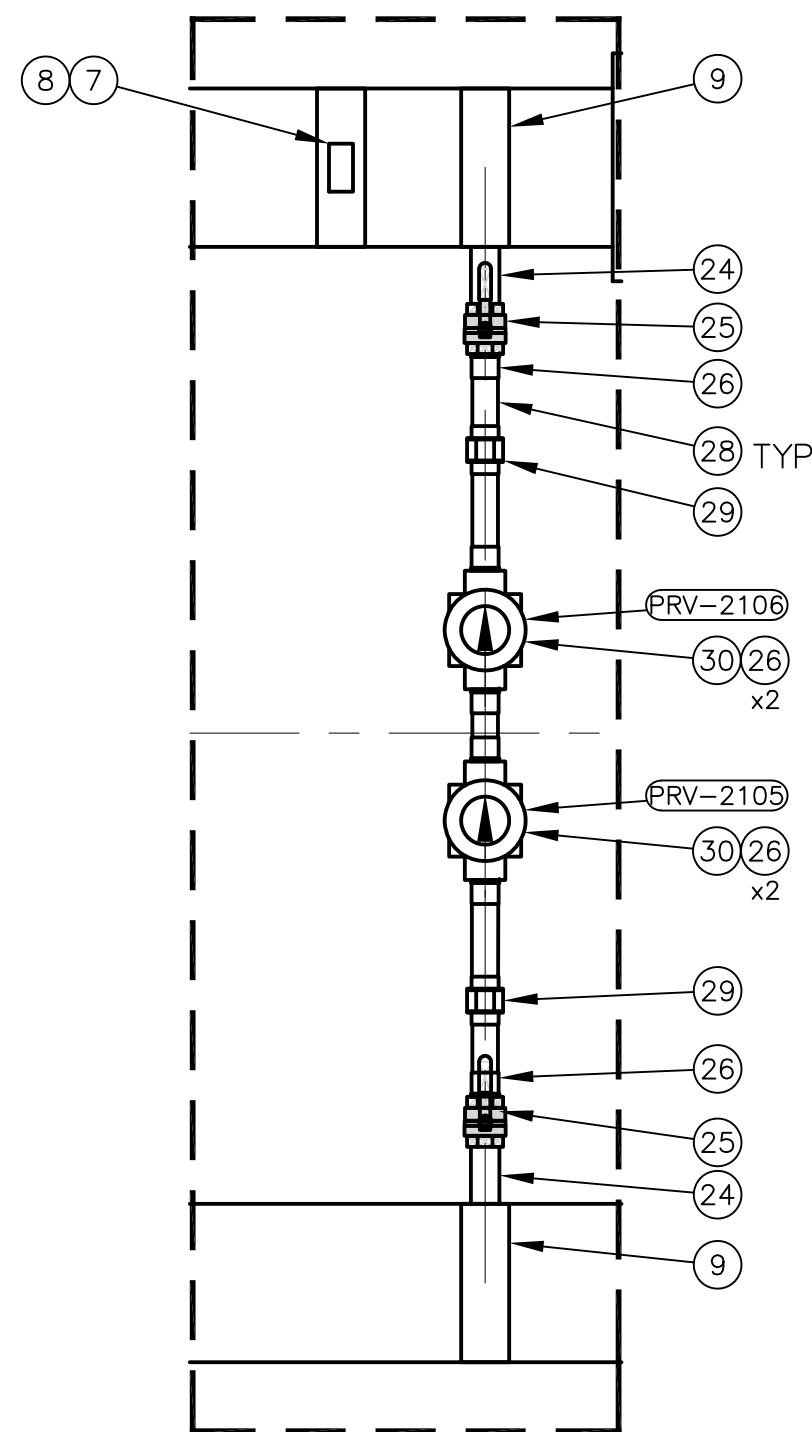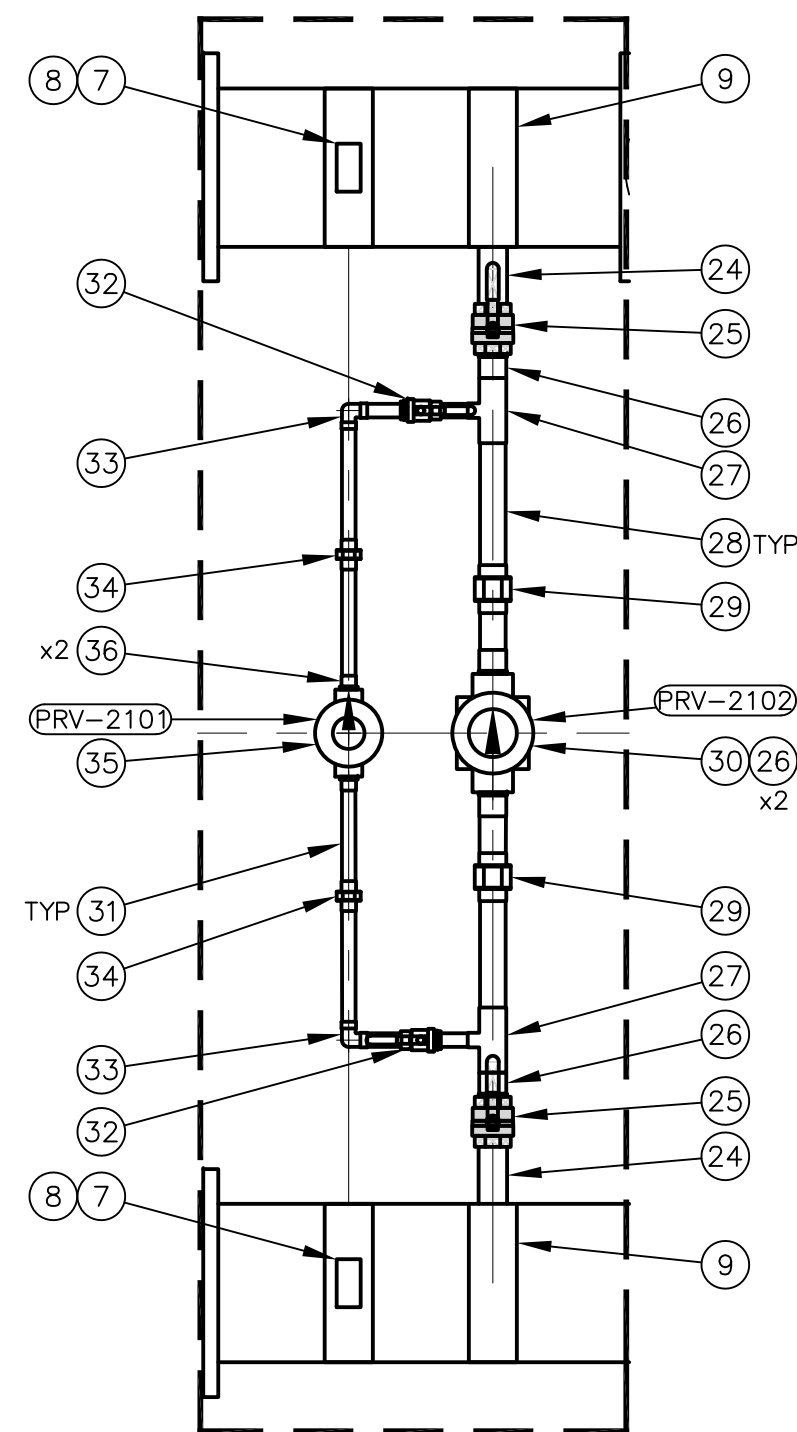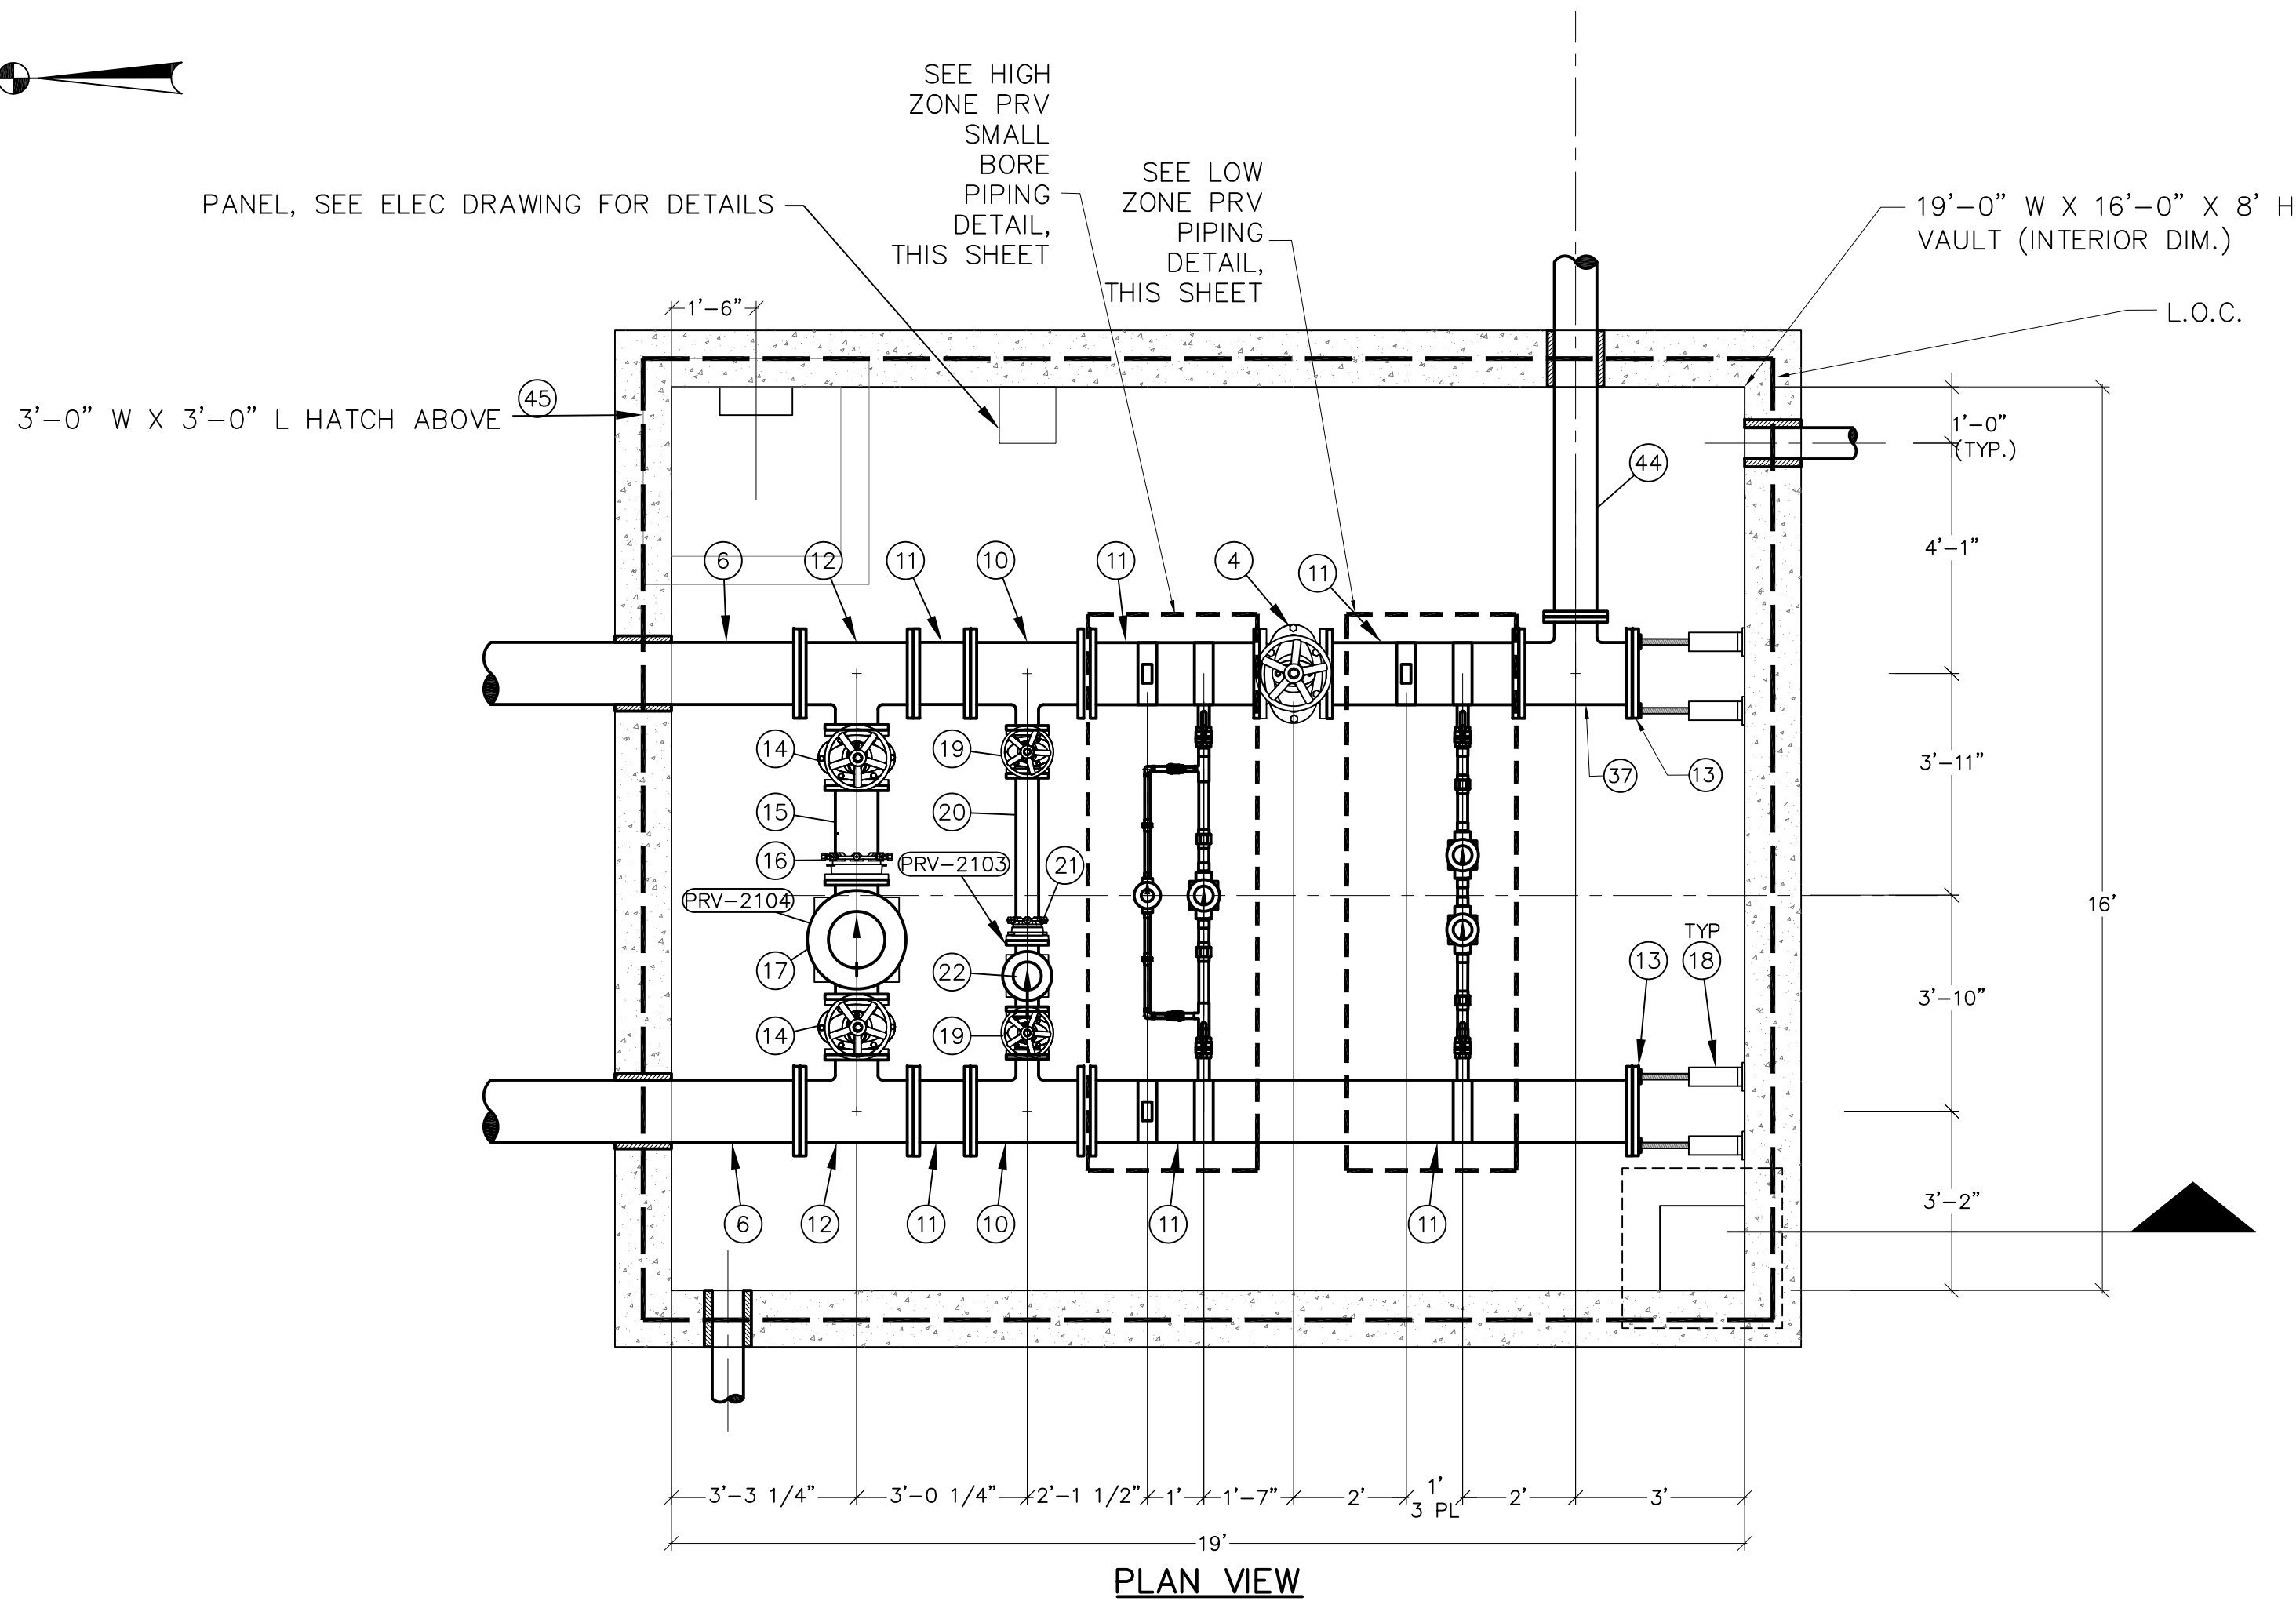

NOTES:

- ALL PIPES SHOWN ARE EXISTING AND SHALL BE PAINTED BY CONTRACTOR.
- ALL PIPING WITHIN LIMITS OF PRECAST CONCRETE VAULT STRUCTURE SHALL BE PAINTED PER SPEC SECTION 09900-PAINTING.

BILL OF MATERIALS	
ITEM	DESCRIPTION
1	12" RESTRAINED MJ DUCTILE IRON SOLID SLEEVE COUPLING
2	12" PIPE, DI CL 52
3	TEE, 12" X 12" X 12" MJ DI
4	12" GATE VALVE
5	THRUST BLOCK
6	12" FLANGE X PLAIN END SPOOL
7	12" X 3/4" SERVICE SADDLE
8	PRESSURE GAUGE/TRANSMITTER DETAIL
9	12" X 2" SERVICE SADDLE
10	12" X 12" X 4" FLANGED DUCTILE IRON TEE
11	12" FLANGE X FLANGE, DIP SPOOL
12	12" X 12" X 8" FLANGED DUCTILE IRON TEE
13	12" DIP BLIND FLANGE
14	8" FLANGED GATE VALVE
15	8" PIPE, FLNG X PL, DIP SPOOL
16	8" RESTRAINED FLANGED COUPLING ADAPTER
17	8" PRESSURE REDUCING VALVE, FLNG
18	ADJ PIPE SUPPORT, SEE SHEET C25
19	4" FLANGED GATE VALVE
20	4" FLANGE X PLAIN END DIP SPOOL
21	4" RESTRAINED FLANGED COUPLING ADAPTER
22	4" FLANGED PRESSURE REDUCING VALVE
23	8" PIPE, DI CL 52
24	2" NIPPLE, MPT, BRASS
25	2" BALL VALVE, FPT, BRASS
26	2" MALE ADAPTER, MPT X SOC, CU
27	2" X 2" X 1" COPPER SOLDER JOINT TEE
28	2" PIPE, CU TYPE M
29	2" UNION, SOC, CU
30	2" PRESSURE REDUCING VALVE, FPT
31	1" PIPE, CU TYPE M
32	1" BALL VALVE, SOC, BRASS
33	1" ELBOW, 90 SOC, CU
34	1" UNION, SOC, CU
35	1/2" PRESSURE REDUCING VALVE, FPT
36	1/2" MPT X 1" SOC MALE ADAPTER, MPT X SOC, CU
37	12" X 12" X 8" TEE, REDUCING, DI
38	8" RESTRAINED MJ DUCTILE IRON SOLID SLEEVE COUPLING
39	12" MEGALUG
40	8" MEGALUG
41	12" LINK SEAL
42	8" LINK SEAL
43	12" PIPE, PVC C905 SDR 14
44	8" PIPE, FLNG X PL SPOOL, DI
45	HATCH, 3' X 3' OPENING

ROXBOROUGH WATER AND SANITATION DISTRICT  
RAVENNA PHASE II WATER CONNECTION INFRASTRUCTURE

EMERGENCY INTERCONNECT VAULT PAINTING PLAN - SHEET 1 OF 1




DATE: **NOVEMBER 2019**

JOB NO. **001.335.01**


**RWSD**

DRAWING NO.


**C17**

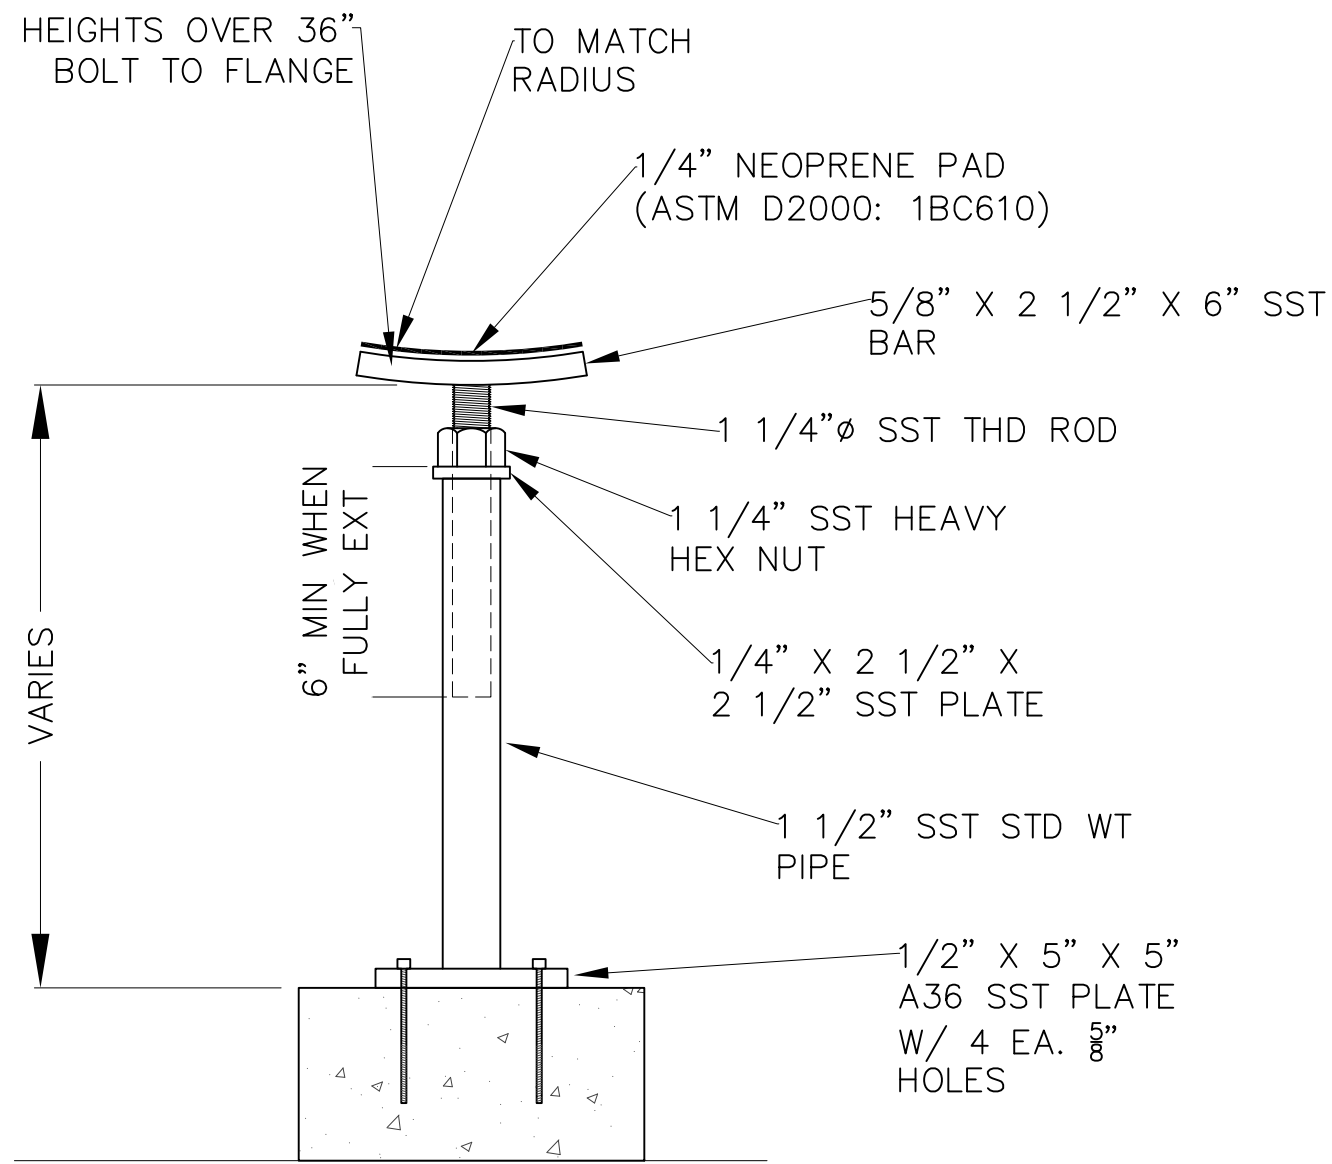


ADJUSTABLE PIPE SUPPORT DETAIL  
NOT TO SCALE

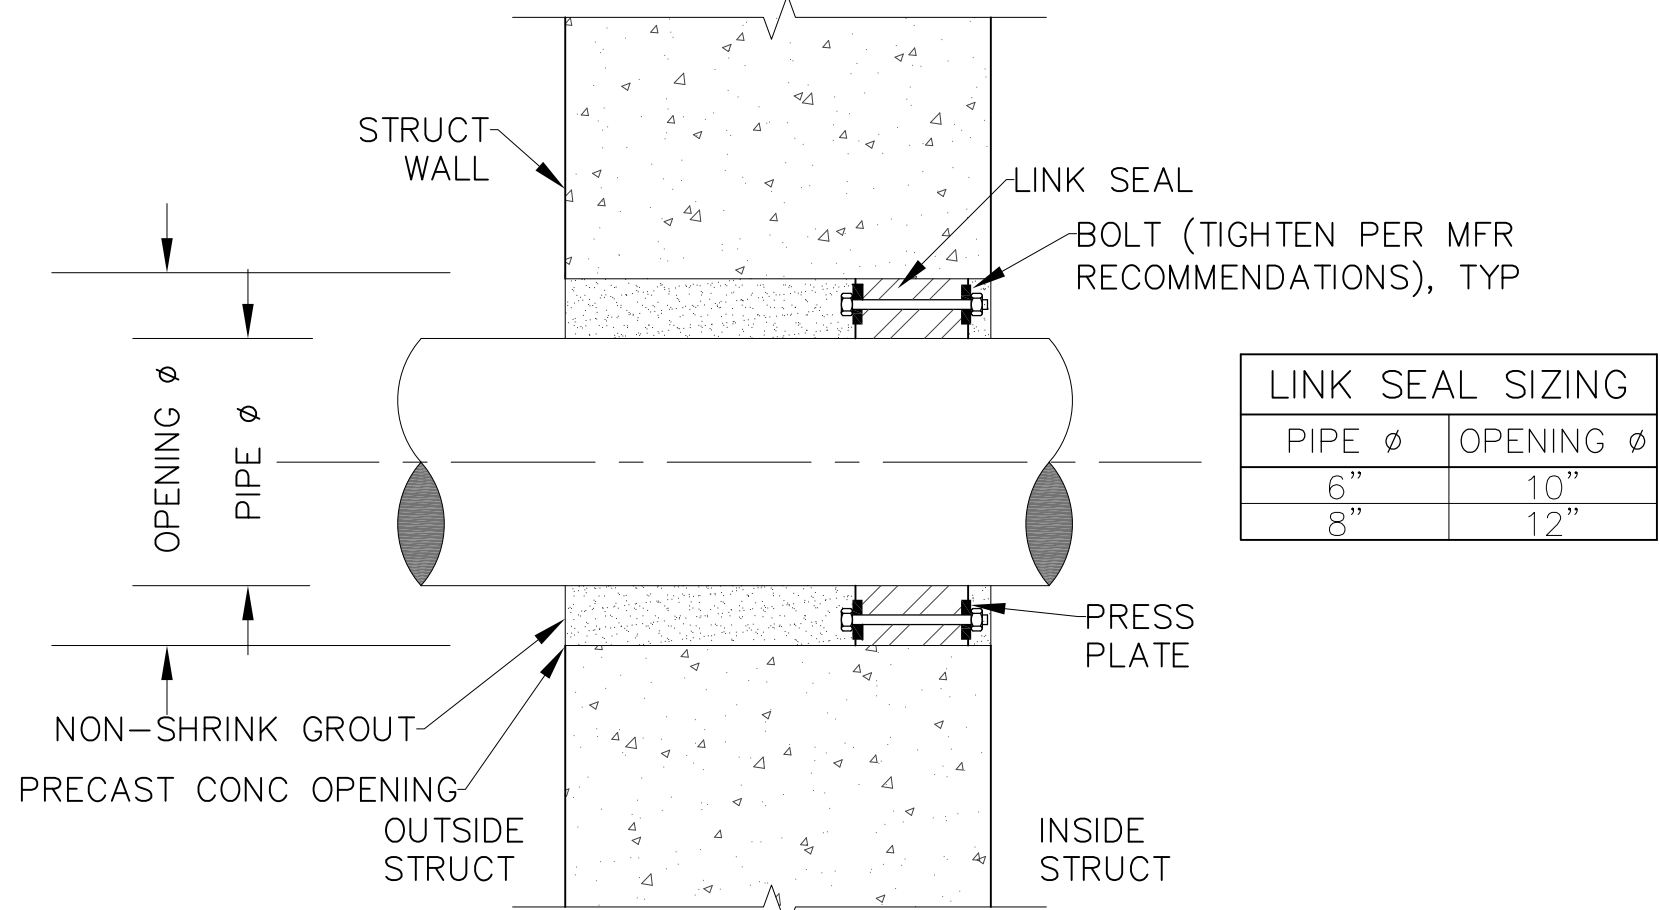


LINK SEAL DETAIL  
NOT TO SCALE

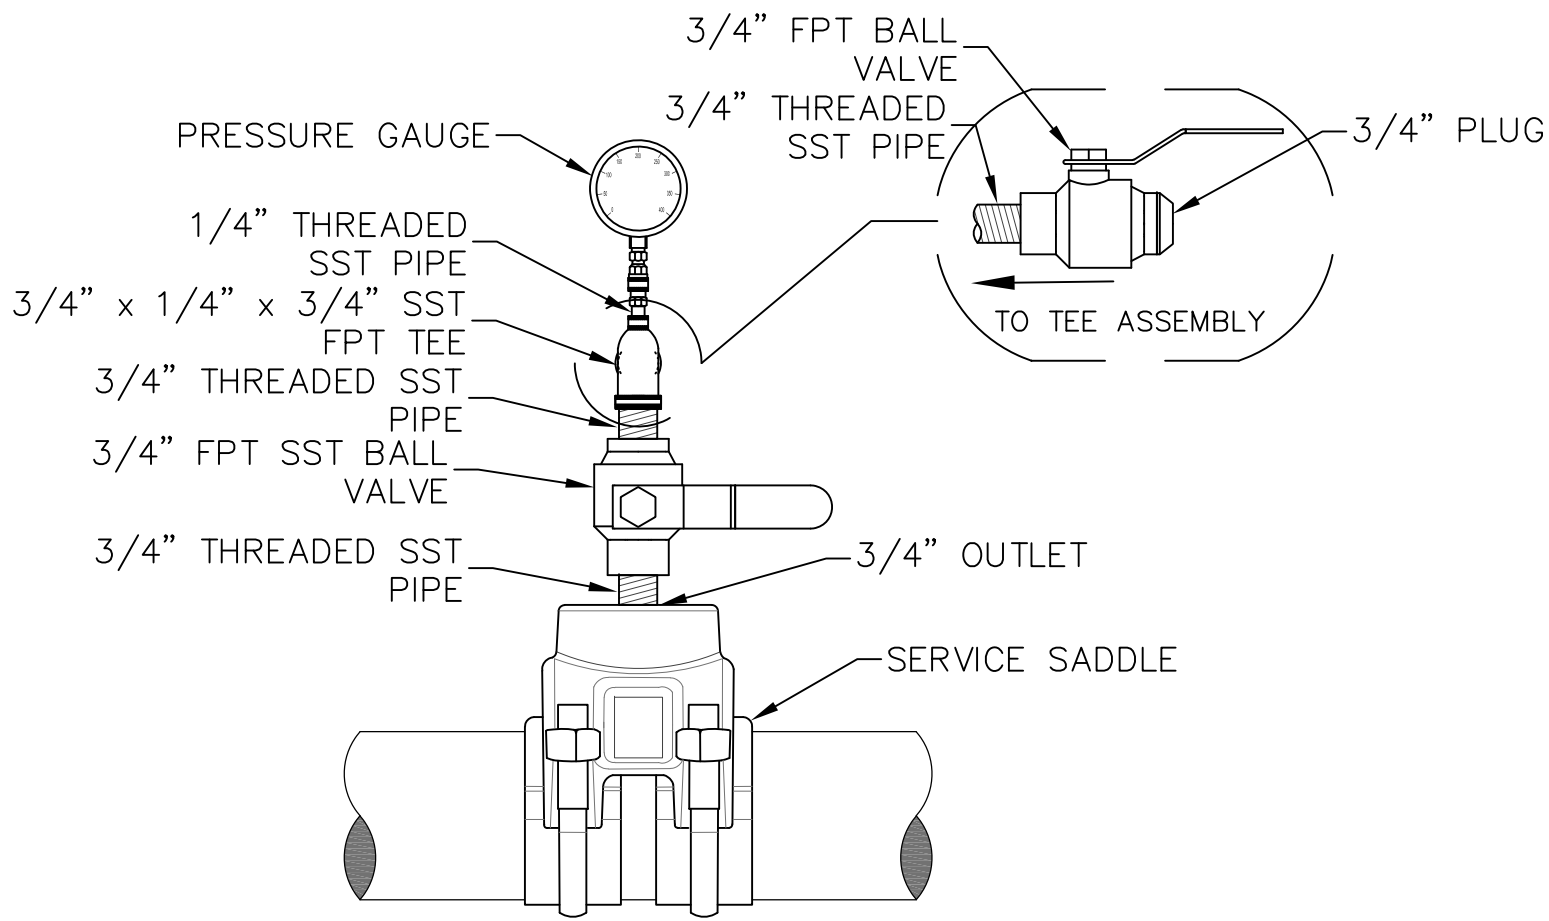


PRESSURE GAUGE ASSEMBLY  
NOT TO SCALE

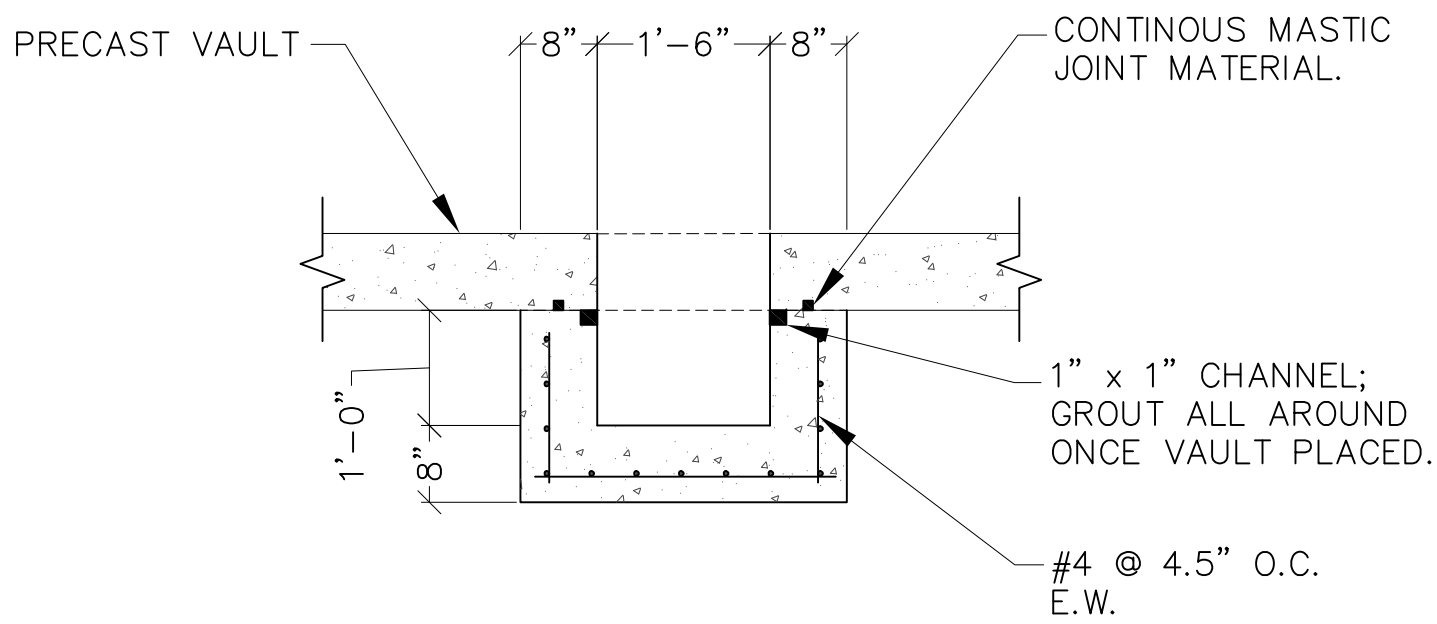


PRECAST 18" SQUARE SUMP  
NOT TO SCALE

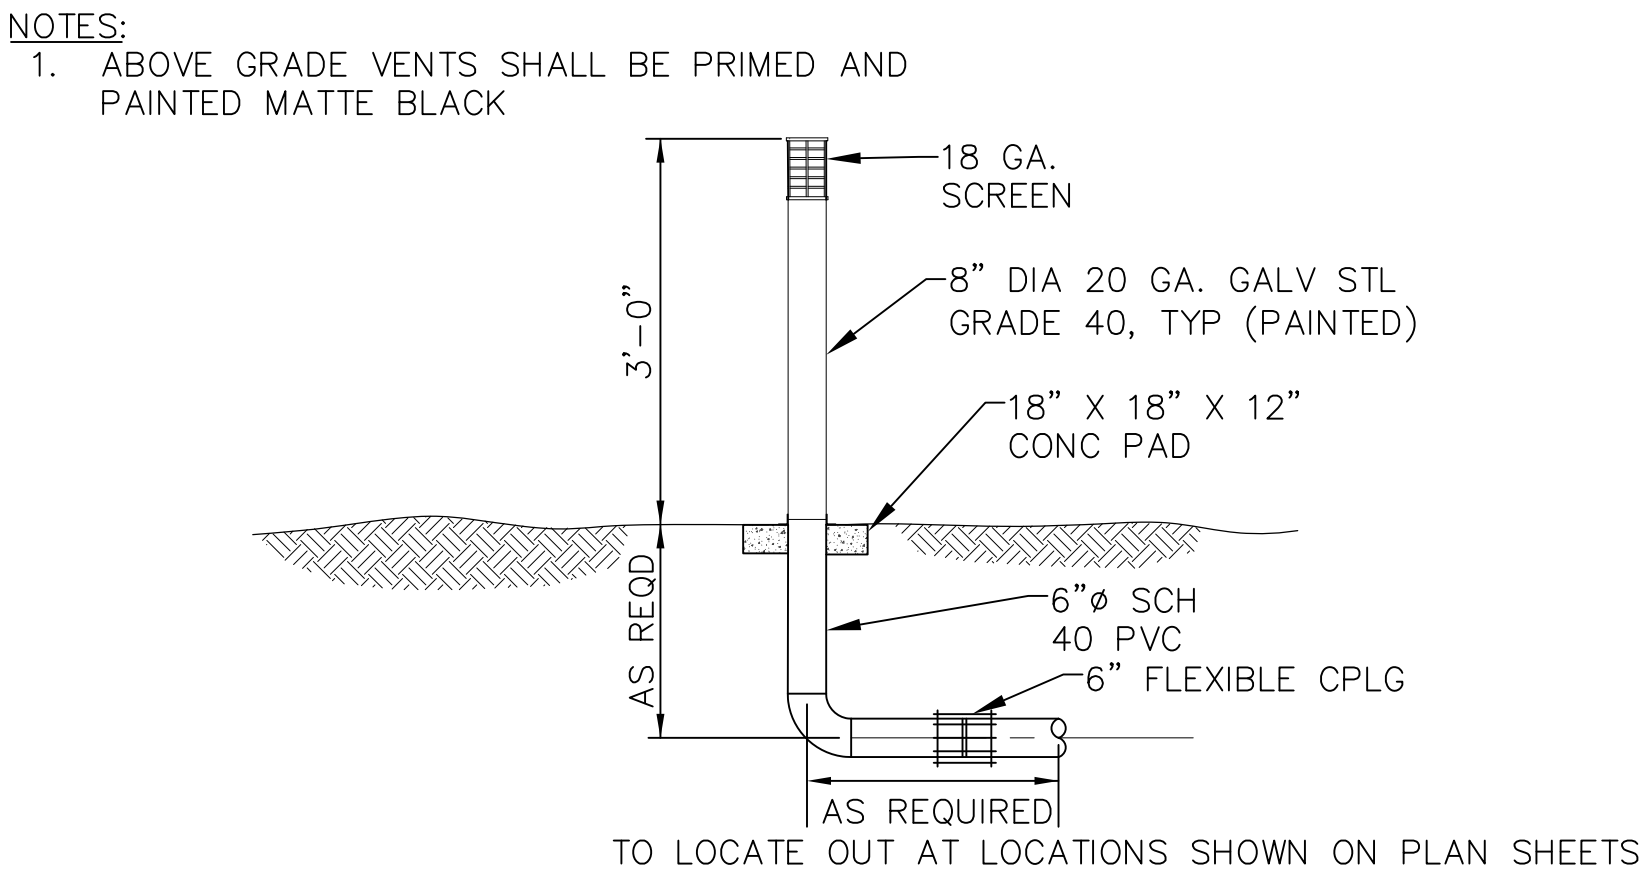

AIR VENT DETAIL  
NOT TO SCALE

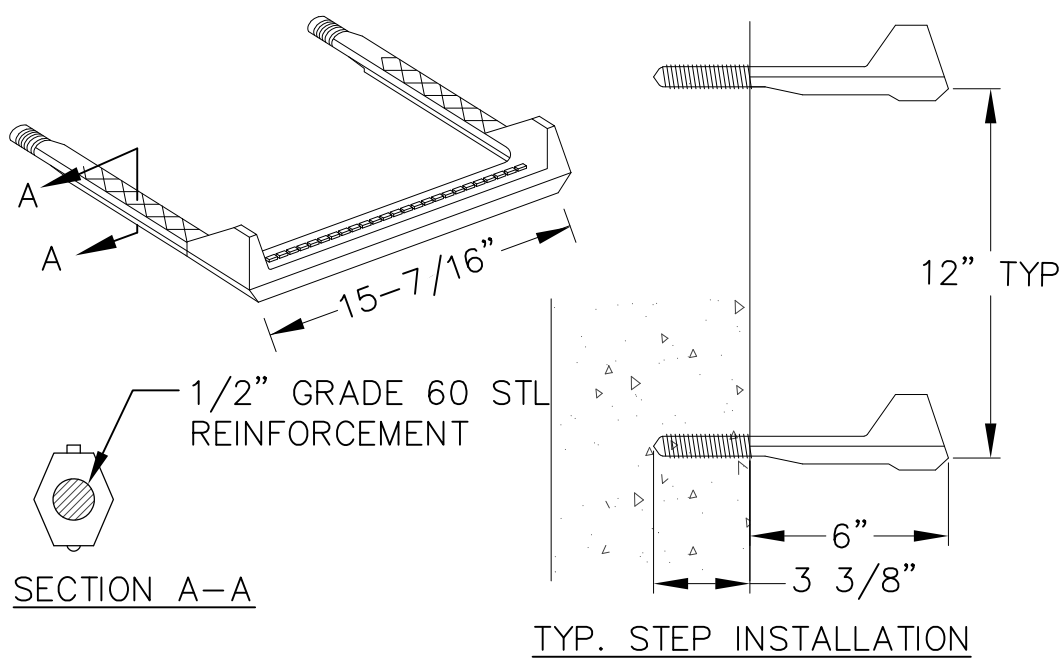

NOTE:  
USE COPOLYMER POLYPROPYLENE PLASTIC STEPS (TYP. FOR ALL STEPS)  
MH/VAULT STEP  
NOT TO SCALE

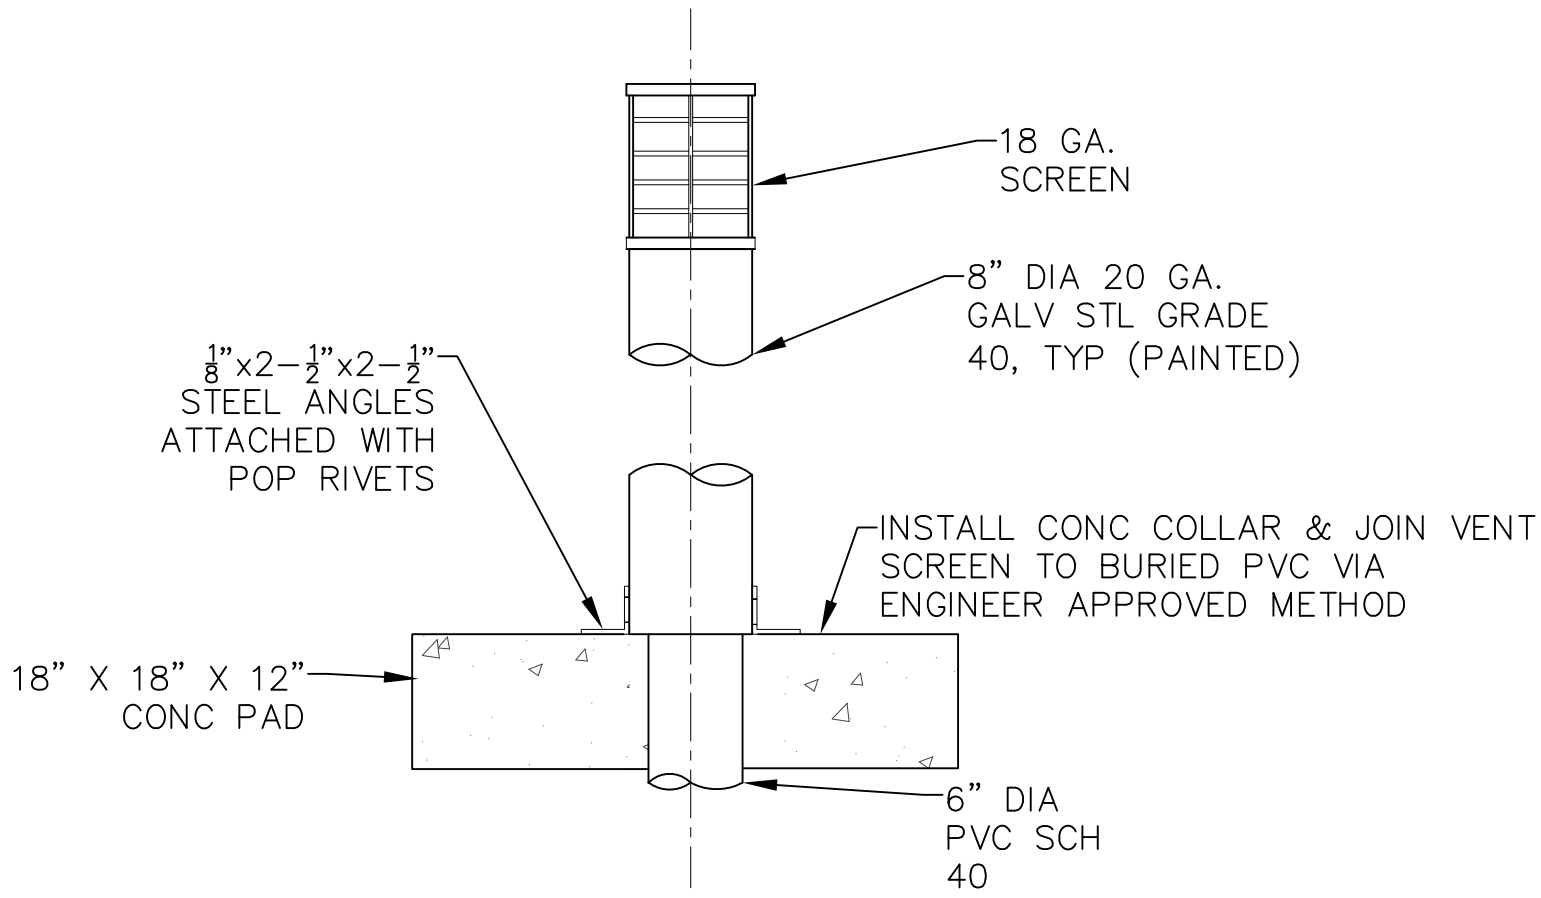

NOTES:  
1. ABOVE GRADE VENTS SHALL BE PRIMED AND PAINTED MATTE BLACK

ROXBOROUGH WATER AND SANITATION DISTRICT  
RAVENNA PHASE II WATER CONNECTION INFRASTRUCTURE

TYPICAL VAULT DETAILS - SHEET 1 OF 1



TST INFRASTRUCTURE, LLC  
Consulting Engineers

DATE: NOVEMBER 2019

JOB NO. 001.335.01

RWSD


DRAWING NO.

AS-BUILTS

C18

NOTES:

1. SEE SHEET E4 FOR ADDITIONAL DETAILS
2. INSTALL MIXER PER MANUFACTURES RECOMMENDATION

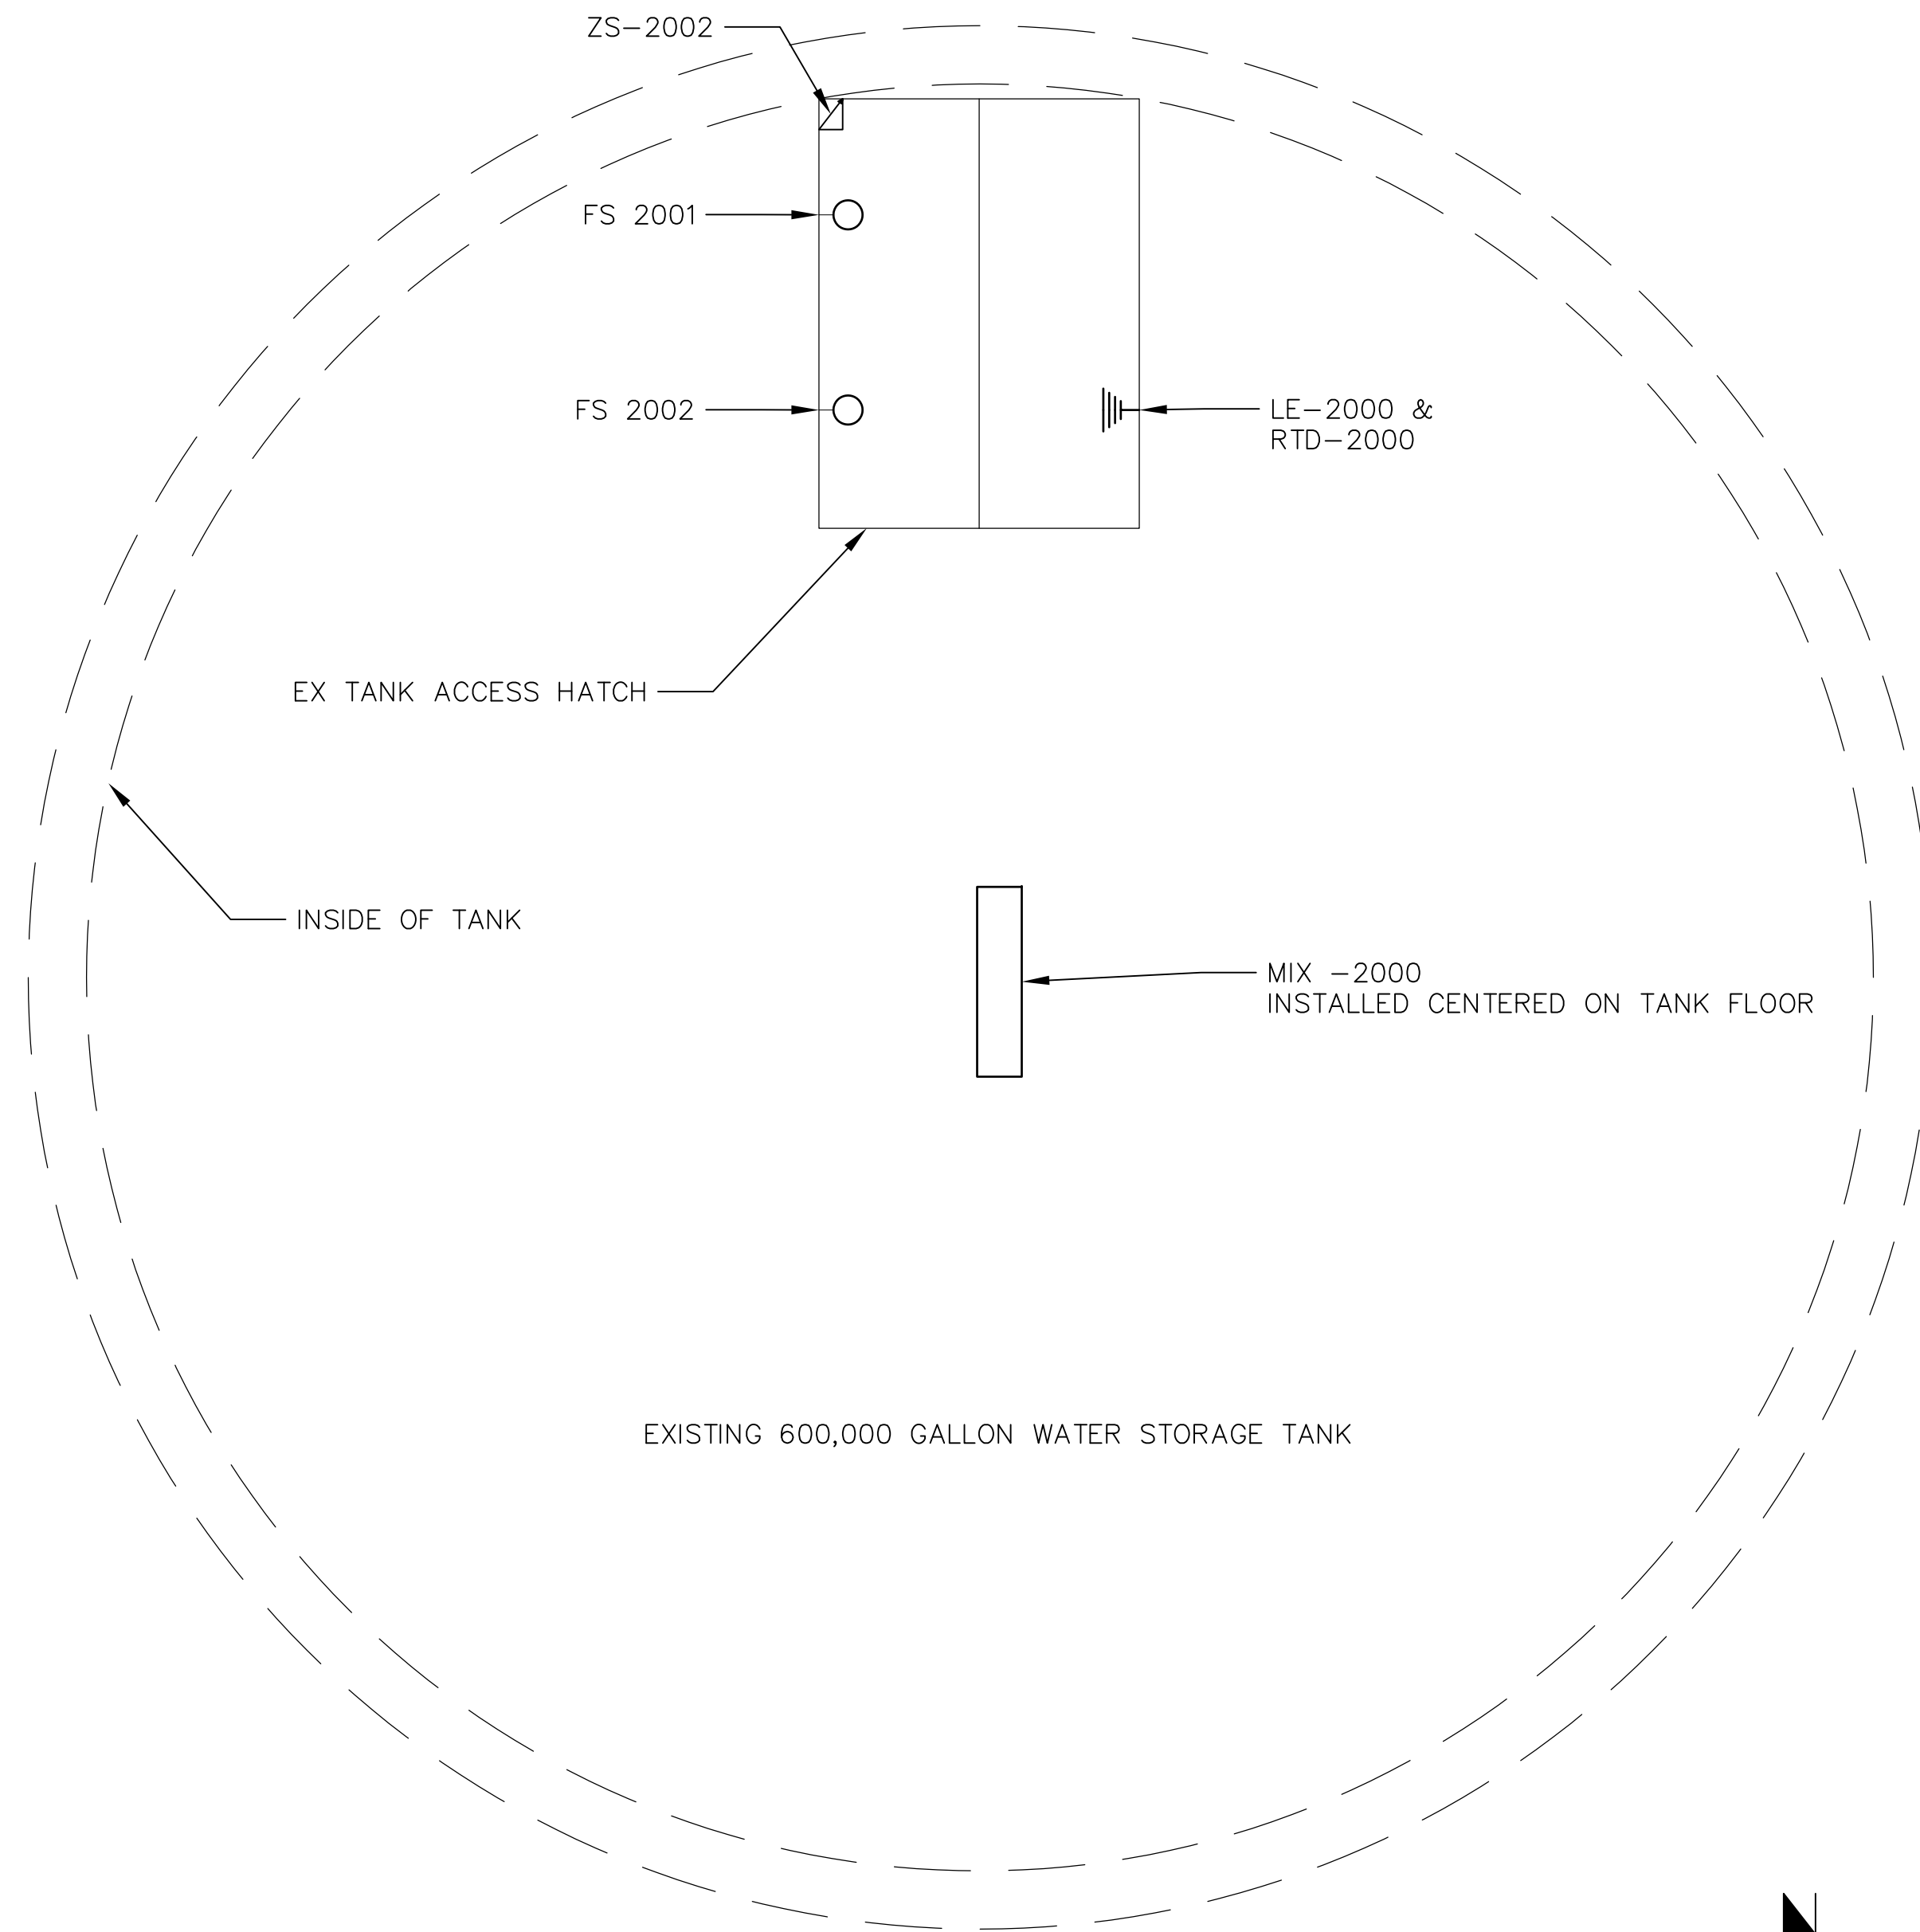


14 TANK RESTORATION DETAIL  
C2 NOT TO SCALE



## AS-BUILTS







<div>ROXBOROUGH WATER AND SANITATION DISTRICT</div> <div>RAVENNA PHASE II WATER CONNECTION INFRASTRUCTURE</div>		REVISIONS	
		By	Date
		ACP	11/22/2019
DESIGNED: JDB			
CHECKED: MKM			
DRAWN: SDH			
<div><div>1 INCH</div><div>1 INCH</div></div>		<div>BARS PLOT</div> <div>1 INCH x 1 INCH</div> <div>AT FULL SCALE</div>	
<div>DRAWING</div>		<div>TANK RESTORATION DETAIL - SHEET 1 OF 1</div>	
<div><div>TST</div><div>TST INFRASTRUCTURE, LLC</div><div>Consulting Engineers</div></div>			
DATE: NOVEMBER 2019			
JOB NO. 001.335.01			
RWSD			
DRAWING NO. C19			

H:\Drawings\Roxborough\001.335.00 - Ravenna WS Impr Design\Sheets\Civil Details in Progress.dwg, C20, 12/10/2019 10:16 AM

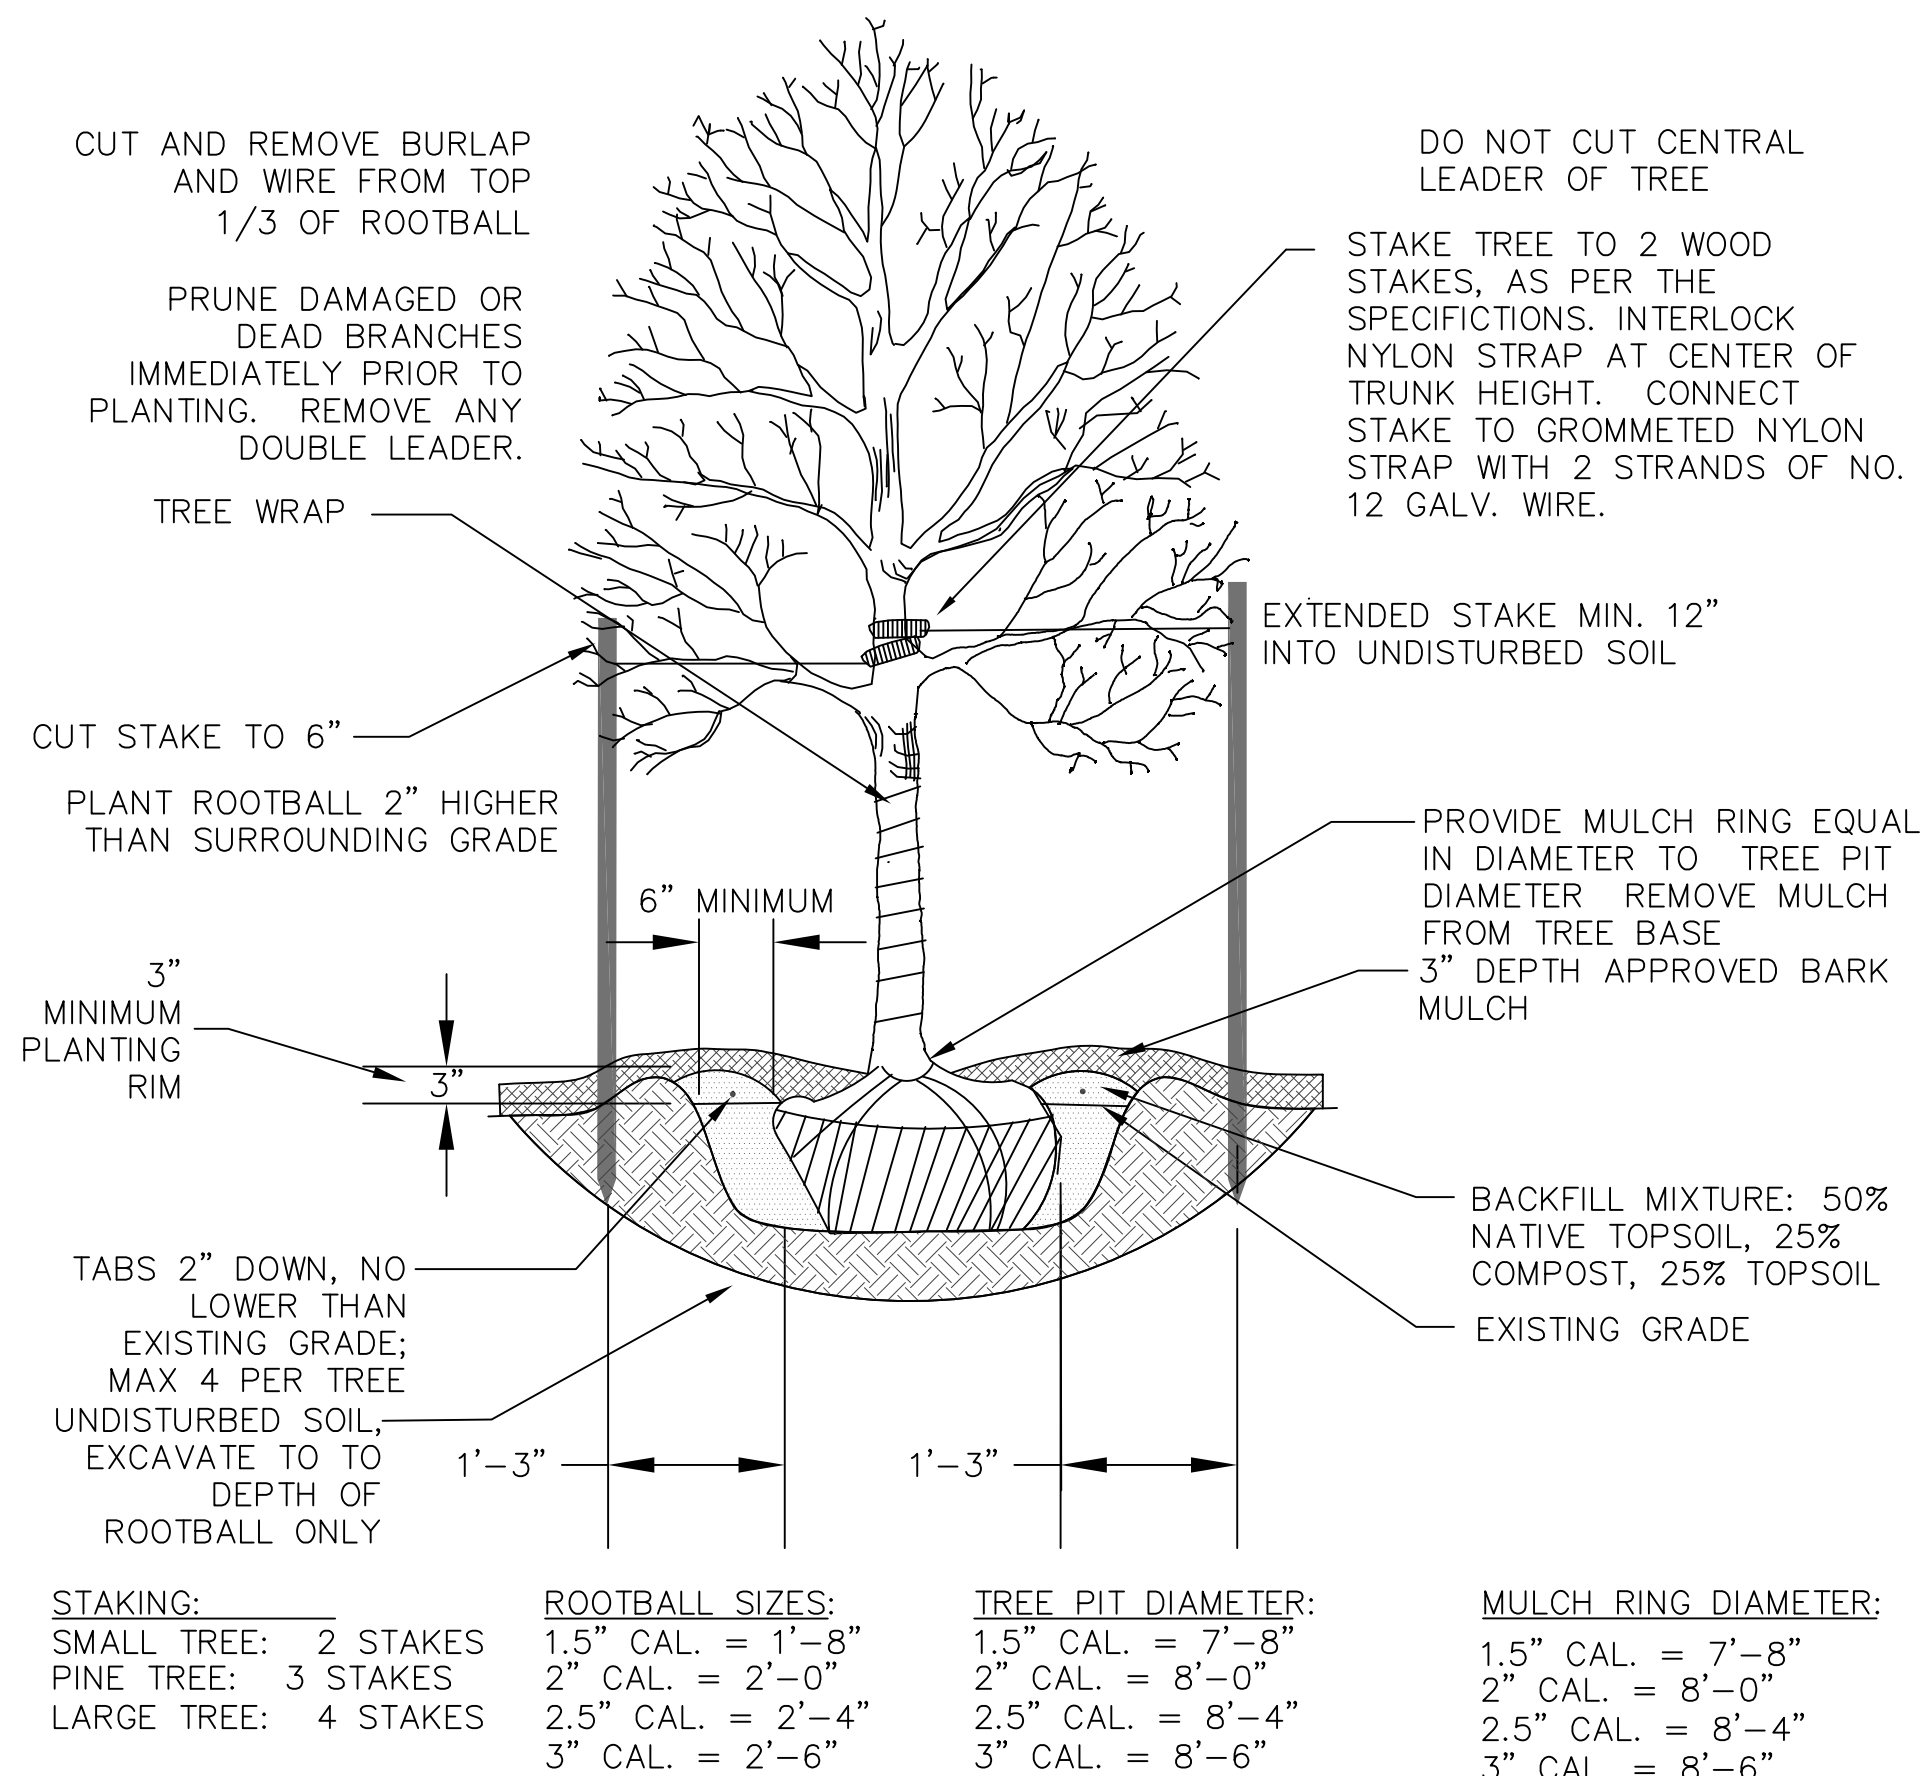

NOTE:  
TREES SHALL BE RELOCATED ONE TIME FROM EXISTING LOCATION TO A LOCATION DETERMINED BY PROPERTY OWNER WITHIN 500 FEET OF ORIGINAL TREE LOCATION.

**TREE RELOCATION DETAIL**  
NOT TO SCALE

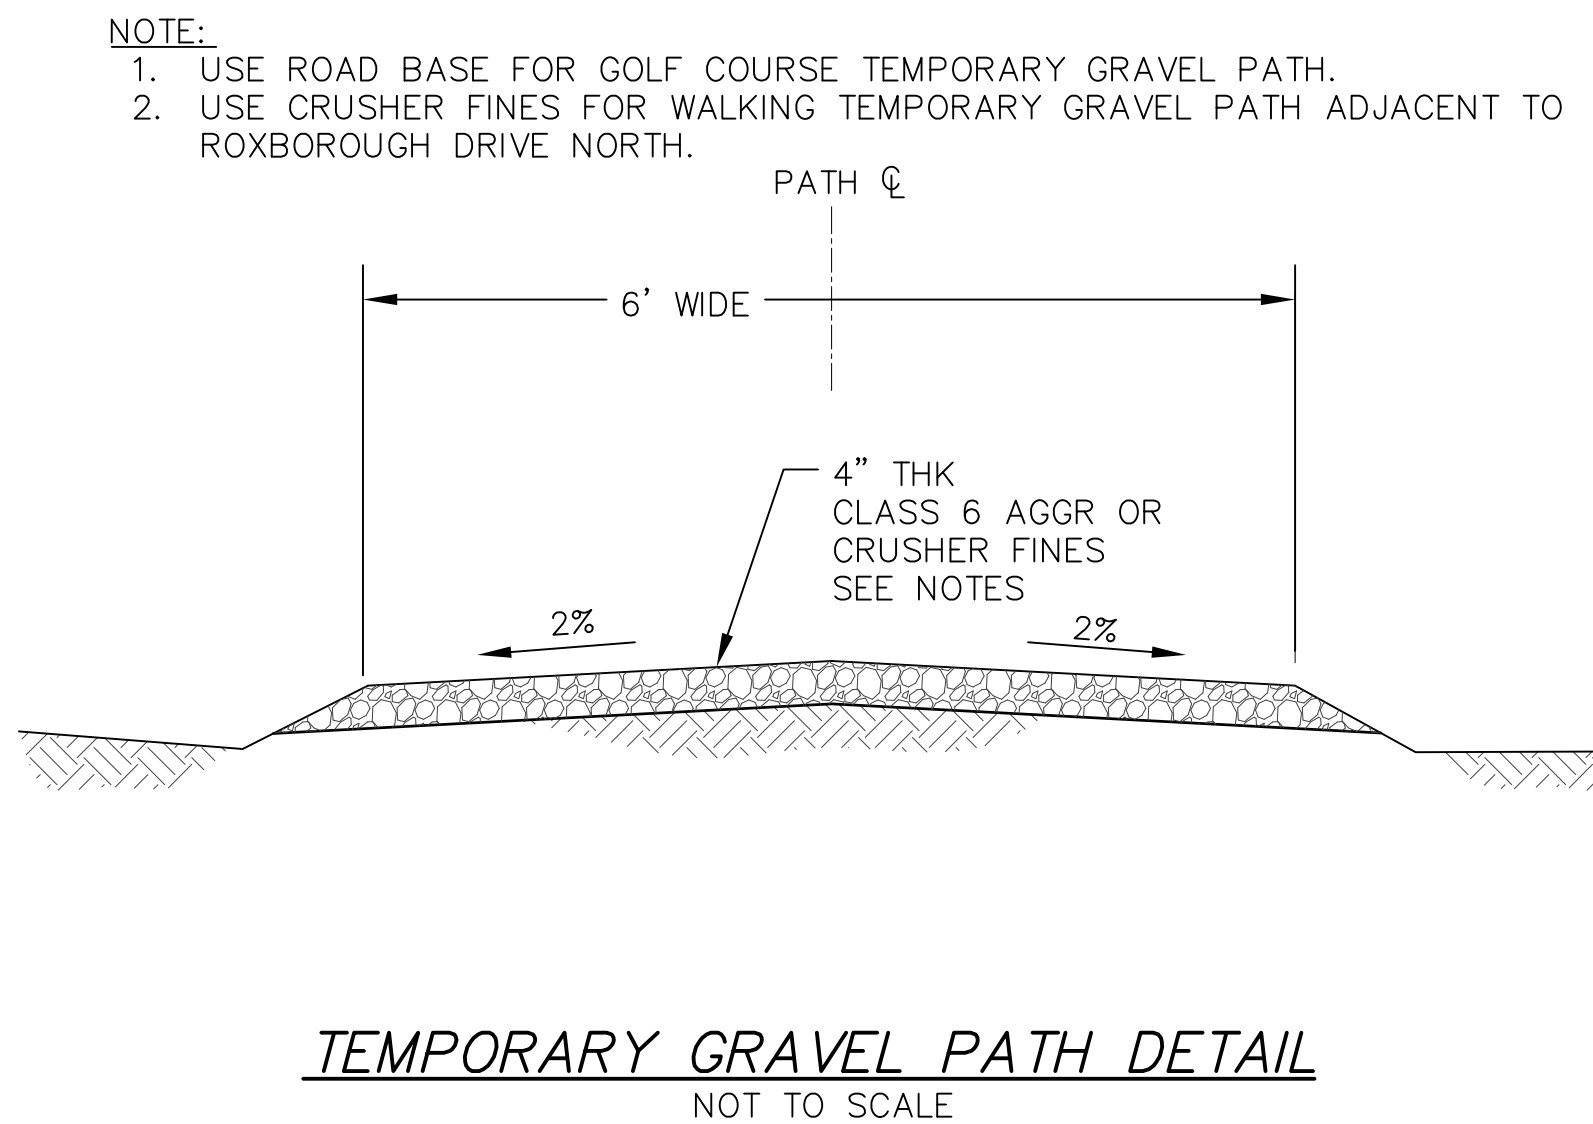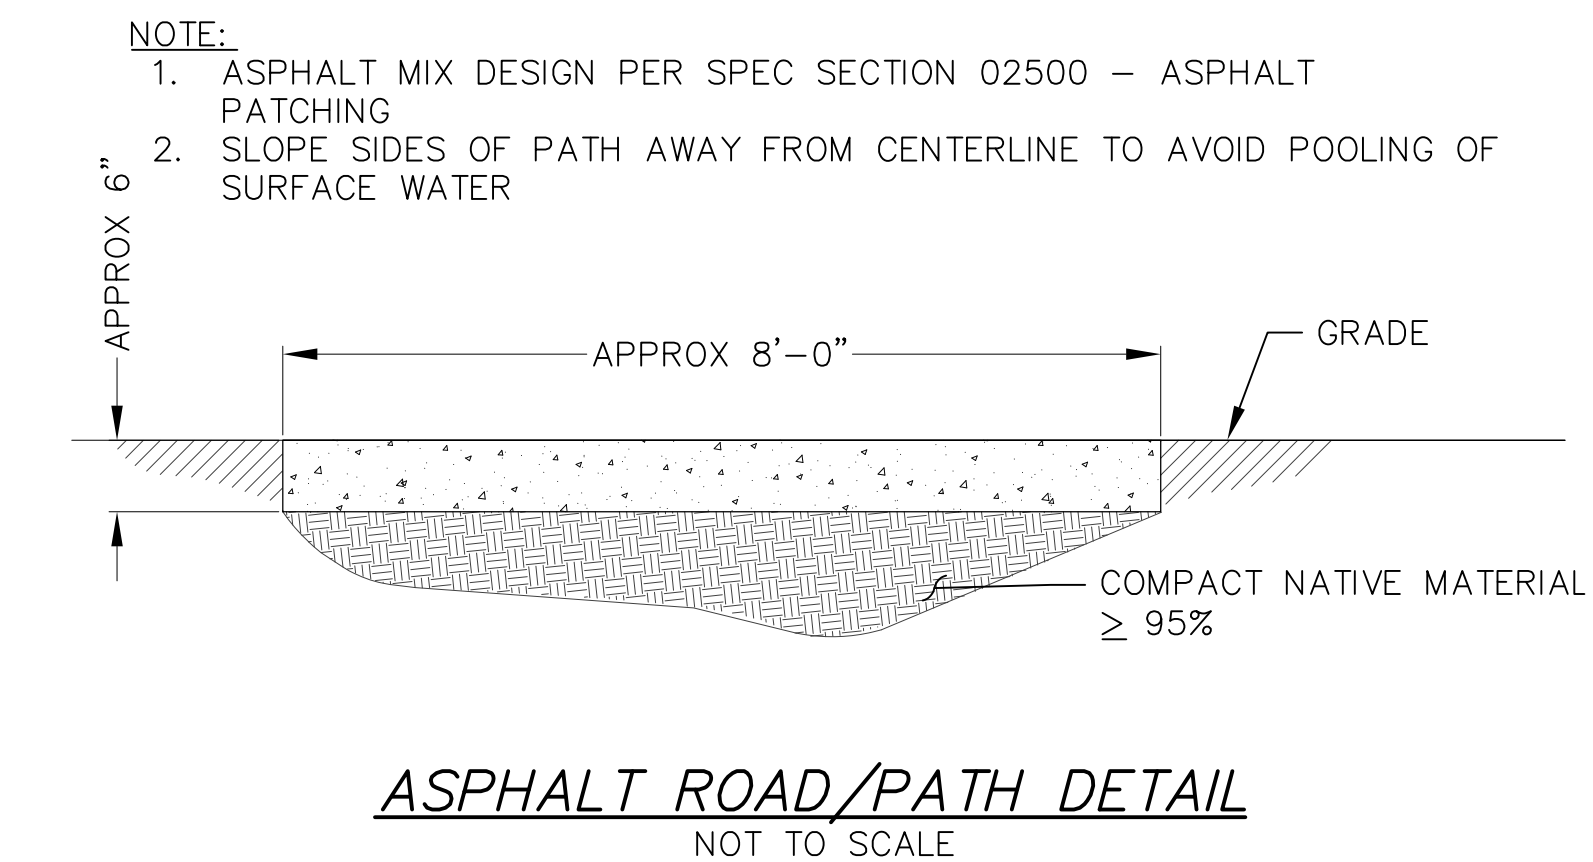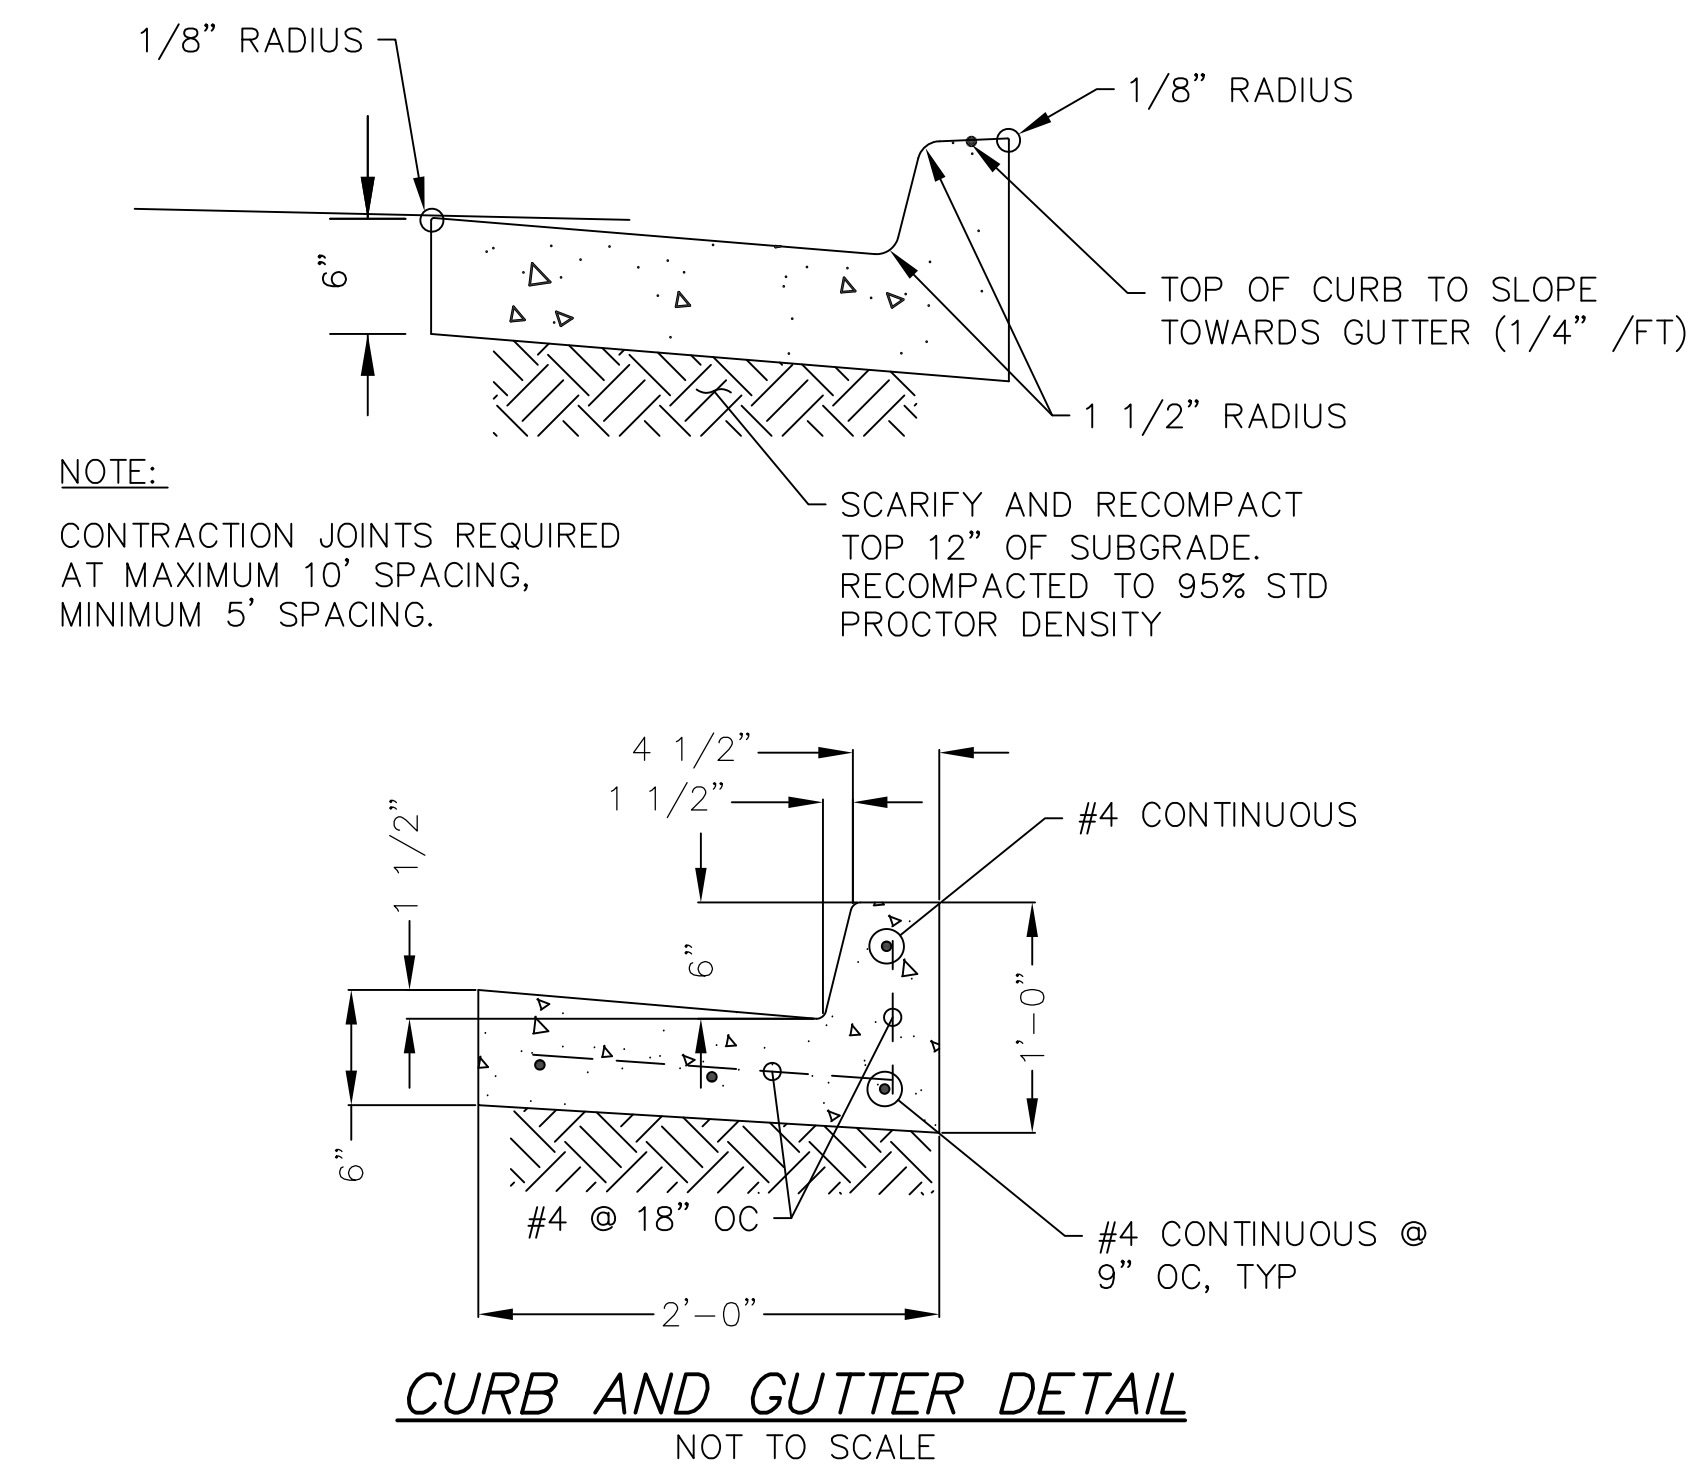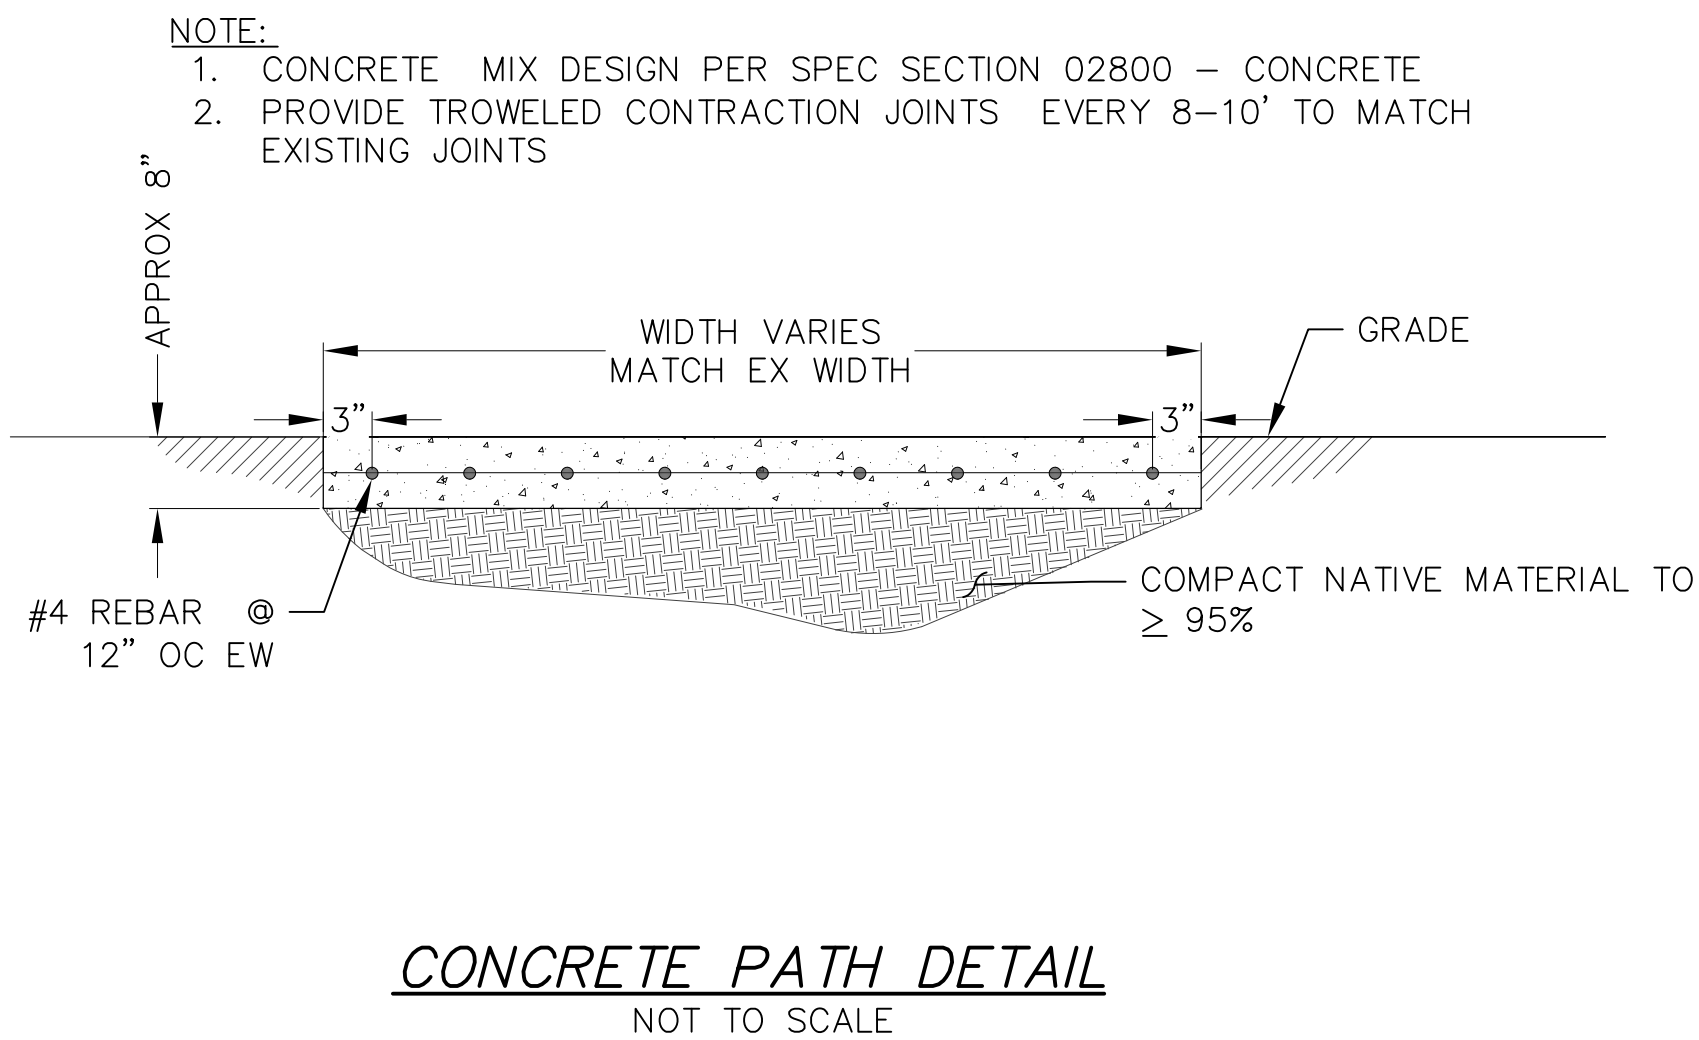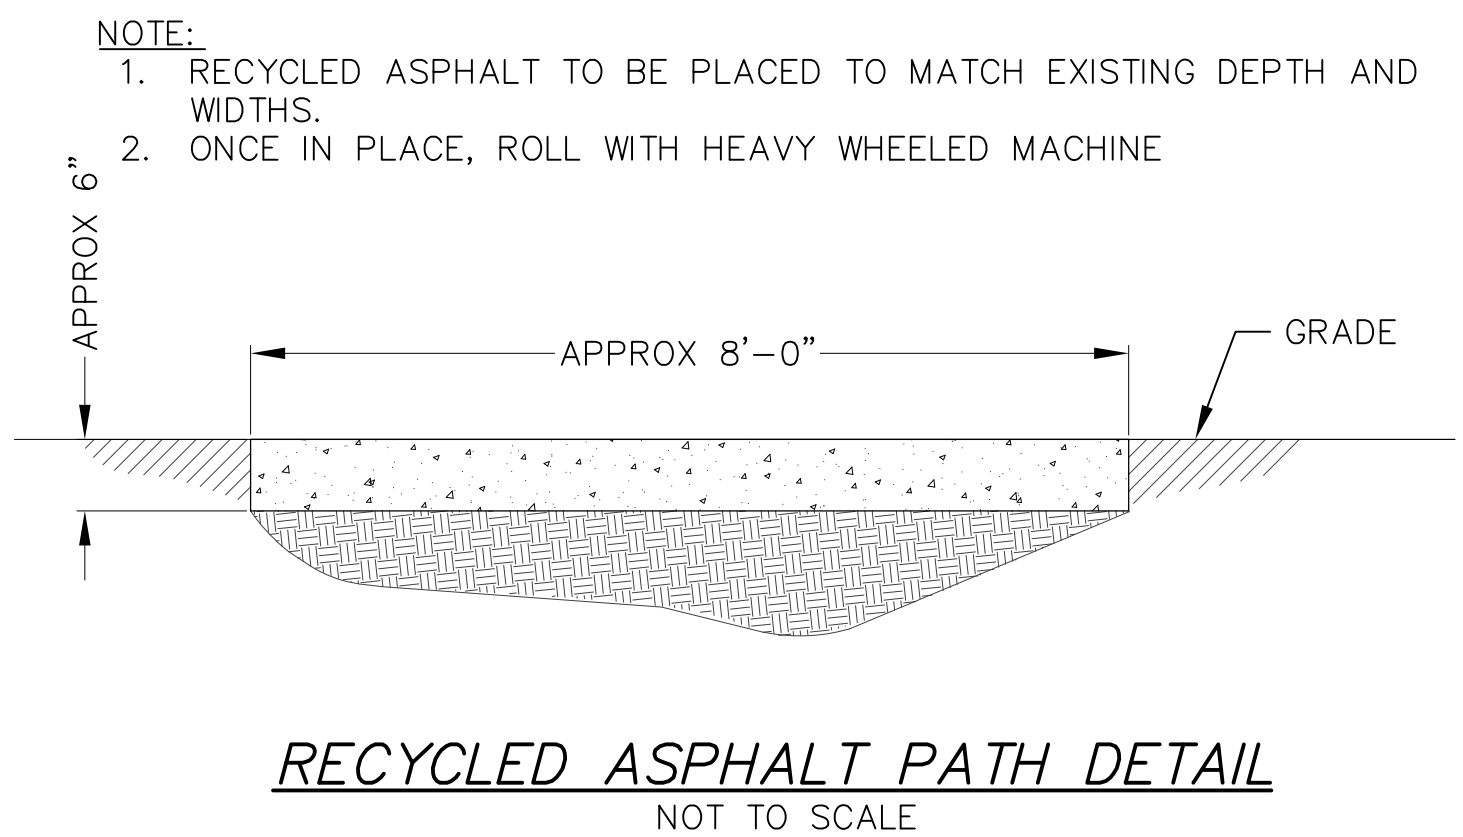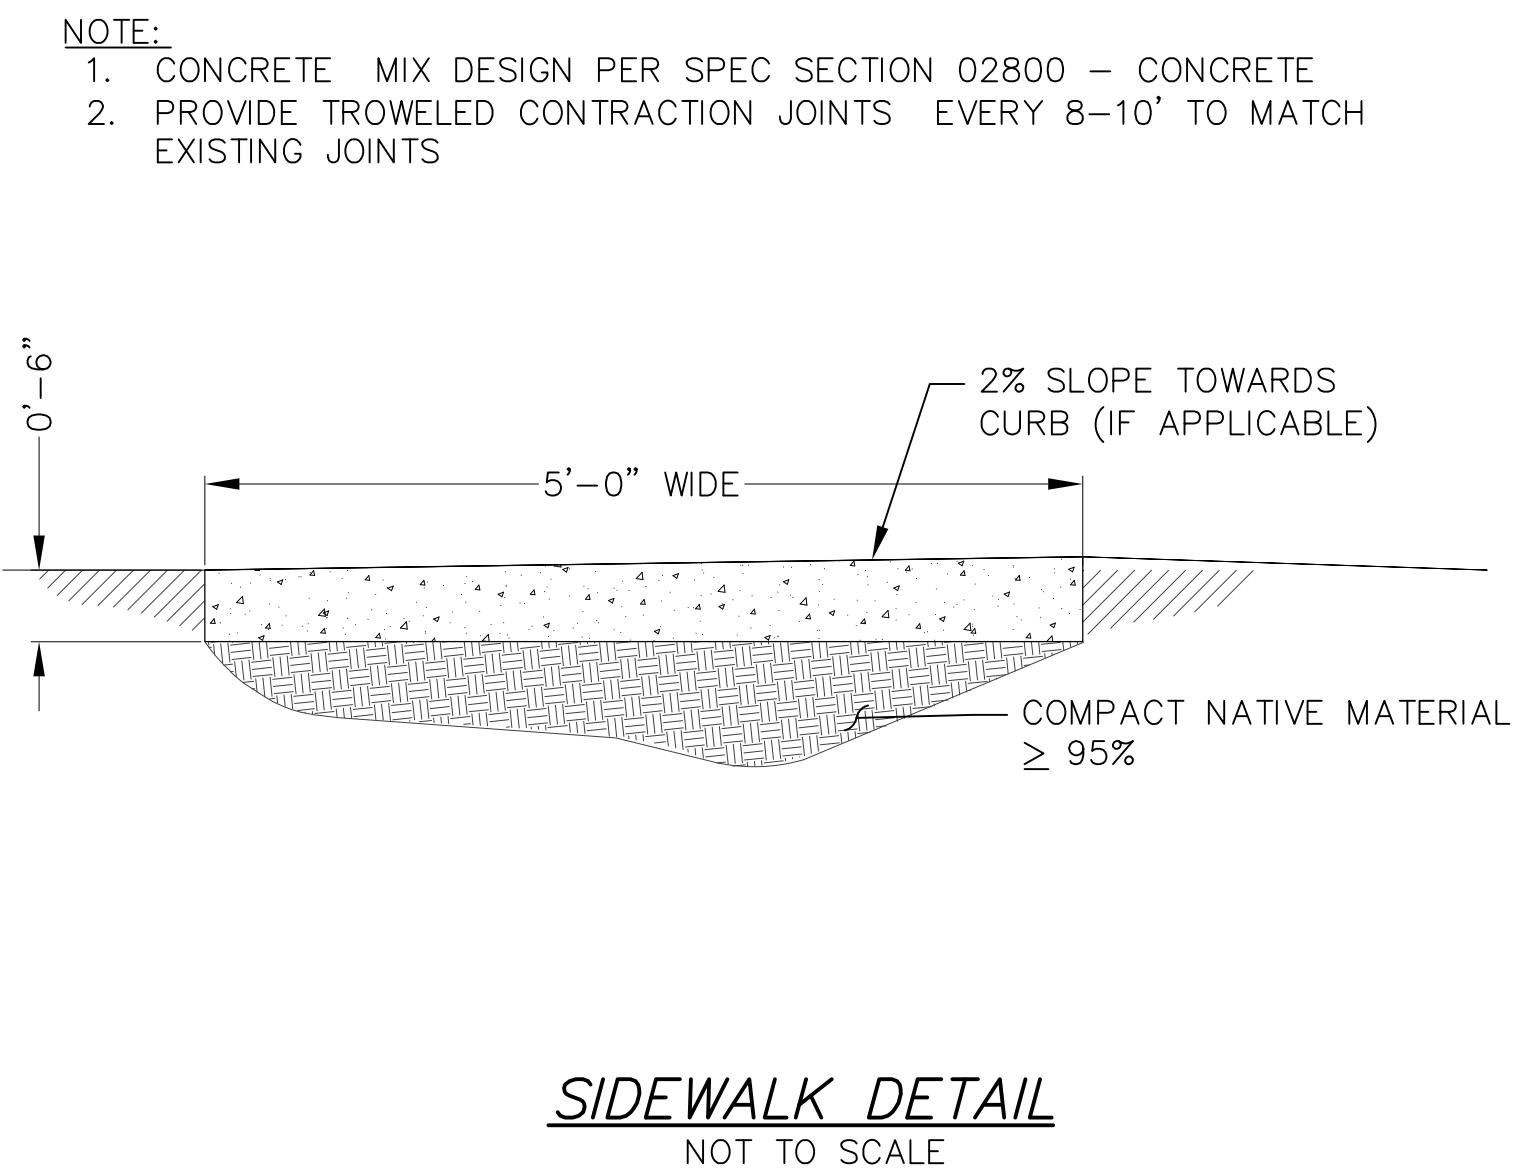

AS-BUILTS


REVISIONS	AS-BUILT	11/22/2019	ACP	JDB	SDH	1 INCH 1 INCH x 1 INCH AT FULL SCALE	ROXBOROUGH WATER AND SANITATION DISTRICT RAVENNA PHASE II WATER CONNECTION INFRASTRUCTURE SURFACE RESTORATION AND FLATWORK DETAILS - SHEET 1 OF 1	TST TST INFRASTRUCTURE, LLC Consulting Engineers	DATE NOVEMBER 2019	JOB NO. 001.335.01	RWSD	C20
-----------	----------	------------	-----	-----	-----	--	---	--	-----------------------	-----------------------	------	-----




H:\Drawings\Roxborough\001.335.00 - Ravenna WS Impr Design\Sheets\Civil\RAPHAEL\_DANTE PRV RELOCATION.dwg, PRV RELOCATION - C16, 12/10/2019 10:17 AM




2" WATER LINE EXTENSION  
SCALE: 1" = 80'

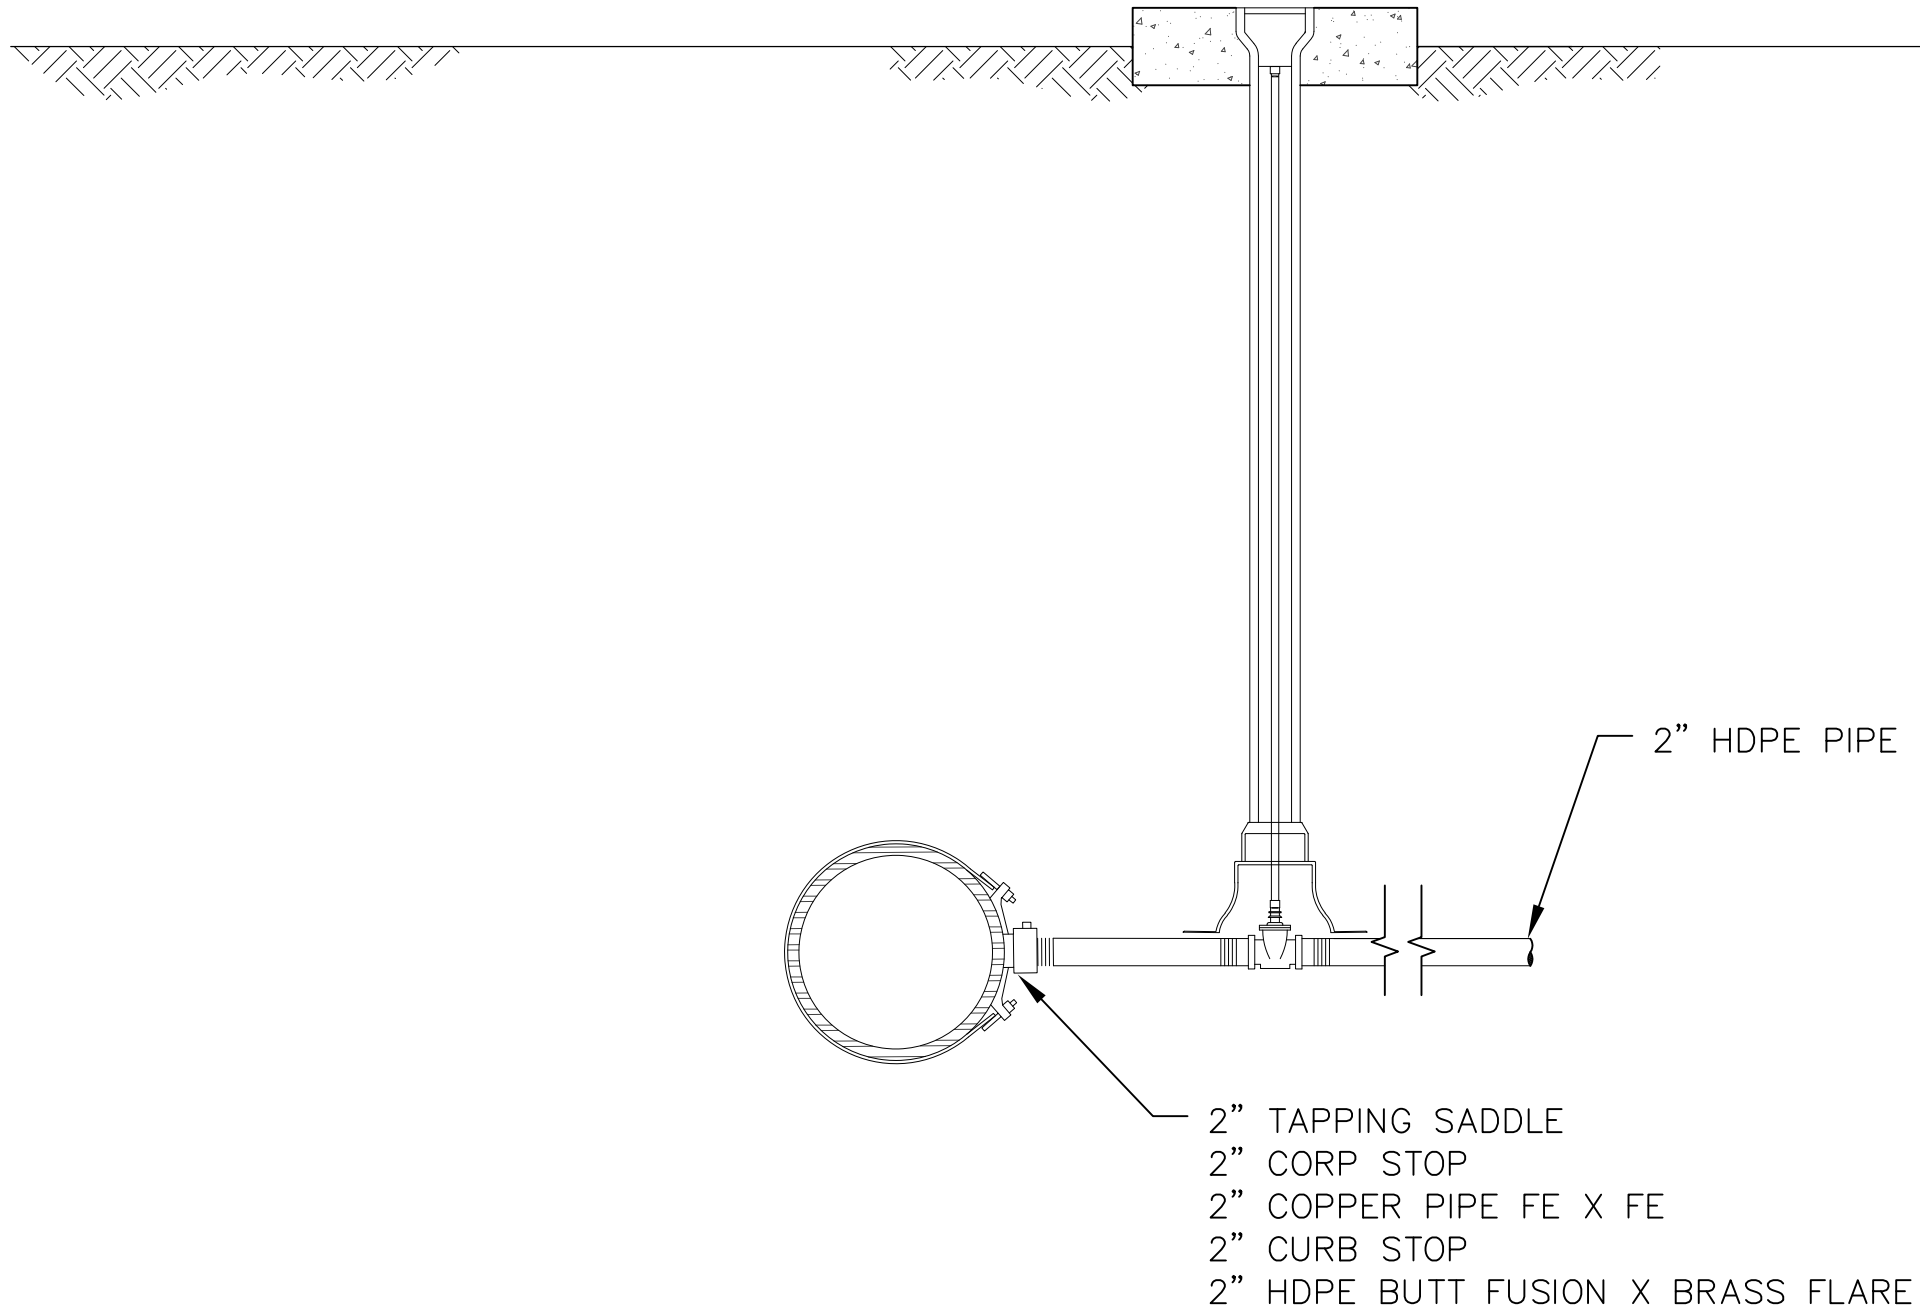

2" HDPE WATER LINE DETAIL  
NOT TO SCALE

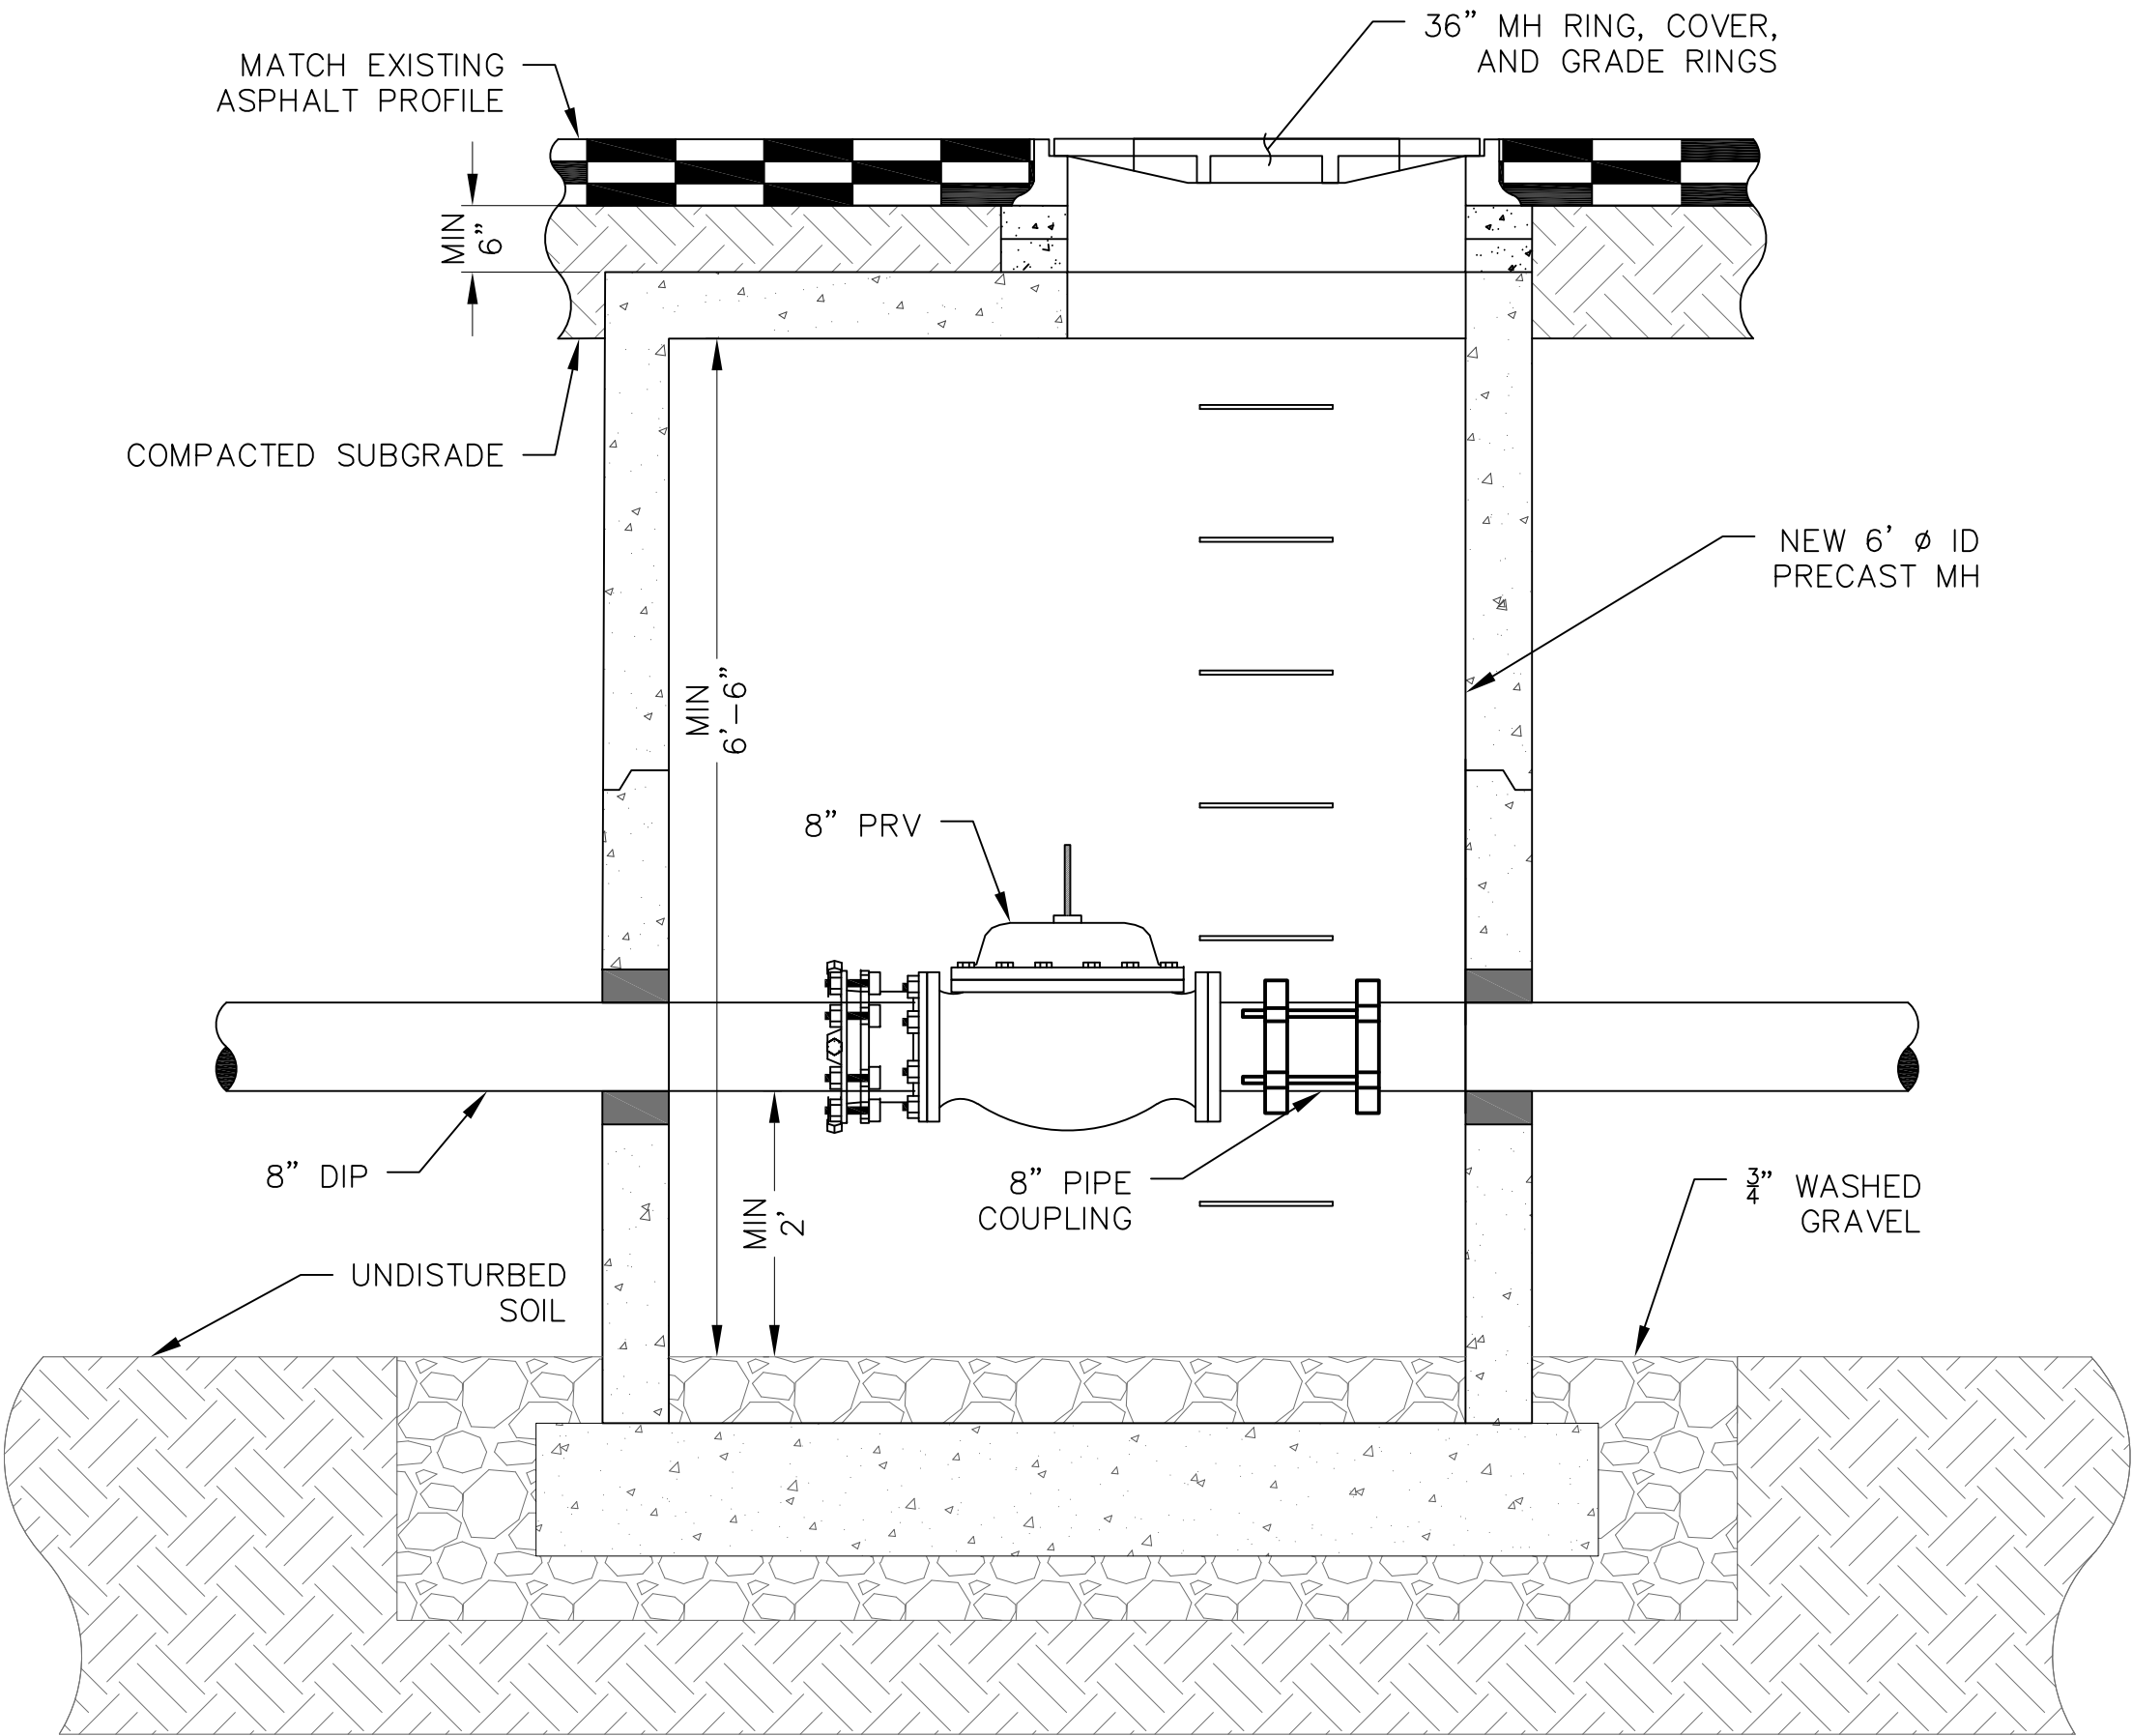


1 PRV SECTION  
NOT TO SCALE

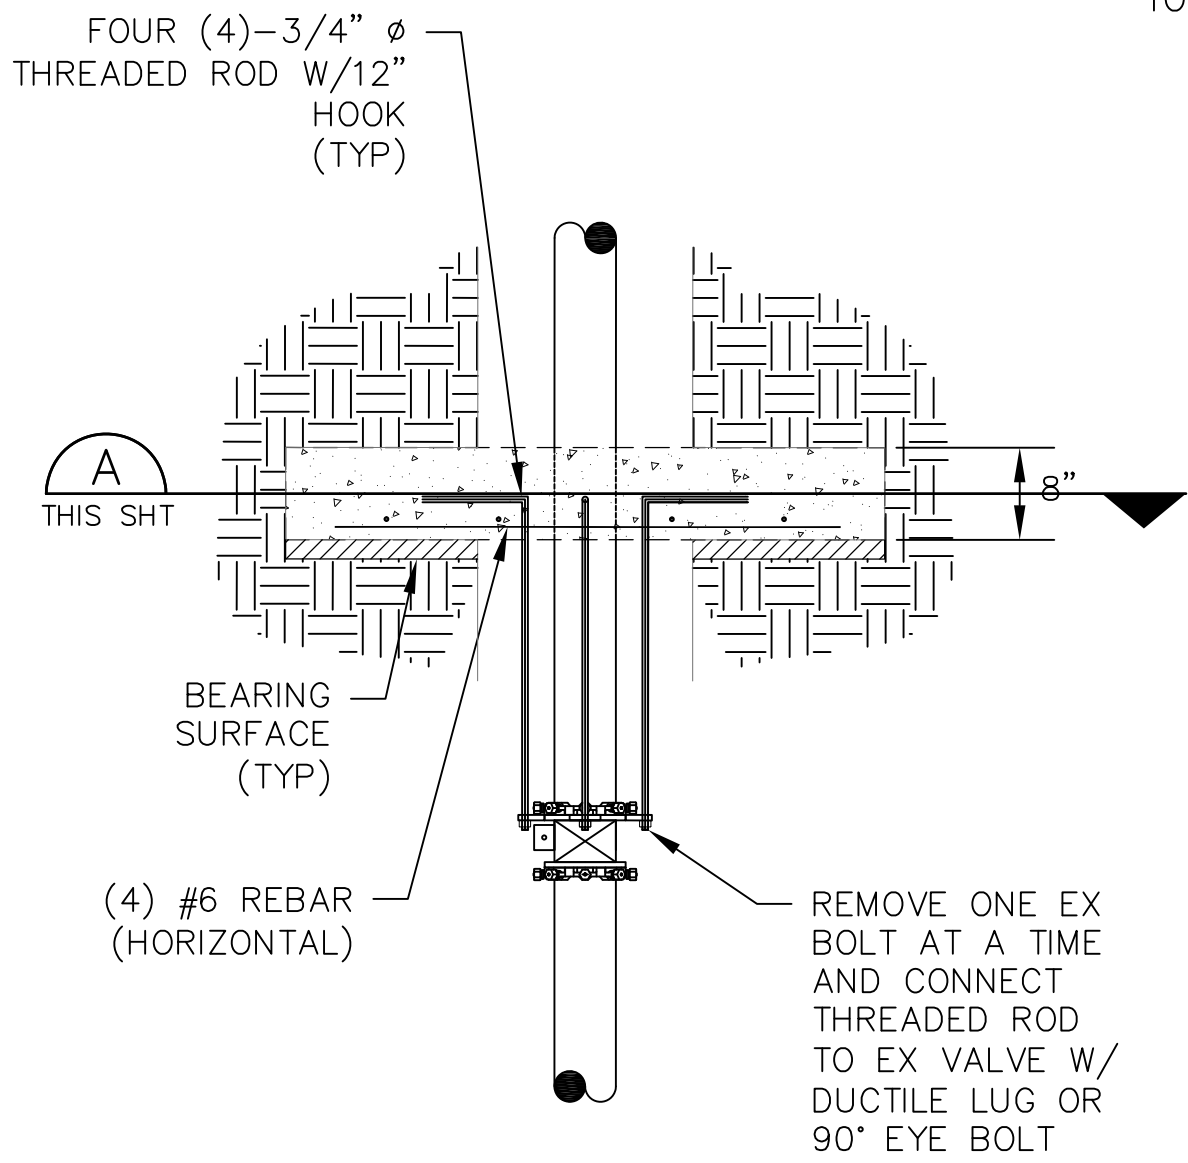

2 DEADMAN RESTRAINT DETAIL  
NOT TO SCALE

PROCEDURE  
STEP 1: INSTALL DEADMAN AND  
THREADED RODS. ALLOW DEADMAN  
TO CURE.  
STEP 2: CONNECT THREADED RODS  
TO EX VALVES AND NEW VALVES.

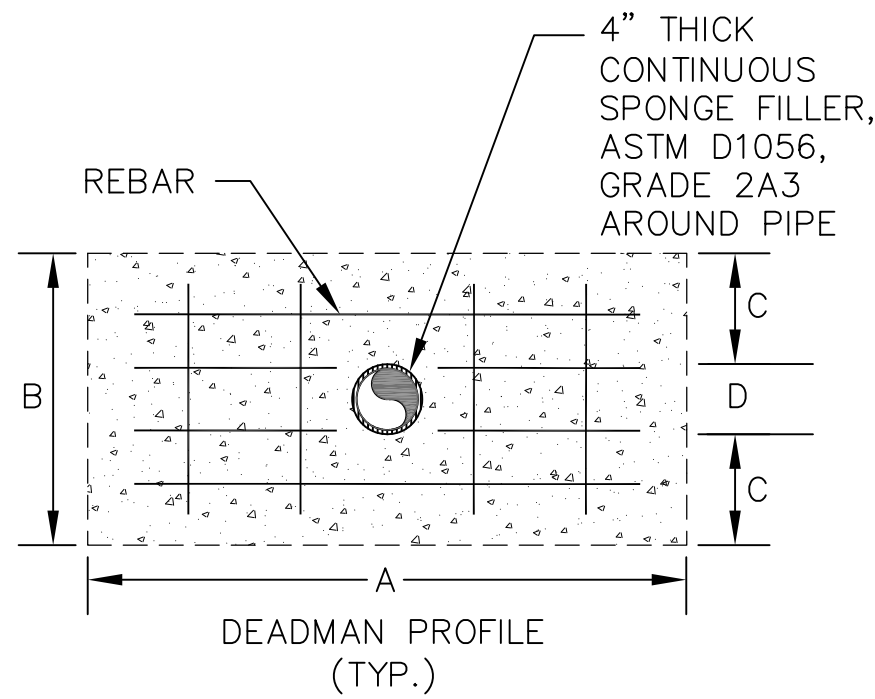

PIPE DIAM	MINIMUM BEARING SURFACE AREA (SF)	A	B	C	D
8"	12	84"	48"	19.5"	9"

- NOTES:
- DIM "A" IS BASED ON AN ASSUMED TRENCH WIDTH OF 48" AT DEADMAN LOCATION. IF WIDTH OF TRENCH IS GREATER, ADJUST "A" TO TRENCH WIDTH.
  - THE MINIMUM BEARING SURFACE AREAS SHOWN IN THE TABLE FOR OUTLET PIPING ARE BASED ON 160 PSI INTERNAL PIPE PRESSURE PLUS 110 PSI WATER HAMMER & AN ALLOWABLE SOIL BEARING CAPACITY EQUAL TO 250 PCF 5.5 FOOT DEPTH BELOW GRADE (TO MID-POINT OF THRUST BLOCK FACE). FOR DEPTH EQUAL TO 10 FEET OR MORE, USE 2500 PSF.

A SECTION A-A DETAIL  
THIS SHT NOT TO SCALE

AS-BUILTS

ROXBOROUGH WATER AND SANITATION DISTRICT  
RAVENNA PHASE II WATER CONNECTION INFRASTRUCTURE

PRV DETAILS AND HDPE WATER LINE DETAILS

TST  
TST INFRASTRUCTURE, LLC  
Consulting Engineers

DATE: NOVEMBER 2019



JOB NO. 001.335.01

RWSD

DRAWING NO.

C22

1. LANDSCAPING RESTORATION AND SOD REPLACEMENT TO BE COMPLETED BY RAVENNA METRO DISTRICT (RMD) FOLLOWING COMPLETION OF WATER LINE INSTALLATION. ALL DISTURBED LANDSCAPED OR SODDED AREAS WITHIN RMD/GOLF COURSE PROPERTY SHALL HAVE ECB INSTALLED BY CONTRACTOR IMMEDIATELY AFTER WATER LINE COMPLETION TO PREVENT SURFACE EROSION PRIOR TO FULL LANDSCAPE RESTORATION BY RMD. LANDSCAPING AND SOD RESTORATION BY RMD ANTICIPATED TO BE COMPLETED WITHIN SEVERAL WEEKS FOLLOWING WATER LINE COMPLETION.
2. ECB INSTALLED IN LANDSCAPED/SODDED AREA WILL NOT REQUIRE SEEDING PRIOR TO INSTALLATION.
3. WATER LINE AND APPURTENANCES SHOWN ON THIS SHEET TO BE INSTALLED VIA OPEN CUT METHOD.
4. VTC PAD TO BE INSTALLED AS REQUIRED BY DOUGLAS COUNTY EROSION CONTROL INSPECTOR.

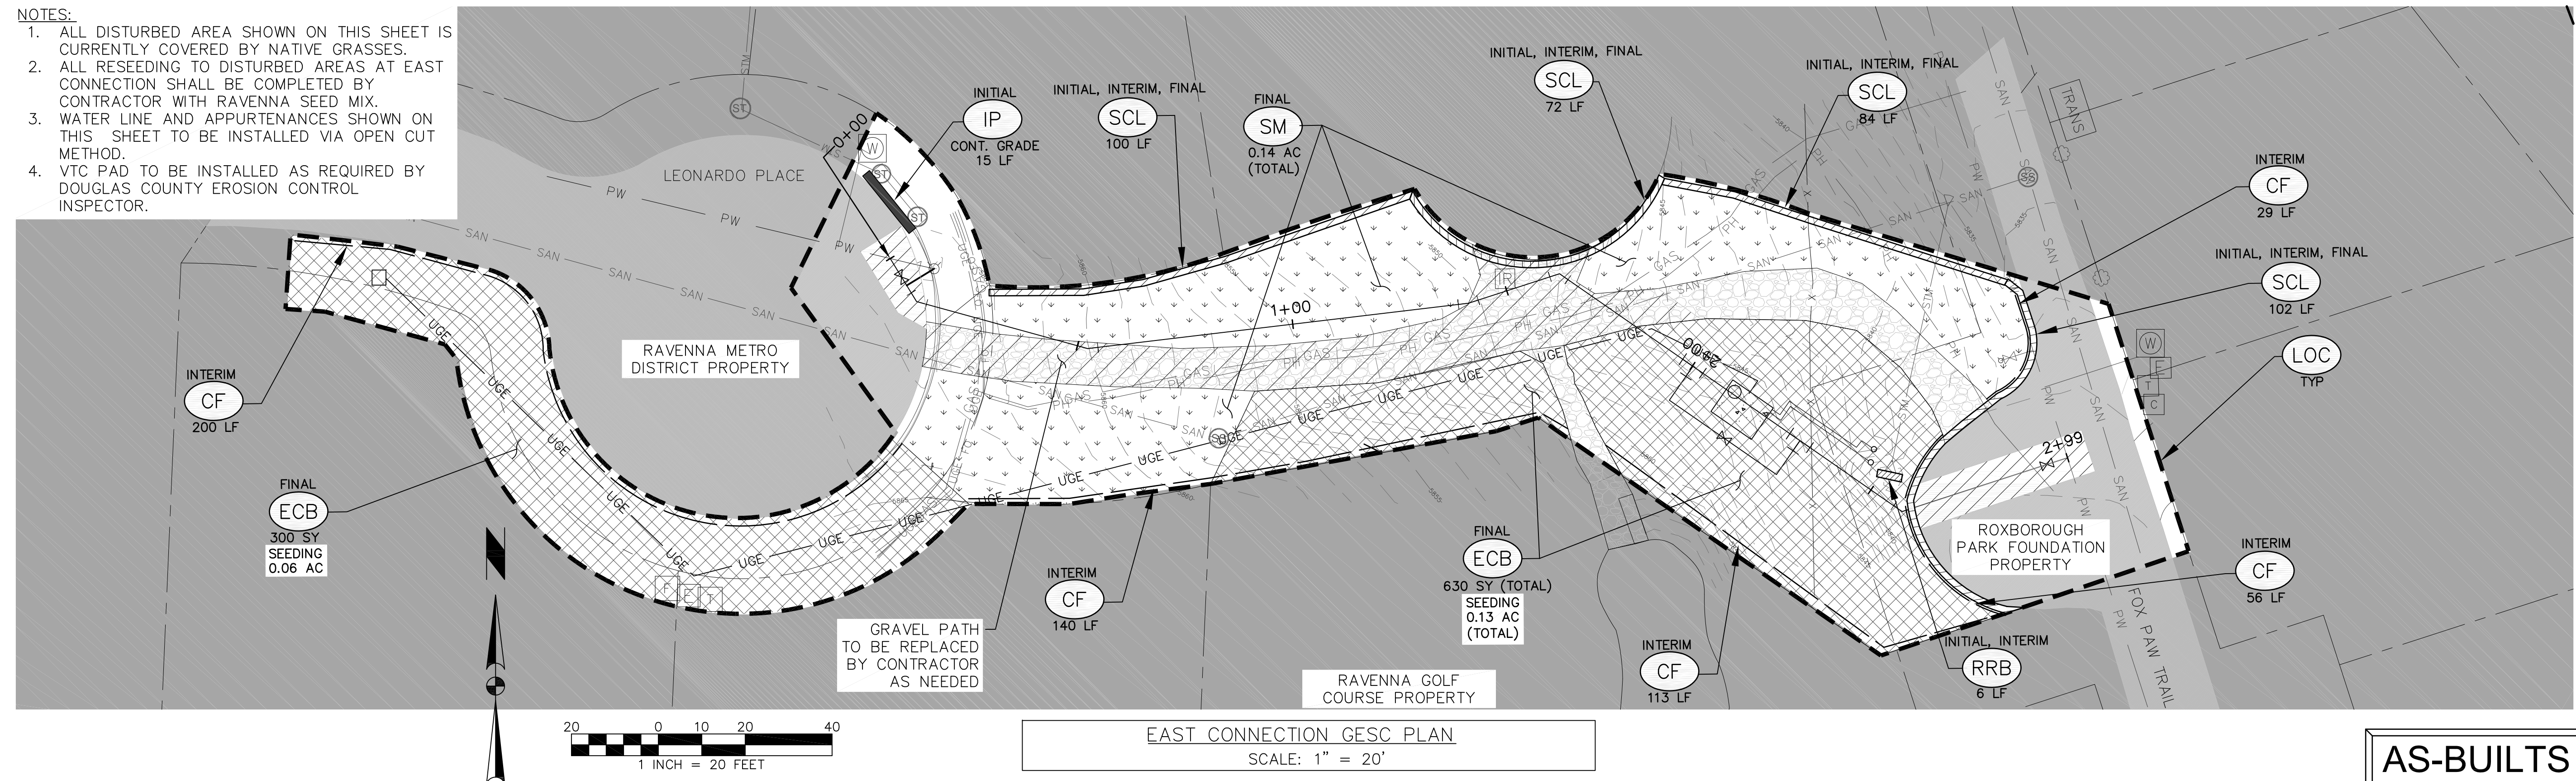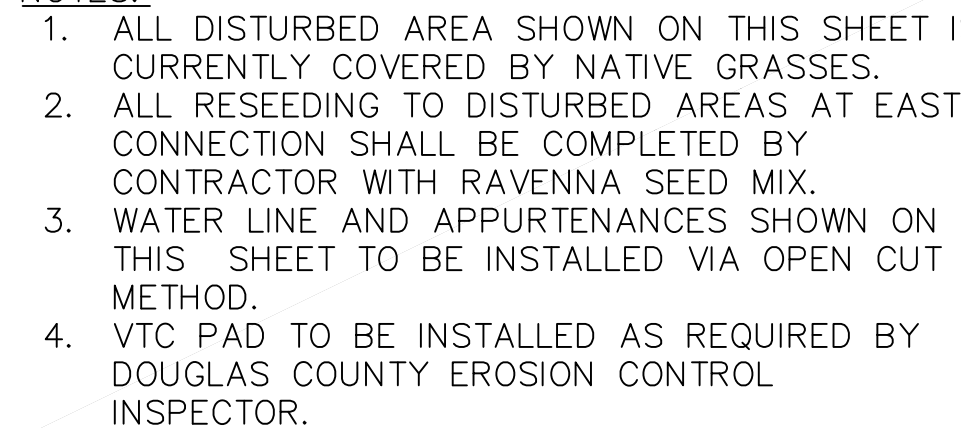

## AS-BUILTS

## ROXBOROUGH WATER AND SANITATION DISTRICT

NORTH AND EAST CONNECTION GESC PLAN



TST INFRASTRUCTURE, LLC  
Consulting Engineers

DATE **NOVEMBER 2019**

JOB NO. **001.335.01**

RWSI

# GESC2























NOTE: SCALES SHOWN ARE FOR 24"x36" SHEETS; ADJUST ACCORDINGLY FOR 11"x17" SHEETS.



**SHEET  
2 OF 3**

## AS-BUILTS

# GESC5

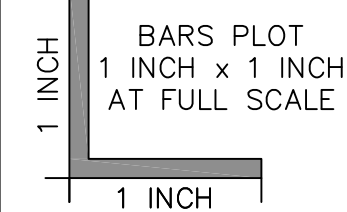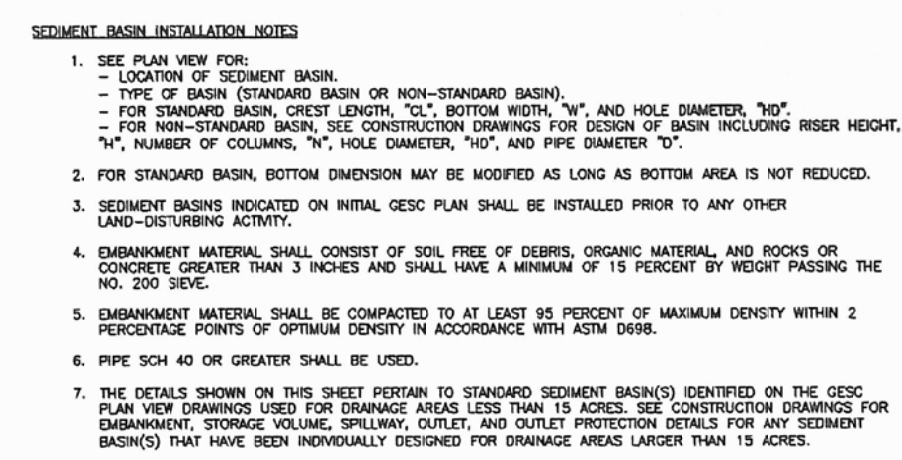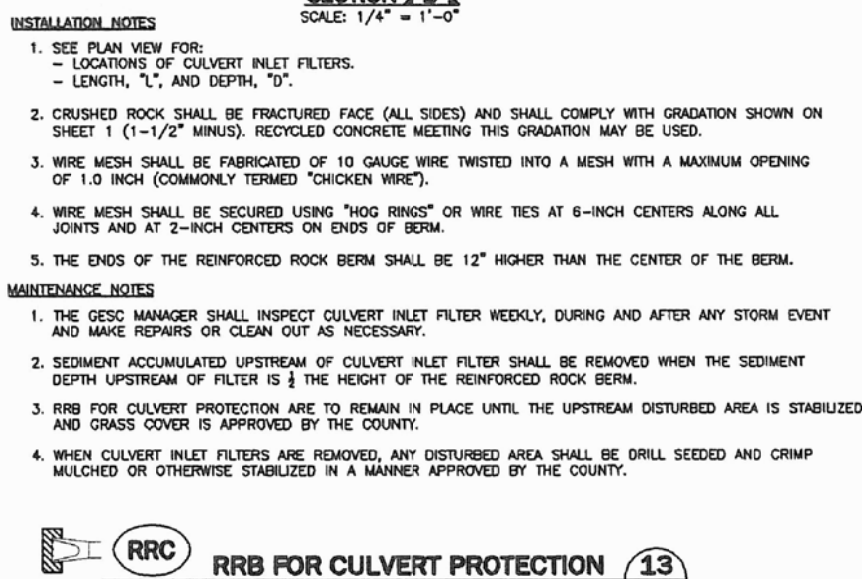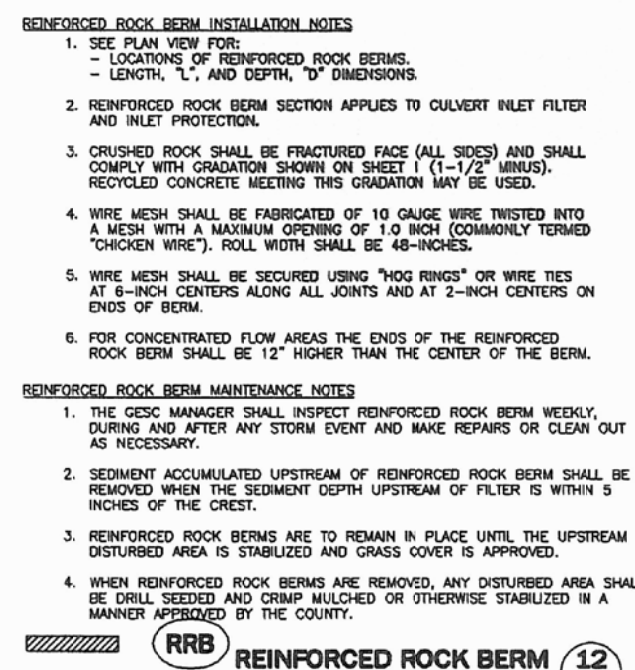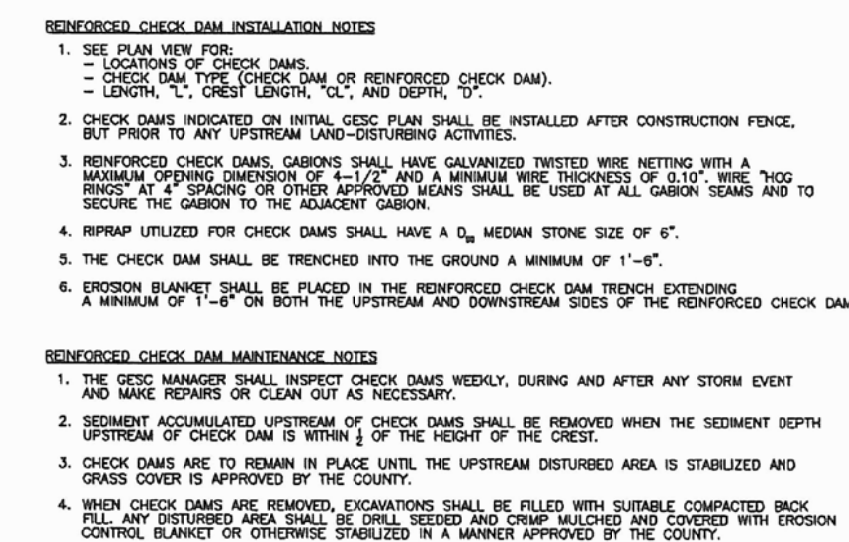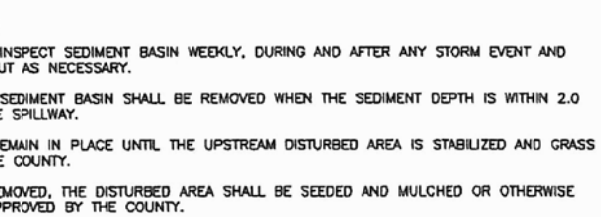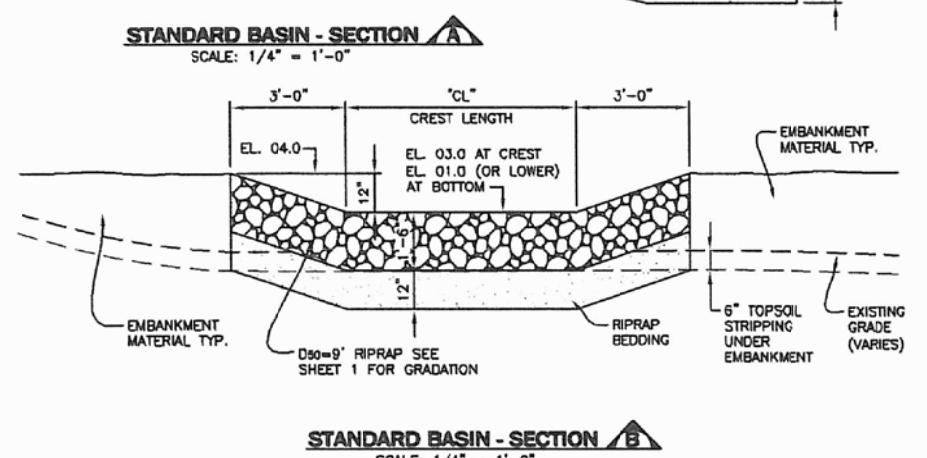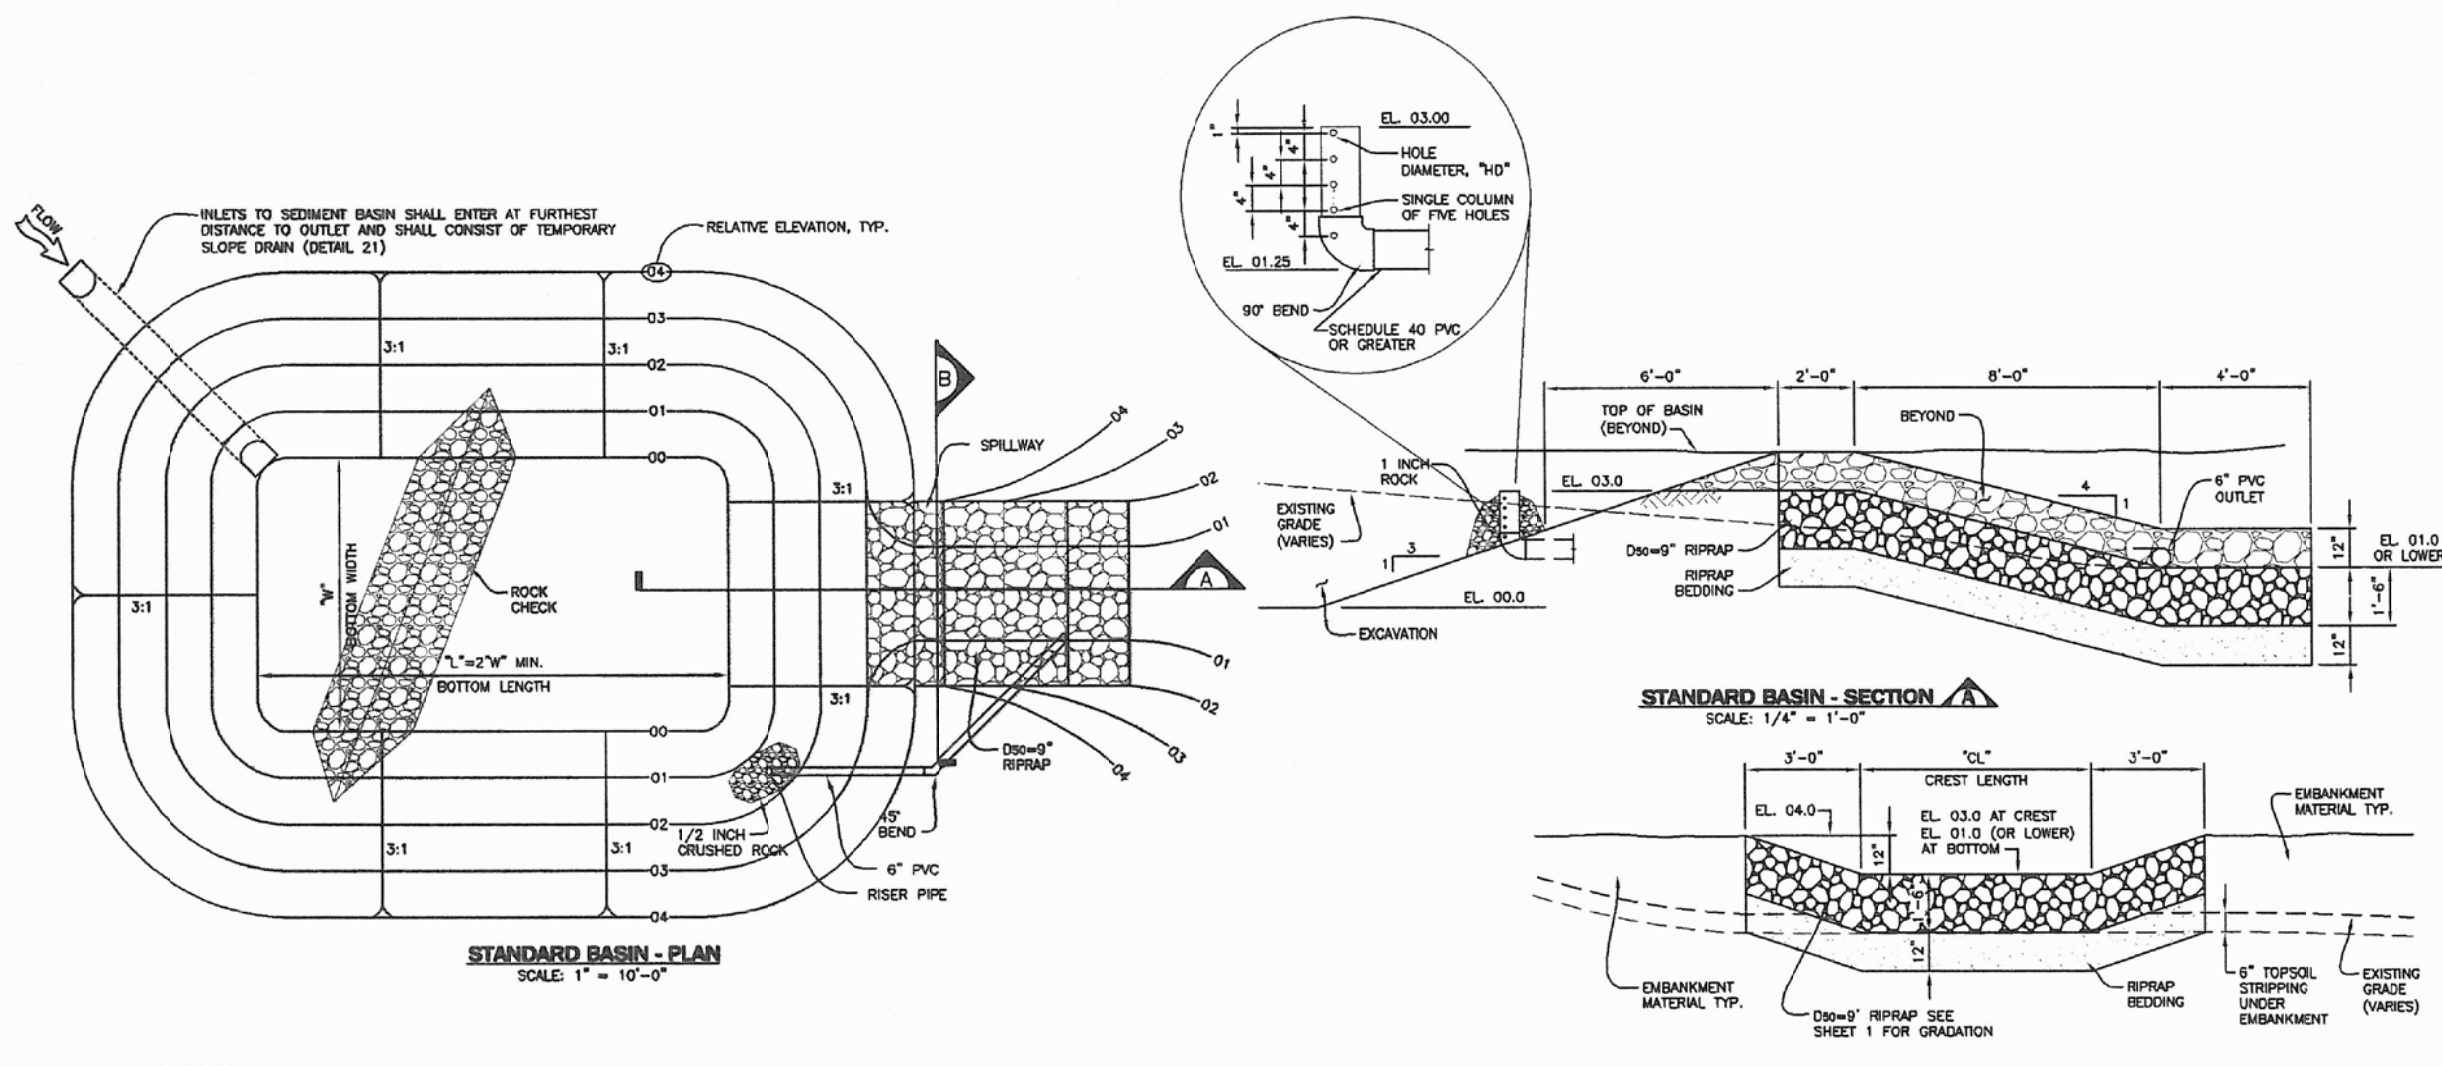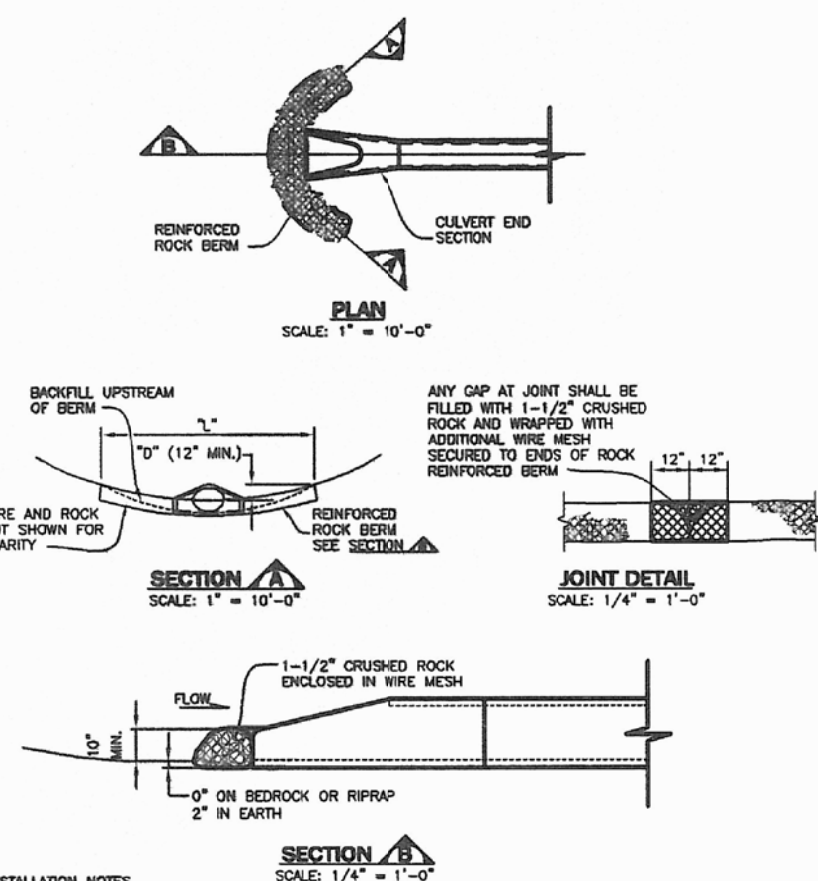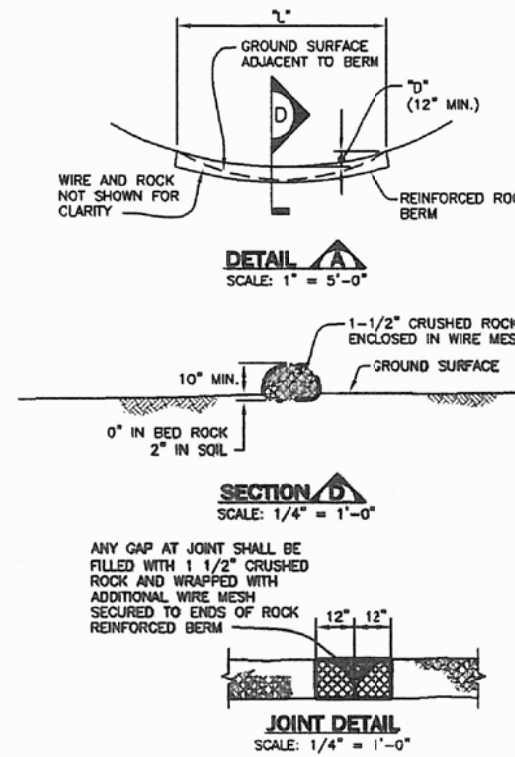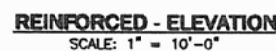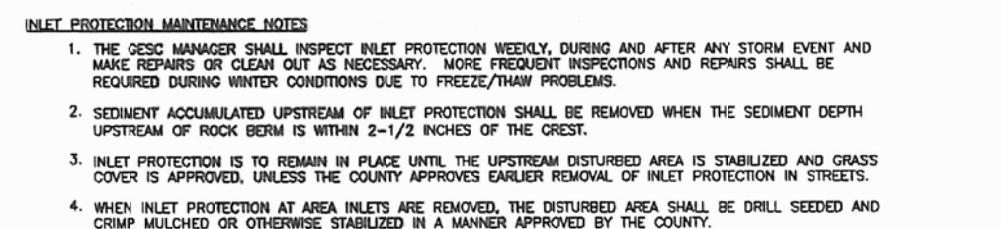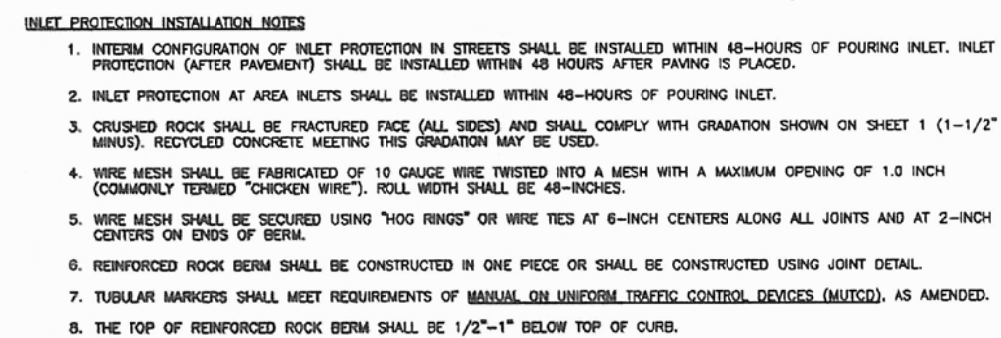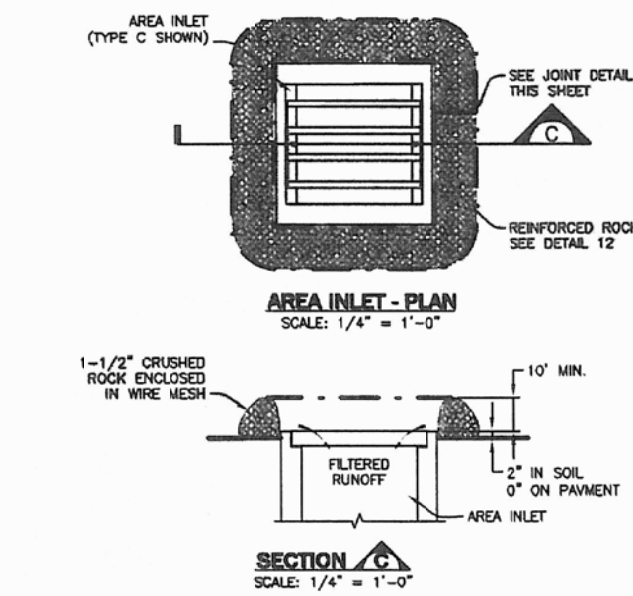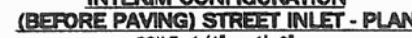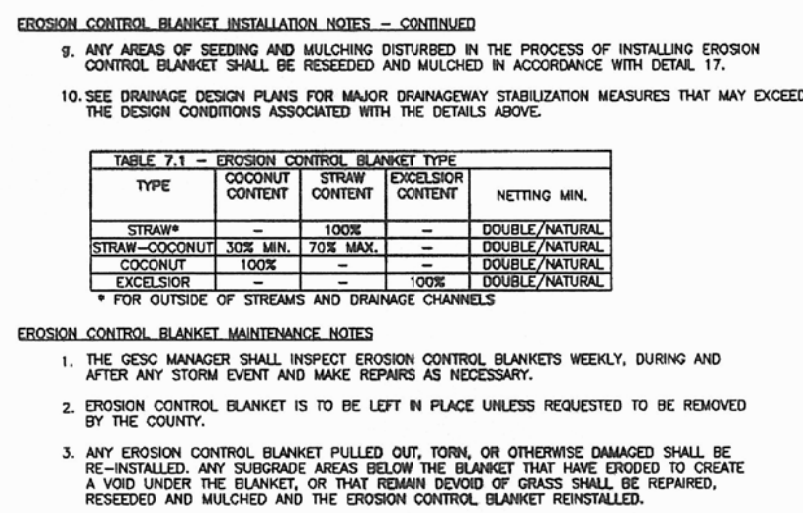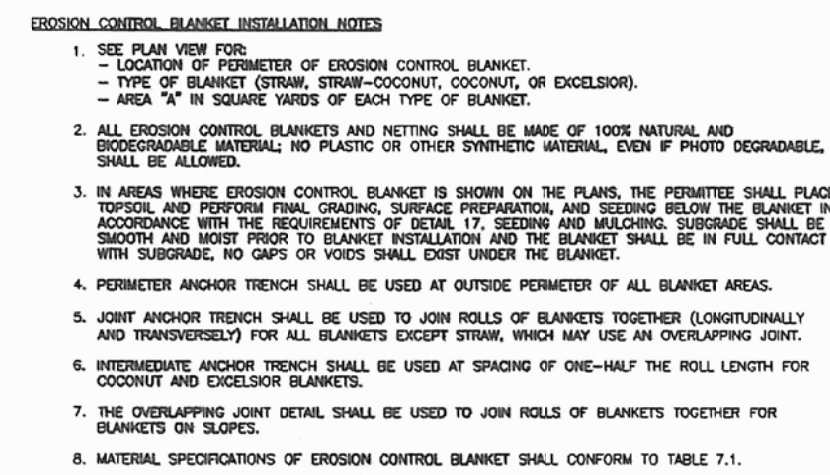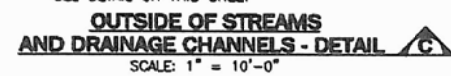DRAWN:DRAWN:DRAWN:



W:\T4104\T4104-15\10 DRAWINGS\03\_WIP\E1\_GENERAL LEGEND & ABBREVIATIONS\_RL\_REVA.dwg, E1, 8/1/2019 7:57 AM

LOW TENSION AND SIGNAL

	WALL MOUNTED COMBINATION DATA PORT GENERAL NETWORK / PLANT NETWORK
	WALL MOUNTED DATA PORT
	UTILITY COLUMN MOUNTED DATA PORT
	FLOOR MOUNTED DATA PORT
	CEILING MOUNTED SPEAKER F-FLUSH MTD. S-SURFACE MTD.
	WALL MOUNTED SPEAKER
	SPEAKER HORN
	PUSH BUTTON
	BELL
	BUZZER
	CARD READER
	WIRELESS ACCESS POINT

LIGHTING

	CEILING MOUNTED FIXTURE TYPE:1 PANEL:A-B SWITCH-b CIRCUIT-2
	WALL MOUNTED FIXTURE
	SURFACE MTD. FLUORESCENT FIXTURE
	WALL MTD. FLUORESCENT FIXTURE
	RECESSED FLUORESCENT FIXTURE
	INDICATOR LIGHT OR LIGHT FIXTURE
	EXIT LIGHT: WALL OR SURFACE MOUNT, ARROW AS (ARROW AS INDICATED ON DRAWINGS)
	EMERGENCY LIGHT
	WALL MOUNTED FLOODLIGHTS
	POLE MOUNTED FLOODLIGHTS
	PHOTOCELL
	TIME CLOCK CONTROLLED CEILING MTD. RECESSED EMERG. BATTERY PACK

CONDUIT AND WIRING

	SURFACE MOUNTED PANEL
	FLUSH MOUNTED PANEL
	CONDUIT (RUN IN WALLS, CEILING, OR ABOVE GRADE)
	CONDUIT (RUN IN SLAB, UNDERGROUND OR BEHIND OBSTRUCTION)
	CONDUIT (CAPPED)
	CONDUIT (TURNS AS INDICATED)
	FLEX CONDUIT (NOT ALWAYS SHOWN)
	GROUND CONDUCTOR
	UNDERGROUND CONCRETE ENCASED DUCTBANK
	UNDERGROUND CONCRETE ENCASED REINFORCED DUCTBANK
	DETAIL CROSS REFERENCE

SINGLE LINE & SCHEMATIC

	POTHEAD OR CABLE/BUS-JUNCTION
	CAPACITOR
	POWER TRANSFORMER
	POWER CIRCUIT BREAKER
	LOW VOLTAGE CIRCUIT BREAKER
	LOAD BREAK SWITCH
	FUSED DISCONNECT SWITCH
	FUSED DISCONNECT (AIR)
	FUSE
	GROUND ROD
	GROUND TEST WELL
	FUSE LINK
	BUSDUCT
	POTENTIAL TRANSFORMER
	CURRENT TRANSFORMER
	ZERO SEQUENCE CURRENT TRANSFORMER
	BUSHING TYPE CURRENT TRANSFORMER
	DISCONNECT DRAW-OUT TYPE TEST BLOCK
	WITHDRAW
	GROUND CONNECTION
	BOLTED CONNECTION
	THERMAL OVERLOAD. IF 'E' IS SHOWN - SOLID STATE OVERLOAD
	INCOMING LINE
	OUTGOING LINE
	KEY INTERLOCK
	TRANSFORMER CONNECTION
	ARRESTOR
	PHASE
	EMERGENCY STOP
	NORMALLY CLOSED PUSHBUTTON
	NORMALLY OPEN PUSHBUTTON
	TEMPERATURE SWITCH
	NO ON TIME DELAY SWITCH
	NC ON TIME DELAY SWITCH
	CONTACTOR: NORMALLY CLOSED
	CONTACTOR: NORMALLY OPEN
	HEATER
	FLOAT SWITCH
	PRESSURE SWITCH (CLOSING ON RISING PRESSURE)
	PRESSURE SWITCH (OPENING ON RISING PRESSURE)

	ANALOG SIGNAL
	DIGITAL SIGNAL

MOTORS AND CONTROL

	MOTOR CONTROL CENTER
	COMBINATION STARTER
	FUSED DISCONNECT SWITCH
	UNFUSED DISCONNECT SWITCH
	MANUAL MOTOR STARTER P-c/w PILOT LIGHT K-KEY OPERATED
	THERMOSTAT
	EXHAUST FAN
	RESISTANCE TEMPERATURE DETECTOR
	MOTOR
	GENERATOR

OUTLETS AND DEVICES

	WALL MTD. DUPLEX RECEPTACLE (CCT. A-B-1)
	DOUBLE DUPLEX RECEPTACLE
	SPECIAL PURPOSE RECEPTACLE
	SPLIT FED RECEPTACLE
	SPECIAL RECEPTACLE E - EMERGENCY G - GROUND H - HOUSEKEEPING S - SAFETY IP- ISOLATED POWER G- ISOLATED GROUND
	UTILITY COLUMN MTD. RECEPTACLE
	FLOOR MOUNTED RECEPTACLE
	20 AMPS
	SWITCH (X: SWITCH LABEL; Y: 3-3 WAY, 4-4 WAY, Y: T TIMED SWITCH)
	SINGLE POLE SWITCH (X: SWITCH LABEL)
	WALL MOUNTED JUNCTION BOX
	WALL MOUNTED SINGLE FACED CLOCK
	WALL MOUNTED CLOCK OUTLET
	SECURITY CAMERA

FIRE ALARM DEVICES

	PRODUCTS OF COMBUSTION DETECTOR ZONE 3, DEVICE 6, F-FLUSH & S-SURFACE MTD. OUTLET BOX
	HEAT DETECTOR (15° RATE OF RISE)
	HEAT DETECTOR (FIXED TEMPERATURE)
	FIRE ALARM BREAKGLASS STATION
	FIRE ALARM HORN
	FIRE ALARM ROTATING BEACON
	FIRE ALARM DUCT DETECTOR
	FIRE ALARM DOOR RELEASE - FLOOR MTD.
	VOICE COMM. TELEPHONE (FIREMEN'S)
	VOICE COMM. SPEAKER (FIREMEN'S)

ABBREVIATIONS:

#	NUMBER	MAU	MAKEUP AIR UNIT
A	AMPS (AMPERES)	MCC	MOTOR CONTROL CENTER
ABBR	ABBREVIATION	MCP	MOTOR CIRCUIT PROTECTOR
AC	ALTERNATING CURRENT	MDF	MAIN DISTRIBUTION FRAME
A/C	AIR CONDITIONING	MDP	MAIN DISTRIBUTION PANEL
AFF	ABOVE FINISHED FLOOR	MH	MAN HOLE
AFG	ABOVE FINISHED GRADE	MM	MULTIMODE
AHU	AIR HANDLING UNIT	MOV	MOTOR OPERATED VALVE
AIC	AMPS INTERRUPTING CURRENT	MUX	MULTIPLEXER
ATS	AUTOMATIC TRANSFER SWITCH	MSH	MOTOR SPACE HEATER
AUTO	AUTOMATIC	MTS	MOTOR TEMPERATURE SWITCH
AUX	AUXILIARY	N	NEUTRAL
AWG	AMERICAN WIRE GAUGE	NC	NORMALLY CLOSED
BATT	BATTERY	NEC	NATIONAL ELECTRIC CODE
BFC	BELOW FINISHED CEILING	NEMA	NATIONAL ELECTRIC MANUFACTURES ASSOCIATION
BFF	BELOW FINISHED FLOOR	NIC	NOT IN CONTRACT
BFG	BELOW FINISHED GRADE	NO	NORMALLY OPEN
C	CONDUIT	NTS	NOT TO SCALE
CAP	CAPACITOR	O/L	OVERLOAD
CB	CIRCUIT BREAKER	OS	OCCUPANCY SENSOR
CKT	CIRCUIT	PB	PULL BOX
CO	CONDUIT ONLY	PH, Ø	PHASE
COMM	COMMUNICATION	PLC	PROGRAMMABLE LOGIC CONTROLLER
CR	CONTROL RELAY	PR	PAIR
CS	CONTROL STATION	PRI	PRIMARY
CT	CURRENT TRANSFORMER	PSS	PANIC SHUTDOWN SYSTEM
CU	COPPER	PVC	POLYVINYL CHLORIDE
DC	DIRECT CURRENT	QTY	QUANTITY
DCS	DISTRIBUTED CONTROL SYSTEM	REC	RECEPTACLE
DISC	DISCONNECT	RGS	RIGID GALVANIZED STEEL CONDUIT
DS	DOOR SWITCH	RMS	ROOT MEAN SQUARE
DWG	DRAWING	RM	ROOM
E	EXISTING	RTU	REMOTE TERMINAL UNIT
E-STOP	EMERGENCY STOP	SDBC	SOFT DRAWN BARE COPPER
EF	EXHAUST FAN	SEC	SECONDARY
EM	EMERGENCY	SPD	SURGE PROTECTION DEVICE
EMT	ELECTRICAL METALLIC TUBING CONDUIT	SS	SOFT START
F	FUSE	ST	SHUNT TRIP
FA	FIRE ALARM	SW	SWITCH
FACP	FIRE ALARM CONTROL PANEL	SWBD	SWITCHBOARD
FATC	FIRE ALARM TERMINATION CABINET	SWGR	SWITCHGEAR
FBO	FURNISHED BY OWNER	SHD	SHIELD
FLA	FULL LOAD AMPS	T, XFMR	TRANSFORMER
FLEX	FLEXIBLE METAL CONDUIT	TD	TIME DELAY RELAY
FLMC	FLEXIBLE LIQUIDTIGHT METALLIC CONDUIT	TC	TRAY CABLE OR TIME CLOCK
FO	FIBER OPTIC	TVSS	TRANSIENT VOLTAGE SURGE SUPPRESSION
FREQ	FREQUENCY	TYP	TYPICAL
FVR	FULL VOLTAGE REVERSING	UG	UNDERGROUND
FVNR	FULL VOLTAGE NON-REVERSING	UH	UNIT HEATER
G	GROUND	UL	UNDERWRITER LABORATORY
GFCI	GROUND FAULT CIRCUIT INTERRUPTER	UON	UNLESS OTHERWISE NOTED
GRC	GALVANIZED RIGID CONDUIT	UPS	UNINTERRUPTIBLE POWER SUPPLY
HH	HAND HOLE	V	VOLT
HMI	HUMAN TO MACHINE INTERFACE	VA	VOLTAMPERES
IDF	INTERMEDIATE DISTRIBUTION FRAME	VFD	VARIABLE FREQUENCY DRIVE
IDS	INTRUSION DETECTION SYSTEM	W	WATTS
IG	ISOLATED GROUND	WP	WEATHERPROOF AND IN-USE COVER
LAN	LOGICAL AREA NETWORK	WT	WATERTIGHT
LC	LIGHTING CONTACTOR		
LTG	LIGHTING		

SPECIAL AREA DESIGNATIONS

THE DESIGNATIONS BELOW ARE LOCATED ON THE ELECTRICAL DRAWINGS TO DEFINE INSTALLATION REQUIREMENTS FOR THAT AREA. DESIGNATIONS ARE LOCATED WITHIN THE ROOM. ALL INDOOR AREAS NOT INDICATED BELOW ARE CLASSIFIED TYPE 1 AND MINIMUM NEMA TYPE 1 ENCLOSURES.

	CORROSIVE STORAGE AND CHEMICAL FEED AREAS. CONDUIT SYSTEMS SHALL BE PVC-COATED RIGID STEEL CONDUIT AND ACCESSORIES. ENCLOSURES AND BOXES SHALL BE TYPE 4X PLASTIC.
	INDOOR WET LOCATIONS: VAULTS, HOSEDOWN, BASEMENTS, ETC. CONDUIT SYSTEMS SHALL RIGID STEEL CONDUIT AND ACCESSORIES, ENCLOSURES AND BOXES SHALL BE TYPE 4X 316 STAINLESS STEEL.
	INDOOR, DRY, DIRTY AREAS, DUSTY. ENCLOSURES AND EQUIPMENT SHALL BE MINIMUM TYPE 12 GASKETED.
	CLASS 1, DIVISION 1, GROUP C AND D AS DEFINED BY NEC. ALL EQUIPMENT AND CONDUIT SYSTEMS SHALL BE RATED FOR USE IN THIS AREA.
	CLASS 1, DIVISION 2, GROUP C AND D AS DEFINED BY NEC. ALL EQUIPMENT AND CONDUIT SYSTEMS SHALL BE RATED FOR USE IN THIS AREA.


GENERAL NOTES:

- INFORMATION SHOWN ON THE DRAWINGS IS DIAGRAMTIC. DATA PRESENTED ON THE DRAWINGS IS AS ACCURATE AS PLANNING CAN DETERMINE, BUT ACCURACY IS NOT GUARANTEED AND FIELD VERIFICATION OF ALL DIMENSIONS, LOCATIONS, LEVELS, ETC., TO BEST SUIT FIELD CONDITIONS IS REQUIRED. REVIEW ALL ARCHITECTURAL, CIVIL, STRUCTURAL AND MECHANICAL DRAWINGS AND ALL SPECIFICATIONS AND ADJUST ALL WORK TO CONFORM TO ALL CONDITIONS SHOWN THEREIN.
- WHERE WIRE AND CABLE ROUTING IS NOT SHOWN, AND DESTINATION ONLY IS INDICATED, DETERMINE EXACT ROUTING AND LENGTHS REQUIRED BY FIELD VERIFICATION.




REVISIONS	Description	By	Rev	Issued For Bid	Issued For Construction	As-Built
		RL	8/2/18		9/21/2018	
		RL	7/9/2019			
DESIGNED: RL						
CHECKED: TMR						
DRAWING: RL						
1 INCH 1 INCH x 1 INCH AT FULL SCALE 1 INCH						
ROXBOROUGH WATER AND SANITATION DISTRICT RAVENNA PHASE II WATER CONNECTION INFRASTRUCTURE ELECTRICAL GENERAL LEGEND AND ABBREVIATIONS						
 96 INVERNESS DRIVE EAST UNIT R ENGLEWOOD, CO 80112 (303) 799-1273						
DATE: JUNE 2018						
JOB NO: 001.335.01						
RWSO						
DRAWING NO: E1						


W:\T4104\T4104-15\10 DRAWINGS\03\_WIP\E2\_NORTH AND EAST VAULT SINGLE LINE DIAGRAM\_RL\_REV.B.dwg, E2, 8/1/2019 7:58 AM

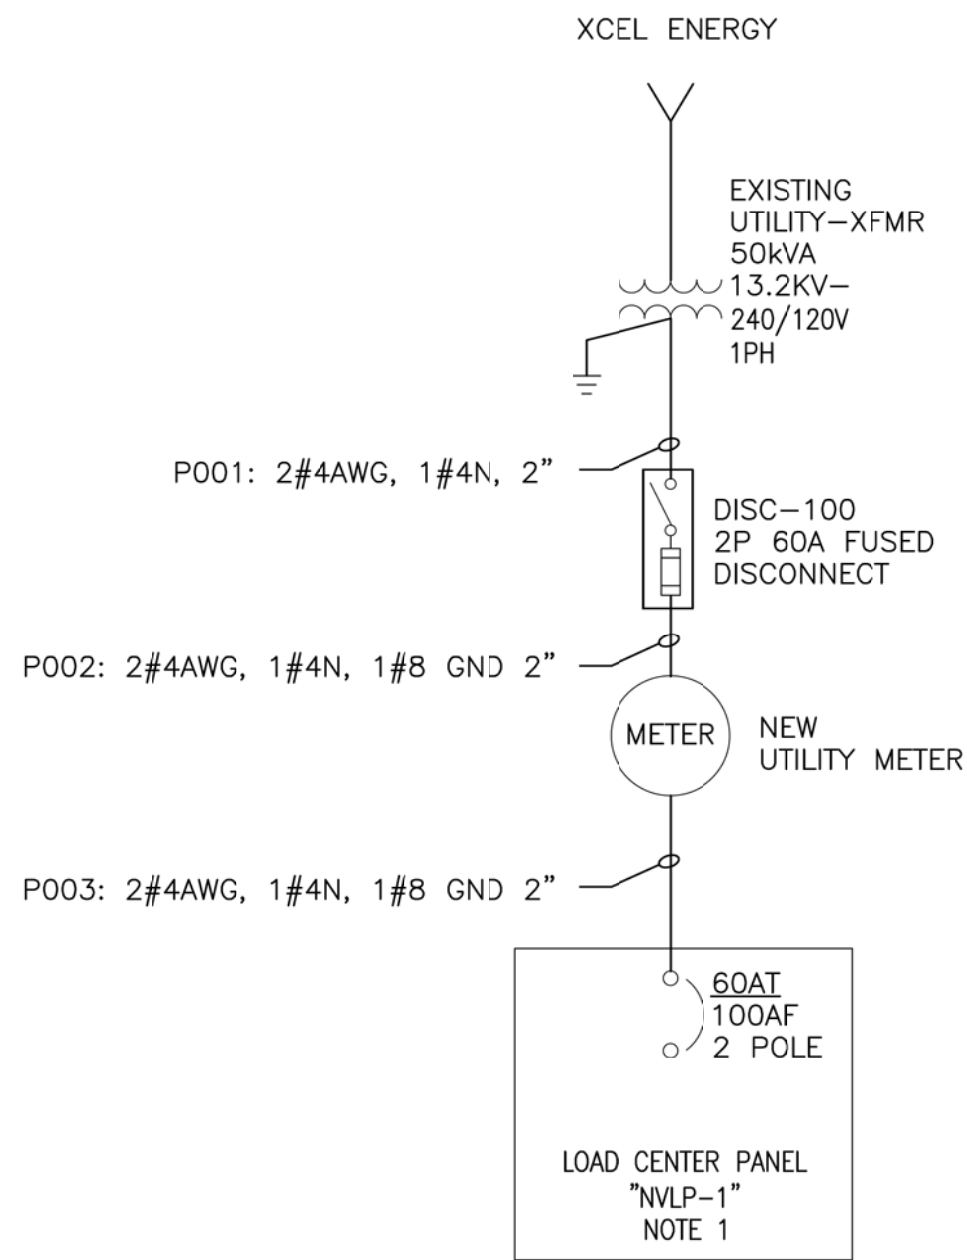


NORTH VAULT ONE LINE DIAGRAM

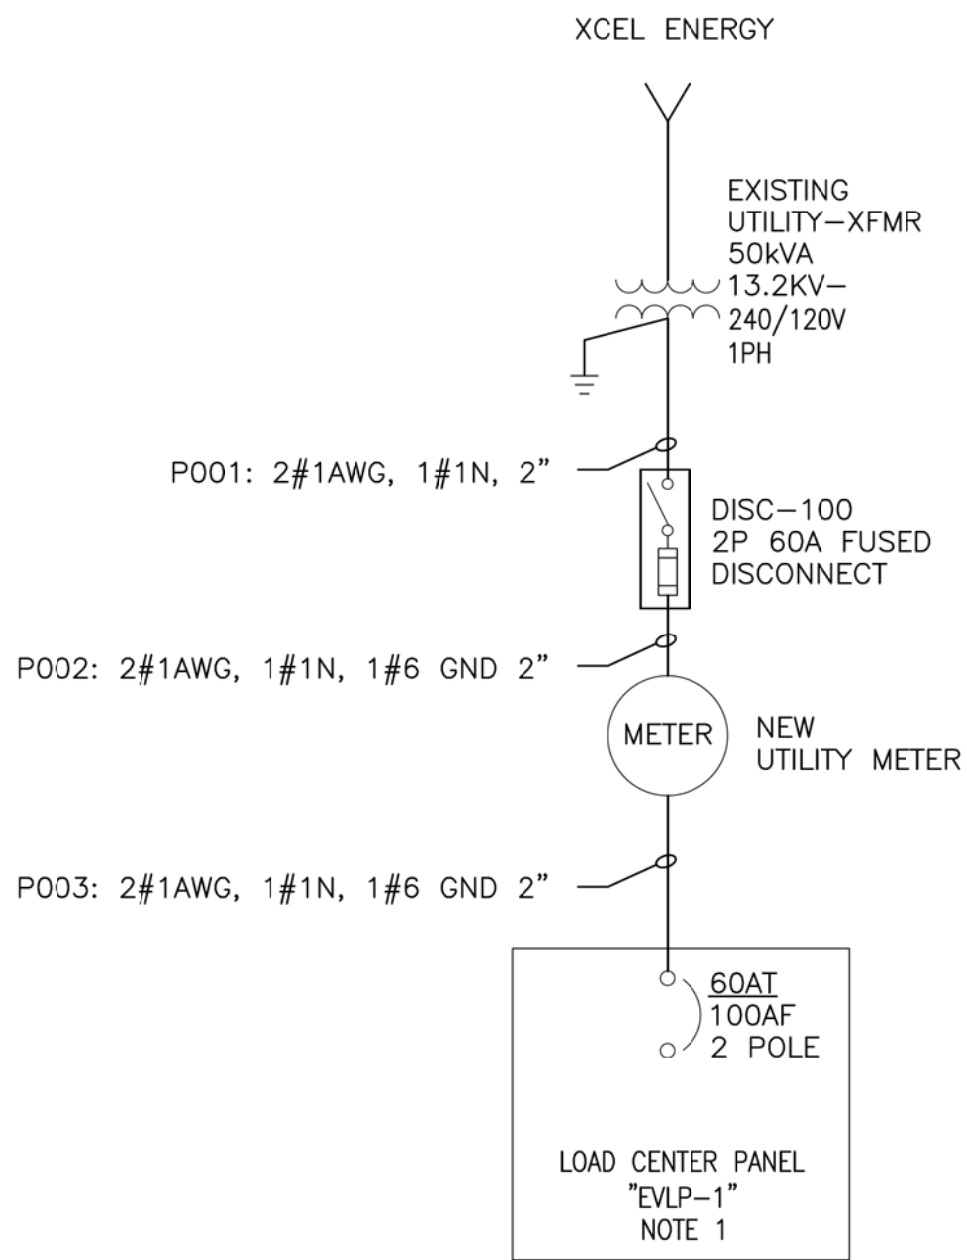


EAST VAULT ONE LINE DIAGRAM

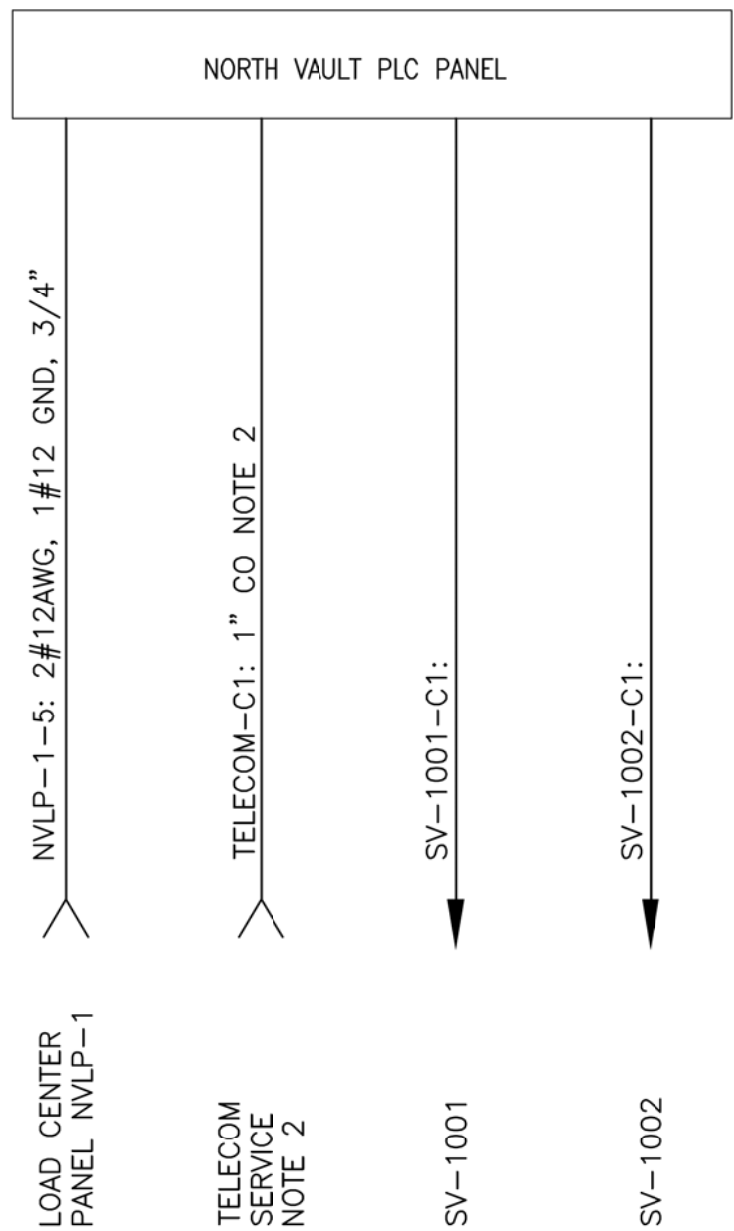

NORTH VAULT PLC PANEL  
PLC-1000

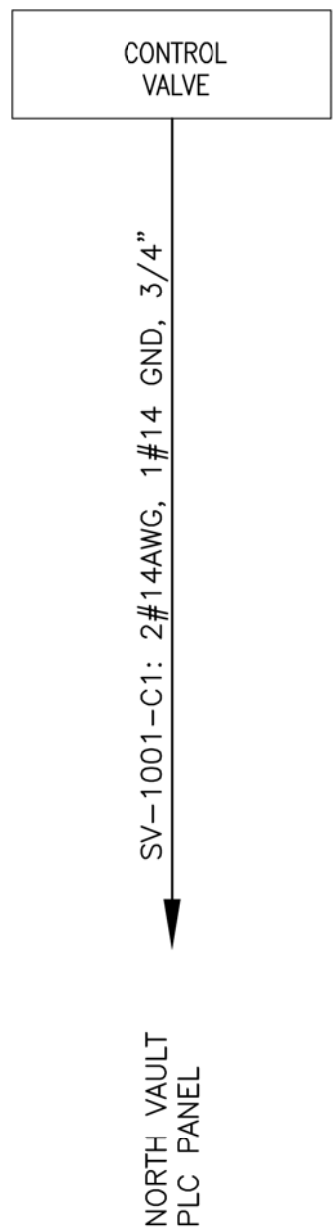

CONTROL VALVE SV-1001  
(TYPICAL: SV-1002)

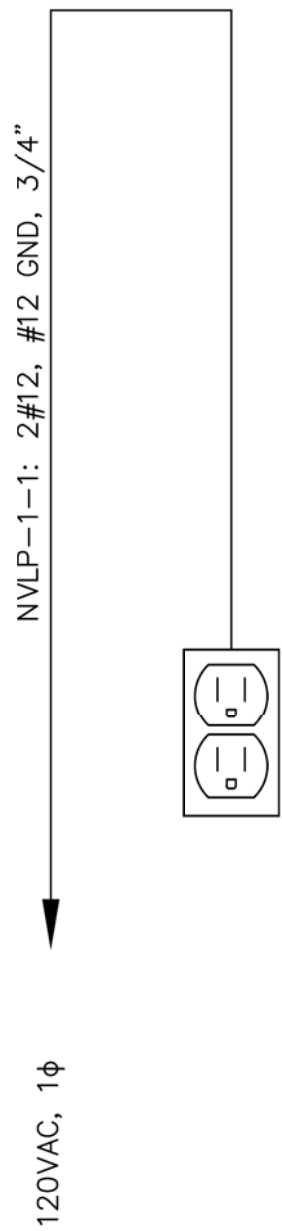

VAULT RECEPTACLE

PANEL: NVLP-1									
CCT	SIDE "A" LOAD	LOAD	BKR			BKR	LOAD	SIDE "B" LOAD	CCT
		VA	SIZE	A	B	SIZE	VA		
1	VAULT RECEPTACLES	360	20	X		20		Spare	2
3	VAULT LIGHTING	100	20		X	20		Spare	4
5	N. VAULT PLC Panel PLC-1000	600	20	X				Spare	6
7	Space				X			Space	8
9	Space			X				Space	10
11	Space				X			Space	12
TOTAL PHASE "A" LOAD		960					100	TOTAL PHASE "B" LOAD	
CONNECTION: From Utility Meter				LOCATION: Above Grade at Vault VOLTAGE: 240/120VAC PHASE: 1P/3W MOUNTING: Surface					
BUS SIZE: 100A									
FEEDER: Refer to Drawings									
MAIN BREAKER: 60A									

PANEL: EVLP-1									
CCT	SIDE "A" LOAD	LOAD	BKR			BKR	LOAD	SIDE "B" LOAD	CCT
		VA	SIZE	A	B	SIZE	VA		
1	VAULT RECEPTACLES	360	20	X		20		Spare	2
3	VAULT LIGHTING	100	20		X	20		Spare	4
5	Space			X				Space	6
7	Space				X			Space	8
9	Space			X				Space	10
11	Space				X			Space	12
TOTAL PHASE "A" LOAD		360					100	TOTAL PHASE "B" LOAD	
CONNECTION: From Utility Meter				LOCATION: Above Grade at Vault					
BUS SIZE: 100A				VOLTAGE: 240/120VAC					
FEEDER: Refer to Drawings				PHASE: 1P/3W					
MAIN BREAKER: 60A				MOUNTING: Surface					

NOTES:

- CONTRACTOR SHALL PROVIDE AND INSTALL MAIN BONDING JUMPER AT THE LOAD CENTER PANEL. LOAD CENTER PANEL SHALL BE SERVICE ENTRANCE RATED.
- PROVIDE A 1" CONDUIT ONLY FROM THE NORTH VAULT PLC PANEL TO THE TELECOM POINT OF SERVICE. COORDINATE SERVICE ENTRANCE REQUIREMENTS WITH THE SERVING TELECOM UTILITY.

ROXBOROUGH WATER AND SANITATION DISTRICT  
RAVENNA PHASE II WATER CONNECTION INFRASTRUCTURE

NORTH AND EAST VAULT ONE LINE DIAGRAMS

**MAGNA**  
96 INVERNESS DRIVE EAST  
UNIT R  
ENGLEWOOD, CO 80112  
(303) 799-1273



DATE  
JUNE 2018


JOB NO.  
001.335.01

RWSD


DRAWING NO.

E2

W:\T4104\T4104-15\10 DRAWINGS\03-WIP\E3-EMERGENCY INTERCONNECT VAULT SINGLE LINE DIAGRAM\_RL\_REV.Dwg, E3, 8/1/2019 7:58 AM

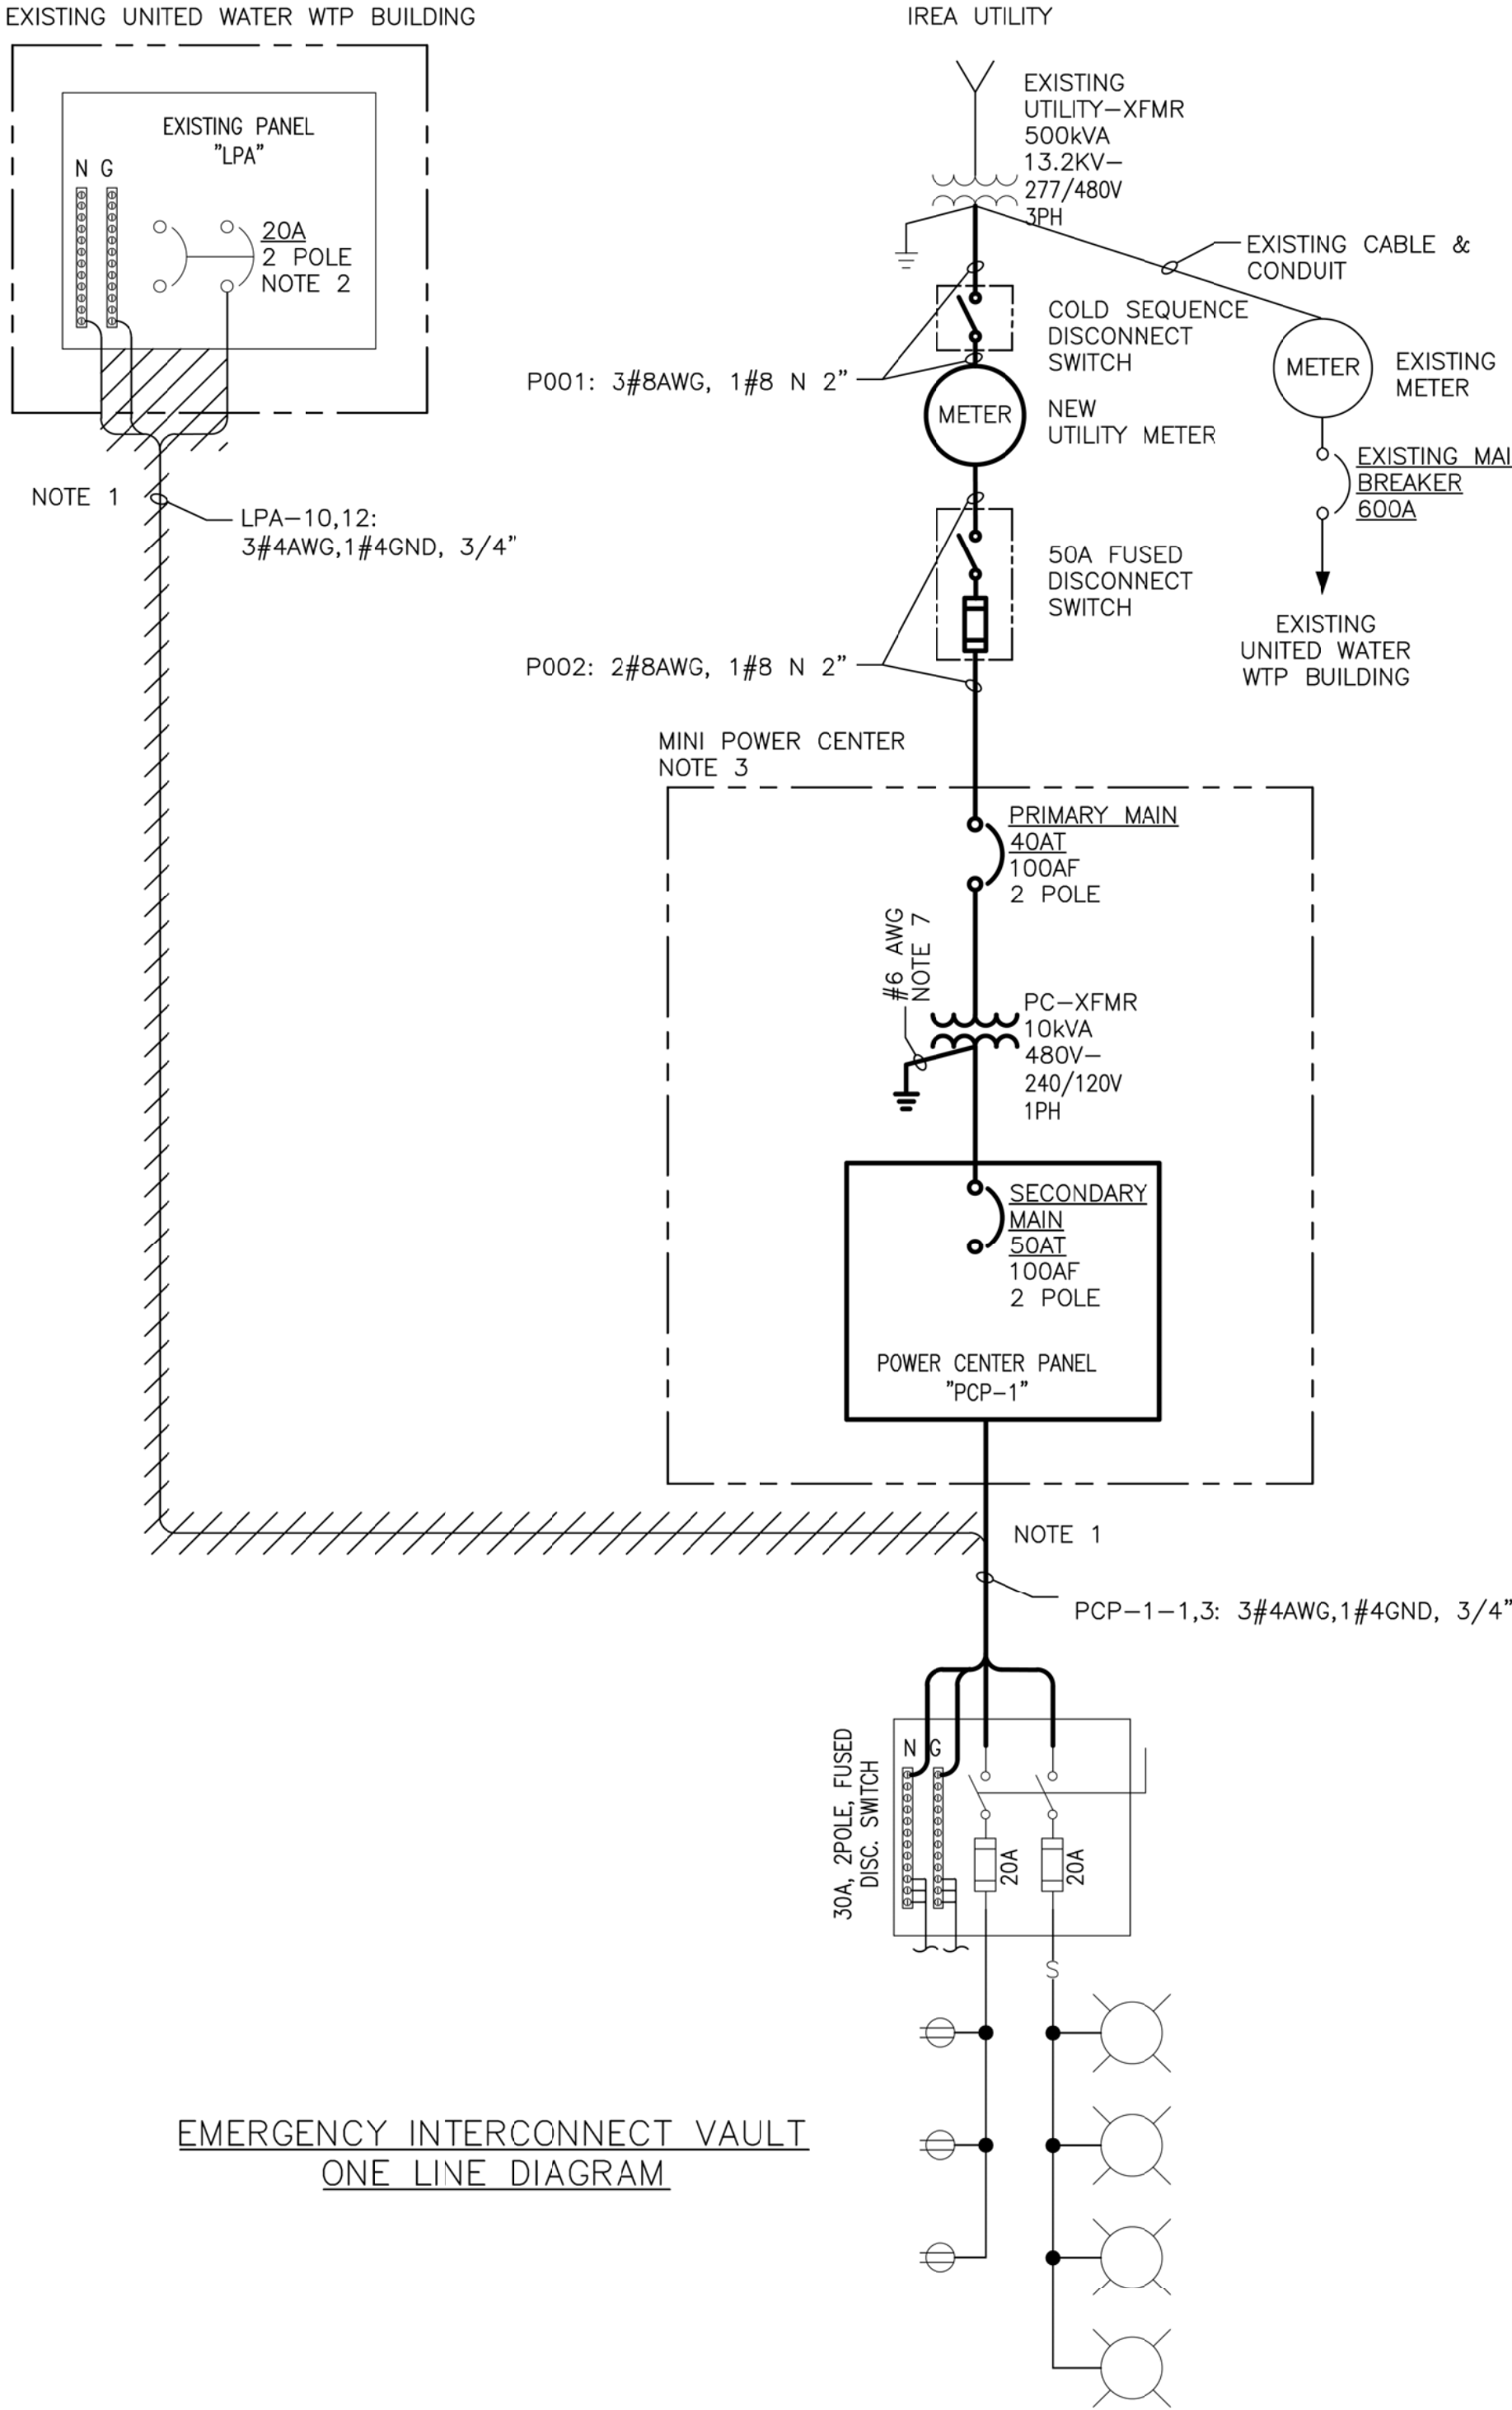

EMERGENCY INTERCONNECT VAULT  
ONE LINE DIAGRAM

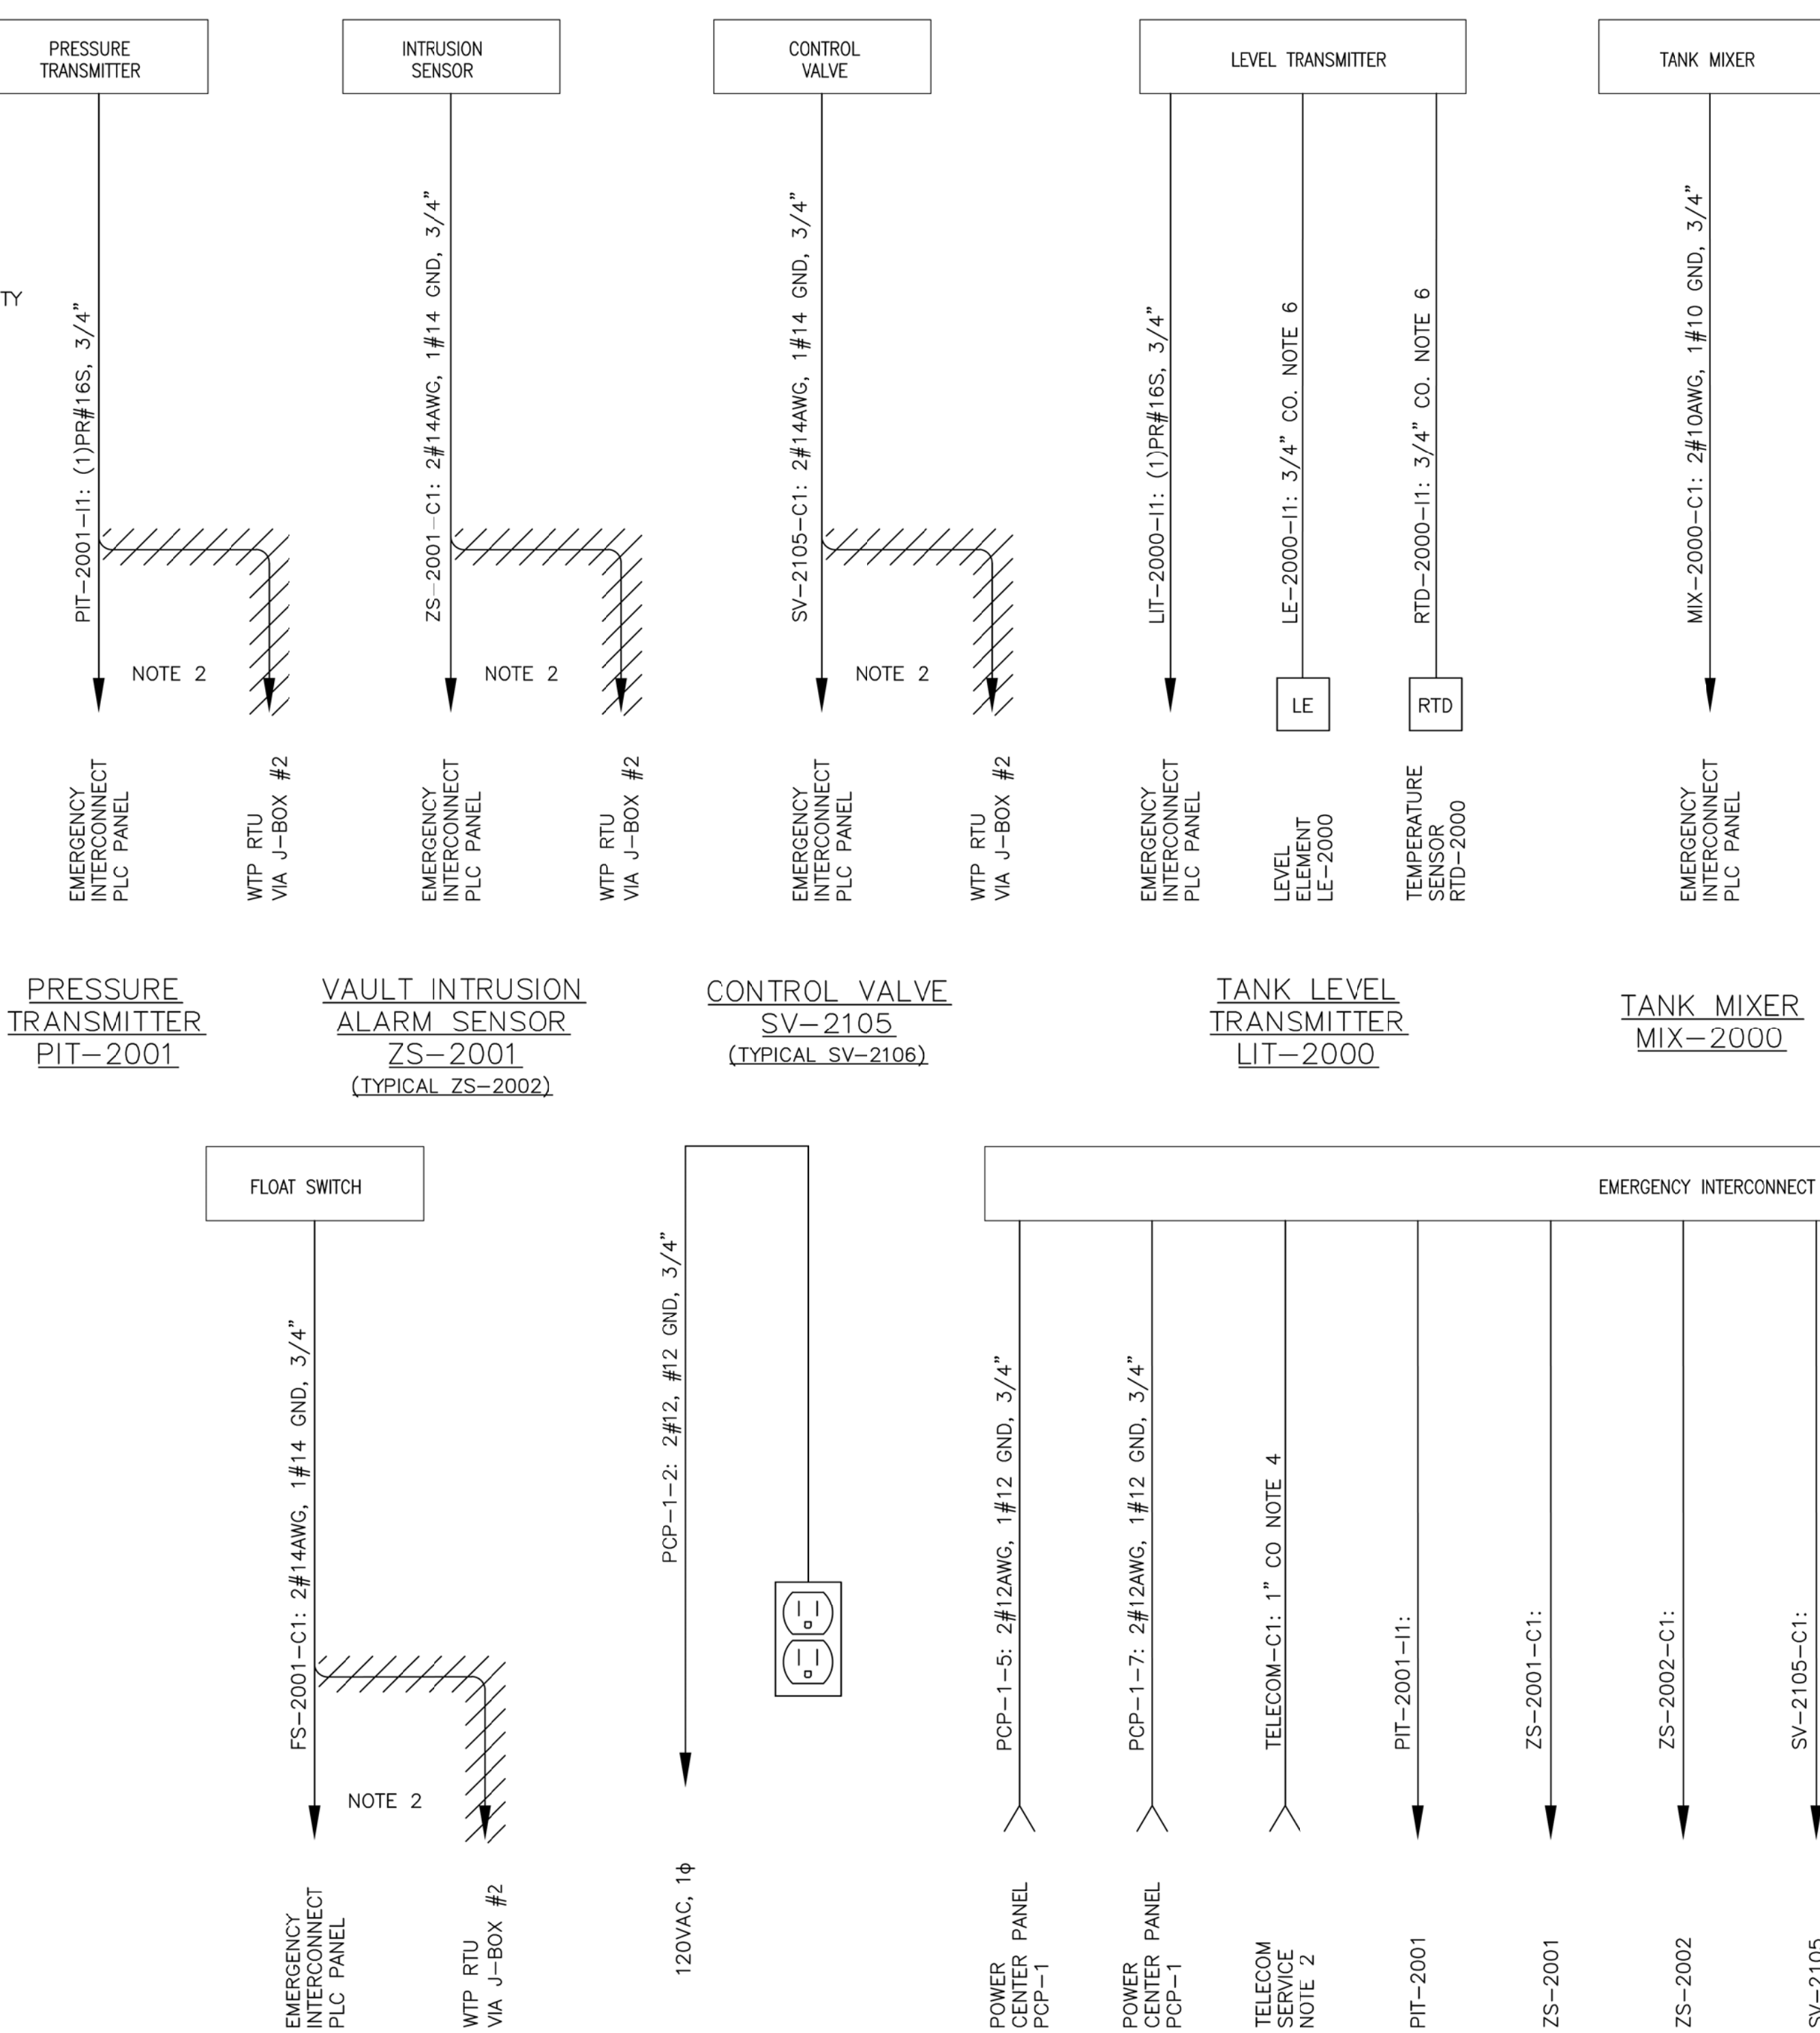

- NOTES:
- CONTRACTOR SHALL INTERCEPT AND EXTEND EXISTING CABLE AND CONDUIT ROUTED TO PANEL "LPA" LOCATED IN THE EXISTING WTP BUILDING TO POWER CENTER PANEL "PCP-1".
  - CONTRACTOR SHALL INTERCEPT AND EXTEND EXISTING CABLE AND CONDUIT ROUTED TO WTP RTU LOCATED IN THE EXISTING WTP BUILDING TO THE EMERGENCY INTERCONNECT PLC PANEL "PLC-2000".
  - CONTRACTOR SHALL PROVIDE AND INSTALL MAIN BONDING JUMPER AT PCP-1. POWER CENTER PCP-1 SHALL BE SERVICE ENTRANCE RATED.
  - PROVIDE A 1" CONDUIT ONLY FROM THE EMERGENCY INTERCONNECT PLC PANEL TO THE TELECOM POINT OF SERVICE. COORDINATE SERVICE ENTRANCE REQUIREMENTS WITH THE SERVING TELECOM UTILITY.
  - CONTRACTOR SHALL COORDINATE EXISTING INSTRUMENTATION OUTAGE TIME AND DURATION WITH OWNER PRIOR TO CONSTRUCTION.
  - CONTRACTOR SHALL COORDINATE MANUFACTURER SUPPLIED CABLE WITH INSTRUMENT SUPPLIER. CONTRACTOR SHALL COORDINATE CABLE LENGTH WITH FIELD CONDITIONS.
  - CONTRACTOR SHALL PROVIDE AND INSTALL TWO GROUND RODS FOR GROUND CONNECTION AS SHOWN.

PANEL: PCP-1									
CCT	SIDE "A" LOAD	LOAD	BKR			BKR	LOAD	SIDE "B" LOAD	CCT
		VA	SIZE	A	B	SIZE	VA		
1	VAULT RECEPTACLES	360	20	X		20	360	TANK RECEPTACLE	2
3	VAULT LIGHTING	100	20		X	20		Spare	4
5	EM INTER, PLC Panel PLC-2000	600	20	X				Space	6
7	EM INTER, PLC Panel PLC-2000	1000	20		X			Space	8
9	Spare		20	X				Space	10
11	Spare		20		X			Space	12
TOTAL PHASE "A" LOAD		1320					1100	TOTAL PHASE "B" LOAD	
CONNECTION: From Utility Meter				LOCATION: Above Grade at Vault					
BUS SIZE: 100A				VOLTAGE: 240/120VAC					
FEEDER: Refer to Drawings				PHASE: 1P/3W					
MAIN BREAKER: 50A				MOUNTING: Surface					

FLOAT SWITCH  
FS-2001  
(TYPICAL FS-2002)

TANK RECEPTACLE

EMERGENCY INTERCONNECT PLC PANEL  
PLC-2000



ROXBOROUGH WATER AND SANITATION DISTRICT  
RAVENNA PHASE II WATER CONNECTION INFRASTRUCTURE

EMERGENCY INTERCONNECT VAULT ONE LINE DIAGRAMS

**MAGNA**  
96 INVERNESS DRIVE EAST  
UNIT R  
ENGLEWOOD, CO 80112  
(303) 799-1273

DATE  
JUNE 2018

JOB NO.  
001.335.01

RWSD

DRAWING NO.


E3



1. ALL UTILITIES SHOWN ARE APPROXIMATE. CONTRACTOR SHALL OBTAIN PUBLIC AND PRIVATE UTILITY LOCATES TO VERIFY UTILITY LOCATIONS. POTHOLE ALL UTILITY CROSSINGS PRIOR TO CONSTRUCTION.
2. CONTRACTOR SHALL ROUTE CONDUITS TO BEST SUIT FIELD CONDITIONS. CONTRACTOR SHALL PROVIDE HAND HOLES AND JUNCTION BOXES AS REQUIRED FOR A COMPLETE INSTALLATION.
3. CONTRACTOR SHALL BE RESPONSIBLE FOR RETURNING LANDSCAPING AFFECTED BY WORK BACK TO ORIGINAL CONDITION.
4. CONTRACTOR SHALL INTERCEPT EXISTING CONDUCTORS ROUTED TO THE EXISTING WTP BUILDING AND EXTEND CONDUCTORS AND PROVIDE NEW CONDUIT AS REQUIRED TO THE NEW EQUIPMENT RACK.
5. PROVIDE A LOCKABLE IN USE WEATHER PROOF RECEPTACLE MOUNTED TO THE SIDE OF THE TANK HATCH.

DESIGNED: *RL*

CHECKED: *TMM*

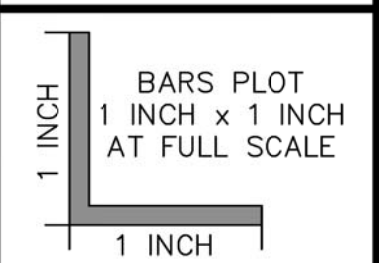DRAWN: *RL*

**ROXBOROUGH WATER AND SANITATION DISTRICT**

---

**RAVENNA PHASE II WATER CONNECTION INFRASTRUCTURE**

---

**EMERGENCY INTERCONNECT TANK & VAULT SITE  
ELECTRICAL PLAN**

DATE **JUNE 2018**

JOB NO. **001.335.01**

RWSD


DRAWING NO.

# E4



NOTE 4

DIRECT BURIED CONDUIT SCHEDULE						
NO.	CONDUIT ID	CIRCUIT ID	FROM	TO	SIZE	TYPE
1	P003	PCP-1-1,3	POWER CENTER PANEL "PCP-1"	EXISTING DISCONNECT SWITCH	2"	PVC
2	I001	PIT-2001-I1	EMERGENCY INTERCONNECT "PLC-2000"	PRESSURE TRANSMITTER "PIT-2001"	1"	PVC
3	C001	ZS-2001-C1, SV-2105-C1, SV-2106-C1, SPARE 2#14	EMERGENCY INTERCONNECT "PLC-2000"	INTRUSION SWITCH "ZS-2001", SOLENOID "SV-2105", AND SOLENOID "SV-2106"	1"	PVC
4	P001	P001	EXISTING UTILITY TRANSFORMER	UTILITY METER	2"	PVC
5	P002	P002	UTILITY METER	POWER CENTER PANEL "PCP-1"	2"	PVC
6	C002	MIX-2000-C1, PCP-1-2	POWER CENTER PANEL "PCP-1"	TANK MIXER "MIX-2000", TANK RECEPTACLE	1"	PVC
7	I002	LE-2000-I1, RTD-2000-I1	LEVEL TRANSMITTER "LIT-2000"	LEVEL ELEMENT "LE-2000" AND TEMPERATURE SENSOR "RTD-2000"	1"	PVC
8	C004	FS-2001-C1 AND FS-2002-C1	EMERGENCY INTERCONNECT "PLC-2000"	TANK FLOAT SWITCHES "FS-2001" AND "FS-2002"	1"	PVC

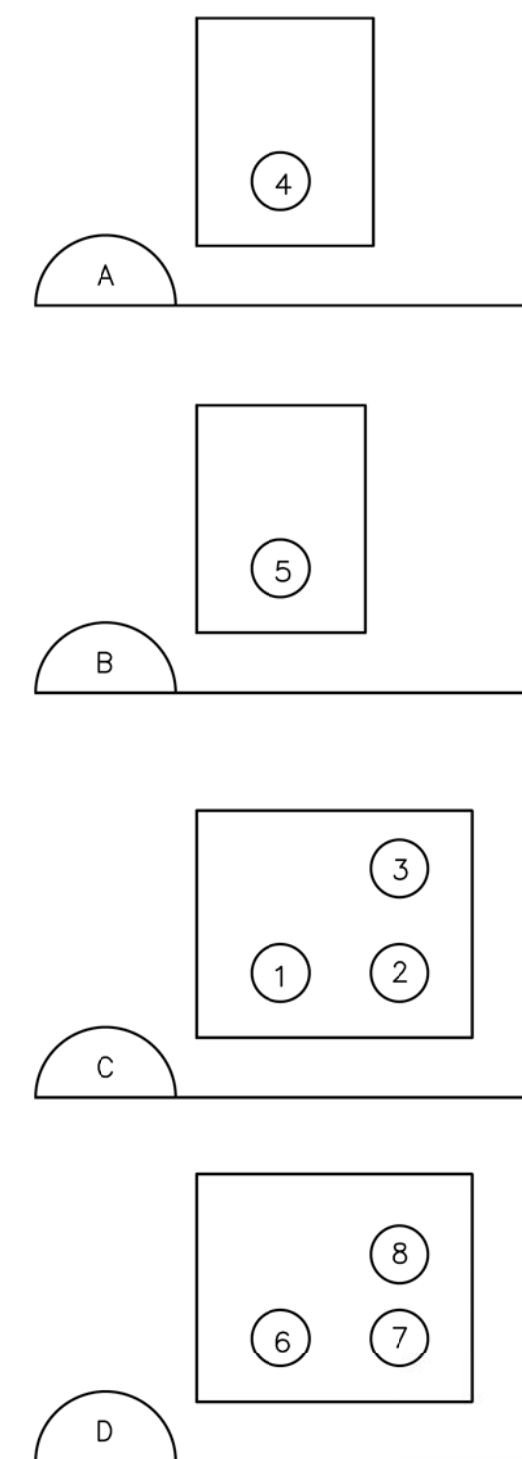


- | REVISIONS |          |                         |
|-----------|----------|-------------------------|
| By        | Date     | Description             |
| RL        | 8/2/18   | ISSUED FOR BID          |
| RL        | 9/2/2018 | ISSUED FOR CONSTRUCTION |
| RL        | 7/9/2019 | AS-BUILT                |
|           |          |                         |
|           |          |                         |
|           |          |                         |
|           |          |                         |

DRAWN: *RL*

ROXBOROUGH WATER AND SANITATION DISTRICT  
 RAVENNA PHASE II WATER CONNECTION INFRASTRUCTURE

NORTH VAULT ELECTRICAL SITE PLAN


---

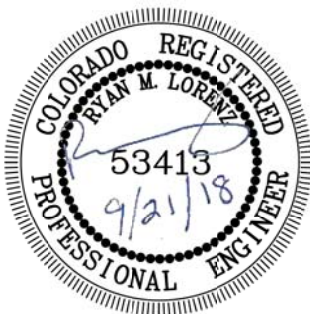


DRAWING NO.

# E5

W:\T4104\T4104-15\10 DRAWINGS\03-WP\E6-EAST VAULT SITE PLAN\_RL\_REVA.dwg, E6, 8/1/2019 7:58 AM

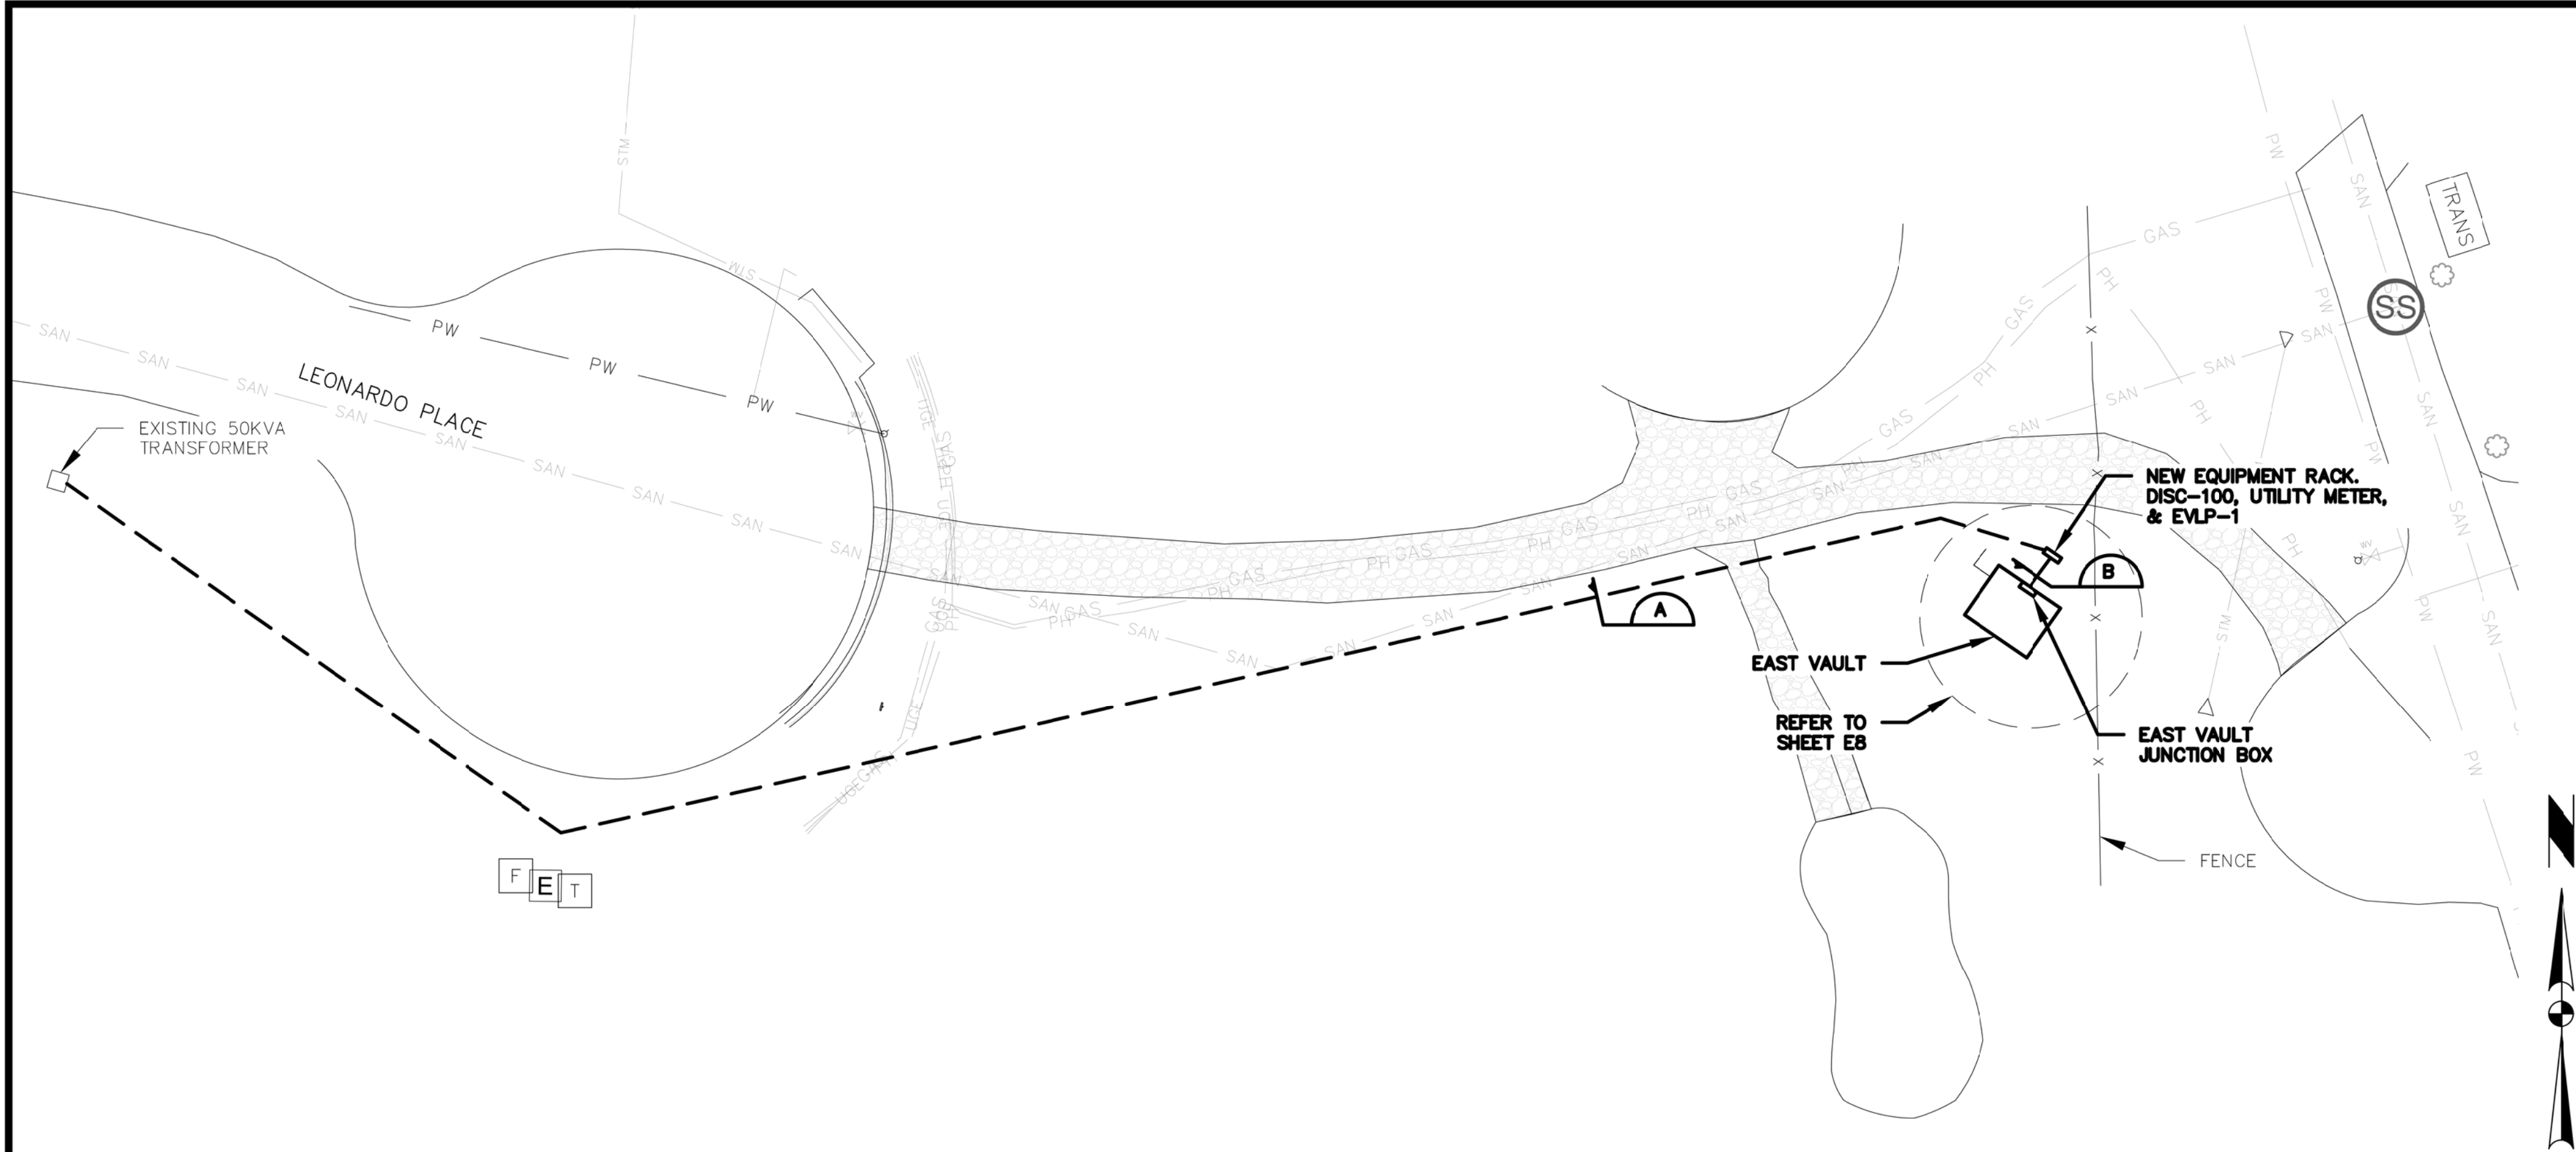


EAST VAULT SITE PLAN  
SCALE: 1" = 20'

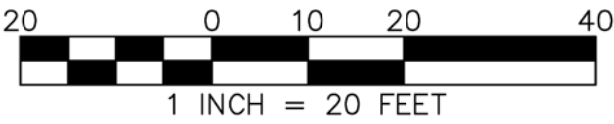

NOTE 4

DIRECT BURIED CONDUIT SCHEDULE						
NO.	CONDUIT ID	CIRCUIT ID	FROM	TO	SIZE	TYPE
1	P001	UTILITY SERVICE	EXISTING UTILITY TRANSFORMER	DISCONNECT SWITCH "DISC-100"	2"	PVC
2	P004	EVLP-1-1,3	LOAD CENTER PANEL "EVLP-1"	VAULT LIGHTING & RECEPTACLES	1"	PVC

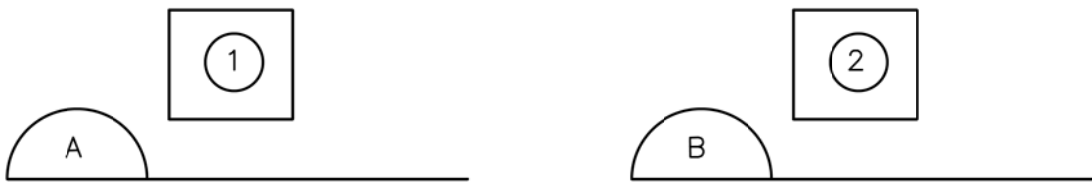


- NOTES:
- ALL UTILITIES SHOWN ARE APPROXIMATE. CONTRACTOR SHALL OBTAIN PUBLIC AND PRIVATE UTILITY LOCATES TO VERIFY UTILITY LOCATIONS. POTHOLE ALL UTILITY CROSSINGS PRIOR TO CONSTRUCTION.
  - CONTRACTOR SHALL ROUTE CONDUITS TO BEST SUIT FIELD CONDITIONS. CONTRACTOR SHALL PROVIDE HAND HOLES AND JUNCTION BOXES AS REQUIRED FOR A COMPLETE INSTALLATION.
  - CONTRACTOR SHALL BE RESPONSIBLE FOR RETURNING EXISTING LANDSCAPING AFFECTED BY WORK BACK TO ORIGINAL CONDITION.
  - DIRECT BURIED CONDUIT ROUTING IS DIAGRAMTIC. CONTRACTOR SHALL ROUTE CONDUITS TO BEST SUITE FIELD CONDITIONS AND ROUTE CONDUITS WITHIN ANY EXISTING UTILITY EASEMENTS.

REVISIONS		Description	By	Date
	ISSUED FOR BID	8/27/18	RL	
	ISSUED FOR CONSTRUCTION	9/2/2018	RL	
	AS-BUILT	7/9/2019	RL	

DESIGNED: RL

CHECKED: TMR

DRAWN: RL

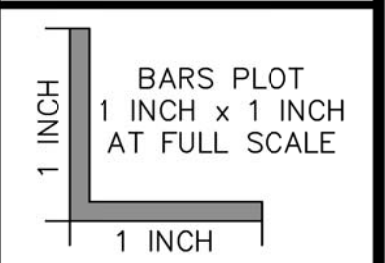

ROXBOROUGH WATER AND SANITATION DISTRICT  
RAVENNA PHASE II WATER CONNECTION INFRASTRUCTURE  
EAST VAULT ELECTRICAL SITE PLAN

**MAGNA**  
96 INVERNESS DRIVE EAST  
UNIT R  
ENGLEWOOD, CO 80112  
(303) 799-1273



DATE: JUNE 2018


JOB NO: 001.335.01

RWSD


DRAWING NO.

E6

W:\T4104\T4104-15\10 DRAWINGS\03\_WIP\E7\_NORTH VAULT PLAN\_RL\_REV5.dwg, E7, 8/1/2019 7:58 AM

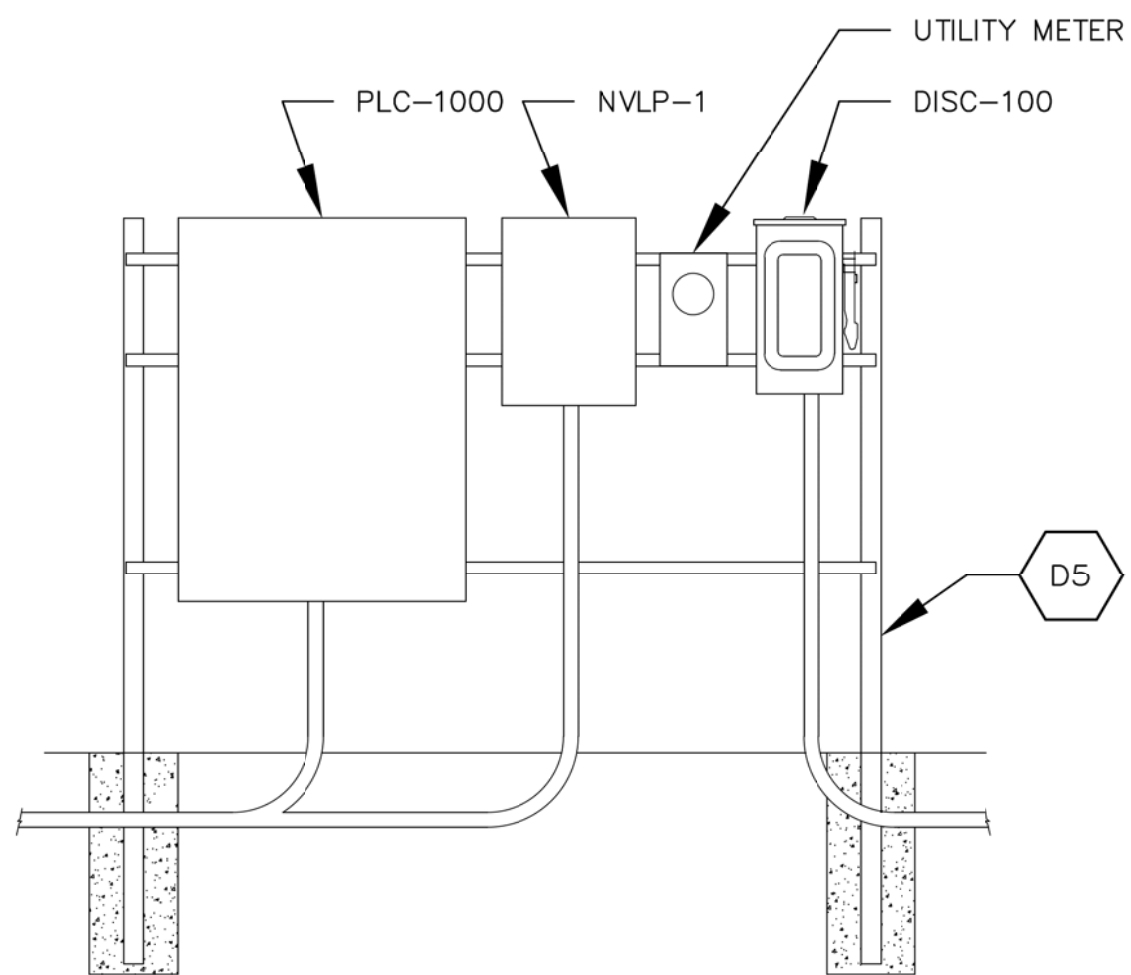

NORTH VAULT EQUIPMENT RACK DETAIL  
SCALE: NTS

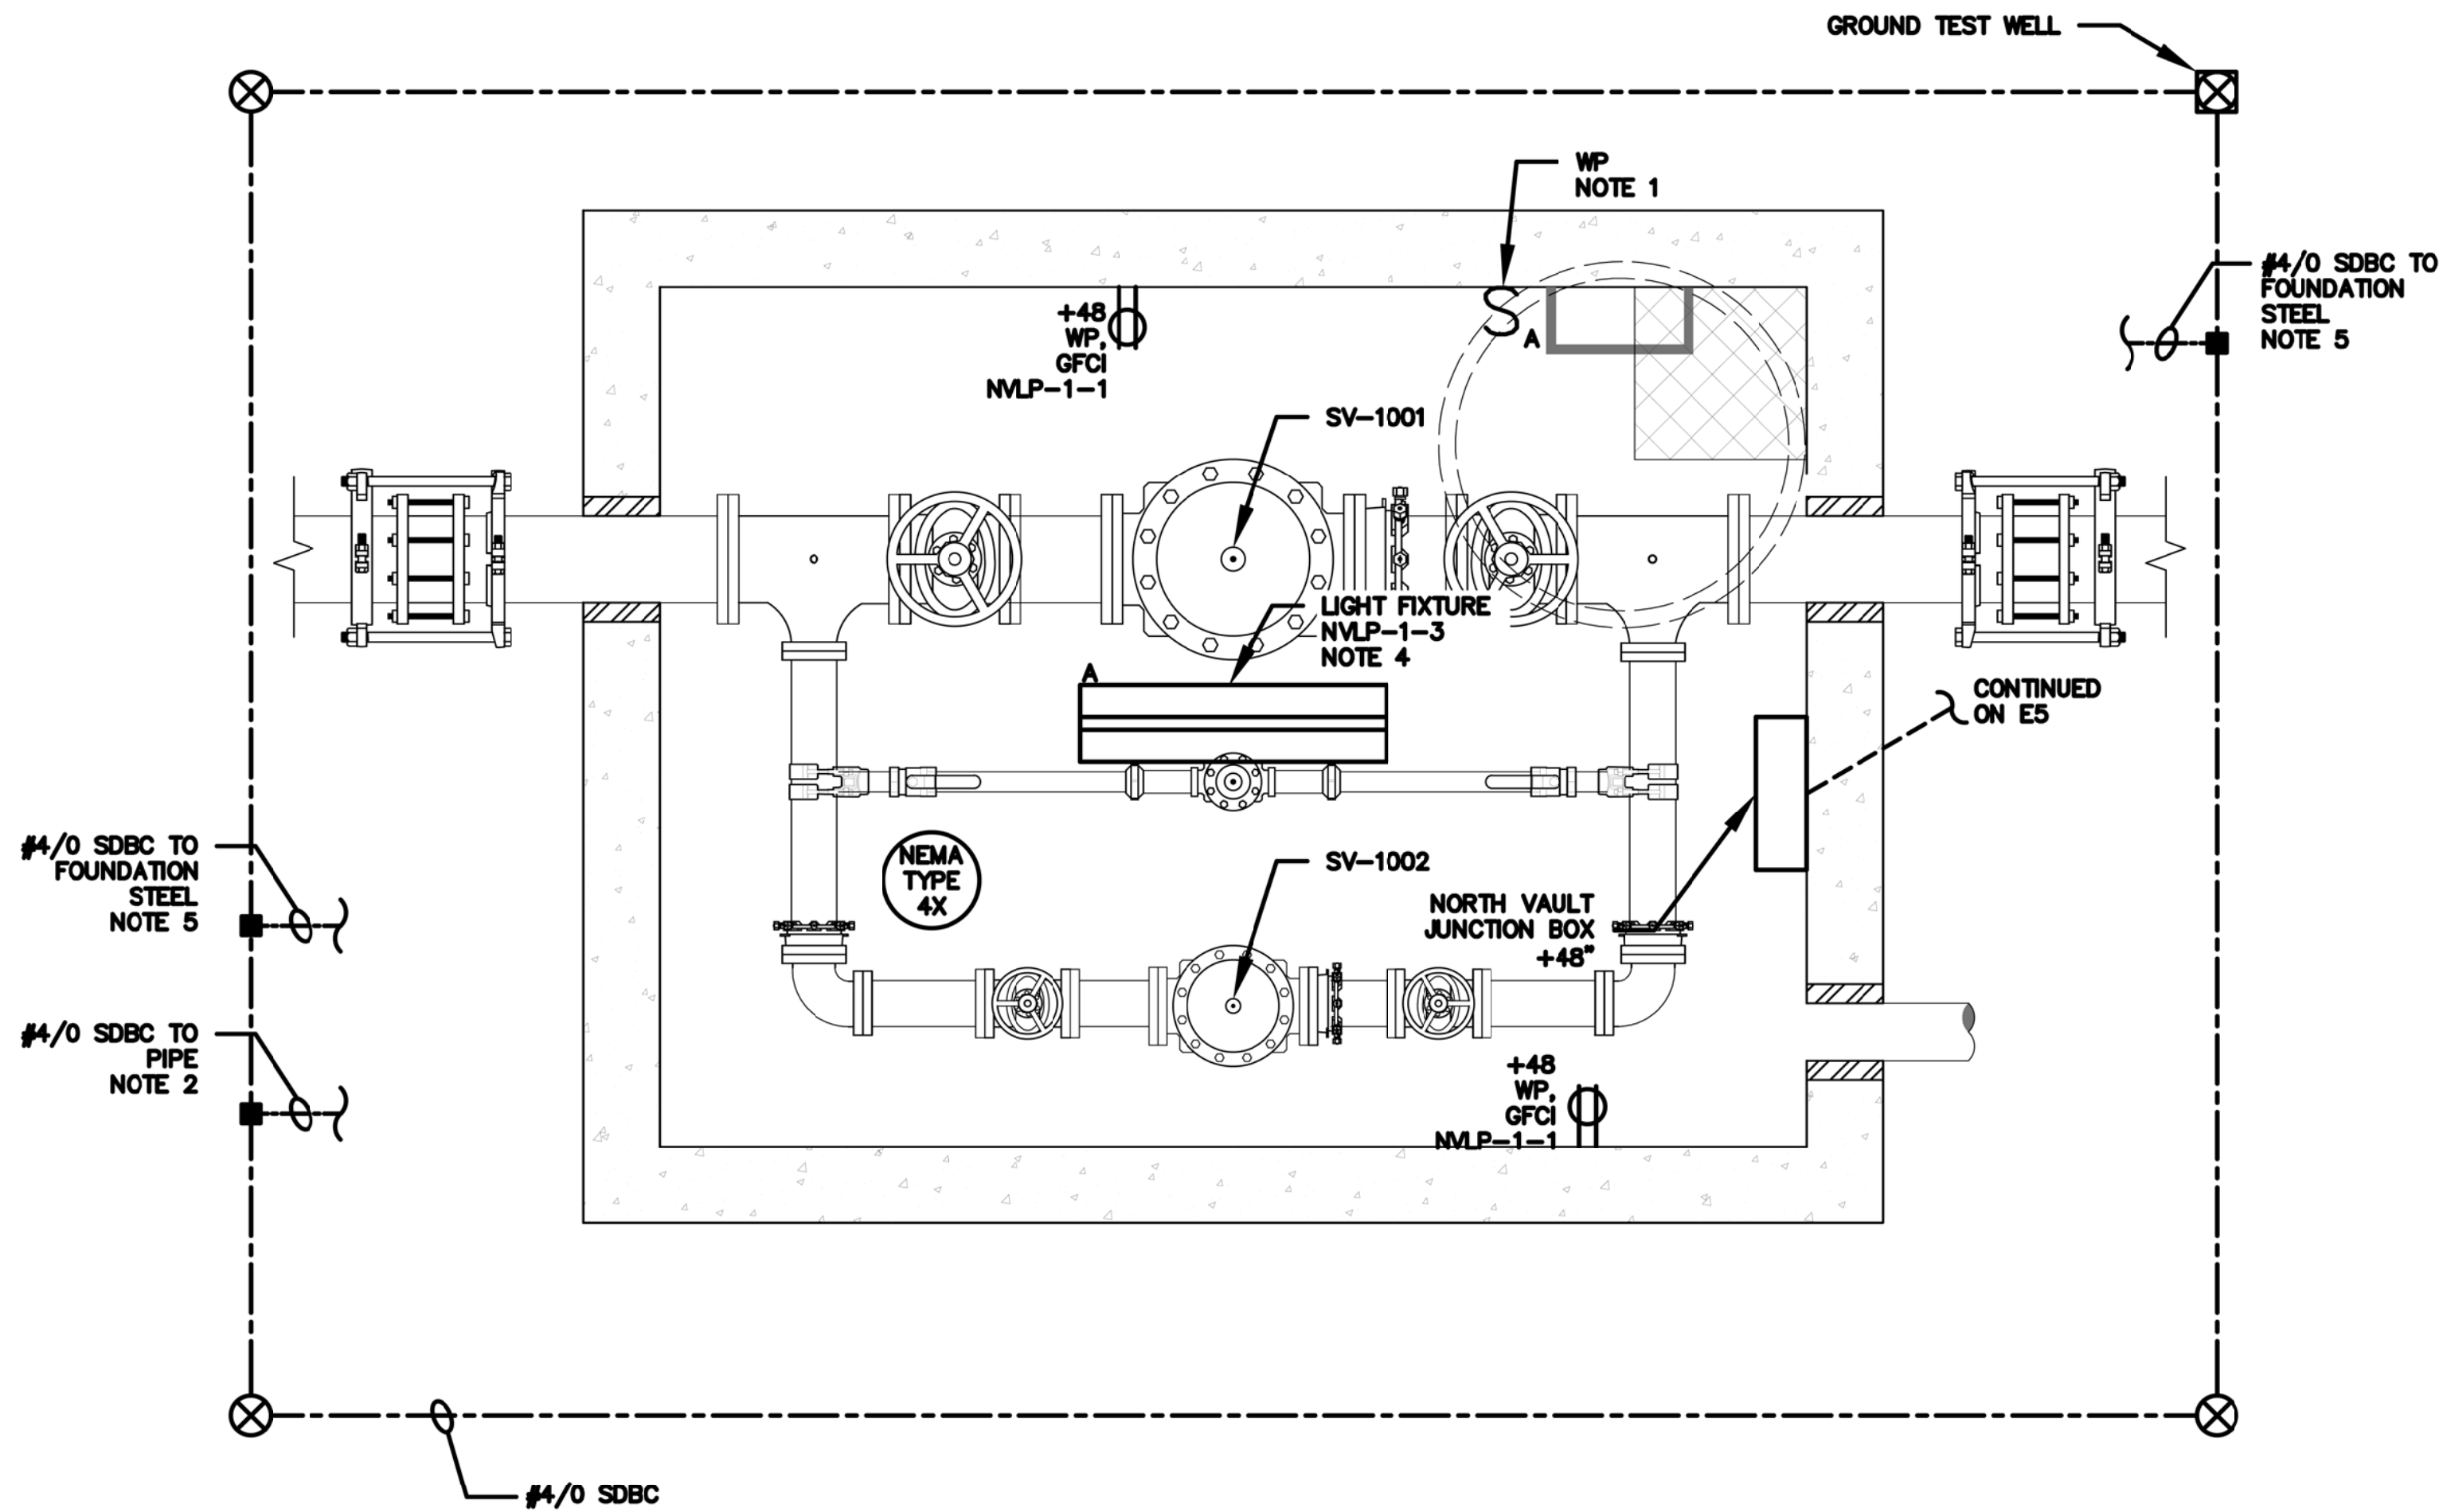

NORTH VAULT PLAN  
SCALE: 3/4" = 1'-0"

NOTES:

1. CONTRACTOR SHALL MOUNT SWITCH WITHIN ARMS REACH OF HATCH OPENING.
2. CONTRACTOR SHALL GROUND PIPE ON THE ISOLATED SIDE OF ANY CATHODIC PROTECTION.
3. CONTRACTOR SHALL PROVIDE A 20"H X 16"W X 6"D MINIMUM JUNCTION BOX TO SUIT INCOMING CABLES AND PROVIDE ALLEN-BRADLEY 1492-J6 TERMINAL BLOCKS OR EQUIVALENT REQUIRED FOR INTERCONNECTIONS. TERMINAL BLOCKS SHALL BE ARRANGED IN JUNCTION BOX TO PROVIDE ADEQUATE VOLTAGE SEGREGATION OF CONTROL SIGNALS. JUNCTION BOXES SHALL BE NEMA TYPE 4X 316 STAINLESS STEEL ENCLOSURES.
4. SURFACE MOUNT LIGHT FIXTURE, LINEAR LED LOW BAY FIXTURE, 29W, 120V LED LITHONIA LIGHTING MSL 4000LM L/LV MVOLT GZ10 35K 80CRI OR EQUIVALENT.
5. PRECAST VAULT SHALL HAVE PROVISIONS FOR TWO GROUND CONNECTIONS TO FOUNDATION STEEL AS SHOWN.

ROXBOROUGH WATER AND SANITATION DISTRICT  
RAVENNA PHASE II WATER CONNECTION INFRASTRUCTURE

NORTH VAULT ELECTRICAL PLAN


**MAGNA**  
96 INVERNESS DRIVE EAST  
UNIT R  
ENGLEWOOD, CO 80112  
(303) 799-1273




DATE: JUNE 2018  
JOB NO: 001.335.01  
RWSO

E7

W:\T4104\T4104-15\10 DRAWINGS\03\_WIP\E8\_EAST VAULT PLAN\_RL\_REV.dwg, E8, 8/1/2019 7:58 AM

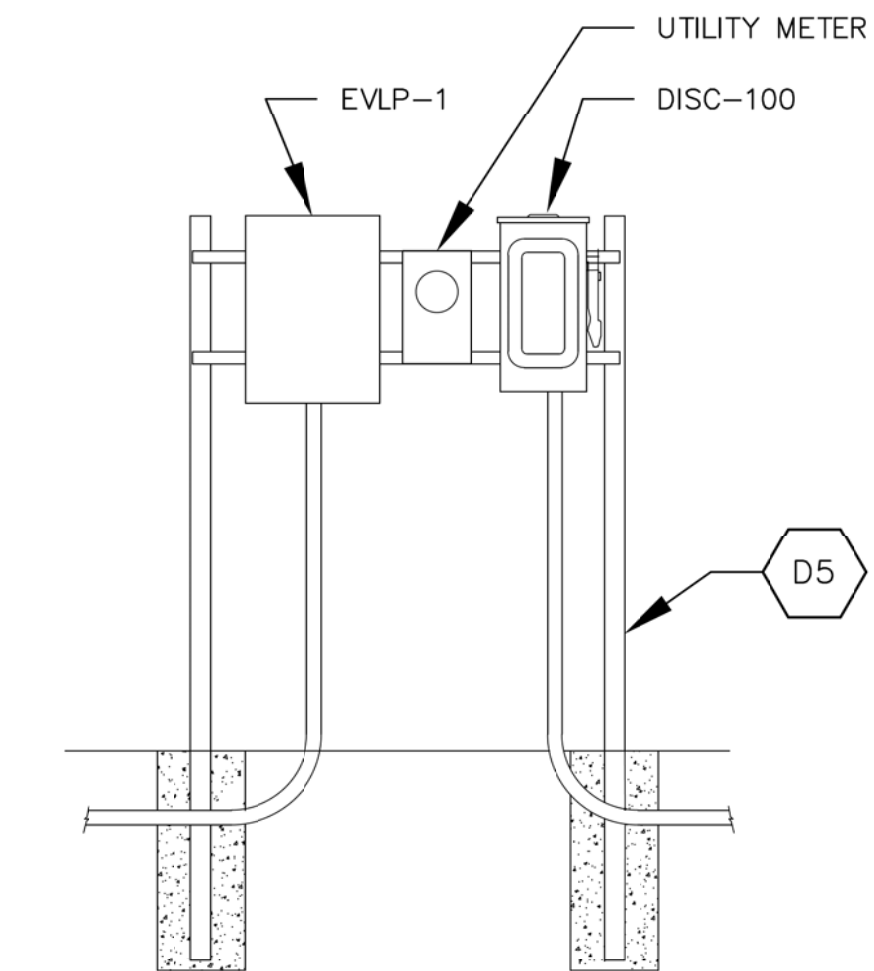

EAST VAULT EQUIPMENT RACK DETAIL  
SCALE: NTS

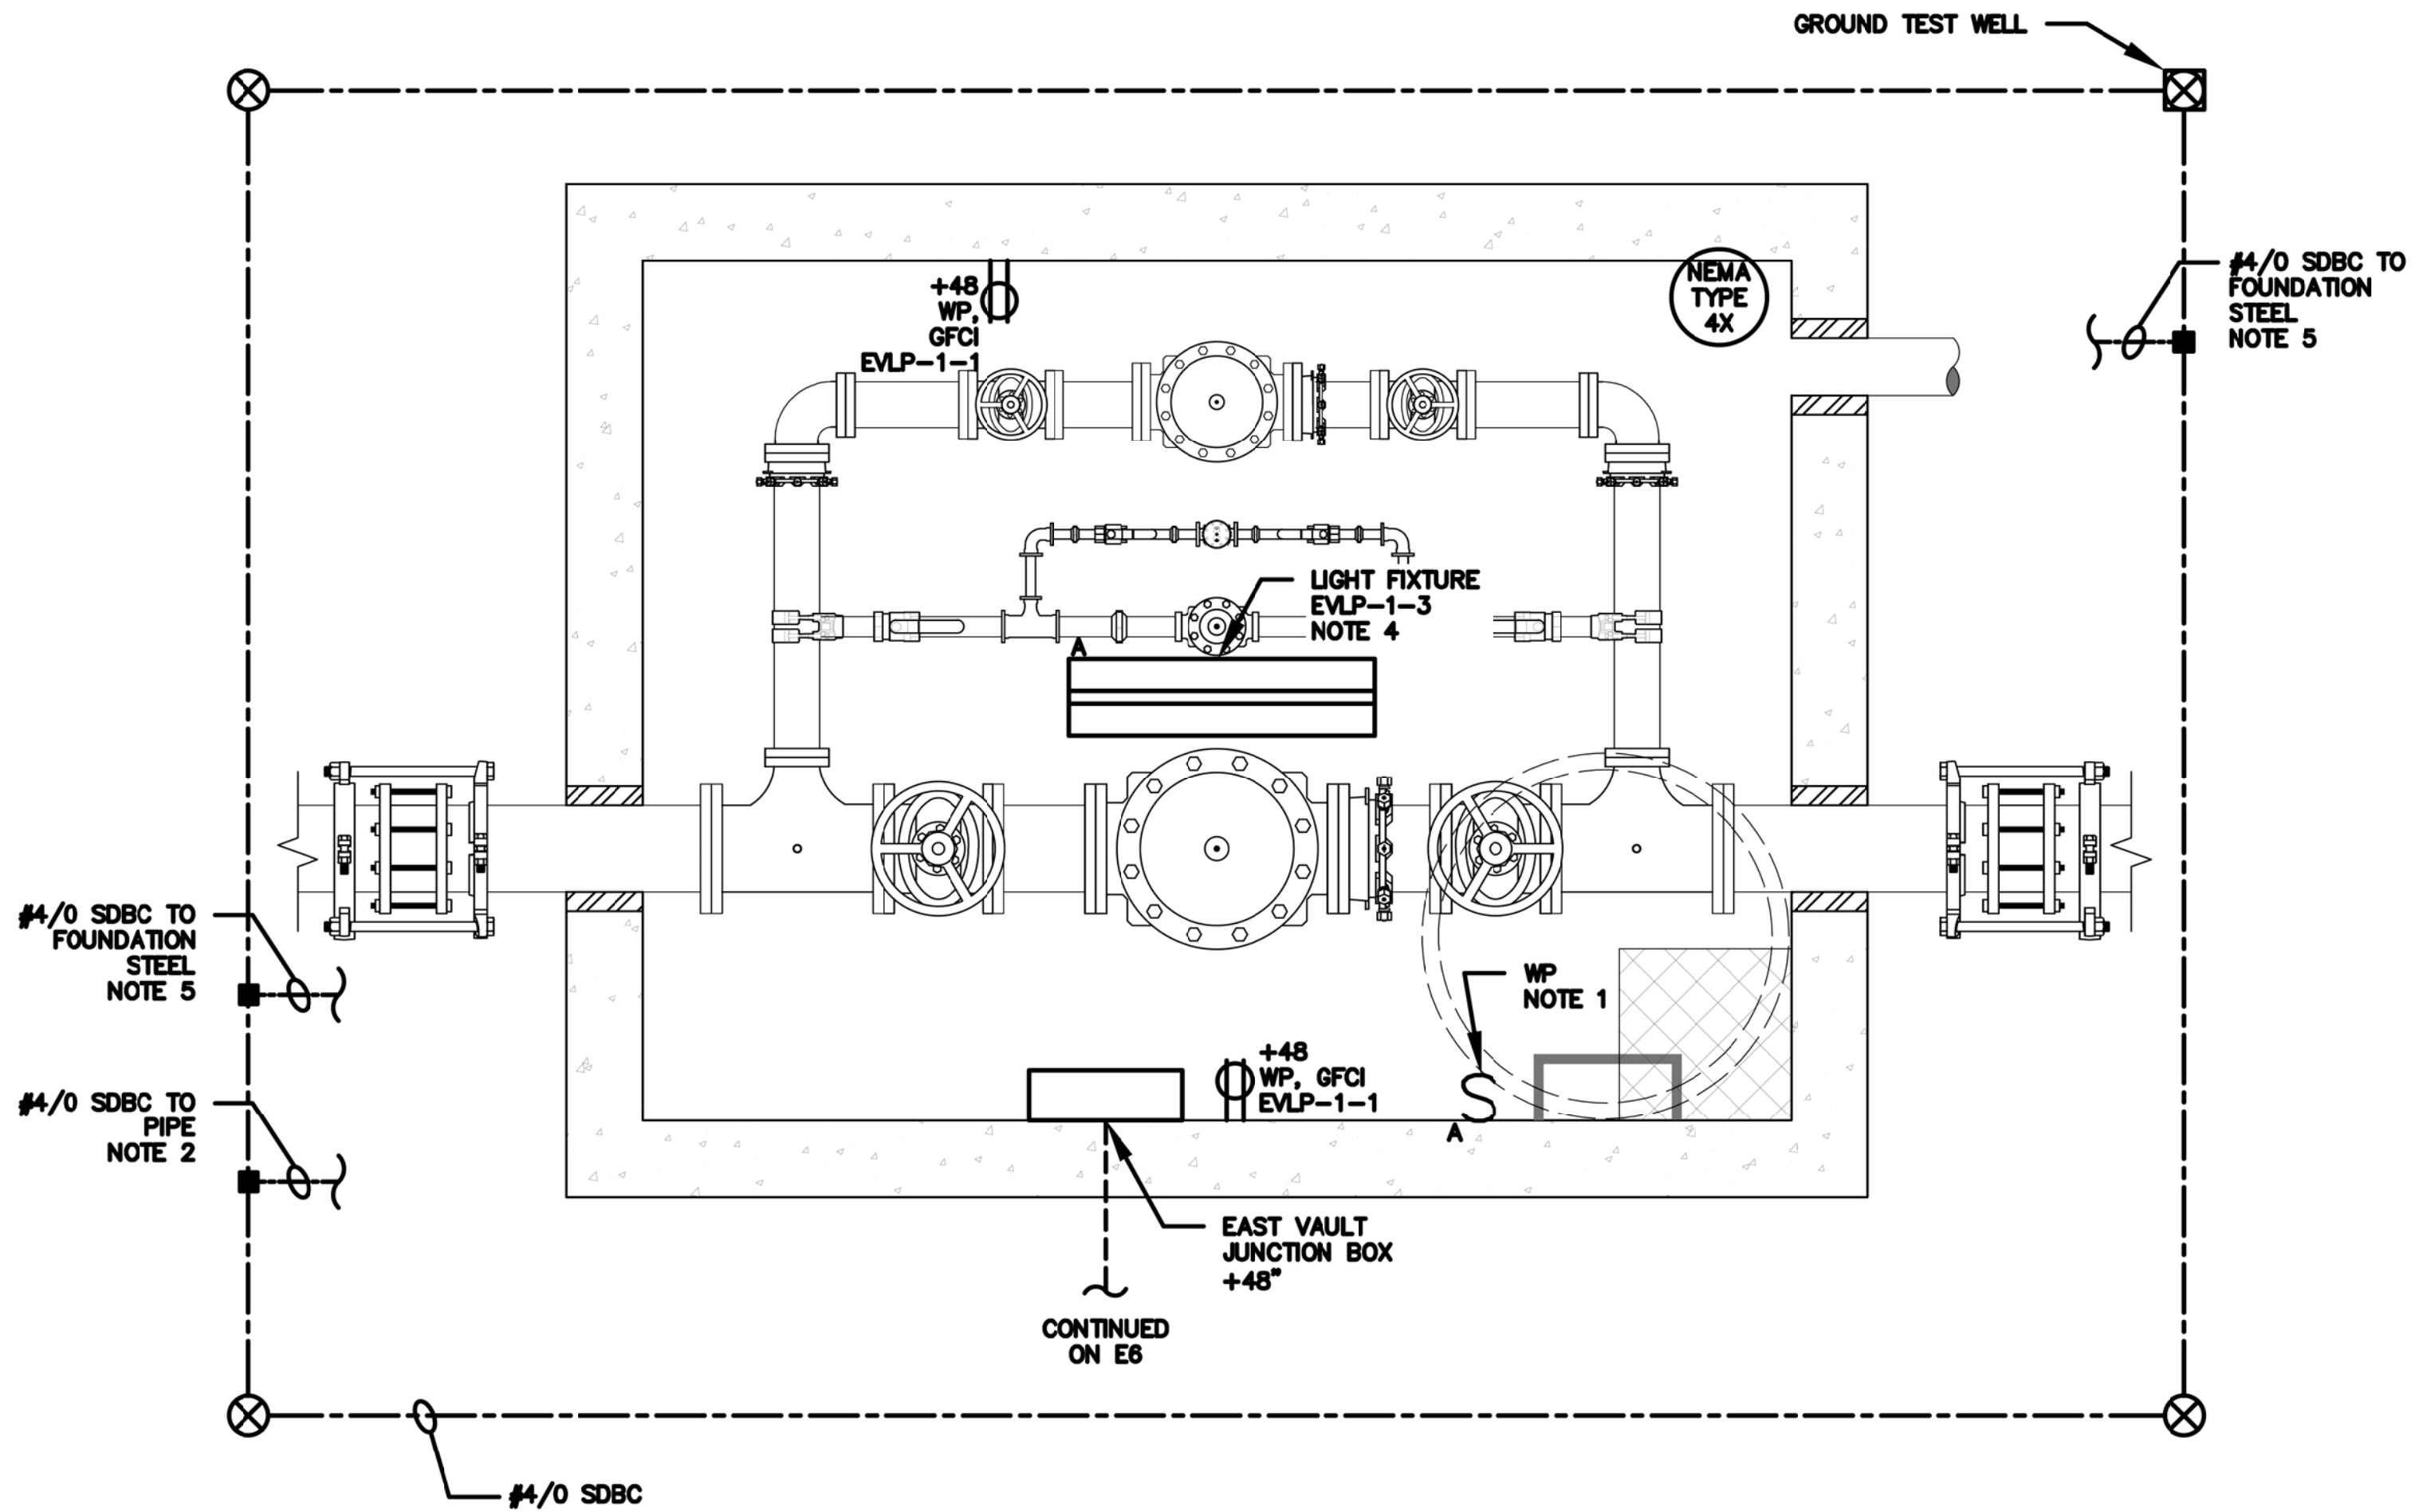

EAST VAULT PLAN  
SCALE: 3/4" = 1'-0"

NOTES:

1. CONTRACTOR SHALL MOUNT SWITCH WITHIN ARMS REACH OF HATCH OPENING.
2. CONTRACTOR SHALL GROUND PIPE ON THE ISOLATED SIDE OF ANY CATHODIC PROTECTION.
3. CONTRACTOR SHALL PROVIDE A 20"H X 16"W X 6"D MINIMUM JUNCTION BOX TO SUIT INCOMING CABLES AND PROVIDE ALLEN-BRADLEY 1492-J6 TERMINAL BLOCKS OR EQUIVALENT REQUIRED FOR INTERCONNECTIONS. TERMINAL BLOCKS SHALL BE ARRANGED IN JUNCTION BOX TO PROVIDE ADEQUATE VOLTAGE SEGREGATION OF CONTROL SIGNALS. JUNCTION BOXES SHALL BE NEMA TYPE 4X 316 STAINLESS STEEL ENCLOSURES.
4. SURFACE MOUNT LIGHT FIXTURE, LINEAR LED LOW BAY FIXTURE, 29W, 120V LED LITHONIA LIGHTING MSL 4000LM L/LV MVOLT GZ10 35K 80CRI OR EQUIVALENT.
5. PRECAST VAULT SHALL HAVE PROVISIONS FOR TWO GROUND CONNECTIONS TO FOUNDATION STEEL AS SHOWN.


ROXBOROUGH WATER AND SANITATION DISTRICT  
RAVENNA PHASE II WATER CONNECTION INFRASTRUCTURE

EAST VAULT ELECTRICAL PLAN



DATE: JUNE 2018  
JOB NO: 001.335.01  
DRAWING NO: RWSD

E8

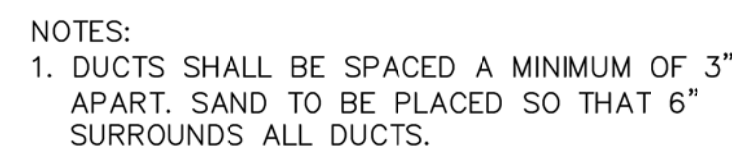

TOP SURFACE CONSISTING OF GRAVEL/ASPHALT OR TOPSOIL AS REQUIRED FINISHED GRADE

MARKER TAPE

SLOPE ACCORDING TO OCCUPATIONAL HEALTH AND SAFETY REGULATIONS AND AS REQUIRED TO FACILITATE INSTALLATION

NATIVE BACKFILL, COMPACTED TO 98% SPD

#5 BARS @ 8" MAX SPACING

3500 PSI CONCRETE WITH RED DIE.

PLASTIC DUCT SPACERS (TYP)

#3 U BARS @ 12", T&B LAP 16"

UNDISTURBED SOIL

3'-0"

6"

1"

6"

3"

6"

3"

3"

NOTES (DUCTBANK):

- NOTES (DUCTBANK):**
1. THIS DETAIL IS TYPICAL AND IDENTIFIES THE SPECIFIC CONSTRUCTION OF ALL CONCRETE DUCTBANKS.
  2. REFER TO OTHER DRAWINGS (PLANS AND SCHEDULES) FOR SIZE AND QUANTITY OF DUCTS.
  3. AS BEST AS PRACTICAL, SLOPE DUCTBANKS TO MANHOLES TO PROMOTE DRAINAGE.
  4. INSTALL REINFORCING ONLY WHERE SPECIFIED OR INDICATED ON DRAWINGS.

STAINLESS STEEL SUPPORT CHANNEL  
ATTACH TO WALL OR SUPPORT MEMBERS  
WITH EXPANDABLE ANCHORS, MACHINE  
BOLTS AT OTHER LOCATIONS

CONDUITS

(TYPICAL FOR  
PENETRATION

USE MANUFACTURED  
CONDUIT STRAPS FOR  
ATTACHING CONDUITS

WALL OR SUPPORT  
MEMBER BOLTS

CONDUIT

CONDUIT  
STRAP

SEAL CO

- NOTES:
1. CONDUITS SHALL BE MOUNTED TO BEST SUITE FIELD CONDITIONS.
  2. USED IN AREAS WHERE TWO OR MORE CONDUITS RUN PARALLEL.

PORT CHANNEL  
SUPPORT MEMBERS  
BRACKETS, MACHINES  
FUNCTIONS

FINISHED GRADE

EXTERIOR WALL

CLEAN COMPACTED SAND

JUNCTION BOX  
(TYPICAL FOR ALL DUCTBANK  
PENETRATIONS, SIZED PER  
NEC)

PVC-RGS CONDUIT

SEAL CONDUIT ENTRANCE WITH  
NON-SHRINK GROUT  
(NOTE 1)

EXPANSION/DEFLECTION FITTING  
SUITABLE FOR DIRECT-BURY  
(THOMAS & BETTS OR EQUAL)

NOTES (ENTRANCE DETAIL):  
1. CAULK ALL CONCRETE SURFACES IN OPENING AND

- NOTES (ENTRANCE DETAIL):  
1. CAULK ALL CONCRETE SURFACES IN OPENING AND AROUND EACH CONDUIT WITH A HYDROSTATIC WATER STOP (ADEKA P-201 OR EQUAL) AT  $\frac{1}{2}$ " WALL PRIOR TO GROUTING.

5'-0" MAXIMUM

ENCLOSURE

ADJUST SEPARATION TO FIT WIDTH OF ENCLOSURE

STAINLESS STEEL UNISTRUT

CONDUIT

CONDUIT STRAP

STAINLESS STEEL CHANNEL BASE

4" MIN

$\phi 1/4"$

5/8" STAINLESS STEEL PLATE SHIM AND PLUMB. PROVIDE LEVELING NUTS.

1" (MIN) NON-SHRINK GROUT

LEVELING NUTS

1/2" x 5" STAINLESS STEEL EXPANSION BOLT WITH NUTS AND WASHERS (4 REQUIRED)

CONCRETE 15" DIA

30" BELOW FINISHED GRADE

Diagram illustrating the assembly for a wall penetration, showing the connection between an electrical equipment enclosure and a concrete wall. The assembly includes:

- ELECTRICAL EQUIPMENT ENCLOSURE
- FLAT WASHERS
- STAINLESS STEEL MACHINE BOLT  $3/8"$ -16 X  $3/4"$
- STAINLESS STEEL  $3/8"$  X  $16$  X  $1"$  MACHINE BOLT
- CONCRETE ANCHOR  $3/8"$ -16
- STAINLESS STEEL (1-5/9" X 1-5/9") CHANNEL
- SPRING NUTS


- NOTES:  
1. POLYMER CONCRETE FRAME AND NON-SKID COVER FOR STRENGTH. FLARED AT BASE TO PROVIDE ADDITIONAL WORK SPACE.

DESIGNED: *RL*

CHECKED: *TMR*




DRAWN: *RL*

# ROXBOROUGH WATER AND SANITATION DISTRICT RAVENNA PHASE II WATER CONNECTION INFRASTRUCTURE ELECTRICAL GENERAL DETAILS

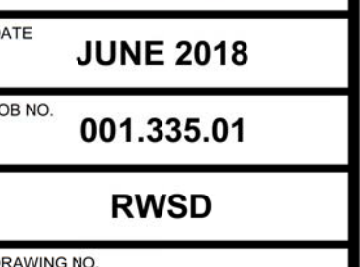

# E9

W:\T4104\T4104-15\10 DRAWINGS\03\_WIP\11\_EMERGENCY INTERCONNECT PLC POWER DIST\_RL\_REVA.dwg, 11, 8/1/2019 7:58 AM

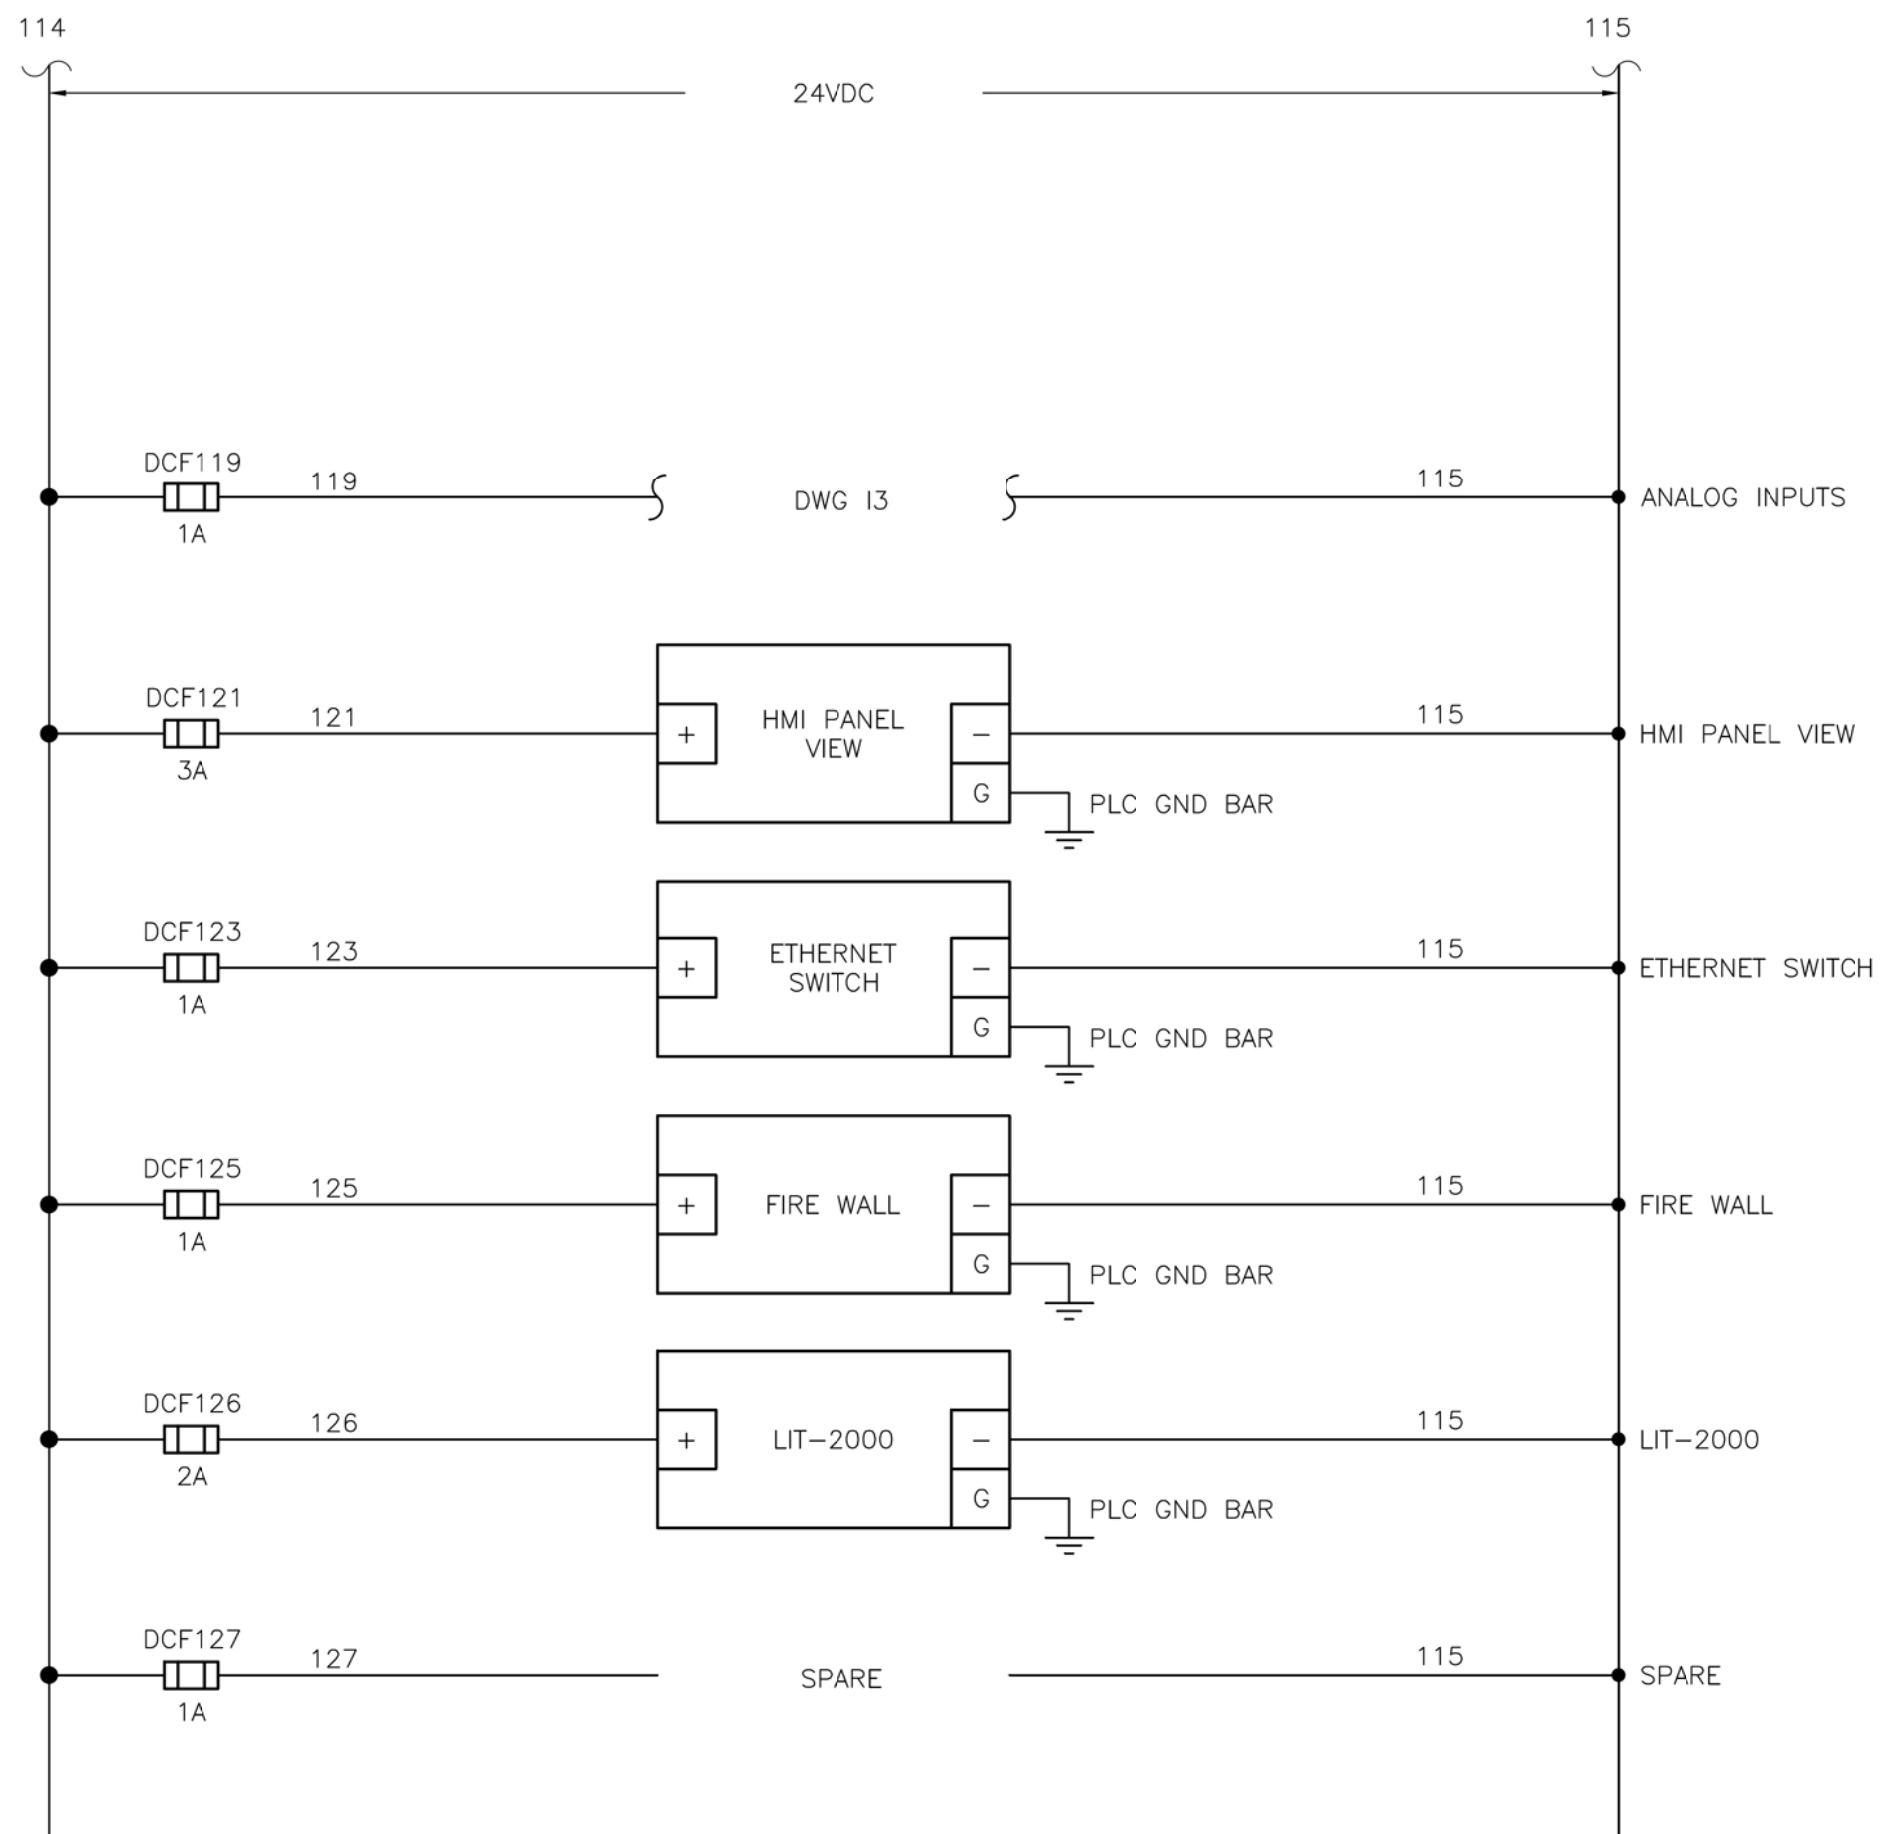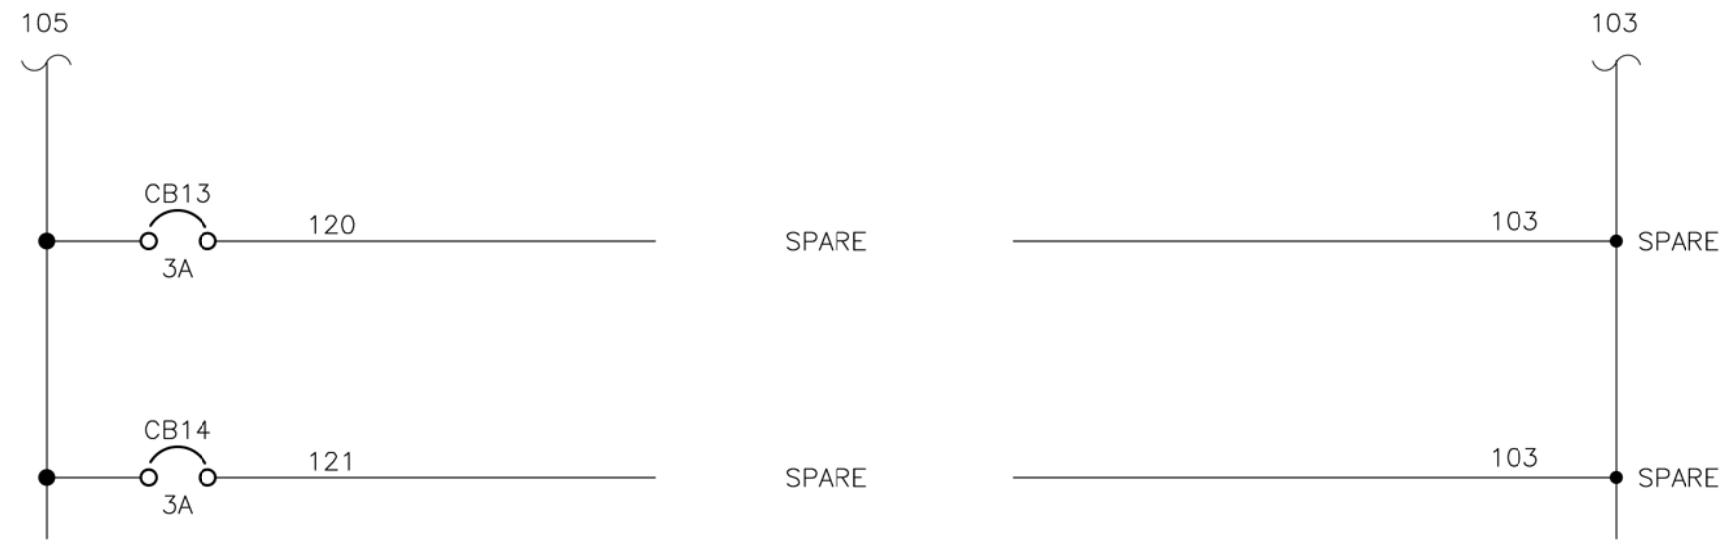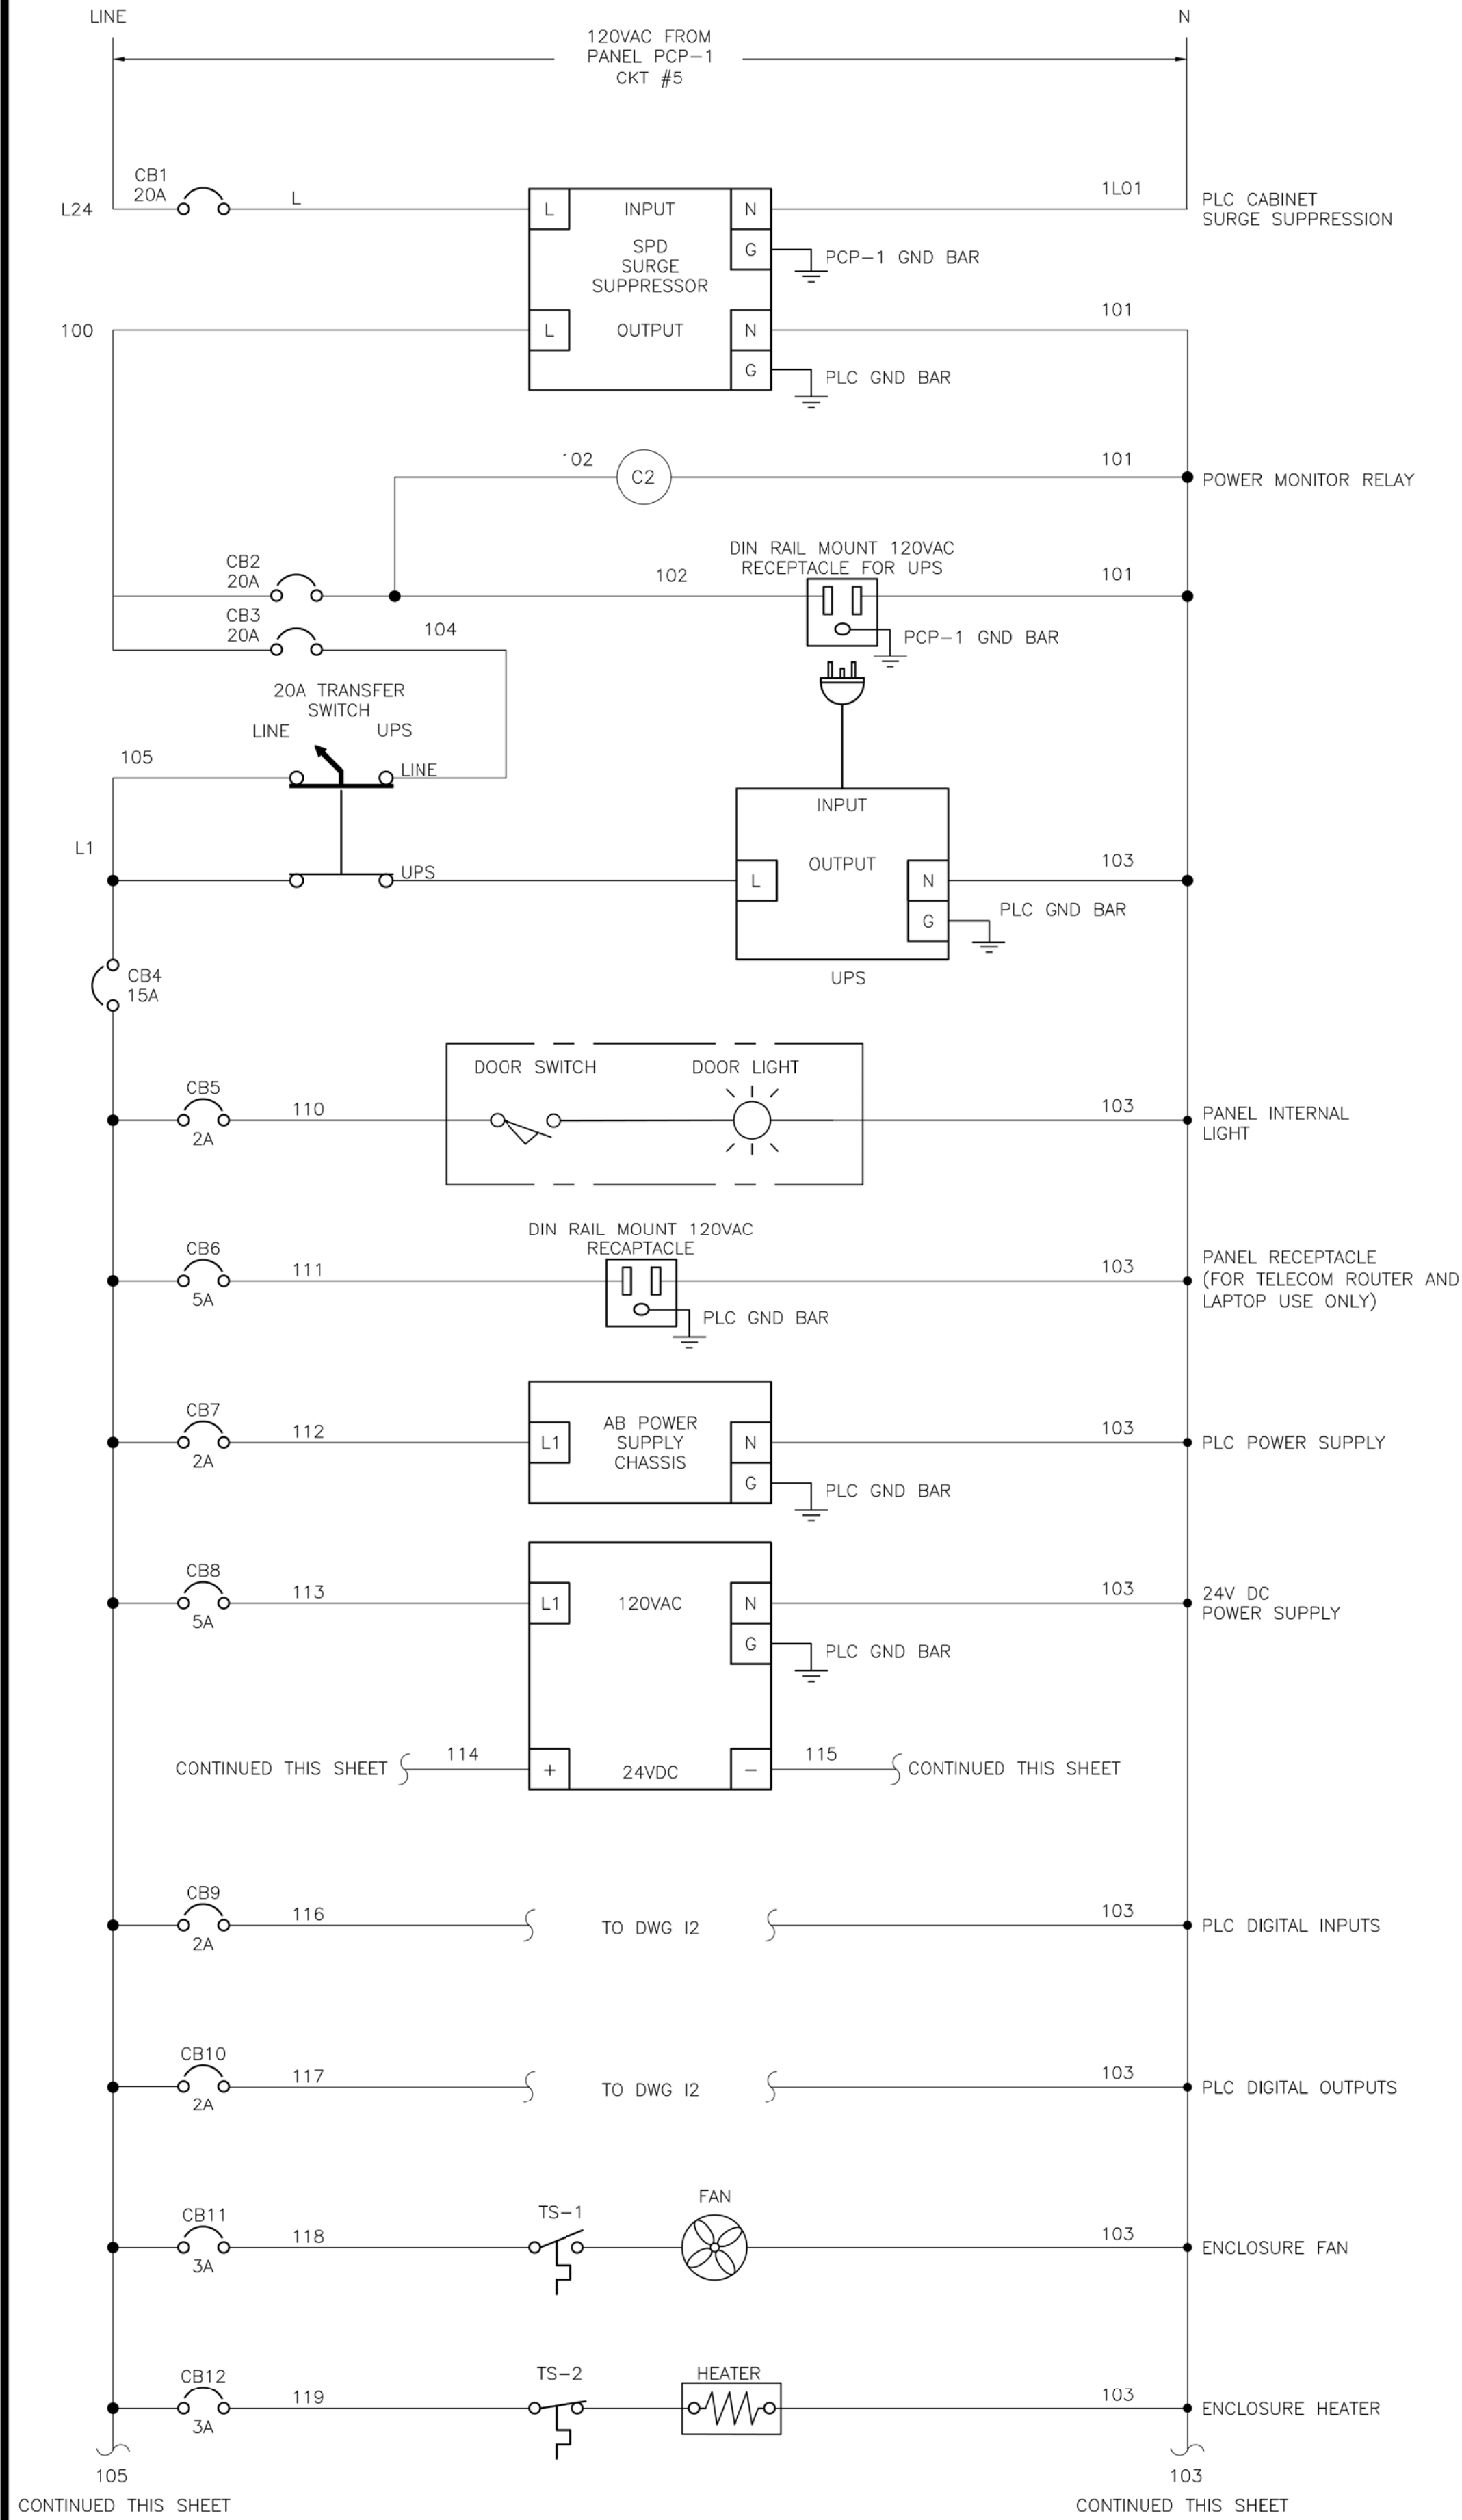

NOTES:  
1. SCHEMATICS SHOWN FOR GENERAL INTENT ONLY.  
CONTRACTOR SHALL DESIGN SCHEMATICS TO  
MATCH INTENT OF INSTALLED INSTRUMENTS AND  
DEVICES.

REVISIONS	
Rev	Description
1	ISSUED FOR BID
2	ISSUED FOR CONSTRUCTION
3	AS-BUILT

By	Rev	Date
RL	1	8/2/18
RL	2	9/2/2018
RL	3	7/9/2019

DESIGNED: **RL**  
CHECKED: **TMR**  
DRAWN: **RL**


1 INCH  
1 INCH x 1 INCH  
AT FULL SCALE  
1 INCH

**ROXBOROUGH WATER AND SANITATION DISTRICT**  
**RAVENNA PHASE II WATER CONNECTION INFRASTRUCTURE**  
**EMERGENCY INTERCONNECT PLC POWER DISTRIBUTION**


**MAGNA**  
96 INVERNESS DRIVE EAST  
UNIT R  
ENGLEWOOD, CO 80112  
(303) 799-1273

DATE: **JUNE 2018**  
JOB NO.: **001.335.01**  
DRAWING NO.: **RWSD**

**11**

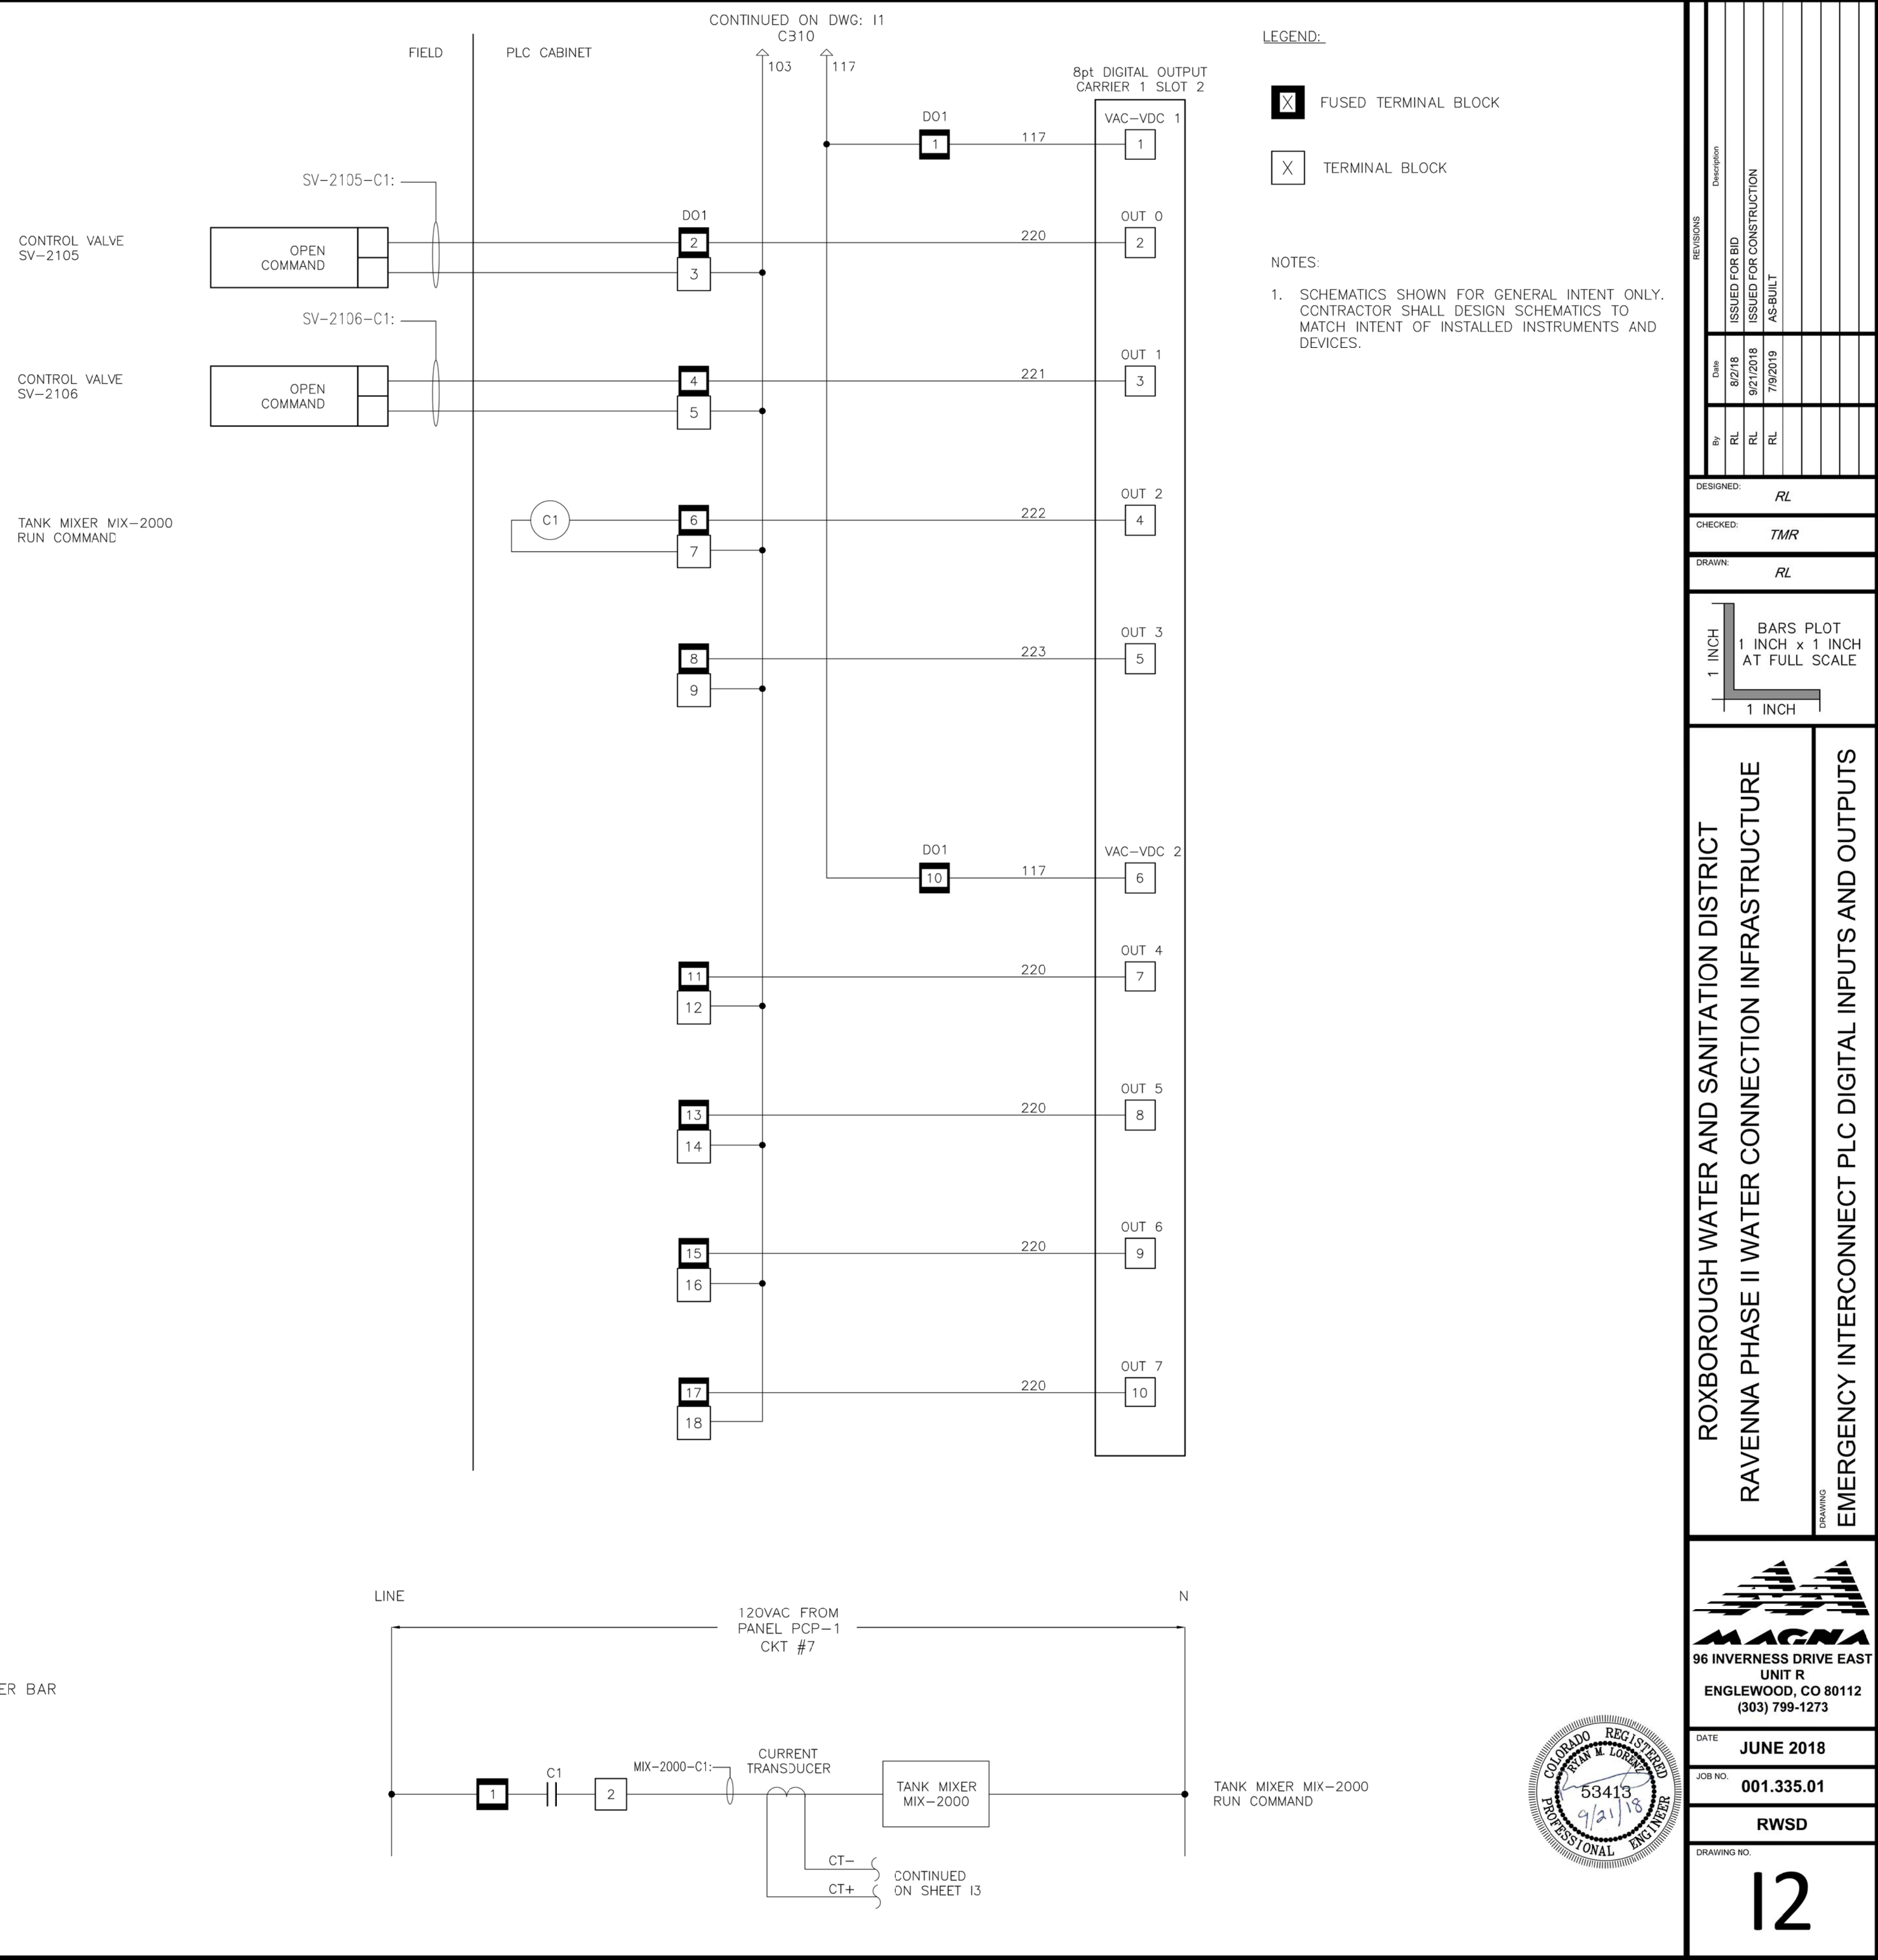

W:\T4104\T4104-15\10 DRAWINGS\03\_WIP\13\_EMERGENCY INTECONNECT PLC ANALOG INPUTS\_RL\_REVA.dwg, 13, 8/1/2019 7:59 AM

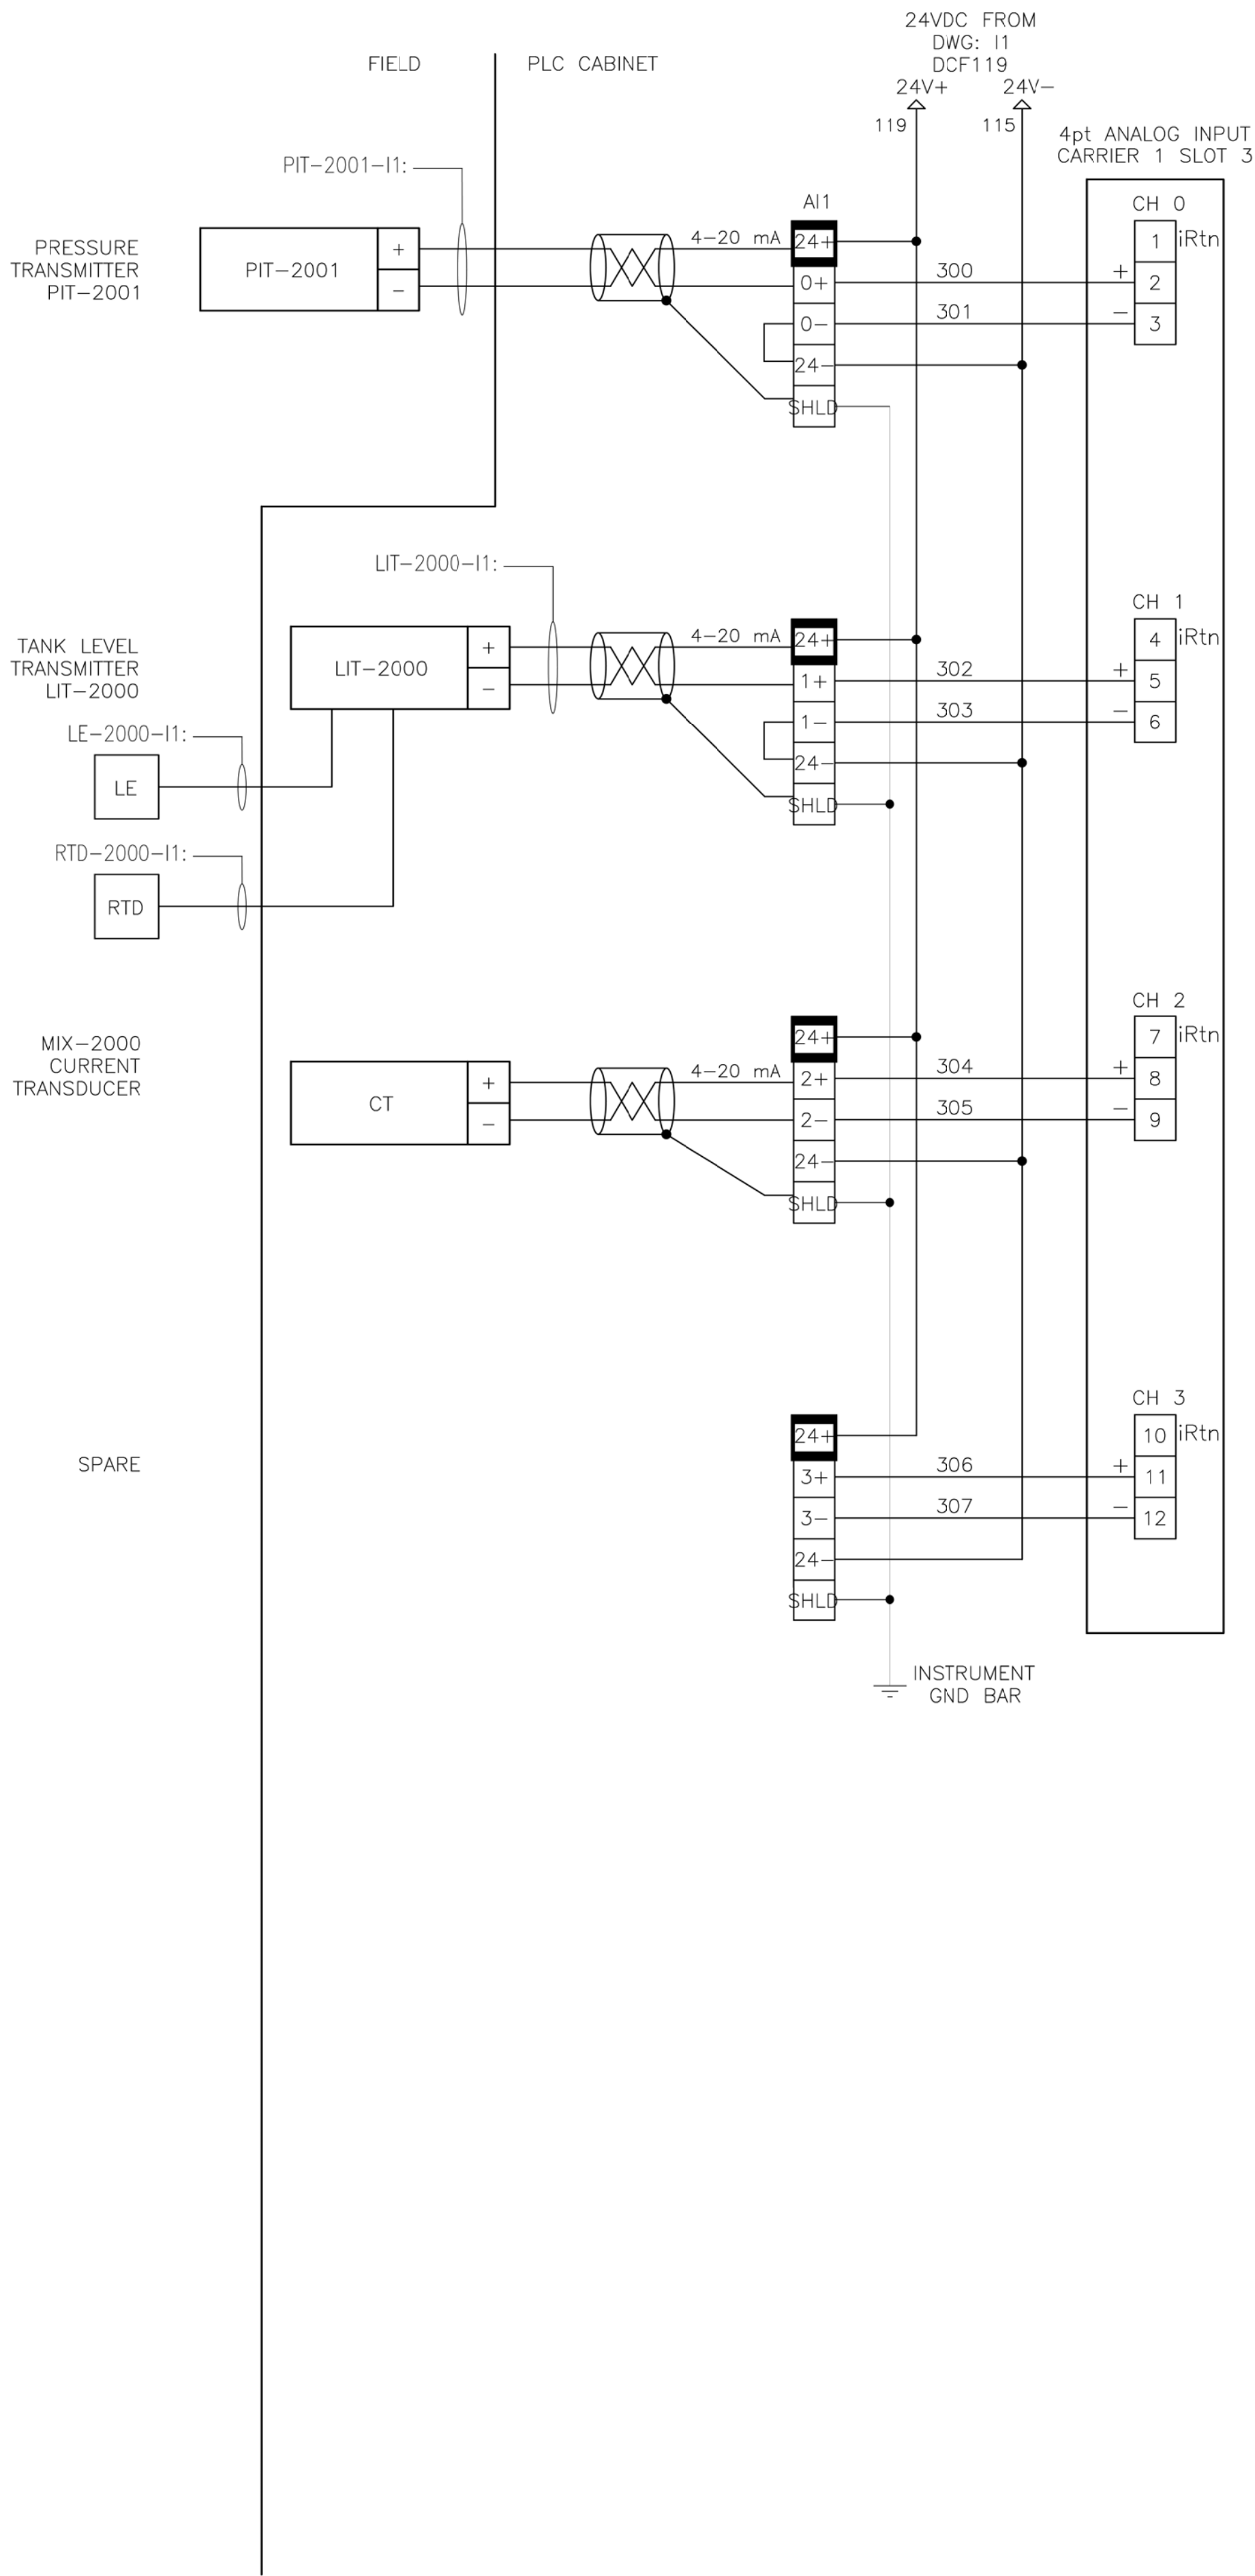

LEGEND:

 FUSED TERMINAL BLOCK

 TERMINAL BLOCK

NOTES:

- SHIELD WIRES TO BE CONNECTED TO GROUND AT PANEL. DEVICE SIDE SHALL BE ISOLATED.
- SCHEMATICS SHOWN FOR GENERAL INTENT ONLY. CONTRACTOR SHALL DESIGN SCHEMATICS TO MATCH INTENT OF INSTALLED INSTRUMENTS AND DEVICES.

ROXBOROUGH WATER AND SANITATION DISTRICT  
RAVENNA PHASE II WATER CONNECTION INFRASTRUCTURE

EMERGENCY INTERCONNECT PLC ANALOG INPUTS

  
96 INVERNESS DRIVE EAST  
UNIT R  
ENGLEWOOD, CO 80112  
(303) 799-1273

DATE  
JUNE 2018

JOB NO.  
001.335.01




RWSD

DRAWING NO.

13



W:\T4104\T4104-15\10 DRAWINGS\03\_WIP\14\_EMERGENCY INTERCONNECT PLC PANEL LAYOUT\_RL\_REV4.dwg, 14, 8/1/2019 7:59 AM

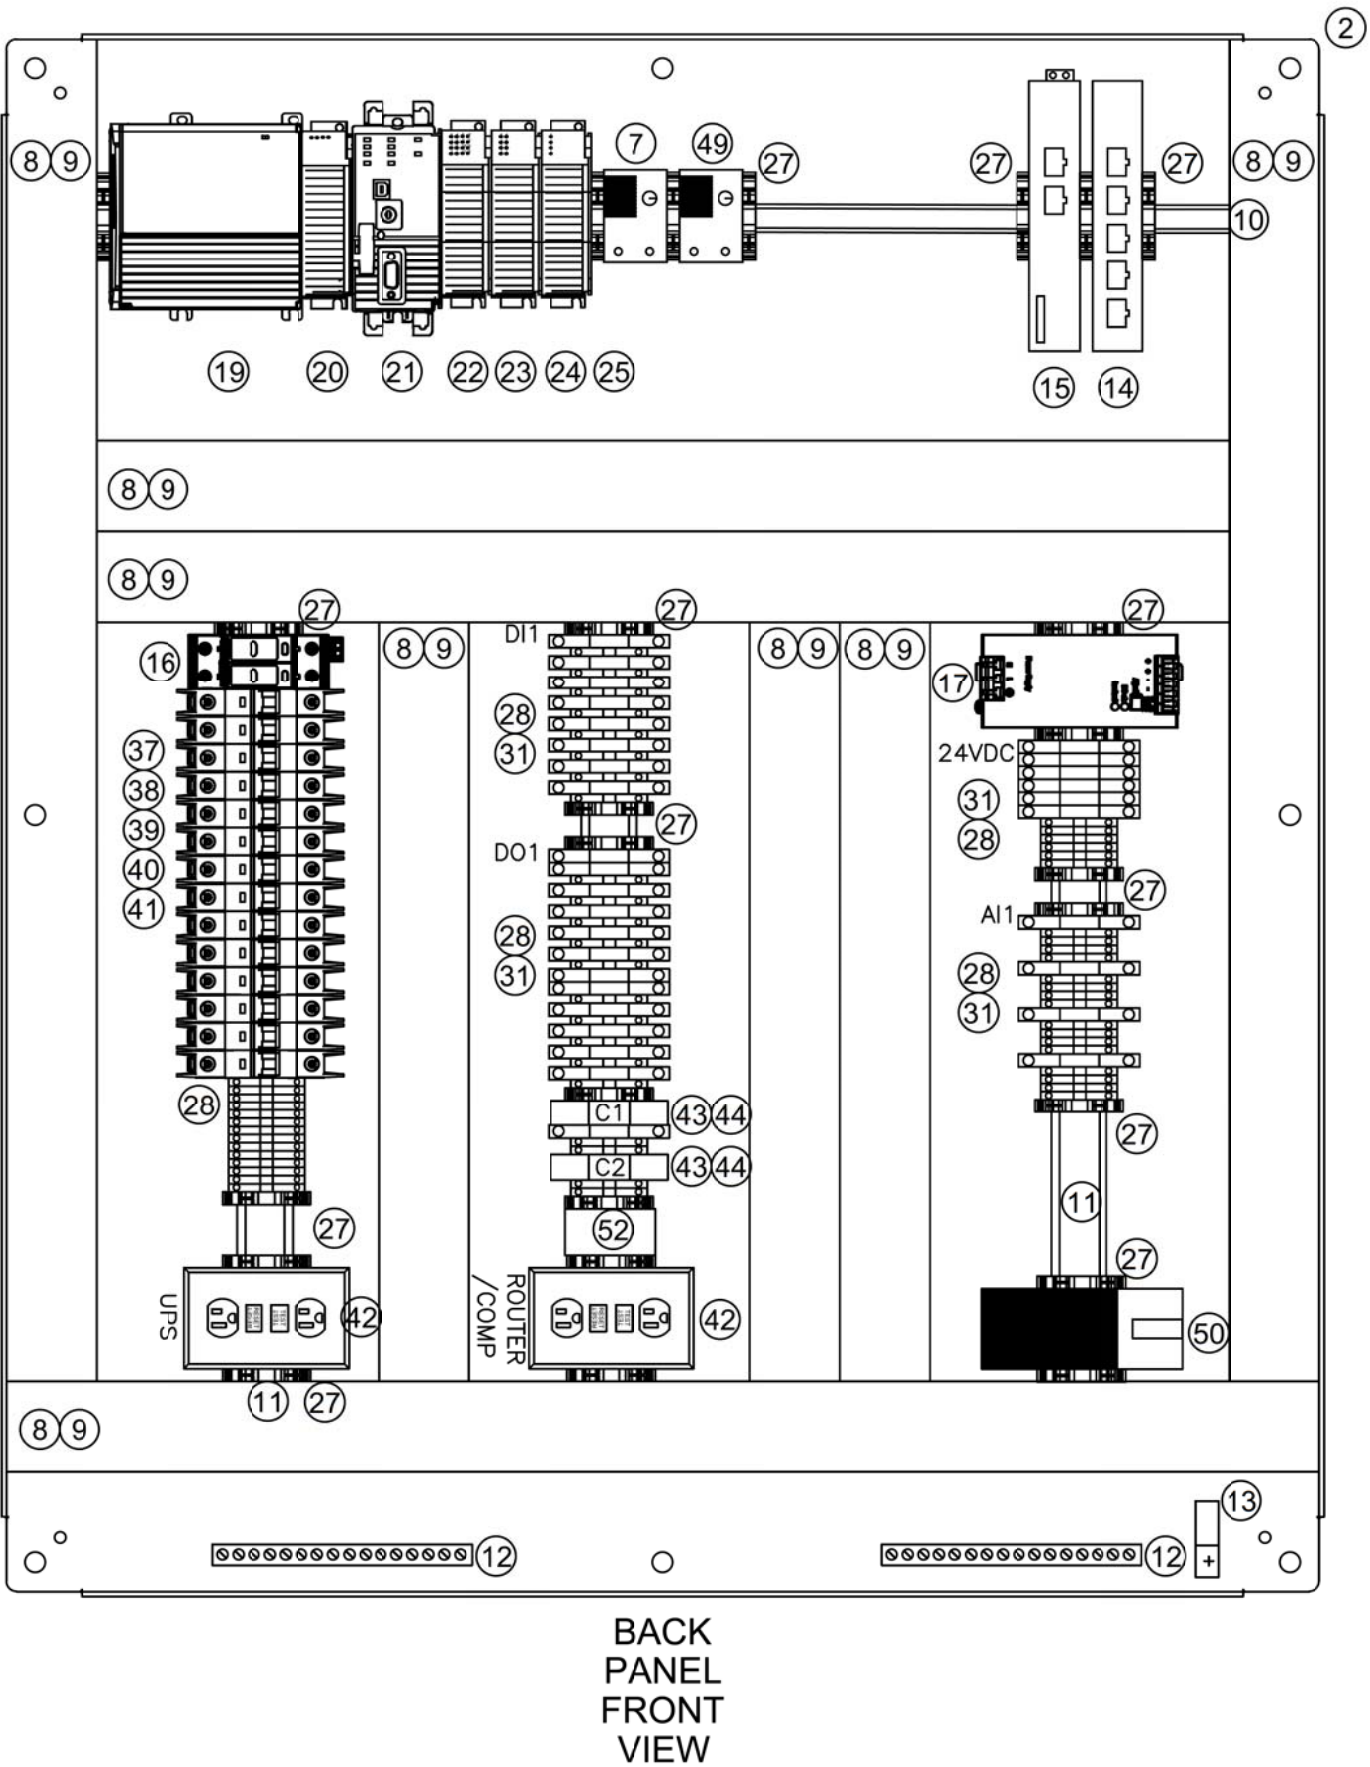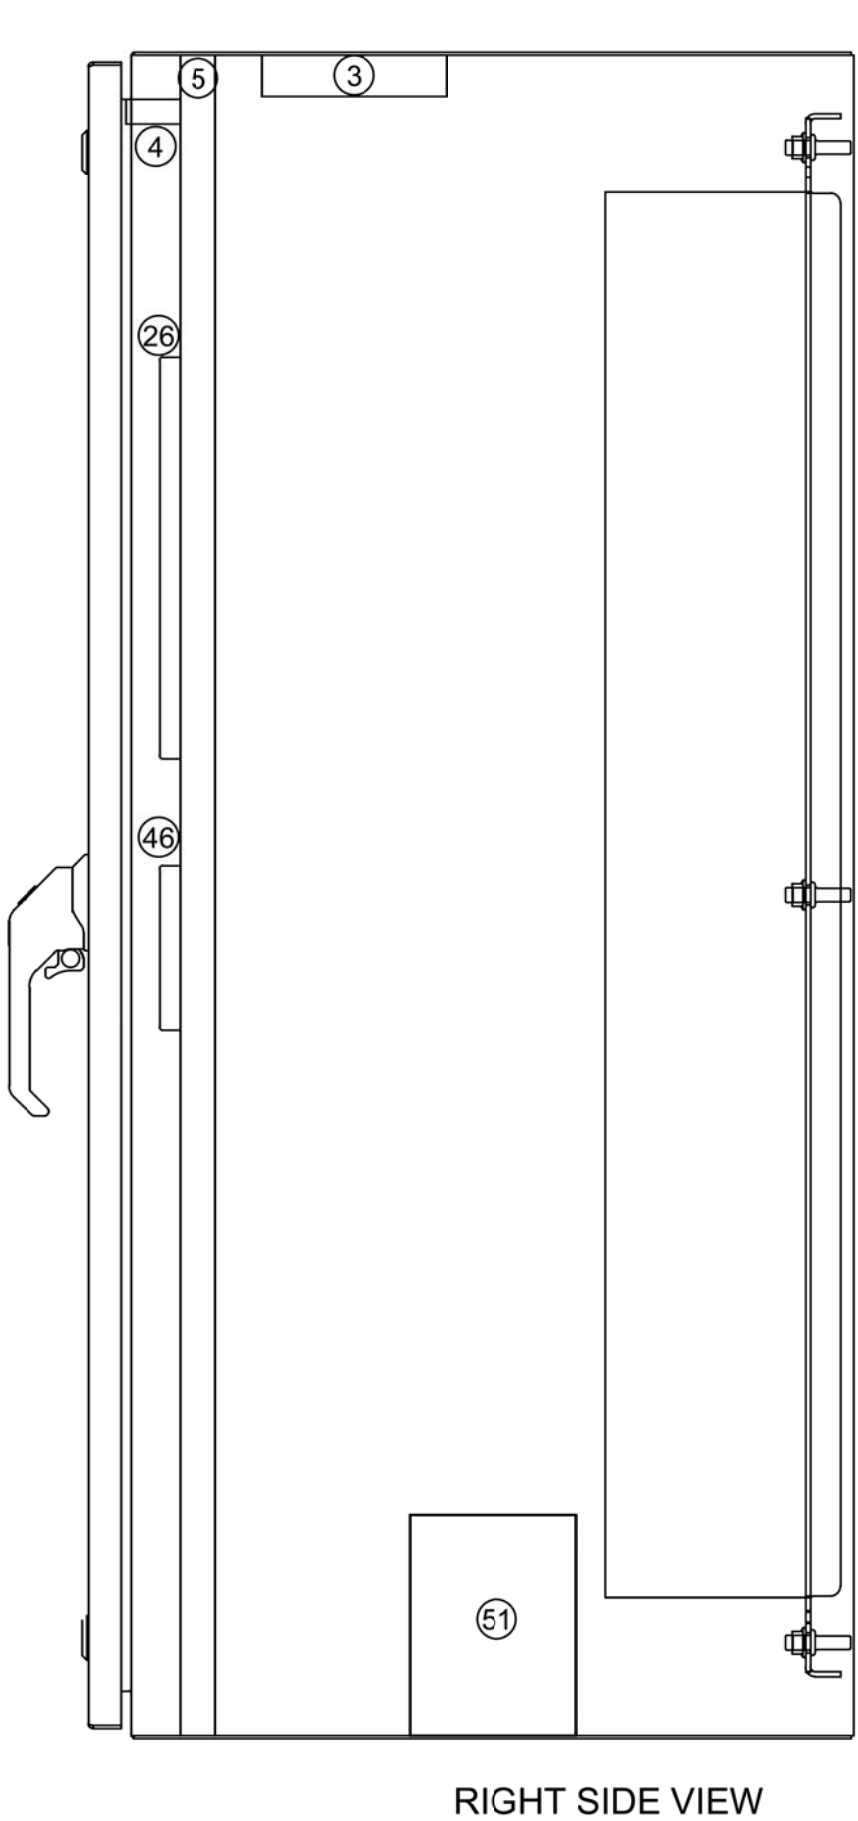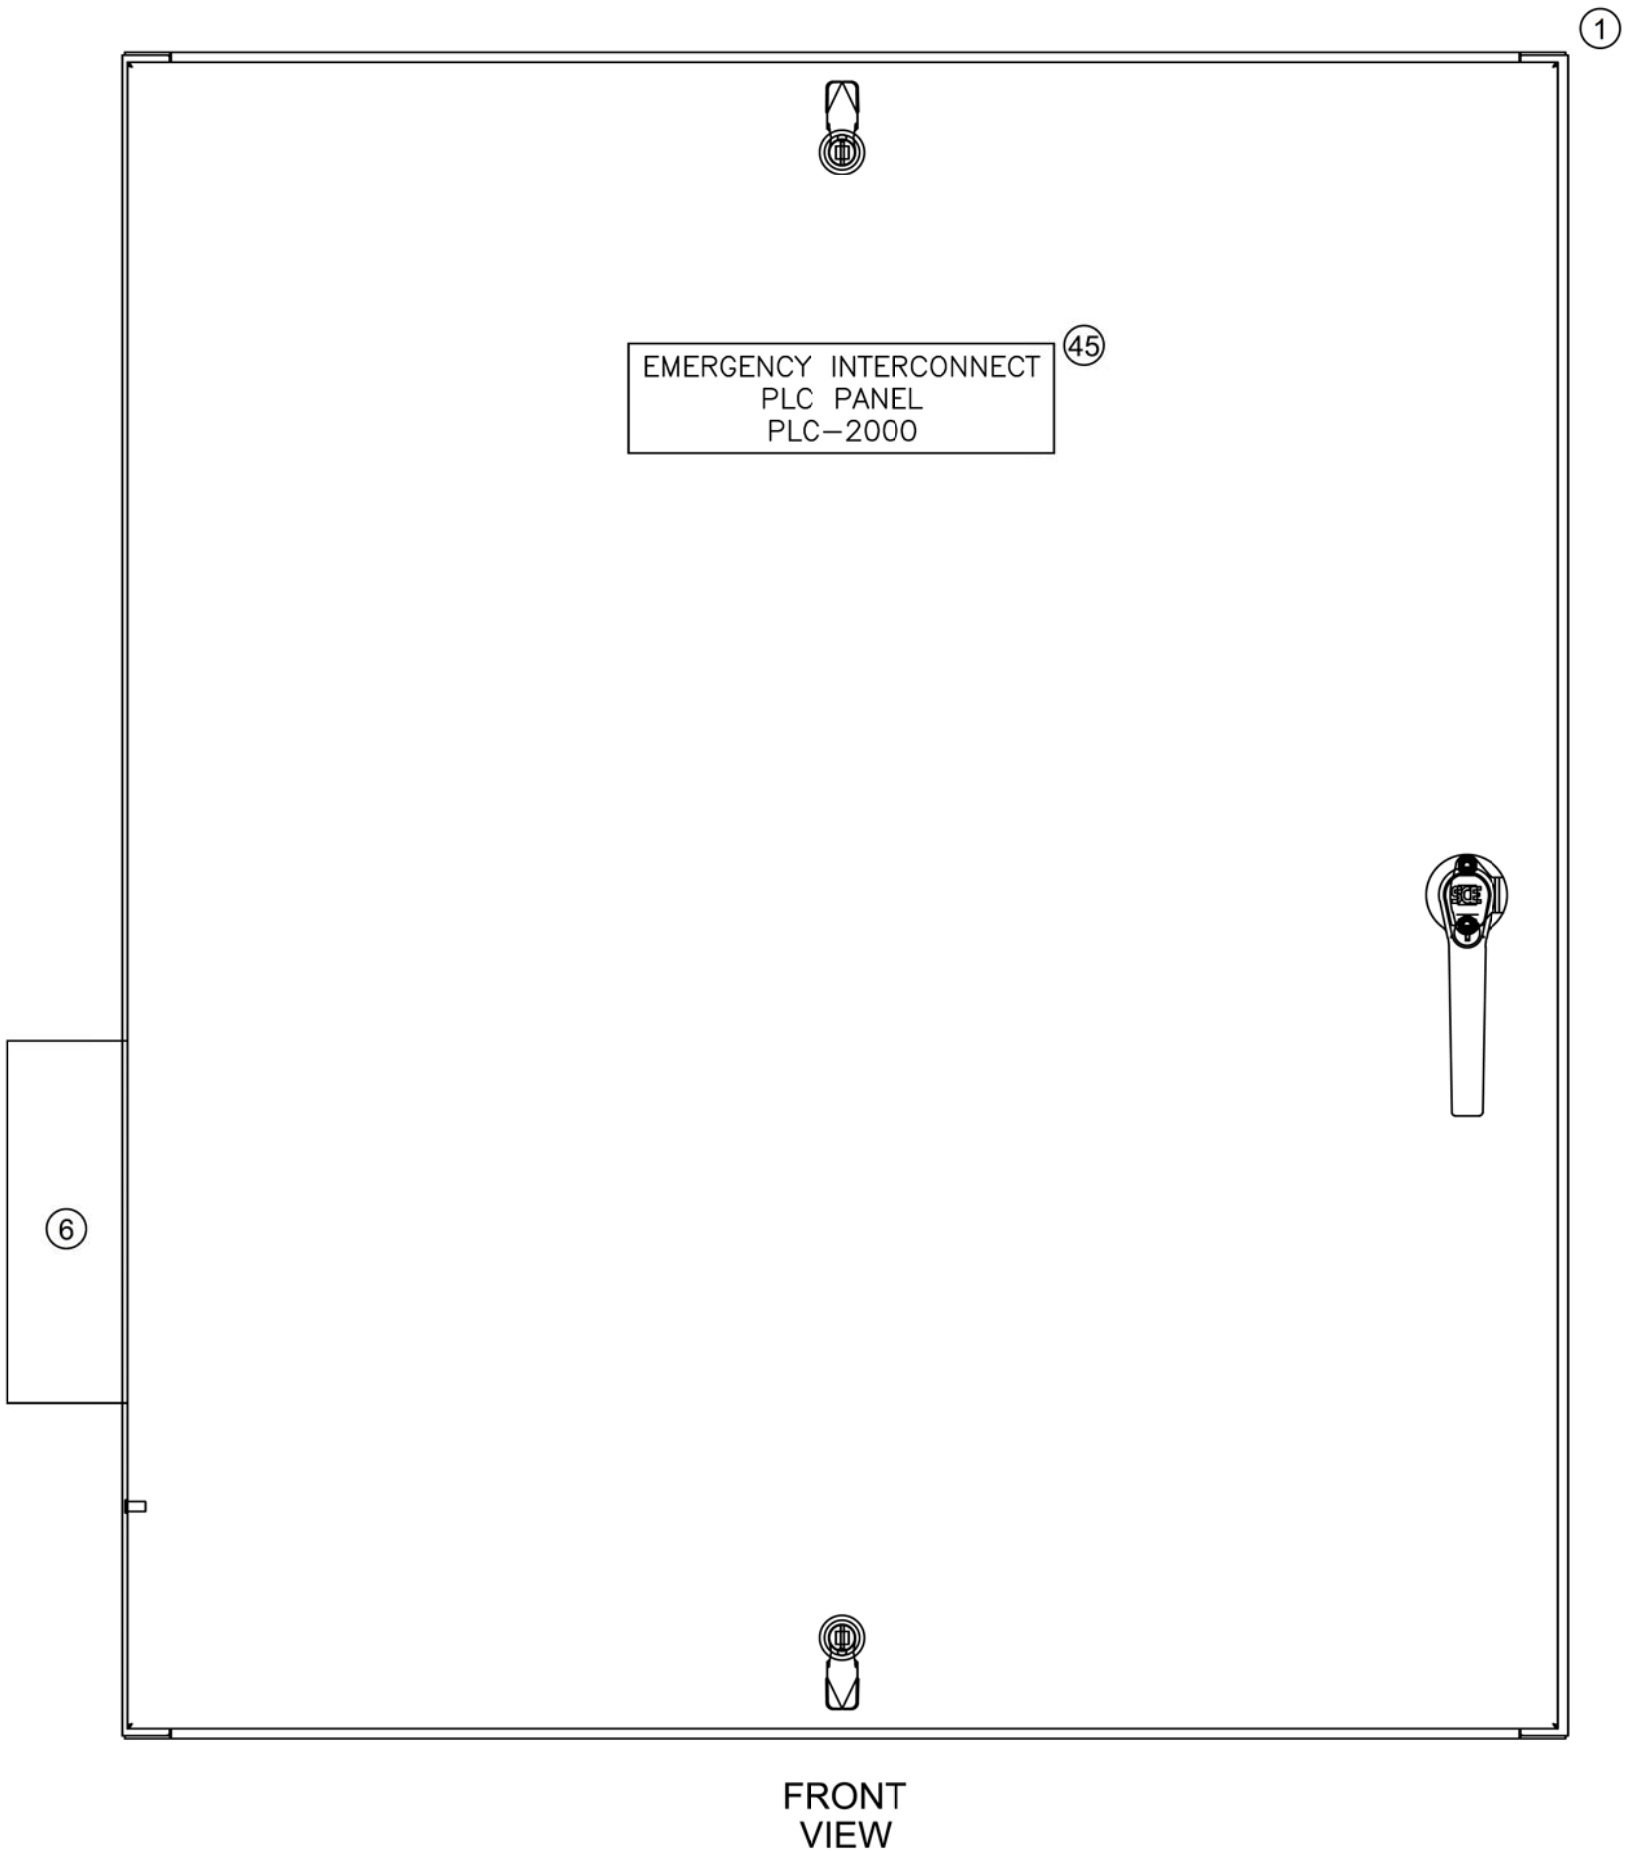

NOT SHOWN

NOT SHOWN

		MATERIAL LIST	
ITEM	QTY	MANUFACTURER	DESCRIPTION
1	1	SAGINAW ENCLOSURE	42"X36"X18" ENCLOSURE
2	1	SAGINAW ENCLOSURE	42"X36" ENCLOSURE BACK PANEL
3	1	SAGINAW ENCLOSURE	24" ENCLOSURE LIGHT FIXTURE
4	1	SAGINAW ENCLOSURE	ENCLOSURE DOOR SWITCH & ASSEMBLY
5	1	SAGINAW ENCLOSURE	DEAD FRONT PANEL ASSEMBLY
6	1	KOOLTRONICS	NEMA 3R FILTER FAN
7	1	KOOLTRONICS	THERMOSTAT NORMALLY OPEN
8	AS REQ	PANDUIT	WIRE DUCT 2"X5" LT GRY
9	AS REQ	PANDUIT	WIRE DUCT COVER 2" LT GRY
10	AS REQ	ALLEN BRADLEY	DIN RAIL
11	AS REQ	ALLEN BRADLEY	HIGH RISE DIN RAIL
12	2	ELECTRIC MOTION	GROUND BAR
13	1	BURNDY	SINGLE BARREL GROUND LUG
14	1	PHOENIX CONTACT	5 PORT ETHERNET SWITCH
15	1	PHOENIX CONTACT	MGuard INTELLIGENT FIREWALL ROUTER
16	1	PHOENIX CONTACT	SURGE ARRESTER
17	1	PULS	24VDC 196W POWER SUPPLY
18	3	AUTOMATION DIRECT	SHIELDED ETHERNET CABLE 7FT
19	1	ALLEN BRADLEY	COMPACT LOGIX POWER SUPPLY
20	1	ALLEN BRADLEY	COMPACT LOGIX COMM MODULE
21	1	ALLEN BRADLEY	COMPACT LOGIX PROCESSOR
22	1	ALLEN BRADLEY	COMPACT LOGIX DIGITAL INPUT-16PTS
23	1	ALLEN BRADLEY	COMPACT LOGIX DIGITAL OUTPUT-8PTS
24	1	ALLEN BRADLEY	COMPACT LOGIX ANALOG INPUT-4PTS
25	1	ALLEN BRADLEY	COMPACT LOGIX END CAP
26	1	ALLEN BRADLEY	9" PANELVIEW PLUS
27	AS REQ	PHOENIX CONTACT	END CLAMP
28	AS REQ	PHOENIX CONTACT	TERMINAL BLOCK
29	AS REQ	PHOENIX CONTACT	TERMINAL BLOCK END PLATE
30	AS REQ	PHOENIX CONTACT	TERMINAL BLOCK CENTER JUMPER
31	AS REQ	PHOENIX CONTACT	FUSE BLOCK
32	AS REQ	PHOENIX CONTACT	FUSE BLOCK END PLATE
33	AS REQ	PHOENIX CONTACT	FUSE BLOCK CENTER JUMPER
34	AS REQ	BUSSMANN	1/4A FUSE 1/4"-1-1/4"
35	AS REQ	BUSSMANN	1/2A FUSE 1/4"-1-1/4"
36	AS REQ	BUSSMANN	1A FUSE 1/4"-1-1/4"
37	3	ALLEN BRADLEY	1 POLE 20A CIRCUIT BREAKER
38	1	ALLEN BRADLEY	1 POLE 15A CIRCUIT BREAKER
39	2	ALLEN BRADLEY	1 POLE 5A CIRCUIT BREAKER
40	4	ALLEN BRADLEY	1 POLE 3A CIRCUIT BREAKER
41	4	ALLEN BRADLEY	1 POLE 2A CIRCUIT BREAKER
42	2	PHOENIX CONTACT	DIN RAIL MOUNT GFCI RECEPTACLE
43	2	ALLEN BRADLEY	16A SPDT RELAY
44	2	ALLEN BRADLEY	SPDT RELAY SOCKET
45	1	-	EMERGENCY INTERCONNECT PLC PANEL PLC-2000
46	1	ENDRESS + HAUSER	ULTRA SONIC MEASUREMENT TRANSMITTER/DISPLAY UNIT
47	AS REQ	BUSSMANN	2A FUSE 1/4"-1-1/4"
48	AS REQ	BUSSMANN	3A FUSE 1/4"-1-1/4"
49	1	KOOLTRONICS	THERMOSTAT NORMALLY CLOSED
50	1	RITTAL	ENCLOSURE HEATER
51	1	APC	600VA UPS
52	1	-	20A RATED 4-20mA CURRENT TRANSDUCER

NOTES

1. ALL ENCLOSURE PENETRATIONS SHALL MAINTAIN ENCLOSURE NEMA RATING.

ROXBOROUGH WATER AND SANITATION DISTRICT  
RAVENNA PHASE II WATER CONNECTION INFRASTRUCTURE

EMERGENCY INTERCONNECT PLC PANEL LAYOUT

**MAGNA**  
96 INVERNESS DRIVE EAST  
UNIT R  
ENGLEWOOD, CO 80112  
(303) 799-1273



DATE JUNE 2018


JOB NO. 001.335.01

RWSD



DRAWING NO.

14

W:\T4104\T4104-15\10 DRAWINGS\03\_WIP\5\_NORTH VAULT PLC POWER DIST\_RL\_REVA.dwg, IS, 8/1/2019 7:59 AM

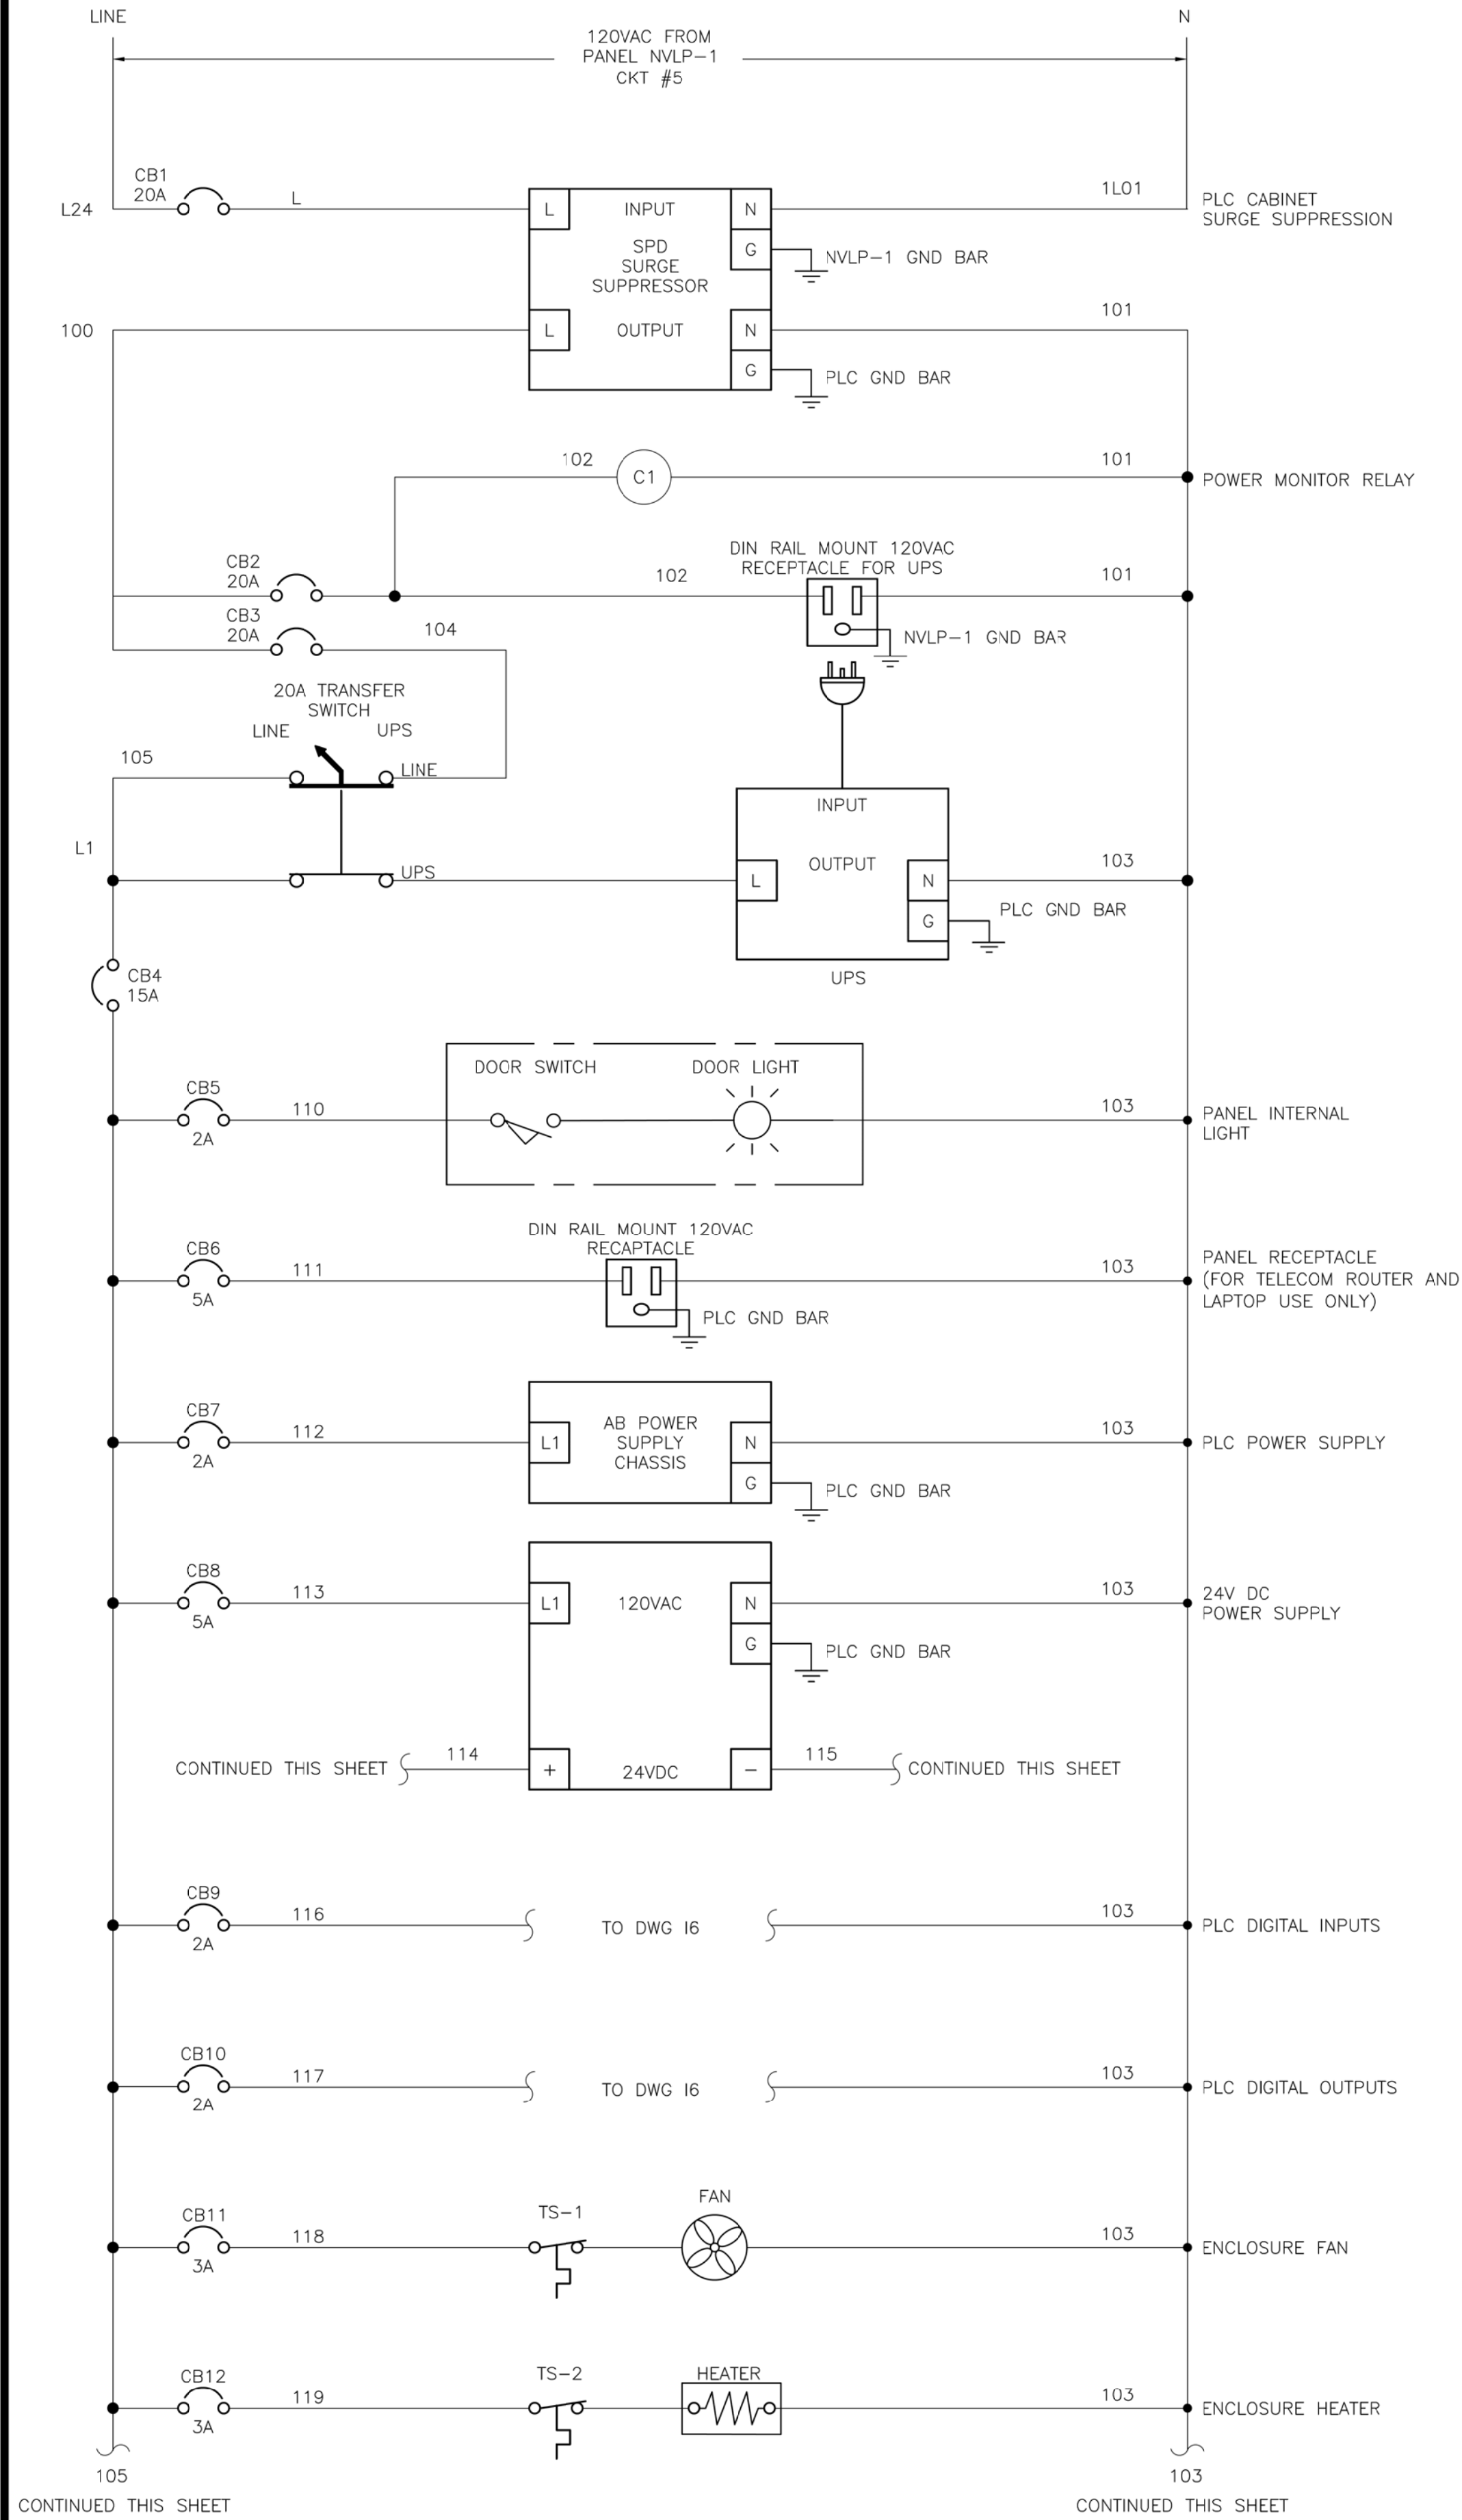

NOTES:  
1. SCHEMATICS SHOWN FOR GENERAL INTENT ONLY. CONTRACTOR SHALL DESIGN SCHEMATICS TO MATCH INTENT OF INSTALLED INSTRUMENTS AND DEVICES.

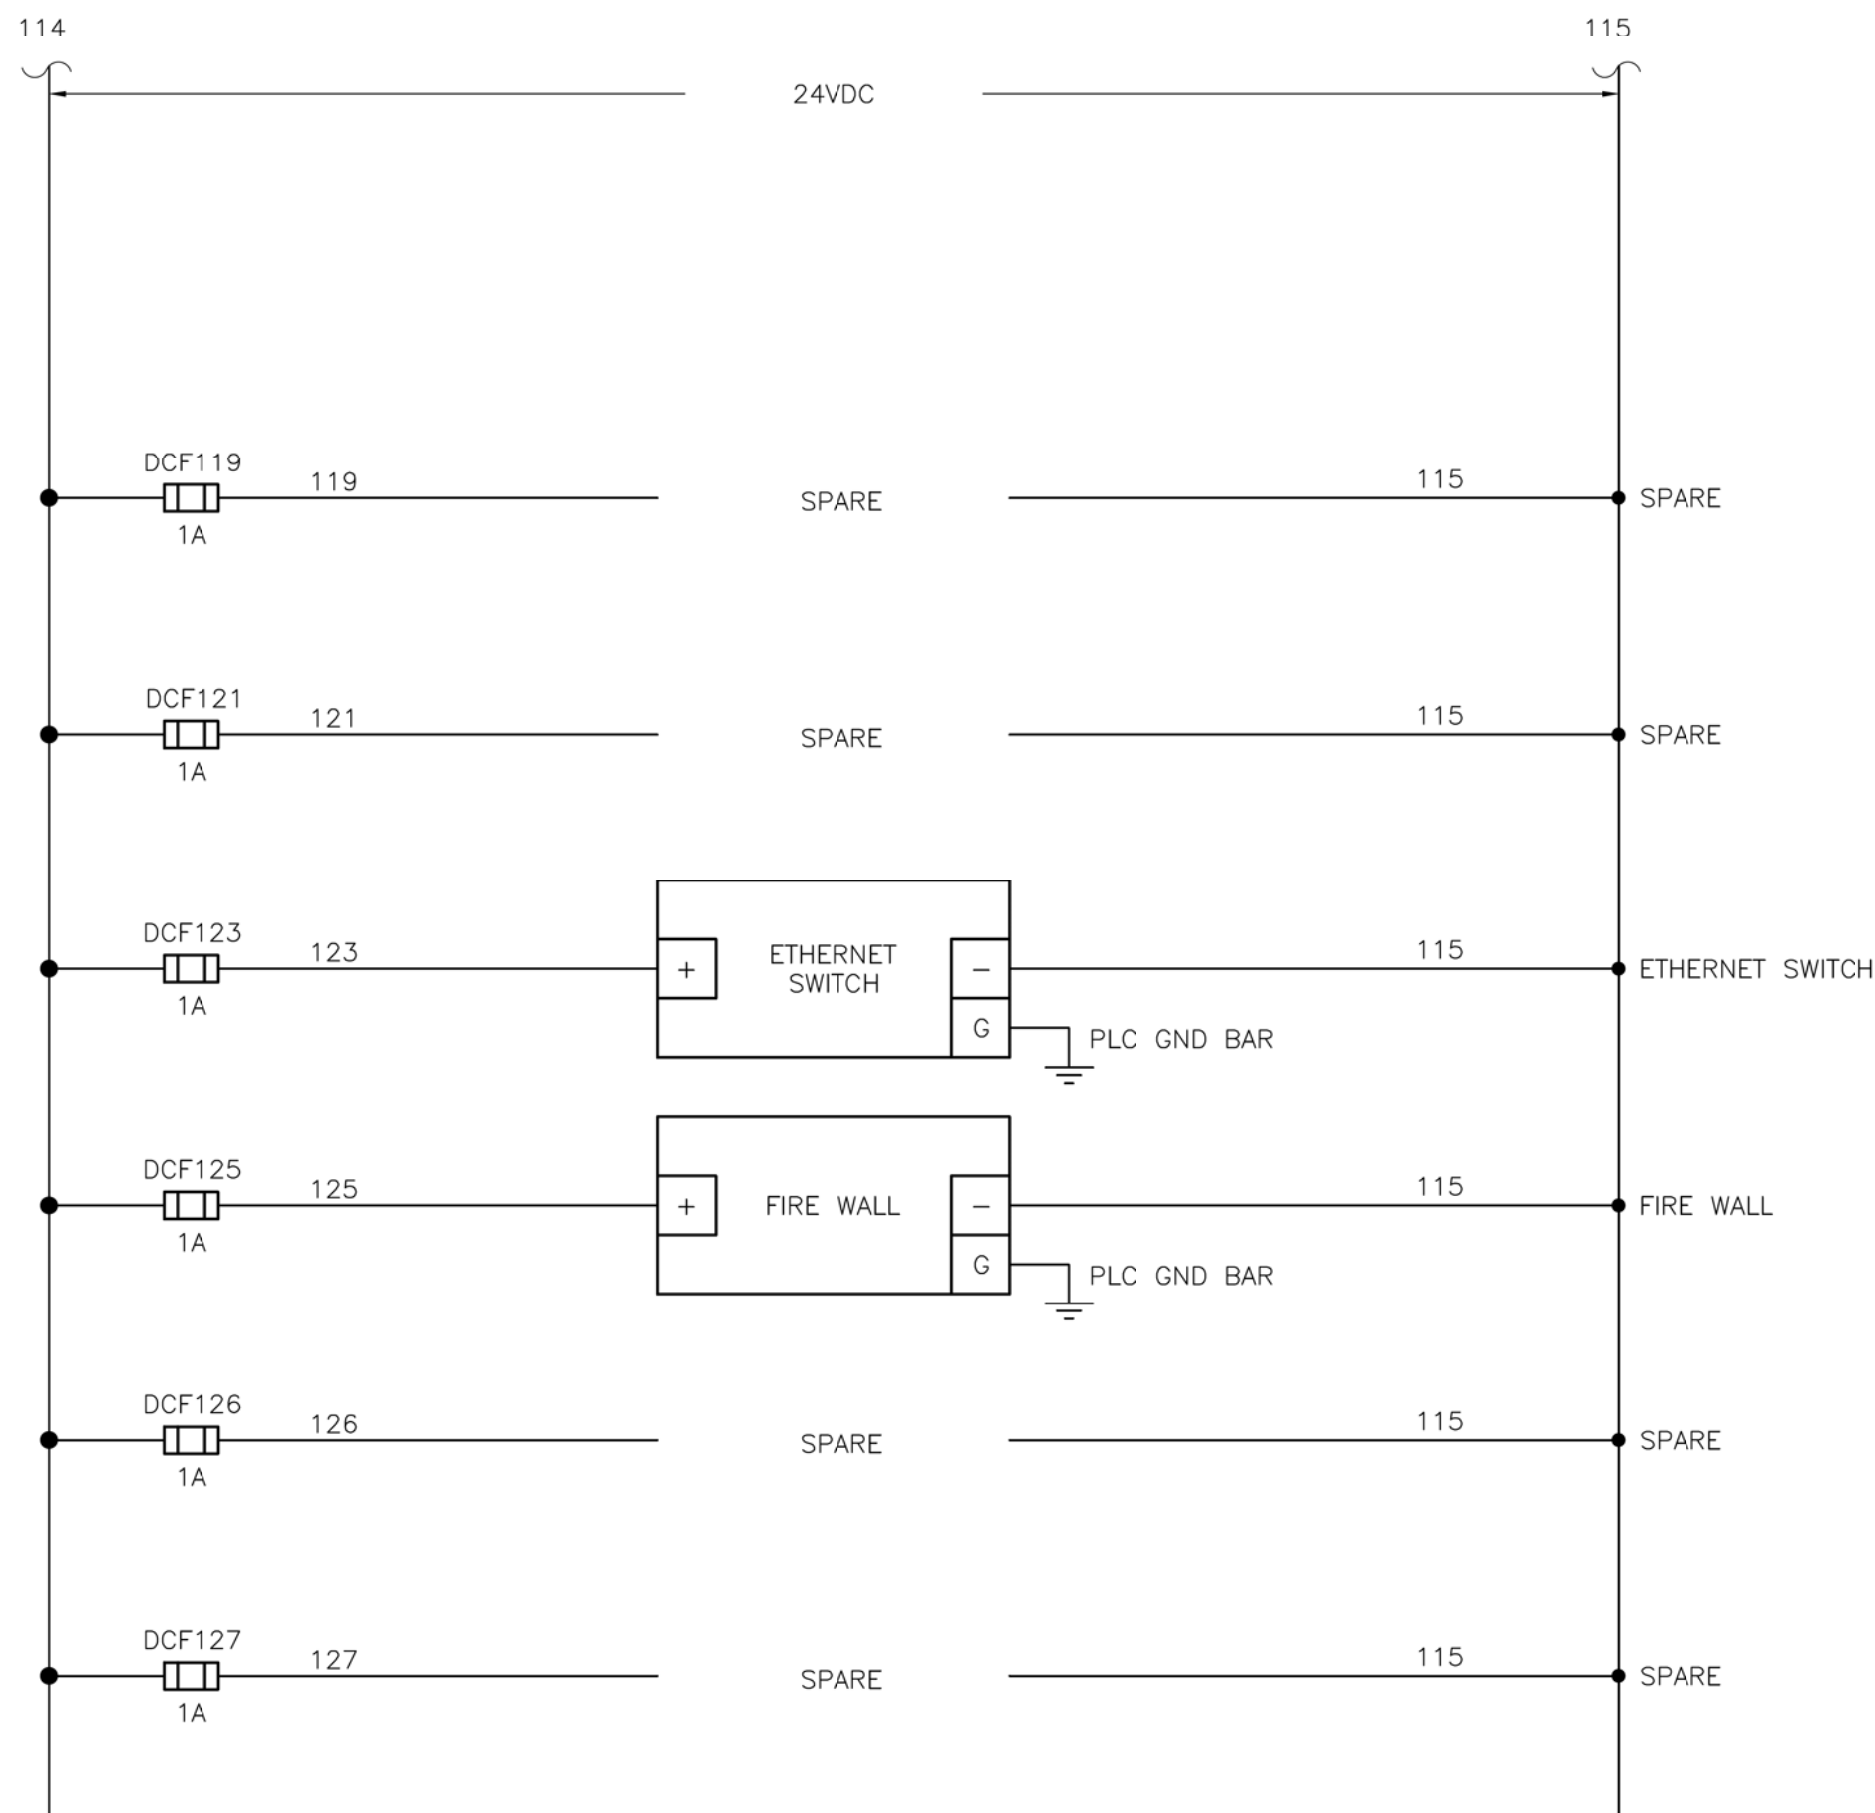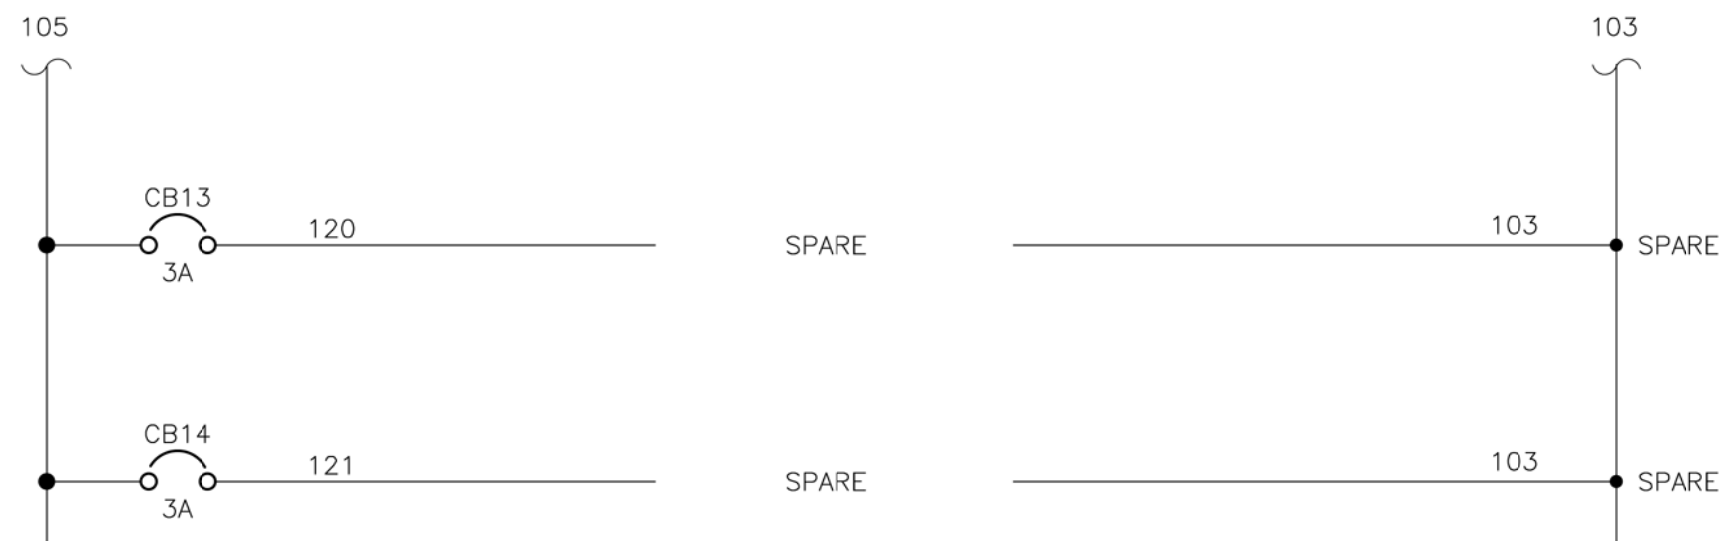

ROXBOROUGH WATER AND SANITATION DISTRICT  
RAVENNA PHASE II WATER CONNECTION INFRASTRUCTURE

NORTH VAULT PLC POWER DISTRIBUTION



DATE JUNE 2018




JOB NO. 001.335.01

DRAWING NO. RWSD

15

[illegible]

W:\T4104\T4104-15\10 DRAWINGS\03\_WPV\7\_NORTH VAULT PLC PANEL LAYOUT\_RL\_REVA.dwg, 17, 8/1/2019 7:59 AM

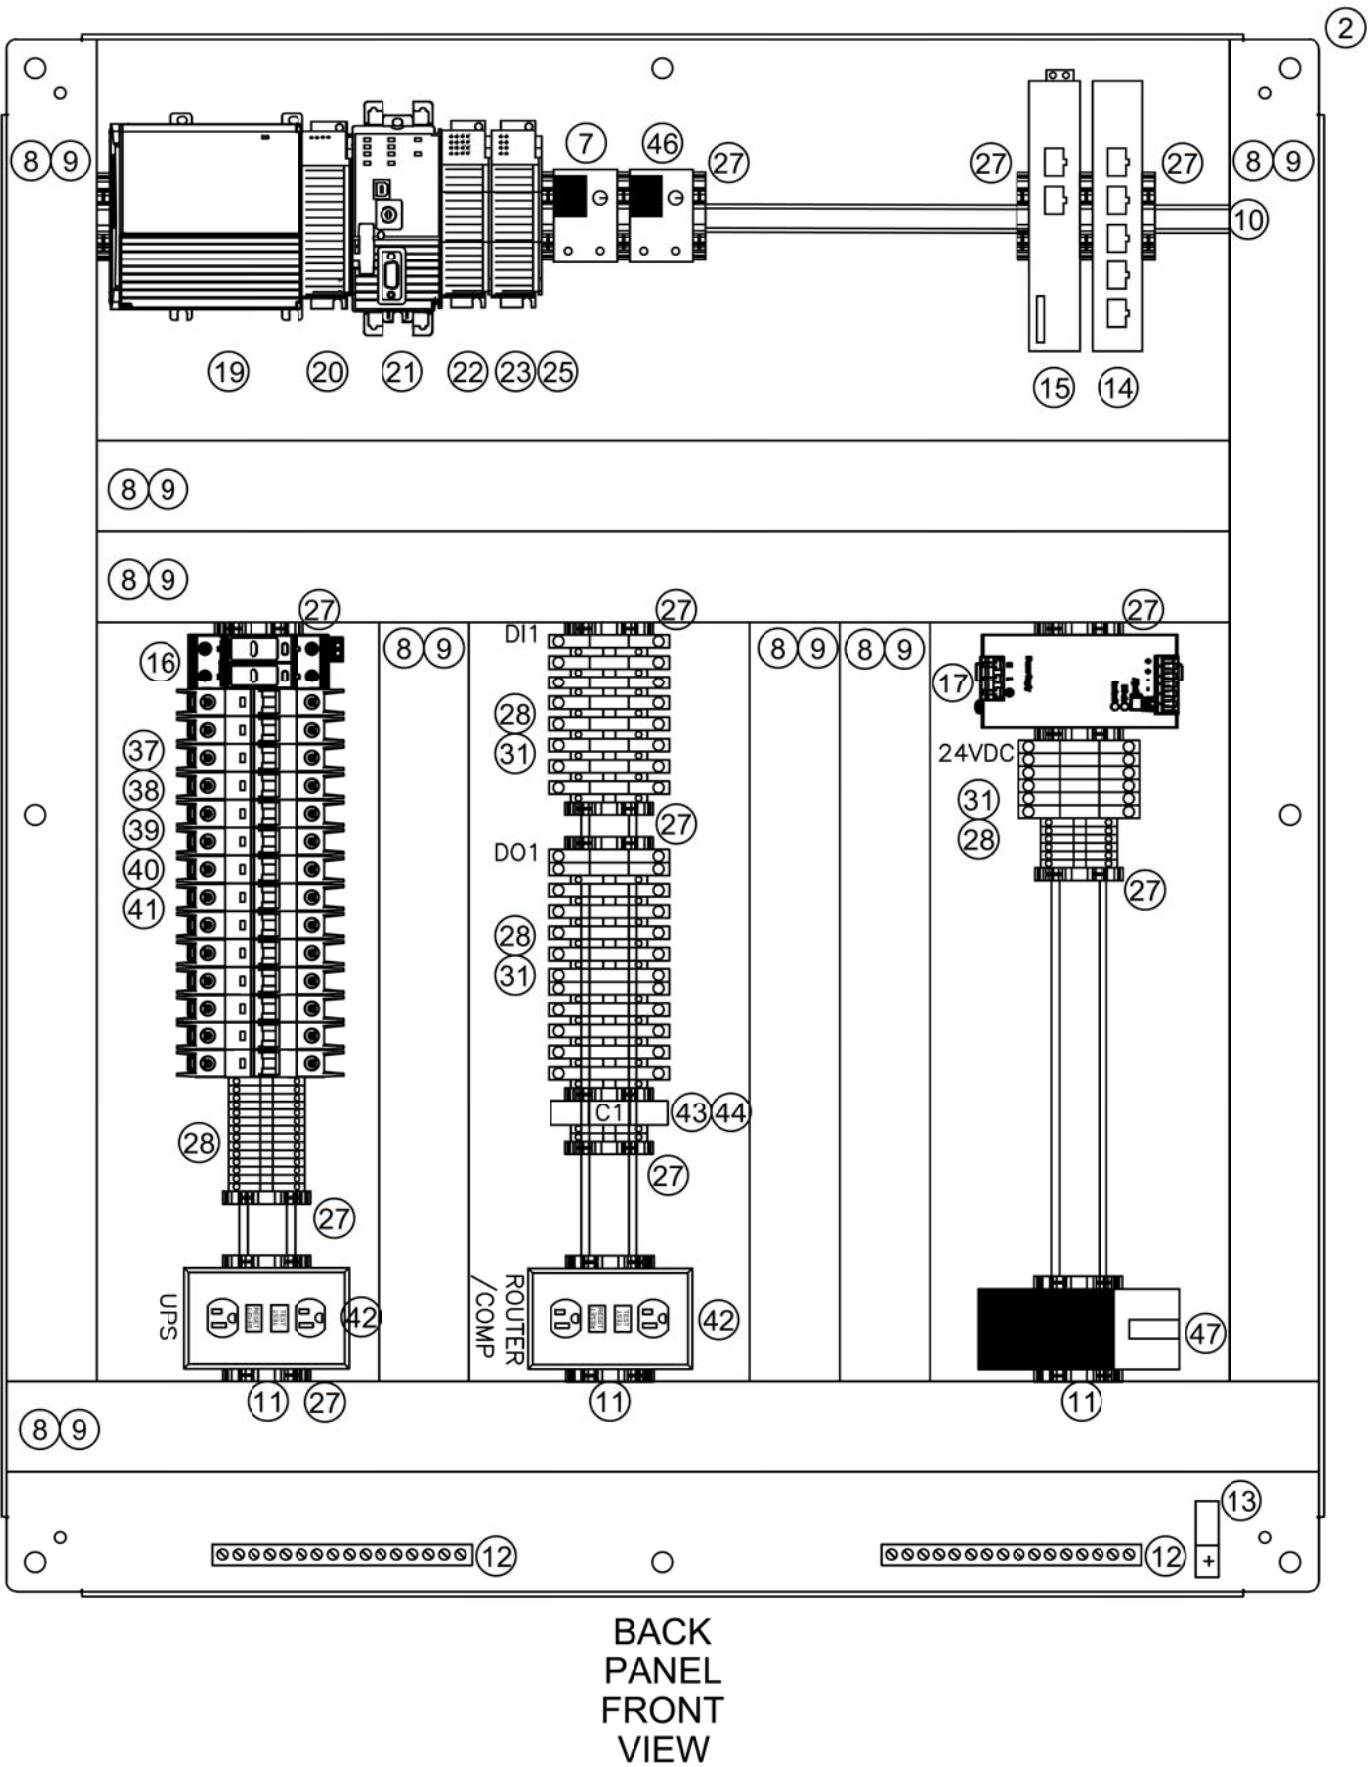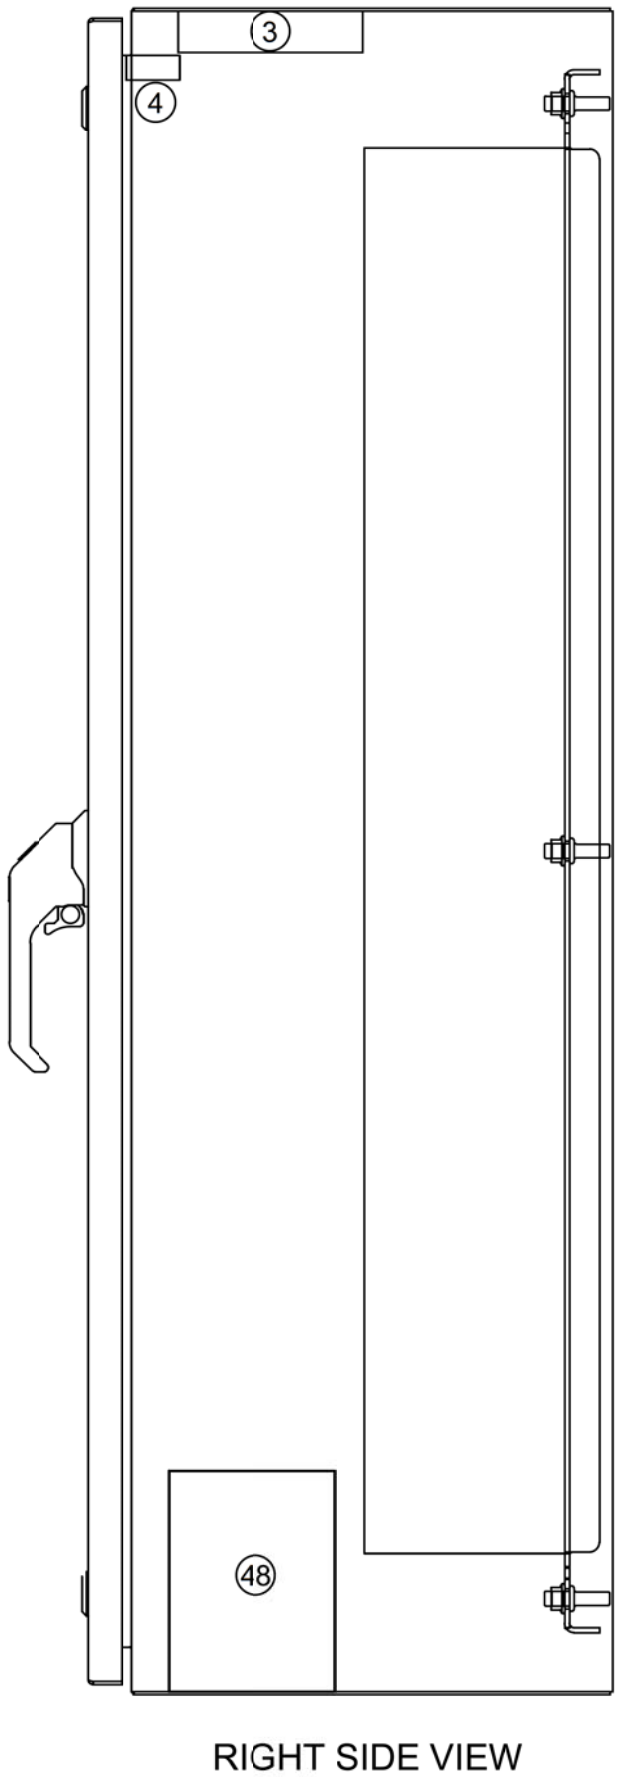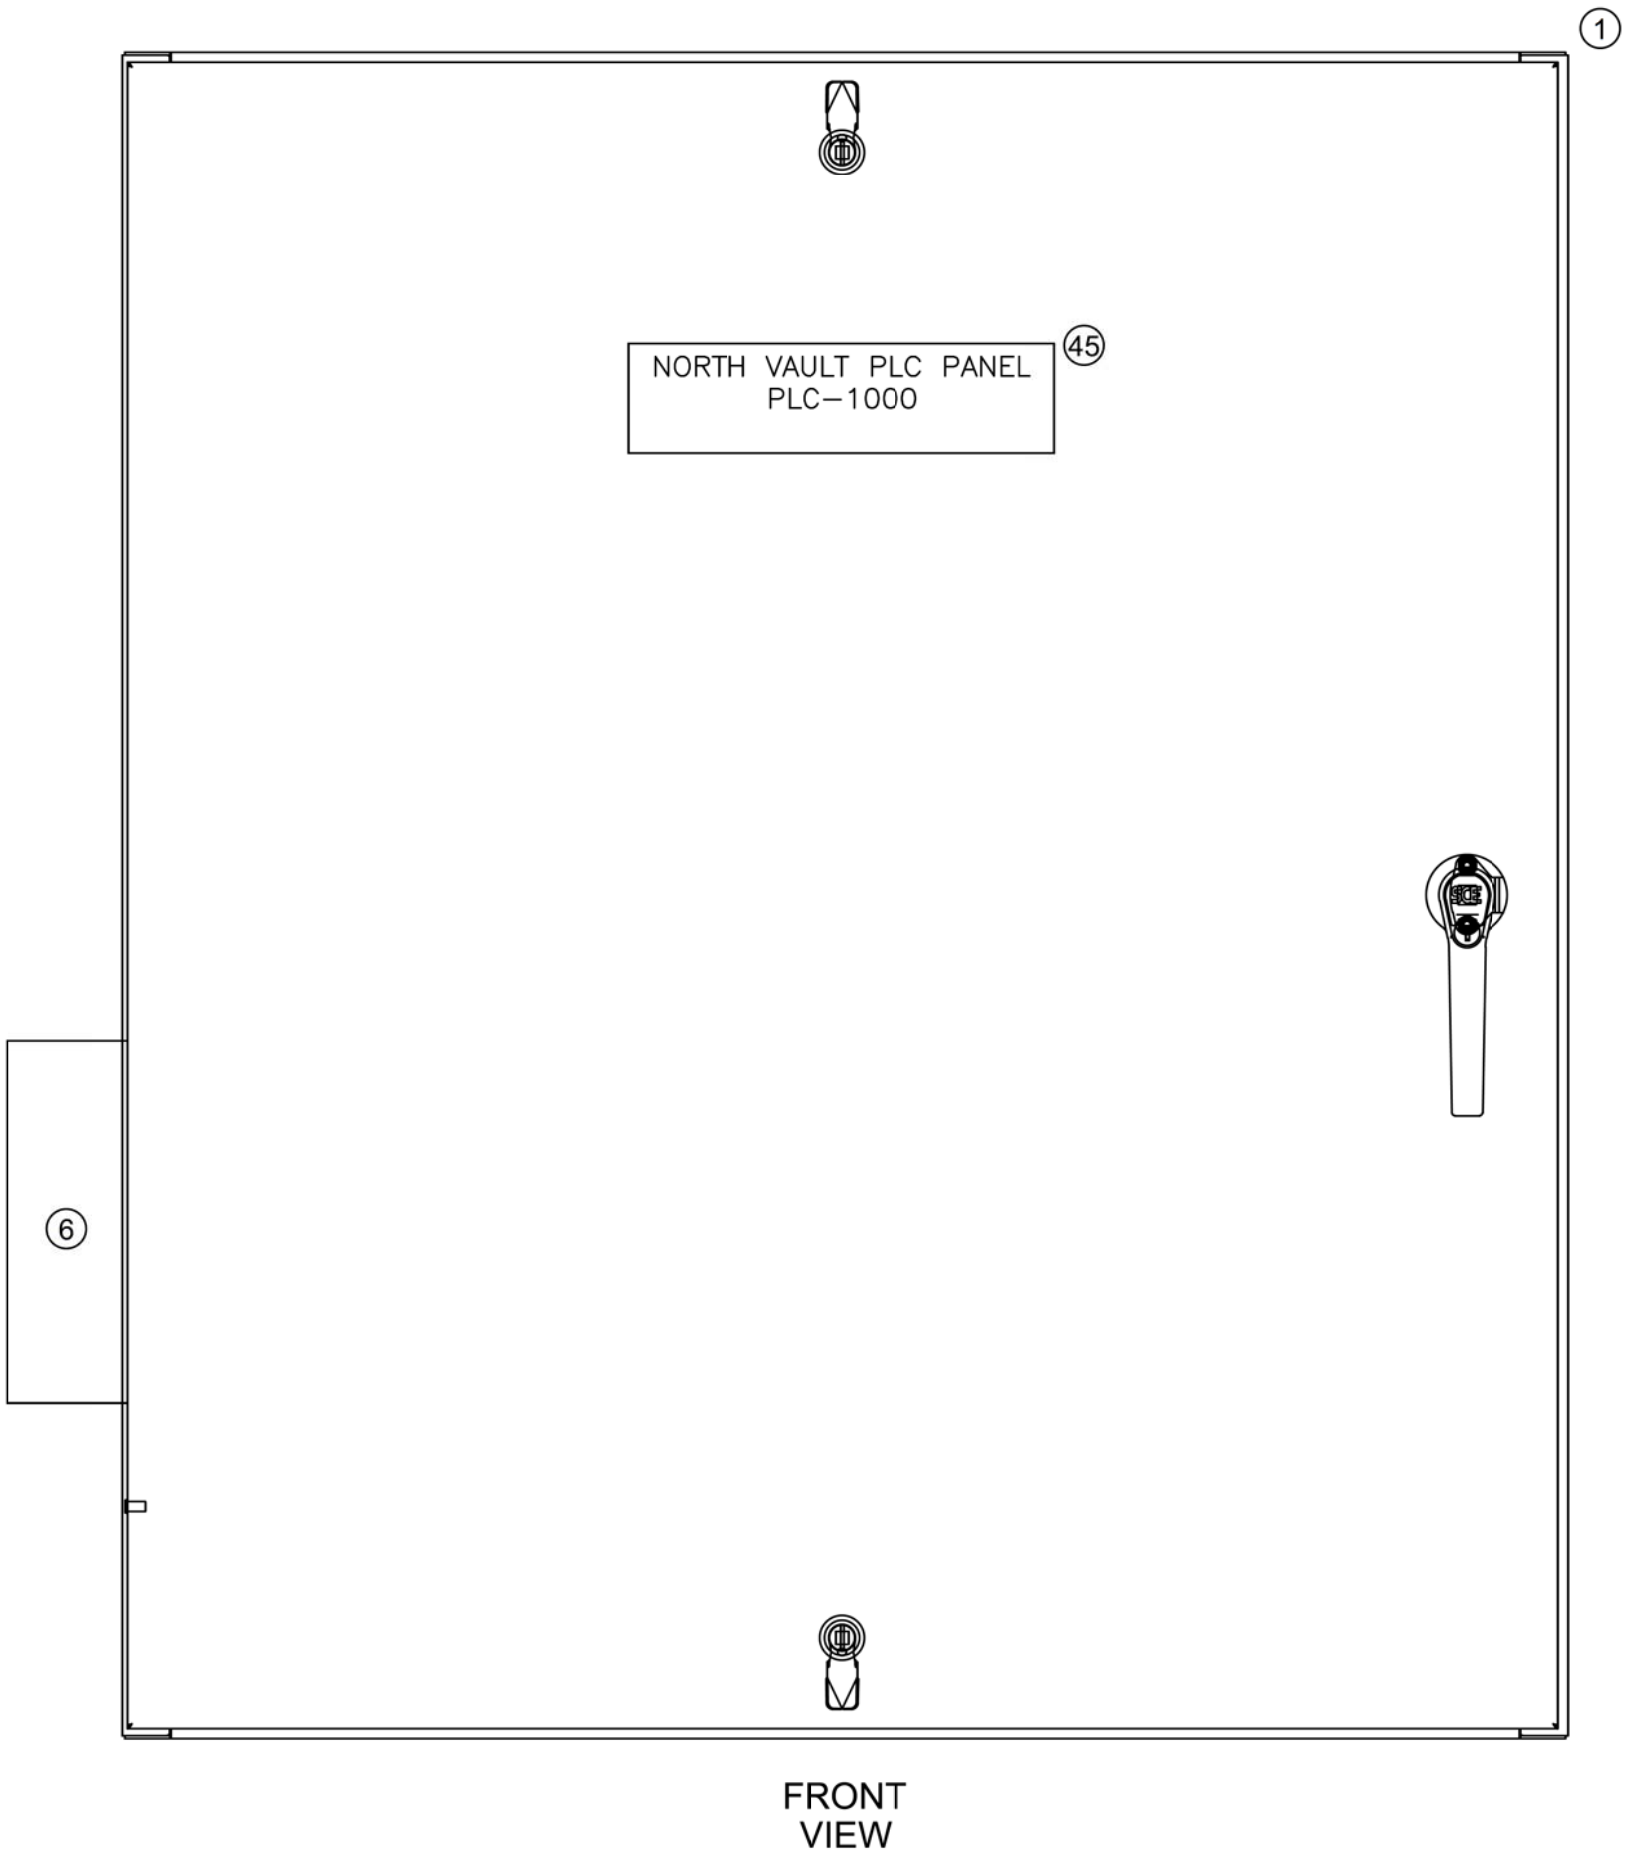

		MATERIAL LIST		
ITEM	QTY	MANUFACTURER	PART NUMBER	DESCRIPTION
1	1	SAGINAW ENCLOSURE	SCE-42EL3612LPPL	42"X36"X12" ENCLOSURE
2	1	SAGINAW ENCLOSURE	SCE-42P36	42"X36" ENCLOSURE BACK PANEL
3	1	SAGINAW ENCLOSURE	SCE-LF24	24" ENCLOSURE LIGHT FIXTURE
4	1	SAGINAW ENCLOSURE	SCE-LSA	ENCLOSURE DOOR SWITCH & ASSEMBLY
5	—	—	—	—
6	1	KOOLTRONICS	KNP40F	NEMA 3R FILTER FAN
7	1	KOOLTRONICS	KSSTF	THERMOSTAT NORMALLY OPEN
8	AS REQ	PANDUIT	F2X5LG6	WIRE DUCT 2"X5" LT GR
9	AS REQ	PANDUIT	C2LG6	WIRE DUCT COVER 2" LT GR
10	AS REQ	ALLEN BRADLEY	199-DR2	DIN RAIL
11	AS REQ	ALLEN BRADLEY	1492-DR6	HIGH RISE DIN RAIL
12	2	ELECTRIC MOTION	EM 4250-12SSO	GROUND BAR
13	1	BURNDY	KA31U	SINGLE BARREL GROUND LUG
14	1	PHOENIX CONTACT	2891001	5 PORT ETHERNET SWITCH
15	1	PHOENIX CONTACT	2700634	MGUARD INTELLIGENT FIREWALL ROUTER
16	1	PHOENIX CONTACT	2856812	SURGE ARRESTER
17	1	PULS	QS10.DNET	24VDC 196W POWER SUPPLY
18	3	AUTOMATION DIRECT	C5E-STPBK-S7	SHIELDED ETHERNET CABLE 7FT
19	1	ALLEN BRADLEY	1768-PA3	COMPACT LOGIX POWER SUPPLY
20	1	ALLEN BRADLEY	1768-ENBT	COMPACT LOGIX COMM MODULE
21	1	ALLEN BRADLEY	1768-L43	COMPACT LOGIX PROCESSOR
22	1	ALLEN BRADLEY	1769-IA16	COMPACT LOGIX DIGITAL INPUT-16PTS
23	1	ALLEN BRADLEY	1769-OW8	COMPACT LOGIX DIGITAL OUTPUT-8PTS
24	—	—	—	—
25	1	ALLEN BRADLEY	1769-ECR	COMPACT LOGIX END CAP
26	—	—	—	—
27	AS REQ	PHOENIX CONTACT	0800886	END CLAMP
28	AS REQ	PHOENIX CONTACT	3031212	TERMINAL BLOCK
29	AS REQ	PHOENIX CONTACT	3030417	TERMINAL BLOCK END PLATE
30	AS REQ	PHOENIX CONTACT	3030226	TERMINAL BLOCK CENTER JUMPER
31	AS REQ	PHOENIX CONTACT	3036385	FUSE BLOCK
32	AS REQ	PHOENIX CONTACT	3206212	FUSE BLOCK END PLATE
33	AS REQ	PHOENIX CONTACT	3030323	FUSE BLOCK CENTER JUMPER
34	AS REQ	BUSSMANN	MDA-1/4-R	1/4A FUSE 1/4"-1-1/4"
35	AS REQ	BUSSMANN	MDA-1/2-R	1/2A FUSE 1/4"-1-1/4"
36	AS REQ	BUSSMANN	MDA-1-R	1A FUSE 1/4"-1-1/4"
37	3	ALLEN BRADLEY	1489-A1D200	1 POLE 20A CIRCUIT BREAKER
38	1	ALLEN BRADLEY	1489-A1D150	1 POLE 15A CIRCUIT BREAKER
39	2	ALLEN BRADLEY	1489-A1D050	1 POLE 5A CIRCUIT BREAKER
40	4	ALLEN BRADLEY	1489-A1D030	1 POLE 3A CIRCUIT BREAKER
41	4	ALLEN BRADLEY	1489-A1D020	1 POLE 2A CIRCUIT BREAKER
42	2	PHOENIX CONTACT	5600462	DIN RAIL MOUNT GFCI RECEPTACLE
43	1	ALLEN BRADLEY	700-HK36A1	16A SPDT RELAY
44	1	ALLEN BRADLEY	700-HN121	SPDT RELAY SOCKET
45	1	—	PHENOLIC TAG	NORTH VAULT PLC PANEL PLC-1000
46	1	KOOLTRONICS	KSSTCF	THERMOSTAT NORMALLY CLOSED
47	1	RITTAL	3105.320	ENCLOSURE HEATER
48	1	APC	BE600M1	600VA UPS

- NOTES
1. ALL ENCLOSURE PENETRATIONS SHALL MAINTAIN ENCLOSURE NEMA RATING.

ROXBOROUGH WATER AND SANITATION DISTRICT  
RAVENNA PHASE II WATER CONNECTION INFRASTRUCTURE

NORTH VAULT PLC PANEL LAYOUT

**MAGNA**  
96 INVERNESS DRIVE EAST  
UNIT R  
ENGLEWOOD, CO 80112  
(303) 799-1273




DATE JUNE 2018


JOB NO. 001.335.01

DRAWING NO. RWSD

17

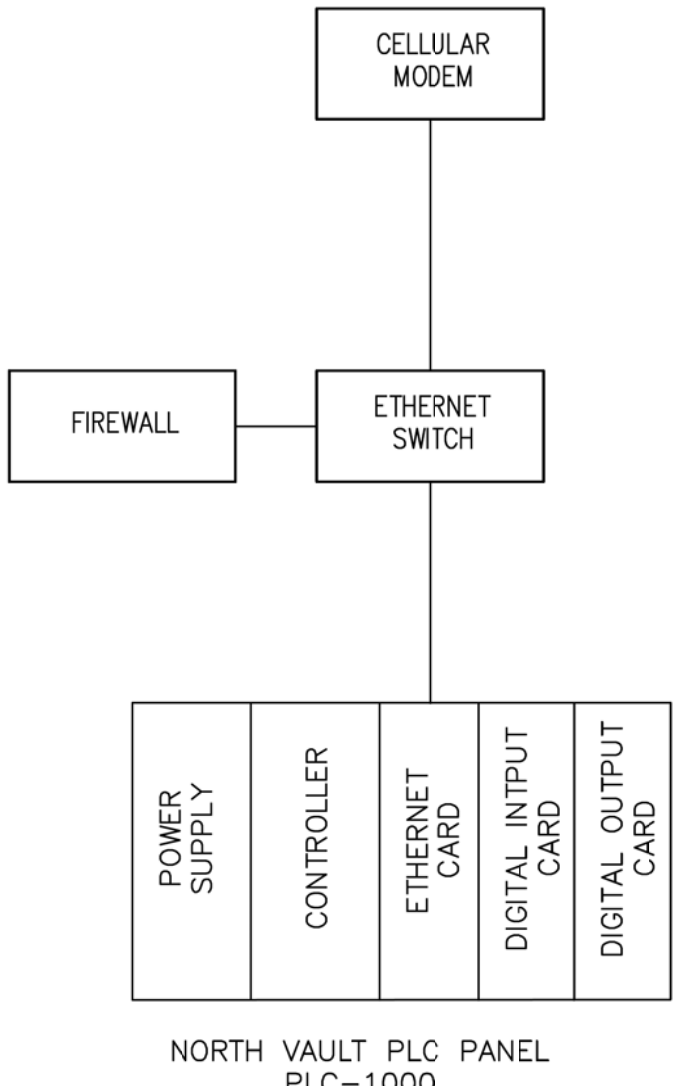

## NORTH VAULT COMMUNICATION DIAGRAM

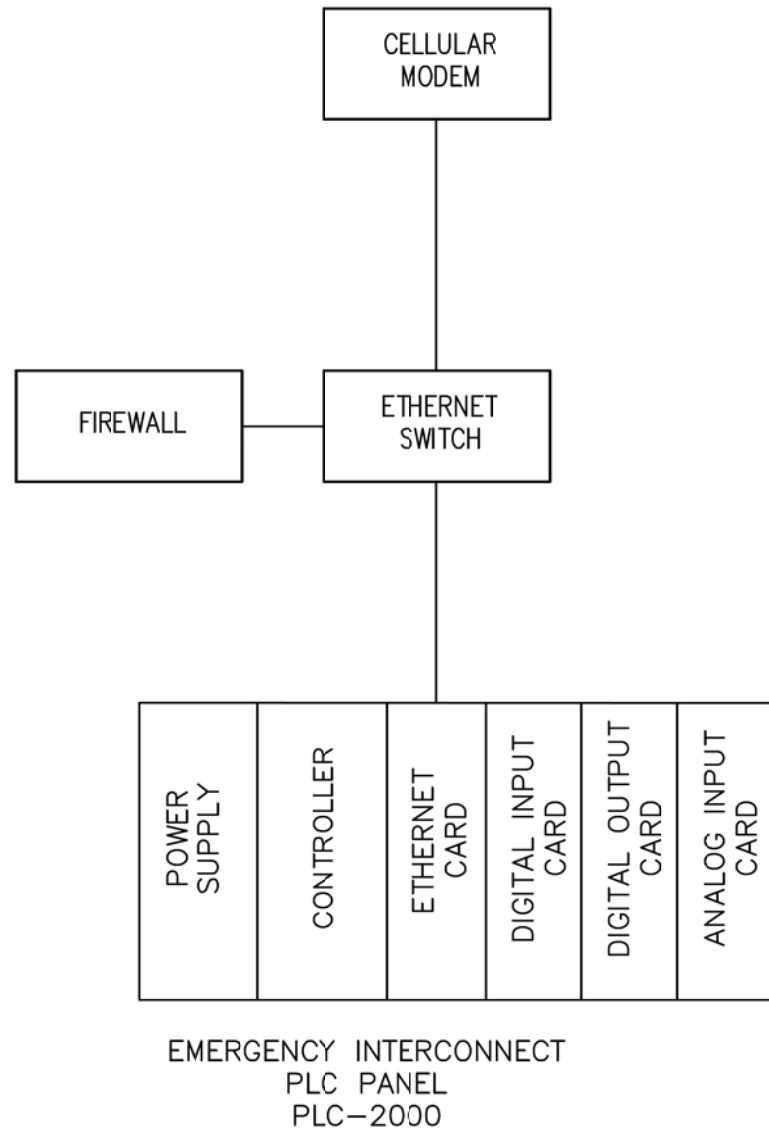

## EMERGENCY INTERCONNECT COMMUNICATION DIAGRAM

NOTES

1.

[illegible]