



October 29th, 2021

As-Built Report for the Pleasant Valley Fish Habitat Improvement Project
Regional General Permit No. 12, Corps Identification Number SPA-2021-00131

Dear Drew Johnroe and the Yampa Valley Stream Improvement Charitable Trust (Trust):

FlyWater, inc. has completed construction on the Pleasant Valley Fish Habitat Improvement Project as per the conditions listed for the Army Corps of Engineers (ACOE) Identification No *SPA-2021-00131*. All coordination for this project occurred with Tucker Feyder (ACOE), Billy Atkinson (CPW), Eric Scherff (BLM) and Tom Fresques (BLM). The project was completed within the projected time frame, and FlyWater, inc. is pleased to submit this As-Built Report.

CONSTRUCTION

The Pleasant Valley Fish Habitat Improvements on the Yampa River focused on aquatic habitat improvement within ~3,900 linear feet of the Yampa River between Stagecoach Reservoir and Lake Catamount, including the recently acquired BLM Hubbard Summer Camp property. Thirteen large improvements and several micro-improvements were constructed throughout the 3,900 ft of the Yampa River (See As-Built Plans, Attachment A).

The thirteen large improvements, and several micro-improvements were excavated and constructed to increase instream complexity, increase deep water holding areas for adult fish, maintain and improve juvenile trout habitat, increase instream cover, minimize negative effect of sediment from upstream tributaries and increase overall recreational and angling opportunity throughout the reach. Excavated material was used to create point bars and channel complexity. Habitat rocks and woody material were placed throughout the reach to provide increased cover. Five trees were harvested (saw cut) from onsite and placed within the treatments located near Station 25+00, 37+50 and 47+00. Other vegetation harvested on site included 750 willow stakes and willow clump transplants, which were used to reclaim access ramps and were installed along with log structures. Once construction was completed, all staging areas, travel paths and access ramps were seeded with a Routt County and BLM approved seed mix and then wood strand mulch was applied.

PHOTOS

Photographs from the projects photo points are presented below. Photo point locations are depicted in the as-built plan-set. Approximate view direction is noted for each photo.



Pre-Construction and Post-Construction Photos:

Pleasant Valley – Yampa River Fish Habitat Improvement Project; Routt County, CO.

PP1



Station # 47+50: Looking at opposite bank from river left. Bearing: 10°N

Photos captured: 8/24/2021 (photo left, pre-construction), 9/22/2021 (photo right, post-construction)

PP1



Station # 47+50: Looking downstream from river left. Bearing: 320°NW

Photos captured: 8/24/2021 (photo left, pre-construction), 9/22/2021 (photo right, post-construction)



PP2



Station # 42+90: Looking at opposite bank from river left. Bearing: 60°NE
Photos captured: 8/24/2021 (photo left, pre-construction), 9/22/2021 (photo right, post-construction)

PP2



Station # 42+90: Looking downstream from river left. Bearing: 0°N
Photos captured: 8/24/2021 (photo left, pre-construction), 9/22/2021 (photo right, post-construction)



PP3



Station # 38+75: Looking downstream from river left. Bearing: 350°N
Photos captured: 8/24/2021 (photo left, pre-construction), 9/22/2021 (photo right, post-construction)

PP4



Station # 34+80: Looking at opposite bank from river left. Bearing: 60°NE
Photos captured: 8/24/2021 (photo left, pre-construction), 9/22/2021 (photo right, post-construction)



PP4



Station # 34+80: Looking downstream from river left. Bearing: 330°NW
Photos captured: 8/24/2021 (photo left, pre-construction), 9/22/2021 (photo right, post-construction)

PP5



Station # 33+25: Looking downstream from river left. Bearing: 330°NW
Photos captured: 8/24/2021 (photo left, pre-construction), 9/22/2021 (photo right, post-construction)



PP5



Station # 33+25: Looking upstream from river left. Bearing: 140°SE
Photos captured: 8/24/2021 (photo left, pre-construction), 9/22/2021 (photo right, post-construction)

PP6



Station # 28+60: Looking downstream from river right. Bearing: 310°SE
Photos captured: 8/24/2021 (photo left, pre-construction), 9/22/2021 (photo right, post-construction)



PP6



Station # 28+60: Looking upstream from river right. Bearing: 190°S

Photos captured: 8/24/2021 (photo left, pre-construction), 9/22/2021 (photo right, post-construction)

PP7



Station # 25+25: Looking upstream from river left. Bearing: 135°SE

Photos captured: 8/24/2021 (photo left, pre-construction), 9/22/2021 (photo right, post-construction)




PP7



Station # 25+25: Looking at opposite bank from river left. Bearing: 70° ENE
Photos captured: 8/24/2021 (photo left, pre-construction), 9/22/2021 (photo right, post-construction)

PP8

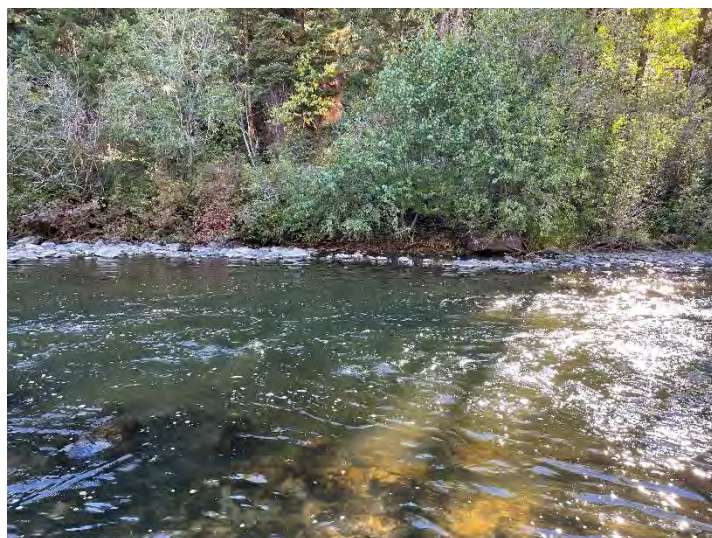

Station # 21+60: Looking at opposite bank from river left. Bearing: 90° E
Photos captured: 8/24/2021 (photo left, pre-construction), 9/22/2021 (photo right, post-construction)



PP8



Station # 21+60: Looking downstream from river left. Bearing: 0° N

Photos captured: 8/24/2021 (photo left, pre-construction), 9/22/2021 (photo right, post-construction)

PP9



Station # 17+60: Looking at opposite bank from river left. Bearing: 60° NE

Photos captured: 8/24/2021 (photo left, pre-construction), 9/22/2021 (photo right, post-construction)



PP9



Station # 17+60: Looking downstream from river left. Bearing: 10° N
Photos captured: 8/24/2021 (photo left, pre-construction), 9/22/2021 (photo right, post-construction)

PP10



Station # 15+40: Looking at the opposite bank from river left. Bearing: 80° E
Photos captured: 8/24/2021 (photo left, pre-construction), 9/22/2021 (photo right, post-construction)



PP10



Station # 15+40: Looking downstream from river left. Bearing: 0° N

Photos captured: 8/24/2021 (photo left, pre-construction), 9/22/2021 (photo right, post-construction)

PP11




Station # 12+10: Looking at opposite bank from river left. Bearing: 80° E

Photos captured: 8/24/2021 (photo left, pre-construction), 9/22/2021 (photo right, post-construction)



PP11

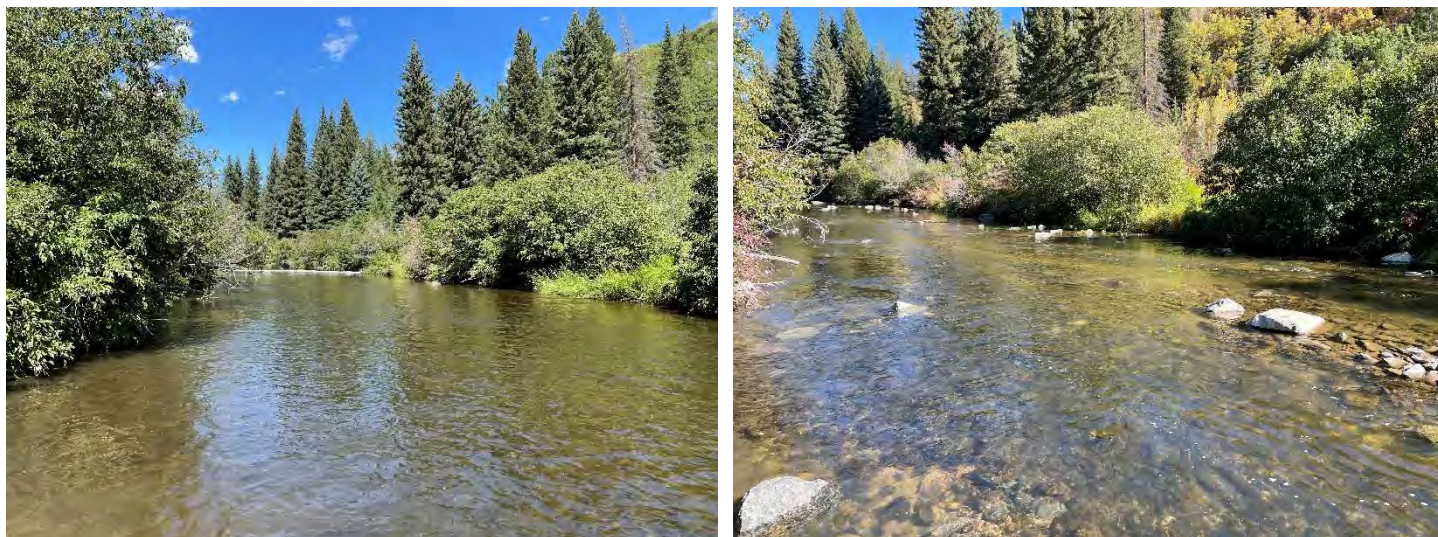

Station # 12+10: Looking downstream from river left. Bearing: 0° N

Photos captured: 8/24/2021 (photo left, pre-construction), 9/22/2021 (photo right, post-construction)

CONCLUSION

The Pleasant Valley Fish Habitat Improvement Project was successfully constructed with a few minor field design changes implemented in response to site conditions.

I would like to thank you in advance for reviewing our As-Built Survey Report. If you have any questions or comments, please contact me. I can be reached by phone at (303) 941-1677 or by email at parker@flywater.com.



RIVER CONSULTANTS & CONSTRUCTORS

ATTACHEMENT A

PLEASANT VALLEY

FISH HABITAT IMPROVEMENT PROJECT

ROUTT COUNTY, COLORADO

AS BUILT PLANS

STAKEHOLDERS

Bureau of Land Management (BLM)
Representative -

Yampa Valley Stream Improvement Charitable Trust (YSVICT)
Representative -

DESIGN BUILD TEAM

Stillwater Sciences
Contact - Julie Ash
(720) 618-5032

FlyWater Inc.
Contact - Corey Engen
(970) 217-3182

SHEET INDEX

- CS - COVER SHEET
- CP - CONTROL POINTS
- KM - KEY MAP
- STAGING AND ACCESS
- 1 - PLAN AND PROFILE STA. 10+00 - 15+00
- 2 - PLAN AND PROFILE STA. 15+00 - 20+00
- 3 - PLAN AND PROFILE STA. 20+00 - 25+00
- 4 - PLAN AND PROFILE STA. 25+00 - 30+00
- 5 - PLAN AND PROFILE STA. 30+00 - 35+00
- 6 - PLAN AND PROFILE STA. 35+00 - 40+00
- 7 - PLAN AND PROFILE STA. 40+00 - 45+00
- 8 - PLAN AND PROFILE STA. 45+00 - 50+68
- XS - TYPICAL CROSS-SECTION
- TYPICAL DETAILS - HR,LWD1,LWD2,LWD3, PA
- GN - GENERAL NOTES





PLEASANT VALLEY
FISH HABITAT
IMPROVEMENT PROJECT
ROUTT COUNTY, CO

DESIGN BUILD PLANSET
YAMPA RIVER

CS
DATE: OCT. 2021

C:\Users\Owner\Desktop\From Server\298-101 YSICT Pleasant Valley\Data-General\Valley\CAD\PLEASANT VALLEY P&P050621.dwg8/16/2021

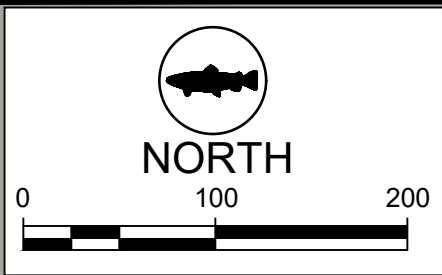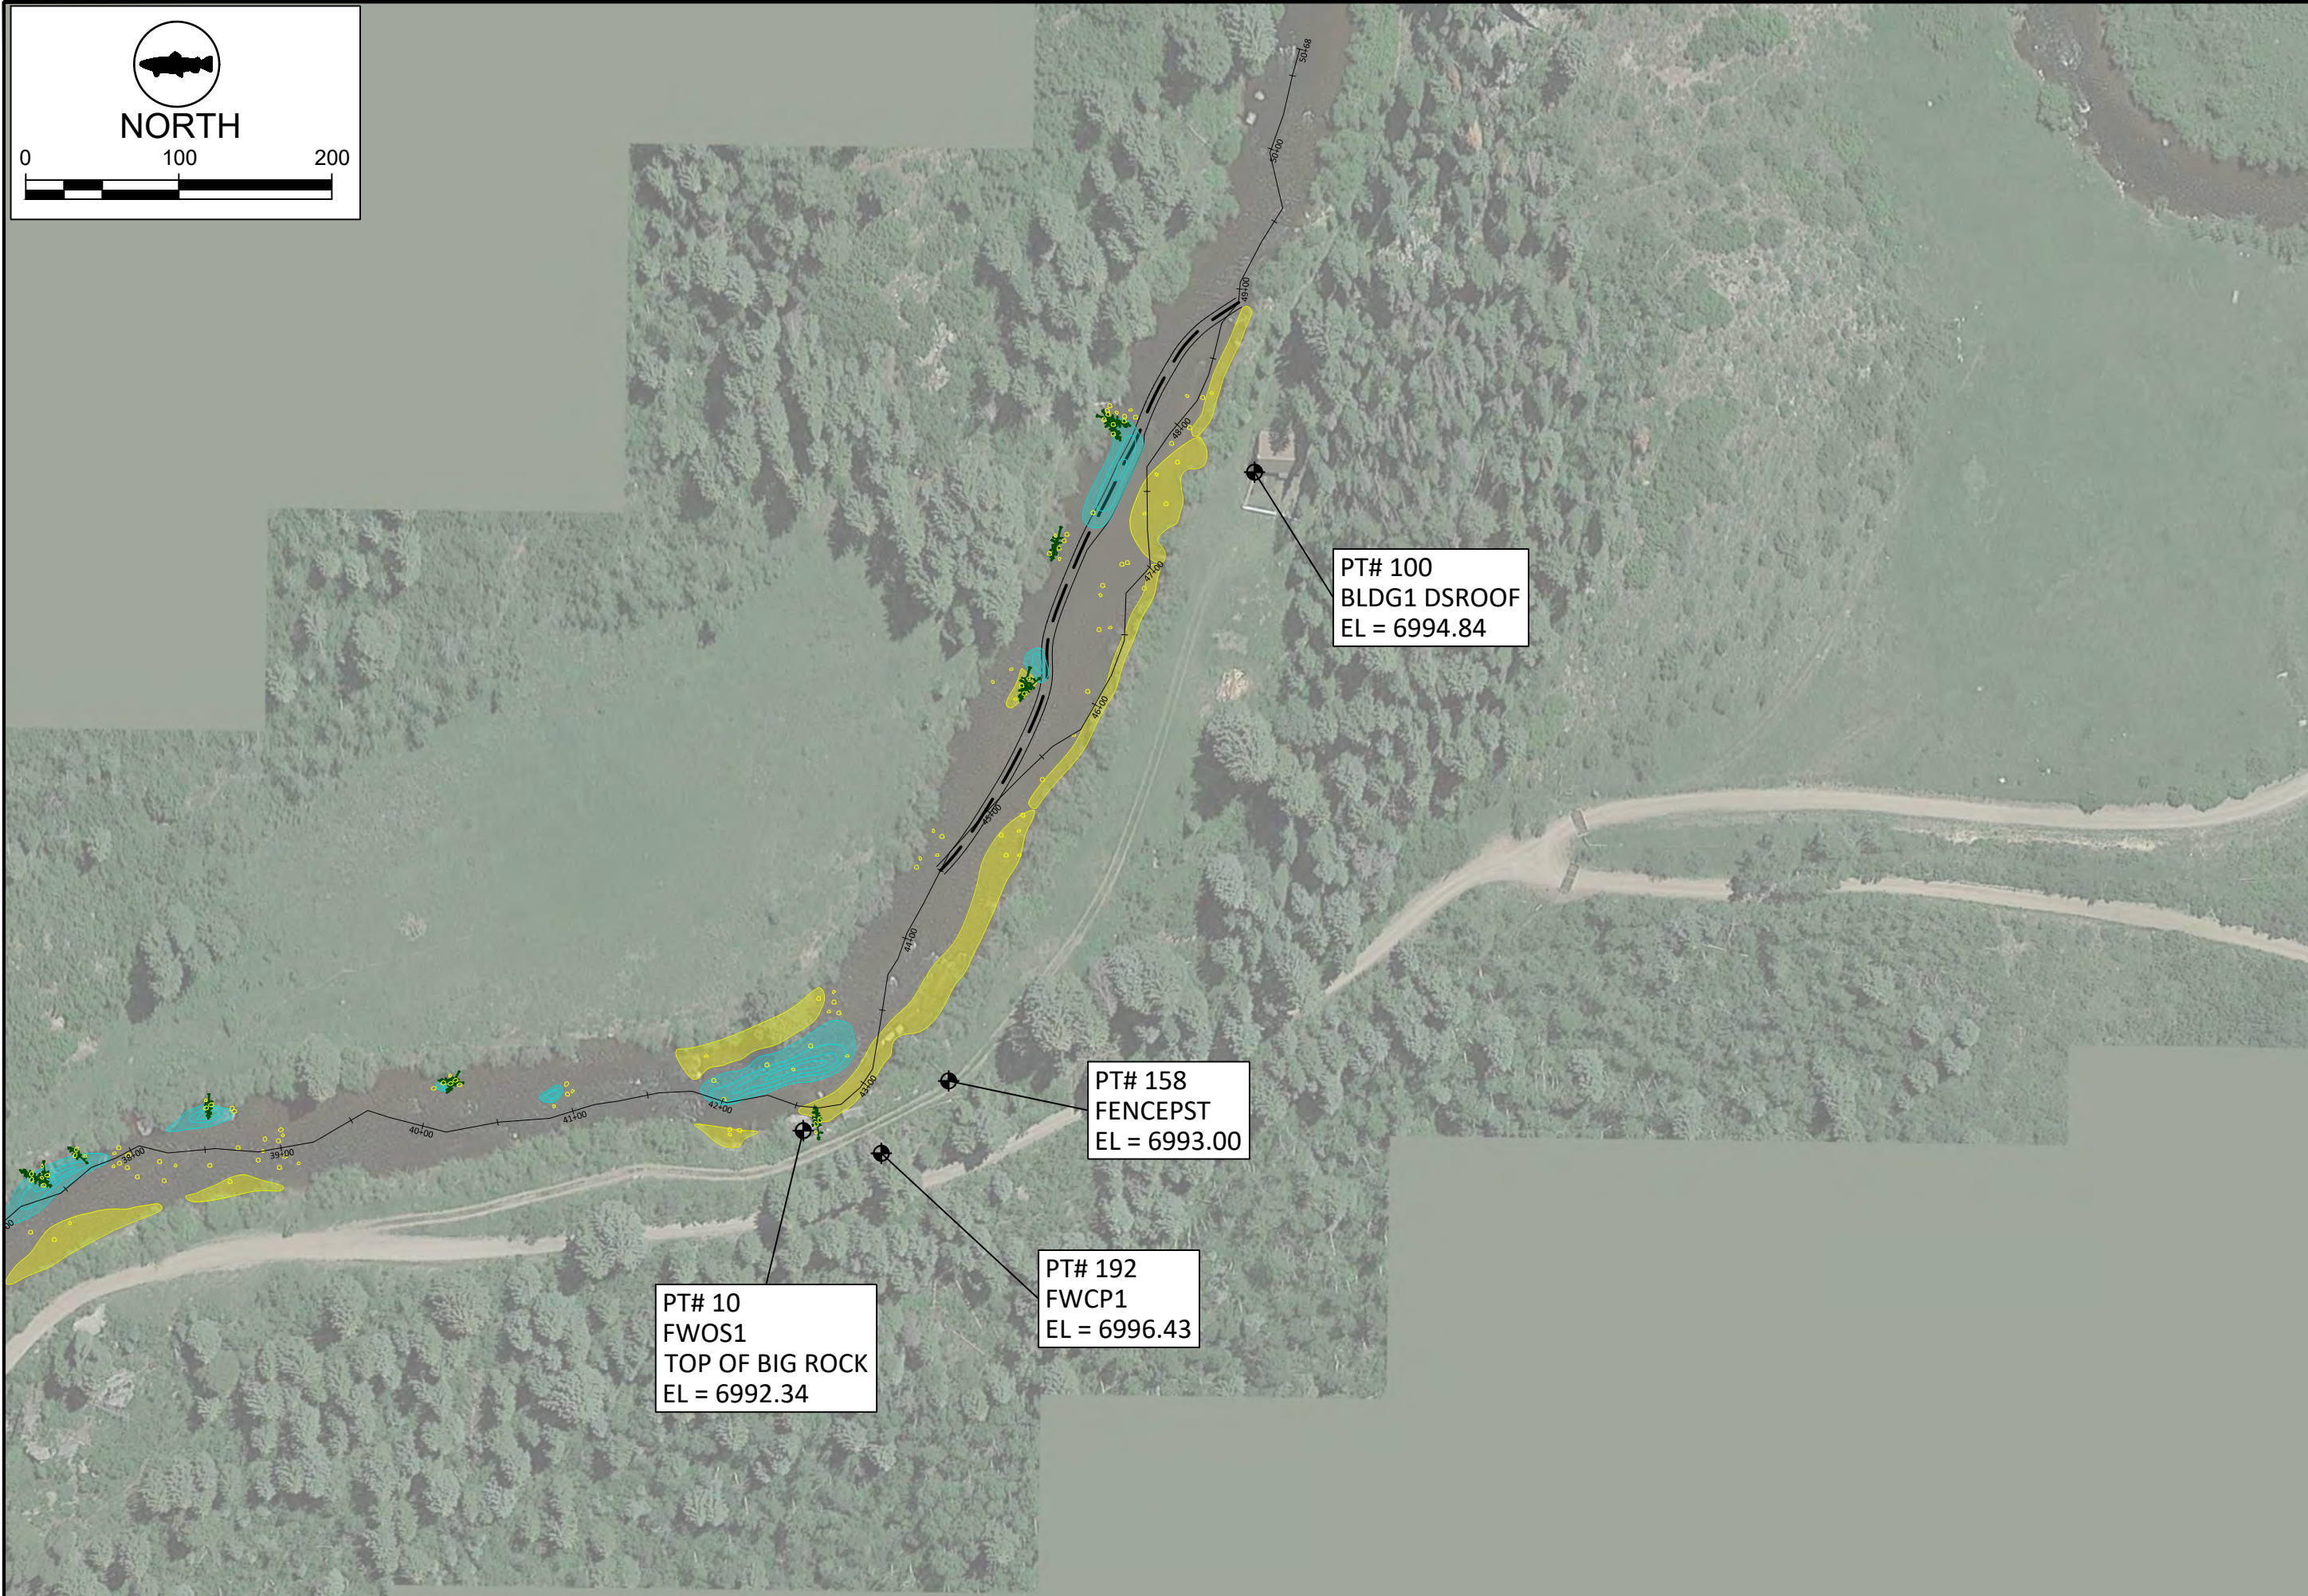


PLEASANT VALLEY
FISH HABITAT
IMPROVEMENT PROJECT
ROUTT COUNTY, CO

CONTROL POINT
MAP

CP
DATE: OCT. 2021

C:\Users\Owner\Desktop\From Server\298-101 YSICT Pleasant Valley\Data_General\CAD\PLEASANT VALLEY P&P050621.dwg8/16/2021

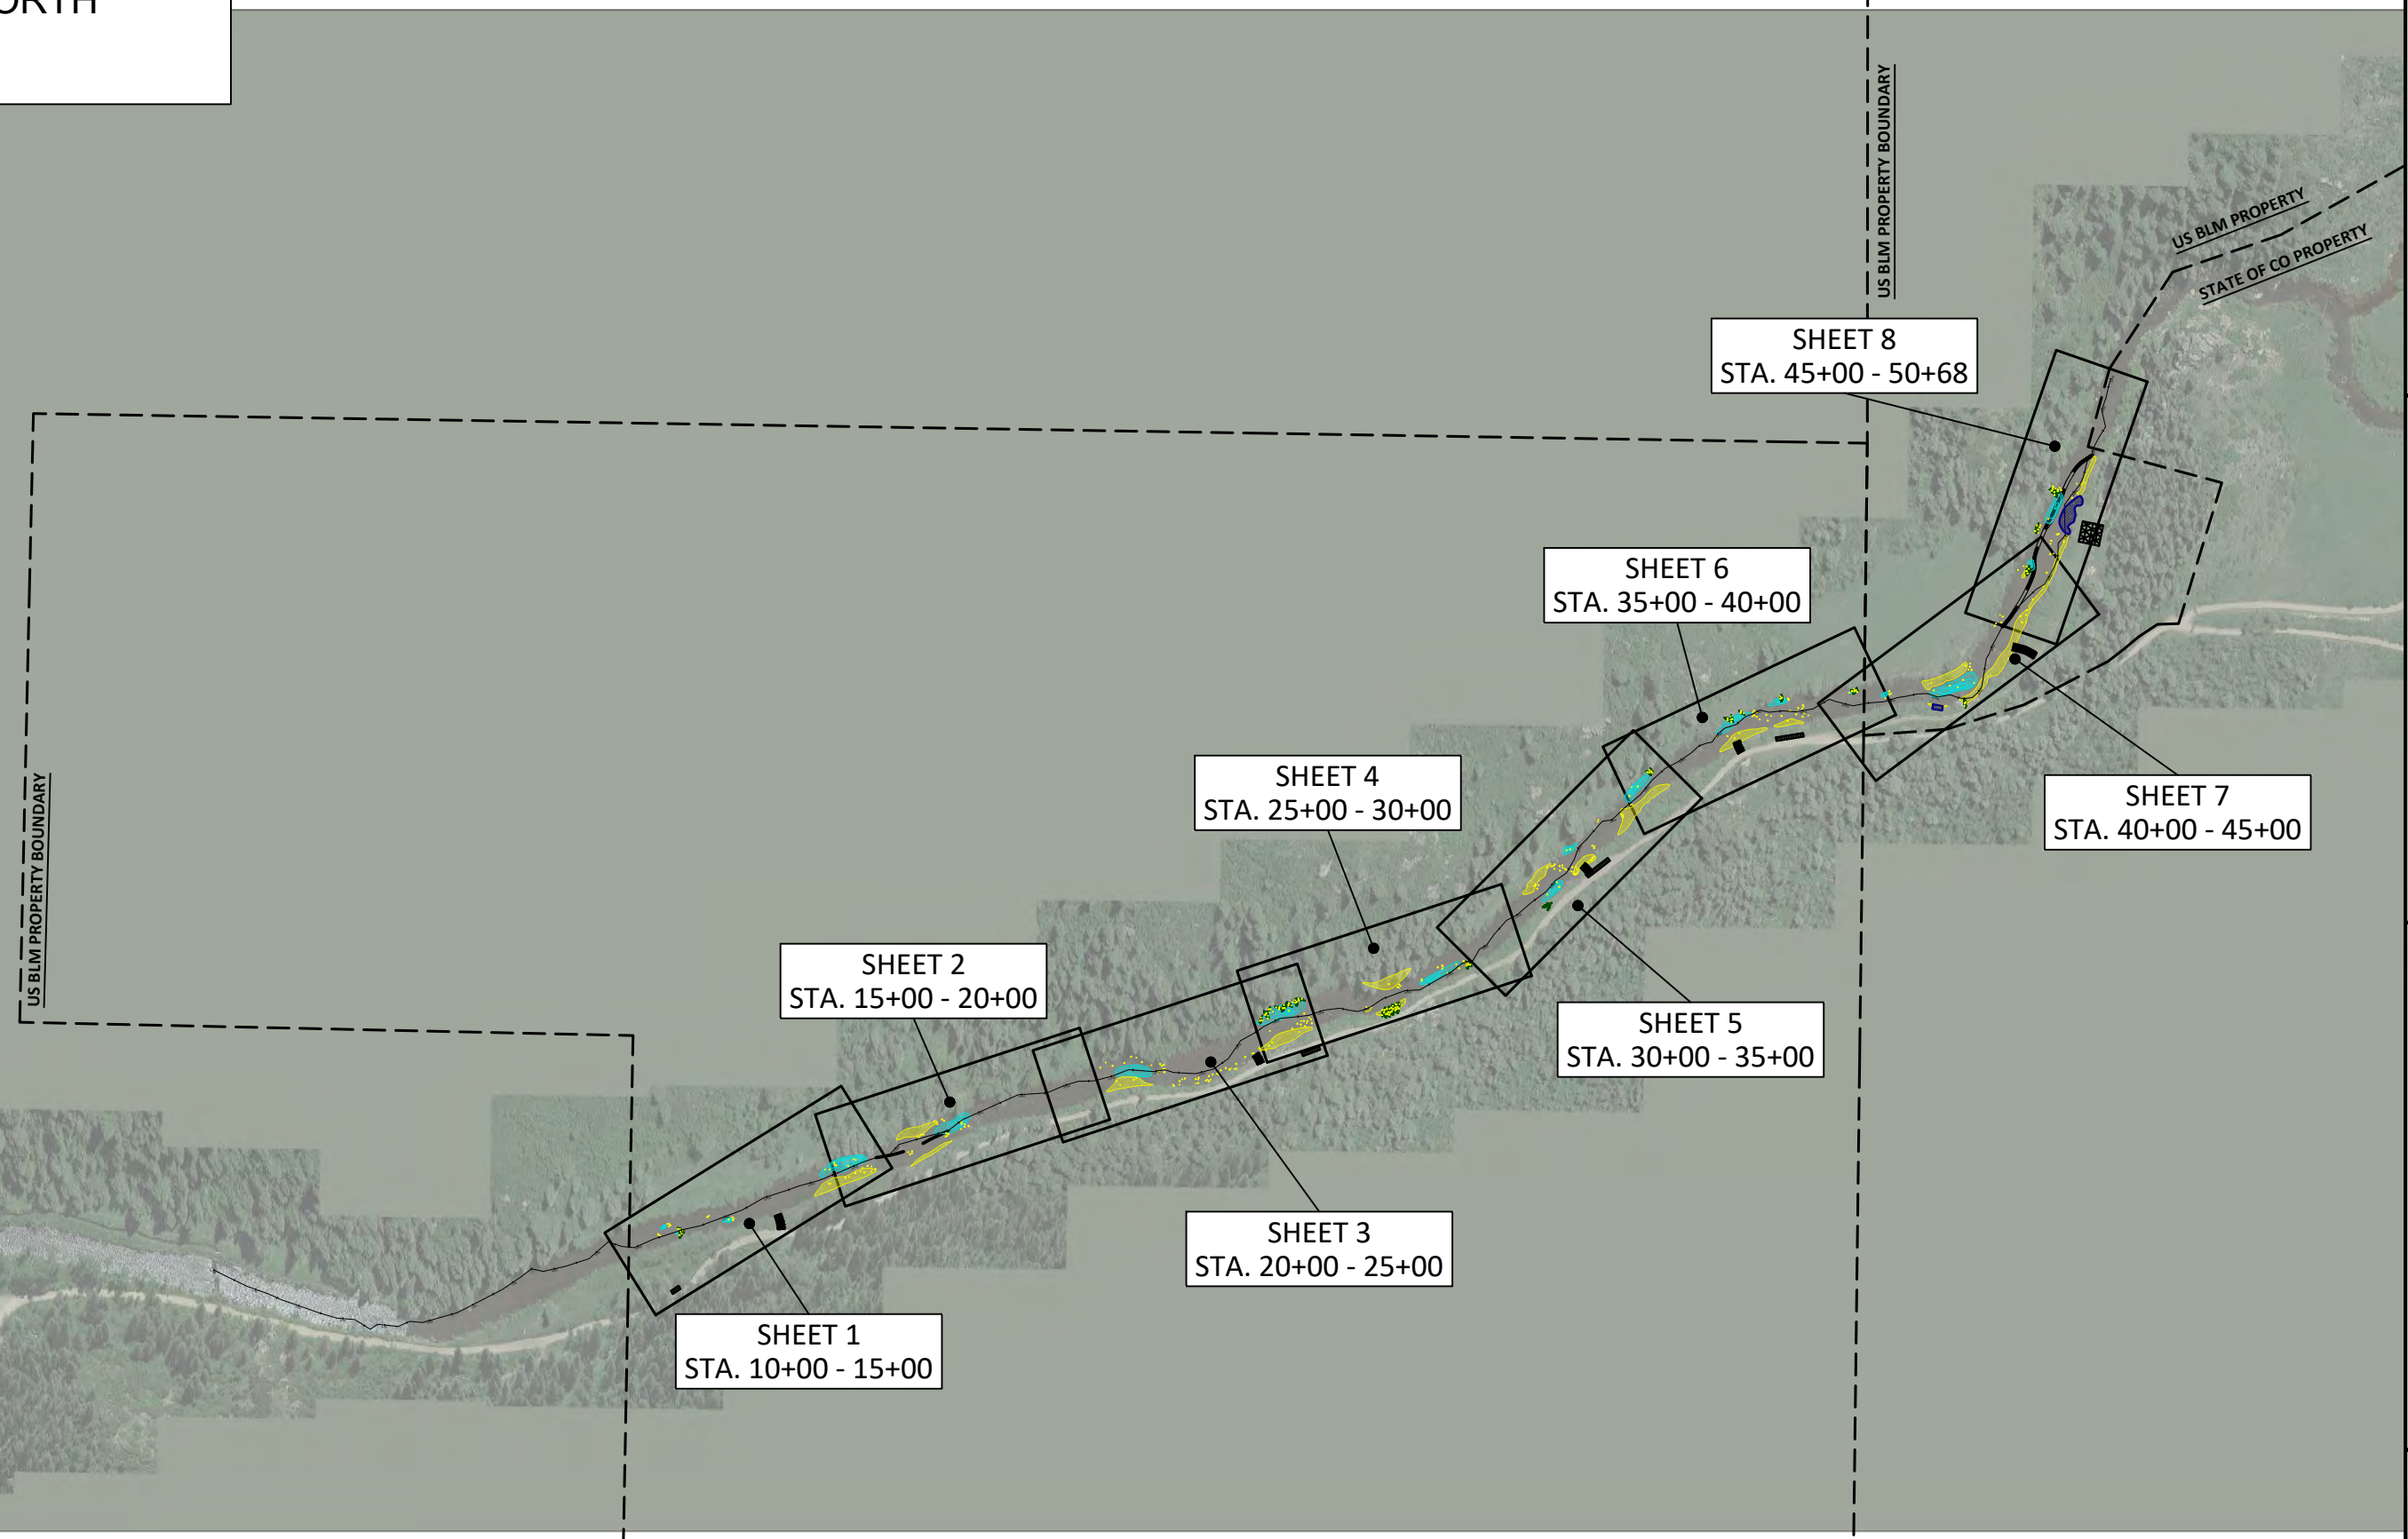


PLEASANT VALLEY
FISH HABITAT
IMPROVEMENT PROJECT
ROUTT COUNTY, CO

SHEET LOCATOR
KEY MAP



KM
DATE: OCT. 2021

C:\Users\Owner\Desktop\From Server\298-101 YSICT Pleasant Valley\Data_General\Valley\CAD\PLEASANT VALLEY P&P050621.dwg8/16/2021

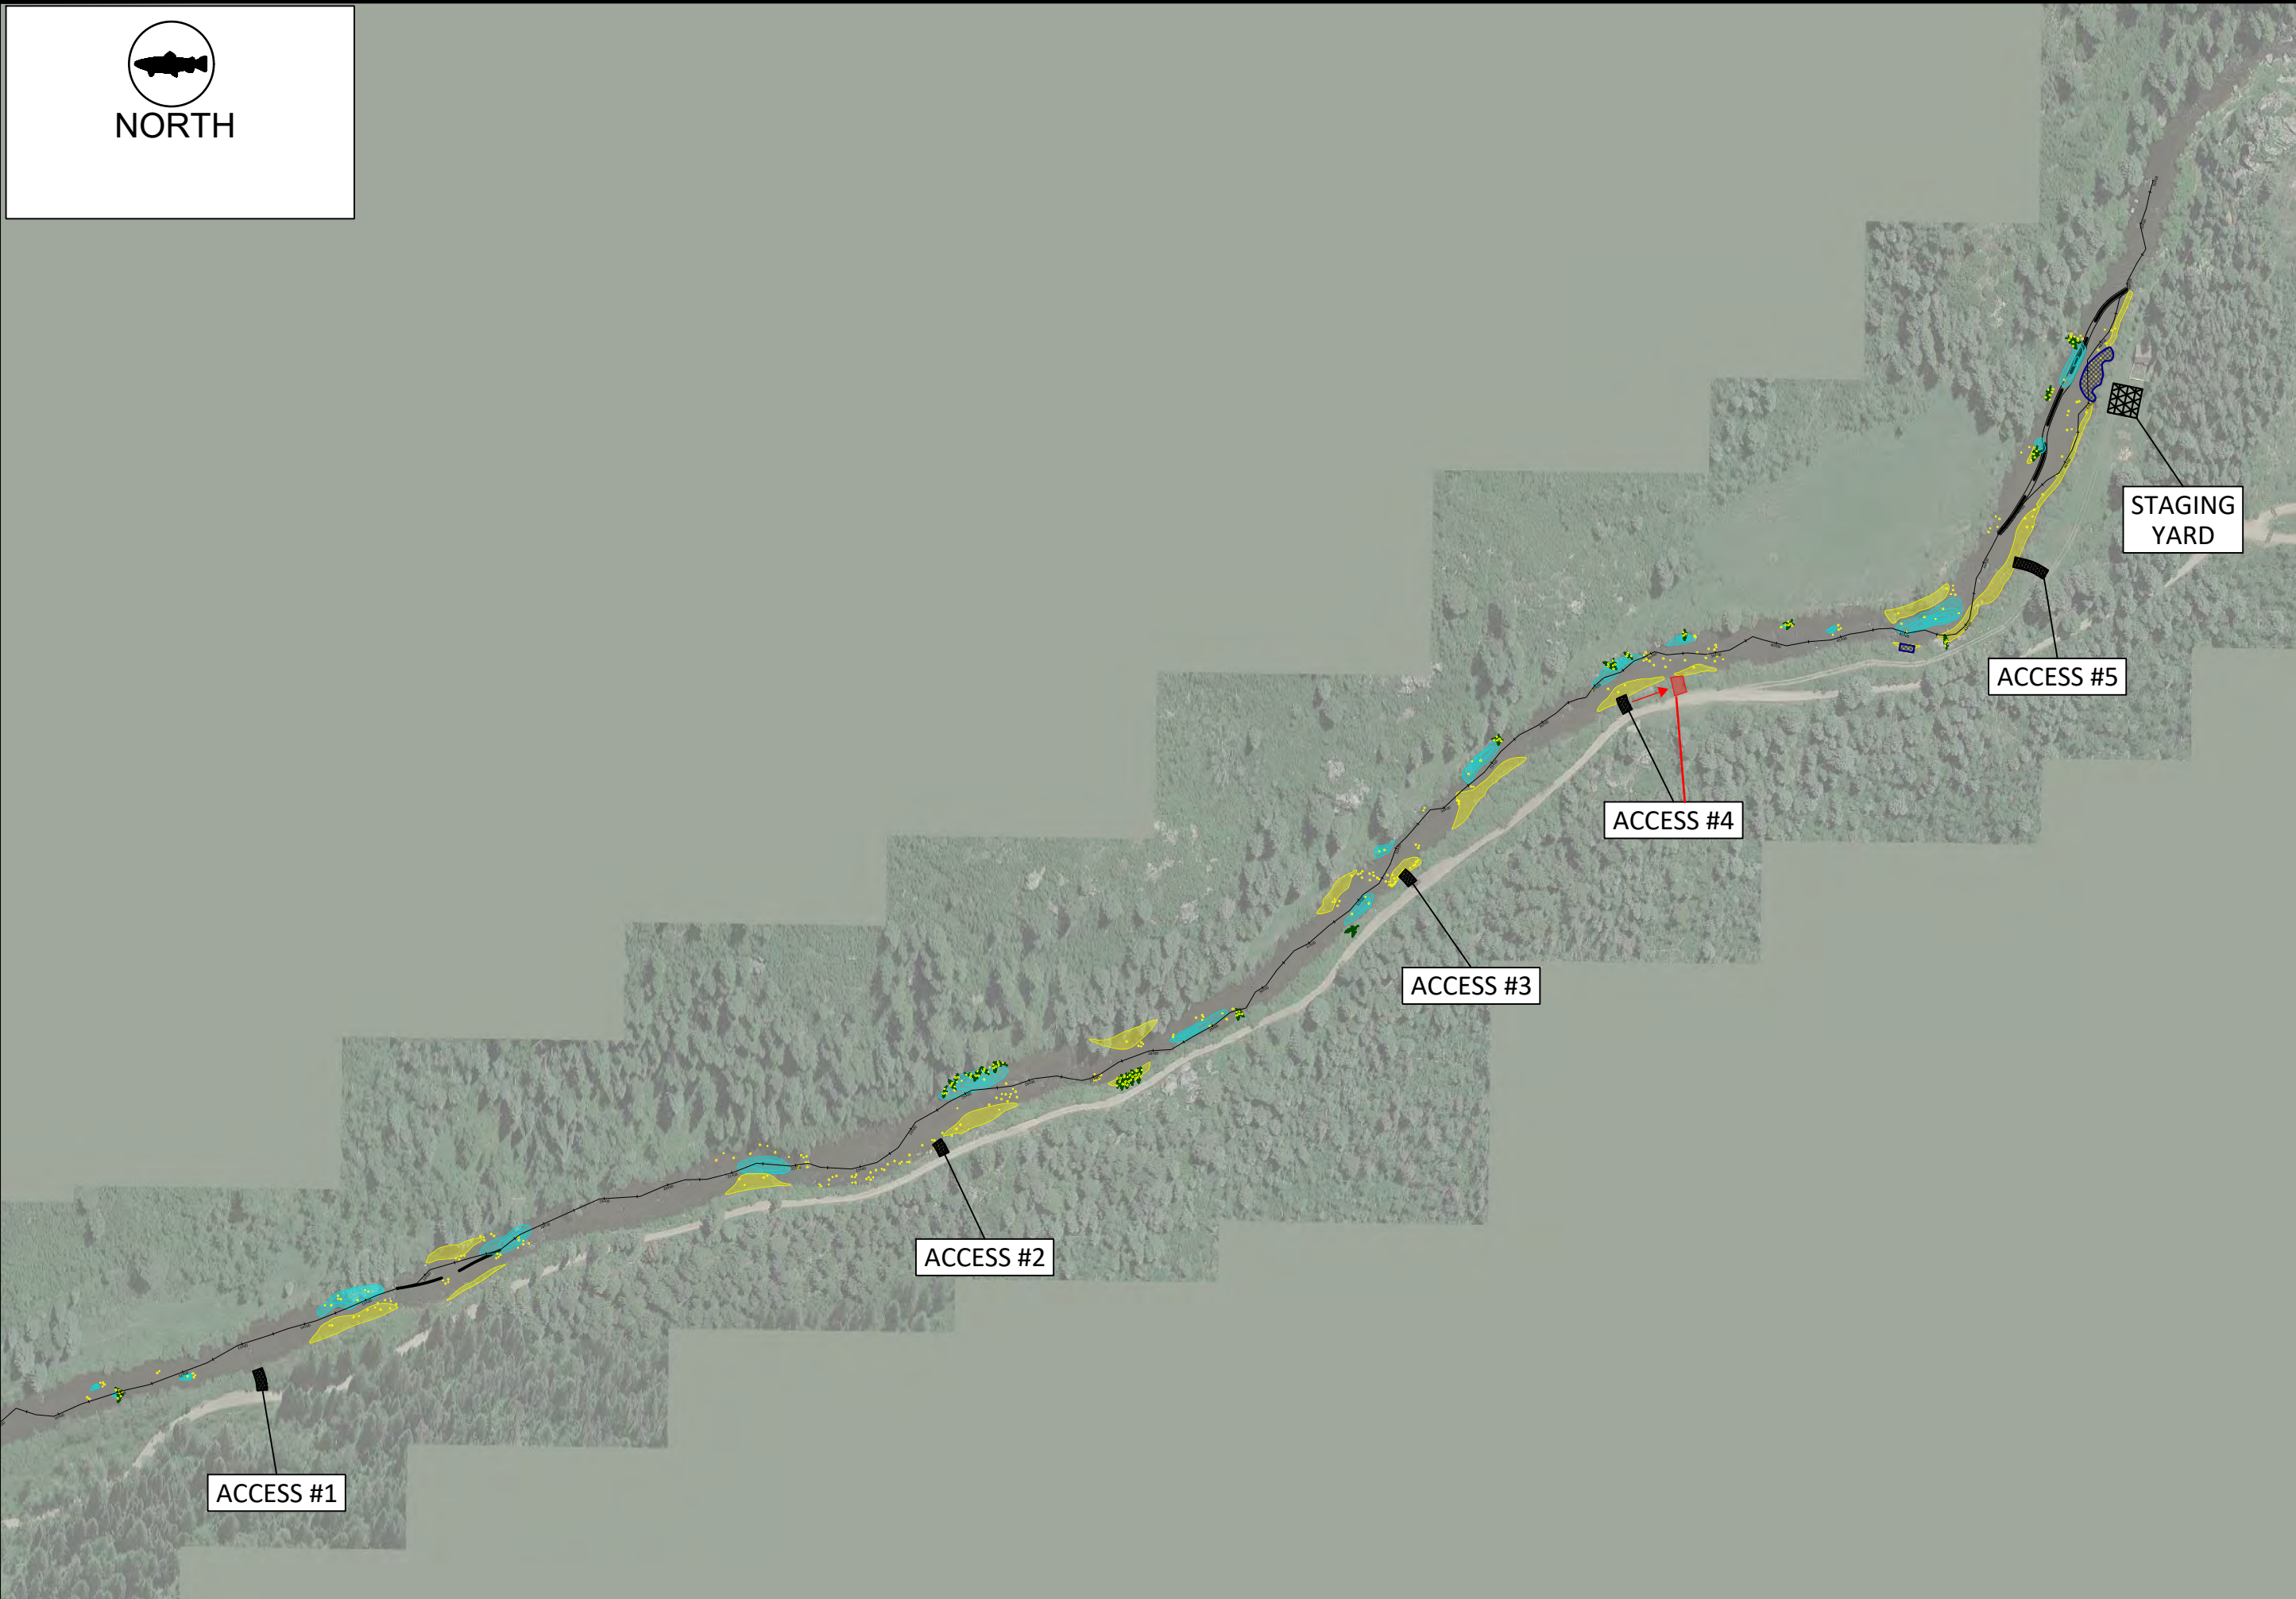

ST DATE: OCT. 2021	STAGING AND ACCESS PLAN	PLEASANT VALLEY FISH HABITAT IMPROVEMENT PROJECT ROUTT COUNTY, CO	  Stillwater Sciences
------------------------------	----------------------------	---	---

C:\Users\Owner\Desktop\From Server\298-101 YSICT Pleasant Valley\Data-General\CAD\PLEASANT VALLEY P&P050621.dwg 8/16/2021

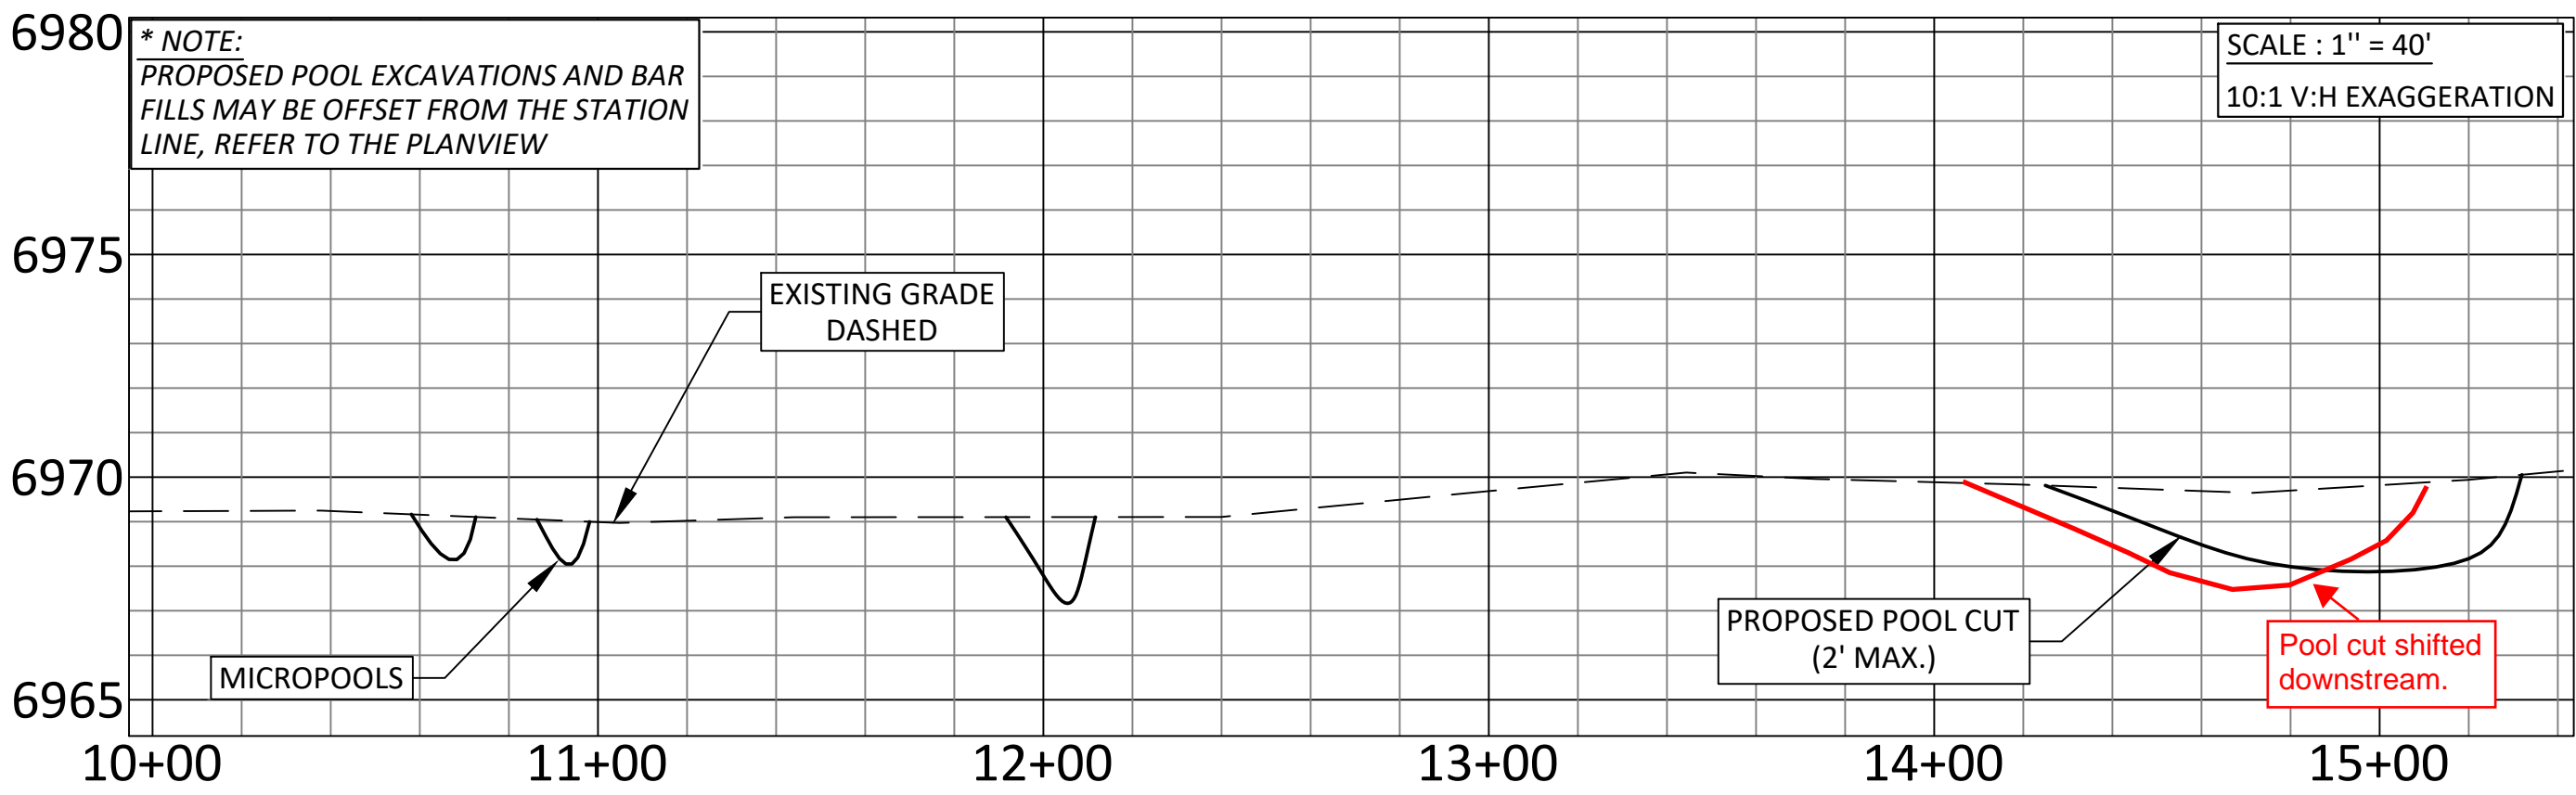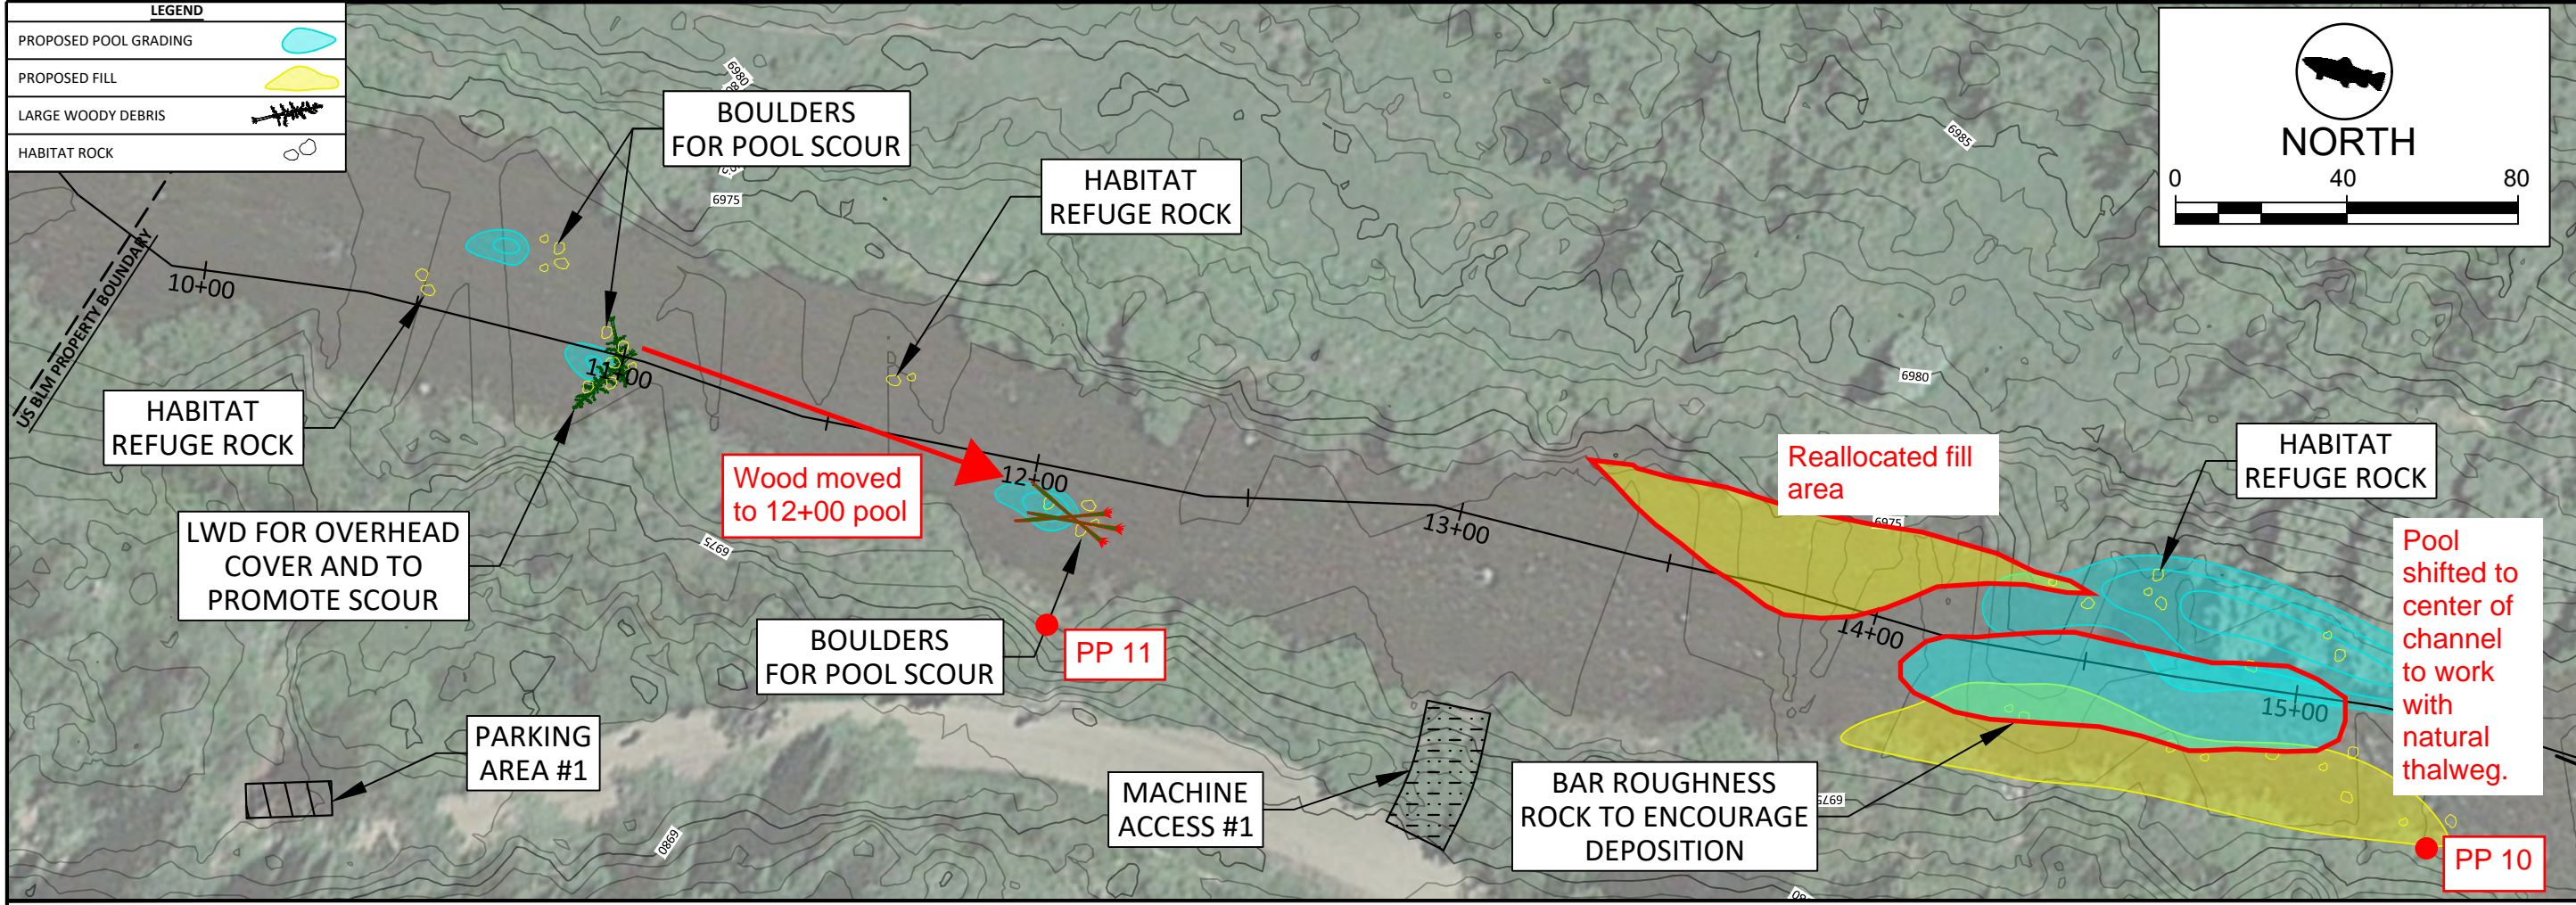



Stullwater Sciences

PLEASANT VALLEY
FISH HABITAT
IMPROVEMENT PROJECT
ROUTT COUNTY, CO

PLAN AND PROFILE SHEET
STA. 10+00 - 15+00

1
DATE: OCT. 2021

C:\Users\Owner\Desktop\From Server\298-101 YSICT Pleasant Valley\Data-General\Valley\CAD\PLEASANT VALLEY P&P050621.dwg8/16/2021

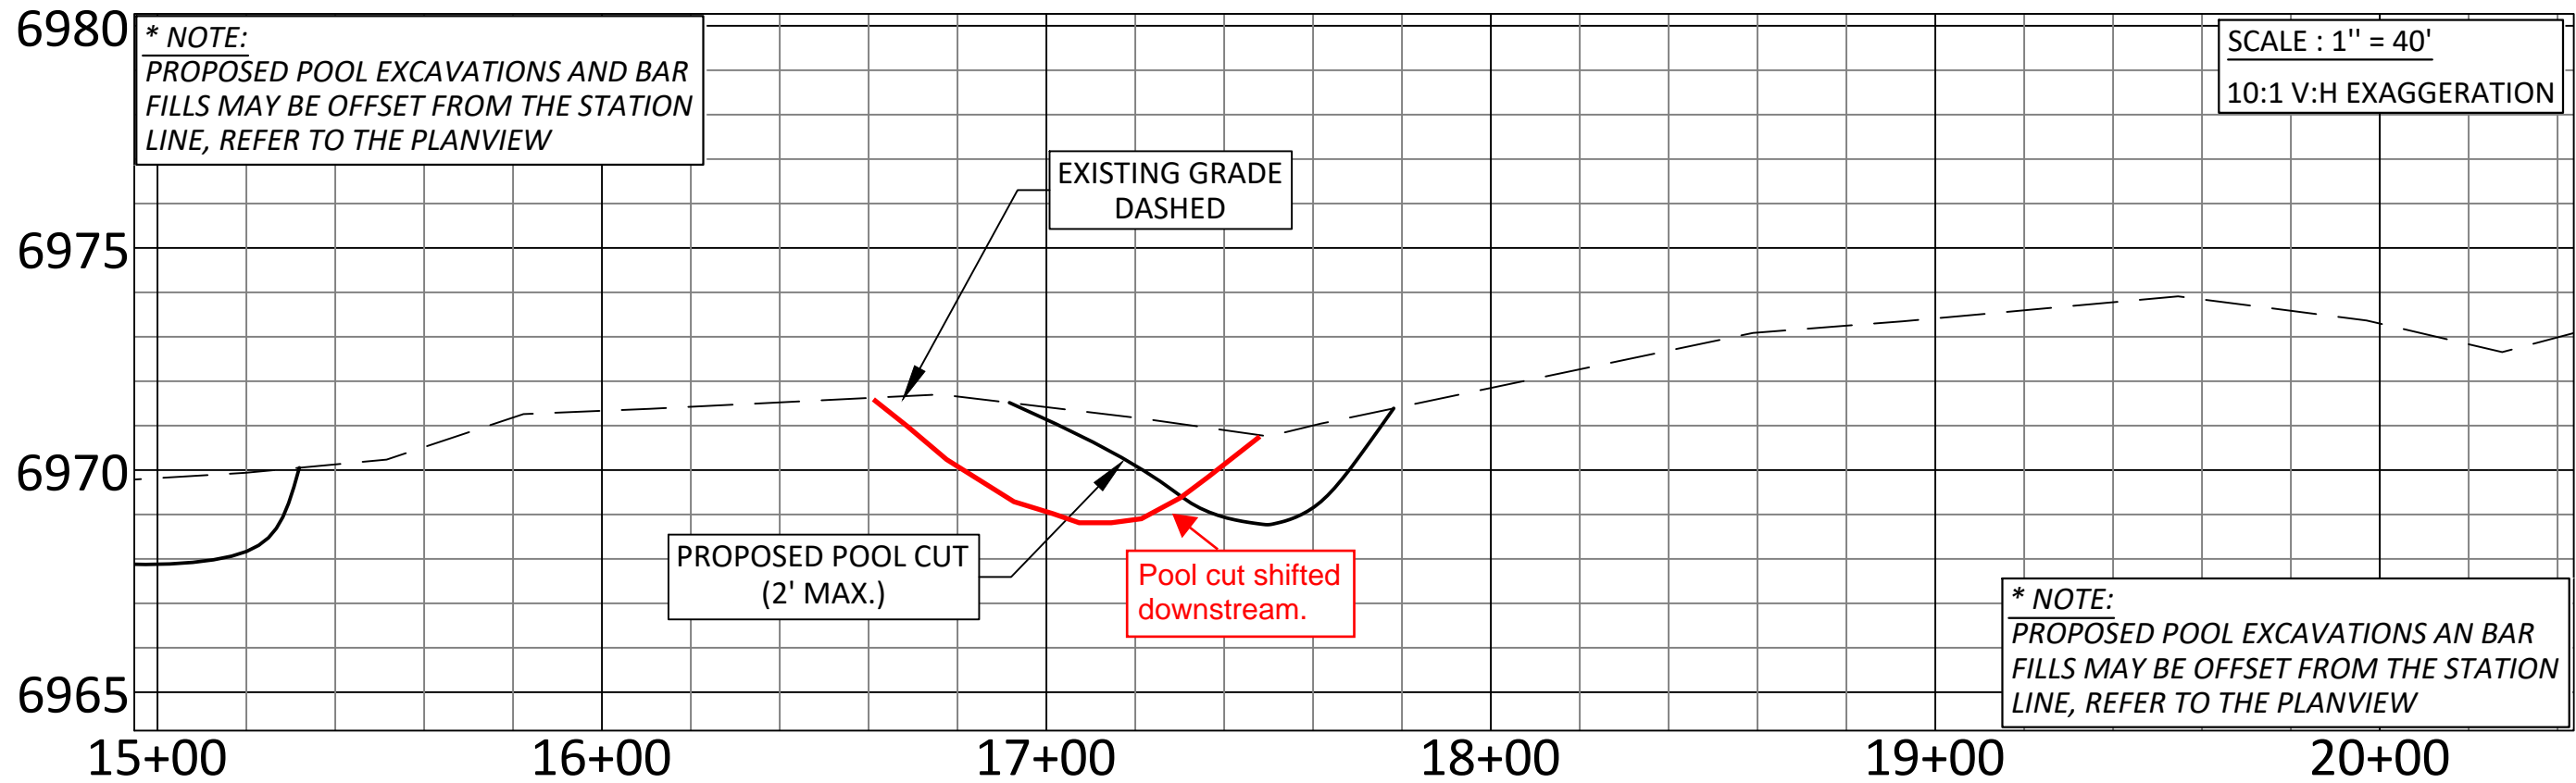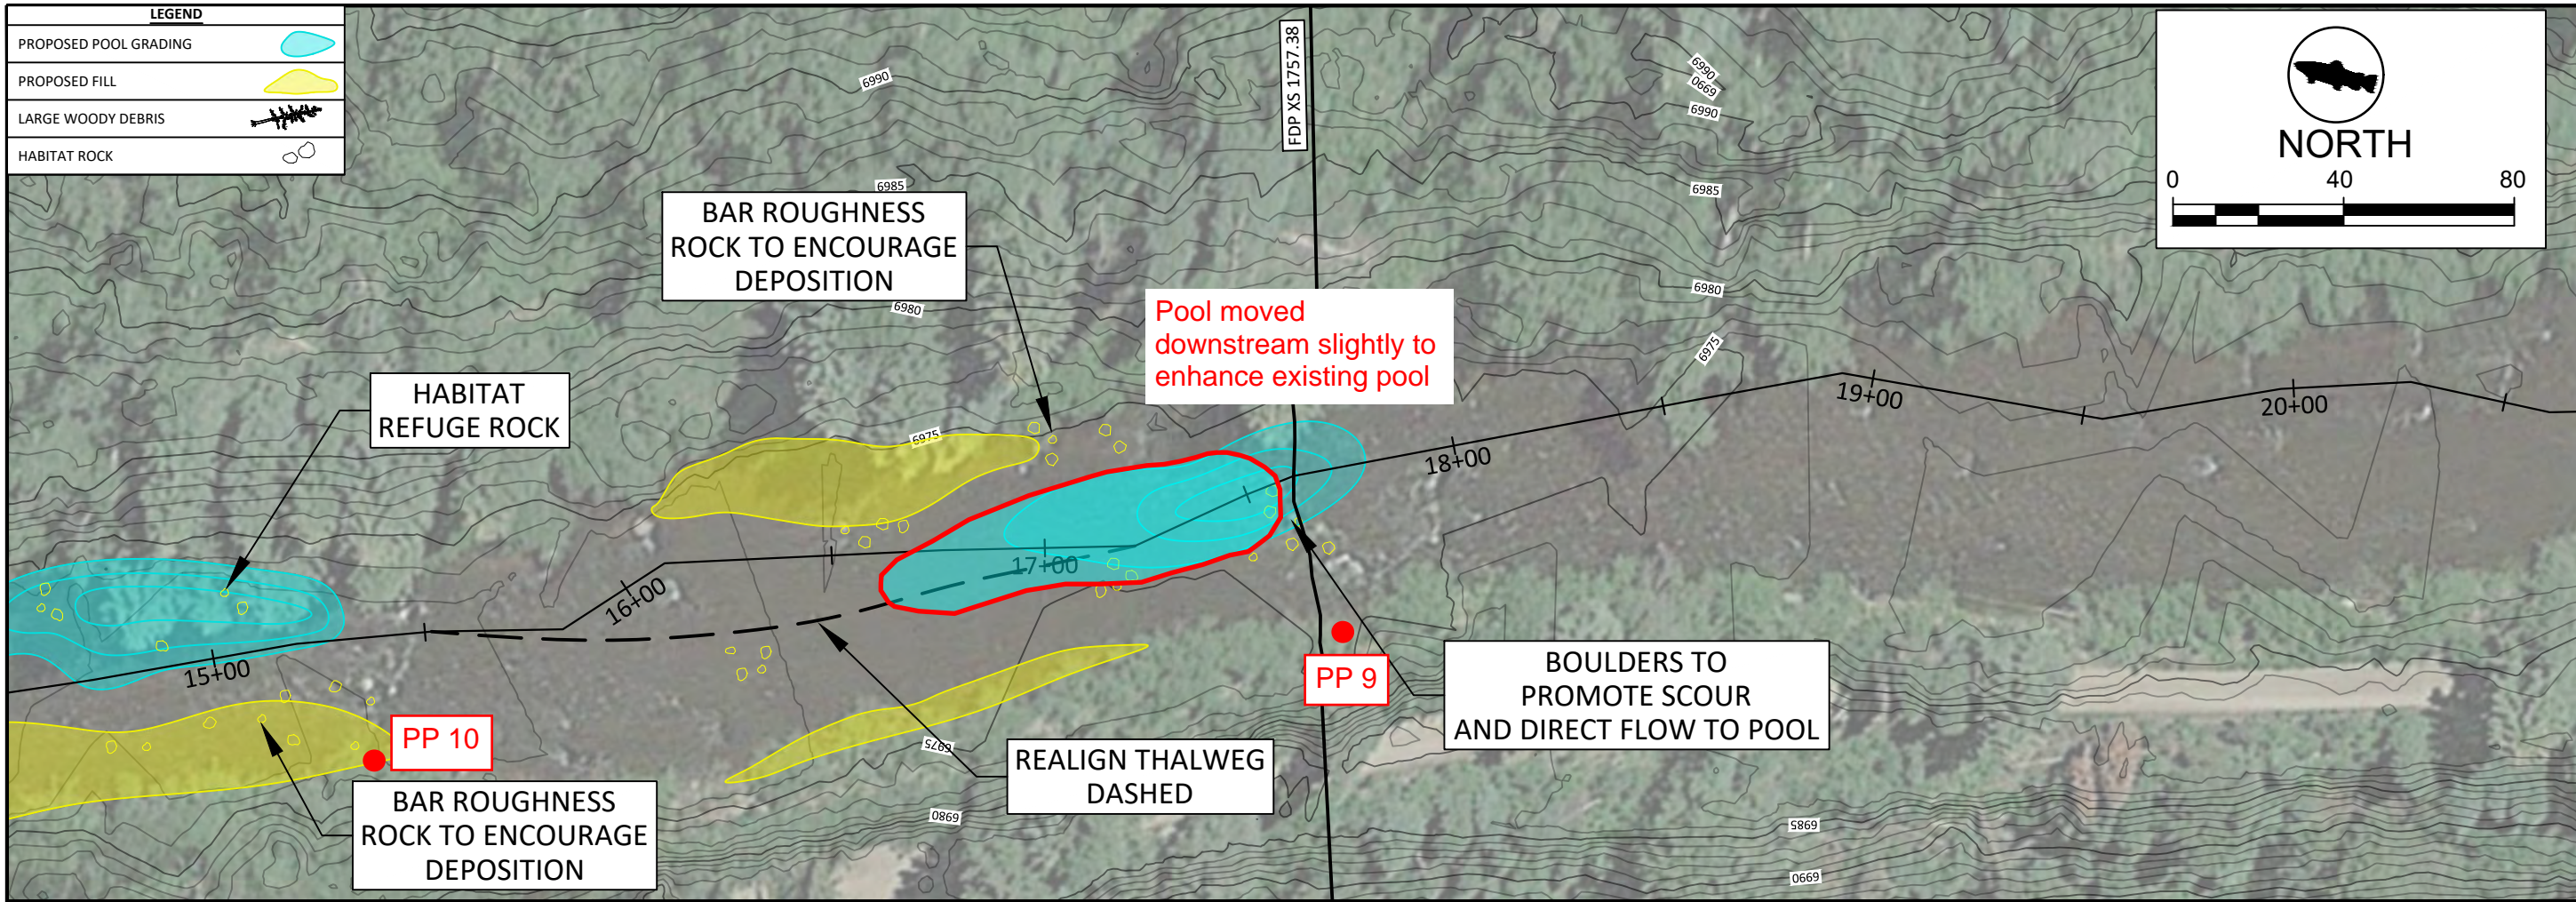



PLEASANT VALLEY
FISH HABITAT
IMPROVEMENT PROJECT
ROUTT COUNTY, CO

PLAN AND PROFILE SHEET
STA. 15+00 - 20+00

2
DATE: OCT. 2021



C:\Users\Owner\Desktop\From Server\298-101 YSICT Pleasant Valley\Data-General\CAD\PLEASANT VALLEY P&P050621.dwg8/16/2021

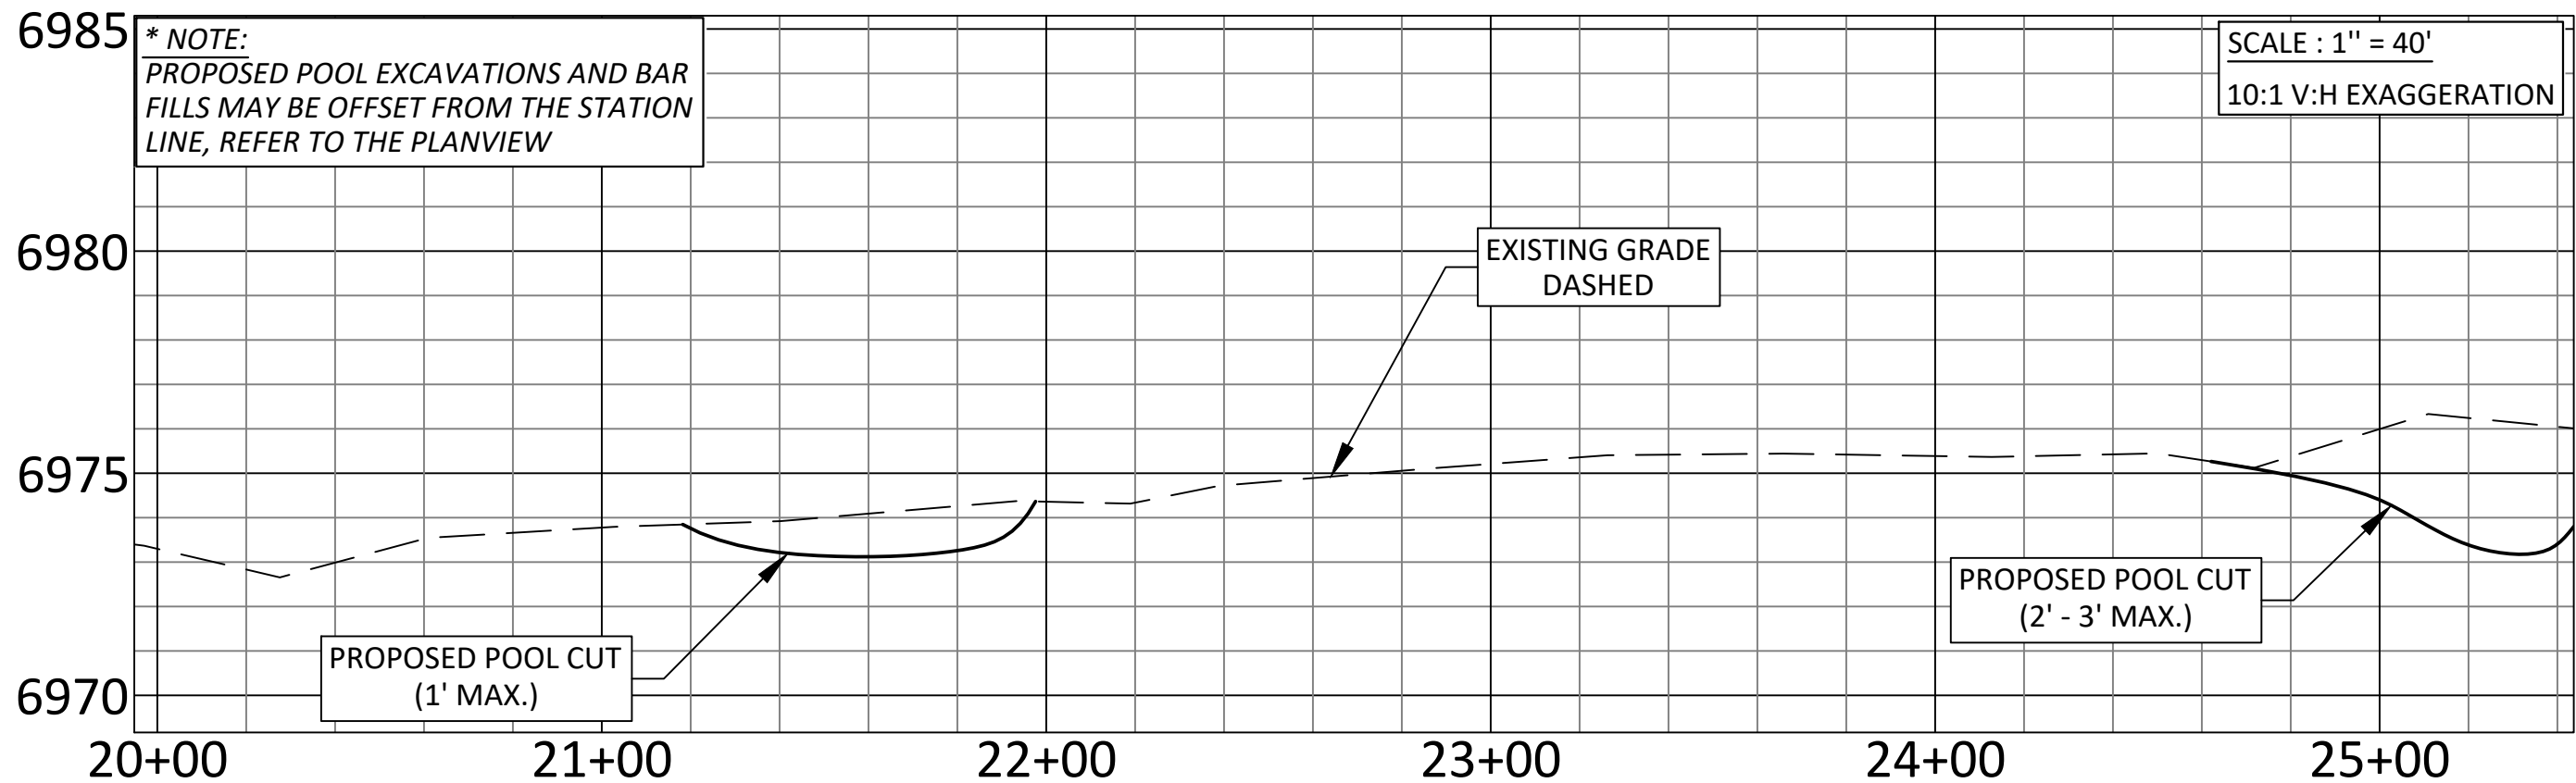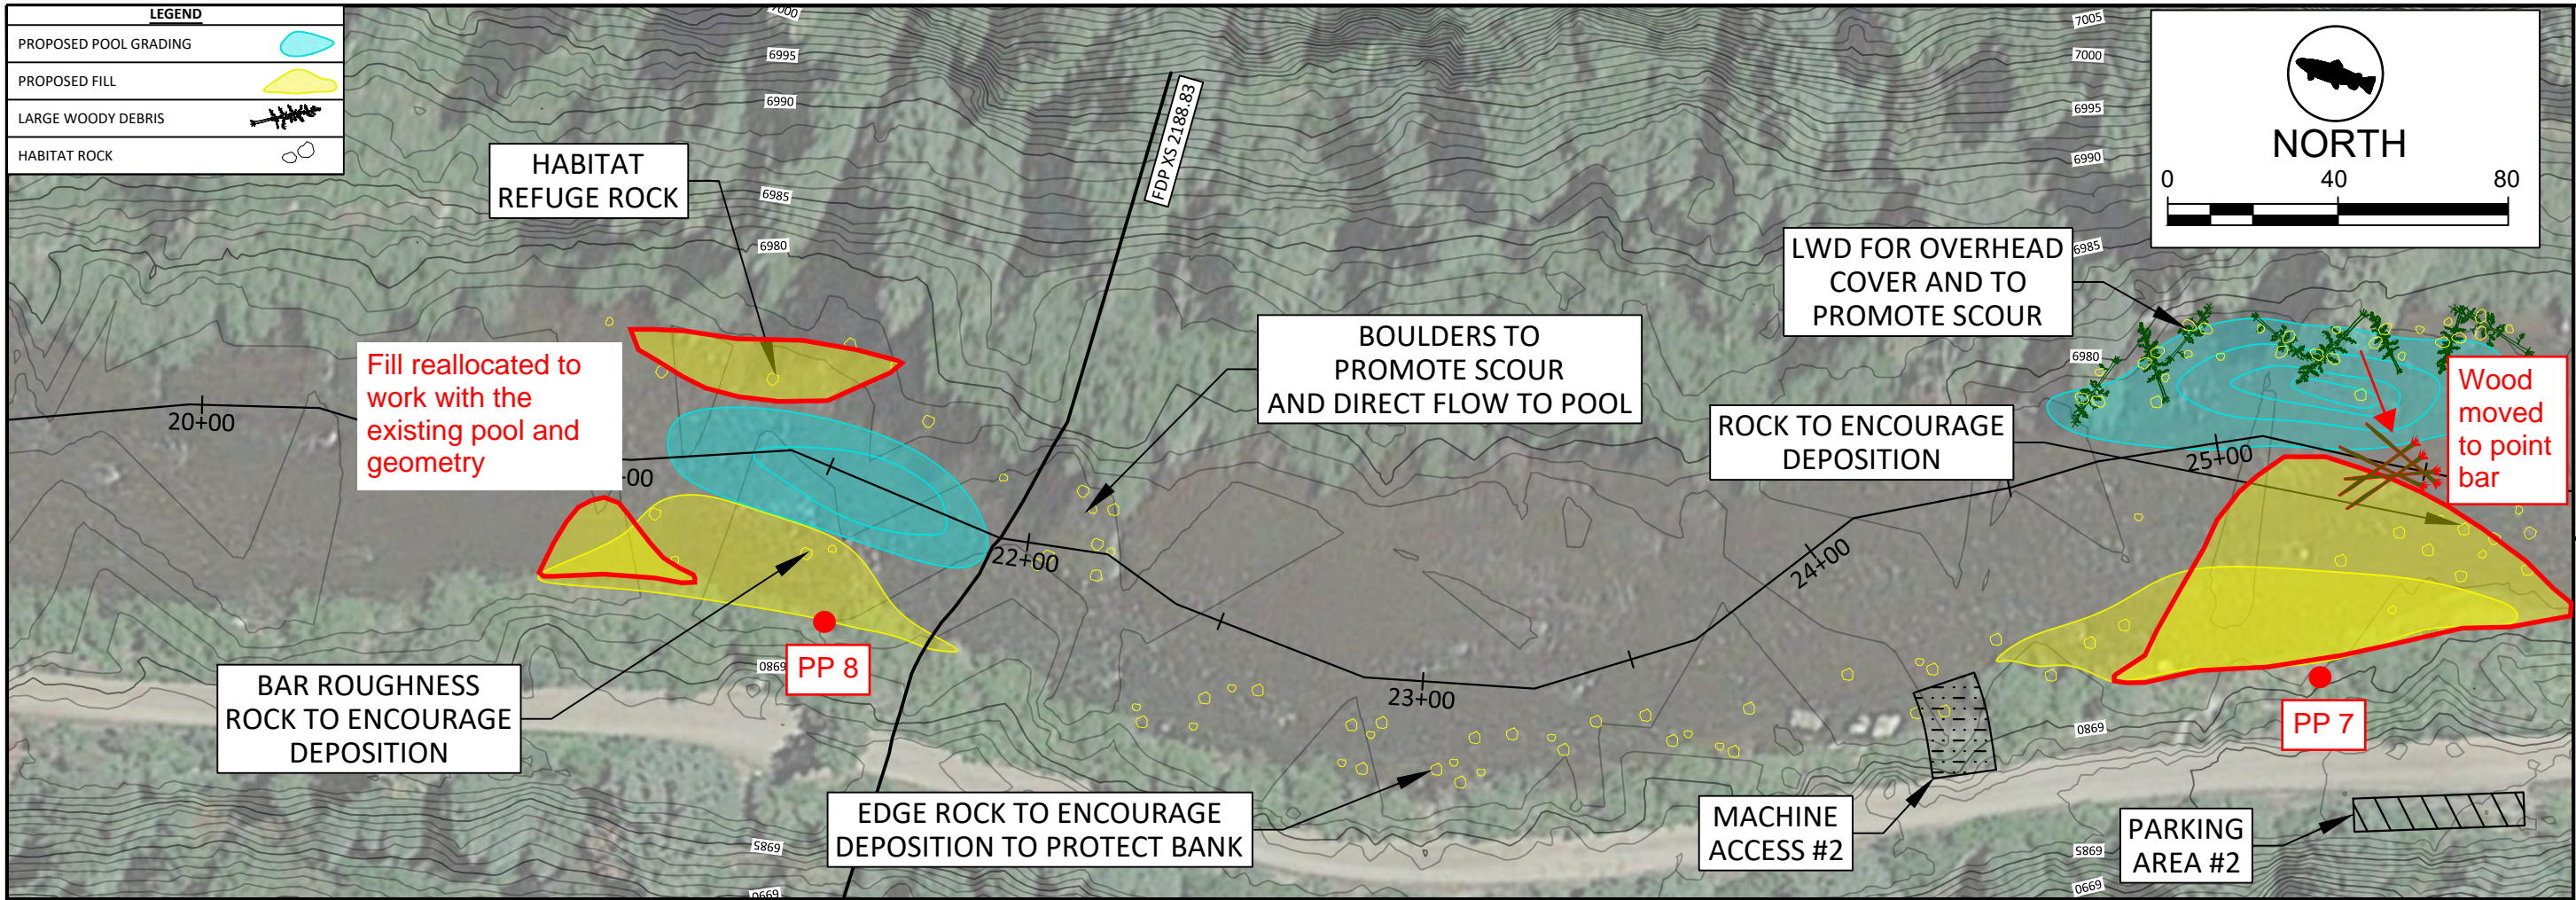



Stullwater Sciences

PLEASANT VALLEY
FISH HABITAT
IMPROVEMENT PROJECT
ROUTT COUNTY, CO



PLAN AND PROFILE SHEET
STA. 20+00 - 25+00

3
DATE: OCT. 2021

C:\Users\Owner\Desktop\From Server\298-101 YSICT Pleasant Valley\Data-General\CAD\PLEASANT VALLEY P&P050621.dwg8/16/2021

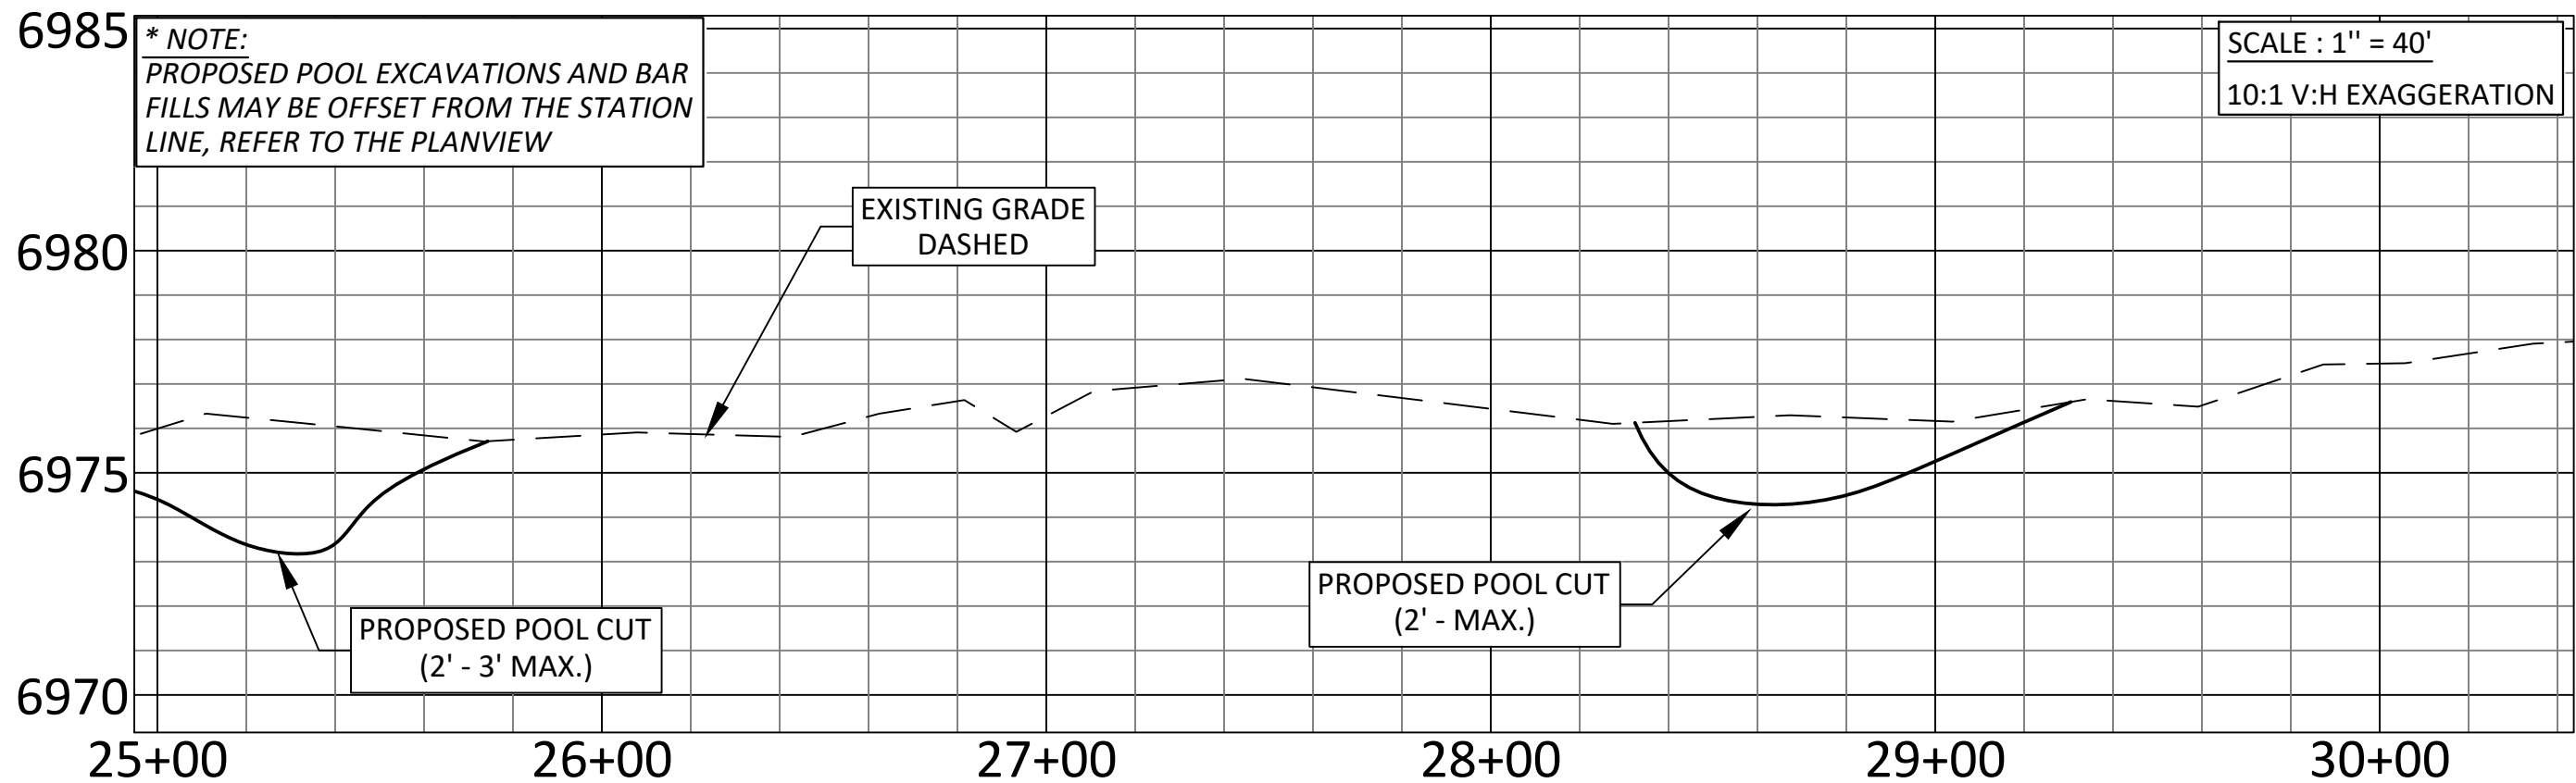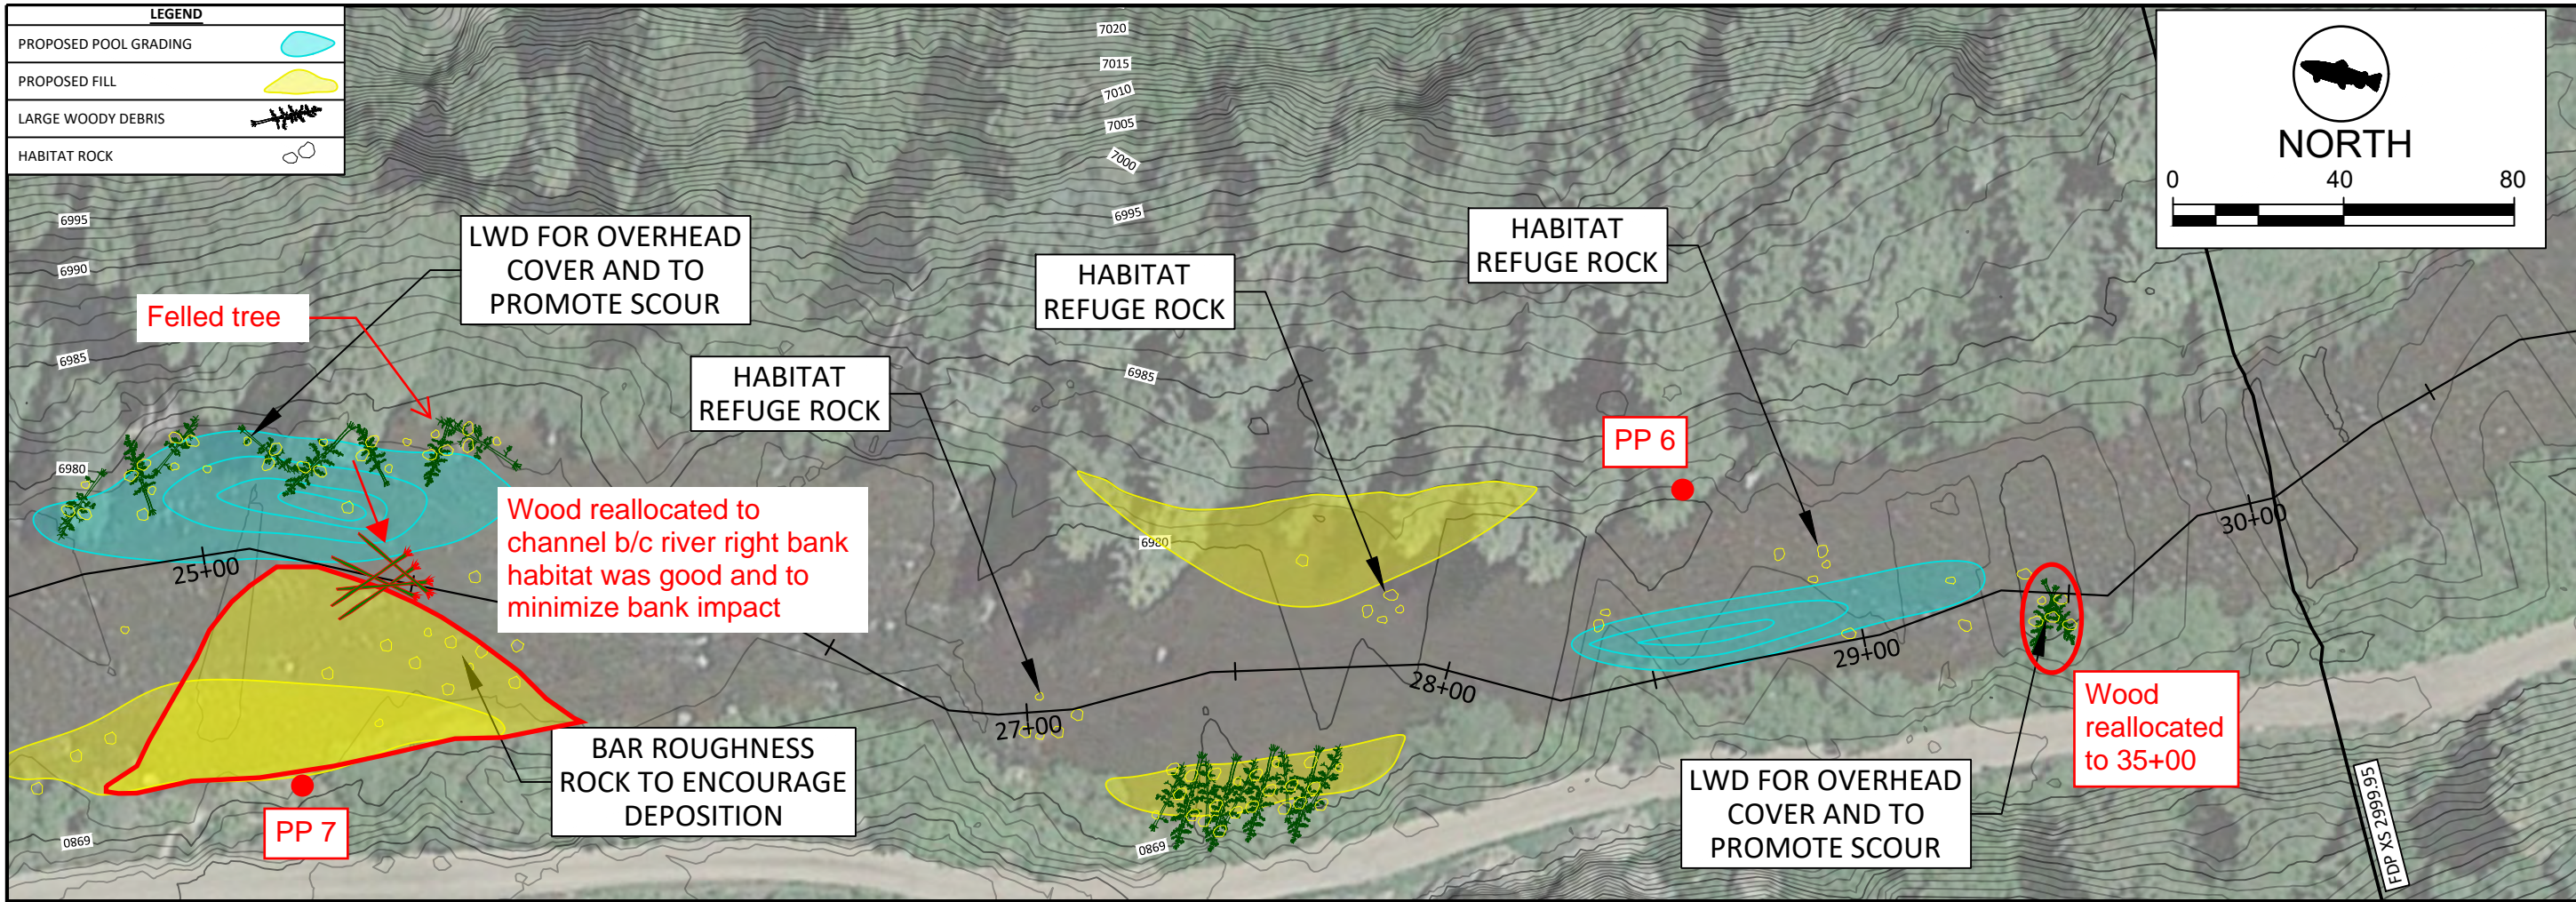

C:\Users\Owner\Desktop\From Server\298-101 YSICT Pleasant Valley\Data-General\Valley\CAD\PLEASANT VALLEY P&P050621.dwg8/16/2021

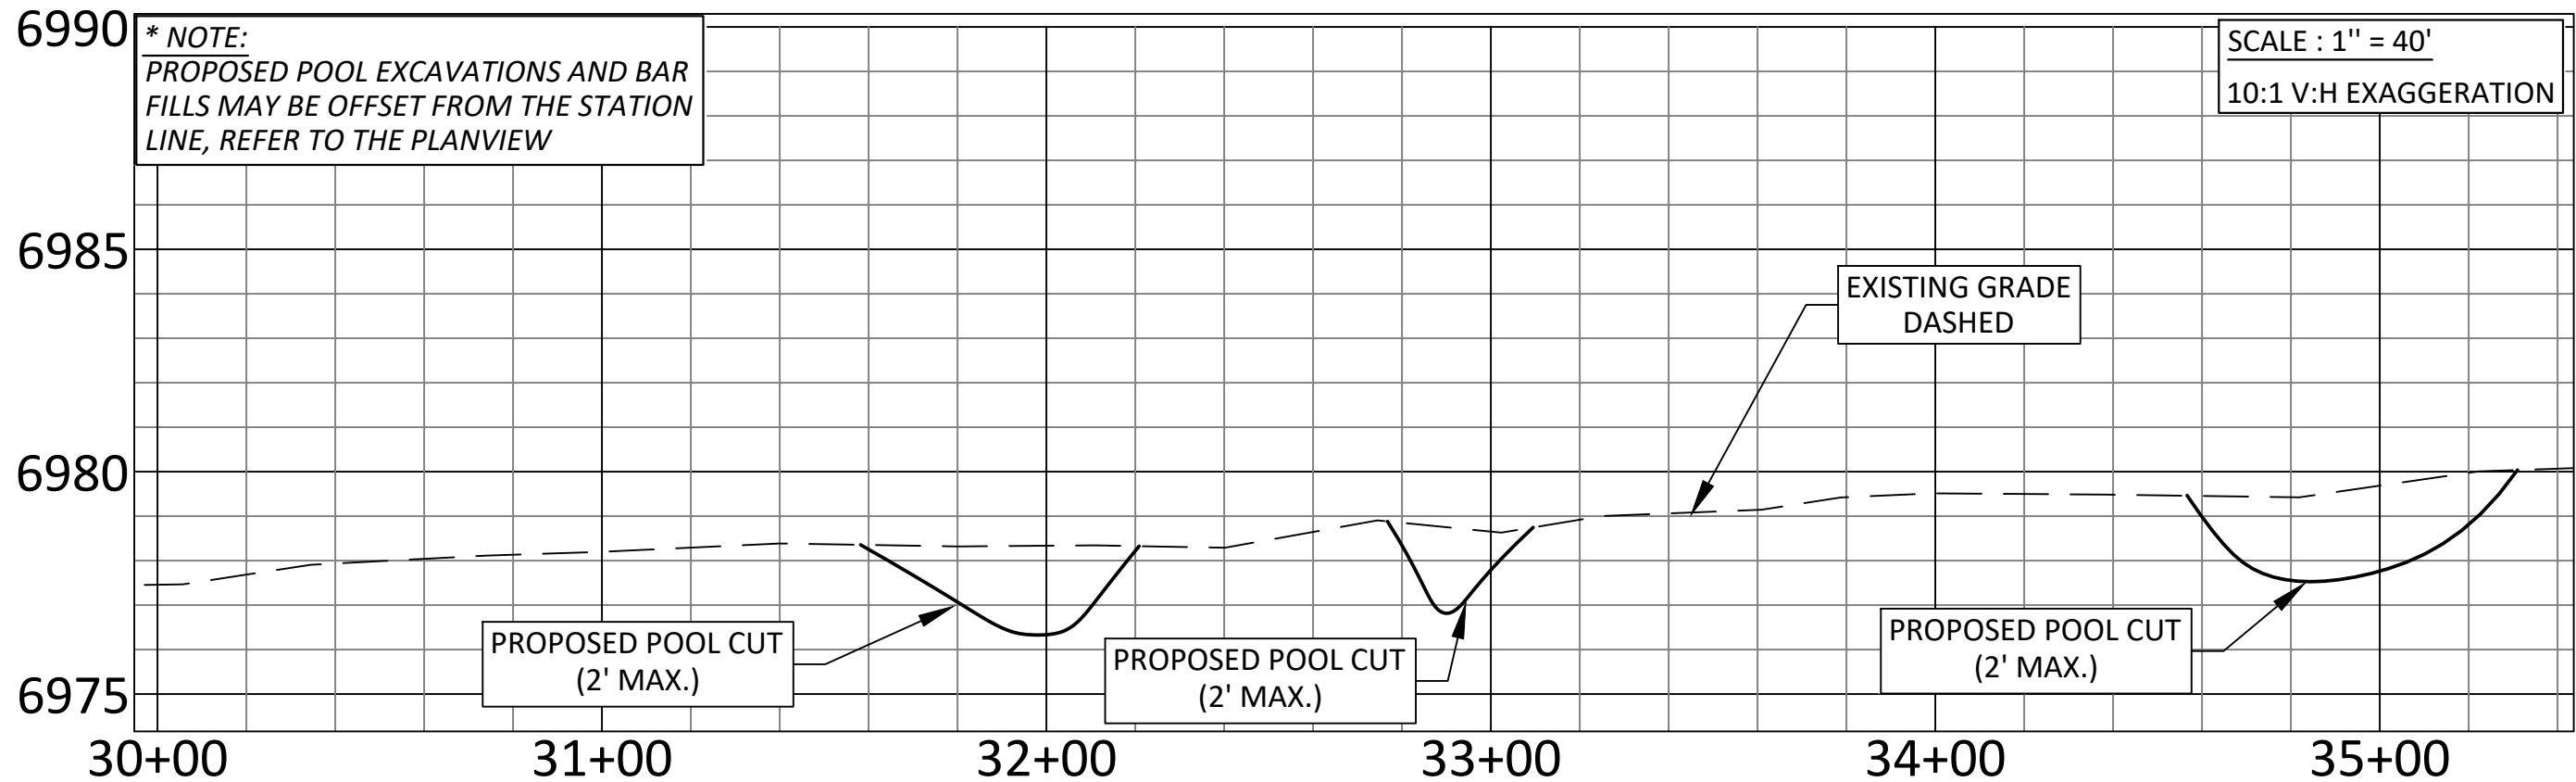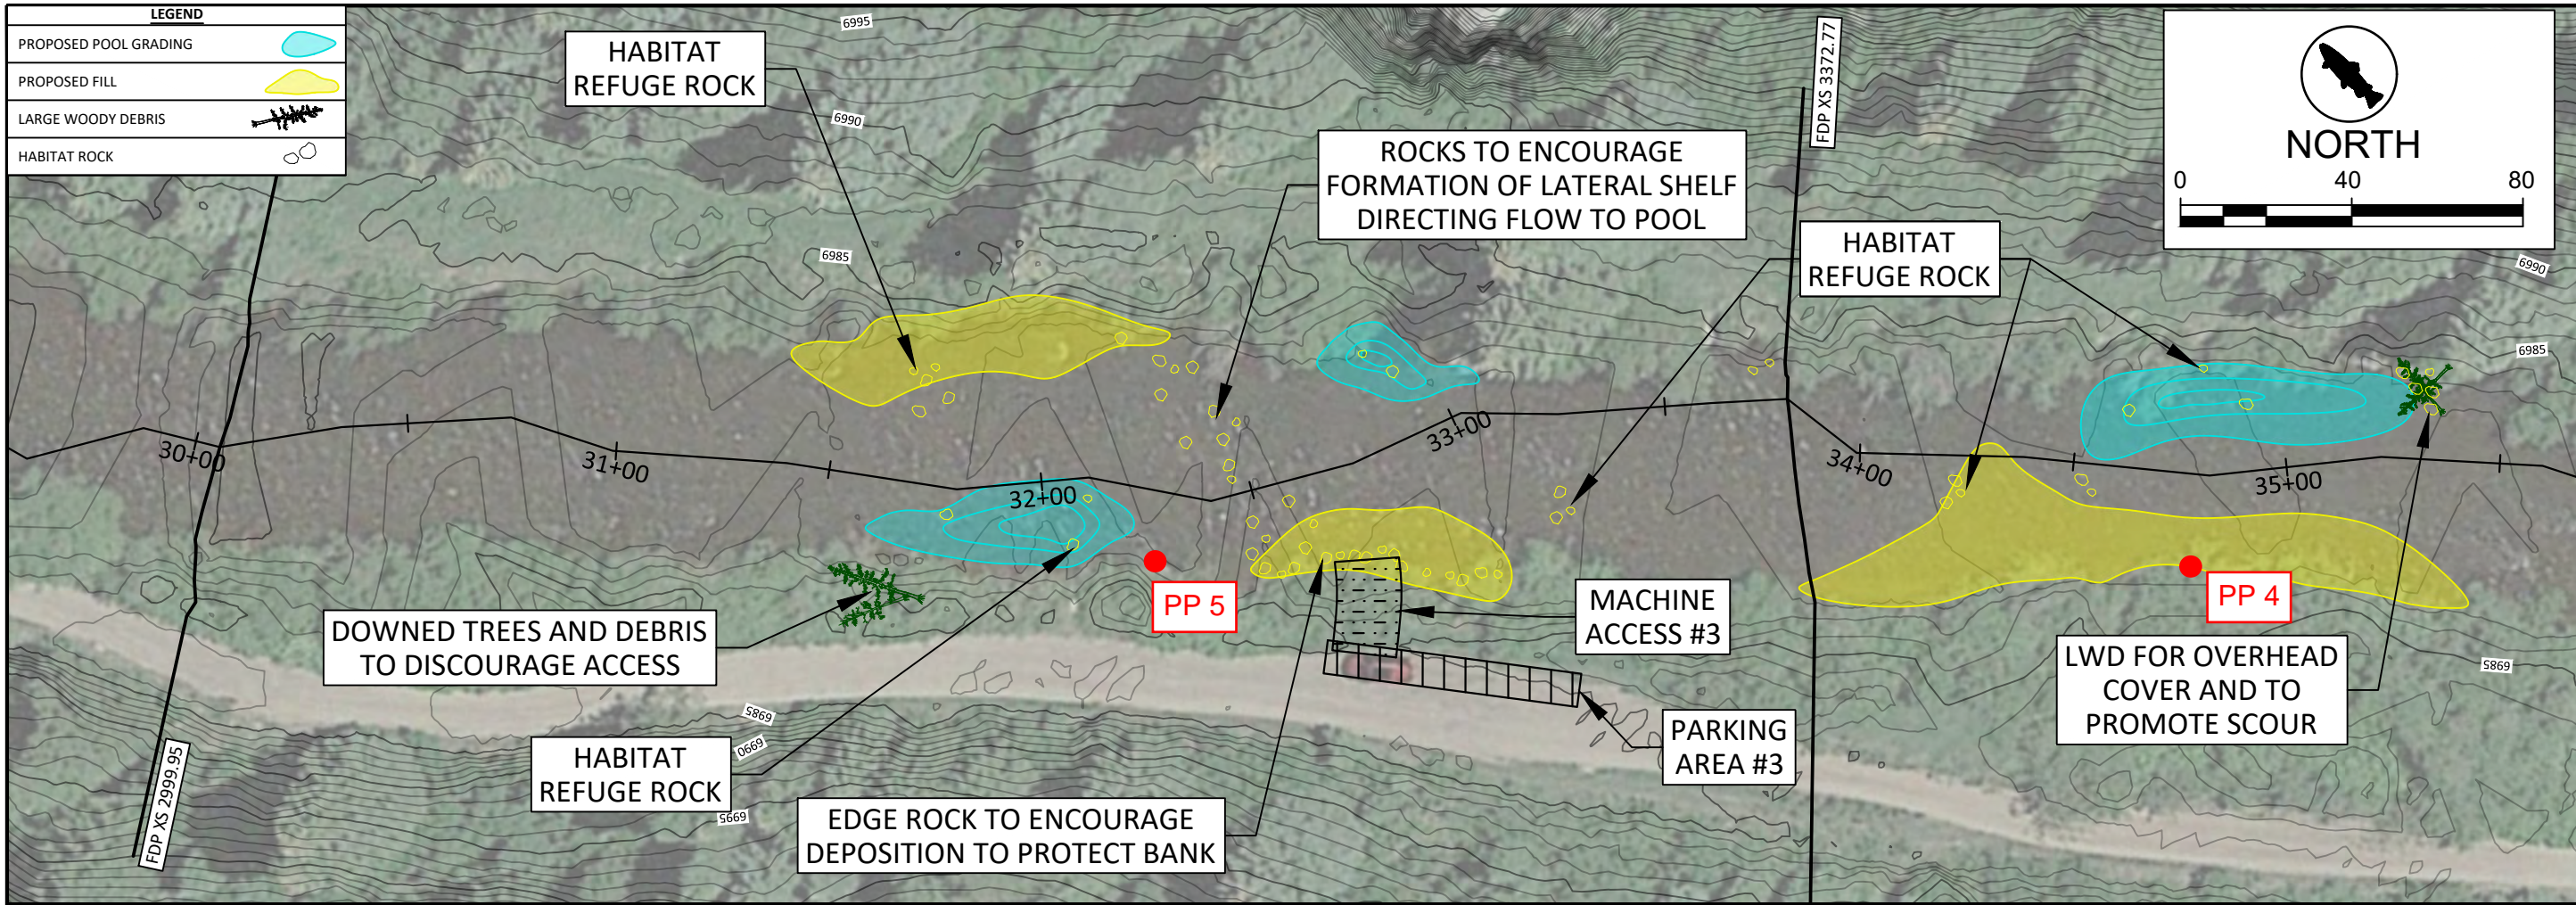



PLEASANT VALLEY
FISH HABITAT
IMPROVEMENT PROJECT
ROUTT COUNTY, CO

PLAN AND PROFILE SHEET
STA. 30+00 - 35+00

5
DATE: OCT. 2021



C:\Users\Owner\Desktop\From Server\298-101 YSICT Pleasant Valley\Data_General\Valley\CAD\PLEASANT VALLEY P&P\050621.dwg 8/16/2021

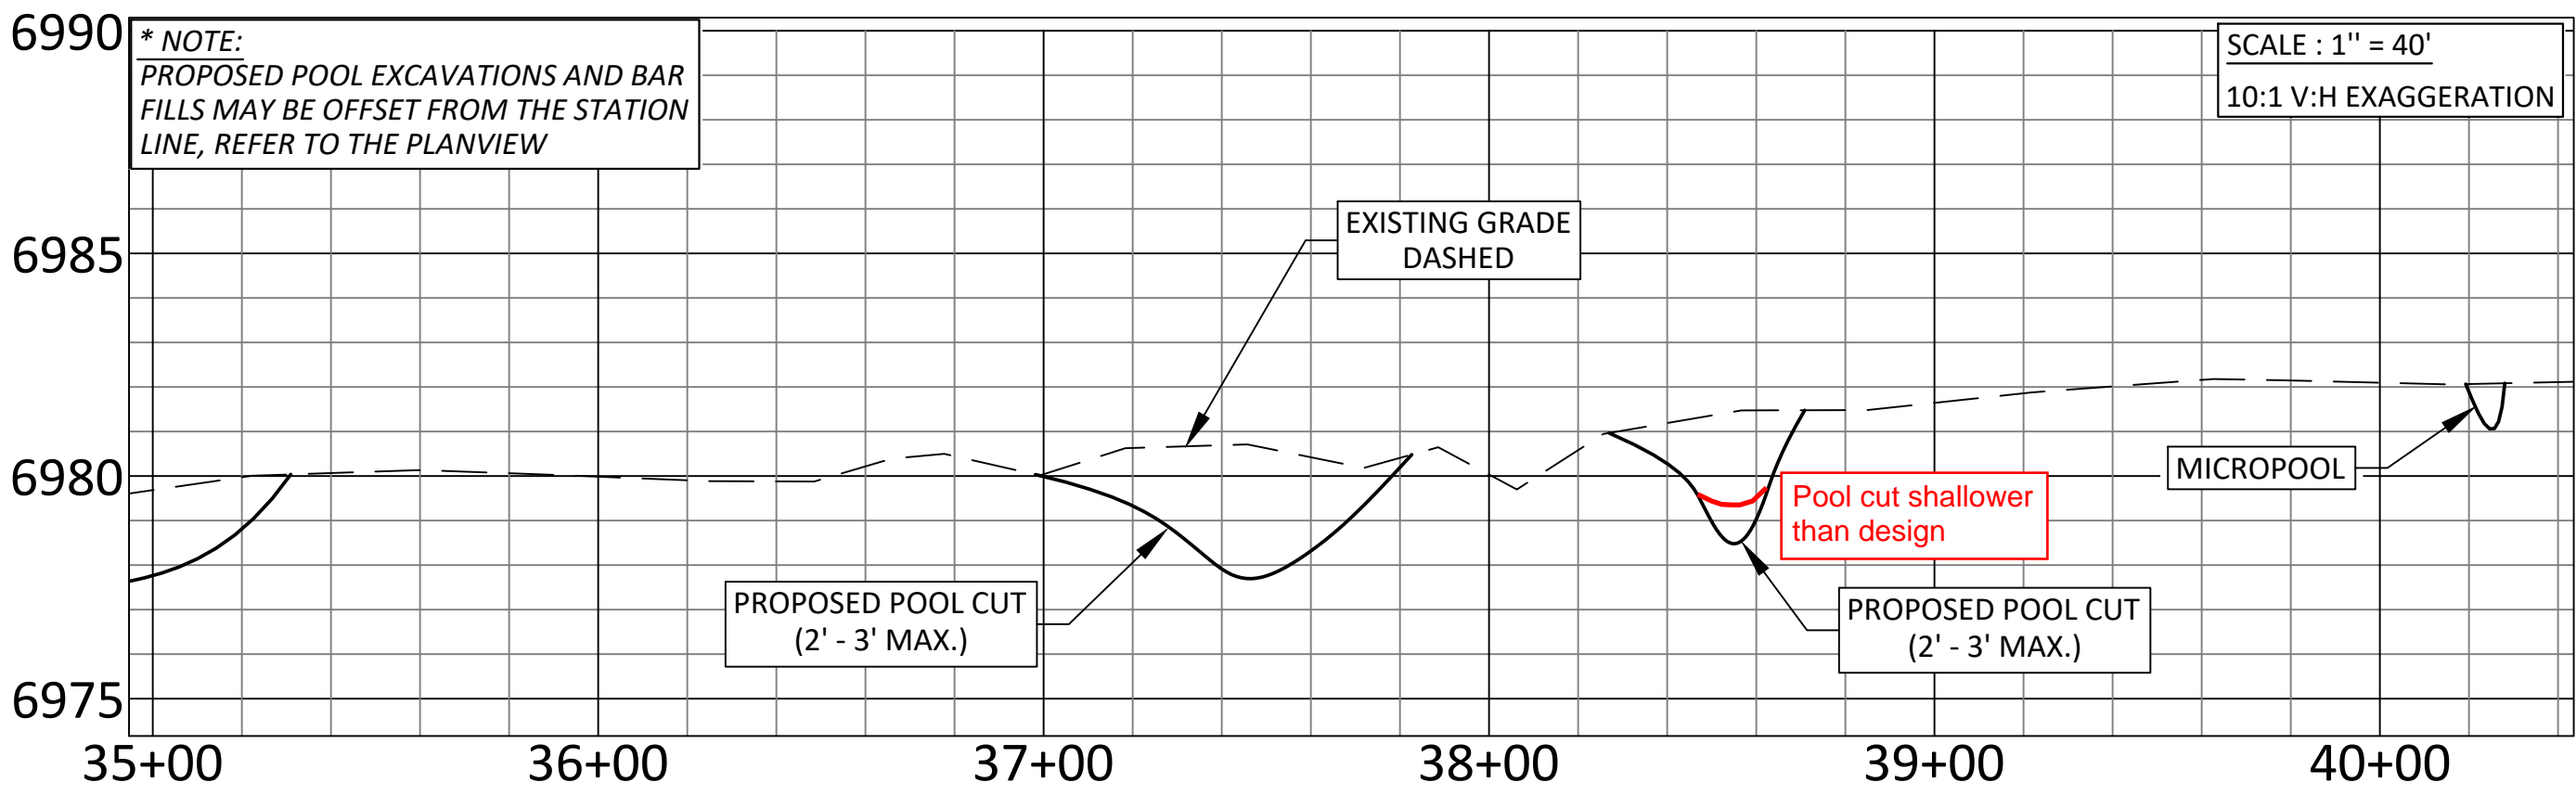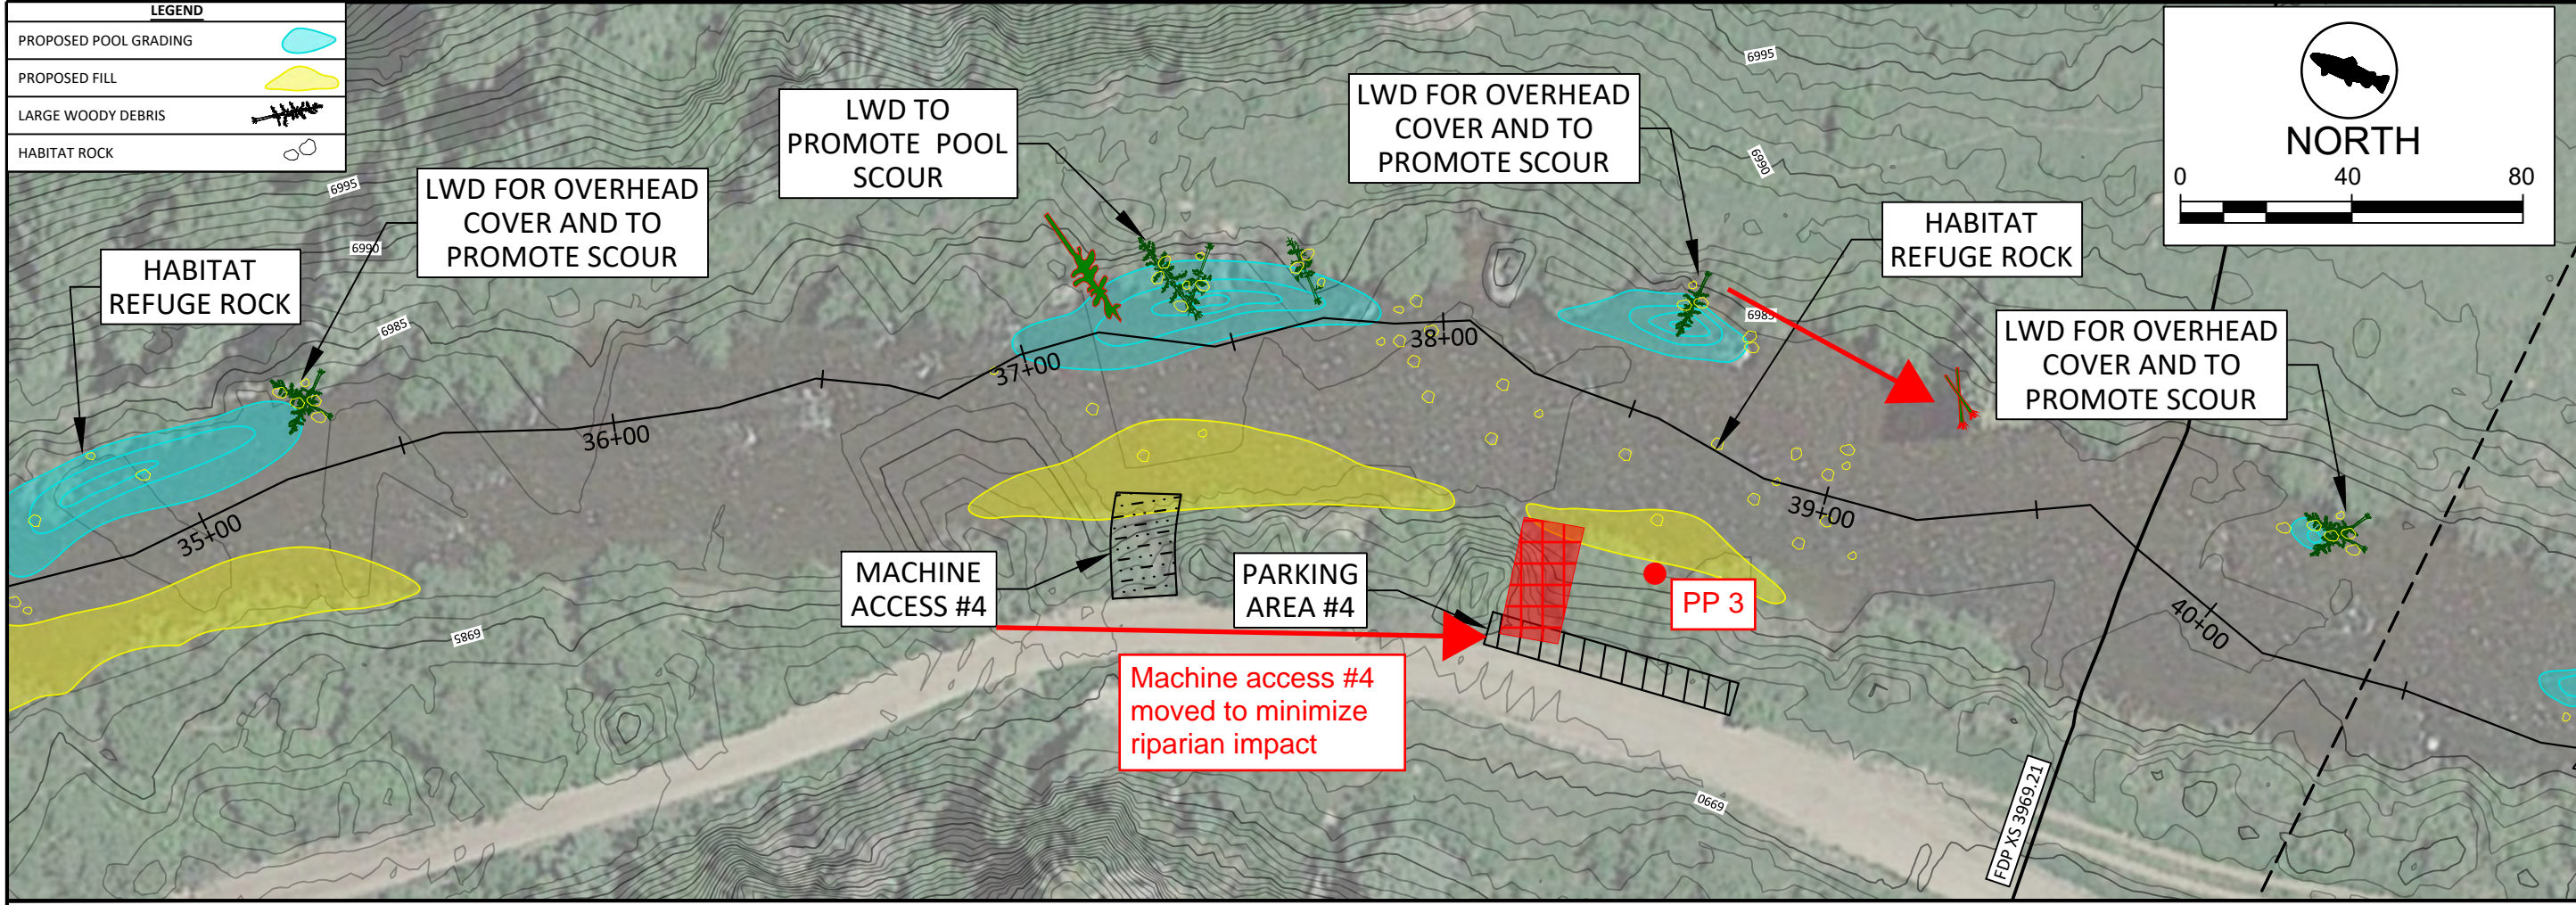




PLEASANT VALLEY
FISH HABITAT
IMPROVEMENT PROJECT
ROUTT COUNTY, CO



PLAN AND PROFILE SHEET
STA. 35+00 - 40+00

6
DATE: OCT. 2021


C:\Users\Owner\Desktop\From Server\298-101 YSICT Pleasant Valley\Data-General\CAD\PLEASANT VALLEY P&P050621.dwg8/16/2021

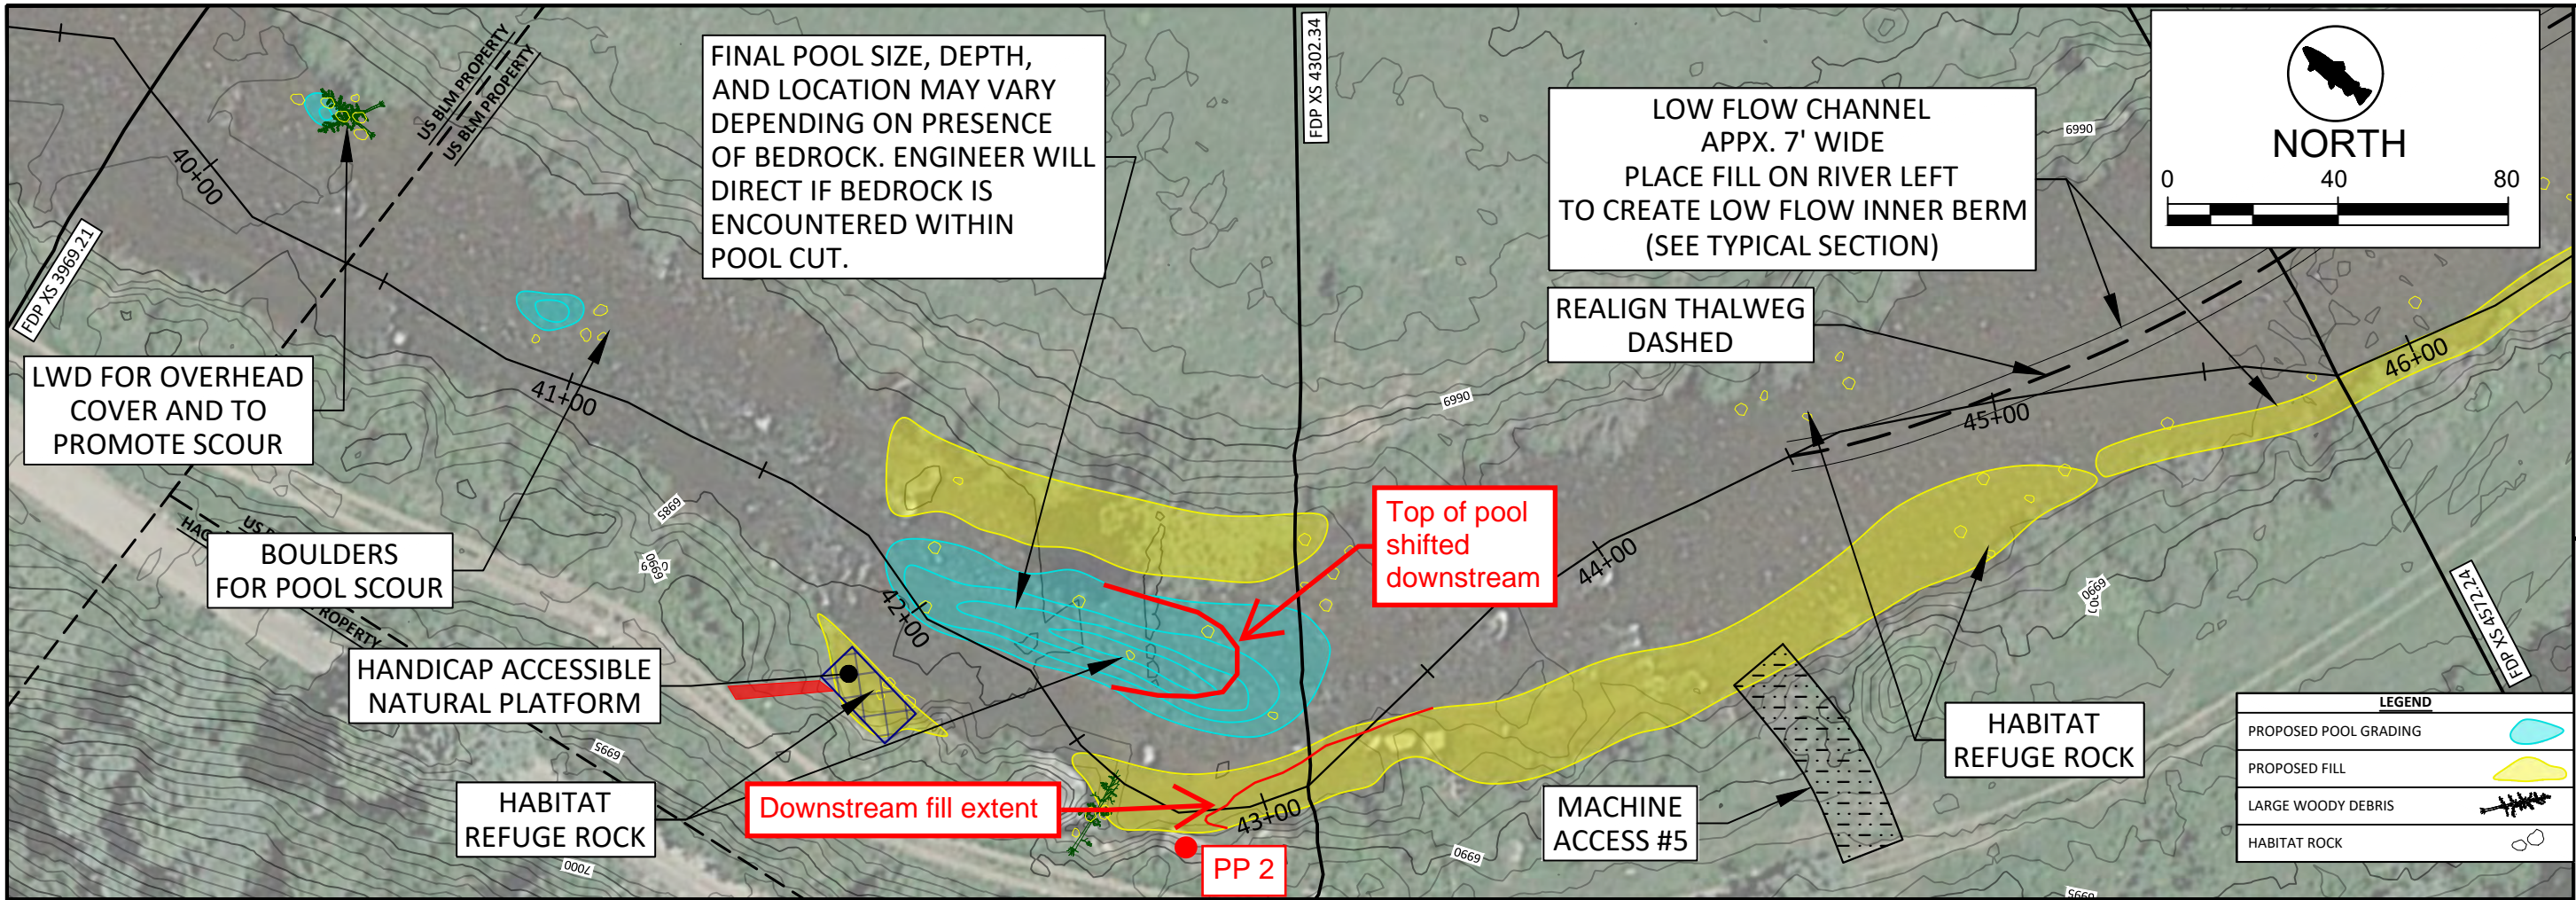

C:\Users\Owner\Desktop\From Server\298-101 YSICT Pleasant Valley\Data_General\Valley\CAD\PLEASANT VALLEY P&P050621.dwg8/16/2021

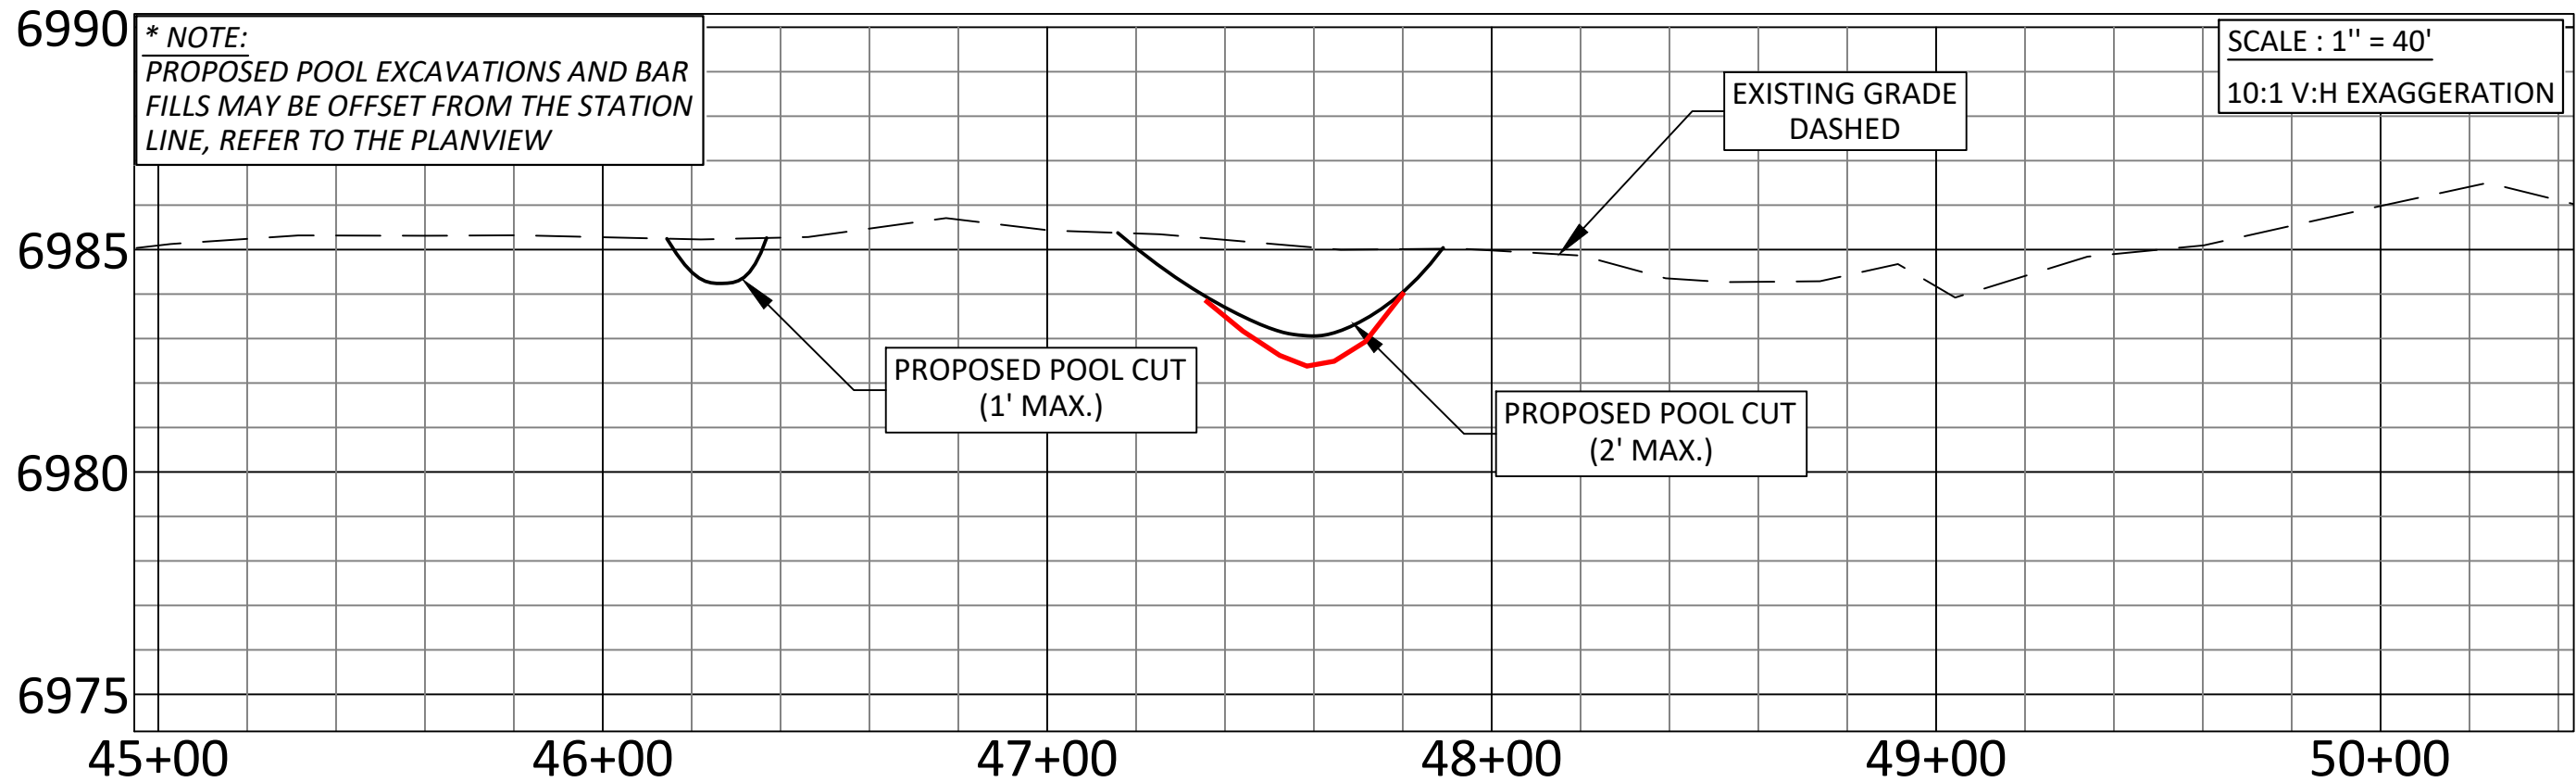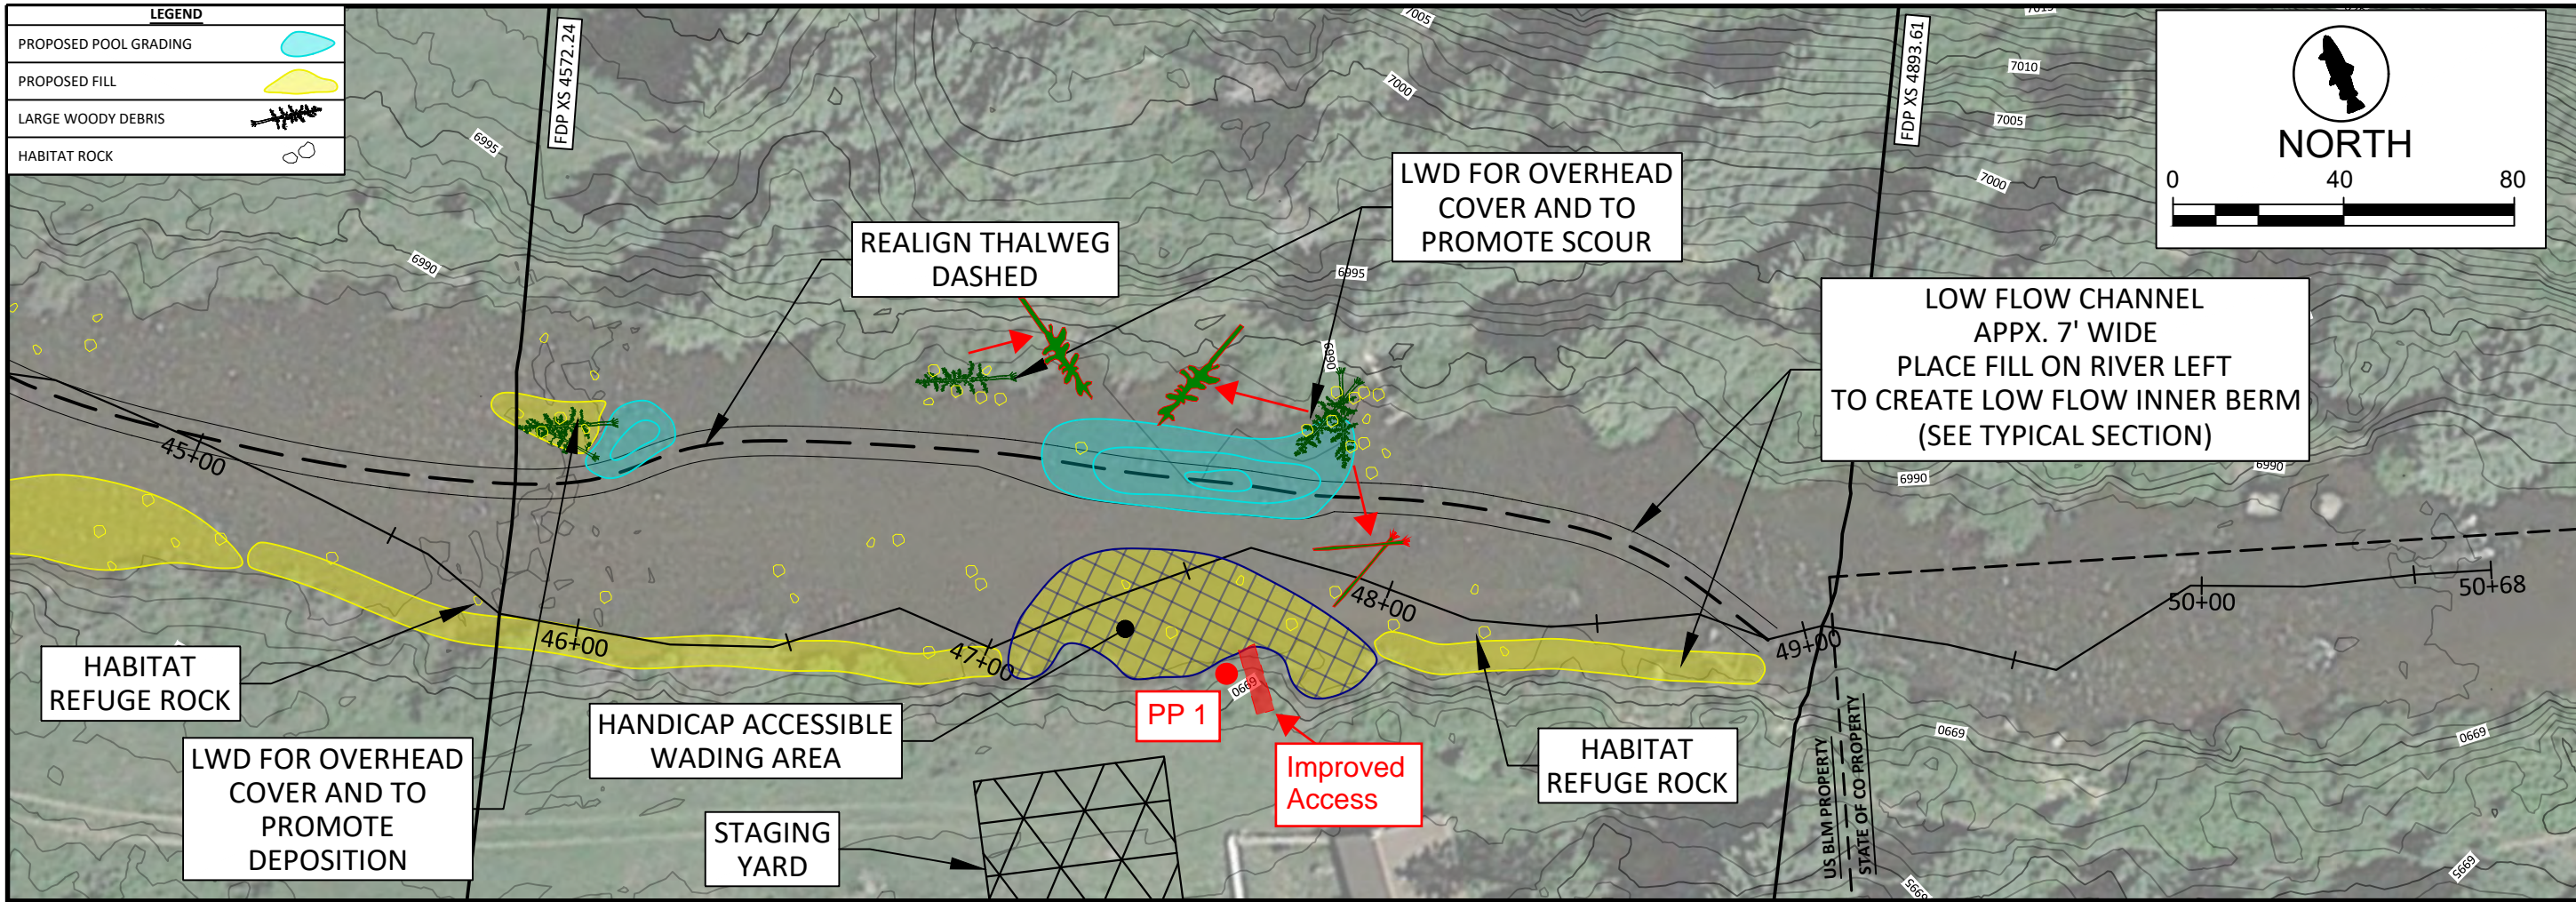

C:\Users\Owner\Desktop\From Server\298-101 YSICT Pleasant Valley\Data_General\CAD\PLEASANT VALLEY P&P050621.dwg8/16/2021

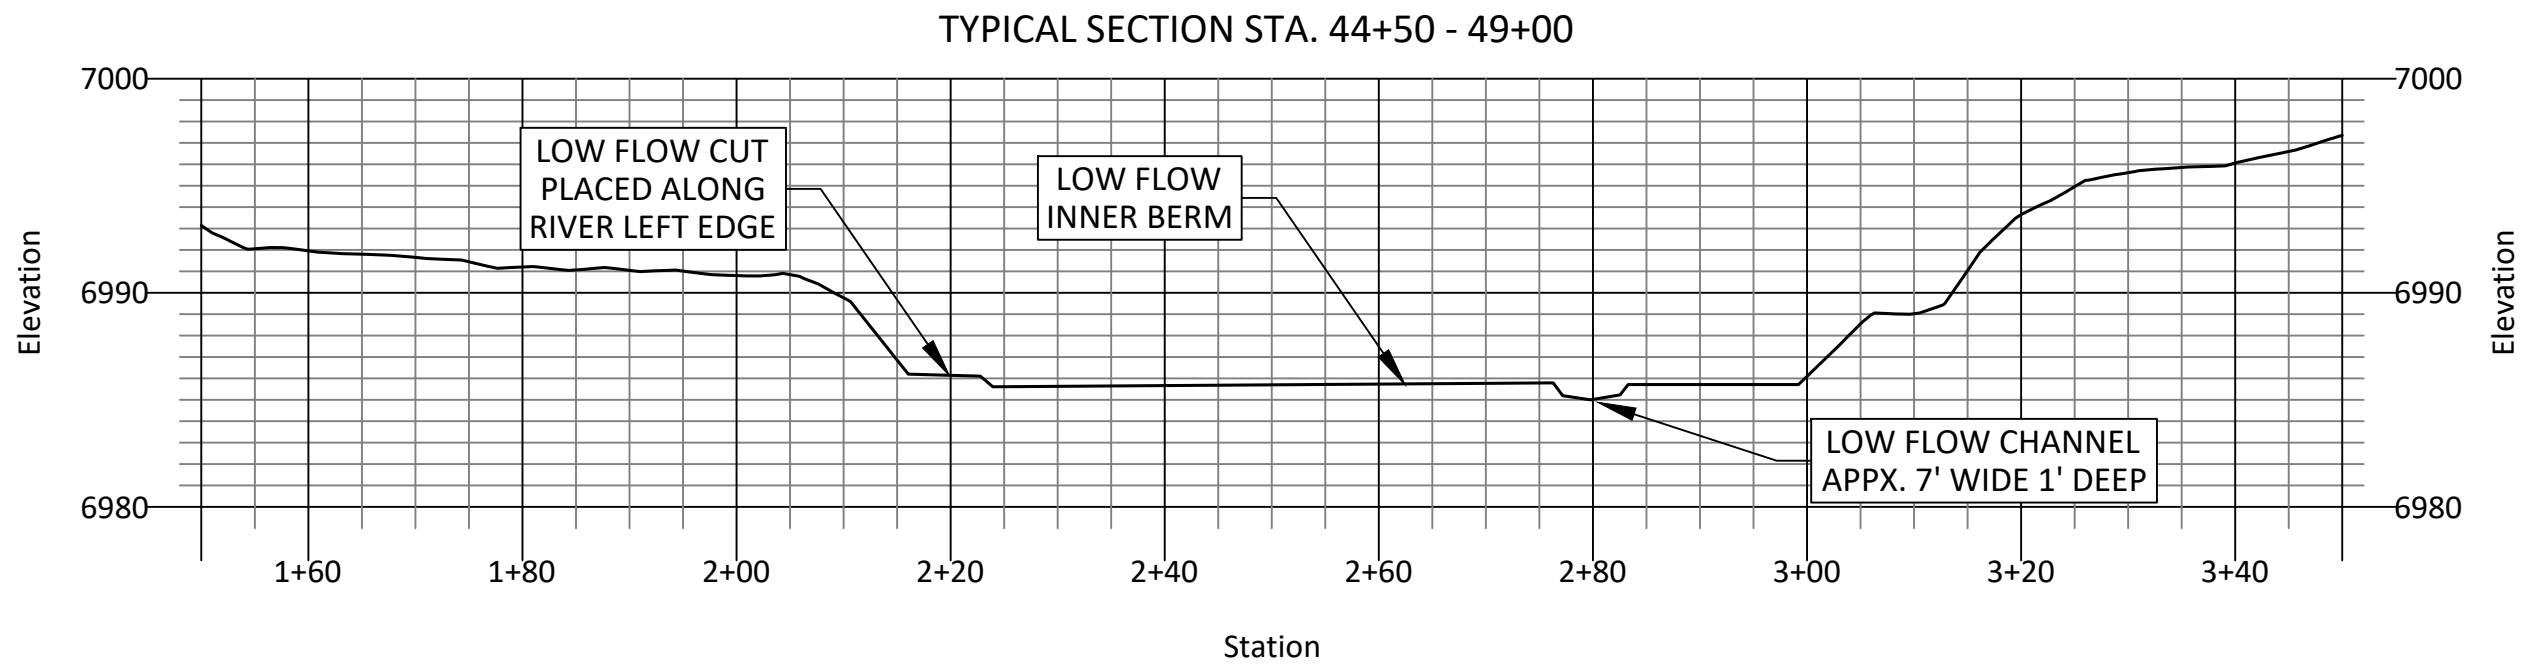


XS

DATE: APR. 2021


TYPICAL CROSS-SECTION
STA. 44+50 - 49+00


PLEASANT VALLEY
FISH HABITAT
IMPROVEMENT PROJECT
ROUTT COUNTY, CO



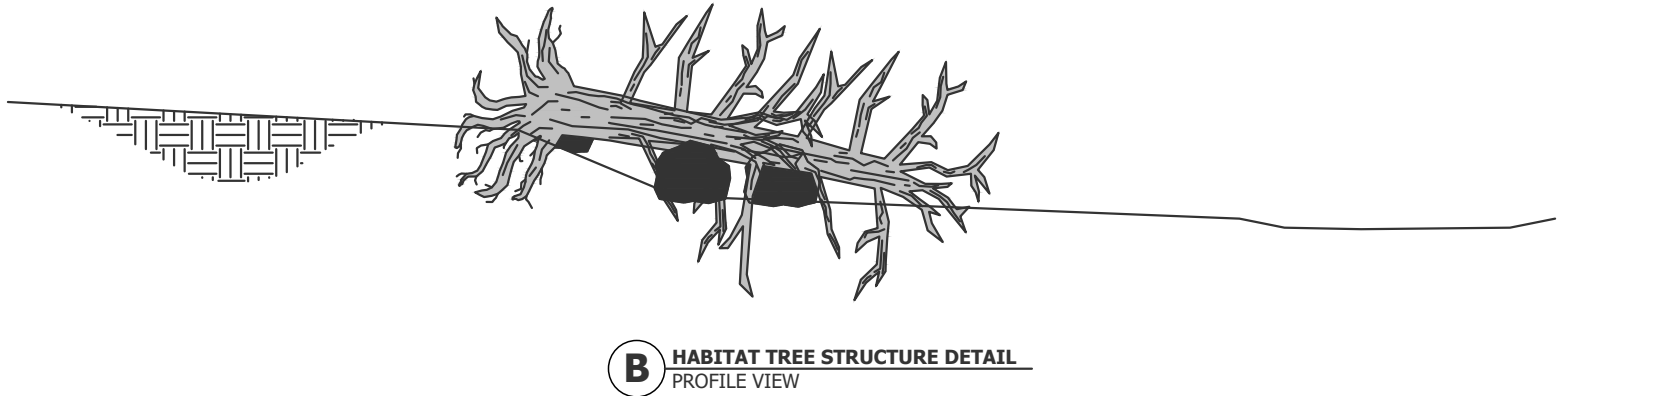

A **HABITAT TREE STRUCTURE DETAIL**
PLAN VIEW

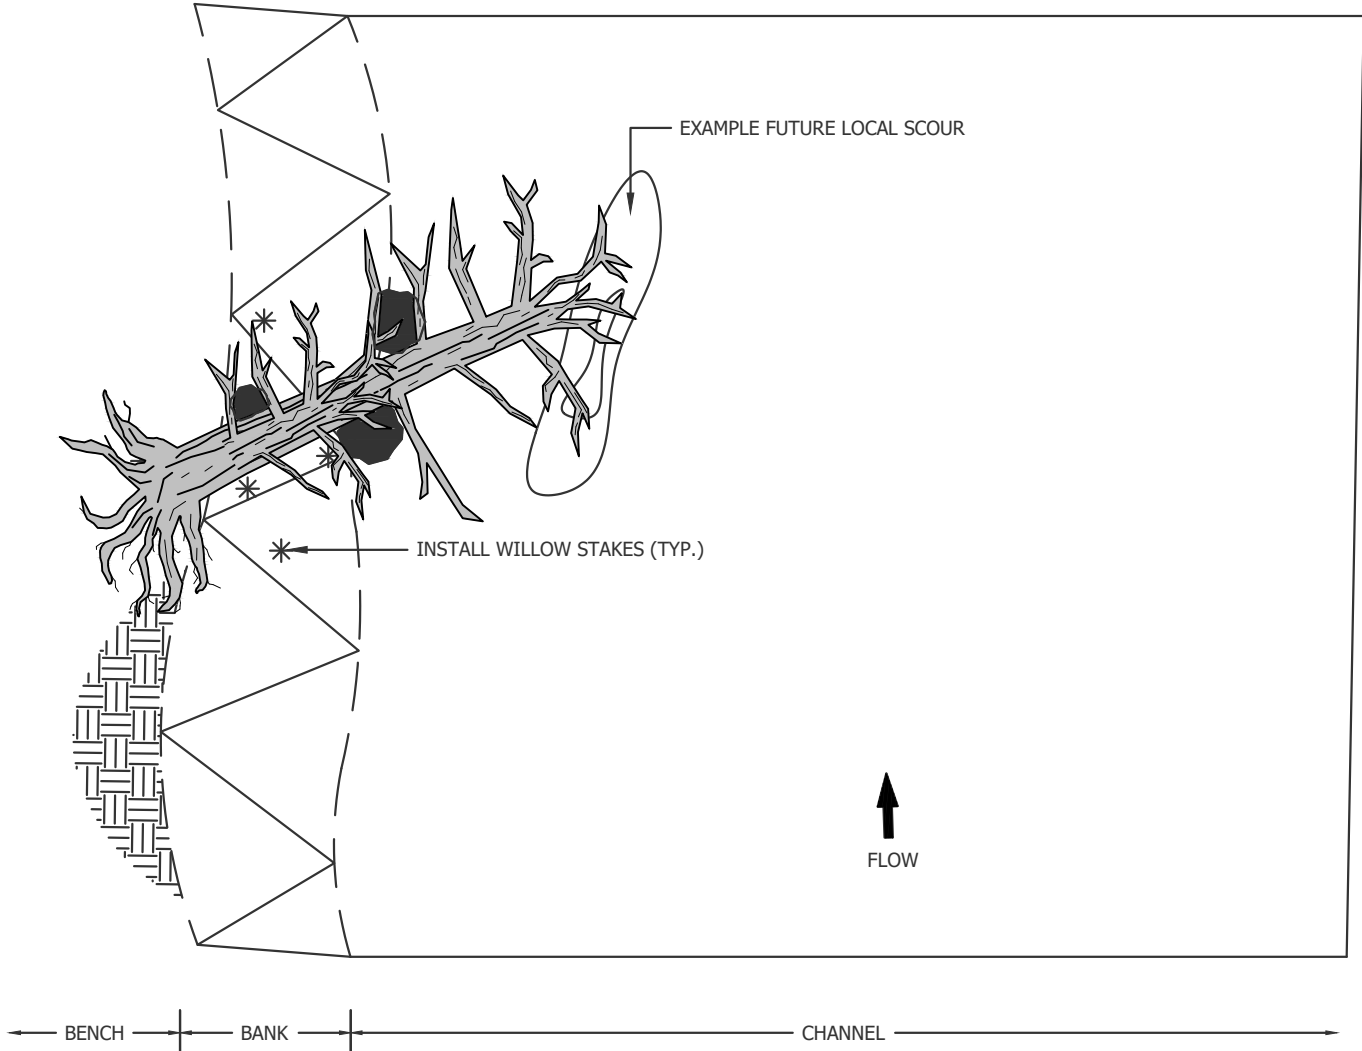


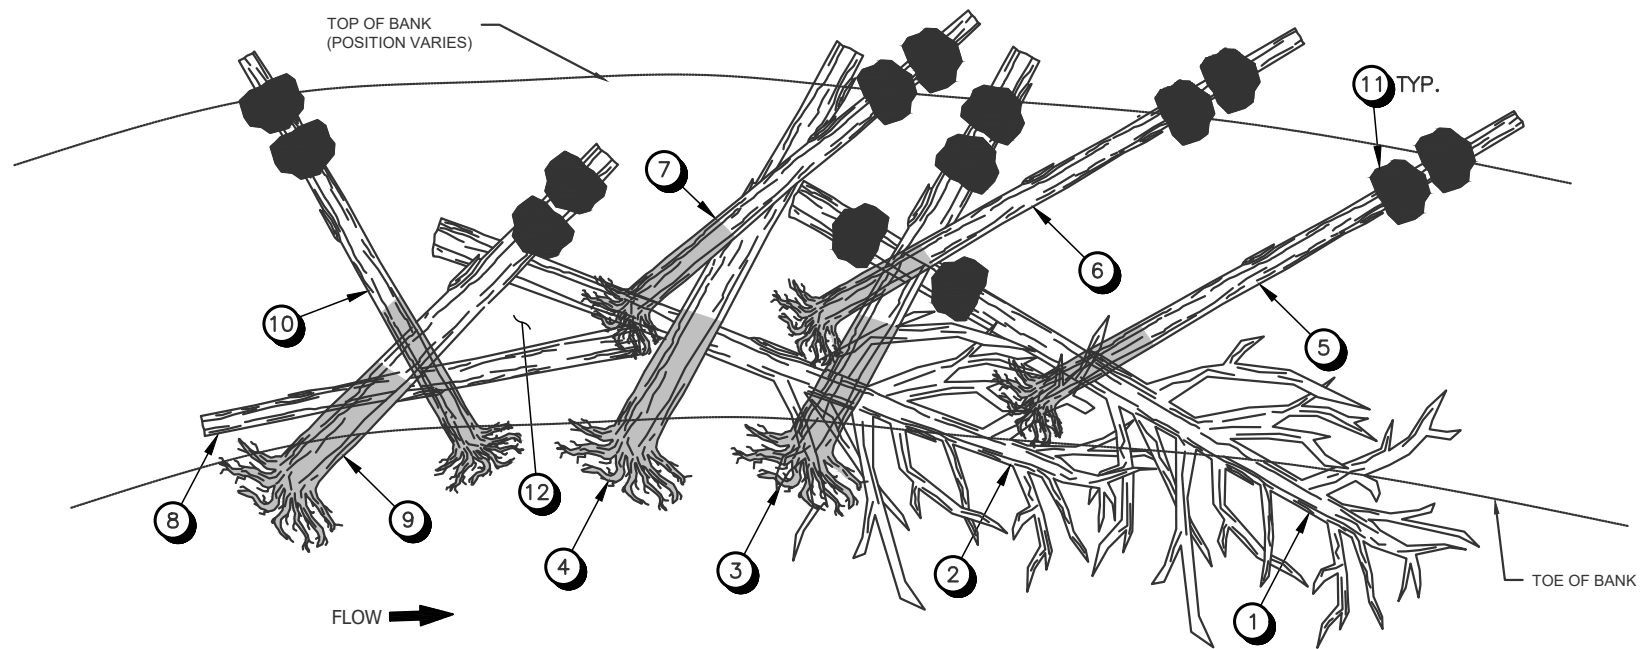

A **LARGE WOOD STRUCTURE DETAIL**
PLAN VIEW



1. PLACE LOG WITH BRANCHES INTACT AT THE TOE OF THE SLOPE WITH BRANCHES EXPOSED AND POINTING DOWNSTREAM. LOG IS ANGLED DOWNSTREAM AT 20 DEG. FROM THE BANK.
2. PLACE LOG WITH BRANCHES INTACT AT THE TOE OF THE SLOPE, UPSTREAM OF THE FIRST LOG, WITH BRANCHES EXPOSED AND POINTING DOWNSTREAM. LOG IS ANGLED DOWNSTREAM AT 30 DEG. FROM THE BANK.
3. INSTALL LOG WITH ROOTWAD CROWN RESTING ON TOP THE LOGS PLACED IN STEPS 1 AND 2 AT TOE OF BANK AND ORIENTED UPSTREAM AT 60 DEG.
4. INSTALL LOG WITH ROOTWAD CROWN RESTING ON LOG PLACED IN STEP 2 ABOVE THE TOE OF BANK AND ORIENTED UPSTREAM AT 50 DEG.
5. INSTALL LOG WITH ROOTWAD CROWN RESTING ON LOG PLACED IN STEP 2 ABOVE THE TOE OF BANK AND ORIENTED UPSTREAM AT 50 DEG.
6. INSTALL LOG WITH ROOTWAD CROWN RESTING ON LOG PLACED IN STEP 3 AND ORIENTED UPSTREAM AT 50 DEG.
7. INSTALL LOG WITH ROOTWAD CROWN RESTING ON LOG PLACED IN STEP 4 AND ORIENTED UPSTREAM AT 50 DEG.
8. EMBED FOOTER LOG AT TOE OF SLOPE PARALLEL TO FLOW WITH THE TOP OF LOG AT THE ELEVATION OF CHANNEL THALWEG.
9. INSTALL LOG WITH ROOTWAD CROWN RESTING ON THE FOOTER LOG PLACED IN STEP 8 AT THE TOE OF THE BANK ORIENTED UPSTREAM AT 45 DEG.
10. INSTALL LOG WITH ROOTWAD CROWN RESTING ON LOG PLACED IN STEP 9 ABOVE THE TOE OF THE BANK AND ORIENTED DOWNSTREAM AT 60 DEG.
11. PLACE TWO 30-INCH DIAMETER BOULDERS ON TOP OF LOGS PLACED IN STEPS 1, 3, 5, 6, 7, 9, AND 10. THE FOURTEEN BOULDERS SHALL BE POSITIONED APPROXIMATELY 5 FEET FROM END OF LOG.
12. PLACE 4-INCH MINUS SLASH DEBRIS (SMALLER BRANCHES SALVAGED DURING GRADING ACTIVITIES) IN ALL VISIBLE VOID SPACES BETWEEN LOGS. PARTIALLY ANCHOR THE SLASH DEBRIS BY PINNING THE ENDS OF THE BRANCHES BENEATH THE KEY LOGS INSTALLED IN THE STEPS ABOVE.

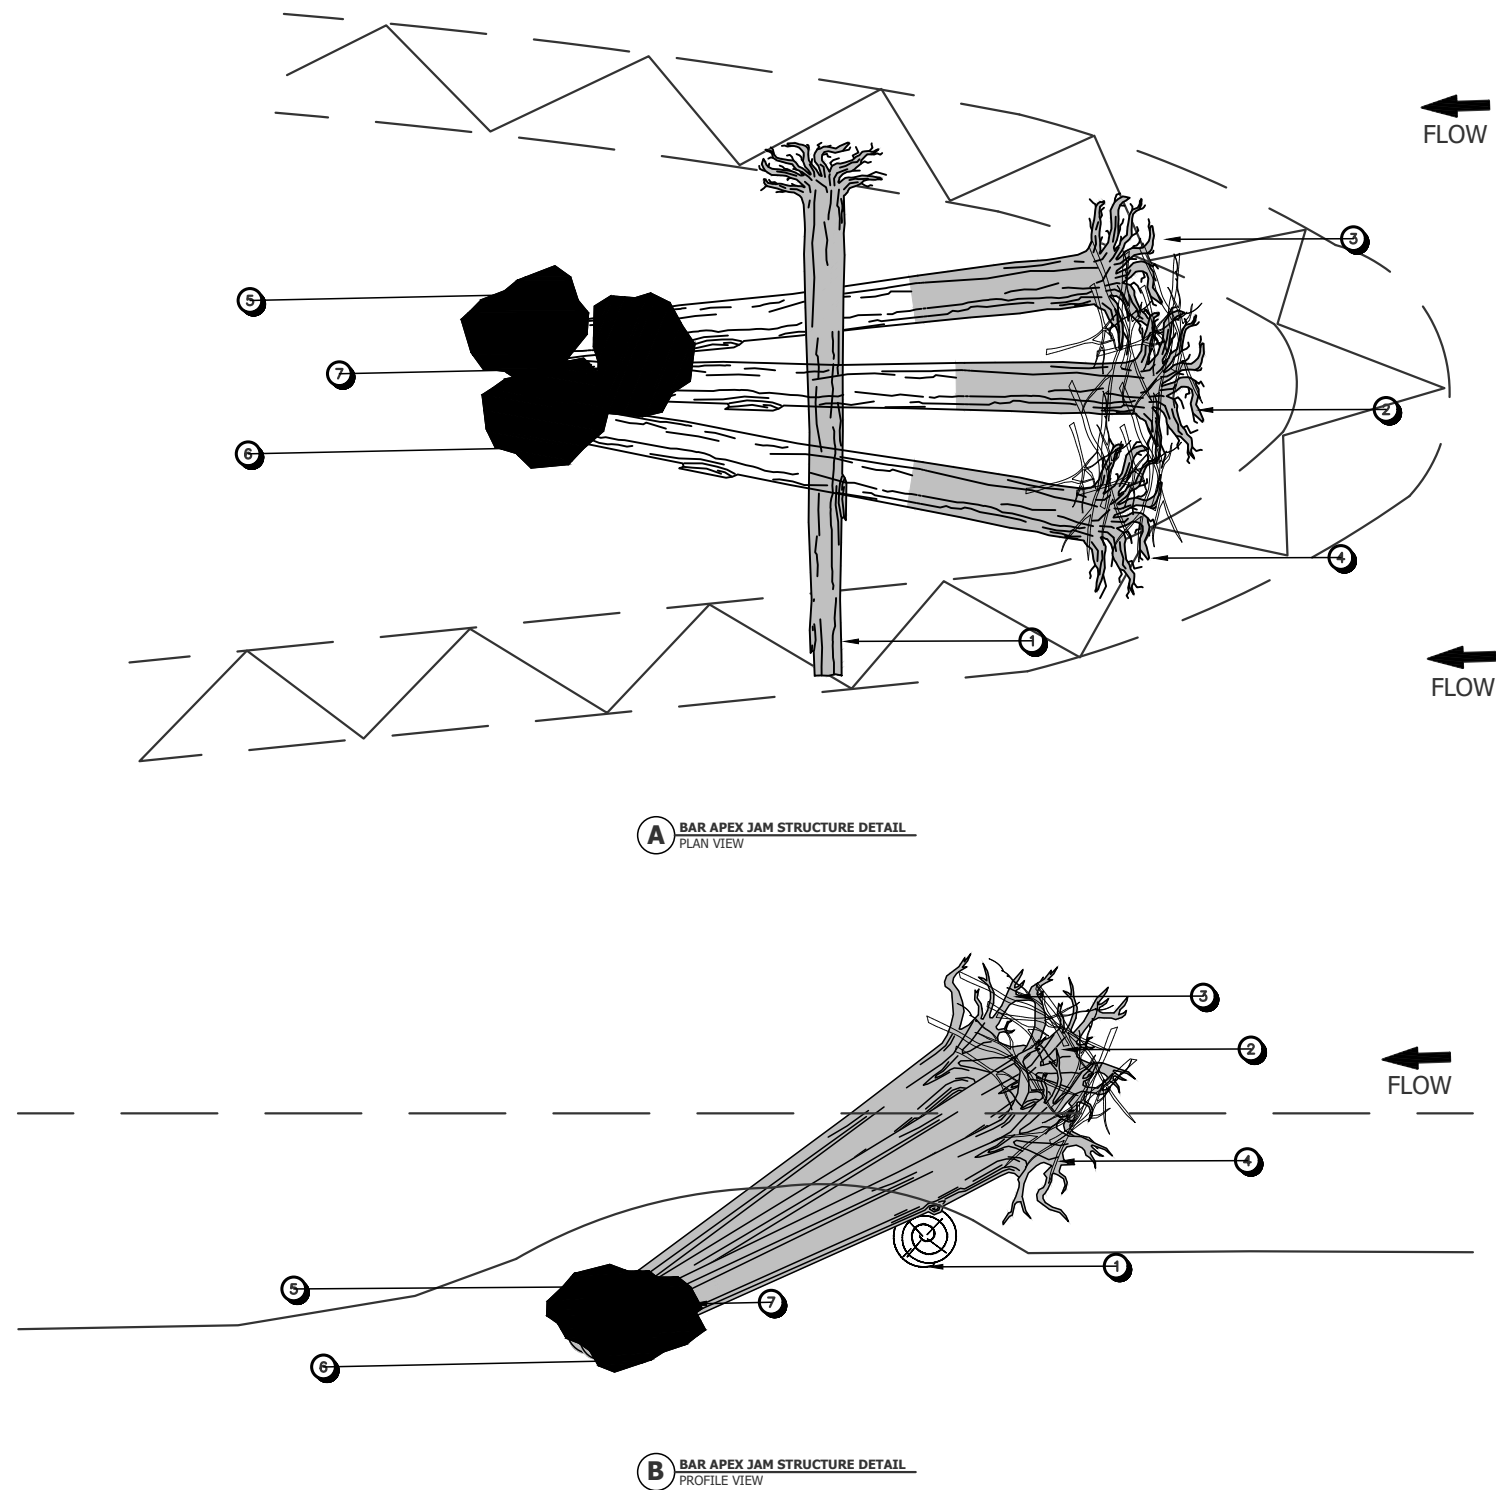


CONSTRUCTION SEQUENCING NOTES:

1. BURY FOOTER LOG (1) INTO UPSTREAM END OF BAR SO TOP OF LOG IS FLUSH WITH GROUND SURFACE. INSTALL FOOTER ORIENT LOG PERPENDICULAR TO FLOW. LOG SHALL BE PLACED AT THE ELEVATION WHERE THE LOGS (5-7) WILL BE BURIED IN THE CHANNEL BED. EMBED FULL LENGTH OF LOG.
2. PLACE BOTTOM CROWN OF LOG ON TOP OF THE FOOTER LOG INSTALLED IN STEP 1. ORIENT DOWNSTREAM END OF LOG SLIGHTLY TOWARDS THE CENTERLINE OF THE CHANNEL.
3. PLACE BOTTOM CROWN OF LOG ON TOP OF THE HEADER LOG INSTALLED IN STEP 1. ORIENT LOG NEARLY PARALLEL TO FLOW.
4. PLACE BOTTOM CROWN OF LOG ON TOP OF THE HEADER LOG INSTALLED IN STEP 1. ORIENT DOWNSTREAM END OF LOG SLIGHTLY TOWARDS THE CENTERLINE OF THE CHANNEL.
5. PLACE AND BURY BOULDERS (5-7) ON TOP OF LOGS (2-5) AS SHOWN. TOP OF BOULDERS SHOULD BE AT OR LOWER THAN ELEVATION OF FOOTER LOG.
6. ADD BRANCHY MATERIAL IN ROOT WADS OF LOGS.

ROUTT COUNTY RD. 18

PLAN VIEW

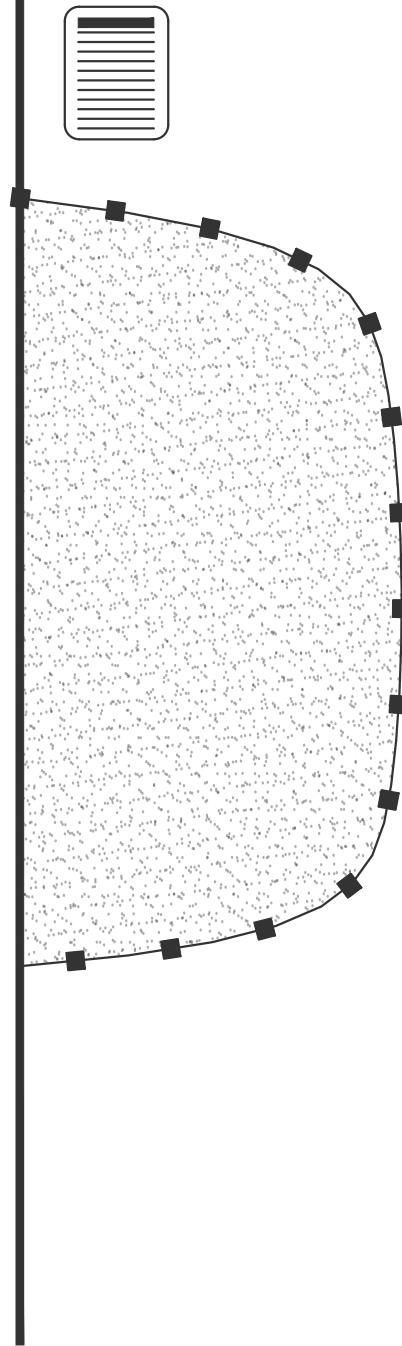

LEGEND



- SIGN DESCRIBING PARKING AREA AND DESIGNATION.



- 8" x 8" TREATED POST



- ROAD BASE AGGREGATE

NOTES:

1. 8" x 8" TREATED POSTS MUST BE 6.5' IN LENGTH AND BURIED 30"+ INTO THE GROUND.
2. 8" x 8" TREATED POSTS ARE INSTALLED TO PROTECT RIPARIAN AREA.
3. PARKING AREA 1 WILL BE NOSE-IN OR TAIL-IN PARKING ONLY.
4. PARKING AREAS 2-4 WILL BE PARALLEL PARKING ONLY.
5. SIGNS WILL DESCRIBE PARKING AREAS AND VEHICLE NUMBER LIMITS.

PA

DATE: MAY. 2021

HARDENED PARKING AREA
TYPICAL DETAIL

PLEASANT VALLEY
FISH HABITAT
IMPROVEMENT PROJECT
ROUTT COUNTY, CO



C:\Users\Owner\Desktop\From Server\298-101 YSICT Pleasant Valley\Data_General\CAD\TypDetails.dwg 5/3/2021

LARGE WOOD STRUCTURE CONSTRUCTION GENERAL NOTES:

1. LARGE WOOD MATERIAL (LWM) FOR STRUCTURES SHALL BE SECURED FROM THE FOLLOWING SOURCES:
 - 1.A. LOGS WITH ROOTWAD PRE-STOCKPILED ON-SITE BY CPW.
 - 1.B. LARGE WOOD (LW) PILES SALVAGED ON-SITE BY CONTRACTOR, AS APPROVED BY STREAM RESTORATION SPECIALIST.
 - 1.C. LW PILES IMPORTED BY CONTRACTOR FROM OFF-SITE SOURCE, AS APPROVED BY STREAM RESTORATION SPECIALIST.
2. UPON NOTIFICATION TO PROCEED, THE CONTRACTOR SHALL BEGIN COORDINATION WITH CPW AND STREAM RESTORATION SPECIALIST TO DEVELOP A LIST AND SPECIFICATIONS FOR LOGS PROPOSED FOR USE FOR THE PROJECT, INCLUDING PRE-STOCKPILED LWM BY CPW AND LW PILES SALVAGED ON-SITE OR IMPORTED BY CONTRACTOR. THE CONTRACTOR SHALL NOTIFY CPW AND THE STREAM RESTORATION SPECIALIST IMMEDIATELY IF A SPECIFIED LOG SIZE IS NOT AVAILABLE. THE LIST AND SPECIFICATIONS SHALL INCLUDE, FOR EACH LWM/LW PILE, THE TREE SPECIES, DIAMETER AT DBH, LENGTH, AND ROOTWAD DIAMETER. THE LARGE WOOD STRUCTURE CONFIGURATIONS AND MATERIAL SCHEDULES SHOWN IN THE PLANS ARE SUBJECT TO REVISION BY THE STREAM RESTORATION SPECIALIST UPON RECEIPT OF THE LIST OF LOG MATERIAL.
3. LWM SHALL PREFERENTIALLY INCLUDE BRANCHES AND ROOTWAD. INVASIVE SPECIES (E.G., CRACK WILLOW) SHALL NOT BE IMPORTED, SALVAGED, OR INSTALLED IN LARGE WOOD STRUCTURES. THE STREAM RESTORATION OR VEGETATION SPECIALIST SHALL IDENTIFY INVASIVE SPECIES OF TREES.
4. THE LOCATION AND CONFIGURATION OF LARGE WOOD STRUCTURES MAY VARY IN FIELD DUE TO SITE CONDITIONS, AND THE FINAL LOCATION OF THESE STRUCTURES WILL BE FLAGGED BY THE STREAM RESTORATION SPECIALIST DURING CONSTRUCTION.
5. SPECIFIED DIAMETER OF LOGS SHALL BE MEASURED AT BREAST HEIGHT (DBH). LENGTHS OF LOGS SHALL INCLUDE THE ROOTWAD PORTIONS OF THE LOG. LOG SIZE SHALL BE WITHIN 3 INCHES OF THE SPECIFIED DIAMETER. ROOTWAD DIAMETER SHALL TYPICALLY BE A MINIMUM OF 3 TIMES THE DBH OF THE LOG, UNLESS OTHERWISE APPROVED BY THE STREAM RESTORATION SPECIALIST.
6. LOG ORIENTATION ANGLES ARE MEASURED BETWEEN THE LOG AND THE BANK. A LOG WITH AN ORIENTATION ANGLE OF 0 DEGREES SHALL BE PLACED PARALLEL TO THE BANK, AND A LOG WITH A 90 DEGREE ORIENTATION ANGLE SHALL BE PLACED PERPENDICULAR TO THE BANK. ORIENTATION OF LOGS SHALL BE WITHIN 10 DEGREES OF THE SPECIFIED ORIENTATION ANGLE, UNLESS APPROVED BY THE STREAM RESTORATION SPECIALIST IN THE FIELD.
7. FINAL WOOD CONFIGURATION, LOCATION, AND STRUCTURE TYPE TO BE DETERMINED IN THE FIELD PER THE DIRECTION OF THE STREAM RESTORATION SPECIALIST.
8. TYPICAL TOP OF STRUCTURE ELEVATIONS WILL BE NEAR THE 5-YR WSEL; FINAL ELEVATIONS TO BE PROVIDED DURING CONSTRUCTION PHASE.
9. TYPICAL TOP OF PILE ELEVATIONS WILL BE NEAR THE 25-YR WSEL; FINAL ELEVATIONS TO BE PROVIDED DURING THE CONSTRUCTION PHASE.



PLEASANT VALLEY
FISH HABITAT
IMPROVEMENT PROJECT
ROUTT COUNTY, CO

DESIGN BUILD PLANSET
GENERAL NOTES

GN
DATE: MAY, 2021