

A



Mountain States Hydro, LLC

P.O. Box 918 Off: (509) 837-6822
Sunnyside, WA. 98944 FAX: (509) 837-6801

ALWAYS THINK SAFELY

**SOUTHEASTERN COLORADO WATER
ACTIVITY ENTERPRISE
PUEBLO DAM HYDROELECTRIC PROJECT
COVER, INDEX TO SHEETS,
PROJECT LOCATION &
VICINITY MAP**

 
AS CONSTRUCTED 2019

COVER, INDEX TO SHEETS,
PROJECT LOCATION &
VICINITY MAP

GA-1


LEGEND

UTILITY POLE	
GATE OR FENCE POST	
SURVEY CONTROL POINT	
MONITORING WELL	
TELEPHONE PED.	
SURFACE WATER FLOW DIRECTION	
DRILL OR TEST HOLE	
SPOT ELEVATION (GRADING)	x 181.0
STRUCTURE ELEVATION	 181.0
PROJECT BENCH MARK	
US BOR INSTURMENTATION POINT	
SLOPE DIRECTION INDICATOR	


	FEATURE LINE
	HIDDEN FEATURE LINE
	SECTION LINE
	CENTERLINE
	EXISTING 5–FOOT CONTOUR
	EXISTING 1–FOOT CONTOUR
	FENCE LINE
	OVERHEAD POWER LINE

DETAIL & SECTION DESIGNATION

TYPICAL CALLOUT WHERE DETAIL OR SECTION IS TAKEN

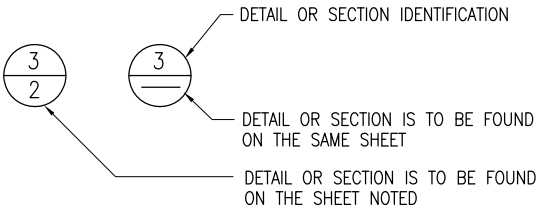

TYPICAL CALLOUT WHERE DETAIL OR SECTION IS SHOWN

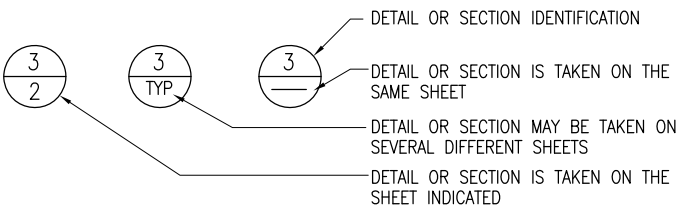

ABBREVIATIONS

AB	ANCHOR BOLT	INT	INTERIOR OR INTERSECTION
AC	ASPHALTIC CONCRETE	L	LENGTH
ADDL	ADDITIONAL	LB	POUND
AL	ALUMINUM	LF	LINEAL FEET
APPROX	APPROXIMATE	LG	LONG
BC	BOTTOM OF CURB OR BOLT CIRCLE	MATL	MATERIAL
BLDG	BUILDING	MAX	MAXIMUM
BM	BENCH MARK	MECH	MECHANICAL
BOT	BOTTOM	MFGR	MANUFACTURER
BVC	BEGIN VERTICAL CURVE	MH	MAN HOLE
C	CONDIUT	MIN	MINIMUM
CI	CAST IRON	MJ	MECHANICAL JOINT
CISP	CAST IRON SOIL PIPE	N	NORTH
CJ	CONSTRUCTION JOINT	NIC	NOT IN CONTRACT
CL	CENTERLINE	NO.	NUMBER
CLR	CLEAR	NTS	NOT TO SCALE
CMP	CORRIGATED METAL PIPE	OC	ON CENTER
CMU	CONCRETE MASONRY UNIT	OPNG	OPENING
CONC	CONCRETE	PC	POINT OF CURVE
CONN	CONNECT OR CONNECTION	PT	POINT OF TANGENT
CONST	CONSTRUCTION	PCF	POUNDS PER CUBIC FOOT
CONT	CONTINUATION	PEN	PENETRATION
CORP	CORPORATION	PE	PLAIN END
CPLG	COUPLING	PERF	PERFORATED
CTR	CENTER	PI	POINT OF INTERSECTION
CU	CUBIC	PJF	PREMOLDED JOINT FILLER
CW	COLD WATER	PL	PLATE
CF	CUBIC FEET	PNL	PANEL
D	DRAIN	PRC	POINT OF REVERSE CURVE
DI	DUCTILE IRON	PRES	PRESSURE
DIMJ	DUCTILE IRON MECHANICAL JOINT	PSF	POUNDS PER SQUARE FOOT
DET	DETAIL	PUD	PUBLIC UTILITY DISTRICT
DIA	DIAMETER	PVC	POLYVINYL CHLORIDE
DIM	DIMENSION	RAD,R	RADIUS
DWG	DRAWING	RCP	REINFORCED CONCRETE PIPE
E	EAST	RD	ROAD
EA	EACH	REINF	REINFORCING
EF	EACH FACE	REM	REMOVE
EFF	EFFLUENT	REQD	REQUIRED
EG	EXISTING GRADE	RM	ROOM
EJ	EXPANSION JOINT	ROW	RIGHT OF WAY
ELB	ELBOW	SCH	SCHEDULE
ELEC	ELECTRICAL	SG	SUB GRADE
EQ	EQUAL	SH OR SHT	SHEET
EQUIP	EQUIPMENT	SIM	SIMILAR
EVC	END VERTICAL CURVE	SL OR S	SLOPE
EW	EACH WAY	SPEC	SPECIFICATION
EWEF	EACH WAY EACH FACE	SQ	SQUARE
EXP	EXPANSION OR EXPAND	SS	STAINLESS STEEL
EXIST	EXISTING	STA	STATION
EXT	EXTERIOR	STD	STANDARD
F	FLANGE	STL	STEEL
FCA	FLANGED COUPLING ADAPTER	SYM	SYMBOL
FF	FINISHED FLOOR	T	TANGENT
FG	FINAL GRADE	T&B	TOP & BOTTOM
FLEX	FLEXIBLE	TBD	TO BE DETERMINED
FL	FLOW LINE	TC	TOP OF CURVE
FLG	FLANGE	THK	THICK OR THICKNESS
FM	FORCE MAIN	THRU	THROUGH
FIN	FINISH	TYP	TYPICAL
FT	FOOT OR FEET	UD	UNDER DRAIN
FTG	FOOTING OR FITTING	VERT	VERTICAL
FUT	FUTURE	VPI	VERTICAL POINT OF INTERSECTION
GALV	GALVANIZED	W	WATER LINE
GD	GROUND	W/	WITH
HORIZ	HORIZONTAL	W/O	WITHOUT
HW	HOW WATER	WS	WELDED STEEL
IE	INVERT ELEVATION	WWF	WELDED WIRE FABRIC
INF	INFLUENT	WWM	WELDED WIRE MESH
INV	INVERT	YD	YARD

CODE INFORMATION

Project: PUEBLO DAM HYDROELECTRIC PROJECT
Address: PUEBLO CO
Engineer: Sorenson Engineering,Ted S. Sorenson P.E.
1032 GRANDVIEW DRIVE, IVINS, UT 84738
Owner: SOUTHEASTERN COLORADO WATER ACTIVITY ENTERPRISE
31717 E UNITED AVE, PUEBLO, CO 81001

Project Type: New
Occupancy Group: F-1/Special Purpose, Industrial
Construction Type: IIB - NON-COMBUSTABLE
Auto Fire Extinguishing System: No
Rated Corridor System: No
Maximum distance to Exit: 113 ft.
Number of Exits Required: 02
Maximum distance of Common Path of Travel: 49 ft.
Fire Resistance of Exterior Walls-Based on Separation Dist: 0 HR
60' Yard around building perimeter
Fire Resistance Rating Requirements for Building Elements
Structural Frame: 0 HR
Bearing Walls: Exterior 0 HR Interior 0 HR
Non–Bearing Walls: Exterior 0 HR Interior 0 HR
Floor Construction: 0 HR
Roof Construction: 0 HR
Shafts: 0 HR
Allowable Building Height: UL FT. 1 Story
Actual Building Area: UL SF
Ground Floor Area and Occupant Load
Floor area: 2282 SF Occupant Load: 23
Basement Floor Area and Occupant Load
Floor area: 3826 SF Occupant Load: 39

SORENSEN
ENGINEERING



SOUTHEASTERN COLORADO WATER
ACTIVITY ENTERPRISE
PUEBLO DAM HYDROELECTRIC PROJECT
LEGEND, ABBREVIATIONS, &
DETAIL/SECTION DESIGNATIONS

ALWAYS THINK SAFETY



AS CONSTRUCTED 2019

DESCRIPTION

REV. NO. TYP. AM. TO NAME, DATE, APPR.

A

B

C

D

DRAWING NUMBER

GA–2

Mountain States Hydro, LLC

P.O. Box 918 Sunnyside, WA. 98944
Off: (509) 837–6822
Fax: (509) 837–6801

DATE AND TIME PLOTTED
October 16, 2019 15:05
PLOTTED BY
MJO

QAD SYSTEM
QAD FILENAME
PUEBLO_TITLE-QAD.DWG

D	GENERAL NOTES (UNLESS OTHERWISE SPECIFIED)					NOTES (UNLESS OTHERWISE SPECIFIED)					SPECIFICATIONS (UNLESS OTHERWISE SPECIFIED)					SORENSEN ENGINEERING					PROJECT					DRAWING NUMBER					D
	1. ALL INSTRUCTIONS AND SPECIAL CONDITIONS CONTAINED ON THIS PLAN SET SHALL BE STRICTLY ADHERED TO. ANY DEVIATIONS SHALL BE APPROVED IN WRITING BY SORENSON ENGINEERING.					G1 SCOPE THE NOTES & TABLES ON THIS SHEET ARE GENERAL AND APPLY TO THE ENTIRE PROJECT EXCEPT WHERE THERE ARE SPECIFIC INDICATIONS TO THE CONTRARY.					EMBANKMENT REPAIR THE PORTION OF THE EXISTING EMBANKMENT AND/OR EXISTING NATIVE MATERIALS THAT WILL BE EXCAVATED FOR THE CONSTRUCTION OF FEATURES ASSOCIATED WITH THIS PROJECT SHALL BE REPLACED IN ACCORDANCE WITH THE PLANS PREPARED FOR THIS PROJECT. BACKFILL MATERIALS SHALL BE PLACED IN ACCORDANCE WITH THE PROJECT PLANS. EXCAVATION BELOW THE BOTTOM ELEVATIONS SHOWN ON THE PLAN SHEETS SHALL BE REPLACED WITH STRUCTURAL CONCRETE UNLESS OTHERWISE APPROVED BY THE ENGINEER. THE REQUIRED COMPACTION IN PIPE ZONES SHALL BE 95% OF LABORATORY STANDARD MAXIMUM DENSITY IN ACCORDANCE WITH AASHTO T99. BACKFILL IN THE PIPE ZONE SHALL BE PLACED IN 8-INCH MAXIMUM THICK LIFTS AND COMPACTED PRIOR TO THE PLACEMENT OF THE NEXT LIFT. COMPACTION ABOVE THE PIPE ZONE SHALL BE AS SHOWN ON THE PLAN SHEETS. REFER TO SECTION 02302 OF THE PROJECT SPECIFICATIONS FOR ADDITIONAL COMPACTION REQUIREMENTS.					PROJECT					DRAWING NUMBER										
	2. THE CONSTRUCTION METHODS AND MATERIALS SHALL MEET THE STANDARDS OF THE PROJECT ENGINEER AND AS SHOWN ON THESE PLANS AND SPECIFICATIONS. IN AREAS OF CONFLICT, THE DECISION OF THE ON-SITE PROJECT ENGINEER SHALL APPLY UNLESS OTHERWISE DIRECTED BY SORENSON ENGINEERING.					G2 APPLICABLE SPECIFICATIONS AND CODES CONSTRUCTION SHALL BE IN ACCORDANCE WITH THE CURRENT EDITION OF THE INTERNATIONAL BUILDING CODE. THE ABOVE SHALL GOVERN EXCEPT WHERE OTHER APPLICABLE CODES OR THE FOLLOWING NOTES ARE MORE RESTRICTIVE.					EROSION CONTROL FABRIC THE EROSION CONTROL FABRIC SHALL BE A BIODEGRADABLE NATURAL FIBER EROSION CONTROL FABRIC MANUFACTURED FROM UN-DYED AND UN-BLEACHED WOVEN JUTE MAT. THE MATERIAL SHALL HAVE A GRAB TENSILE OF 300 LBS/FT DRY AND 125 LBS/FT WET IN ACCORDANCE WITH ASTM D-4632. THE MATERIAL SHALL HAVE AN OPEN AREA OF 60 TO 65 PERCENT. THE MATERIAL SHALL BE ATTACHED TO THE COVERED SLOPE IN ACCORDANCE WITH THE SUPPLIER RECOMMENDATIONS. THE MATERIAL SHALL BE TOTALLY BIODEGRADEABLE WITHIN TWO YEARS. THE EROSION CONTROL FABRIC SHALL BE ANTI-WASH GEOJUTE AS MANUFACTURED BY BELTON INDUSTRIES, 8613 ROSWELL ROAD, ATLANTA, GA. 30350 (800) 225-4099 OR APPROVED EQUAL. 3/4" BACKFILL					PROJECT					DRAWING NUMBER										
	3. VERIFY THE EXACT LOCATION AND DEPTH OF UNDERGROUND FEATURES, POSSIBLE PIPELINES OR ELECTRICAL SERVICE AND WATERLINES TO IDENTIFY POSSIBLE AREAS OF CONFLICTS AND TO PREVENT DAMAGE TO SUCH UNDERGROUND UTILITIES. UNDERGROUND UTILITIES. THE ACTUAL LOCATIONS ARE TO BE VERIFIED BY THE CONTRACTOR PRIOR TO THE COMMENCEMENT OF ANY EXCAVATION ACTIVITIES.					G3 ALTERNATIVE DESIGNS THE STRUCTURAL SYSTEMS AND DETAILS ON THESE PLANS ARE THE PRIORITY DESIGN. ALTERNATIVE SYSTEMS AND DETAILS MAY BE USED IF THE CONTRACTOR SUBMITS PLANS WITH SUBSTANTIATING CALCULATIONS AND TEST DATA, AND IF THE ALTERNATIVE PLANS ARE ACCEPTED BY THE ENGINEER.					PERCENTAGE BY WEIGHT PASSING SQUARE MESH SIEVES					PROJECT					DRAWING NUMBER										
	4. GRADE ALL DISTURBED OR CUT AND FILLED AREAS ON SITE, AFTER CONSTRUCTION, WITH A UNIFORM SLOPE THAT WILL DRAIN WITHOUT PONDING OR DAMAGE TO EITHER ON-SITE OR OFF-SITE PROPERTY IMPROVEMENTS. GRADE ALL DISTURBED OR CUT AND FILL AREAS ON THE EXISTING EMBANKMENT TO MATCH THE EXISTING ADJOINING EMBANKMENT FINISHED GRADE SLOPES UNLESS OTHERWISE SPECIFIED.					G4 DIMENSIONS STRUCTURAL DIMENSIONS CONTROLLED BY OR RELATED TO MECHANICAL OR ELECTRICAL EQUIPMENT SHALL BE VERIFIED BY THE CONTRACTOR PRIOR TO CONSTRUCTION.					SIEVE SIZE					PROJECT					DRAWING NUMBER										
	5. THE CONTRACTOR SHALL BE RESPONSIBLE FOR PROVIDING AN AS-CONSTRUCTED DRAWING RECORD FOR THIS PROJECT. THE ENGINEER SHALL PROVIDE ONE ADDITIONAL SET OF DRAWINGS TO THE CONTRACTOR FOR THIS PURPOSE. THE AS-CONSTRUCTED DRAWING RECORD SHALL INDICATE ALL CHANGES OR DEVIATIONS FROM THE ENGINEERS DESIGN AS SHOWN ON THESE PLANS. APPROVED CHANGES OF FITTINGS, APPURTENANCES, GRADES, STRUCTURE DEPTHS, STATIONING AND ALIGNMENT SHALL BE DULY NOTED ON THESE AS-CONSTRUCTED PLANS. THE CONTRACTOR SHALL MAINTAIN THE AS-CONSTRUCTED DRAWINGS AND THE DEVIATIONS OF CONSTRUCTION FROM THE APPROVED CONSTRUCTION DRAWINGS AS WELL AS ALL FIELD VERIFIED LOCATIONS AND DEPTHS OF ALL EXISTING UTILITIES ENCOUNTERED SHALL BE NOTED. THE AS-CONSTRUCTED DRAWINGS SHALL BE KEPT UP-TO-DATE AT ALL TIMES AND AVAILABLE FOR DAILY INSPECTIONS BY THE ON SITE PROJECT ENGINEER. AT THE COMPLETION OF CONSTRUCTION, THE AS-CONSTRUCTED DRAWINGS WILL BE RETURNED TO THE ENGINEER ALONG WITH A "STATEMENT OF COMPLETION IN ACCORDANCE WITH THE AS-CONSTRUCTED DRAWINGS".					G5 PROVISIONS FOR EQUIPMENT MECHANICAL AND ELECTRICAL EQUIPMENT SUPPORTS, ANCHORAGES, OPENINGS, RECESSES AND EMBEDMENTS NOT SHOWN ON THE STRUCTURAL DRAWINGS BUT REQUIRED BY OTHER CONTRACT DRAWINGS SHALL BE PROVIDED PRIOR TO CASTING CONCRETE.					JOB MIX TARGET LIMITS					PROJECT					DRAWING NUMBER										
	6. THE CONTRACTOR SHALL BE RESPONSIBLE FOR INITIATING, MAINTAINING, SUPERVISING, AND COMPLYING WITH ALL APPLICABLE FEDERAL SAFETY AND HEALTH REGULATIONS AS DETERMINED BY THE STATE OF COLORADO AND BUREAU OF RECLAMATION HEALTH AND SAFETY REQUIREMENTS. THE CONTRACTOR SHALL BE REQUIRED TO COMPLY WITH ALL REGULATIONS AND REQUIREMENTS OF LOCAL COUNTY CODES & ORDINANCES.					G6 CONSTRUCTION LOADS STRUCTURES HAVE BEEN DESIGNED FOR OPERATIONAL LOADS ON COMPLETED STURCTURES AFTER THEY HAVE BEEN PROPERLY CURED. DURING CONSTRUCTION THE STRUCTURES SHALL BE PROTECTED BY BRACING AND SHORING WHEREEVER EXCESSIVE LOADS MAY OCCUR.					JOB MIX TOLERANCE					PROJECT					DRAWING NUMBER										
	7. SHOP DRAWINGS, INCLUDING SUPPLIERS MANUFACTURERS DRAWINGS, DATA SHEETS, CATALOG CUTS, BROCHURES OR OTHER PRINTED INFORMATION THAT CLEARLY DESCRIBES THE ITEM PROPOSED FOR USE AND ITS INSTALLATION CONFIGURATION SHALL BE SUBMITTED TO THE ENGINEER FOR REVIEW AND ACCEPTANCE FOR ALL SPECIFIED EQUIPMENT AND MATERIALS PRIOR TO SITE DELIVERY. THIS INCLUDES, BUT IS NOT LIMITED TO BUILDING SYSTEMS, CONTROLS, VALVES & PIPING ACCESSORIES, ELECTRICAL CONDUCTORS AND CONDUITS J-BOXES, AND MISCELLANEOUS HARDWARE.					G7 DRAINAGE SURFACES SLOPE DRAINAGE SURFACES UNIFORMLY TO DRAIN. SLOPE SHALL BE 1/4" PER FOOT EXCEPT WHERE OTHERWISE NOTED OR SHOWN ON THE PLANS.					1 INCH (25.4 MM)					PROJECT					DRAWING NUMBER										
						G8 FLOOR DRAINS & FLOOR GRATES SEE MECHANICAL DRAWINGS FOR SIZE AND TYPES.					3/4 INCH (19.0 MM)					PROJECT					DRAWING NUMBER										
	C											3/8 INCH (9.5 MM)					PROJECT					DRAWING NUMBER									
										NO. 4 (4.75 MM)					PROJECT					DRAWING NUMBER											
										NO. 40 (0.425 MM)					PROJECT					DRAWING NUMBER											
										NO. 200 (0.075 MM)					PROJECT					DRAWING NUMBER											
															PROJECT					DRAWING NUMBER											
															PROJECT					DRAWING NUMBER											
B																PROJECT					DRAWING NUMBER										
																PROJECT					DRAWING NUMBER										
																PROJECT					DRAWING NUMBER										
A																PROJECT					DRAWING NUMBER										
																PROJECT					DRAWING NUMBER										
																PROJECT					DRAWING NUMBER										
															PROJECT</																

[illegible]

--	--	
SORENSEN
ENGINEERING



PROJECT	DRAWING NUMBER

⊕ ALWAYS THINK SAFETY

PROJECT
SOUTHEASTERN COLORADO WATER
ACTIVITY ENTERPRISE
PUEBLO DAM HYDROELECTRIC PROJECT
STRUCTURAL NOTES
& SPECIFICATIONS

AS CONSTRUCTED 2019

DESCRIPTION
REV. NO. YYYY-MM-DD
NAME, DESG. ABBR.

Mountain States Hydro, LLC

P.O. Box 918
Sunnyside, WA. 98944
Off: (509) 837-6822
Fax: (509) 837-6801

GA-5

DATE AND TIME PLOTTED
October 1, 2019 13:05
DRAWN BY
MO
QAD SYSTEM
AND FILENAME
PUEBLO TITLE - GADWING

SPECIAL INSPECTION AND TESTING:

1. SPECIAL INSPECTION WILL BE PROVIDED BY THE OWNER BASED ON THE REQUIREMENTS OF THE IBC AS SUMMARIZED IN THE SPECIAL INSPECTION AND TESTING PROGRAM ON SHEET ***S0.0X***. THE CONTRACTOR SHALL PROVIDE SUFFICIENT NOTICE AND ACCESS FOR THE SPECIAL INSPECTOR TO PERFORM THESE INSPECTIONS.

TABLE 1					
REQUIRED GEOTECHNICAL SPECIAL INSPECTIONS					
SYSTEM or MATERIAL	INSPECTION				REMARKS
	IBC CODE REFERENCE	CODE or STANDARD REFERENCE	FREQUENCY		
			CONTINUOUS	PERIODIC	
SOILS					
GEOTECHNICAL INVESTIGATIONS	TABLE 1705.6 1803				GEOTECHNICAL INVESTIGATION SHALL INCLUDE ITEMS OF SPECIAL INSPECTION AND TESTING AS NOTED IN TABLE 5 OF THE GUIDELINES
VERIFY MATERIALS BELOW SHALLOW FOUNDATIONS ARE ADEQUATE TO ACHIEVE THE DESIGN BEARING CAPACITY	TABLE 1705.6			X (a)	BY THE GEOTECHNICAL ENGINEER
VERIFY EXCAVATIONS ARE EXTENDED TO PROPER DEPTH AND HAVE REACHED PROPER MATERIAL	TABLE 1705.6			X	
PERFORM CLASSIFICATION AND TESTING OF COMPACTED FILL MATERIALS	TABLE 1705.6 1803.5.1			X	TESTING OF COMPACTED FILL MATERIALS (SEE TABLE 5)
VERIFY USE OF PROPER MATERIALS, DENSITIES AND LIFT THICKNESSES DURING PLACEMENT AND COMPACTION OF COMPACTED FILL	TABLE 1705.6		X		BY THE GEOTECHNICAL ENGINEER
PRIOR TO PLACEMENT OF COMPACTED FILL, OBSERVE SUBGRADE AND VERIFY THAT SITE HAS BEEN PREPARED PROPERLY.	TABLE 1705.6			X	
MECHANICALLY STABILIZED EARTH (MSE) RETAINING WALLS					
INSTALLATION	1707.1	GEOTECHNICAL RESEARCH AND/OR REPORT AND ICC EVALUATION REPORTS	X		BY THE GEOTECHNICAL ENGINEER SPECIAL INSPECTIONS APPLY TO MODULAR UNIT PRODUCT NAME, TYPE, AND DIMENSIONS, FOUNDATION PREPARATION, MODULAR UNIT PLACEMENT, INCLUDING ALIGNMENT AND INCLINATION, GEOSYNTHETIC REINFORCEMENT PRODUCT NAME, TYPE, AND PLACEMENT, BACKFILL PLACEMENT AND COMPACTION, AND DRAINAGE PROVISIONS

TABLE 2					
REQUIRED STRUCTURAL SPECIAL INSPECTIONS					
SYSTEM or MATERIAL	INSPECTION				REMARKS
	IBC CODE REFERENCE	CODE or STANDARD REFERENCE	FREQUENCY		
			CONTINUOUS	PERIODIC	
FABRICATORS					
FABRICATORS	1704.2.5			X	SPECIAL INSPECTION IS REQUIRED FOR STRUCTURAL LOAD-BEARING MEMBERS AND ASSEMBLIES FABRICATED ON THE PREMISES OF A FABRICATOR'S SHOP.
	1704.2.5.1				THE SPECIAL INSPECTOR SHALL VERIFY THAT THE FABRICATOR MAINTAINS DETAILED FABRICATION AND QUALITY CONTROL PROCEDURES AND SHALL REVIEW FOR COMPLETENESS AND ADEQUACY RELATIVE TO THE CODE REQUIREMENT.
	1704.2.5.2				SPECIAL INSPECTIONS REQUIRED BY SECTION 1705 ARE NOT REQUIRED WHERE THE WORK IS DONE ON THE PREMISES OF A FABRICATOR REGISTERED AND APPROVED TO PERFORM SUCH WORK WITHOUT SPECIAL INSPECTION. APPROVAL SHALL BE BASED UPON REVIEW OF THE FABRICATOR'S WRITTEN PROCEDURAL AND QUALITY CONTROL MANUALS AND PERIODIC AUDITING OF FABRICATION PRACTICES BY A NATIONALLY RECOGNIZED ACCREDITING AUTHORITY. AT COMPLETION OF FABRICATION, THE APPROVED FABRICATOR SHALL SUBMIT A CERTIFICATE OF COMPLIANCE TO THE BUILDING OFFICIAL STATING THAT THE WORK WAS PERFORMED IN ACCORDANCE WITH THE APPROVED CONSTRUCTION DOCUMENTS.
CONCRETE					
INSPECTION OF ANCHORS INSTALLED IN HARDENED CONCRETE	1909.1 TABLE 1705.3	ACI 318: 3.8.6, 6.1.3, 21.1.8		X	SPECIAL INSPECTIONS APPLY TO ANCHOR PRODUCT NAME, TYPE, AND DIMENSIONS, HOLE DIMENSIONS, COMPLIANCE WITH DRILL BIT REQUIREMENTS, CLEANLINESS OF THE HOLE AND ANCHOR, ADHESIVE EXPIRATION DATE, ANCHOR/ADHESIVE INSTALLATION, ANCHOR EMBEDMENT, AND TIGHTENING TORQUE
REINFORCING STEEL PLACEMENT	1705.3 1910.4 1901.3.2	ACI 318: 3.5 ACI 318: 7.1-7.7		X	TOLERANCES AND REINFORCING PLACEMENT PER ACI 7.5; SPACING LIMITS FOR REINFORCING ACI 7.6 PROTECTION OF REINFORCEMENT PER ACI 7.7
WELDING REINFORCING STEEL	1705.2.2.1.2 1903.1	ACI 318: 3.5.2 AWS D1.4	X		REFER TO STEEL FOR WELDING REQUIREMENTS TABLE 1705.2.2, ITEM 2b
a. VERIFICATION OF WELDABILITY OF REINFORCING STEEL OTHER THAN ASTM A 706	TABLE 1705.2.2	AWS D1.4 ACI 318: SECTION 3.5.2		X	
PLACEMENT OF BOLTS INSTALLED IN CONCRETE	TABLE 1705.3 1906.5 1909.1	ACI 318: 1.3.2.C ACI 318: 8.1.3 ACI 318: 21.1.8 ACI 318 - APPENDIX D		X	ALL BOLTS VISUALLY INSPECTED
VERIFYING USE OF REQUIRED MIX DESIGN(S)	TABLE 1705.3 1904 1904.2 1910.2 1910.3	ACI 318: CHAPTER 4 ACI 318: 5.2-5.4		X	
CONCRETE PLACEMENT	TABLE 1705.3	ACI 318: 1.3.2.D ACI 318: 5.9 - 5.10	X		
SHOTCRETE PLACEMENT	TABLE 1705.3 1910.6-8		X		
CONCRETE PLACEMENT AT COMPOSITE SLABS		ASCE 9, CHAPTER 3	X		
CONCRETE/SHOTCRETE CURING	TABLE 1705.3 1910.9.1-3	ACI 318: 5.11-5.13		X	
VERIFICATION OF IN-SITU CONCRETE PRIOR TO REMOVAL OF FORMS AND SHORES FROM ELEVATED BEAMS AND STRUCTURAL SLABS	TABLE 1705.3	ACI 318: 6.2		X	
VERIFICATION OF FORMWORK	TABLE 1705.3	ACI 318: 6.1.1		X	SPECIAL INSPECTIONS APPLY TO SHAPE, LOCATION AND DIMENSIONS OF THE CONCRETE MEMBER BEING FORMED

TABLE 2-CONTINUED					
STEEL					
FABRICATION OF STRUCTURAL ELEMENTS	1704.2.5.2	AISC 360 N2		X	REFER TO INSPECTION OF FABRICATOR REQUIREMENTS APPROVAL BASED ON NATIONALLY RECOGNIZED ACCREDITING AUTHORITY
MATERIAL VERIFICATION OF HIGH-STRENGTH BOLTS, NUTS, AND WASHERS		AISC 360 A3.3 AISC 360 N 3.2 ASTM STANDARDS SPECIFIED IN CONSTRUCTION DOCUMENTS RCSC 2.1		X	MANUFACTURER'S CERTIFIED TEST REPORTS
SNUG-TIGHT JOINT HIGH-STRENGTH BOLT INSTALLATION	1705.2.1.1			X	ALL CONNECTIONS INSPECTED AND VERIFIED SNUG
PRETENSIONED AND SLIP-CRITICAL JOINT HIGH-STRENGTH BOLT INSTALLATION USING TURN-OF-THE-NUT METHOD WITH MATCH MARKING, TWIST-OFF BOLT OR DIRECT TENSION INDICATOR METHOD	1705.2.1.1			X	ALL CONNECTIONS INSPECTED. CONNECTIONS USING DIRECT TENSION INDICATORS, ALL BOLTS SHALL BE INSPECTED AFTER SNUGGING AND AFTER PRETENSIONING
PRETENSIONED AND SLIP-CRITICAL JOINT HIGH-STRENGTH BOLT INSTALLATION USING TURN-OF-THE-NUT METHOD WITHOUT MATCH MARKING OR CALIBRATED WRENCH METHOD	1705.2.1.1		X		ALL CONNECTIONS INSPECTED
MATERIAL VERIFICATION OF STRUCTURAL STEEL	1705.2.1 2203.1 TABLE 1705.2	ASTM A6 ASTM STANDARDS SPECIFIED IN CONSTRUCTION DOCUMENTS AISC 360 N3.2 AISC 360 A3.1 AISC 360 M5.5		X	CERTIFIED MILL TEST REPORTS
FOR OTHER STEEL, IDENTIFICATION MARKINGS TO CONFORM TO ASTM STANDARDS SPECIFIED IN THE APPROVED CONSTRUCTION DOCUMENTS	TABLE 1705.2	APPLICABLE ASTM MATERIAL STANDARDS		X	MANUFACTURER'S CERTIFIED TEST REPORTS
MATERIAL VERIFICATION OF WELD FILLER METALS	TABLE 1705.2	AISC 360 N3.2 AISC 360 A3.5 APPLICABLE AWS AS DOCUMENTS		X	MANUFACTURER'S CERTIFICATE OF COMPLIANCE
COMPLETE AND PARTIAL JOINT PENETRATION GROOVE WELDS	TABLE 1705.2	AWS D1.1 SECTION 6	X		ALL WELDS VISUALLY INSPECTED PER AWS D1.1 6.9
MULTIPASS FILLET WELDS	TABLE 1705.2	AWS D1.1 SECTION 6	X		ALL WELDS VISUALLY INSPECTED PER AWS D1.1 6.9
SINGLE PASS FILLET WELDS GREATER THAN 5/16"	TABLE 1705.2	AWS D1.1 SECTION 6	X		ALL WELDS VISUALLY INSPECTED PER AWS D1.1 6.9
PLUG AND SLOT WELDS	TABLE 1705.2	AWS D1.1 SECTION 6	X		ALL WELDS VISUALLY INSPECTED PER AWS D1.1 6.9
SINGLE PASS FILLET WELDS LESS THAN OR EQUAL TO 5/16"	TABLE 1705.2	AWS D1.1 SECTION 6	X		ALL WELDS VISUALLY INSPECTED PER AWS D1.1 6.9
FLOOR AND ROOF DECK WELDS	TABLE 1705.2	AWS D1.3 SECTION 7		X	ALL WELDS INSPECTED PER AWS D1.3 7.1
MATERIAL VERIFICATION OF REINFORCING STEEL FOR WELDING	TABLE 1705.2 1705.2.2.1.2	ACI 318: 3.5.2 AWS D1.4		X	CERTIFIED MILL TEST REPORTS
WELDING REINFORCING EXCEPT AS NOTED OTHERWISE	TABLE 1705.2 1705.2.2.1.2	ACI 318: 3.5.2 AWS D1.4		X	
VERIFICATION OF FRAME JOINT DETAILS INCLUDING MEMBER AND COMPONENT LOCATIONS, BRACING, AND STIFFENERS	TABLE 1705.2	AISC 360 N5.7		X (a)	
MATERIAL VERIFICATION OF ANCHOR BOLTS AND THREADED RODS		AISC 360 N3.2 AISC 360 A3.4 ASTM STANDARDS SPECIFIED IN CONSTRUCTION DOCUMENTS		X	MANUFACTURER'S CERTIFIED TEST REPORTS
VERIFYING USE OF PROPER WPS'S		AISC 360 N3.2			COPY OF WELDING PROCEDURE SPECIFICATIONS
VERIFYING WELDER AND WELDING INSPECTOR QUALIFICATIONS	1705.2.2.1			X	COPY OF QUALIFICATION CARDS
INSTALLATION OF ROOF DECKING	1705.1.1	ICC EVALUATION REPORT		X	SPECIAL INSPECTIONS APPLY TO DECKING TYPE, DEPTH AND GAGE, POWER ACTUATED FASTENERS, SCREWS, PROPRIETARY SIDE SEAM ATTACHMENTS, BUTTON PUNCHES AND SHEAR CONNECTORS
WELDING STUDS EXCEPT AS NOTED OTHERWISE			X		

TABLE 4					
REQUIRED INSPECTIONS FOR SPECIAL CASES					
SYSTEM or MATERIAL	INSPECTION				REMARKS
	IBC CODE REFERENCE	CODE or STANDARD REFERENCE	FREQUENCY		
			CONTINUOUS	PERIODIC	
PRE-ENGINEERED STRUCTURES					
FABRICATION AND ERECTION	1705.1.1		X (b)	x	REFER TO TABLE 2 OF THIS PLAN FOR FABRICATOR, WELDING, AND HIGH STRENGTH BOLTING SPECIAL INSPECTION REQUIREMENTS

TABLE 5					
REQUIRED TESTING FOR SPECIAL INSPECTIONS					
SYSTEM or MATERIAL	IBC CODE REFERENCE	CODE or STANDARD REFERENCE	TESTING		REMARKS
			FREQUENCY		
			CONTINUOUS	PERIODIC	
GEOTECHNICAL					
GEOTECHNICAL ENGINEER TO PERFORM TESTING OF COMPACTED FILL MATERIALS	1803				TESTING PER GEOTECHNICAL REPORT
FILL IN-PLACE DENSITY OR PREPARED SUBGRADE DENSITY	1705.6			X (a)	BY THE GEOTECHNICAL ENGINEER
MATERIAL VERIFICATION		VARIES: CLASSIFICATION AND TESTING OF CONTROLLED FILL MATERIALS		X (a)	BY THE GEOTECHNICAL ENGINEER
TENSION ANCHORS	1705.6		PERFORMANCE TEST FIRST (X) ANCHORS TO ***xxx%*** DL AND PROOF LOAD REMAINING ANCHORS TO ***xxx%*** DL		PER GEOTECHNICAL REPORT
CONCRETE					
AT THE TIME FRESH CONCRETE IS SAMPLED TO FABRICATE SPECIMENS FOR STRENGTH TESTS, PERFORM SLUMP AND AIR CONTENT TESTS, AND DETERMINE THE TEMPERATURE OF THE CONCRETE	TABLE 1705.3	ASTM C 172 ASTM C 31 ACI 318: 5.6, 5.8	X		FABRICATE SPECIMENS AT TIME FRESH CONCRETE IS PLACED ONCE EACH DAY FOR A GIVEN CLASS OF CONCRETE, OR LESS THAN ONCE FOR EACH 150 YDS OF CONCRETE, OR LESS THAN ONCE FOR EACH 5,000 FT2 OF SURFACE AREA FOR SLABS/WALLS, ONCE EACH SHIFT FROM IN-PLACE WORK OR FROM TEST PANEL AND MINIMUM ONE SPECIMEN FOR EACH 50 CUBIC YARDS. *PRECONSTRUCTION TESTS AS REQUIRED PER THE BUILDING OFFICIAL.*
CONCRETE STRENGTH	TABLE 1705.3	ASTM C39	X		
CONCRETE SLUMP	TABLE 1705.3	ASTM C143	X		
CONCRETE AIR CONTENT		ASTM C231	X		
CONCRETE TEMPERATURE		ASTM C1064	X		
SHOTCRETE STRENGTH	1910.10	ASTM C42	X		IBC 1910.10: SPECIMENS SHALL BE TAKEN FROM THE IN-PLACE OR FROM TEST PANELS, AND SHALL BE TAKEN AT LEAST ONCE EACH SHIFT, BUT NOT LESS THAN ONE FOR EACH 50 CUBIC YARDS OF SHOTCRETE
STEEL					
MAGNETIC PARTICLE (MT) AND ULTRASONIC (UT) TESTING OF WELDS	1705.2.2	MT - AWS D1.1 6.14.4 UT - AWS D1.1 6.13 & 6.14.3		PER DRAWINGS	
PRE-CONSTRUCTION TESTING OF WELDING STUDS	1705.2.2	AWS D1.1 7.7.1		EACH SIZE AND TYPE OF STUD EACH SHIFT	THIS TESTING PERFORMED BY CONTRACTOR AND CONFIRMED BY SPECIAL INSPECTOR.
STUD APPLICATION QUALIFICATION	1705.2.2	AWS D1.1 7.6		NON-PREQUALIFIED APPLICATIONS	THIS TESTING PERFORMED BY CONTRACTOR AND CONFIRMED BY SPECIAL INSPECTOR.
PRE-INSTALLATION VERIFICATION OF PRETENSIONED HIGH STRENGTH BOLTS	1705.2.2	RCSC SPECIFICATION FOR STRUCTURAL JOINTS USING ASTM A325 OR A490 BOLTS SECTION 7		EACH COMBINATION OF DIAMETER, LENGTH, GRADE, AND LOT TO BE USED IN THE WORK	

SORENSEN
ENGINEERING

ALWAYS THINK SAFETY

SOUTHEASTERN COLORADO WATER
ACTIVITY ENTERPRISE
PUEBLO DAM HYDROELECTRIC PROJECT
STRUCTURAL INSPECTIONS

AS CONSTRUCTED 2019

STRUCTURAL INSPECTIONS

GA-7

Mountain States Hydro, LLC

P.O. Box 918
Sunnyside, WA. 98944
OFF: (509) 837-6822
FAX: (509) 837-6801

DATE AND TIME PLOTTED:
September 27, 2019 17:15
PLOTTED BY:
MDO

CAD SYSTEM
AUTOCAD
PLOT FILE: 8-27-19.DWG

NOTES:
1. NEW 15' MIN. ROADWAY ACCESS TO REMAIN OPEN
THROUGHOUT DURATION OF PROJECT
CONSTRUCTION.



CIVIL SITE
ACCESS & STAGING PLAN

SCALE: 1" = 80'-0"

1
C-1

Mountain States Hydro, LLC

P.O. Box 918
Sunnyside, WA. 98944
OFF: (509) 837-6822
FAX: (509) 837-6801



ALWAYS THINK SAFETY

AS CONSTRUCTED 2019

CIVIL SITE- PLAN VIEW
ACCESS & STAGING PLAN

SOUTHEASTERN COLORADO WATER
ACTIVITY ENTERPRISE
PUEBLO DAM HYDROELECTRIC PROJECT
CIVIL SITE- PLAN VIEW
ACCESS & STAGING PLAN


C-1

REV. NO. 1
DATE
DESCRIPTION

NAME, DATE, APPR.

DRAWING NUMBER

DATE AND TIME PLOTTED: September 27, 2019 17:15
PLOT BY: JAC
CAD SYSTEM: AutoCAD
PLOT FILENAME: P:\CIVIL 9-27-19.DWG

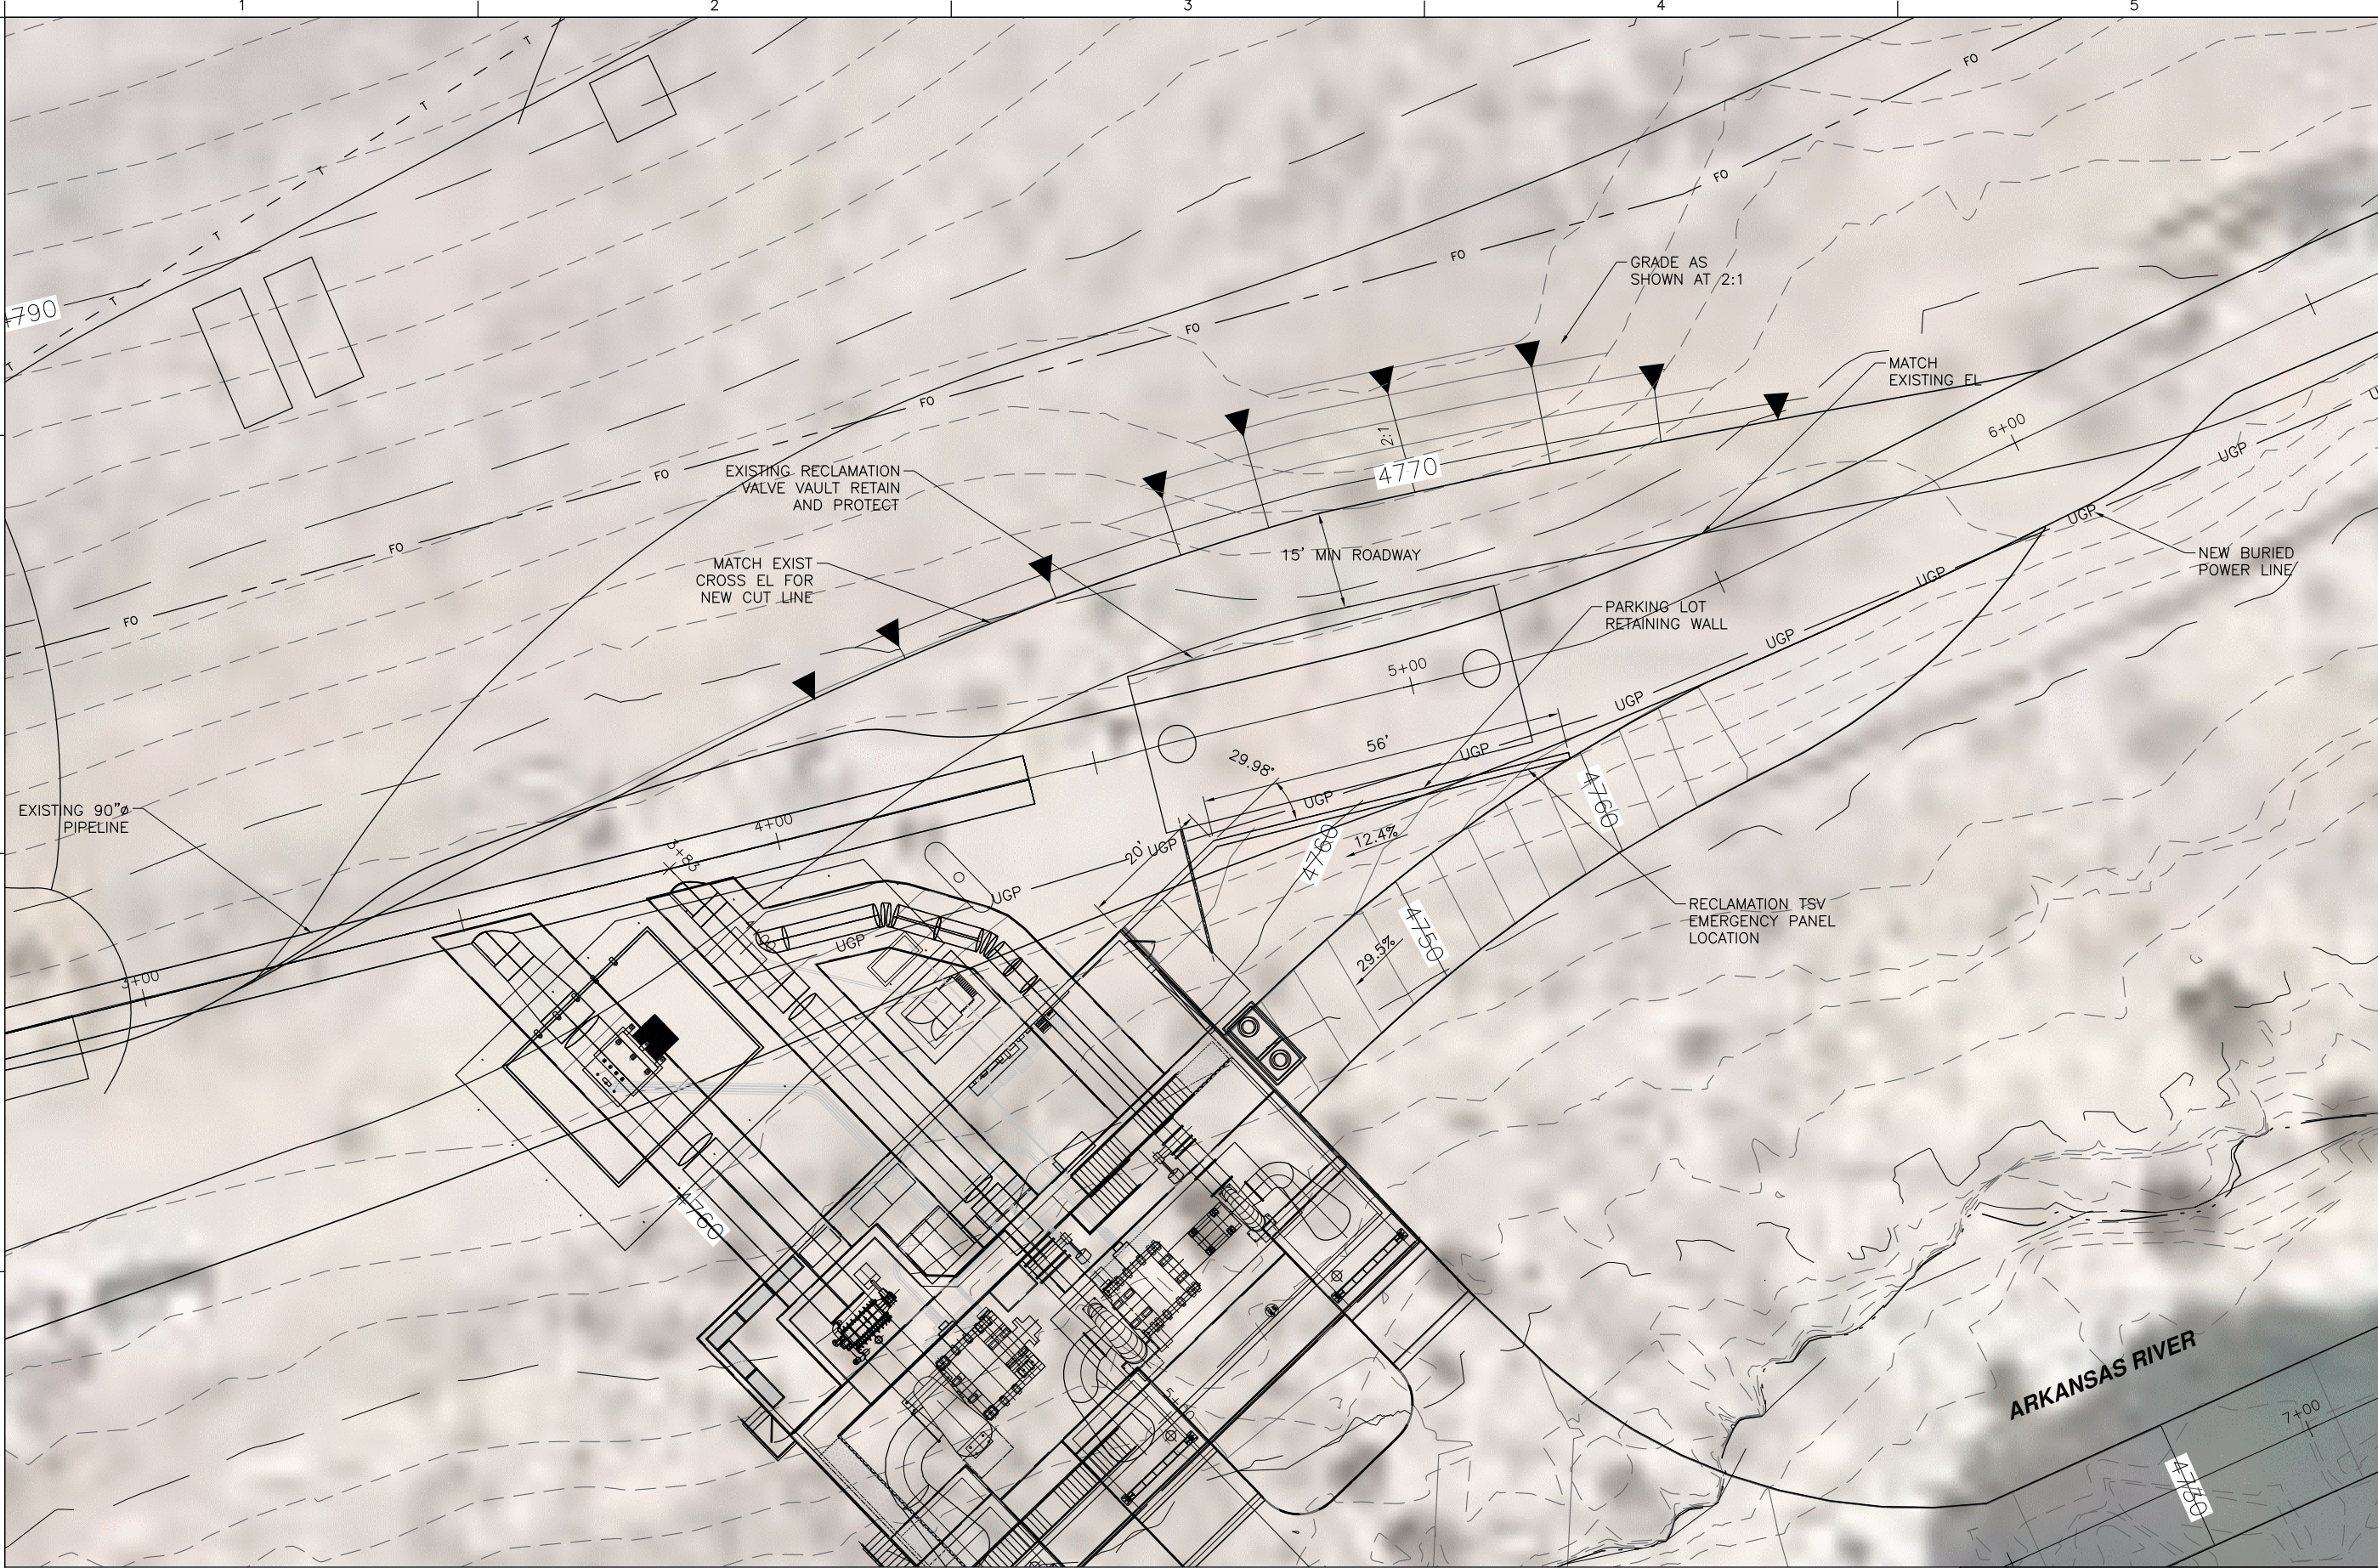

- NOTES:
1. NEW 15' MIN. ROADWAY ACCESS TO REMAIN OPEN THROUGHOUT DURATION OF PROJECT CONSTRUCTION.



CIVIL SITE
ACCESS & STAGING PLAN

SCALE: 1" = 25'-0"

1
C-2

Mountain States Hydro, LLC

P.O. Box 918
Sunnyside, WA. 98944
OFF: (509) 837-6822
FAX: (509) 837-6801

ALWAYS THINK SAFETY

AS CONSTRUCTED 2019

CIVIL SITE- PLAN VIEW
ACCESS & STAGING PLAN

C-2



PROJECT
SOUTHEASTERN COLORADO WATER
ACTIVITY ENTERPRISE
PUEBLO DAM HYDROELECTRIC PROJECT
CIVIL SITE- PLAN VIEW
ACCESS & STAGING PLAN

REV. NO. 11/17/14-MJ-20
NAME, DATE, REVISION

DRAWING NUMBER

DATE AND TIME PLOTTED
September 27, 2019 17:15
PLOTTED BY
MDO

CAD SYSTEM
AUTOCAD
PLOT DATE
9-27-19.DWG



CIVIL SITE
EXCAVATION PLAN
SCALE: 1" = 30'-0"

1
C-3

Mountain States Hydro, LLC

P.O. Box 918
Sunnyside, WA. 98944
OFF: (509) 837-6822
FAX: (509) 837-6801

ALWAYS THINK SAFETY




SOUTHEASTERN COLORADO WATER
ACTIVITY ENTERPRISE
PUEBLO DAM HYDROELECTRIC PROJECT
CIVIL SITE - PLAN VIEW
EXCAVATION PLAN

AS CONSTRUCTED 2019

CIVIL SITE - PLAN VIEW
EXCAVATION PLAN

C-3

CAD SYSTEM
AUTOCAD
STRUCTURAL 9-27-19 AS CONSTRUCTED
DATE AND TIME PLOTTED
October 1, 2019 12:25
PLOTTED BY
MO

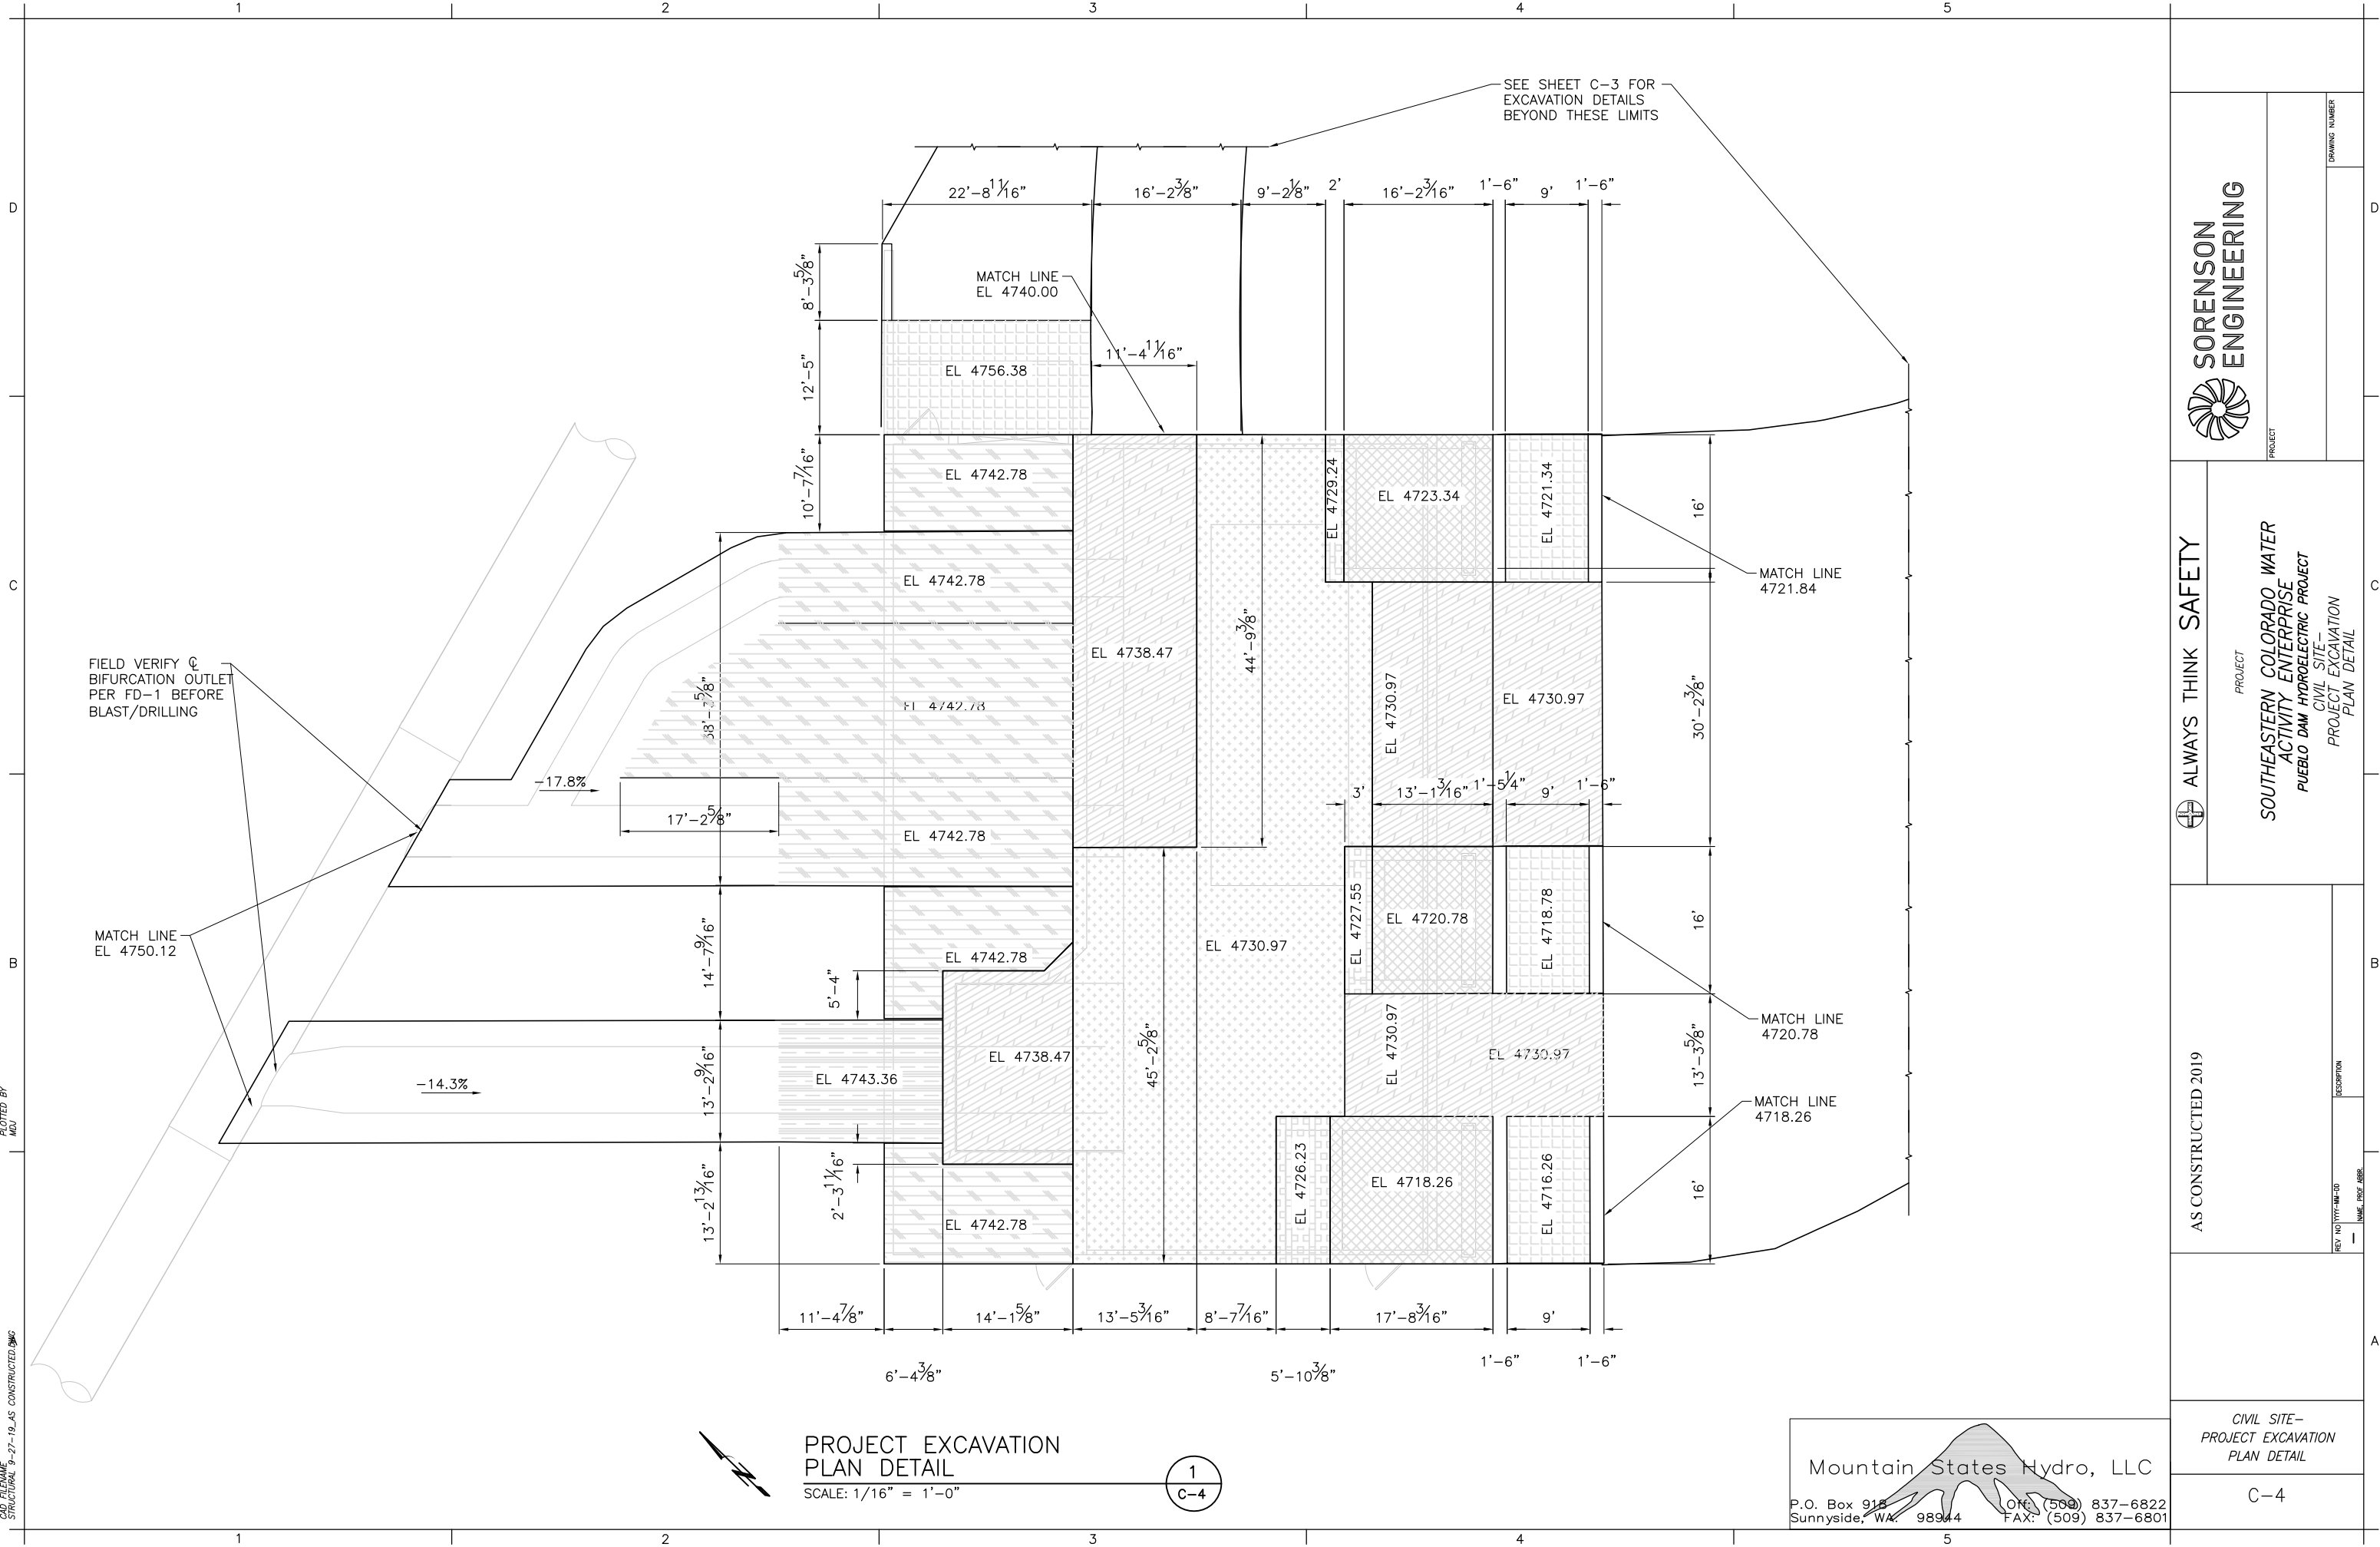

ALWAYS THINK SAFETY

PROJECT
SOUTHEASTERN COLORADO WATER
ACTIVITY ENTERPRISE
PUEBLO DAM HYDROELECTRIC PROJECT
CIVIL SITE-
PROJECT EXCAVATION
PLAN DETAIL

AS CONSTRUCTED 2019


REV. NO. 1/17/19-AM-20
NAME, DATE, APPR.

CIVIL SITE-
PROJECT EXCAVATION
PLAN DETAIL

C-4





DATE AND TIME PLOTTED: October 11, 2019 12:25
AUTOCAD NAME: JMO
STRUCTURAL 9-27-19 AS CONSTRUCTED JMO

CAD SYSTEM: AUTOCAD

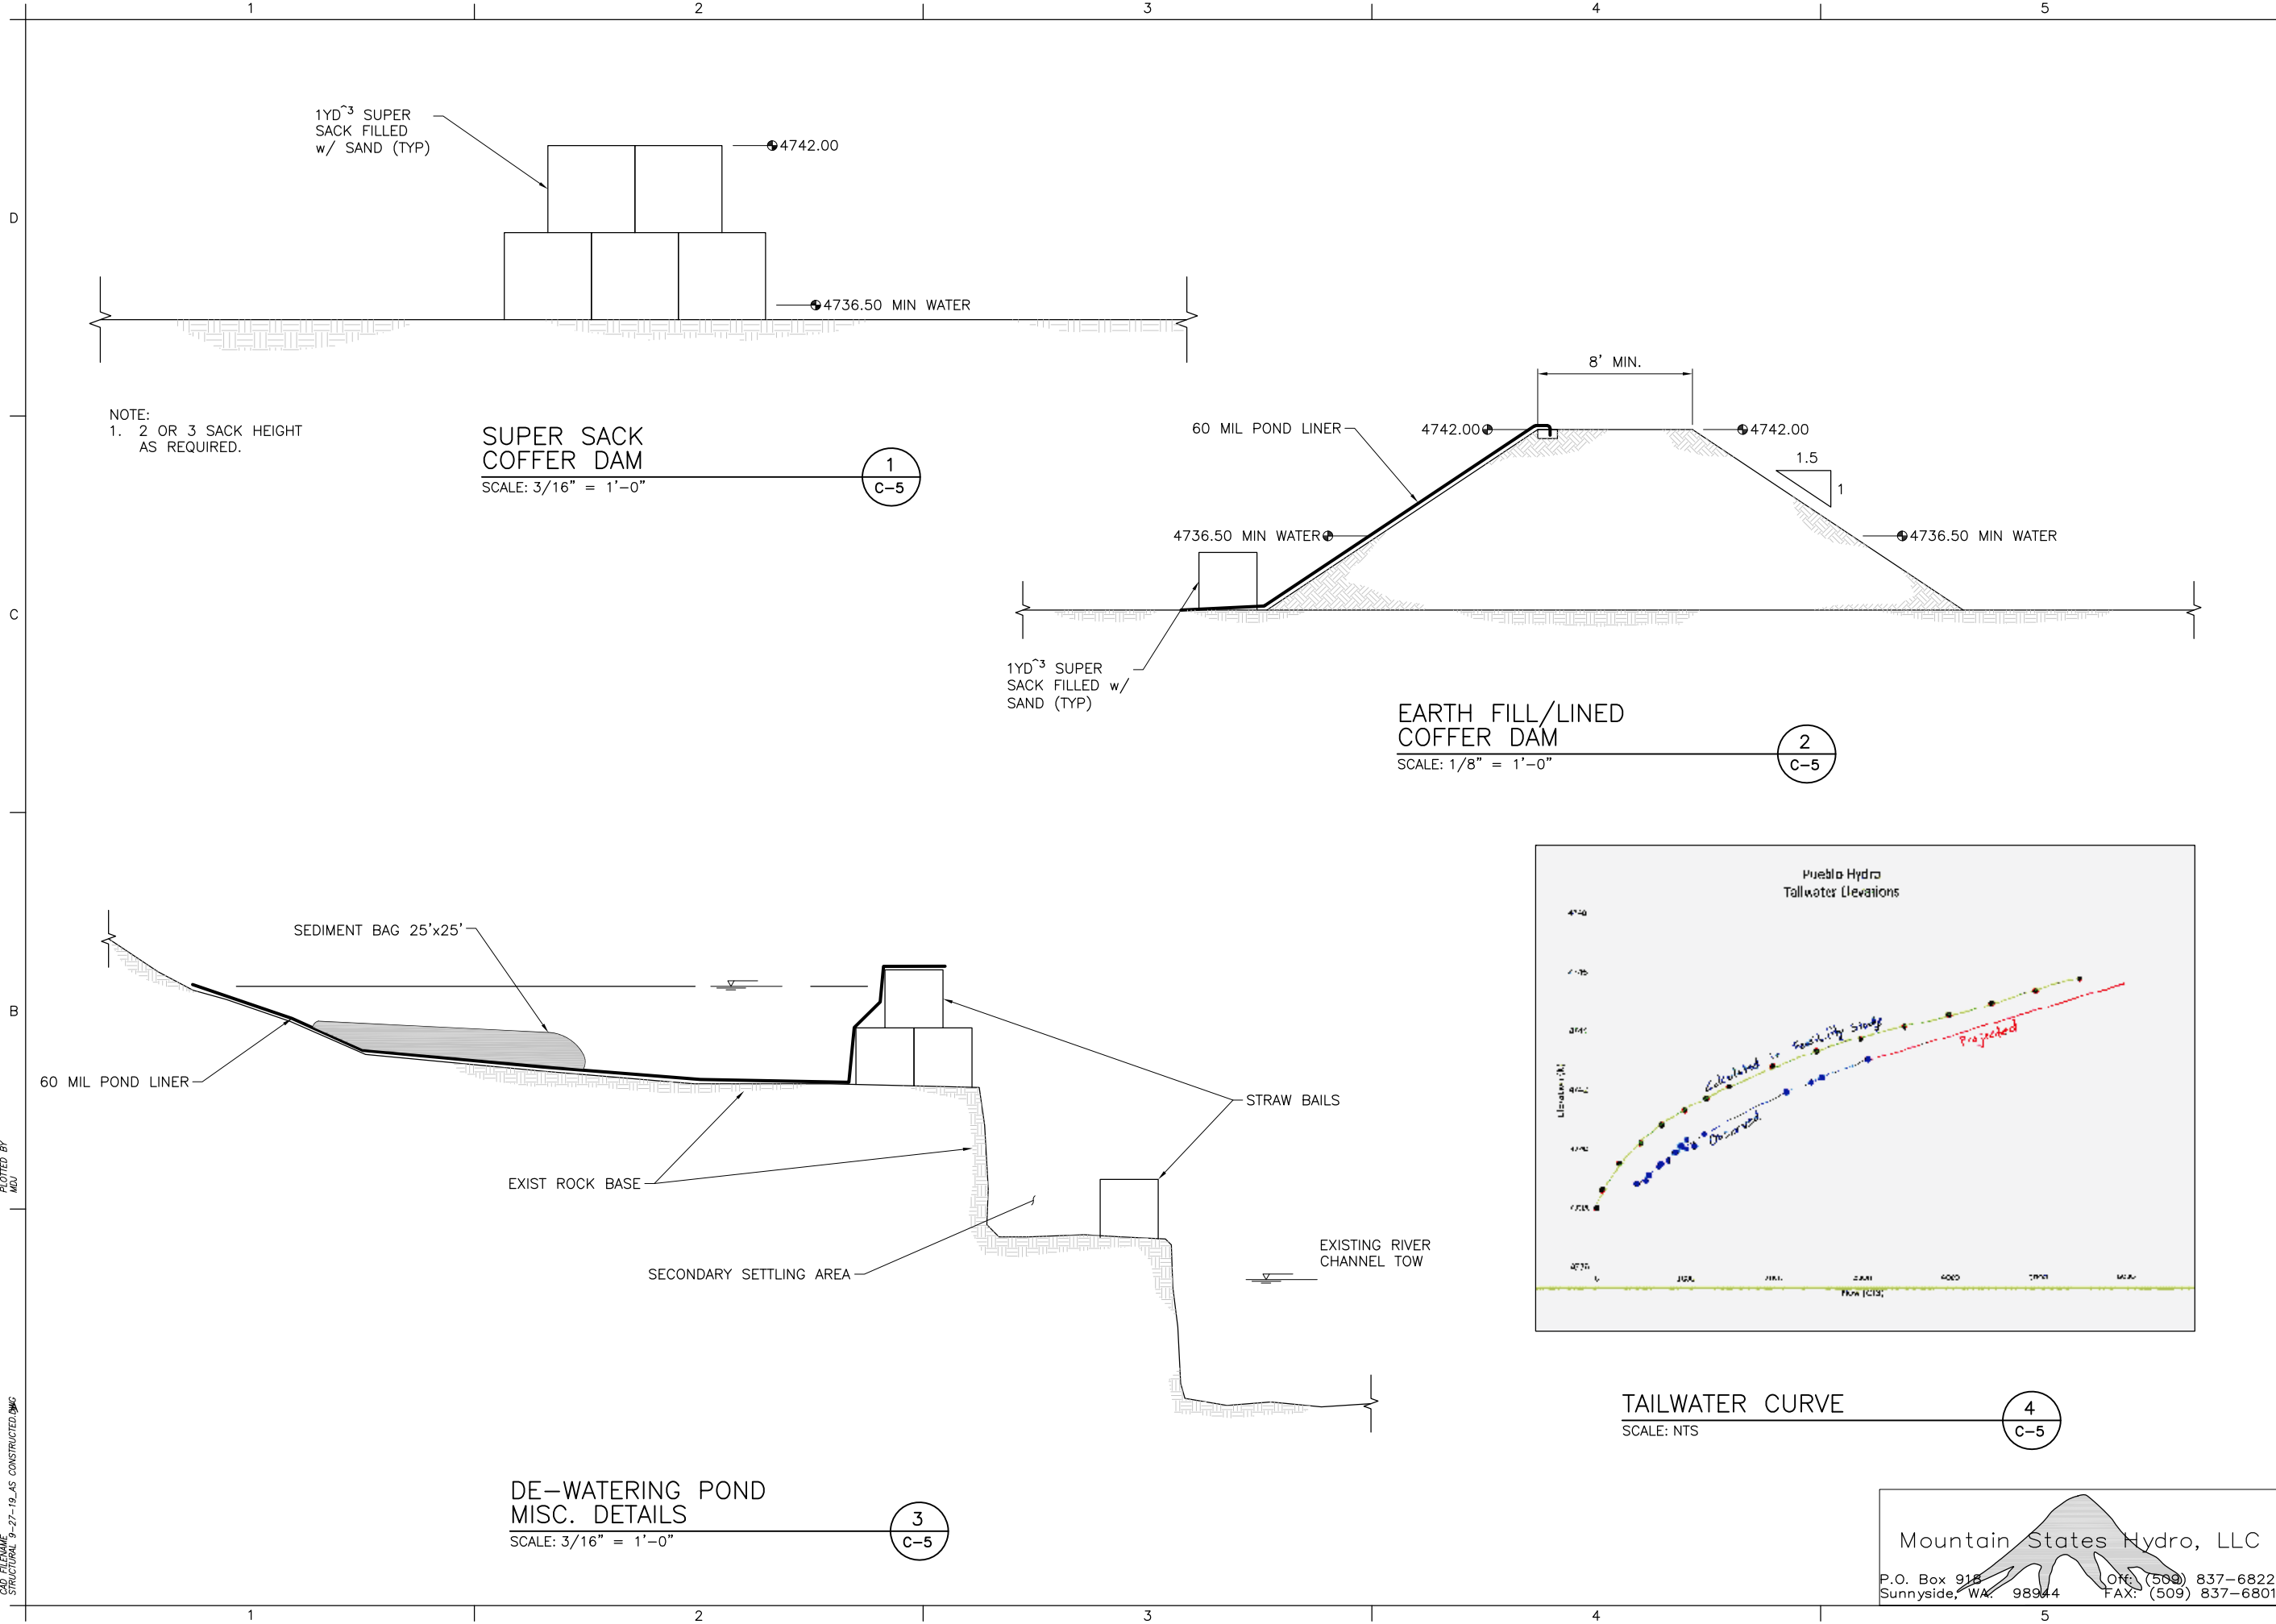

Mountain States Hydro, LLC
P.O. Box 918
Sunnyside, WA. 98944
OFF: (509) 837-6822
FAX: (509) 837-6801

SORENSEN ENGINEERING	PROJECT	
	PROJECT	DRAWING NUMBER
ALWAYS THINK SAFETY	PROJECT	
	SOUTHEASTERN COLORADO WATER ACTIVITY ENTERPRISE PUEBLO DAM HYDROELECTRIC PROJECT CIVIL SITE - DEWATERING/COFFERDAM MISC. DETAILS	DESCRIPTION
AS CONSTRUCTED 2019	REVISION	
	REV NO	DATE
CIVIL SITE - DEWATERING/COFFERDAM MISC. DETAILS	C-5	
	C-5	

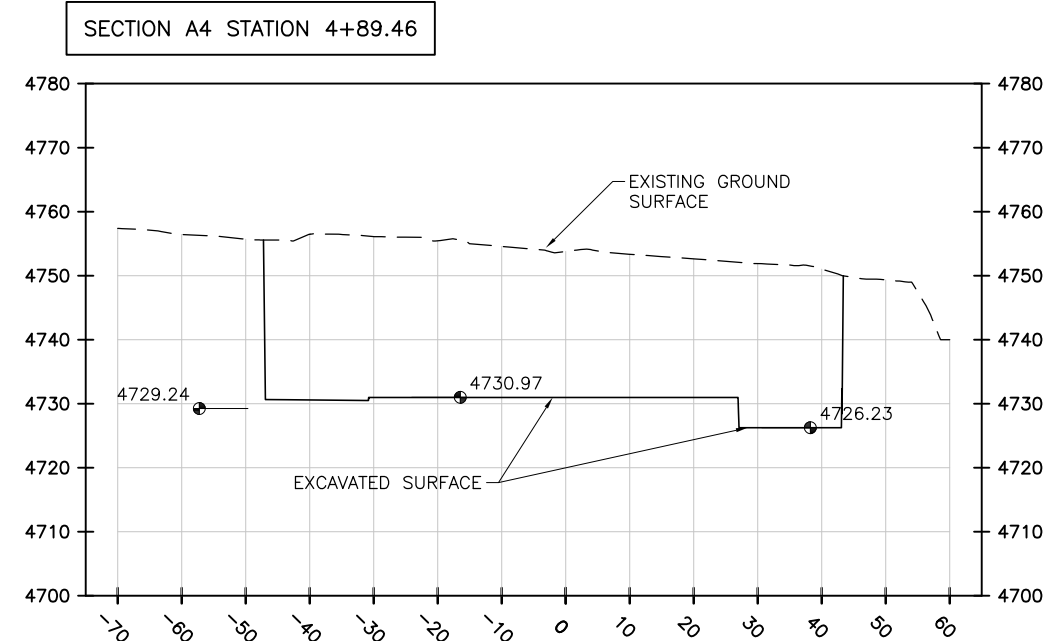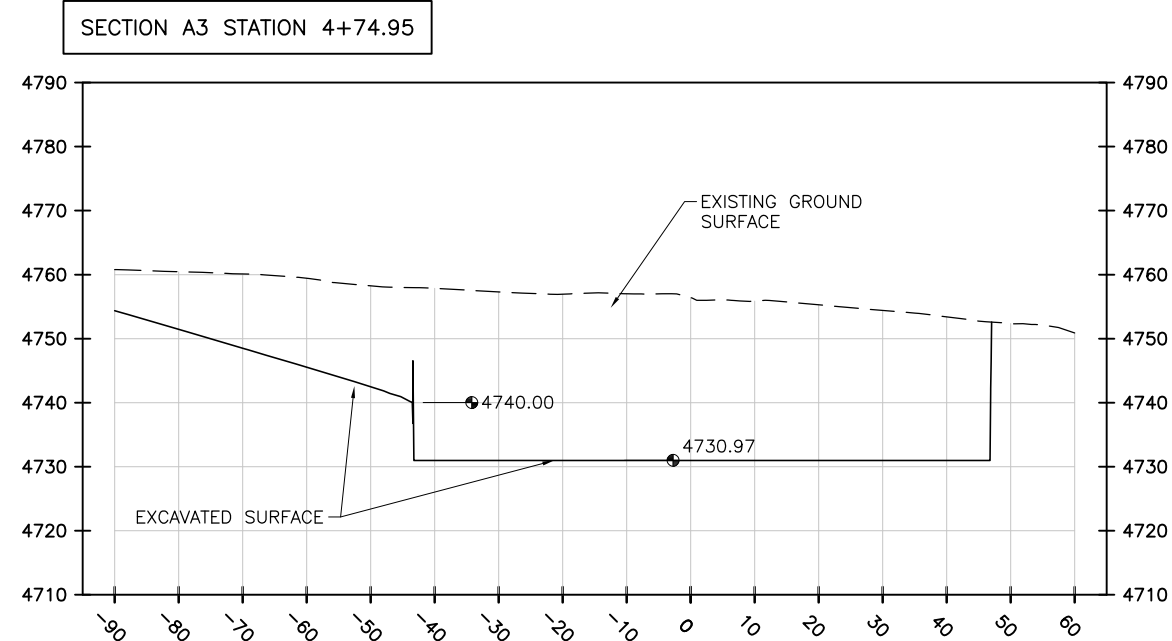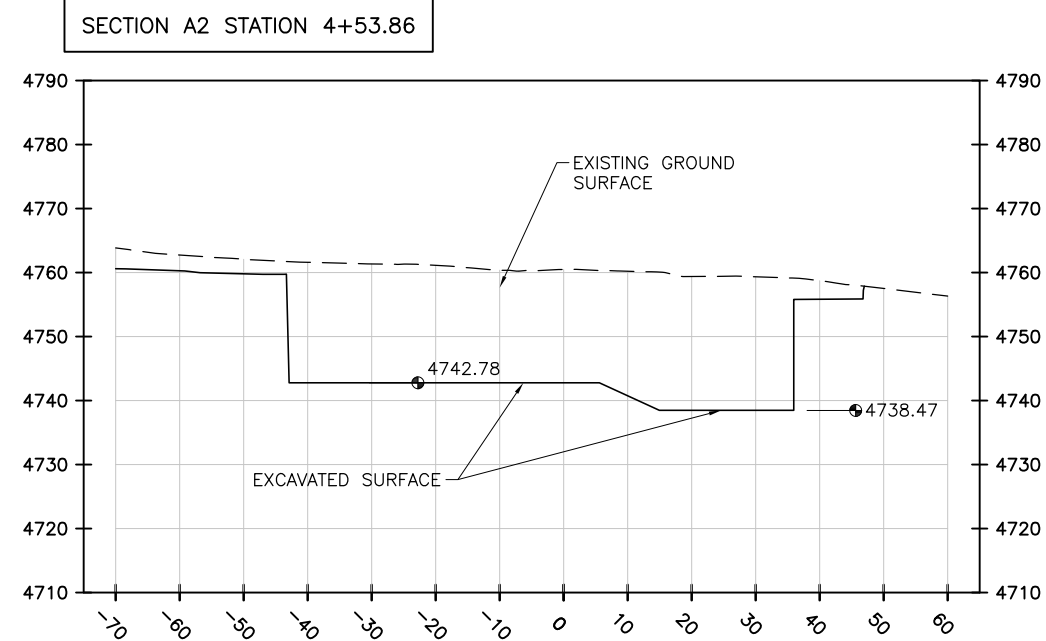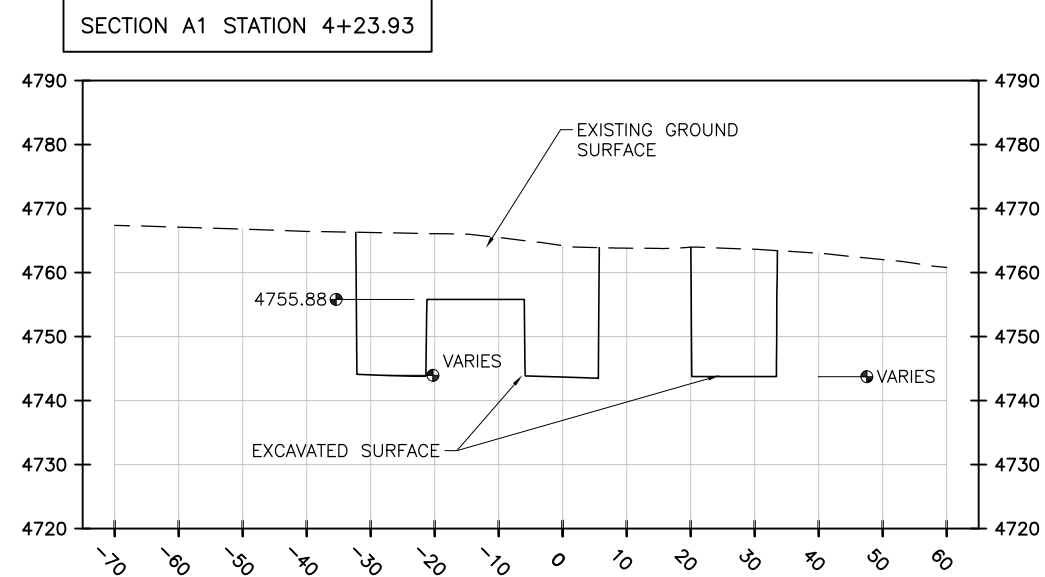

GENERAL NOTES:

1. EXCAVATION PLAN CUTS BASED ON GEOTECHNICAL DATA PRESENTED IN "SOUTHERN DELIVERY SYSTEM, GEOLOGIC AND GEOTECHNICAL DATA REPORT FOR PUEBLO DAM CONNECTIONS", BY RJH CONSULTANTS, INC. DATED SEPTEMBER 28, 2009. ALL CUTS ASSUMED TO BE IN SANDSTONE BEDROCK.
2. EXCAVATION CUTS MUST BE INSPECTED BY DOWL TO DETERMINE IF BEDDING, SEAMS, OR JOINTING IN THE SANDSTONE WARRANTS REMEDIAL RECOMMENDATIONS.
3. FREEZE/THAW CYCLES COULD CAUSE LOCALIZED SPALLING OF ROCK MATERIALS THAT COULD BE A SAFETY HAZARD TO WORKERS.
4. WHILE A REASONABLE EFFORT HAS BEEN MADE TO DESIGN THIS EXCAVATION PLAN FROM AVAILABLE INFORMATION, SUBSURFACE VARIATIONS/ANOMOLIES THAT DIFFER FROM THOSE ASSUMED MAY BE ENCOUNTERED. SUCH VARIATIONS MAY REQUIRE REMEDIAL MEASURES. THE NEED FOR SUCH MEASURES WILL BE HANDLED ON A CASE BY CASE BASIS AFTER DISCOVERY AND EVALUATION OF SUCH VARIATIONS/ANOMOLIES.

CIVIL SITE- EXCAVATION "A" CROSS SECTIONS

SCALE: 1" = 30'-0"

$$\frac{1}{x-1}$$

Mountain States Hydro, LLC

P.O. Box 918
Sunnyside, WA. 98944

Off: (509) 837-6822
FAX: (509) 837-6801

ALWAYS THINK SAFETY

PROJECT
SOUTHEASTERN COLORADO WATER
ACTIVITY ENTERPRISE
PUEBLO DAM HYDROELECTRIC PROJECT
CIVIL SITE -
EXCAVATION PLAN
CROSS SECTIONS



SORENSEN
ENGINEERING

REV NO	DESCRIPTION
—	NAME, PROF ASSG.

A

CIVIL SITE-
EXCAVATION PLAN
CROSS SECTIONS


$$X-1$$

DATE AND TIME PLOTTED
September 27, 2019 17:15
PLOTTED BY
MDJ


CAD SYSTEM
AUTOCAD

CAD FILENAME
P-CIVIL 9-27-19.DWG


SECTION A5 STATION 4+96.02

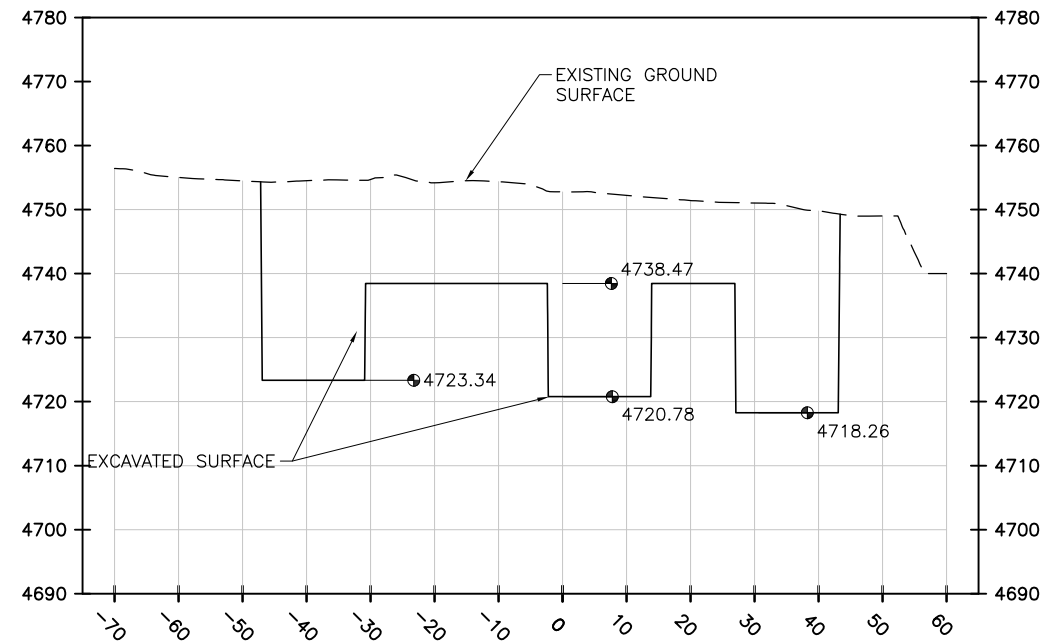


SECTION A6 STATION 5+12.98

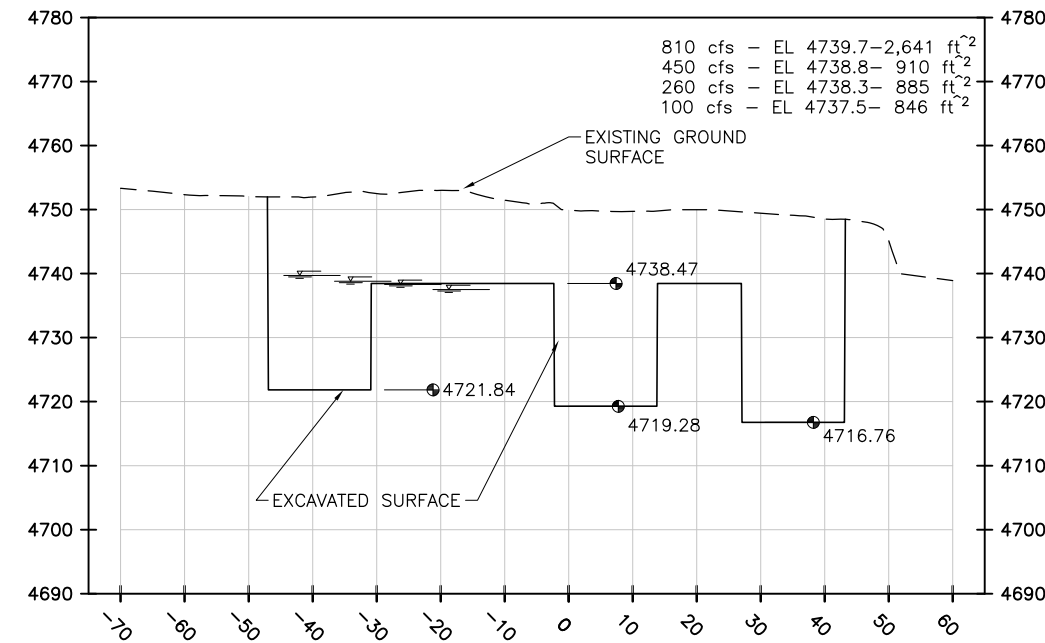

SECTION A7 STATION 5+23.30

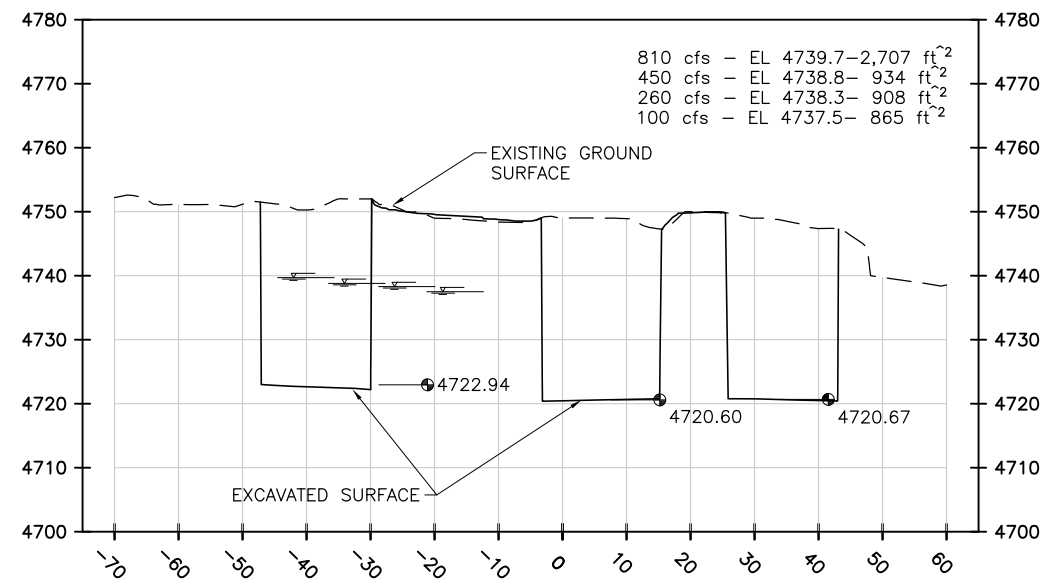

SECTION A8 STATION 5+53.00

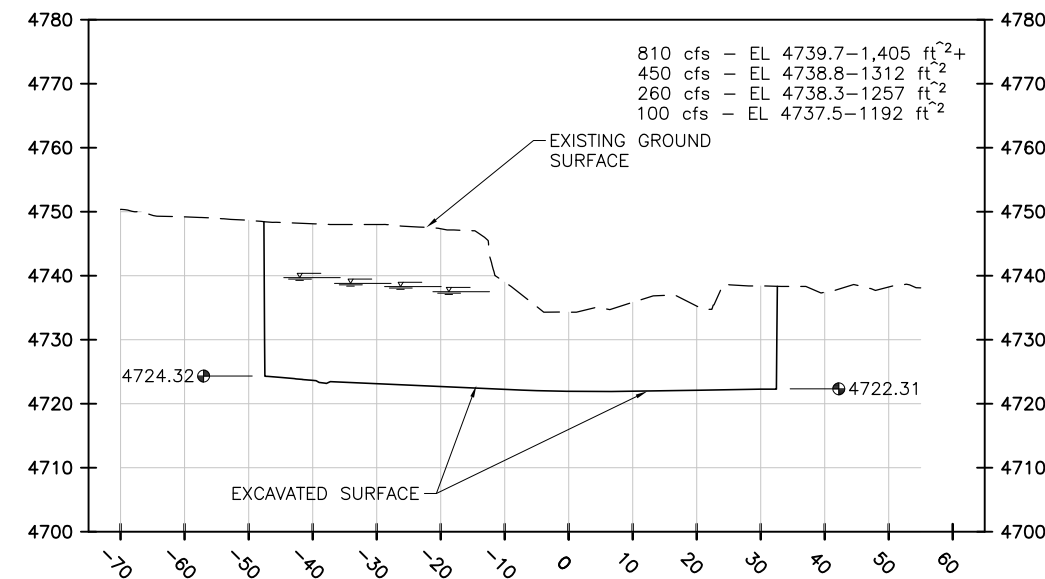

GENERAL NOTES:

- EXCAVATION PLAN CUTS BASED ON GEOTECHNICAL DATA PRESENTED IN "SOUTHERN DELIVERY SYSTEM, GEOLOGIC AND GEOTECHNICAL DATA REPORT FOR PUEBLO DAM CONNECTIONS", BY RJH CONSULTANTS, INC. DATED SEPTEMBER 28, 2009. ALL CUTS ASSUMED TO BE IN SANDSTONE BEDROCK.
- EXCAVATION CUTS MUST BE INSPECTED BY DOWL TO DETERMINE IF BEDDING, SEAMS, OR JOINTING IN THE SANDSTONE WARRANTS REMEDIAL RECOMMENDATIONS.
- FREEZE/THAW CYCLES COULD CAUSE LOCALIZED SPALLING OF ROCK MATERIALS THAT COULD BE A SAFETY HAZARD TO WORKERS.
- WHILE A REASONABLE EFFORT HAS BEEN MADE TO DESIGN THIS EXCAVATION PLAN FROM AVAILABLE INFORMATION, SUBSURFACE VARIATIONS/ANOMOLIES THAT DIFFER FROM THOSE ASSUMED MAY BE ENCOUNTERED. SUCH VARIATIONS MAY REQUIRE REMEDIAL MEASURES. THE NEED FOR SUCH MEASURES WILL BE HANDLED ON A CASE BY CASE BASIS AFTER DISCOVERY AND EVALUATION OF SUCH VARIATIONS/ANOMOLIES.

CIVIL SITE- EXCAVATION
"A" CROSS SECTIONS

SCALE: 1" = 30'-0"

1
X-2

Mountain States Hydro, LLC

P.O. Box 918
Sunnyside, WA. 98944
OFF: (509) 837-6822
FAX: (509) 837-6801



ALWAYS THINK SAFETY

PROJECT
SOUTHEASTERN COLORADO WATER
ACTIVITY ENTERPRISE
PUEBLO DAM HYDROELECTRIC PROJECT
CIVIL SITE-
EXCAVATION PLAN
CROSS SECTIONS

AS CONSTRUCTED 2019

DESCRIPTION
REV NO 10/14/19-10/14/19
NAME, DATE, APPR.


CIVIL SITE-
EXCAVATION PLAN
CROSS SECTIONS

X-2


DATE AND TIME PLOTTED
September 27, 2019 17:15
PLOTTED BY
MOJ

CAD SYSTEM
AUTOCAD
P-CAD 9-27-19.DWG


SECTION A9 STATION 6+18.00

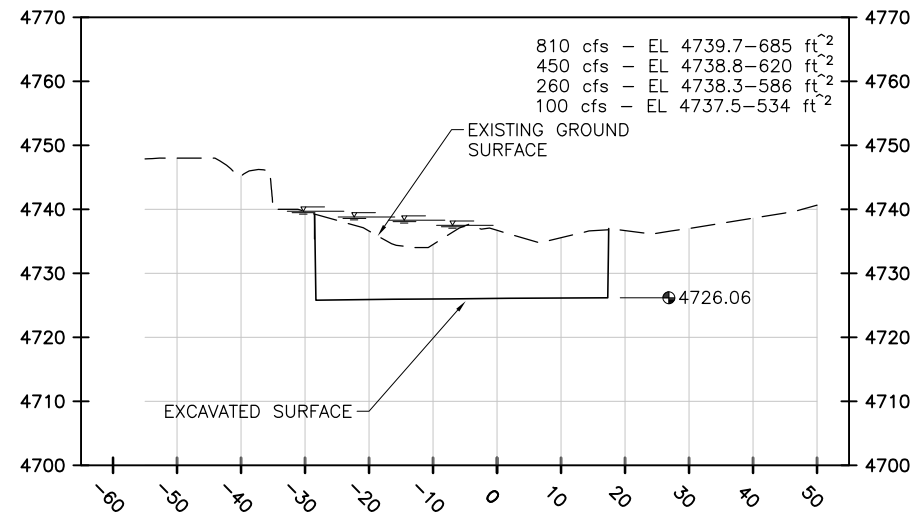


SECTION A10 STATION 6+50.00

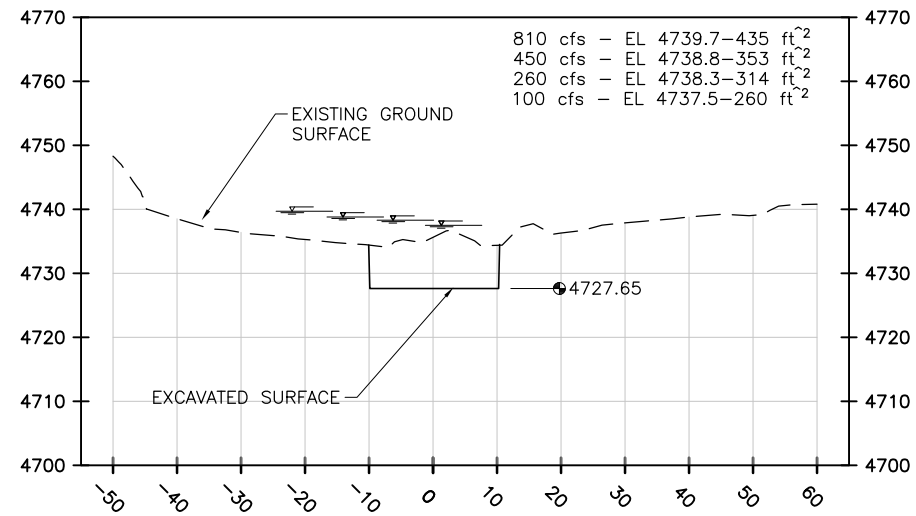

SECTION A11 STATION 7+00.00

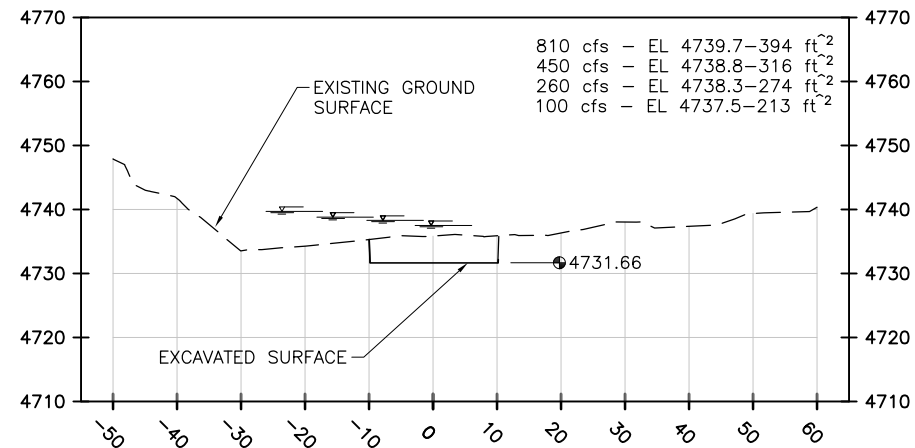

SECTION A12 STATION 7+47.63

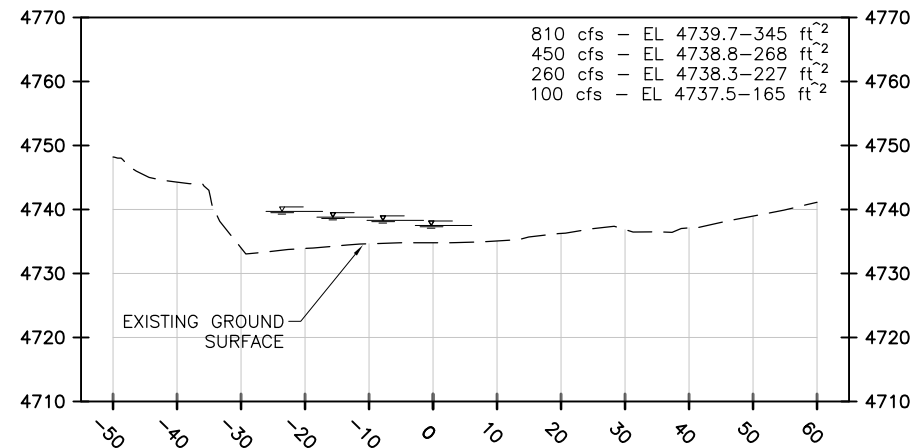

GENERAL NOTES:

1. EXCAVATION PLAN CUTS BASED ON GEOTECHNICAL DATA PRESENTED IN "SOUTHERN DELIVERY SYSTEM, GEOLOGIC AND GEOTECHNICAL DATA REPORT FOR PUEBLO DAM CONNECTIONS", BY RJH CONSULTANTS, INC. DATED SEPTEMBER 28, 2009. ALL CUTS ASSUMED TO BE IN SANDSTONE BEDROCK.
2. EXCAVATION CUTS MUST BE INSPECTED BY DOWL TO DETERMINE IF BEDDING, SEAMS, OR JOINTING IN THE SANDSTONE WARRANTS REMEDIAL RECOMMENDATIONS.
3. FREEZE/THAW CYCLES COULD CAUSE LOCALIZED SPALLING OF ROCK MATERIALS THAT COULD BE A SAFETY HAZARD TO WORKERS.
4. WHILE A REASONABLE EFFORT HAS BEEN MADE TO DESIGN THIS EXCAVATION PLAN FROM AVAILABLE INFORMATION, SUBSURFACE VARIATIONS/ANOMOLIES THAT DIFFER FROM THOSE ASSUMED MAY BE ENCOUNTERED. SUCH VARIATIONS MAY REQUIRE REMEDIAL MEASURES. THE NEED FOR SUCH MEASURES WILL BE HANDLED ON A CASE BY CASE BASIS AFTER DISCOVERY AND EVALUATION OF SUCH VARIATIONS/ANOMOLIES.

CIVIL SITE- EXCAVATION
"A" CROSS SECTIONS

SCALE: 1" = 30'-0"

1
X-3

Mountain States Hydro, LLC

P.O. Box 918
Sunnyside, WA. 98944
OFF: (509) 837-6822
FAX: (509) 837-6801



ALWAYS THINK SAFETY






PROJECT
SOUTHEASTERN COLORADO WATER
ACTIVITY ENTERPRISE
PUEBLO DAM HYDROELECTRIC PROJECT
CIVIL SITE-
EXCAVATION PLAN
CROSS SECTIONS

AS CONSTRUCTED 2019

DESCRIPTION
REV. NO. YYYY-MM-DD
NAME, PROJ. ASSG.

CIVIL SITE-
EXCAVATION PLAN
CROSS SECTIONS

X-3

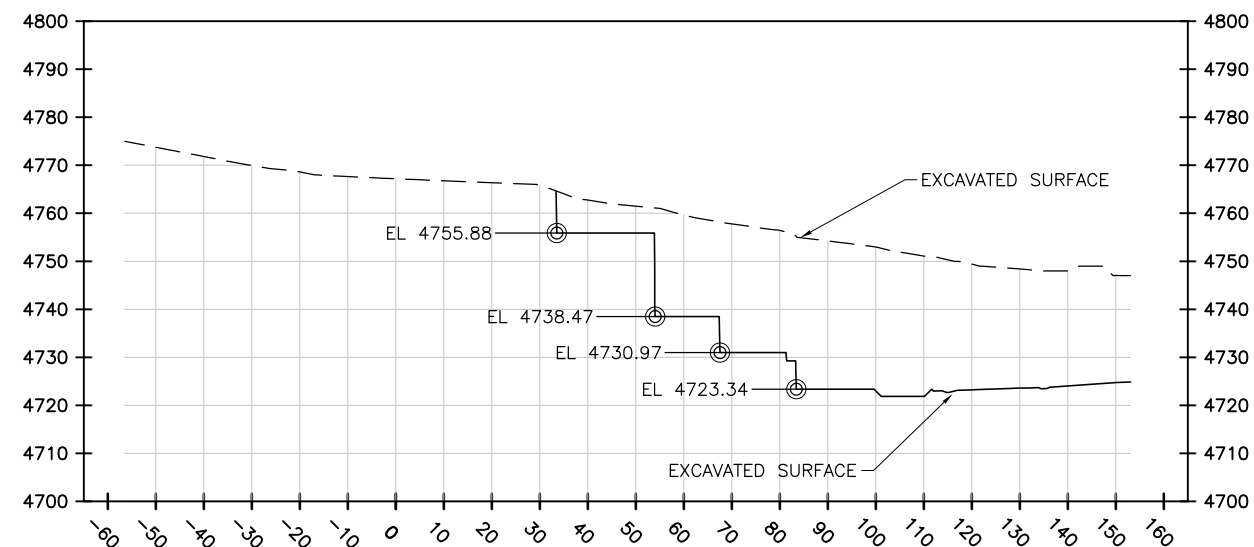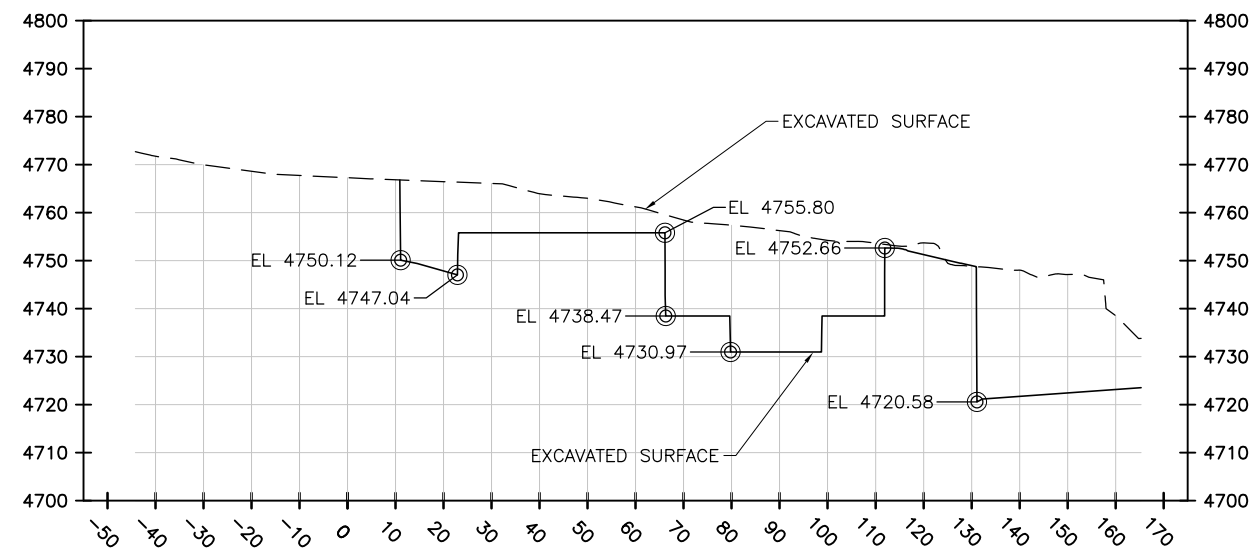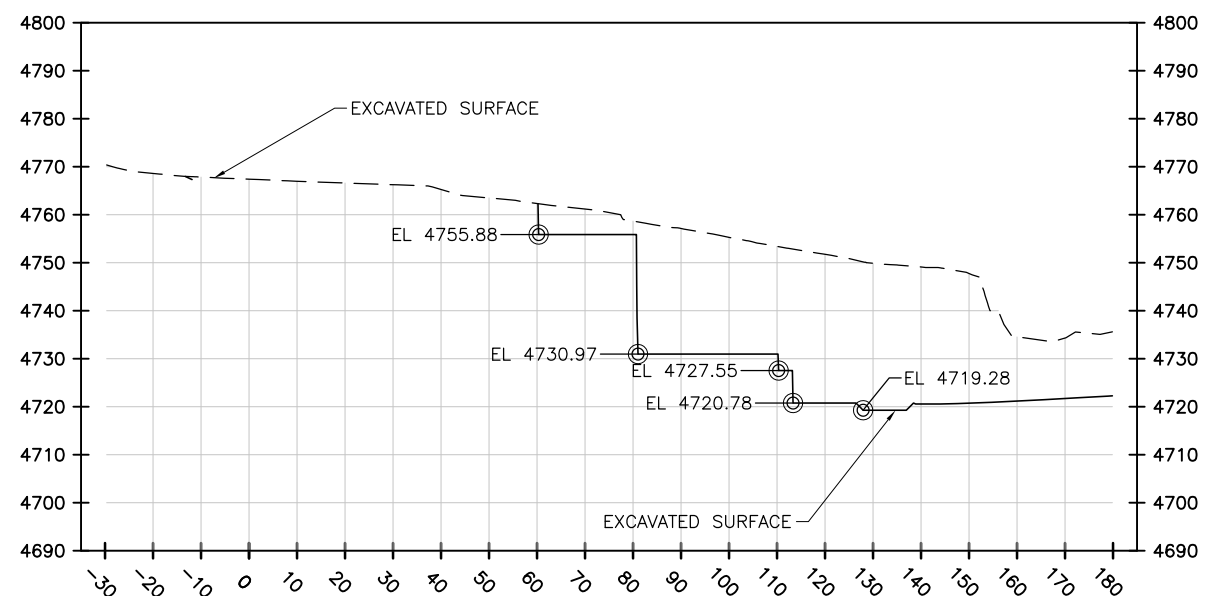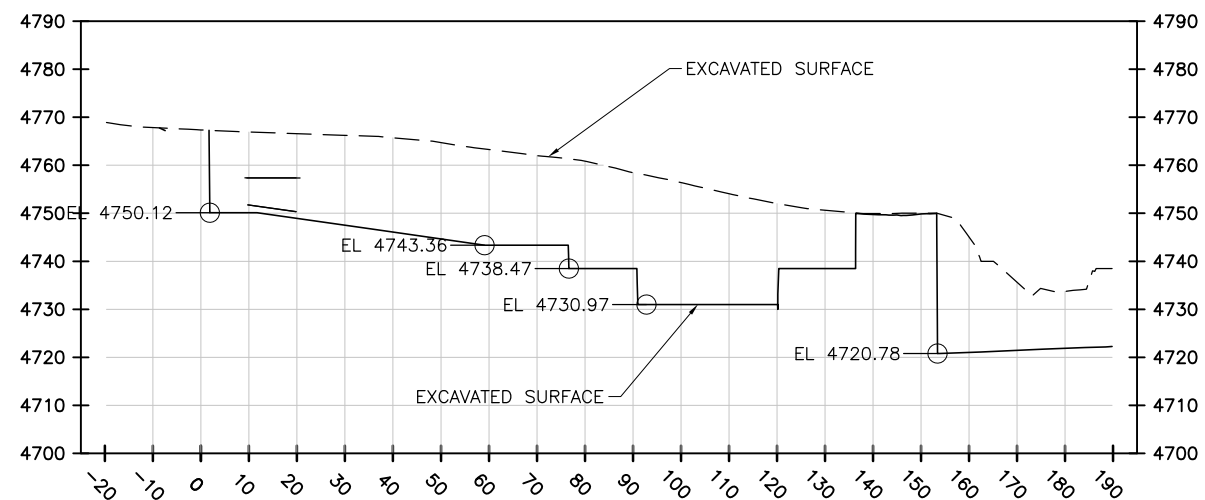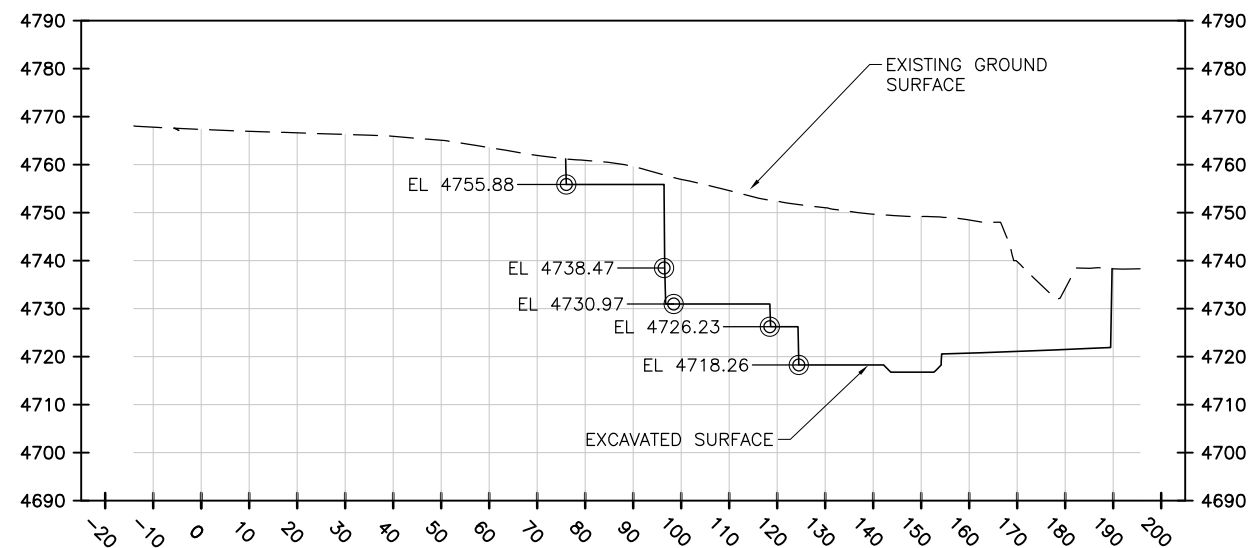

- GENERAL NOTES:

1. EXCAVATION PLAN CUTS BASED ON GEOTECHNICAL DATA PRESENTED IN "SOUTHERN DELIVERY SYSTEM, GEOLOGIC AND GEOTECHNICAL DATA REPORT FOR PUEBLO DAM CONNECTIONS", BY RJH CONSULTANTS, INC. DATED SEPTEMBER 28, 2009. ALL CUTS ASSUMED TO BE IN SANDSTONE BEDROCK.
2. EXCAVATION CUTS MUST BE INSPECTED BY DOWL TO DETERMINE IF BEDDING, SEAMS, OR JOINTING IN THE SANDSTONE WARRANTS REMEDIAL RECOMMENDATIONS.
3. FREEZE/THAW CYCLES COULD CAUSE LOCALIZED SPALLING OF ROCK MATERIALS THAT COULD BE A SAFETY HAZARD TO WORKERS.
4. WHILE A REASONABLE EFFORT HAS BEEN MADE TO DESIGN THIS EXCAVATION PLAN FROM AVAILABLE INFORMATION, SUBSURFACE VARIATIONS/ANOMOLIES THAT DIFFER FROM THOSE ASSUMED MAY BE ENCOUNTERED. SUCH VARIATIONS MAY REQUIRE REMEDIAL MEASURES. THE NEED FOR SUCH MEASURES WILL BE HANDLED ON A CASE BY CASE BASIS AFTER DISCOVERY AND EVALUATION OF SUCH VARIATIONS/ANOMOLIES.

CIVIL SITE- EXCAVATION
"B" CROSS SECTIONS

SCALE: 1" = 30'-0"

$$\frac{1}{y-1}$$

Mountain States Hydro, LLC

P.O. Box 918
Sunnyside, WA. 98944

Off: (509) 837-6822
FAX: (509) 837-6801



 ALWAYS THINK SAFETY

PROJECT

**SOUTHEASTERN COLORADO WATER
ACTIVITY ENTERPRISE
PUEBLO DAM HYDROELECTRIC PROJECT
CIVIL SITE –
EXCAVATION PLAN
CROSS SECTIONS**

AS CONSTRUCTED 2019


CIVIL SITE-
EXCAVATION PLAN
CROSS SECTIONS

X-4

DATE AND TIME PLOTTED
September 27, 2019 17:15
PLOTTED BY
MDJ

CAD SYSTEM
AUTOCAD
CAD FILENAME
P-CIVIL 9-27-19.DWG

DATE AND TIME PLOTTED
October 14, 2019 12:25
AUTOCAD NAME
STRUCTURAL 9-27-19 AS CONSTRUCTED
CADD SYSTEM
AUTOCAD
PLOT BY
MOJ

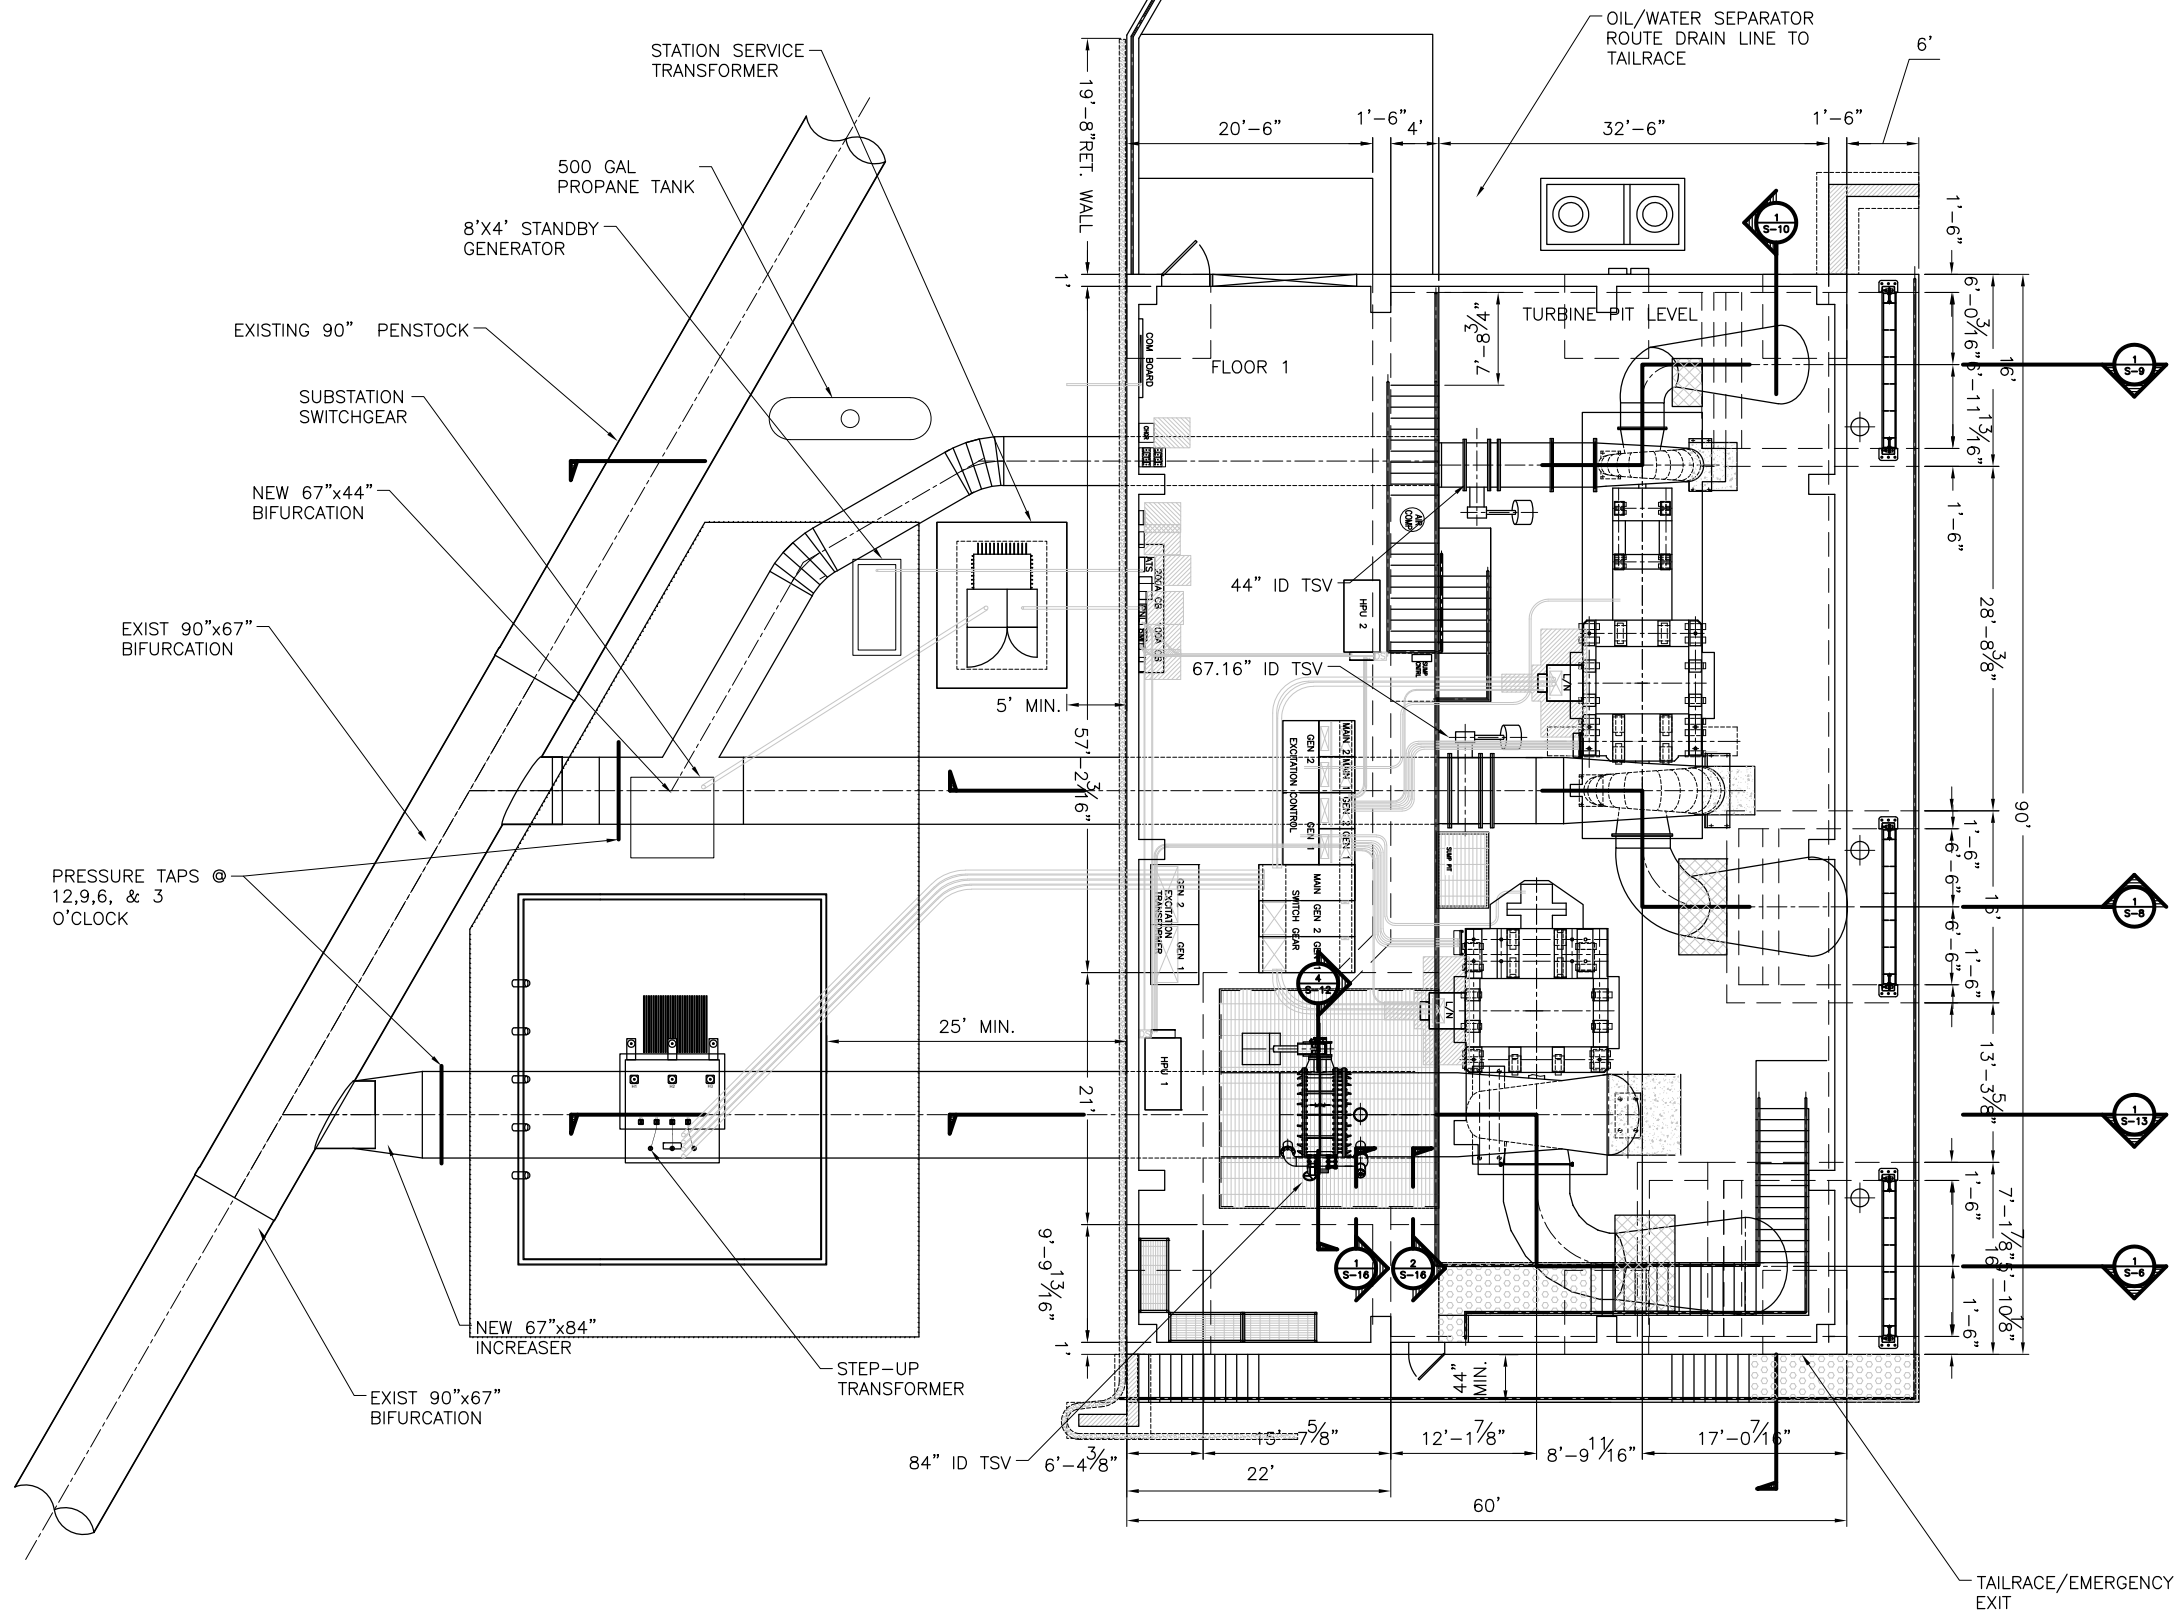

- NOTE:
1. PENSTOCK COAT INSIDE WITH CARBOGUARD 61 PER SPECIFICATIONS
 2. PENSTOCK TO BE ENCASED w/ MIN. 12 IN OF CONCRETE.

POWERHOUSE FINISH FLOOR
PLAN EL 4756.88

SCALE: 1/16" = 1'-0"

1
S-4

Mountain States Hydro, LLC

P.O. Box 918
Sunnyside, WA. 98944
OFF: (509) 837-6822
FAX: (509) 837-6801



ALWAYS THINK SAFETY

PROJECT
SOUTHEASTERN COLORADO WATER
ACTIVITY ENTERPRISE
PUEBLO DAM HYDROELECTRIC PROJECT
POWERHOUSE STRUCTURAL -
PLAN - MAIN LEVEL
EL 4754.26

AS CONSTRUCTED 2019

REV NO 1000-00
NAME, DATE, APPR.

POWERHOUSE STRUCTURAL -
PLAN - MAIN LEVEL
EL 4756.88

S-4

DATE AND TIME PLOTTED
October 16, 2019 12:25
PLOT BY
MOJ
CADD SYSTEM
CADD FILENAME
STRUCTURAL 9-27-19-AS CONSTRUCTED.dwg

POWERHOUSE FINISH FLOOR
PLAN EL 4756.88

SCALE: 3/32" = 1'-0"

1
S-5

- NOTE:
1. STAIR LANDINGS EQUAL 48" AS SHOWN.
 2. Stair Rise = $6-1\frac{5}{16}"$
Run = 11"
 3. MIN. CLR WIDTH FOR STAIRS = 44"
 4. STANDARD HAND RAIL HEIGHT = 42"
 5. STAIR HAND RAIL HEIGHT = 36"
 6. 48" MIN. LANDING AT TOP AND BOTTOM OF STAIRS.
 7. 44" MIN EGRESS EACH SIDE OF DOORWAY. MAX $\frac{1}{2}"$ VARIANCE BETWEEN THRESHOLD AND LANDING
 8. HANDRAIL EXTENSIONS- HANDRAILS SHALL RETURN TO A WALL, GUARD OR THE WALKING SURFACE OR SHALL BE CONTINUOUS TO THE HANDRAIL OF AN ADJACENT FLIGHT OF STAIRS OR RAMP RUN. WHERE HANDRAILS ARE NOT CONTINUOUS BETWEEN FLIGHTS, THE HANDRAILS SHALL EXTEND HORIZONTALLY NOT LESS THAN 12 INCHES BEYOND THE TOP RISER AND CONTINUE TO SLOPE FOR THE DEPTH OF ONE TREAD BEYOND THE BOTTOM RISER. AT RAMPS WHERE HANDRAILS ARE NOT CONTINUOUS BETWEEN RUNS, THE HANDRAILS SHALL EXTEND HORIZONTALLY ABOVE THE LANDING 12 INCHES MINIMUM BEYOND THE TOP AND BOTTOM OF RAMP RUNS. THE EXTENSIONS OF HANDRAILS SHALL BE IN THE SAME DIRECTION OF THE FLIGHTS OF STAIRS AT STAIRWAYS AND THE RAMP RUNS AT RAMPS.
 9. ALL REQUIRED DIMENSIONS FOR CATWALK, STAIRWAY, AND HANDRAIL TO BE FIELD MEASURED PRIOR TO FABRICATION PROTECTION JUNCTION BOXES

4'-8" TALL WING WALL

OIL/WATER SEPERATOR

FLOOR 1

19'-8" RET. WALL

57'-2 $\frac{3}{16}"$

COM BOARD

200A CB 100A CB

ATS

HPU 2

4756.88

4756.88

<

DATE AND TIME PLOTTED
October 16, 2019 12:25
PLOTTER
HP
CUT SYSTEM
CUT FILENAME
STRUCTURAL 9-27-19 AS CONSTRUCTED.DWG




POWERHOUSE BLDG COLUMN
PLAN EL 4756.88


SCALE: 3/32" = 1'-0"

1
S-5C

NOTE:
1. SEE SHEET S-15 FOR COLUMN SCHEDULE.
2. ALL (4) CORNERS ARE C1
3. ALL OTHER COLUMNS ARE C2

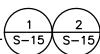CONCRETE COLUMN
BEYOND CRNR C1 (TYP)
SEE DETAIL 

GRATED LANDING
PAD AND STAIRS

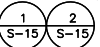CONCRETE COLUMN
BEYOND INTERIOR C2 (TYP)
SEE DETAIL 

CONCRETE
PAD

MCMNICHOLS GRIP STRUT
5 DIAMOND STAIR
TREADS

AIR
COMP

HPU 2

MAIN 2 MAIN 1 GEN 2 GEN 1
GEN 2 CP GEN 1 CP
EXCITATION CONTROL

GEN 2 GEN 1
SWITCH GEAR

GEN 2 GEN 1
EXCITATION
TRANSFORMER

HPU 1


COM BOARD

200A CB 100A CB
AIS

Mountain States Hydro, LLC

P.O. Box 918
Sunnyside, WA. 98944
OFF: (509) 837-6822
FAX: (509) 837-6801

SORENSEN
ENGINEERING

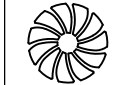

ALWAYS THINK SAFETY

AS CONSTRUCTED 2019

POWERHOUSE STRUCTURAL-
PLAN- MAIN LEVEL
EL 4756.88

S-5C


PROJECT
SOUTHEASTERN COLORADO WATER
ACTIVITY ENTERPRISE
PUEBLO DAM HYDROELECTRIC PROJECT
POWERHOUSE STRUCTURAL -
PLAN- MAIN LEVEL
EL 4754.26

DESCRIPTION
REV NO 1000-00-00
NAME, DATE, APPR.

DRAWING NUMBER

DATE AND TIME PLOTTED
October 11, 2019 12:25
PLOT BY
MJO

CAD SYSTEM
AUTOCAD
STRUCTURAL 9-27-19 AS CONSTRUCTED

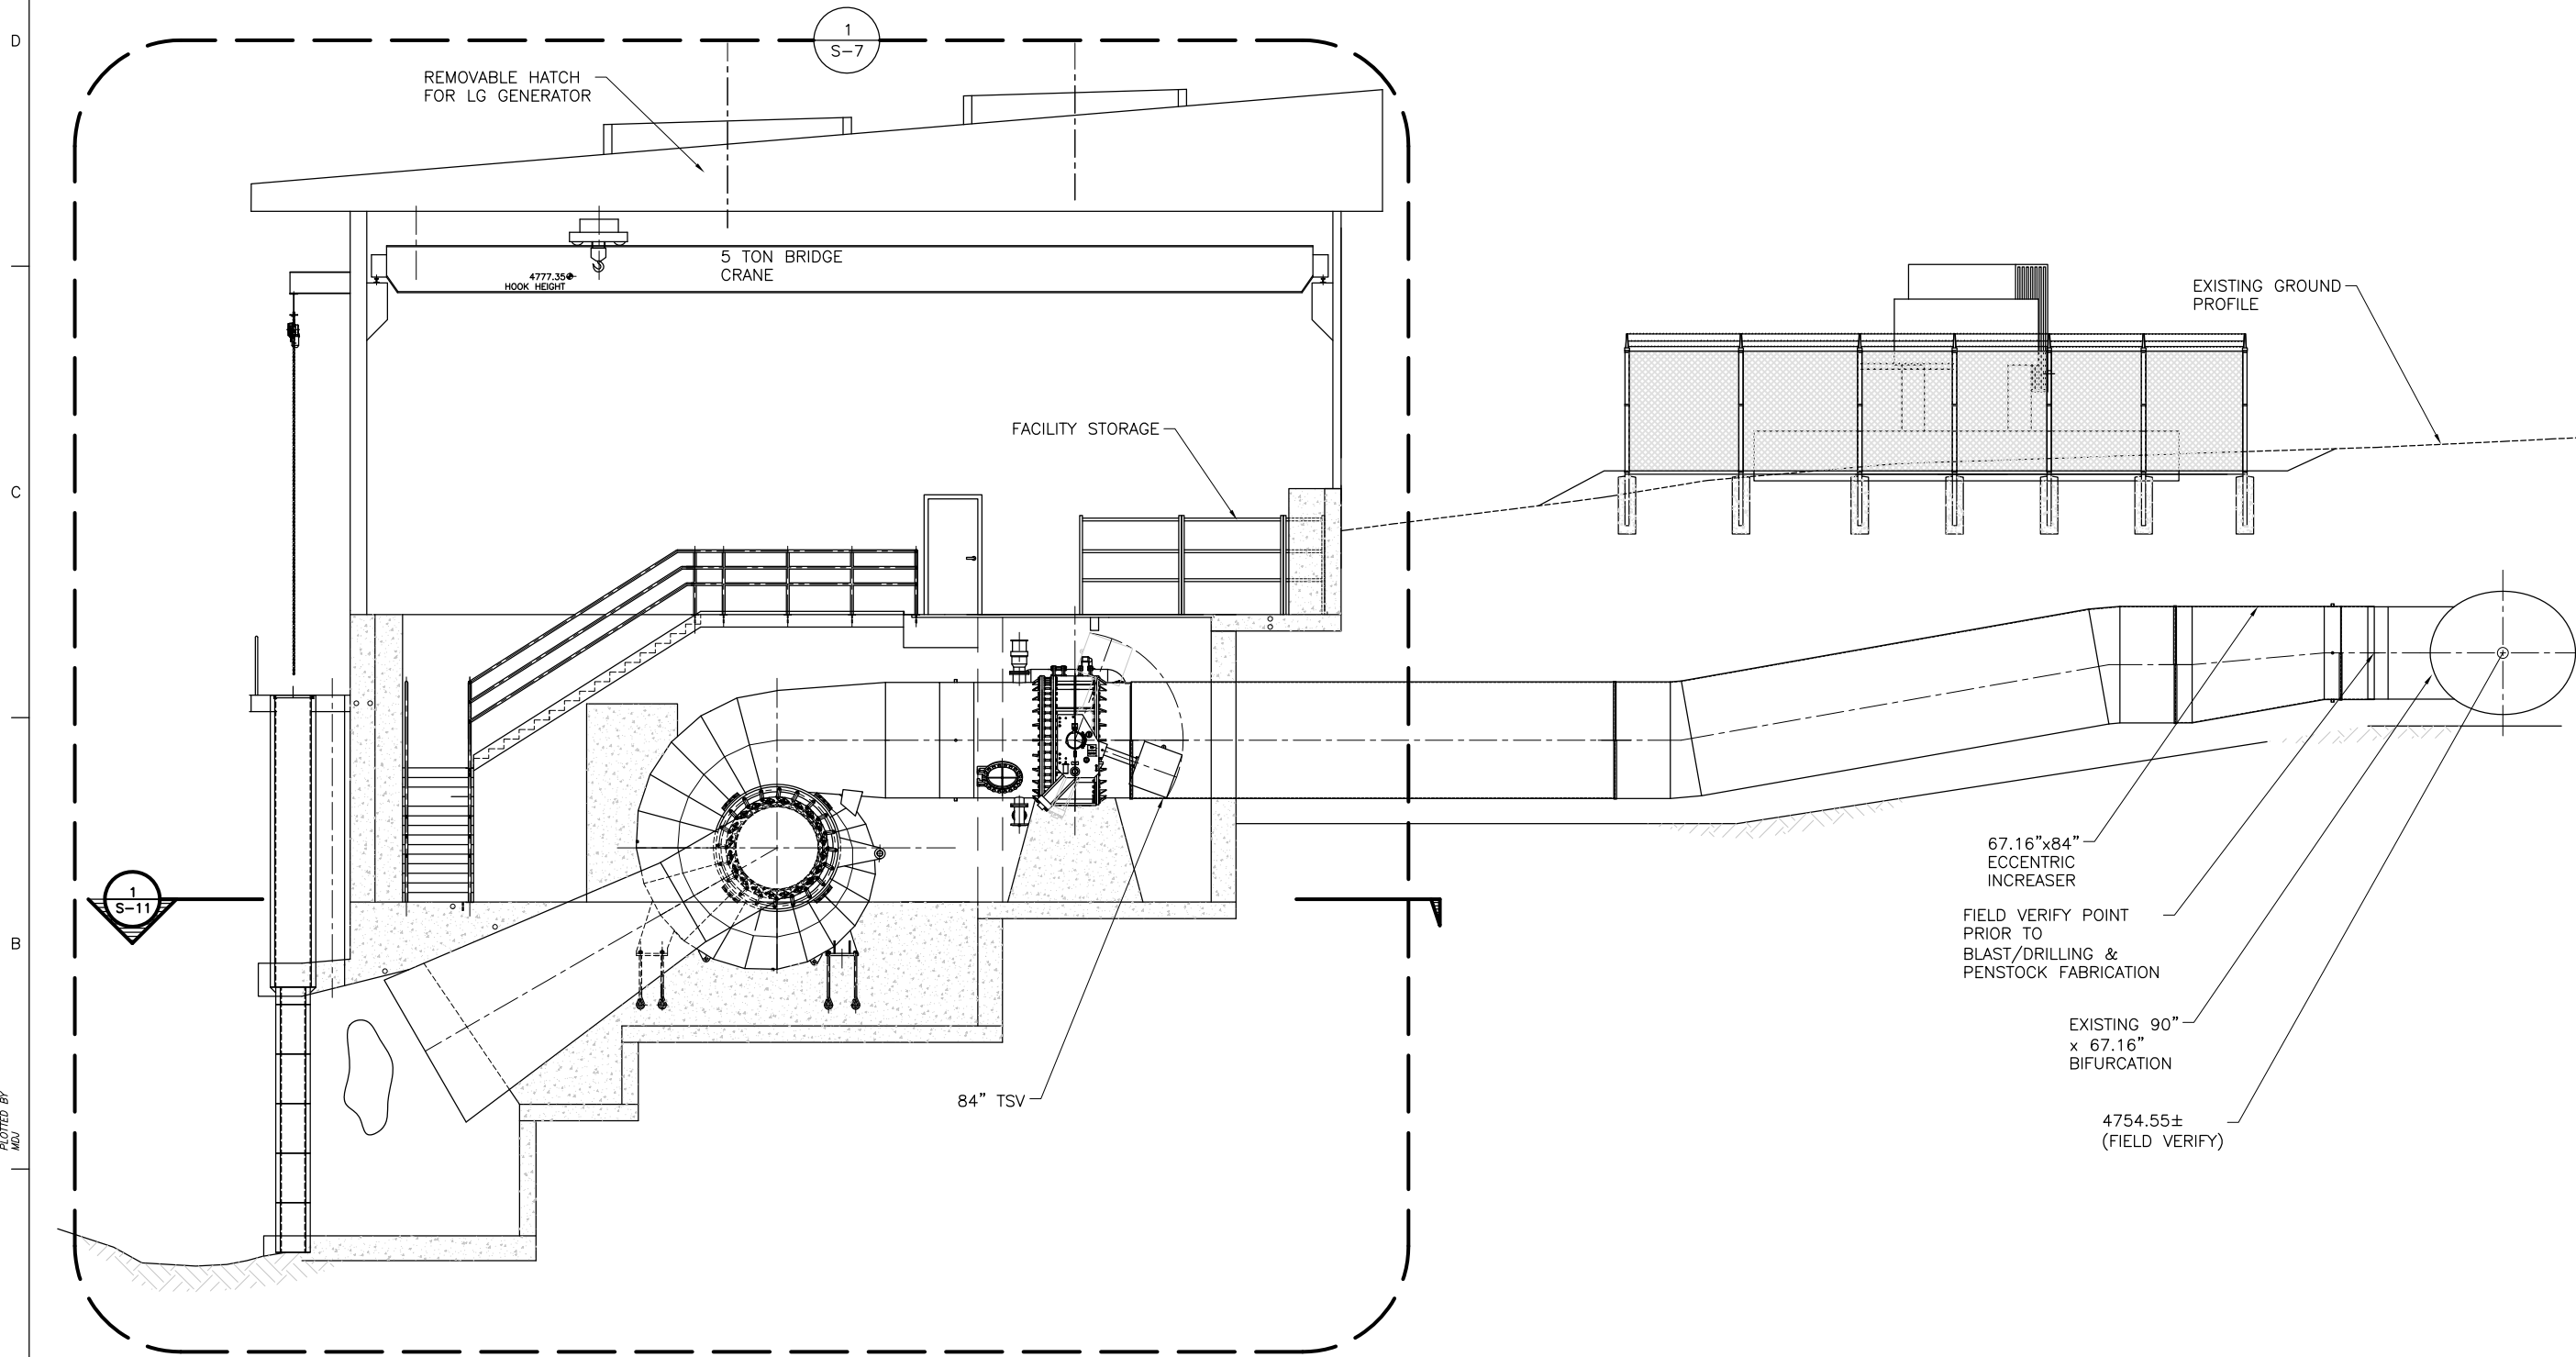

POWERHOUSE SECT. THRU 450 CFS
TURBINE, GENERATOR, & PH
SCALE: 3/32" = 1'-0"

1
S-6

Mountain States Hydro, LLC
P.O. Box 918
Sunnyside, WA. 98944
Off: (509) 837-6822
Fax: (509) 837-6801



ALWAYS THINK SAFETY

AS CONSTRUCTED 2019

POWERHOUSE STRUCTURAL-
SECTION THRU TURBINE,
GENERATOR, & PH


S-6

SOUTHEASTERN COLORADO WATER
ACTIVITY ENTERPRISE
PUEBLO DAM HYDROELECTRIC PROJECT
POWERHOUSE STRUCTURAL -
SECTION THRU TURBINE,
GENERATOR, & PH

REV. NO. 1
DATE 10/11/19
BY MJO
DESCRIPTION

DRAWING NUMBER

CAD SYSTEM
AUTOCAD
DRAWN BY
STRUCTURAL 9-27-19 AS CONSTRUCTED
DATE AND TIME PLOTTED
October 14, 2019 12:25
PLOT BY
MO

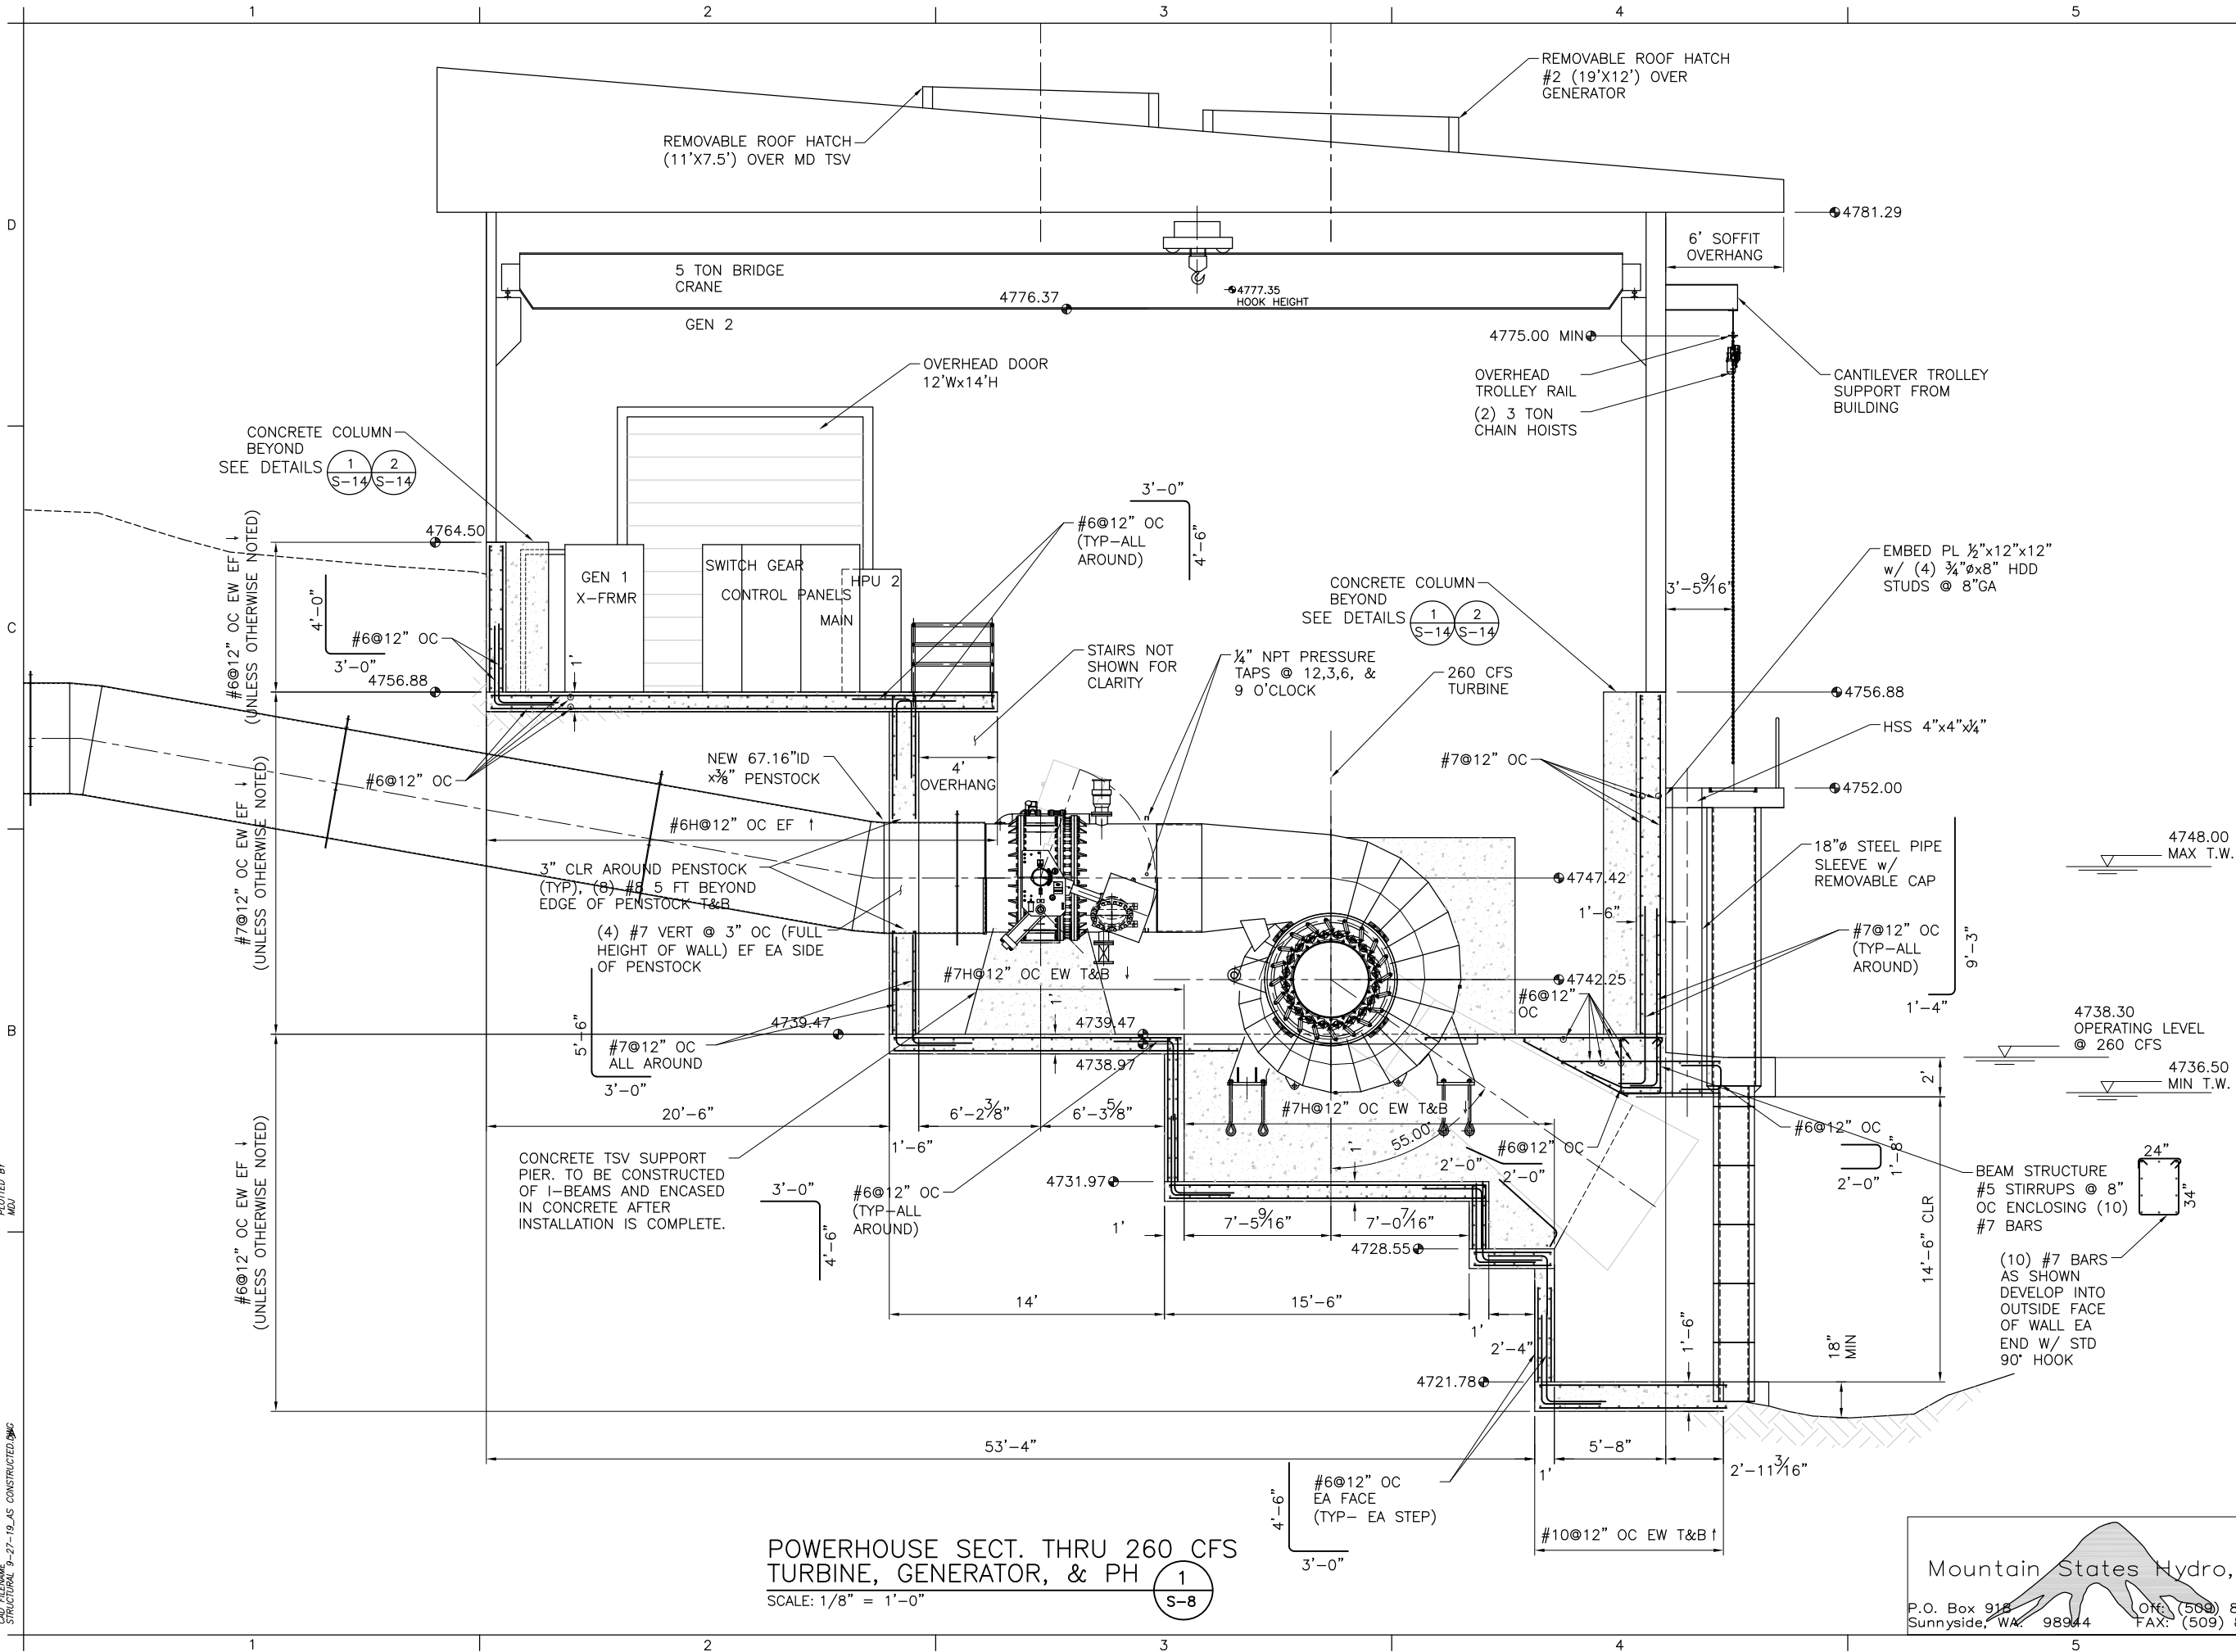

POWERHOUSE SECT. THRU 260 CFS
TURBINE, GENERATOR, & PH
SCALE: 1/8" = 1'-0"

1
S-8

Mountain States Hydro, LLC

P.O. Box 918
Sunnyside, WA. 98944
OFF: (509) 837-6822
FAX: (509) 837-6801



ALWAYS THINK SAFETY

AS CONSTRUCTED 2019


POWERHOUSE STRUCTURAL -
SECTION THRU TURBINE,
GENERATOR, & PH

SOUTHEASTERN COLORADO WATER
ACTIVITY ENTERPRISE
PUEBLO DAM HYDROELECTRIC PROJECT
POWERHOUSE STRUCTURAL -
SECTION THRU TURBINE,
GENERATOR, & PH

S-8

DATE AND TIME PLOTTED
October 1, 2019 12:25
PLOTTER
AUTOCAD
DRAWN BY
MO

CAD SYSTEM
AUTOCAD
STRUCTURAL 9-27-19 AS CONSTRUCTED

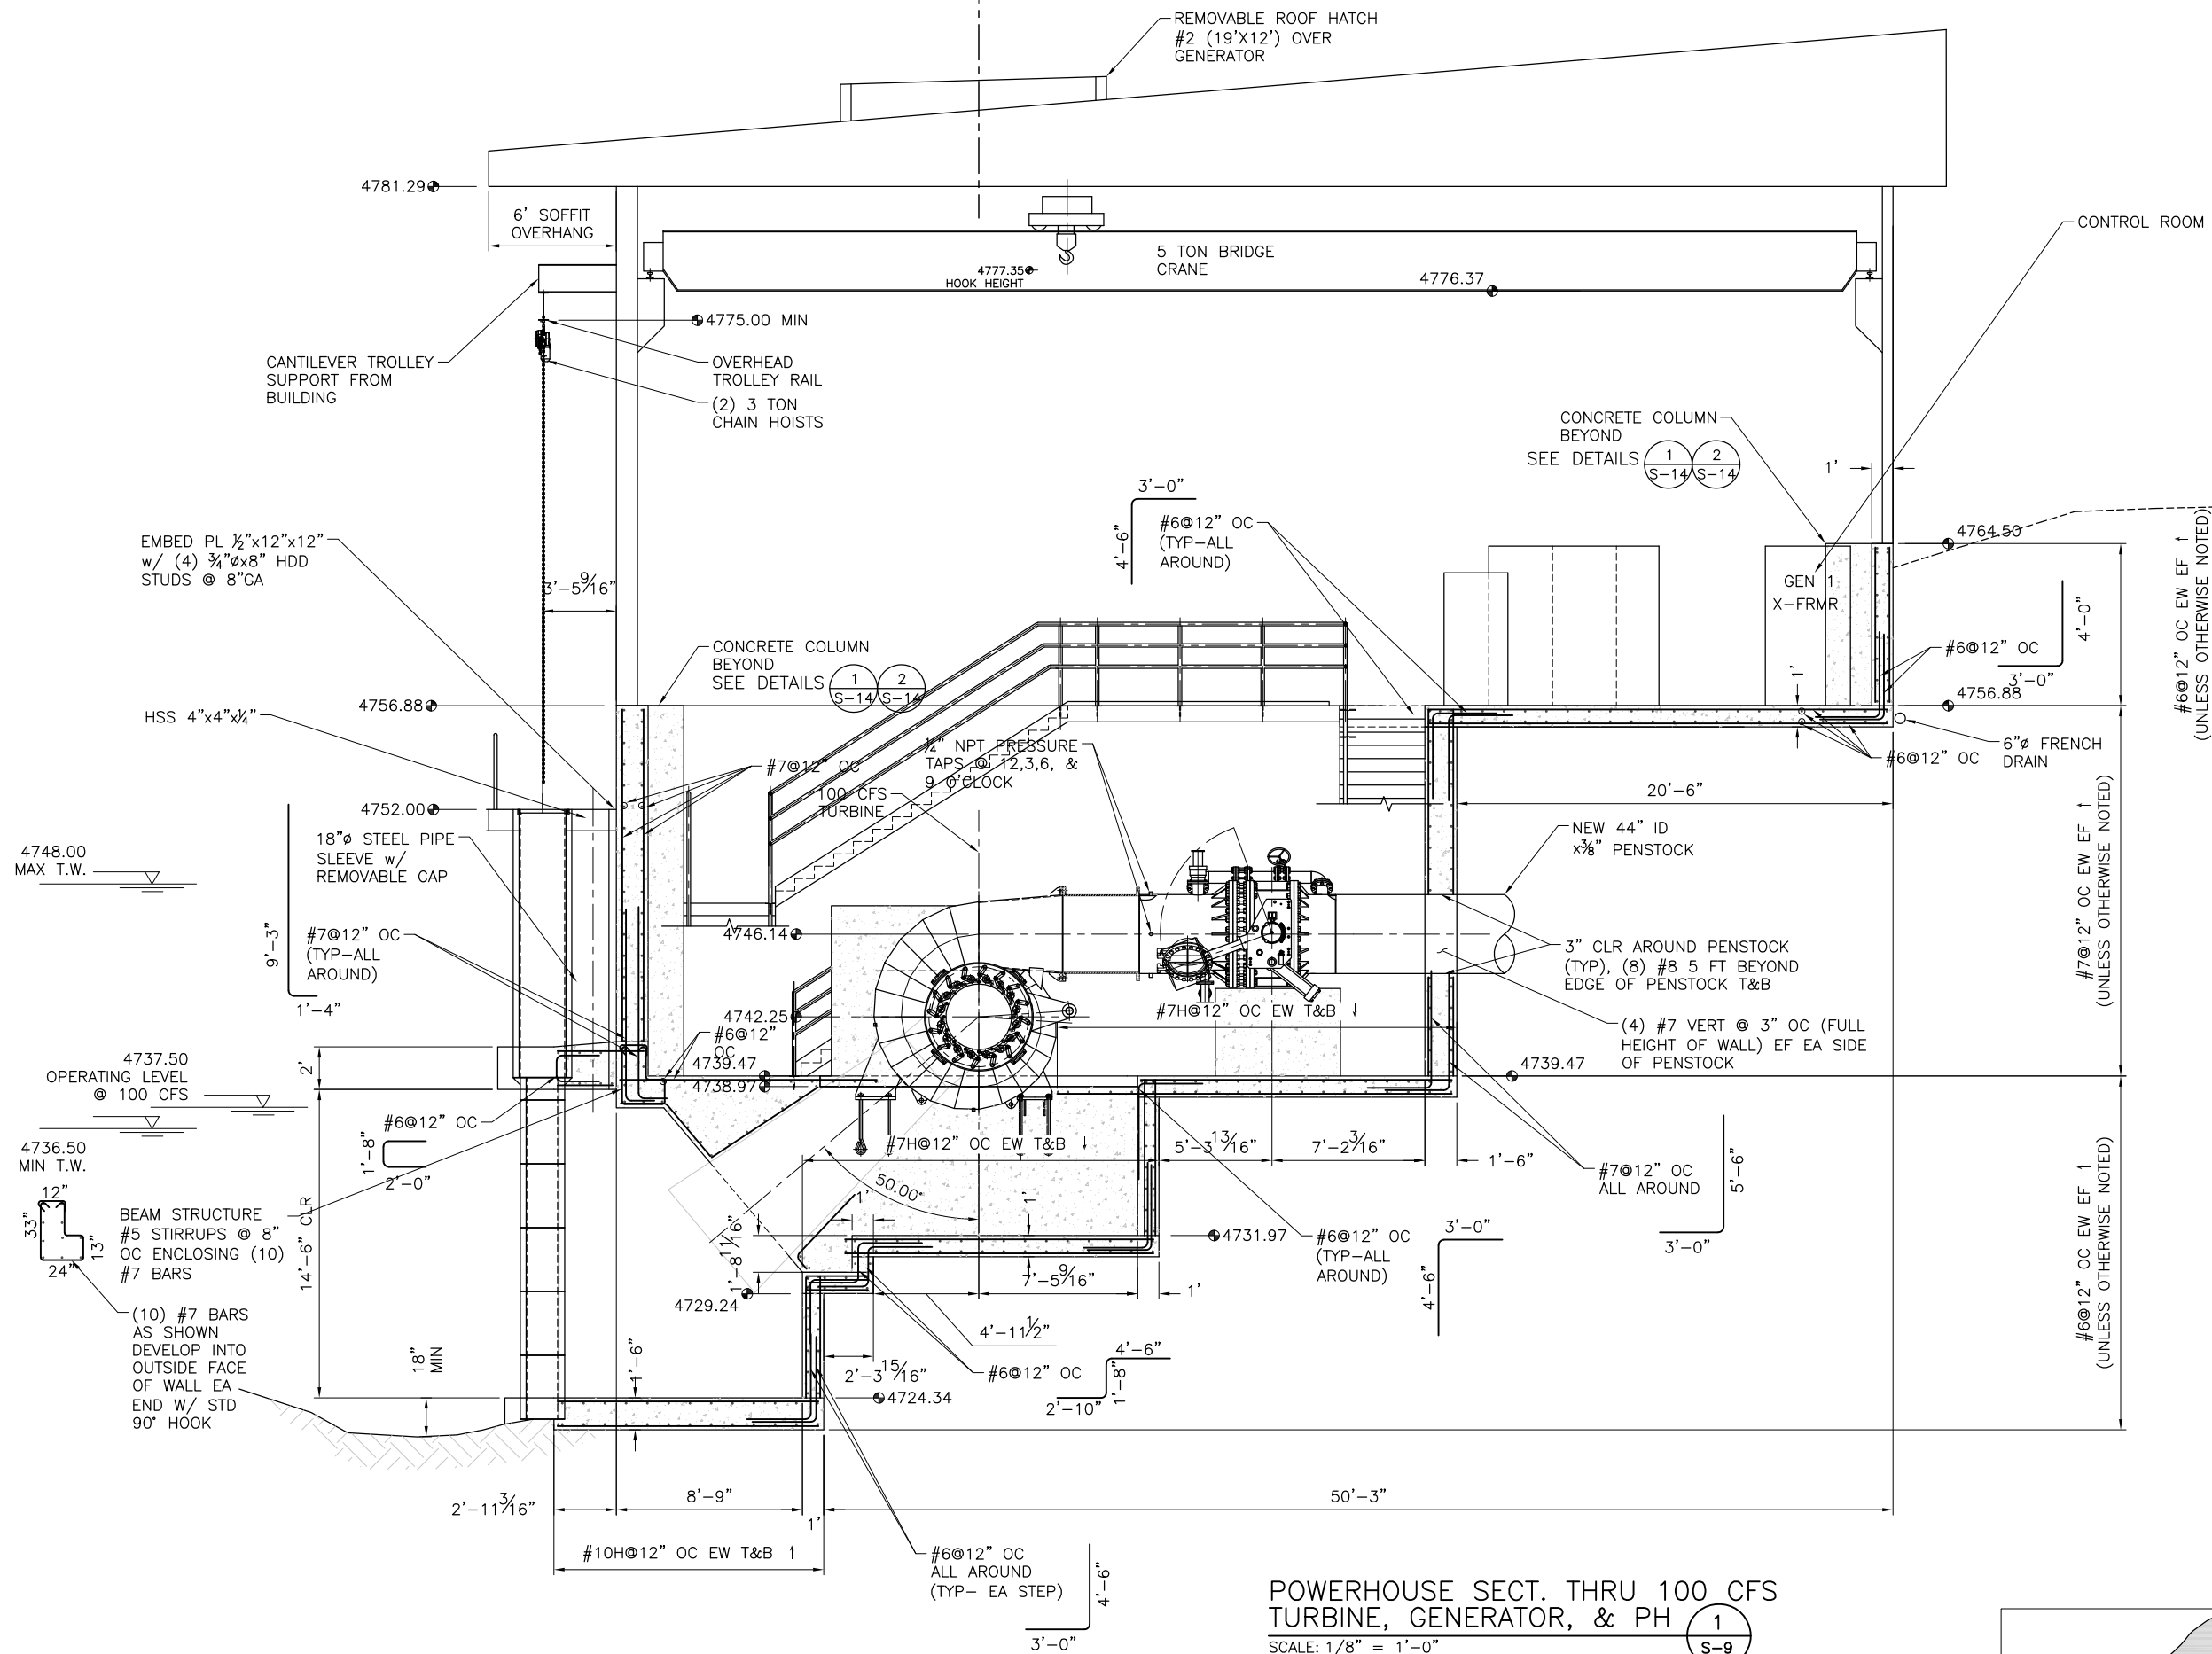

POWERHOUSE SECT. THRU 100 CFS
TURBINE, GENERATOR, & PH
SCALE: 1/8" = 1'-0"

1
S-9

Mountain States Hydro, LLC
P.O. Box 918
Sunnyside, WA. 98944
OFF: (509) 837-6822
FAX: (509) 837-6801

SORENSEN
ENGINEERING

ALWAYS THINK SAFETY


AS CONSTRUCTED 2019

POWERHOUSE STRUCTURAL -
SECT. THRU TURBINE,
GENERATOR, & PH

SOUTHEASTERN COLORADO WATER
ACTIVITY ENTERPRISE
PUEBLO DAM HYDROELECTRIC PROJECT
POWERHOUSE STRUCTURAL -
SECT. THRU TURBINE,
GENERATOR, & PH

S-9

DATE AND TIME PLOTTED
October 11, 2019 12:25
PLOTTER
HP
DRAWN BY
MOU
CADD SYSTEM
AUTOCAD
STRUCTURAL 9-27-19 AS CONSTRUCTED

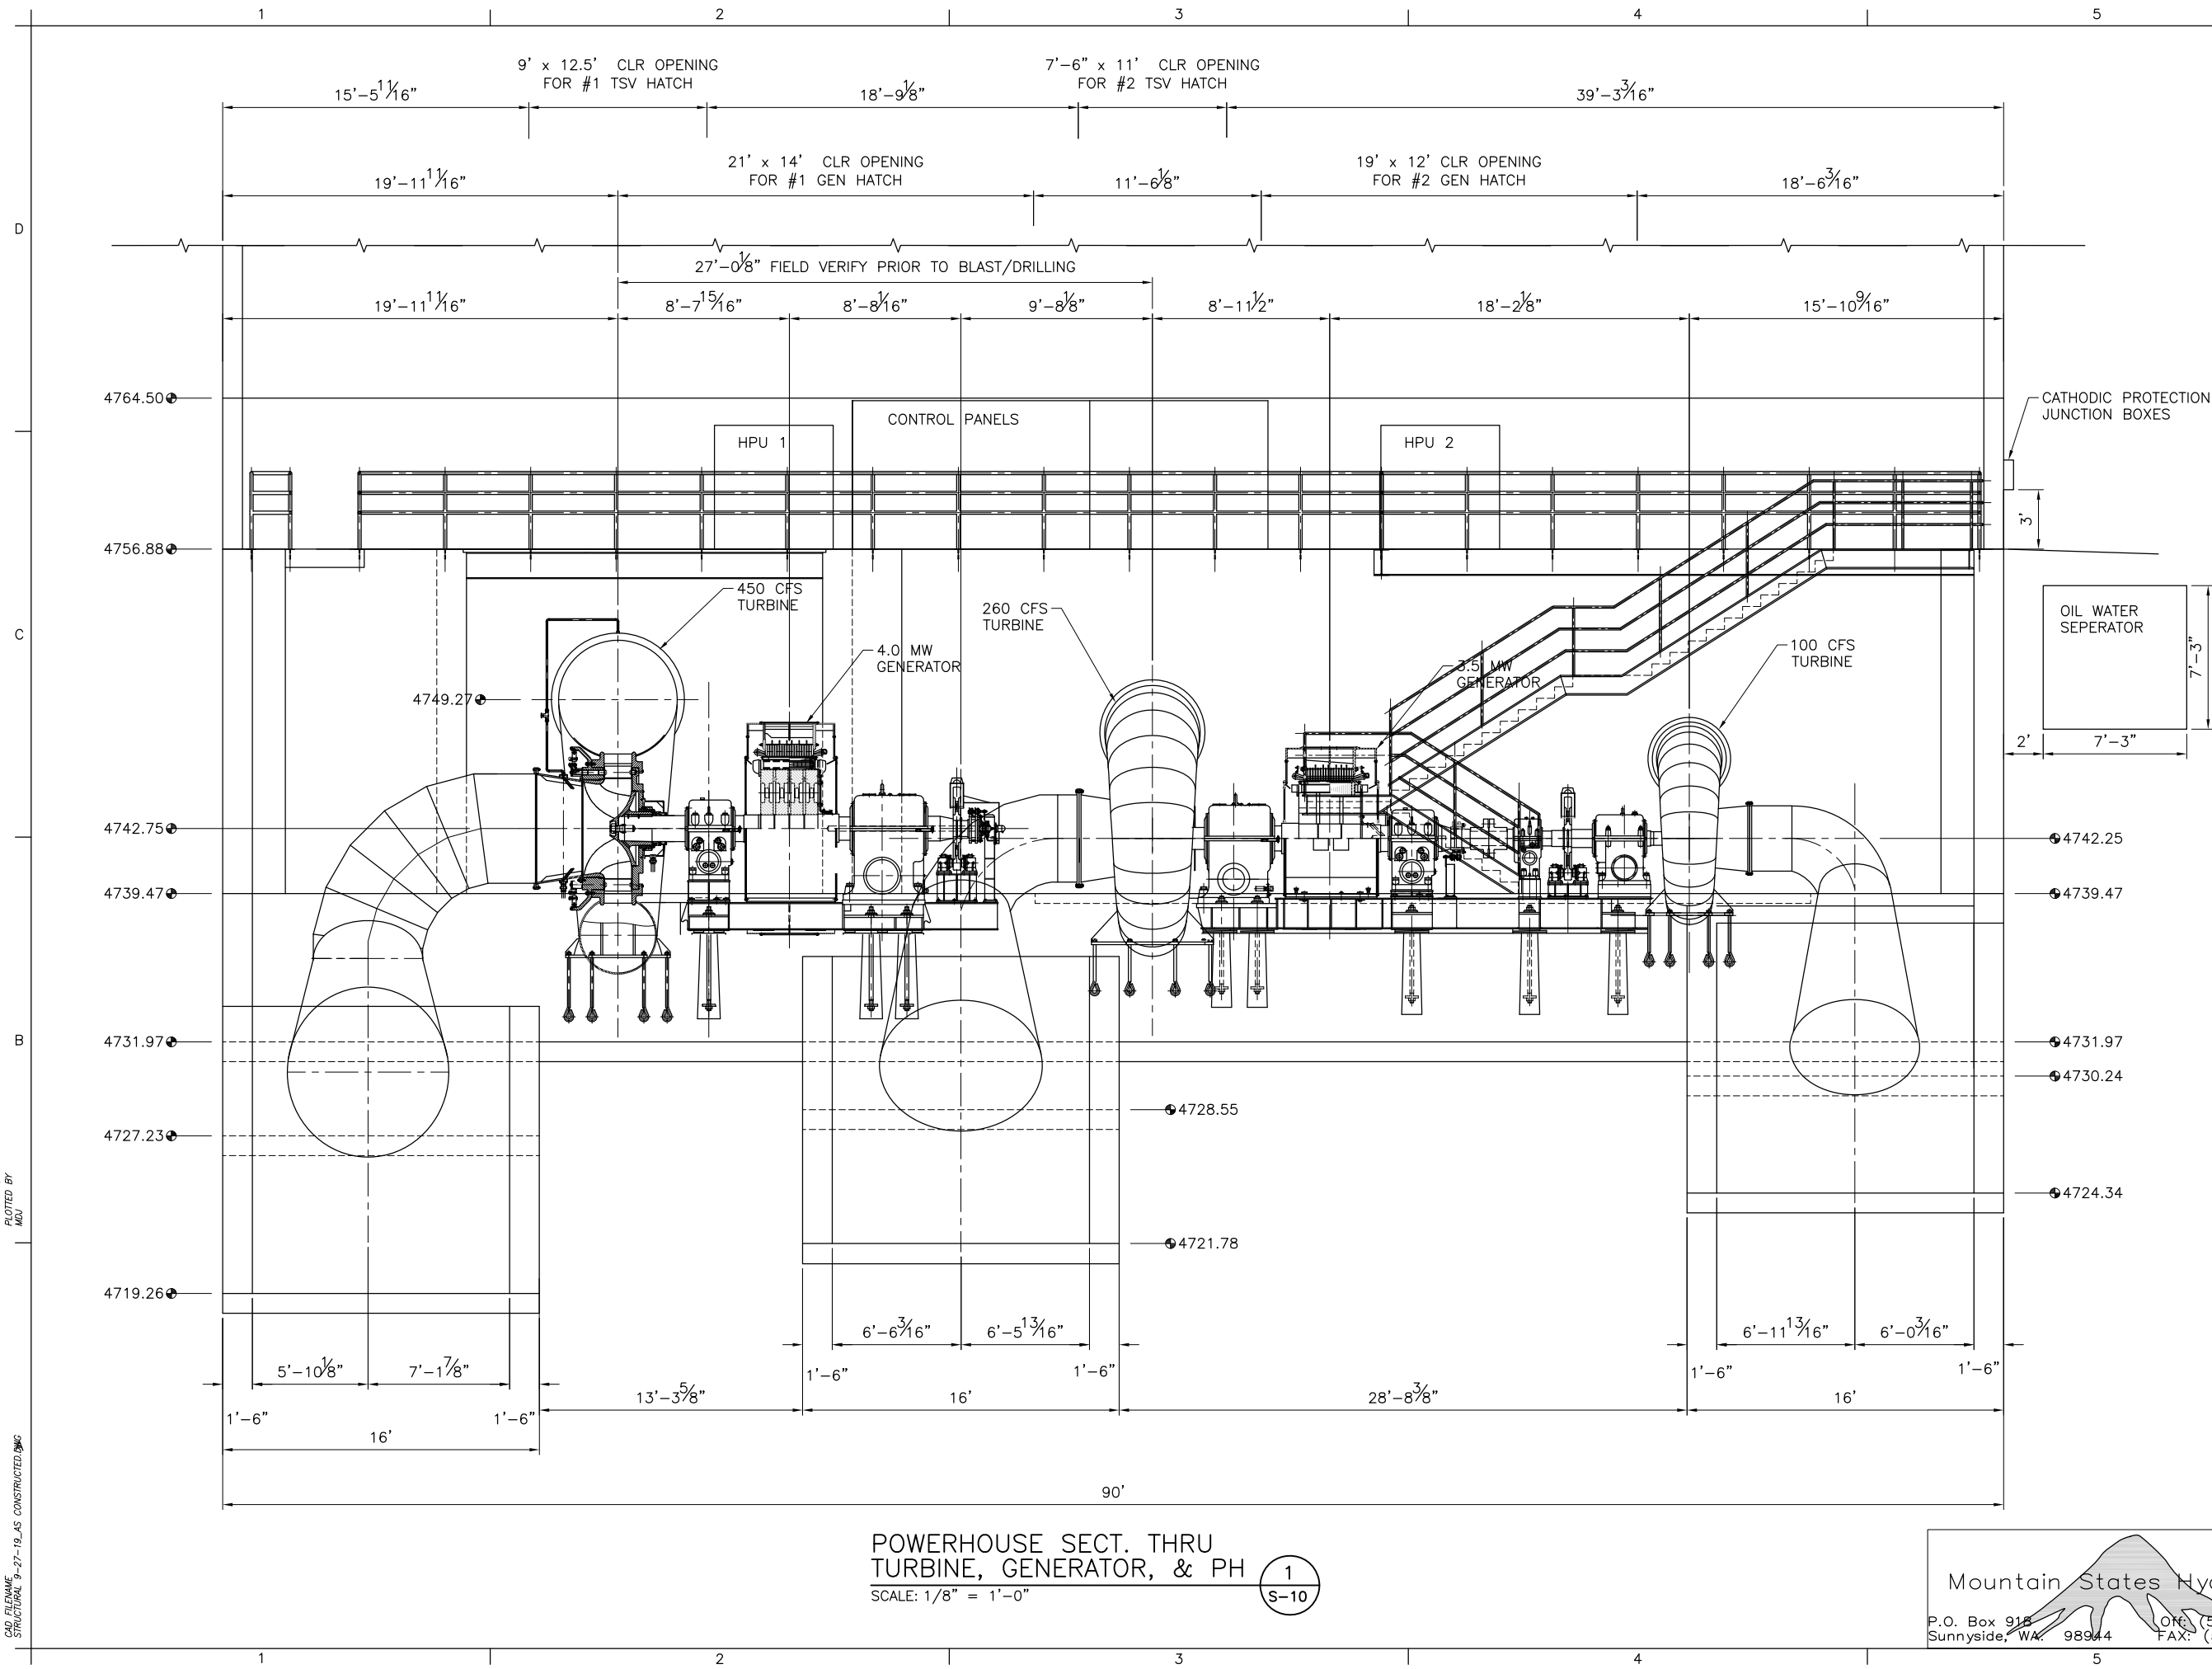

POWERHOUSE SECT. THRU
TURBINE, GENERATOR, & PH
SCALE: 1/8" = 1'-0"

1
S-10

Mountain States Hydro, LLC

P.O. Box 918
Sunnyside, WA. 98944
OFF: (509) 837-6822
FAX: (509) 837-6801



ALWAYS THINK SAFETY

PROJECT
SOUTHEASTERN COLORADO WATER
ACTIVITY ENTERPRISE
PUEBLO DAM HYDROELECTRIC PROJECT
POWERHOUSE STRUCTURAL -
SECT. THRU TURBINE,
GENERATOR, & PH

AS CONSTRUCTED 2019


REV. NO. 1000-100-00
NAME, DATE, APPR.

POWERHOUSE STRUCTURAL -
SECT. THRU TURBINE,
GENERATOR, & PH

S-10

DATE AND TIME PLOTTED
October 11, 2019 12:25
PLOTTED BY
MAD

CAD SYSTEM
AUTOCAD
STRUCTURAL 9-27-19 AS CONSTRUCTED

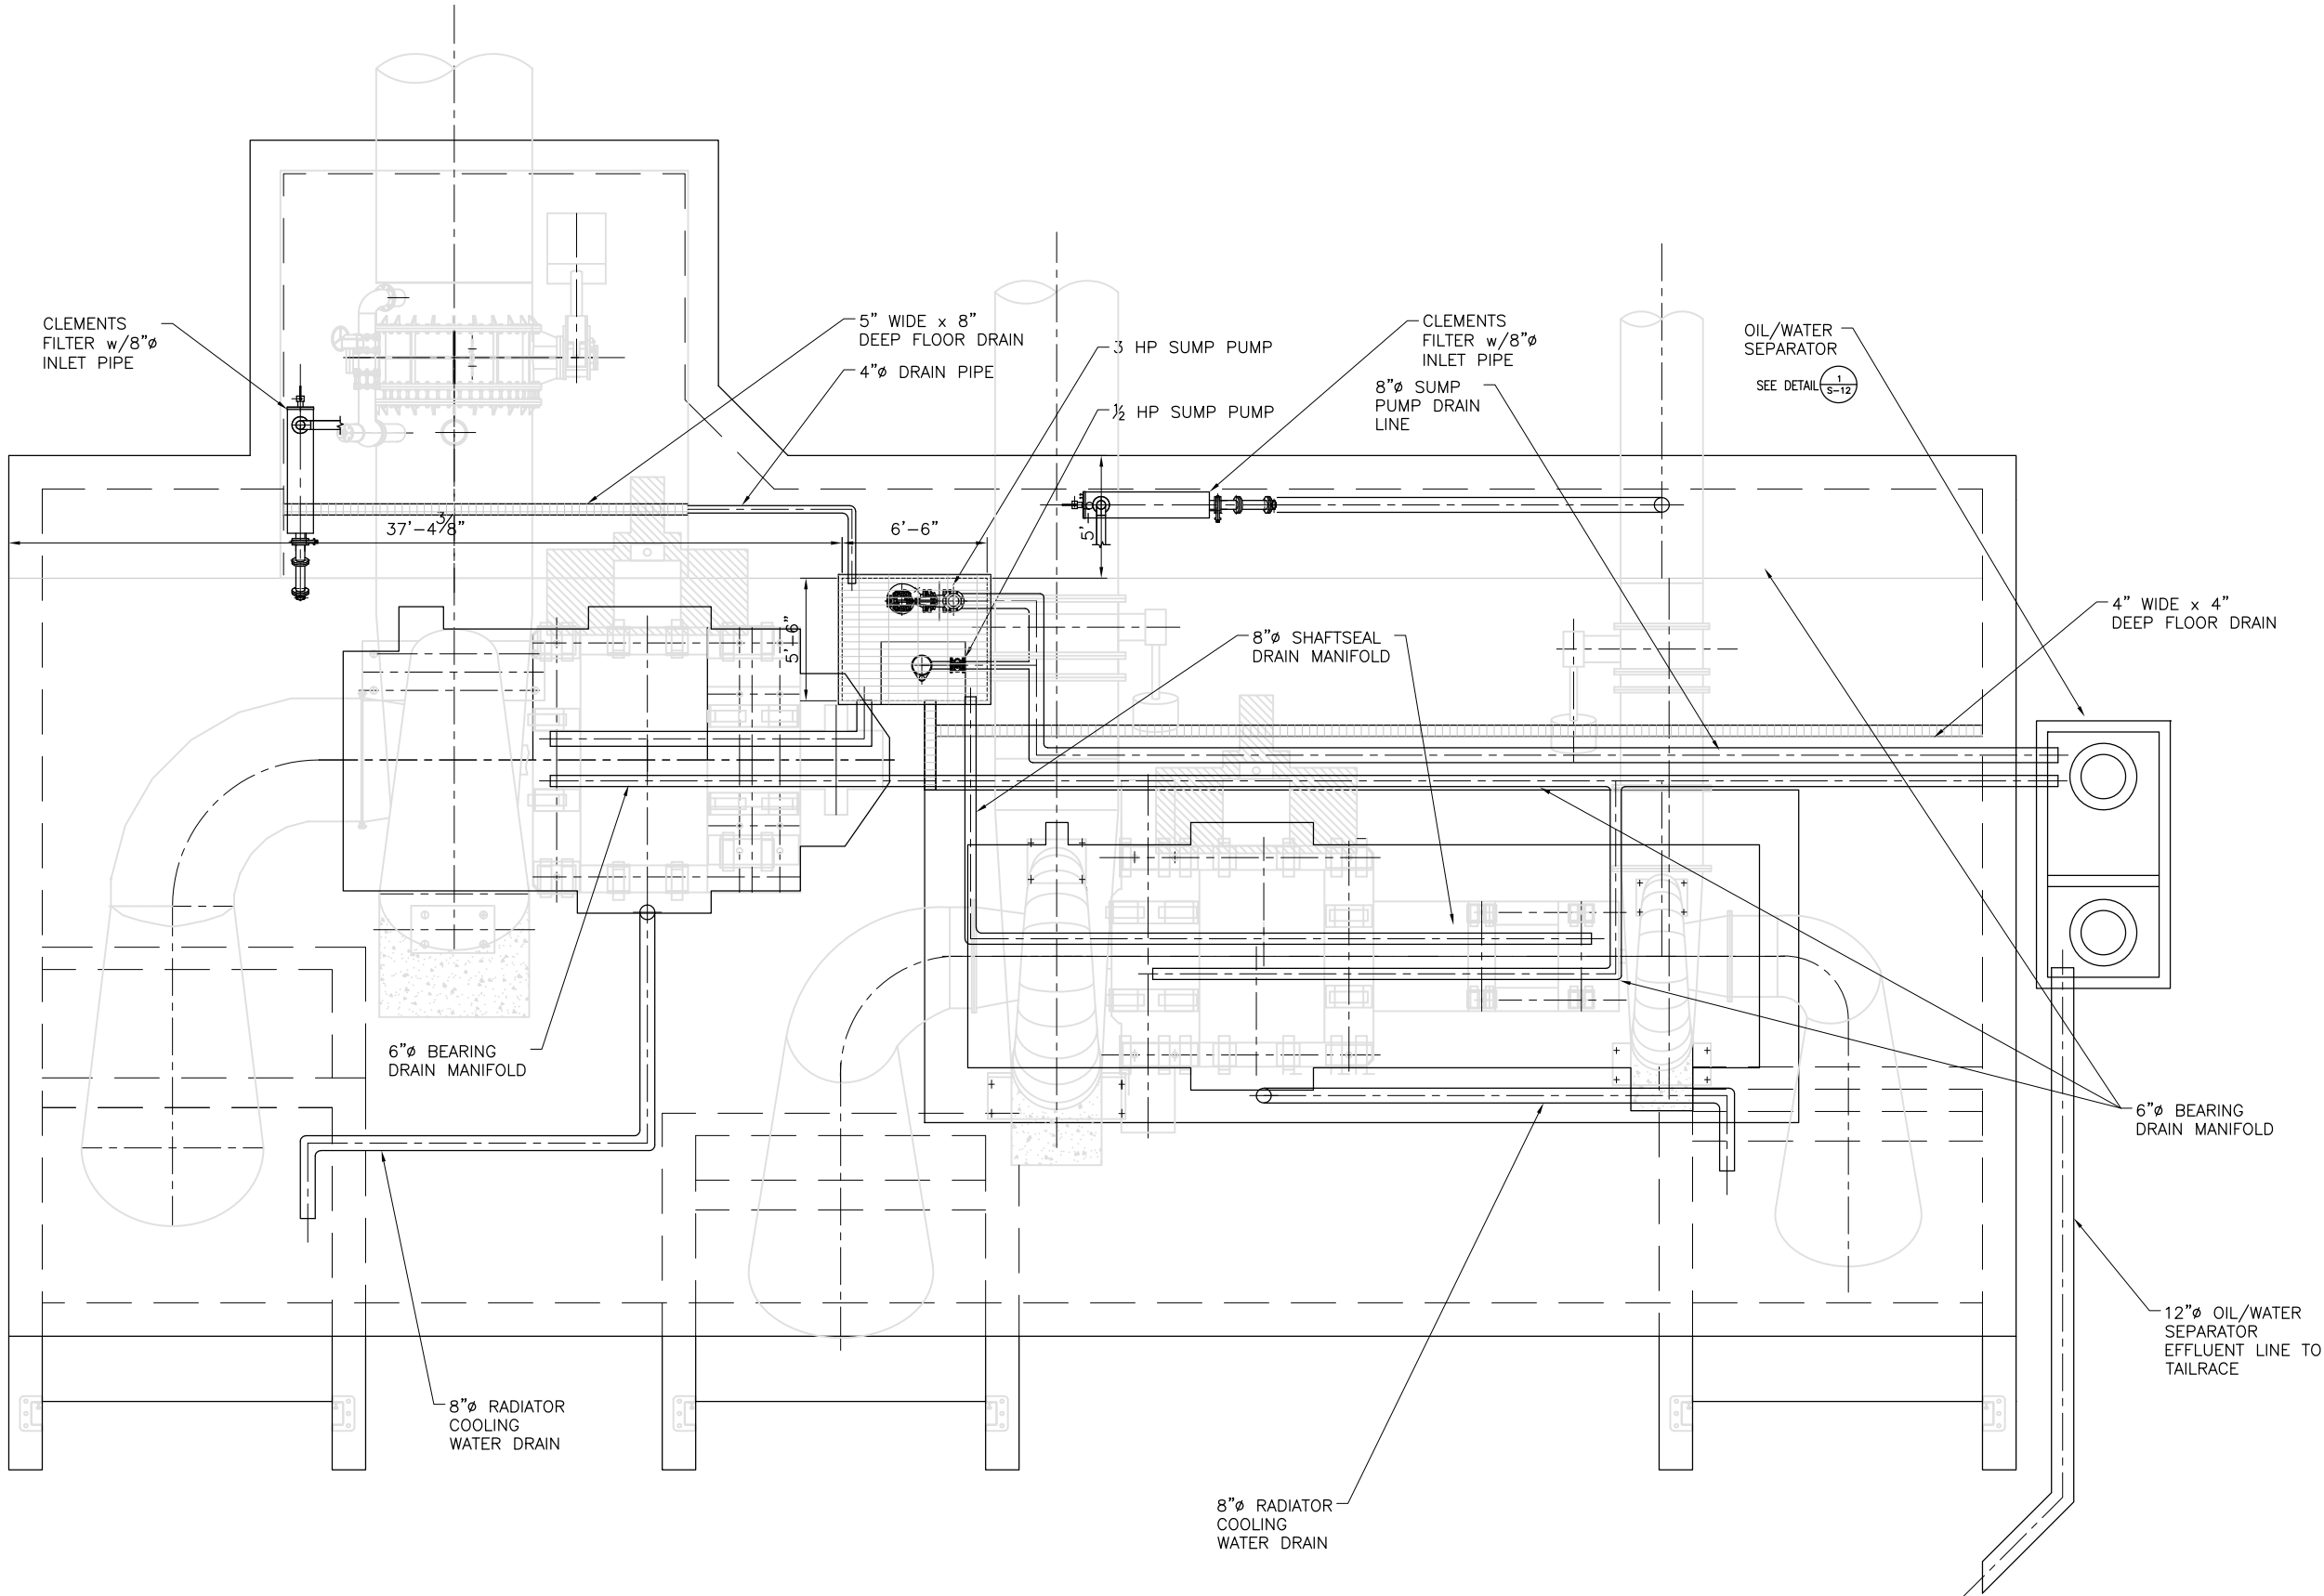

POWERHOUSE GALLEY PLAN
COOLING/DRAIN WATER PIPING PLAN
SCALE: 1/8" = 1'-0"

1
S-11

Mountain States Hydro, LLC

P.O. Box 918
Sunnyside, WA. 98944
OFF: (509) 837-6822
FAX: (509) 837-6801

SORENSEN
ENGINEERING



⚠ ALWAYS THINK SAFETY

PROJECT
SOUTHEASTERN COLORADO WATER
ACTIVITY ENTERPRISE
PUEBLO DAM HYDROELECTRIC PROJECT
POWERHOUSE STRUCTURAL -
POWERHOUSE GALLEY PLAN
COOLING/DRAIN WATER PLAN


AS CONSTRUCTED 2019

DESCRIPTION
REV NO YYYY-MM-DD
NAME, PROJ, ASSG.

POWERHOUSE STRUCTURAL -
POWERHOUSE GALLEY PLAN
COOLING/DRAIN WATER PLAN

S-11

CAD SYSTEM
AUTOCAD
DRAWING NAME
STRUCTURAL 9-27-19 AS CONSTRUCTED
DATE AND TIME PLOTTED
October 16, 2019 12:25
PLOTTED BY
MAD

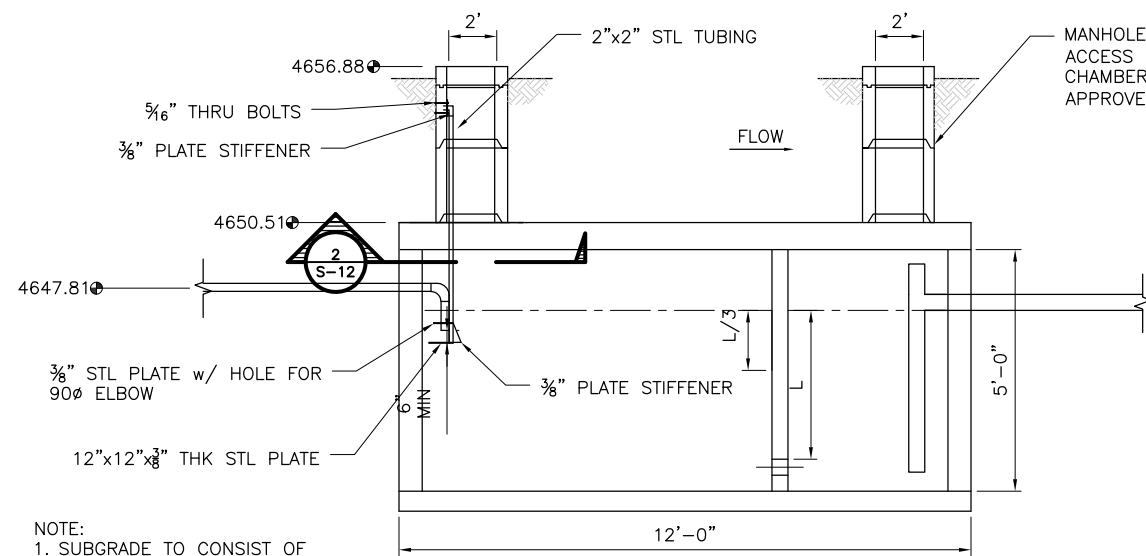

- NOTE:
1. SUBGRADE TO CONSIST OF GEOTEXTILE FABRIC AND 15" TO 20" OF DRAIN ROCK
 2. COAT BAFFLE ASSY W/ 2 COATS OF INDUSTRIAL GRADE ENAMEL.



OIL/WATER
SEPARATOR
SCALE: NTS

1
S-12

NOTE:
APPROX DETENTION TIME
W/ SINGLE DE-WATERING
PUMP IS 30 MIN.


ADDITIONAL BAFFLE
SECTION
SCALE: NTS

2
S-12

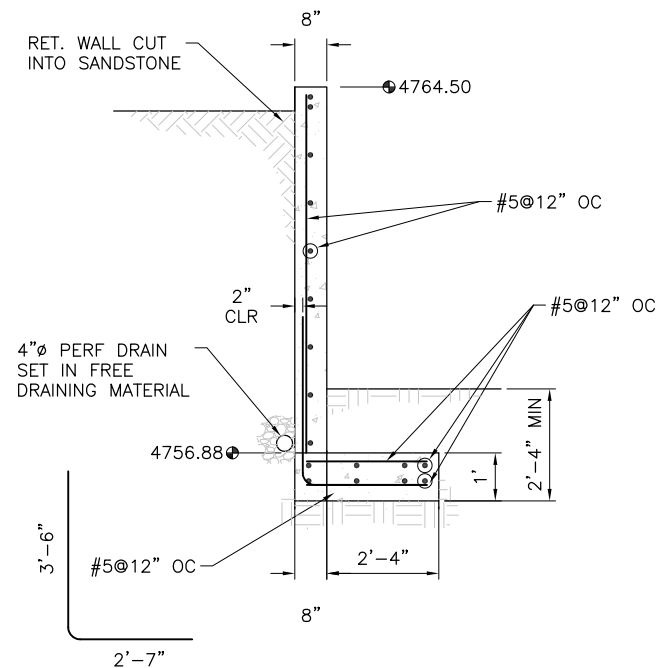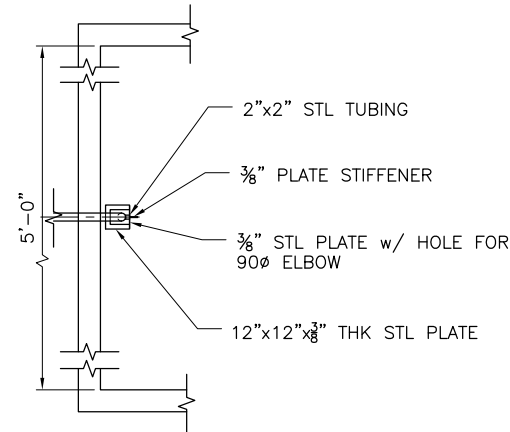

RET. WALL
DETAIL
SCALE: 1/4" = 1'-0"

3
S-12

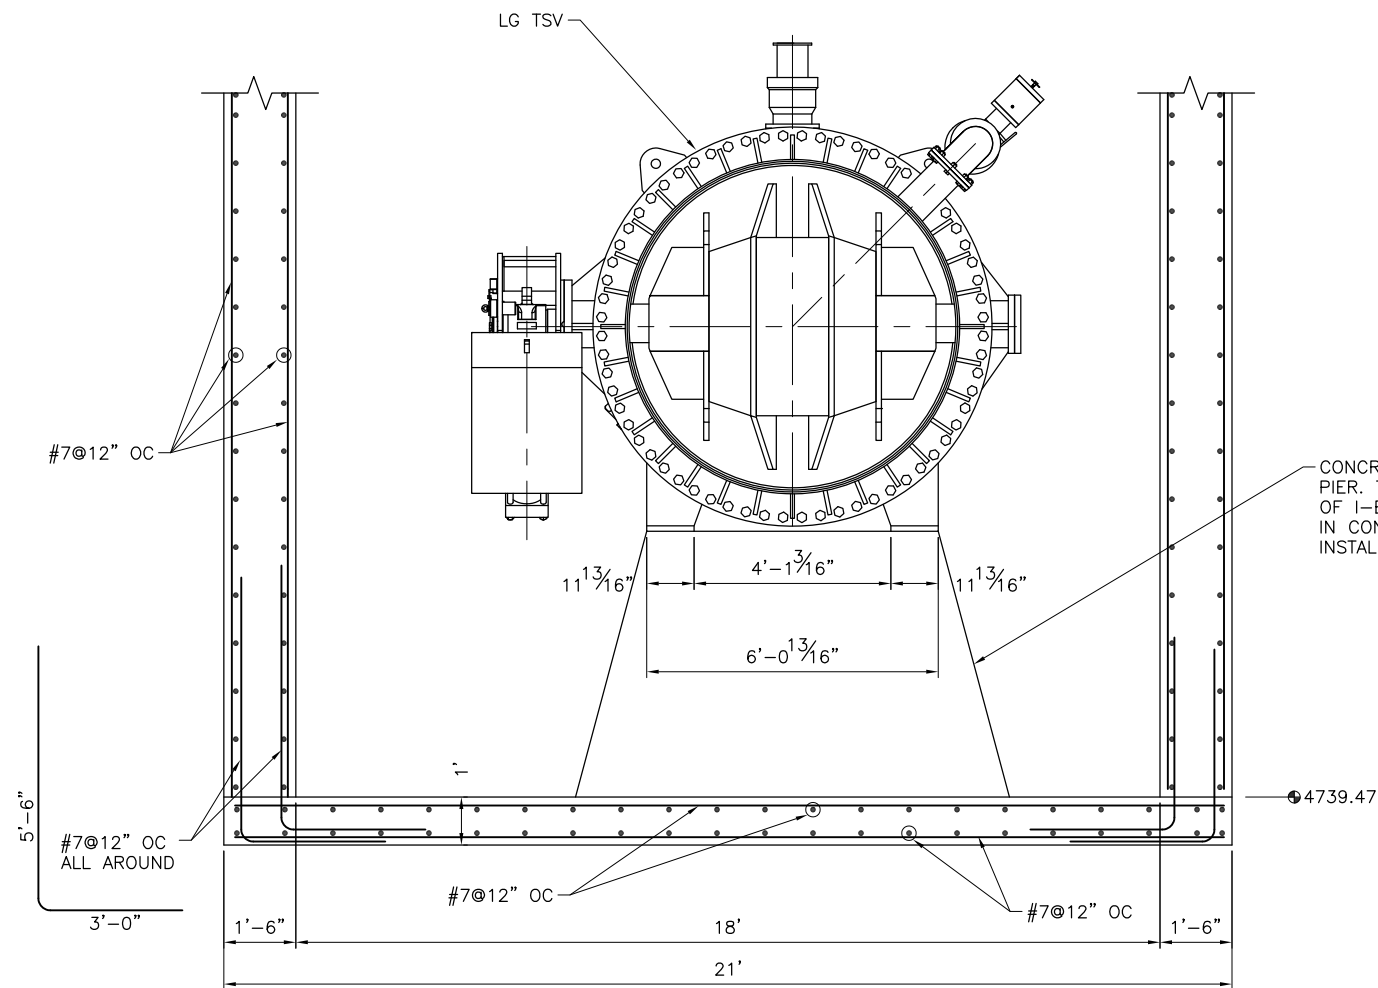

LG TSV SUPPORT
SECTION DETAIL
SCALE: 1/4" = 1'-0"

4
S-12

Mountain States Hydro, LLC

P.O. Box 918
Sunnyside, WA. 98944
OFF: (509) 837-6822
FAX: (509) 837-6801



ALWAYS THINK SAFETY

PROJECT
SOUTHEASTERN COLORADO WATER
ACTIVITY ENTERPRISE
PUEBLO DAM HYDROELECTRIC PROJECT
POWERHOUSE STRUCTURAL -
OIL/WATER SEPARATOR


AS CONSTRUCTED 2019

DESCRIPTION
REV NO YYYY-MM-DD
NAME, RISE, ABSE.

POWERHOUSE STRUCTURAL -
OIL/WATER SEPARATOR

S-12


COLUMN & FOOTING SCHEDULE				
COLUMN	SIZE	REINF	FOOTING	FOOTING REINF.
C1	30"x 30"	(16) #7 #4 TIES @ 12" OC	7'-0" x 7'-0"x 1'-10"	TOP: MATCH SLAB REINF BTM: (7) 7 EW
C2	38"x 20"	(14) #7 #4 TIES @ 12" OC	7'-0" x 7'-0"x 1'-10"	TOP: MATCH SLAB REINF BTM: (7) 7 EW

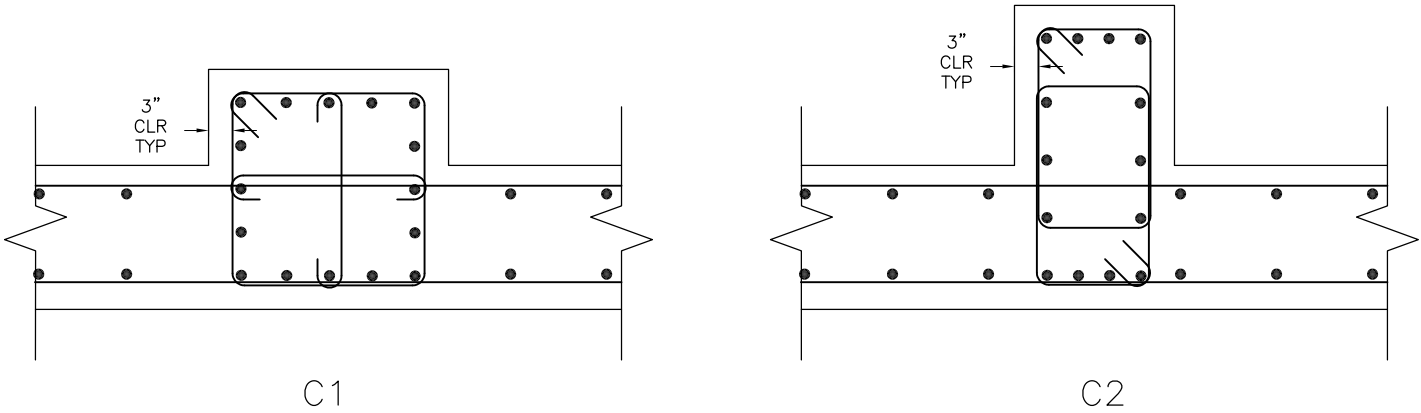

COLUMN REINFORCING
LAYOUT- C1 & C2

SCALE: 1/2" = 1'-0"


1
S-14

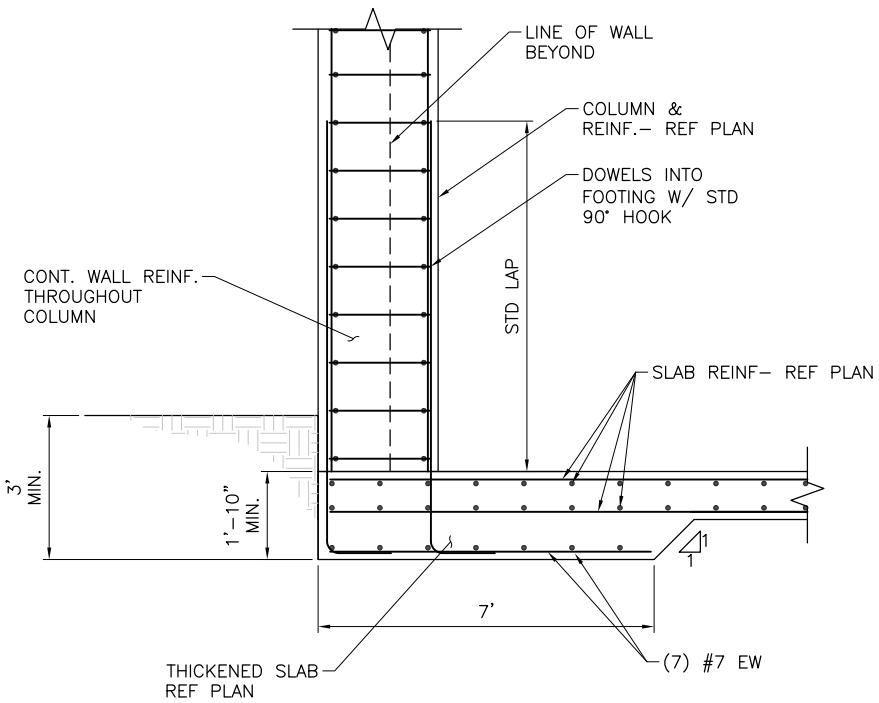

COLUMN REINFORCING
CONCRETE FOOTING

SCALE: 1/4" = 1'-0"

2
S-14

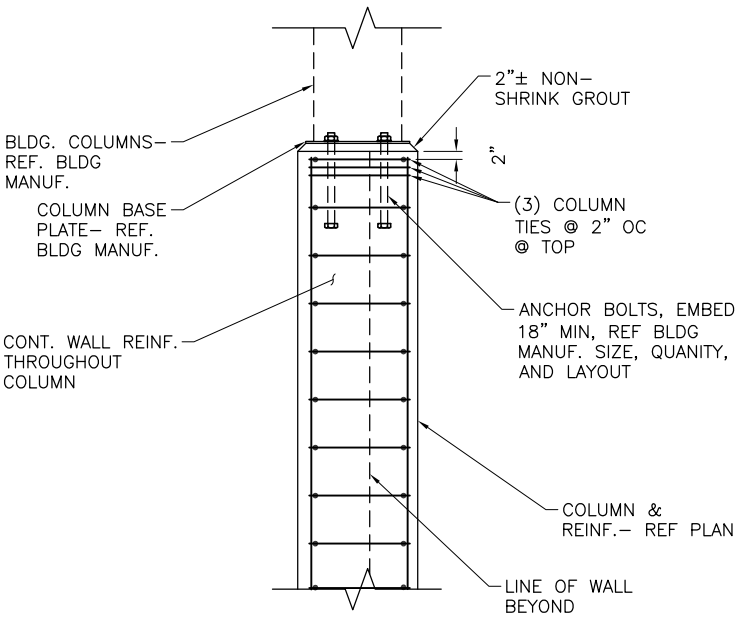

TOP OF COLUMN
CONCRETE PIER

SCALE: 1/4" = 1'-0"

3
S-14



ALWAYS THINK SAFETY

PROJECT
SOUTHEASTERN COLORADO WATER
ACTIVITY ENTERPRISE
PUEBLO DAM HYDROELECTRIC PROJECT
POWERHOUSE STRUCTURAL -
MISC. POWERHOUSE DETAILS

AS CONSTRUCTED 2019

POWERHOUSE STRUCTURAL -
MISC. POWERHOUSE DETAILS

S-14

Mountain States Hydro, LLC

P.O. Box 918
Sunnyside, WA. 98944
OFF: (509) 837-6822
FAX: (509) 837-6801

DATE AND TIME PLOTTED
October 1, 2019 12:25
PLOTTED BY
MO

CAD SYSTEM
AUTOCAD
STRUCTURAL 9-27-19 AS CONSTRUCTED

DATE AND TIME PLOTTED
October 16, 2019 13:04
PLOTTED BY
MO

CAD SYSTEM
CADD FILENAME
STRUCTURAL 9-27-19-AS CONSTRUCTED.DWG



POWERHOUSE BLDG STEEL
PLAN EL 4756.88

SCALE: 3/32" = 1'-0"


1
S-5S

- NOTE:
1. STAIR LANDINGS EQUAL 48" AS SHOWN.
 2. Stair Rise = $6\frac{15}{16}$ "
Run = 11"
 3. MIN. CLR WIDTH FOR STAIRS = 44"
 4. STANDARD HAND RAIL HEIGHT = 42"
 5. STAIR HAND RAIL HEIGHT = 36"
 6. 48" MIN. LANDING AT TOP AND BOTTOM OF STAIRS.
 7. 44" MIN EGRESS EACH SIDE OF DOORWAY.
MAX $\frac{1}{2}$ " VARIANCE BETWEEN THRESHOLD AND LANDING
 8. HANDRAIL EXTENSIONS- HANDRAILS SHALL RETURN TO A WALL, GUARD OR THE WALKING SURFACE OR SHALL BE CONTINUOUS TO THE HANDRAIL OF AN ADJACENT FLIGHT OF STAIRS OR RAMP RUN. WHERE HANDRAILS ARE NOT CONTINUOUS BETWEEN FLIGHTS, THE HANDRAILS SHALL EXTEND HORIZONTALLY NOT LESS THAN 12 INCHES BEYOND THE TOP RISER AND CONTINUE TO SLOPE FOR THE DEPTH OF ONE TREAD BEYOND THE BOTTOM RISER. AT RAMP WHERE HANDRAILS ARE NOT CONTINUOUS BETWEEN RUNS, THE HANDRAILS SHALL EXTEND HORIZONTALLY ABOVE THE LANDING 12 INCHES MINIMUM BEYOND THE TOP AND BOTTOM OF RAMP RUNS. THE EXTENSIONS OF HANDRAILS SHALL BE IN THE SAME DIRECTION OF THE FLIGHTS OF STAIRS AT STAIRWAYS AND THE RAMP RUNS AT RAMP.
 9. ALL REQUIRED DIMENSIONS FOR CATWALK, STAIRWAY, AND HANDRAIL TO BE FIELD MEASURED PRIOR TO FABRICATION.

HSS 4x2x $\frac{1}{4}$
ALIGN w/GUARDRAIL
POSTS- TYP

HSS 4x2x $\frac{1}{4}$
ALIGN w/GUARDRAIL
POSTS- TYP

HSS 4x2x $\frac{1}{4}$
ALIGN w/GUARDRAIL
POSTS- TYP

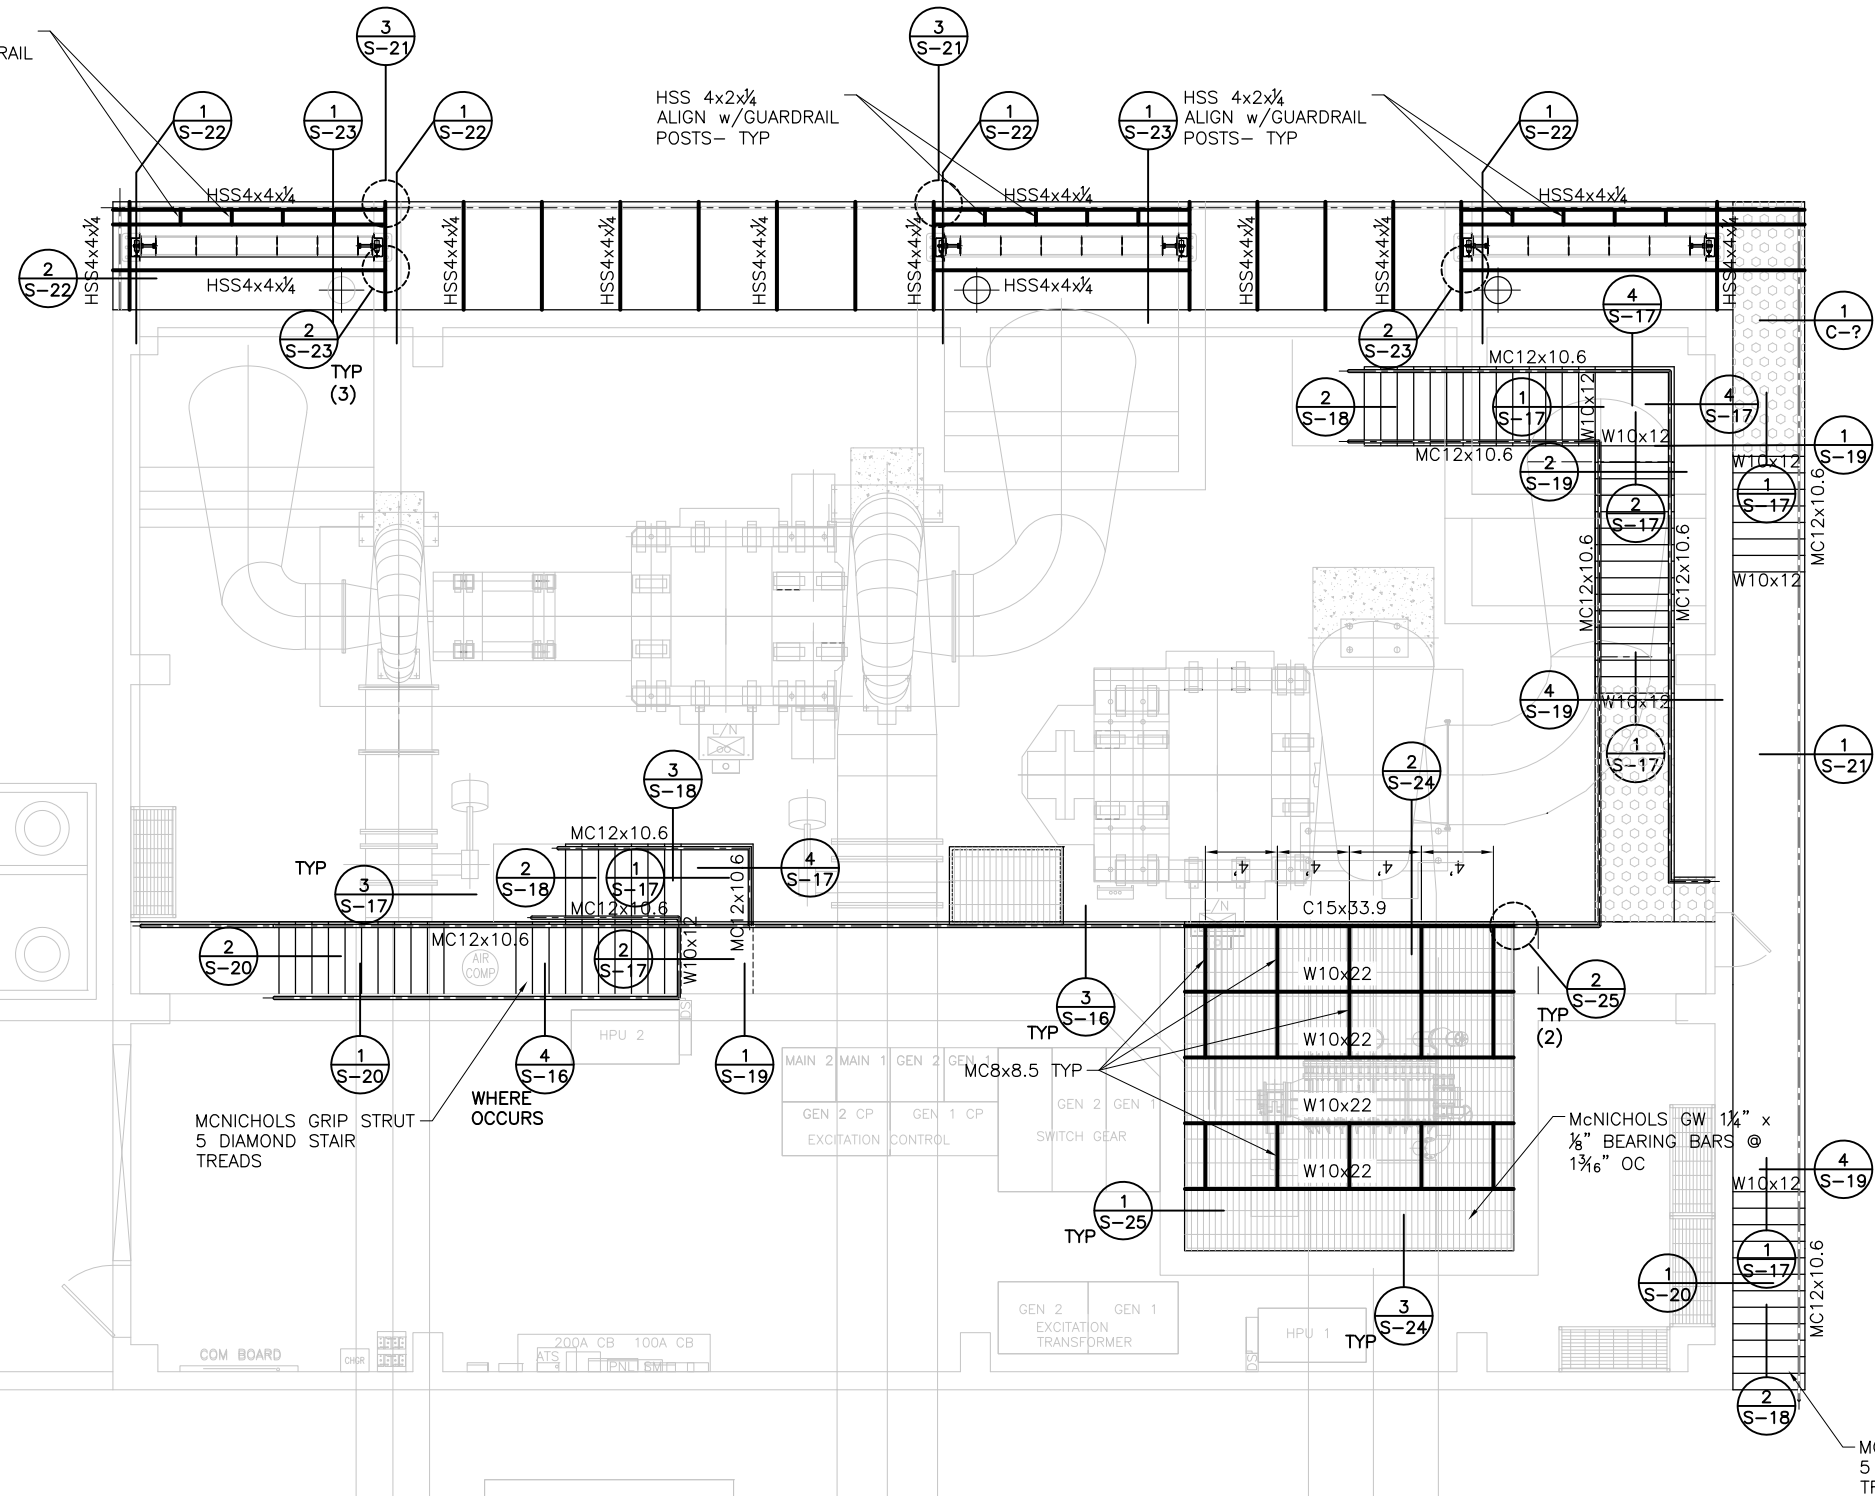

Mountain States Hydro, LLC

P.O. Box 918
Sunnyside, WA. 98944
OFF: (509) 837-6822
FAX: (509) 837-6801



ALWAYS THINK SAFETY

AS CONSTRUCTED 2019

POWERHOUSE STRUCTURAL-
PLAN- MAIN LEVEL
EL 4756.88

S-15

PROJECT
SOUTHEASTERN COLORADO WATER
ACTIVITY ENTERPRISE
PUEBLO DAM HYDROELECTRIC PROJECT
POWERHOUSE STRUCTURAL -
PLAN- MAIN LEVEL
EL 4754.26

DESCRIPTION
REV NO TYP-AM-20
NAME, DATE, APPR.

DRAWING NUMBER

DATE AND TIME PLOTTED
October 16, 2019 12:25
PLOTTED BY
MOU


CAD SYSTEM
AUTOCAD
STRUCTURAL 9-27-19 AS CONSTRUCTED

1 2 3 4 5

D


C

B

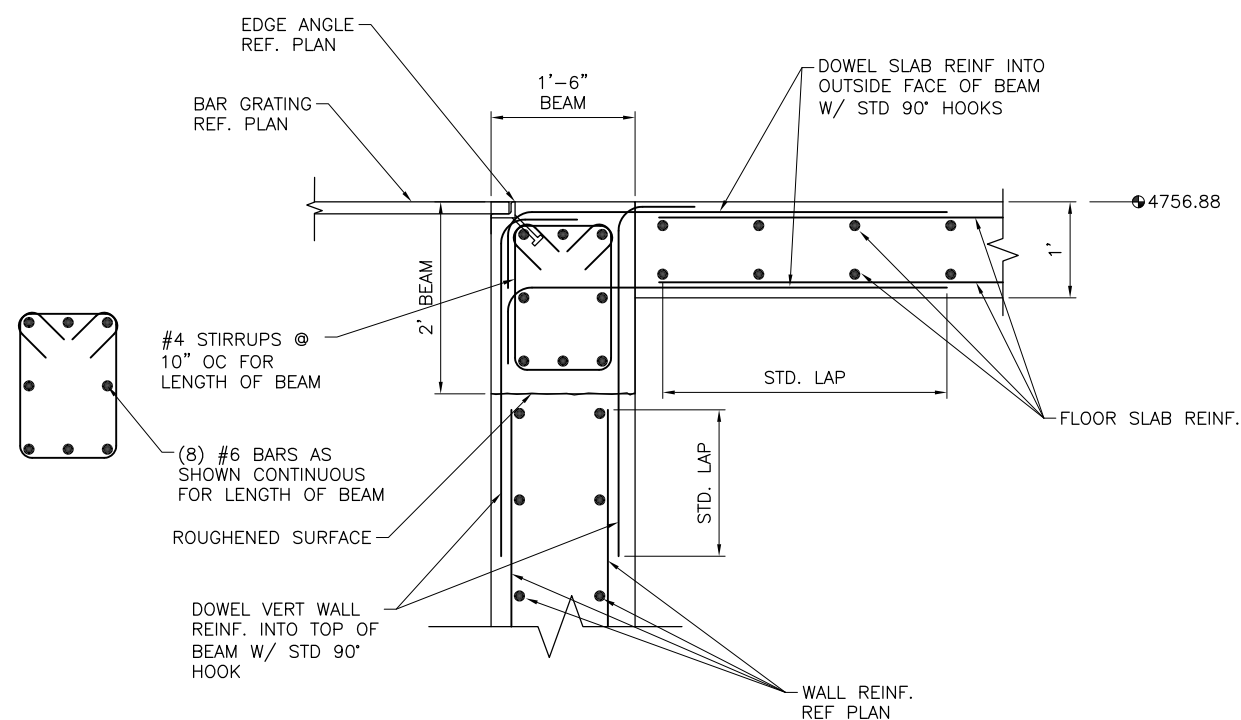


EDGE BEAM
AT WALL
SCALE: 1/2" = 1'-0"

1
S-16

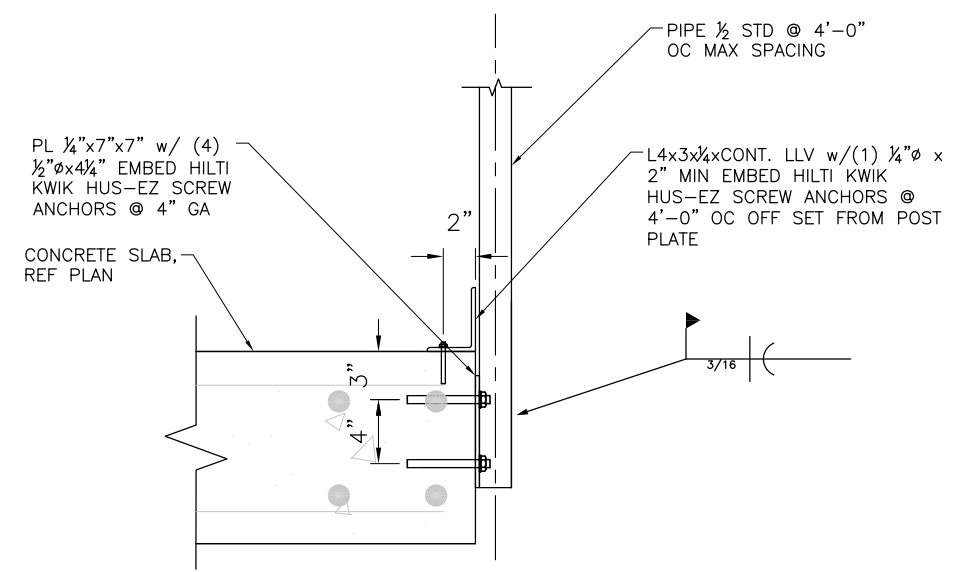


TYP CONCRETE SLAB
EDGE HANDRAIL
SCALE: 1" = 1'-0"

3
S-16

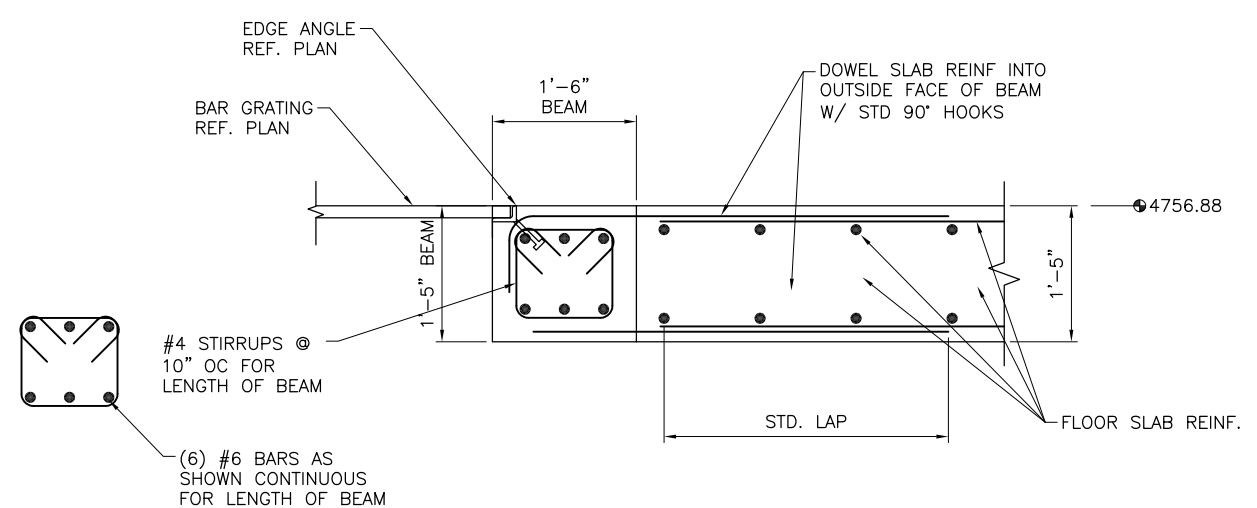

EDGE BEAM
AT CANTILEVER
SCALE: 1/2" = 1'-0"

2
S-16

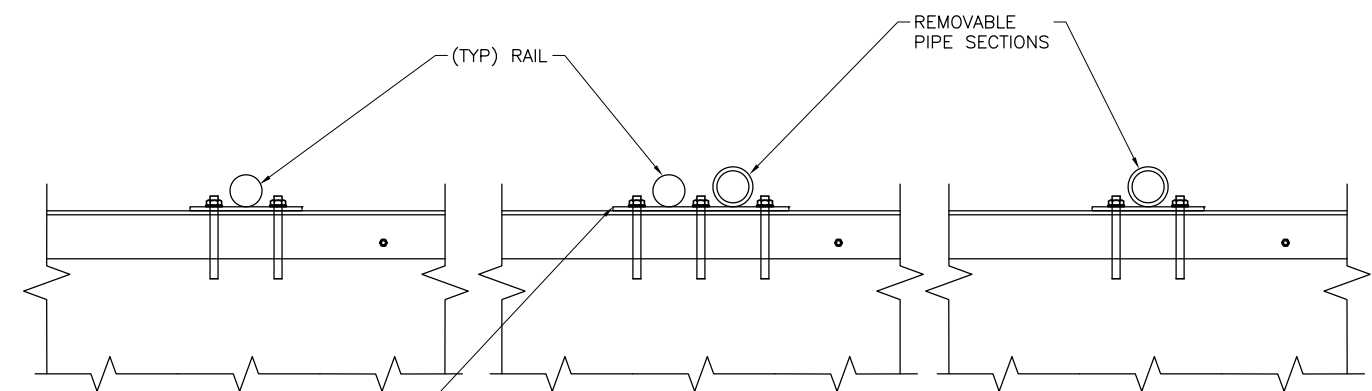

TYP CONCRETE SLAB
REMOVABLE EDGE HANDRAIL
SCALE: 1/2" = 1'-0"

4
S-16

Mountain States Hydro, LLC

P.O. Box 918
Sunnyside, WA. 98944

Off: (509) 837-6822
Fax: (509) 837-6801



ALWAYS THINK SAFETY

PROJECT
SOUTHEASTERN COLORADO WATER
ACTIVITY ENTERPRISE
PUEBLO DAM HYDROELECTRIC PROJECT
POWERHOUSE STRUCTURAL -
MISC. POWERHOUSE DETAILS


AS CONSTRUCTED 2019

POWERHOUSE STRUCTURAL -
MISC. POWERHOUSE DETAILS

S-16


DESCRIPTION
REV NO
DATE
BY
NAME
DATE
APPROVED

DATE AND TIME PLOTTED
October 11, 2019 12:25
PLOTTED BY
MOJ
CADD SYSTEM
AUTOCAD
STRUCTURAL 9-27-19 AS CONSTRUCTED
MOJ

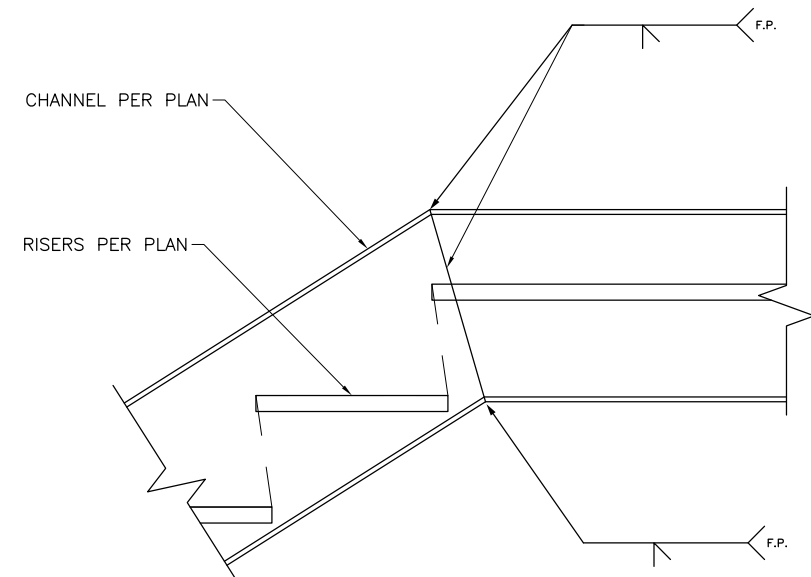


BENT STRINGER
CONNECTION
SCALE: 1" = 1'-0"

3
S-17

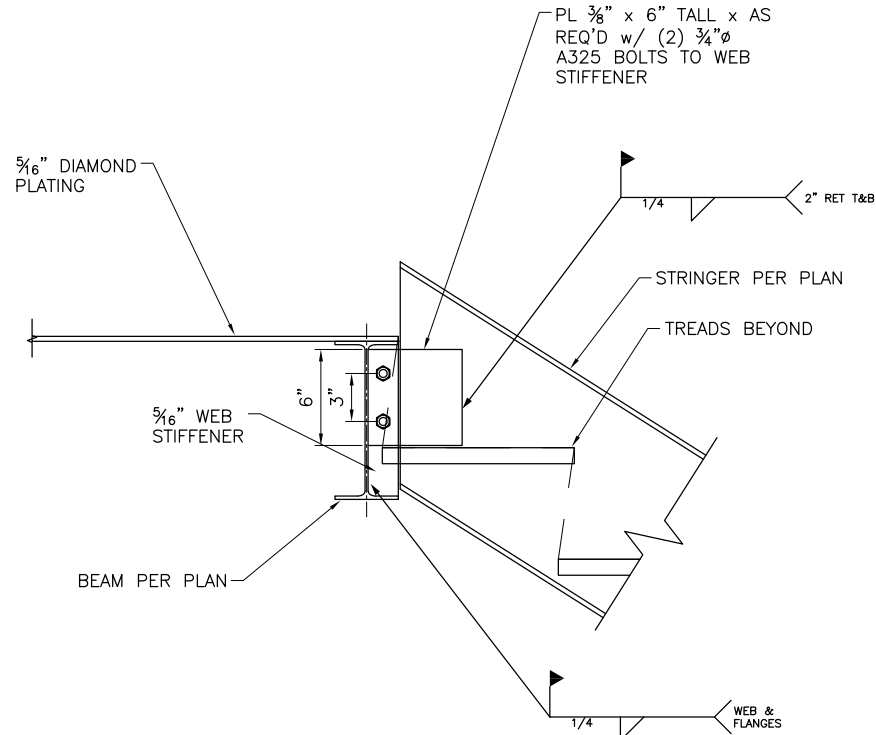


STRINGER TO
LANDING BEAM
SCALE: 1" = 1'-0"

1
S-17

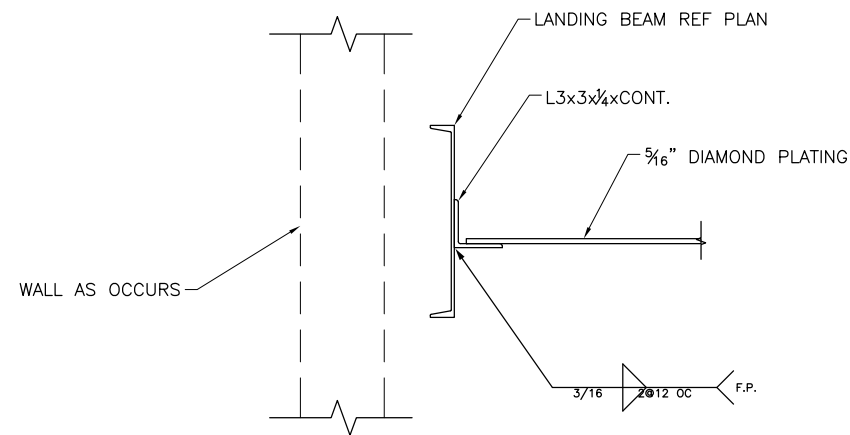

LANDING END
CONNECTION
SCALE: 1" = 1'-0"

4
S-17

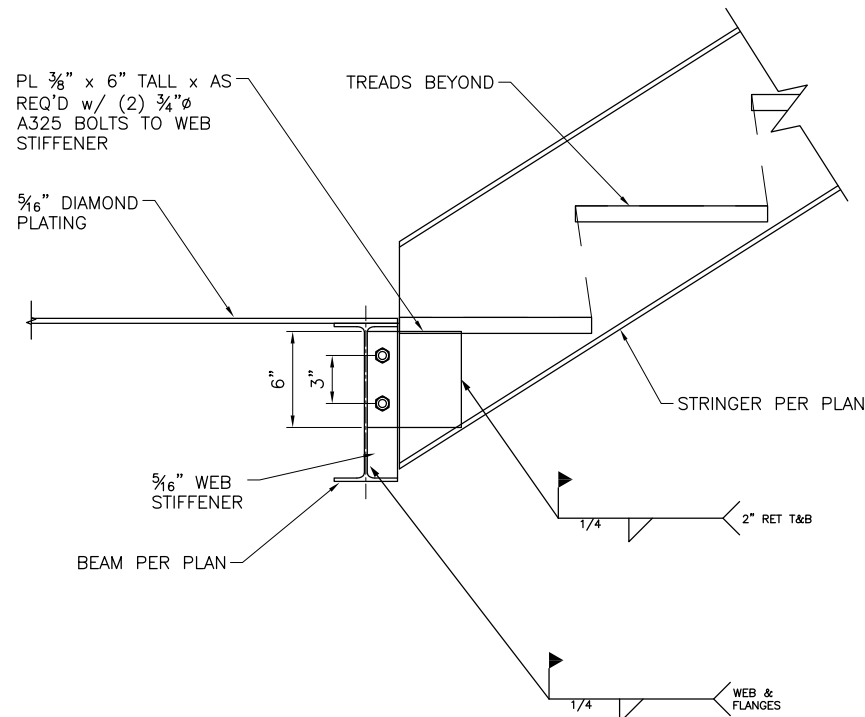

STRINGER TO
LANDING BEAM
SCALE: 1" = 1'-0"

2
S-17

Mountain States Hydro, LLC

P.O. Box 918 Sunnyside, WA. 98944
OFF: (509) 837-6822
FAX: (509) 837-6801



ALWAYS THINK SAFETY

PROJECT
SOUTHEASTERN COLORADO WATER
ACTIVITY ENTERPRISE
PUEBLO DAM HYDROELECTRIC PROJECT
POWERHOUSE STRUCTURAL -
MISC. POWERHOUSE DETAILS


AS CONSTRUCTED 2019

DESCRIPTION
REV. NO. YYYY-MM-DD
NAME, DESIG. ASSG.


POWERHOUSE STRUCTURAL -
MISC. POWERHOUSE DETAILS

S-17


DATE AND TIME PLOTTED
October 11, 2019 12:25
PLOTTED BY
MOJ
CADD SYSTEM
AUTOCAD
STRUCTURAL 9-27-19 AS CONSTRUCTED 9/30

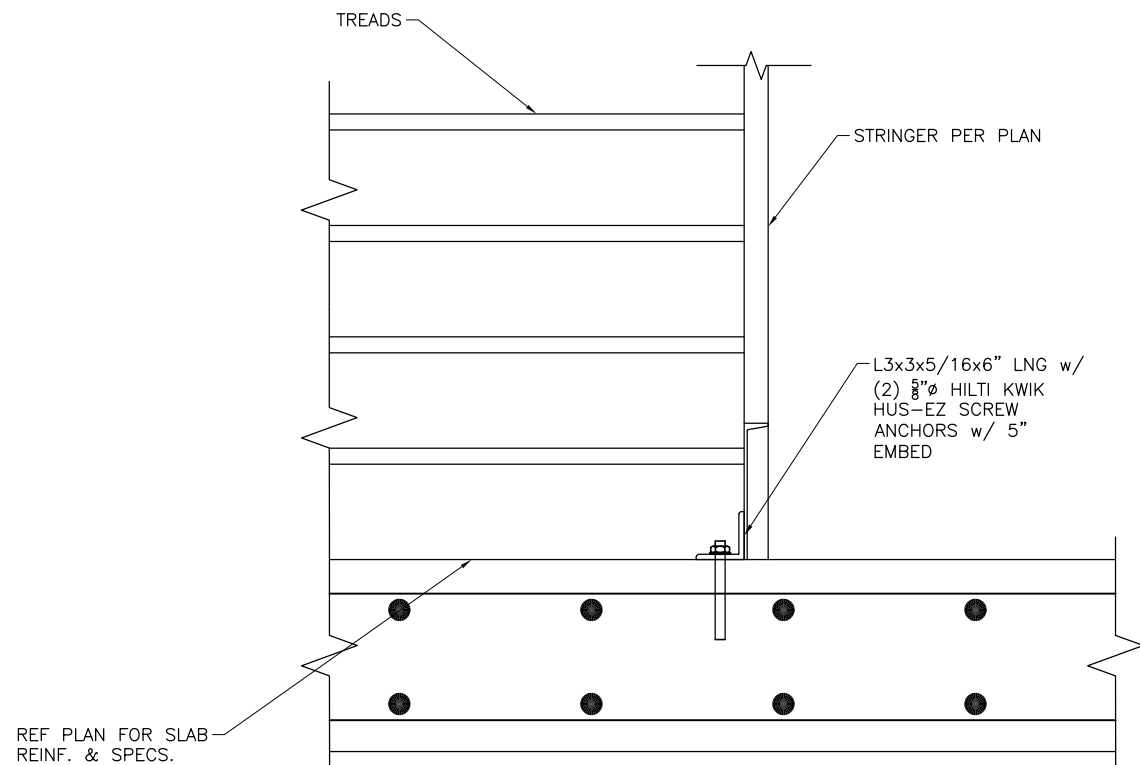

STAIR STRINGER
TO SLAB
SCALE: 1" = 1'-0"
1
S-18

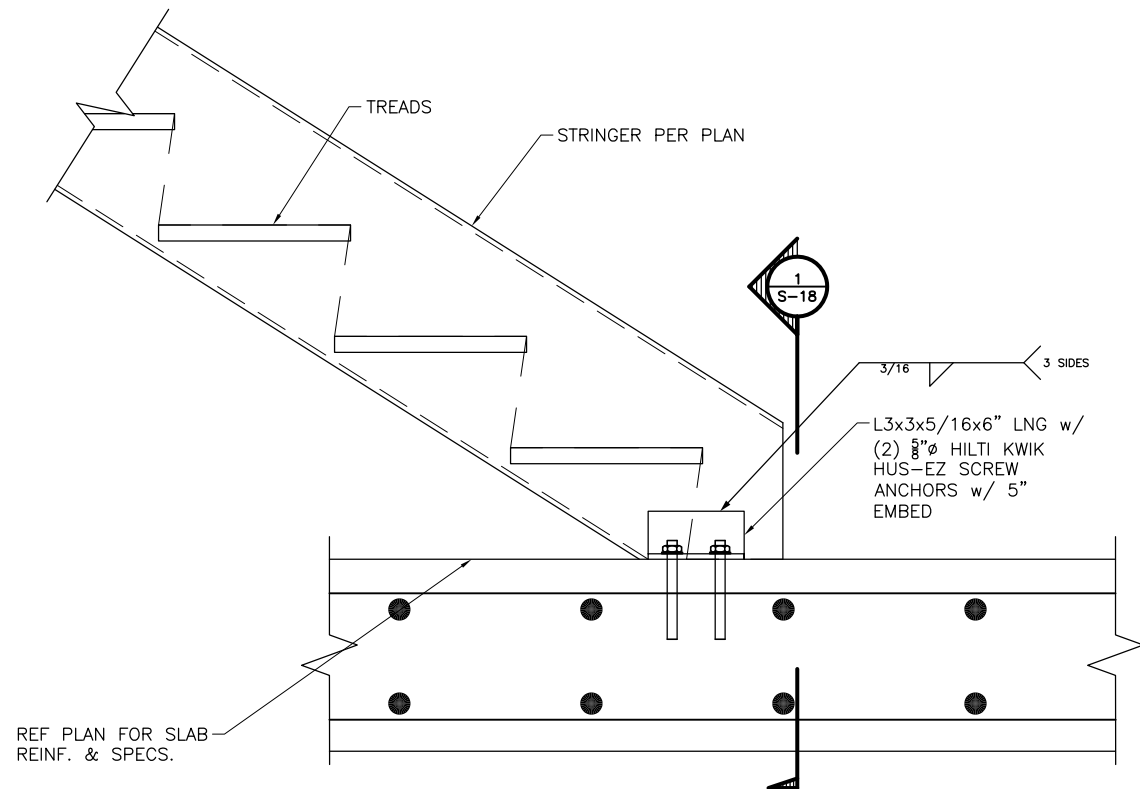

STAIR STRINGER
TO SLAB
SCALE: 1" = 1'-0"
2
S-18

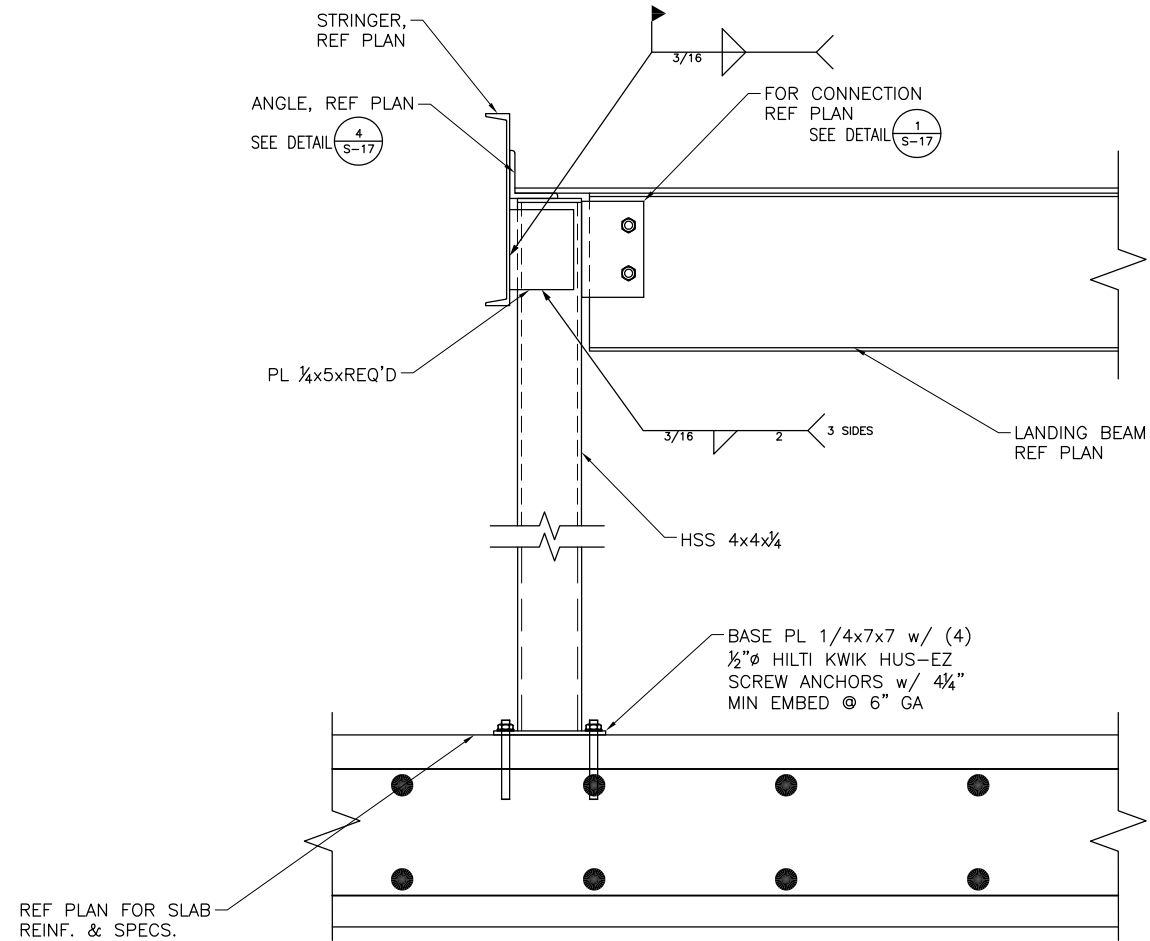

COLUMN BASE &
BEAM CONNECTION
SCALE: 1" = 1'-0"
3
S-18

Mountain States Hydro, LLC
P.O. Box 918
Sunnyside, WA 98944
OFF: (509) 837-6822
FAX: (509) 837-6801



ALWAYS THINK SAFETY

PROJECT
SOUTHEASTERN COLORADO WATER
ACTIVITY ENTERPRISE
PUEBLO DAM HYDROELECTRIC PROJECT
POWERHOUSE STRUCTURAL -
MISC. POWERHOUSE DETAILS


AS CONSTRUCTED 2019

REV NO YYYY-MM-DD
NAME, PROJ, APPR.
DESCRIPTION

POWERHOUSE STRUCTURAL -
MISC. POWERHOUSE DETAILS


S-18

DATE AND TIME PLOTTED
October 11, 2019 12:25
PLOTTED BY
MOJ
CADD SYSTEM
AUTOCAD
STRUCTURAL 9-27-19 AS CONSTRUCTED
MOJ

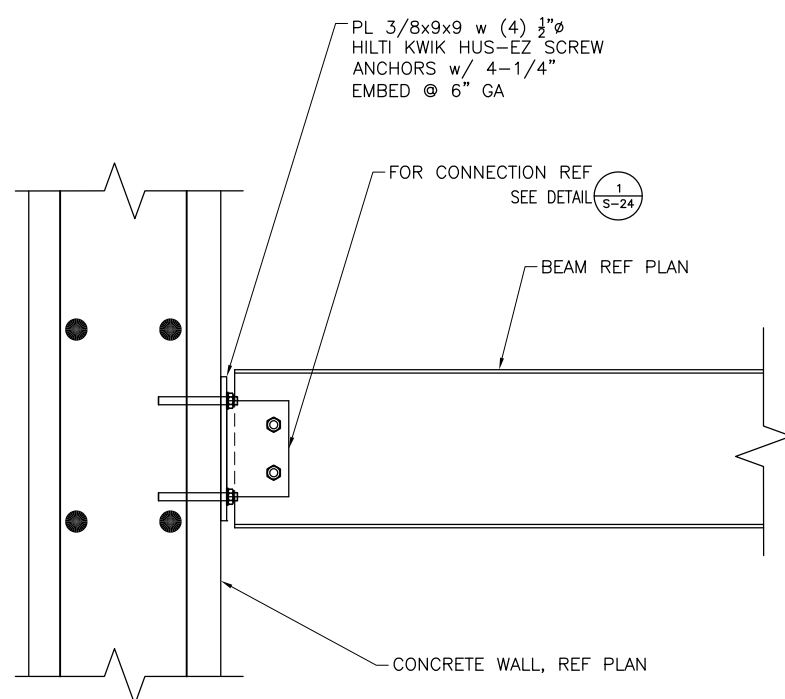


COLUMN BASE &
BEAM CONNECTION
SCALE: 1" = 1'-0"

1
S-19

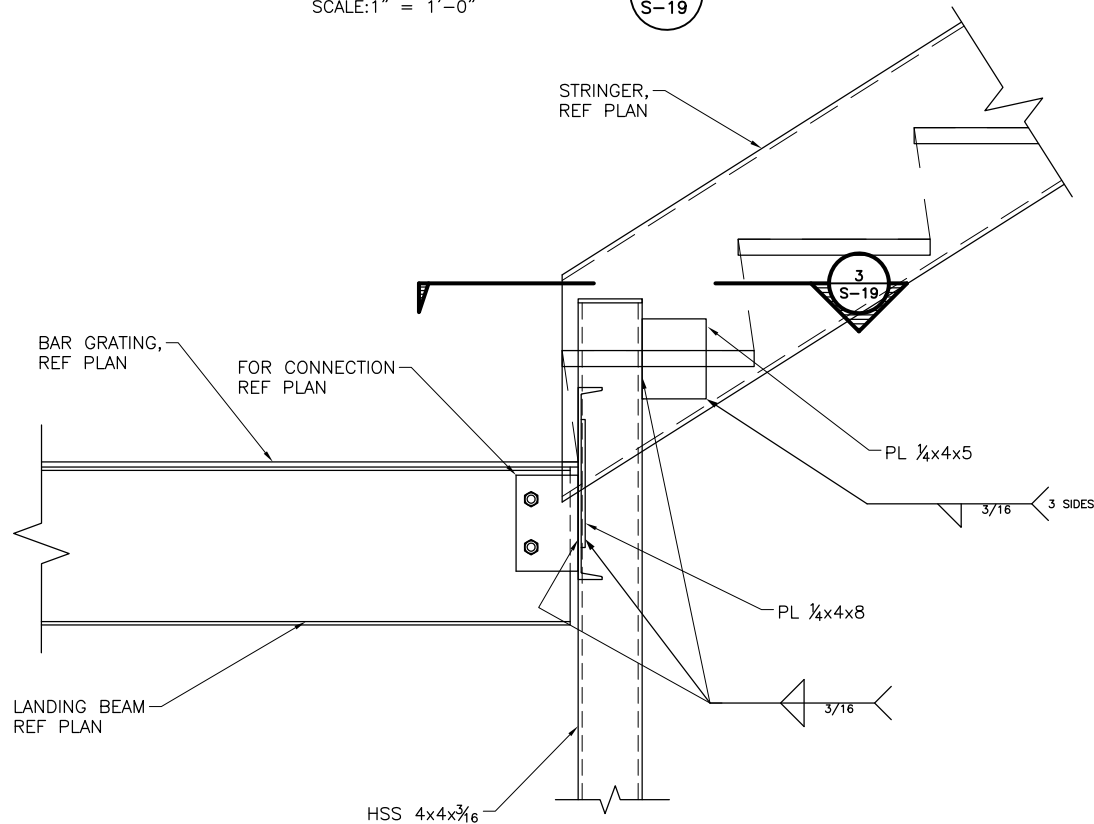


STAIR COLUMN
CONNECTIONS
SCALE: 1" = 1'-0"

2
S-19

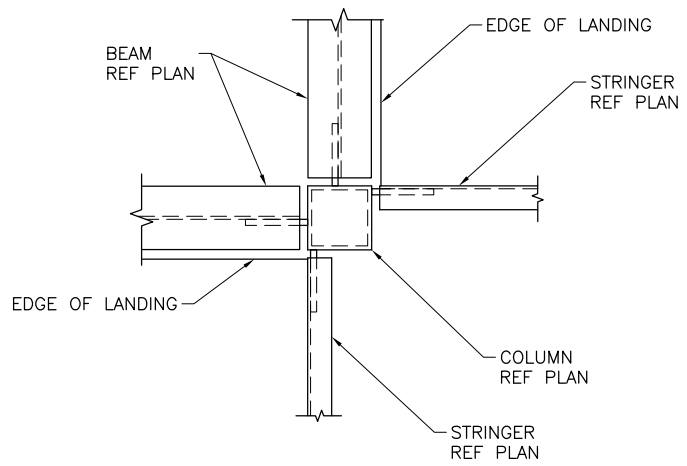

STAIR COLUMN
CONNECTIONS
SCALE: 1" = 1'-0"

3
S-19

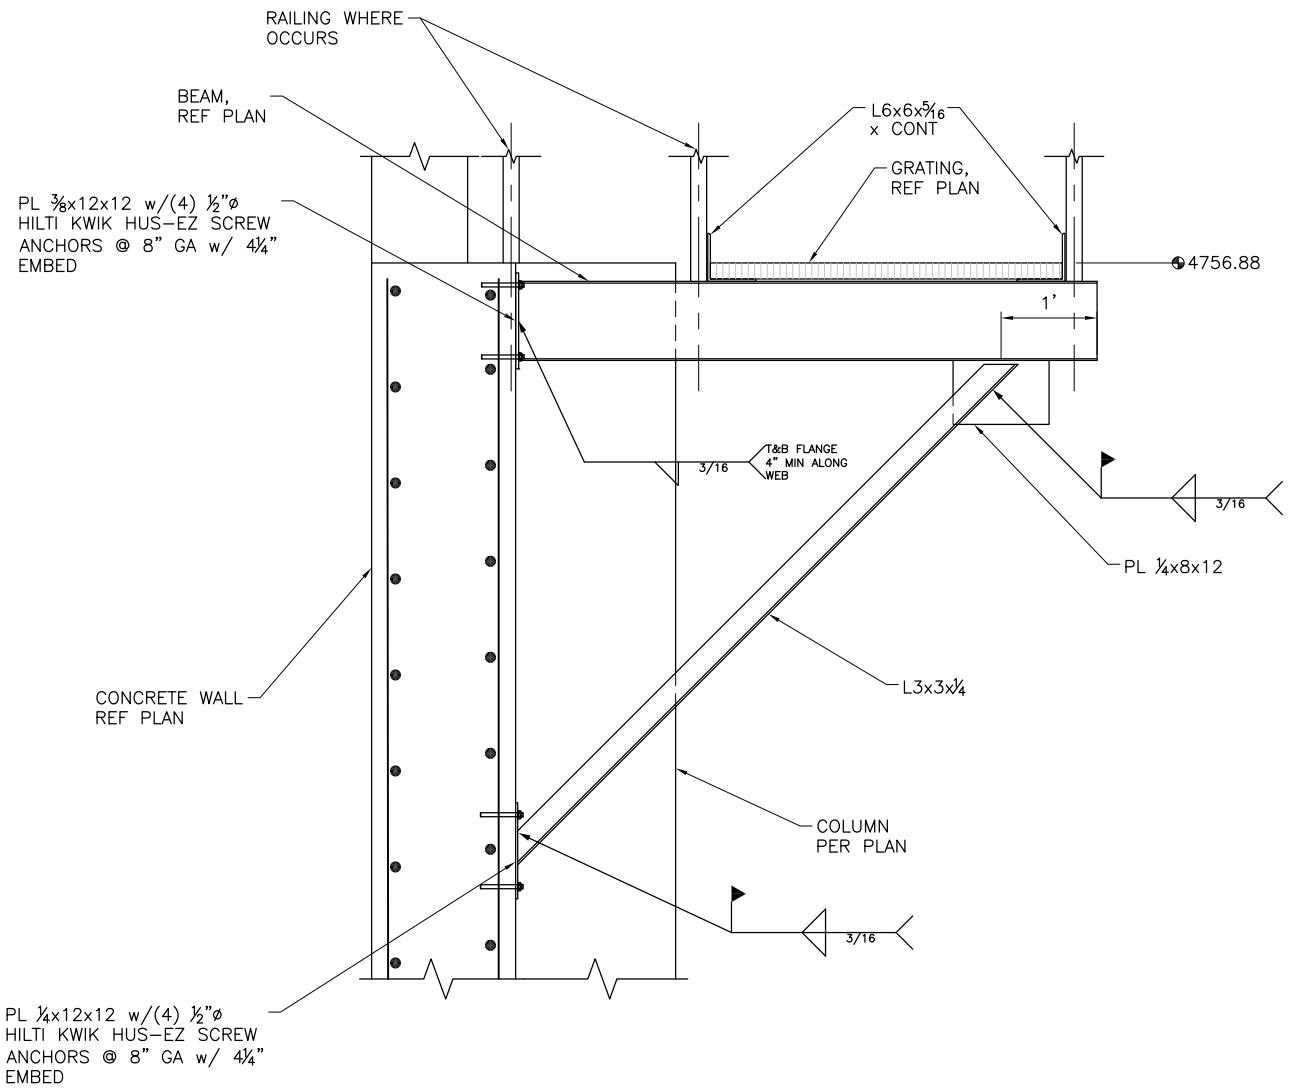

CAT WALK
BEAM ATTACHMENT
SCALE: 1/2" = 1'-0"

4
S-19

Mountain States Hydro, LLC
P.O. Box 918 Sunnyside, WA. 98944
OFF: (509) 837-6822
FAX: (509) 837-6801



ALWAYS THINK SAFETY

AS CONSTRUCTED 2019

POWERHOUSE STRUCTURAL -
MISC. POWERHOUSE DETAILS


SOUTHEASTERN COLORADO WATER
ACTIVITY ENTERPRISE
PUEBLO DAM HYDROELECTRIC PROJECT
POWERHOUSE STRUCTURAL -
MISC. POWERHOUSE DETAILS

S-19

DESCRIPTION
REV NO YYYY-MM-DD
NAME, PROJ, ASSG.

DRAWING NUMBER

DATE AND TIME PLOTTED
October 11, 2019 12:25
PLOTTED BY
MOJ
CADD SYSTEM
AUTOCAD
STRUCTURAL 9-27-19 AS CONSTRUCTED
MOJ

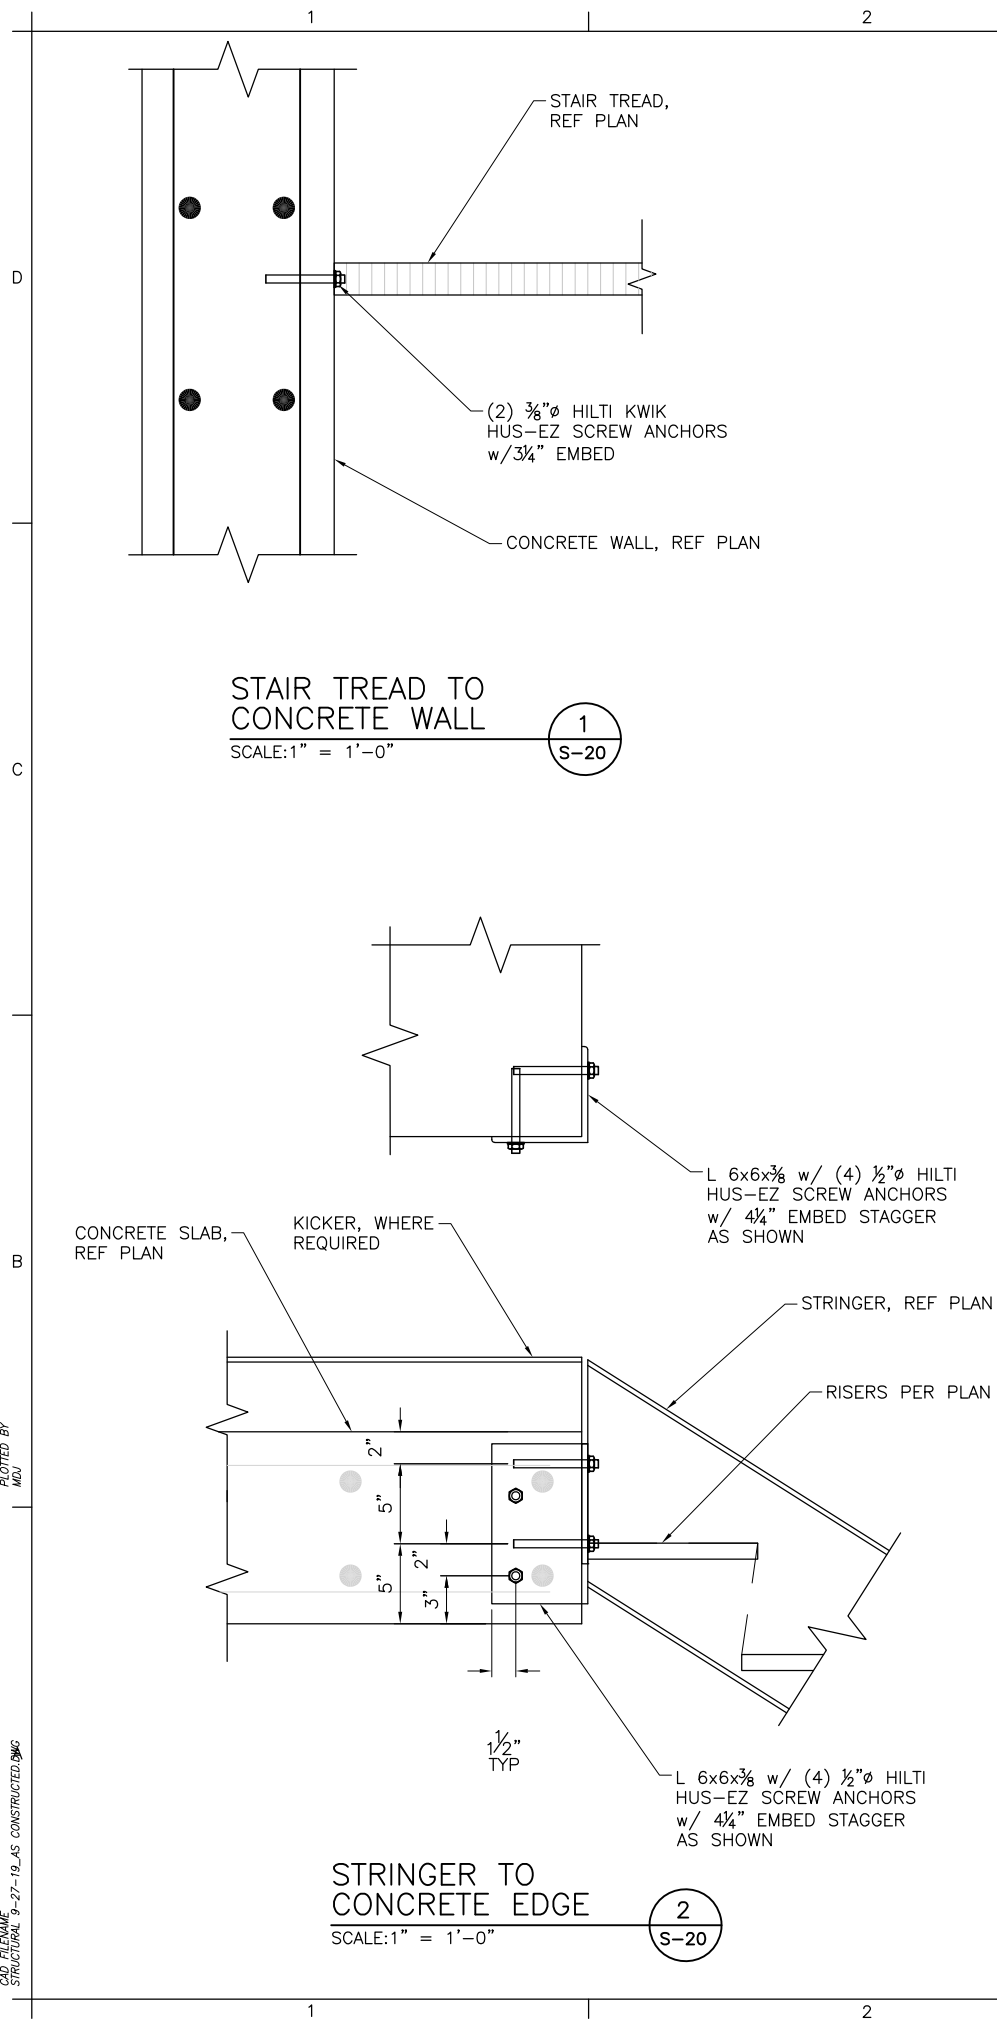

Mountain States Hydro, LLC

P.O. Box 918 Sunnyside, WA. 98944
OFF: (509) 837-6822 FAX: (509) 837-6801



ALWAYS THINK SAFETY

PROJECT
SOUTHEASTERN COLORADO WATER
ACTIVITY ENTERPRISE
PUEBLO DAM HYDROELECTRIC PROJECT
POWERHOUSE STRUCTURAL -
MISC. POWERHOUSE DETAILS


AS CONSTRUCTED 2019

REV. NO. YYYY-MM-DD
NAME, PROJ. ASSG.

POWERHOUSE STRUCTURAL -
MISC. POWERHOUSE DETAILS

S-20

DATE AND TIME PLOTTED
October 11, 2019 13:04
PLOTTER
AUTOCAD
STRUCTURAL 9-27-19 AS CONSTRUCTED
C:\SYSTEM
AUTOCAD
STRUCTURAL 9-27-19 AS CONSTRUCTED

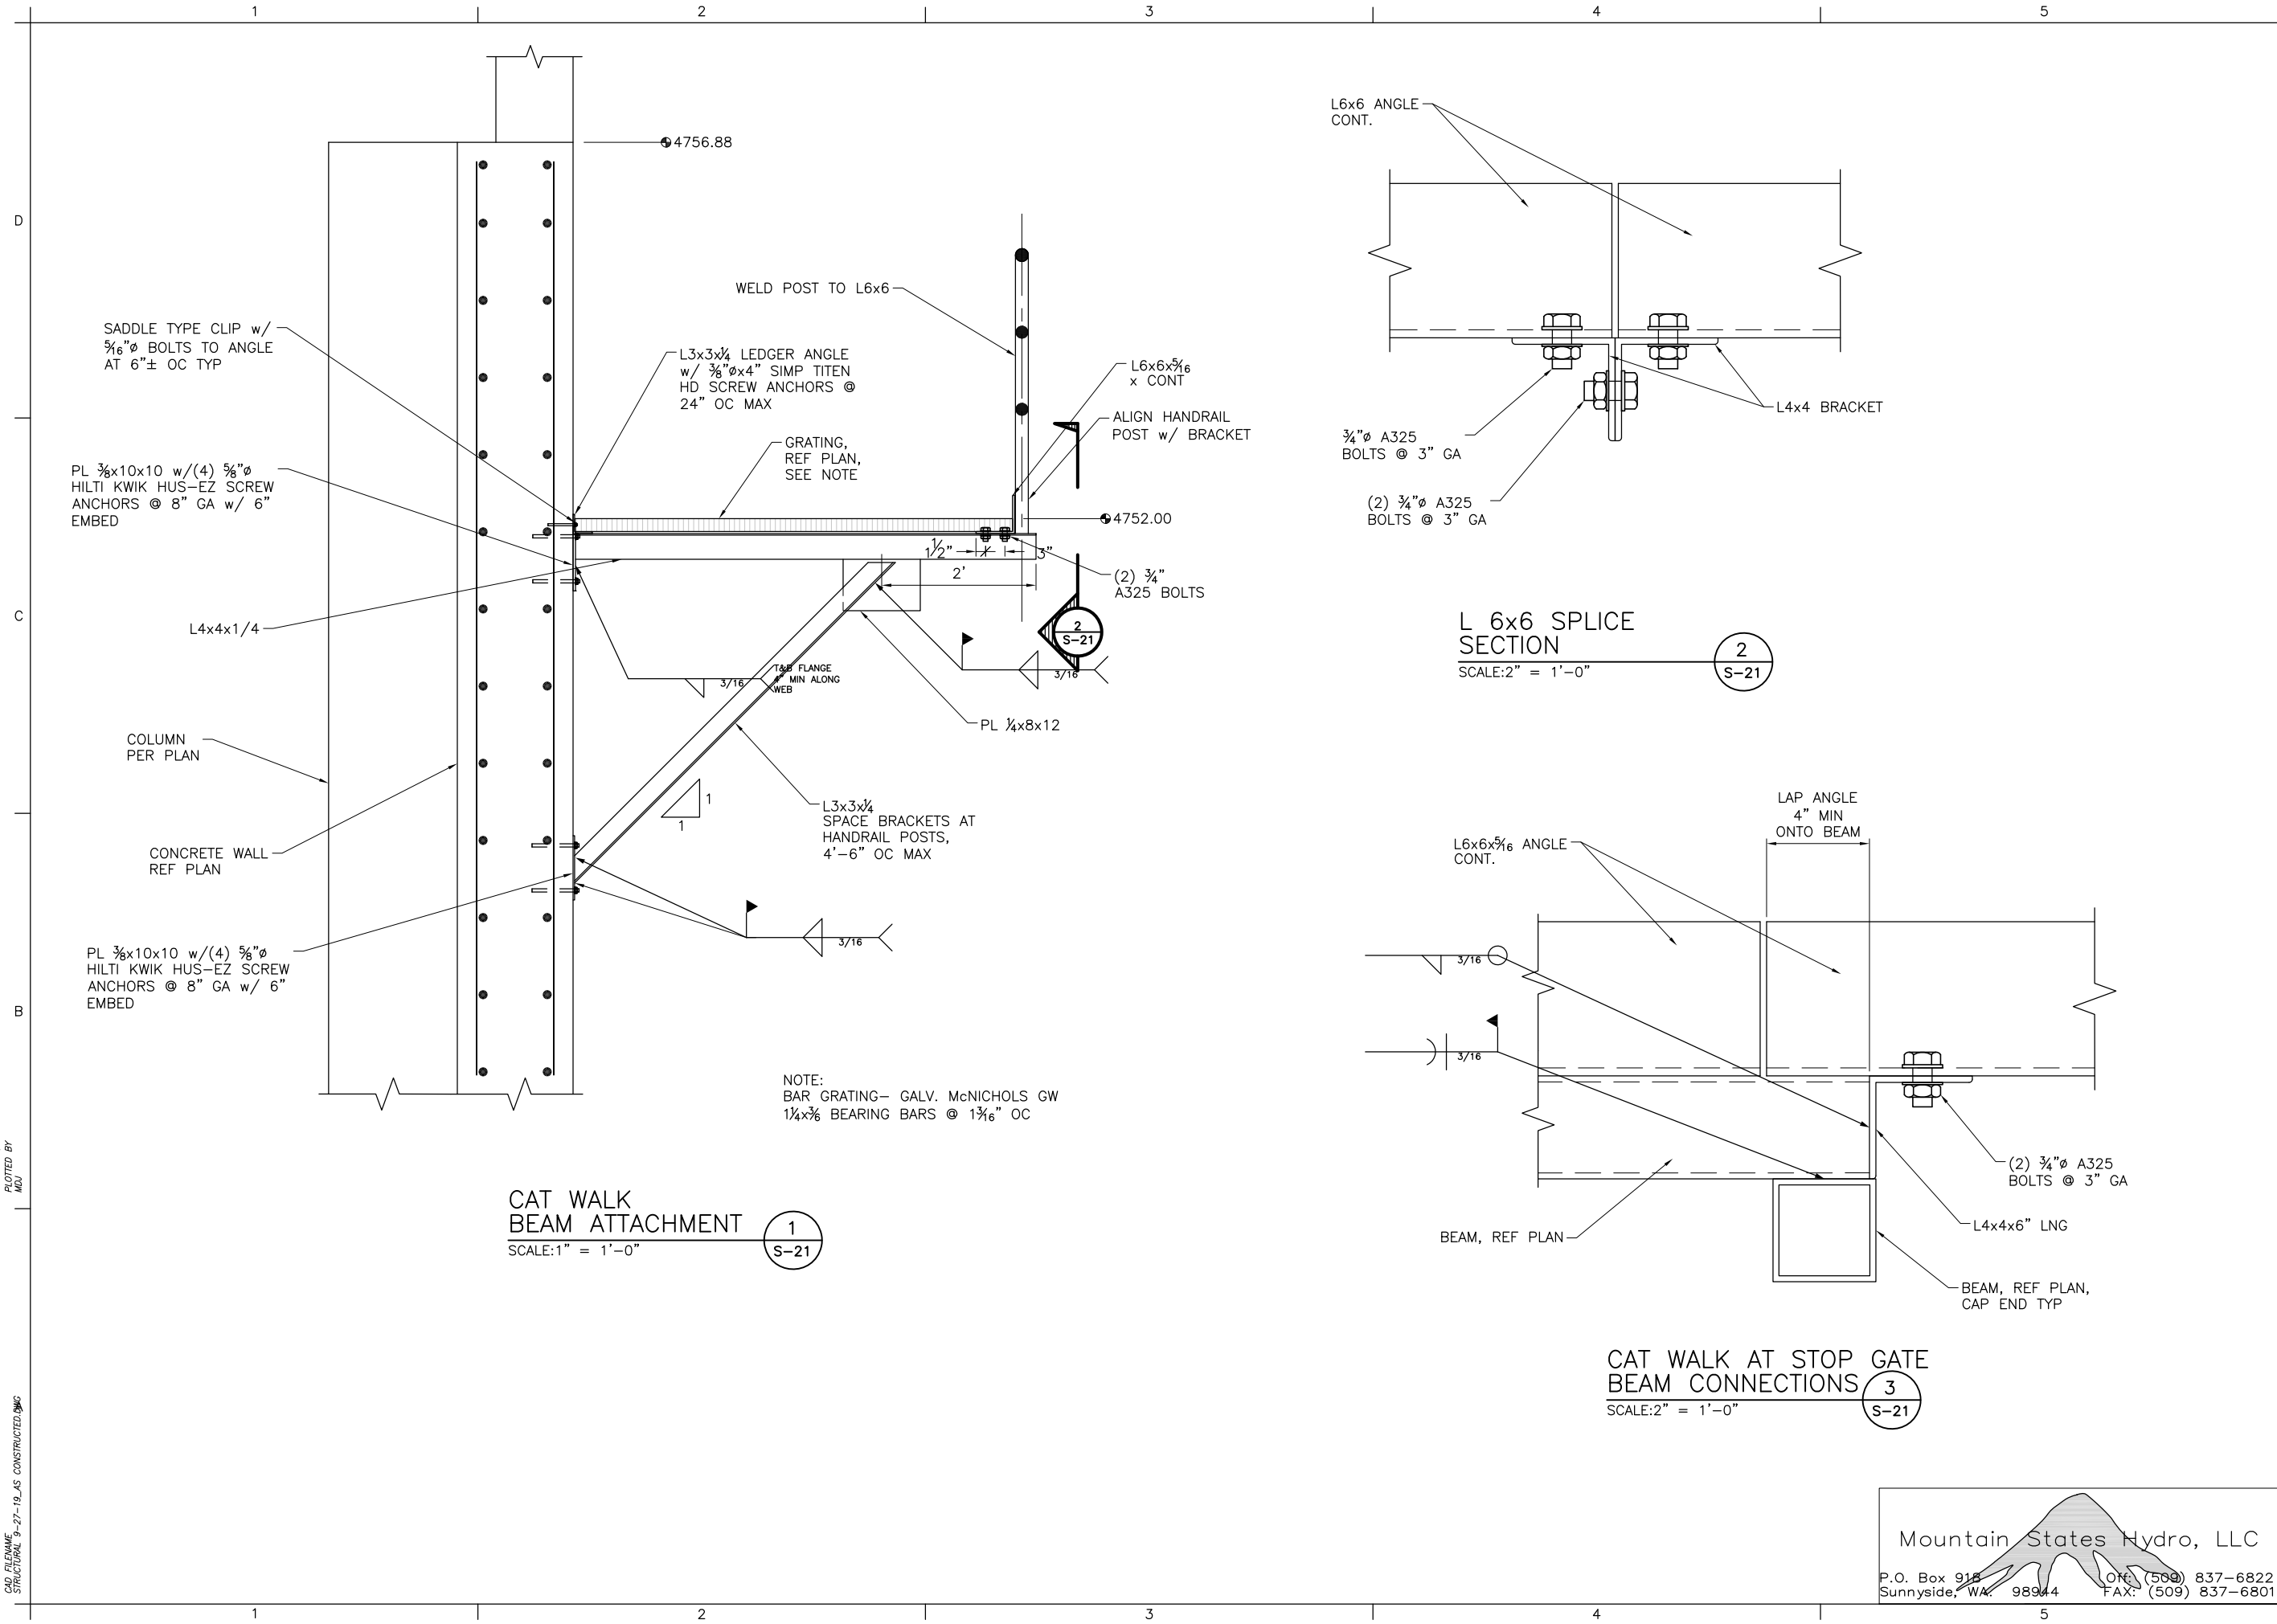


 SORENSEN ENGINEERING	PROJECT	DRAWING NUMBER	D	
 ALWAYS THINK SAFETY	<i>PROJECT</i> SOUTHEASTERN COLORADO WATER ACTIVITY ENTERPRISE PUEBLO DAM HYDROELECTRIC PROJECT POWERHOUSE STRUCTURAL – MISC. POWERHOUSE DETAILS	C	B	
AS CONSTRUCTED 2019	REV NO YYYY-MM-DD	DESCRIPTION	NAME, DATE, ASB#	A
POWERHOUSE STRUCTURAL – MISC. POWERHOUSE DETAILS				S-21

Mountain States Hydro, LLC

P.O. Box 918
Sunnyside, WA. 98944
OFF: (509) 837-6822
FAX: (509) 837-6801

DATE AND TIME PLOTTED
October 11, 2019 13:04
PLOTTER
AUTO
MOU

CAD SYSTEM
AUTOCAD
STRUCTURAL 9-27-19 AS CONSTRUCTED

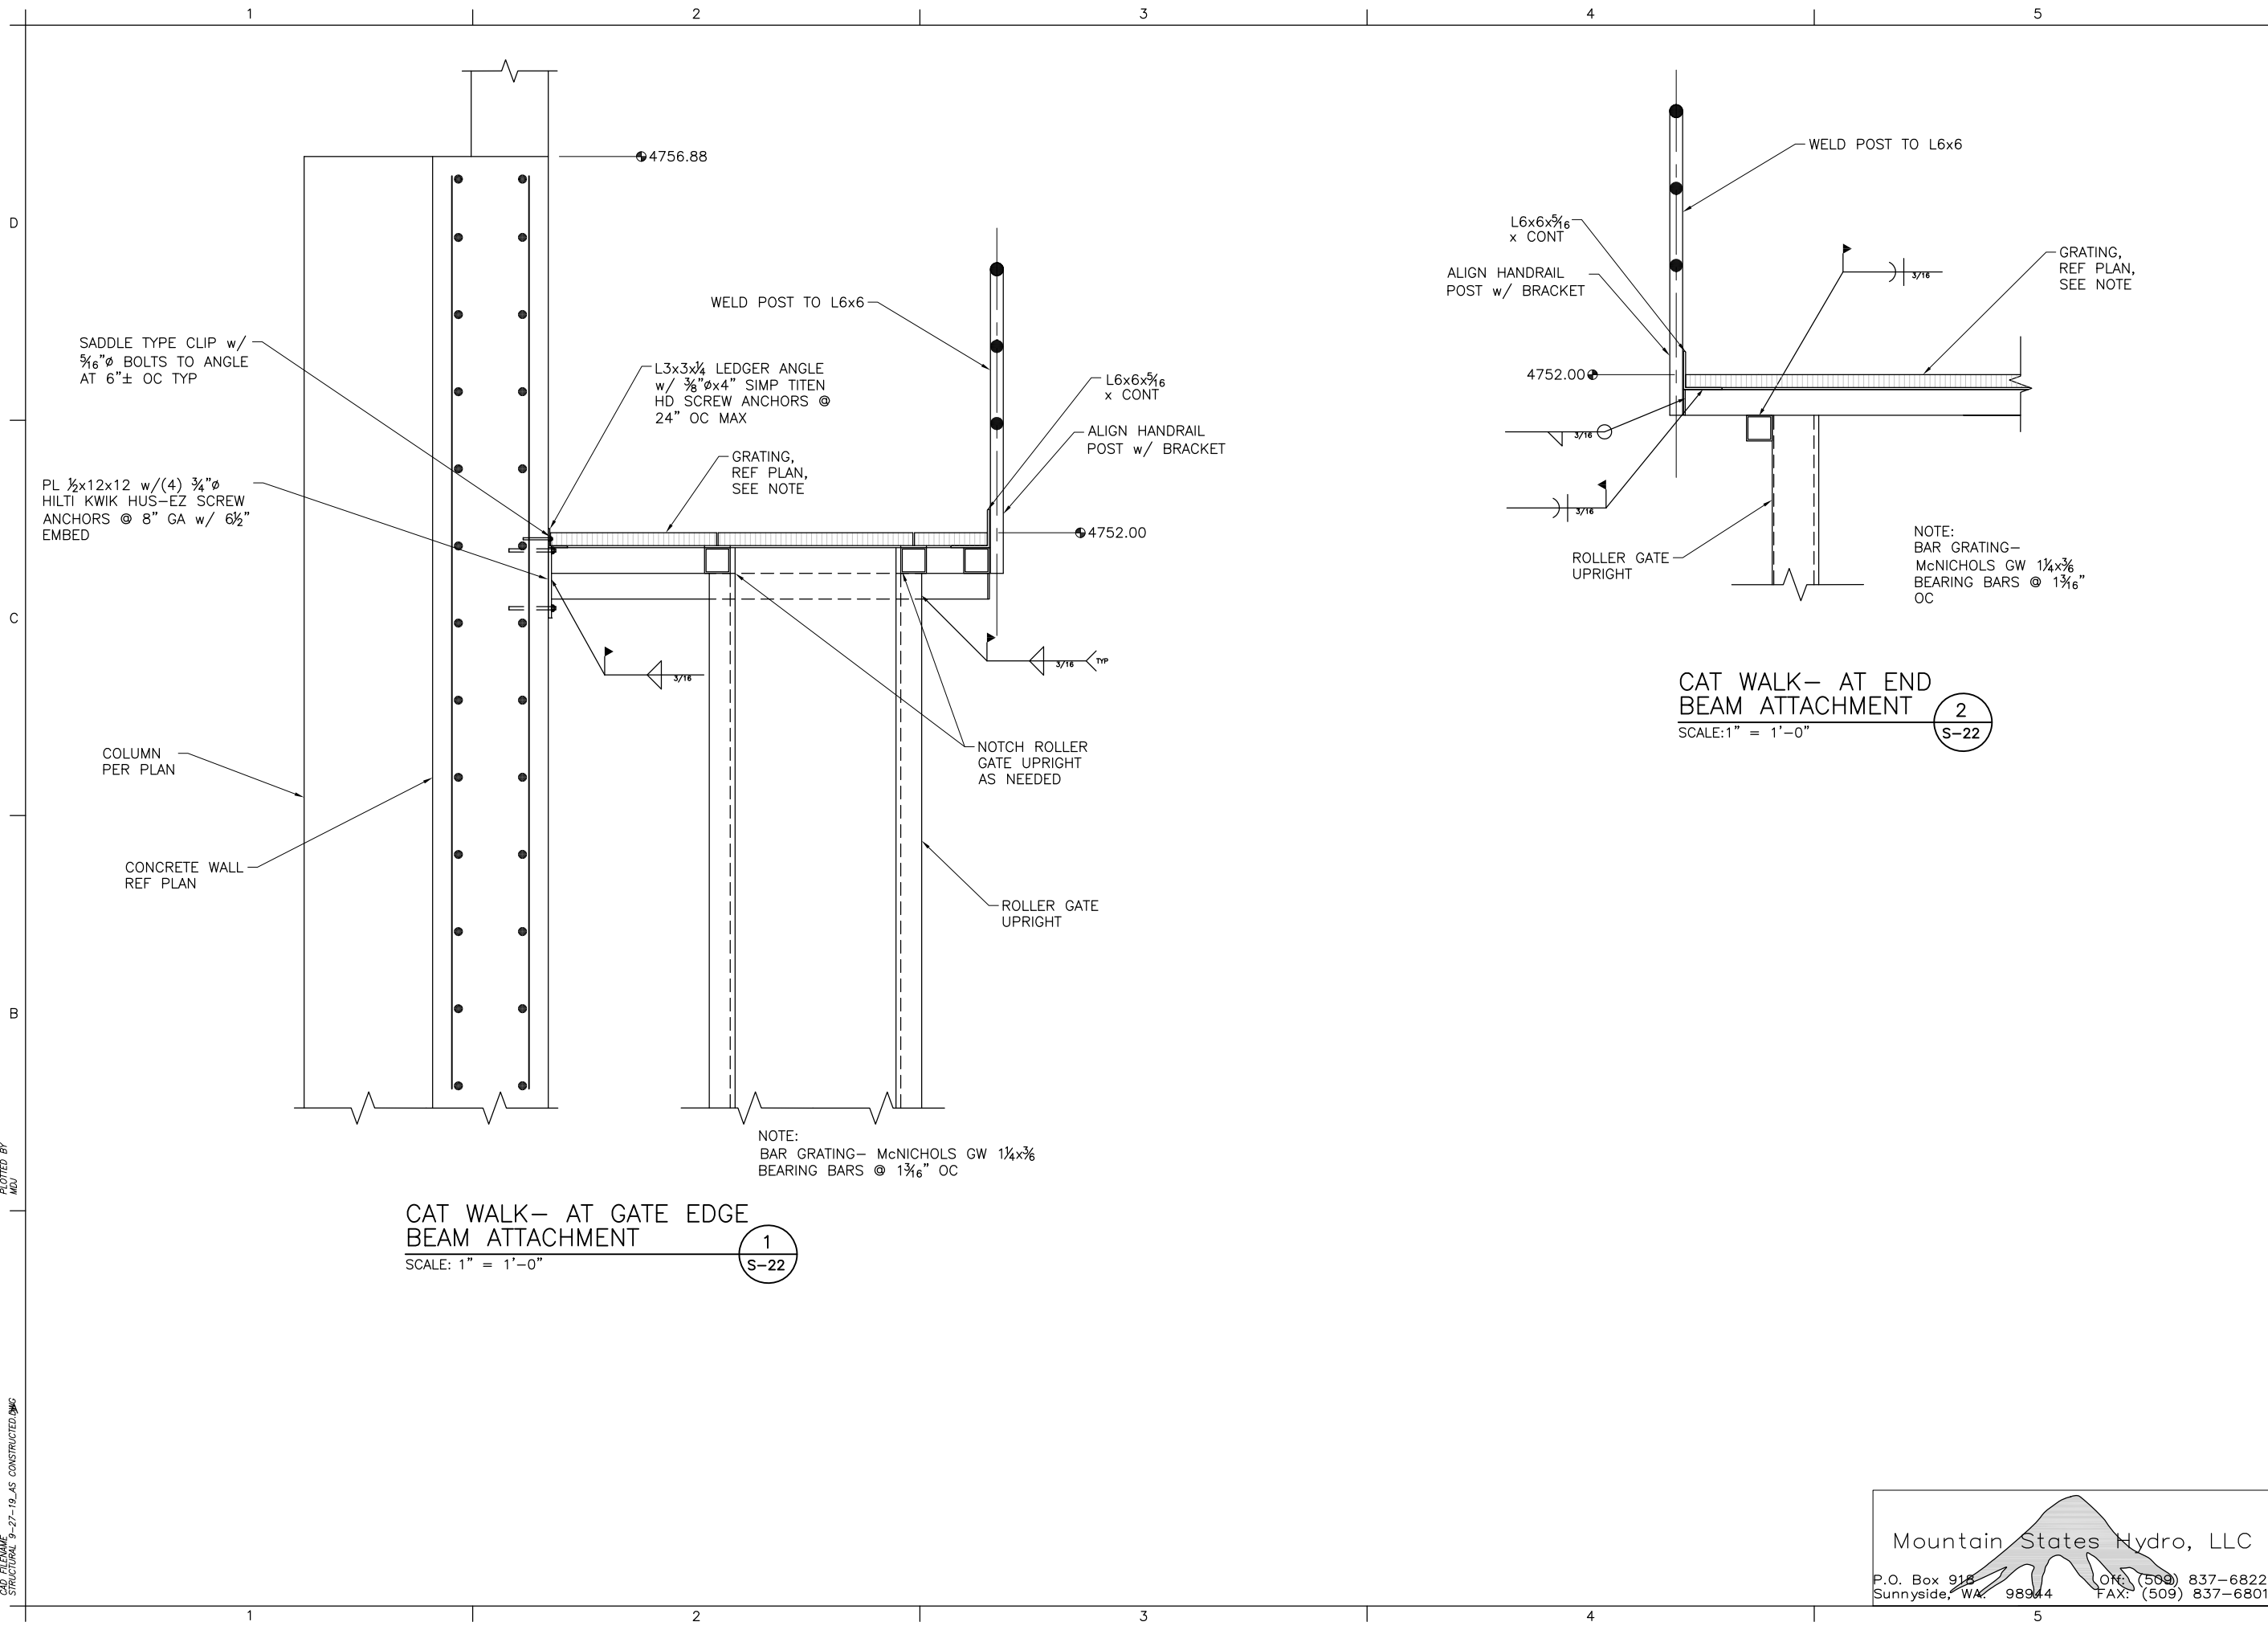

CAT WALK- AT GATE EDGE
BEAM ATTACHMENT
SCALE: 1" = 1'-0"

1
S-22

CAT WALK- AT END
BEAM ATTACHMENT
SCALE: 1" = 1'-0"

2
S-22

Mountain States Hydro, LLC

P.O. Box 918
Sunnyside, WA. 98944
Office: (509) 837-6822
Fax: (509) 837-6801

SORENSEN
ENGINEERING



ALWAYS THINK SAFETY

AS CONSTRUCTED 2019

POWERHOUSE STRUCTURAL-
MISC. POWERHOUSE DETAILS

SOUTHEASTERN COLORADO WATER
ACTIVITY ENTERPRISE
PUEBLO DAM HYDROELECTRIC PROJECT
POWERHOUSE STRUCTURAL-
MISC. POWERHOUSE DETAILS


S-22

REV NO
DATE
BY
NAME
DESCR

DRAWING NUMBER

DATE AND TIME PLOTTED
October 11, 2019 13:04
PLOT BY
MOJ

QAD SYSTEM
AUTOCAD
STRUCTURAL 9-27-19 AS CONSTRUCTED

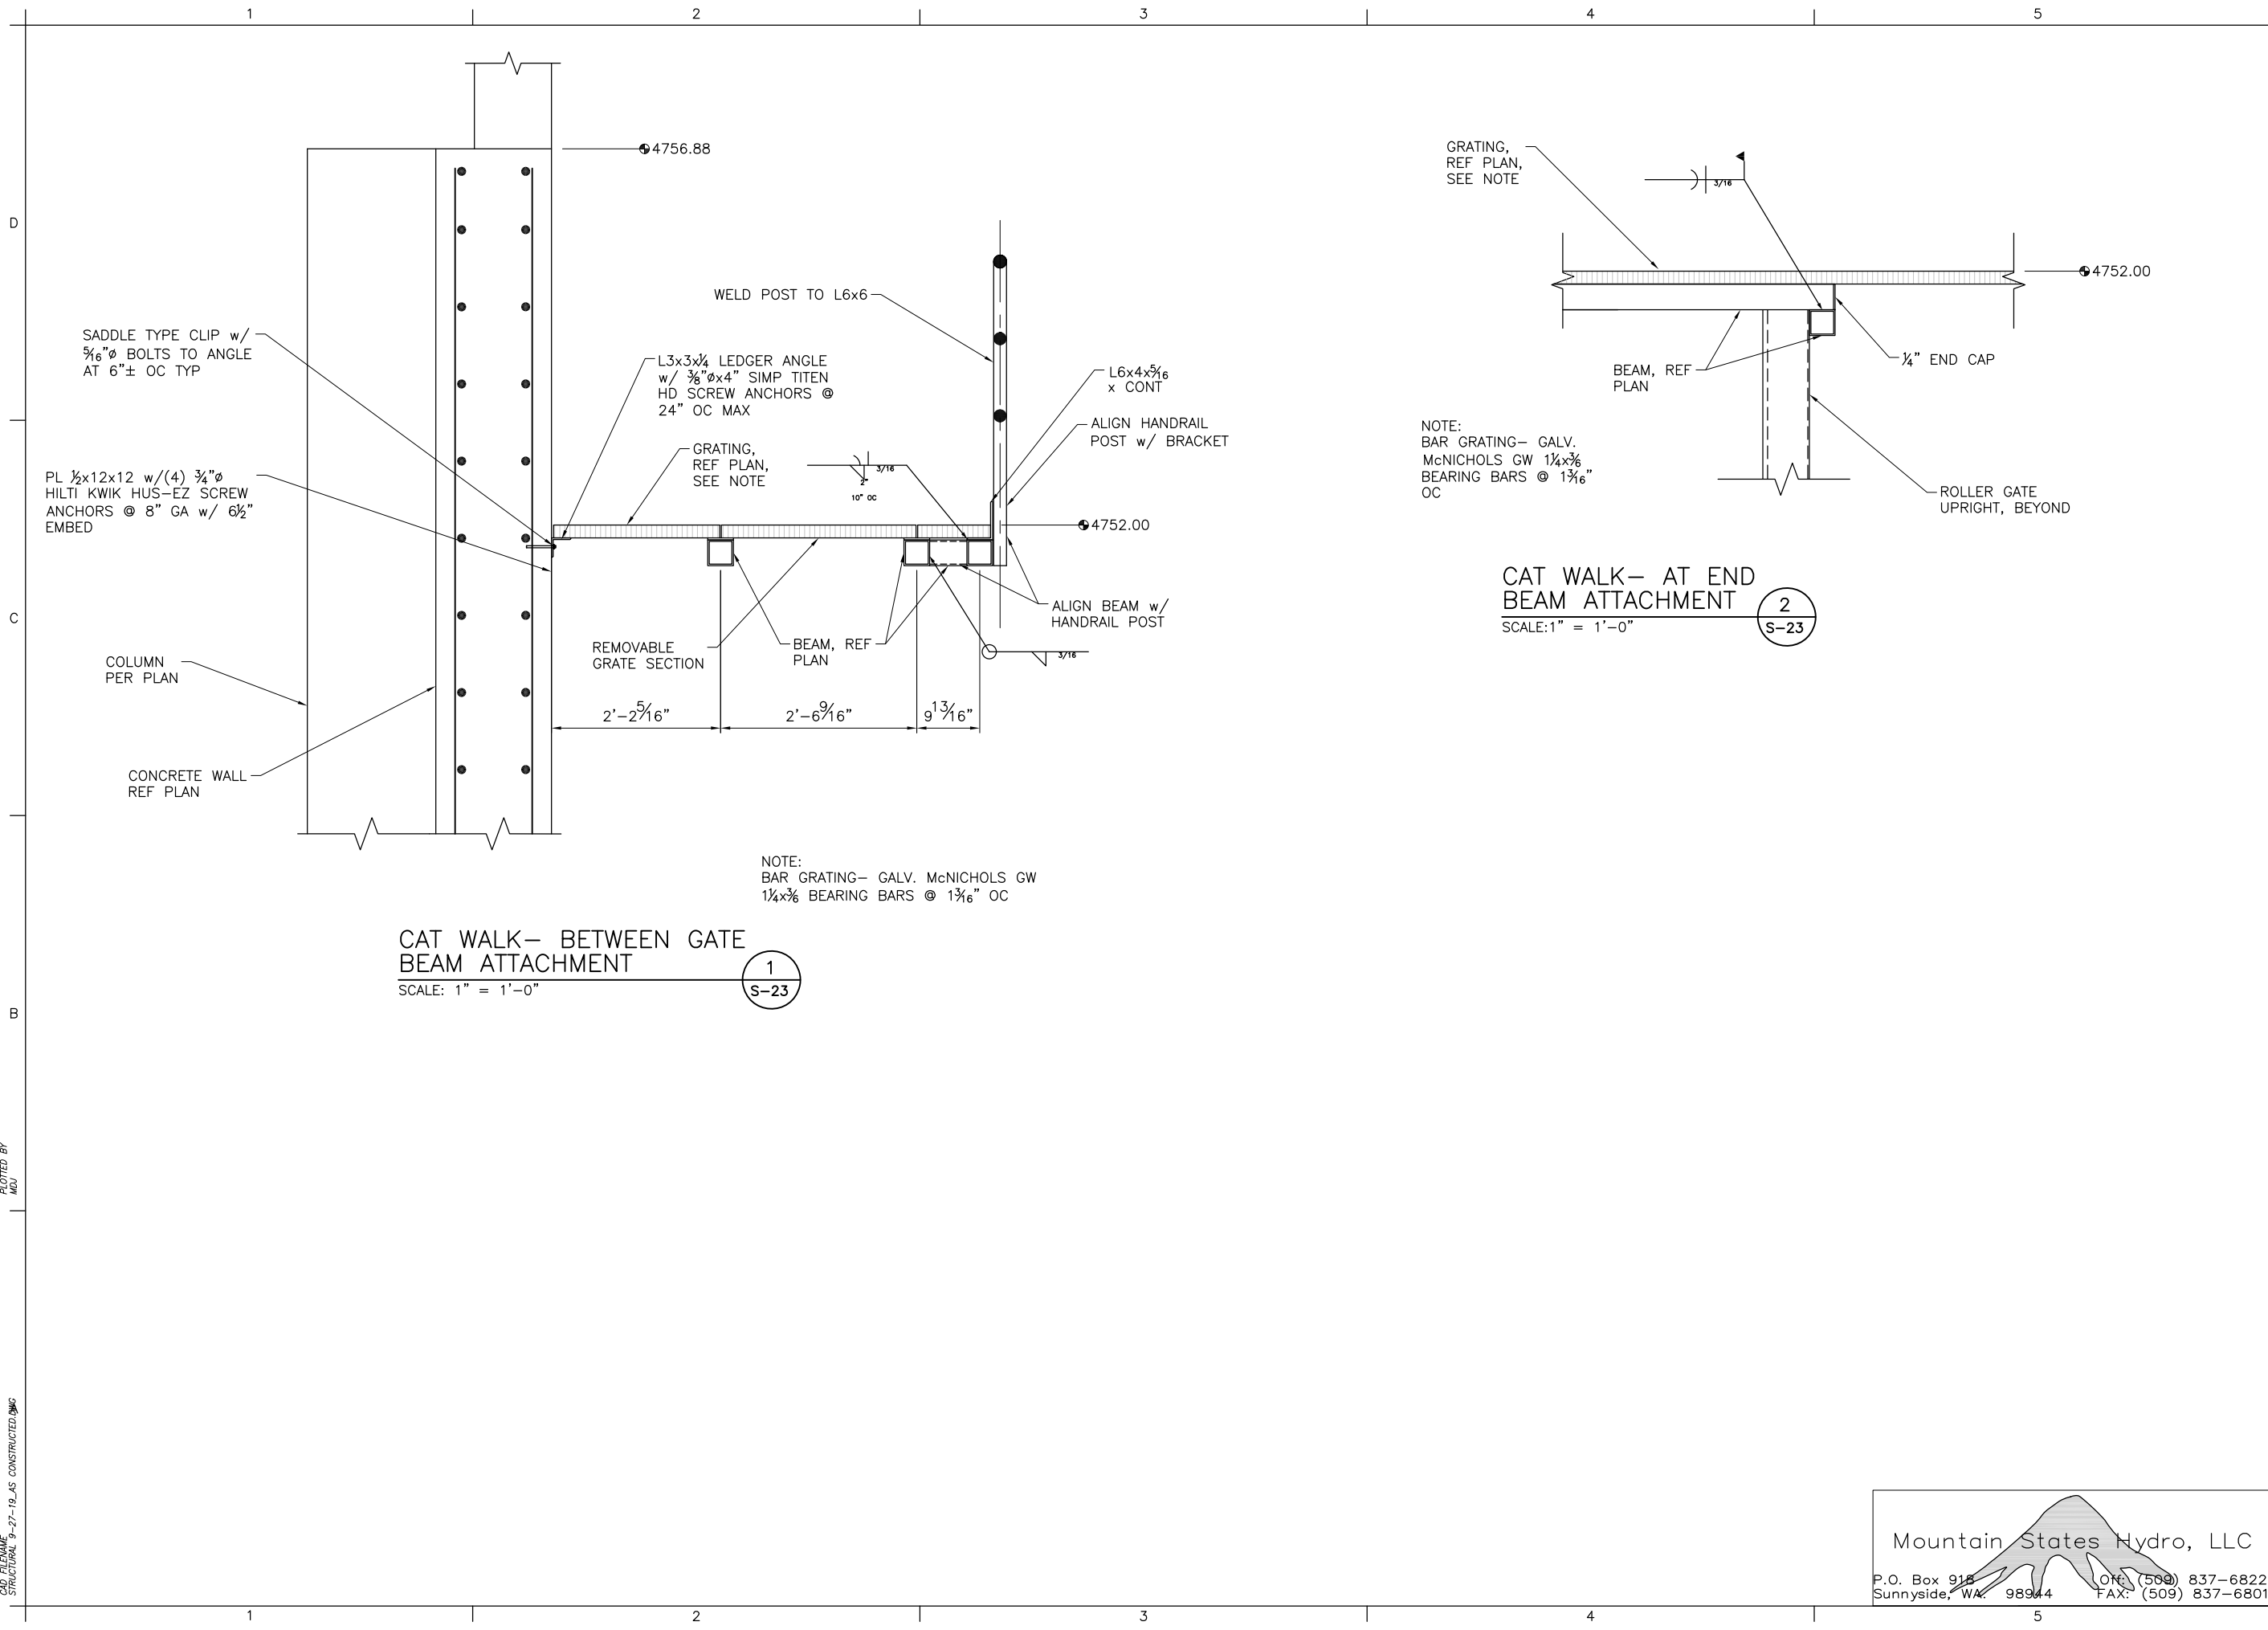

CAT WALK- BETWEEN GATE
BEAM ATTACHMENT

SCALE: 1" = 1'-0"

1
S-23

CAT WALK- AT END
BEAM ATTACHMENT

SCALE: 1" = 1'-0"

2
S-23


Mountain States Hydro, LLC

P.O. Box 918
Sunnyside, WA. 98944

Off: (509) 837-6822
Fax: (509) 837-6801

SORENSEN ENGINEERING	PROJECT	DRAWING NUMBER		D
ALWAYS THINK SAFETY	PROJECT	SOUTHEASTERN COLORADO WATER ACTIVITY ENTERPRISE PUEBLO DAM HYDROELECTRIC PROJECT POWERHOUSE STRUCTURAL - MISC. POWERHOUSE DETAILS		C
AS CONSTRUCTED 2019	DESCRIPTION	REV. NO. YYYY-MM-DD NAME, PROJ. ASSG.		B
POWERHOUSE STRUCTURAL - MISC. POWERHOUSE DETAILS	S-23			A


CONNECTION SCHEDULE			
BEAM SIZE	PLATE DIMENSIONS	# BOLTS	FILLET WELD SIZE
C8x, BC10x, W8x, W10x	$\frac{5}{16}$ "x4"x6"	(2) $\frac{3}{4}$ "Ø A325	$\frac{1}{4}$ " BOTH SIDES
W12x, W14x	$\frac{5}{16}$ "x4"x9"	(3) $\frac{3}{4}$ "Ø A325	$\frac{1}{4}$ " BOTH SIDES
W16x, W18x	$\frac{5}{16}$ "x4"x1'-0"	(4) $\frac{3}{4}$ "Ø A325	$\frac{1}{4}$ " BOTH SIDES
W21x	$\frac{3}{8}$ "x4"x1'-3"	(5) $\frac{3}{4}$ "Ø A325	$\frac{1}{4}$ " BOTH SIDES
W24x	$\frac{3}{8}$ "x4"x1'-6"	(6) $\frac{3}{4}$ "Ø A325	$\frac{1}{4}$ " BOTH SIDES

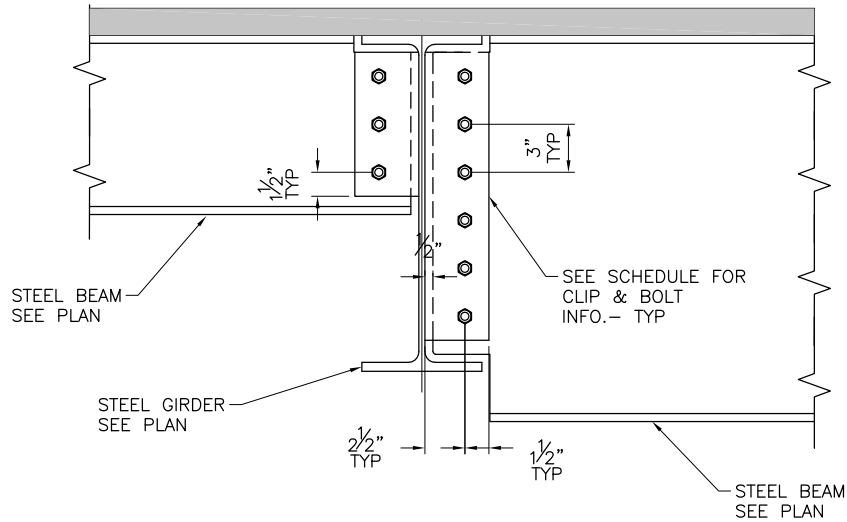

BEAM CONNECTION
SCHEDULE (TYP)

SCALE:1" = 1'-0"

1
S-24

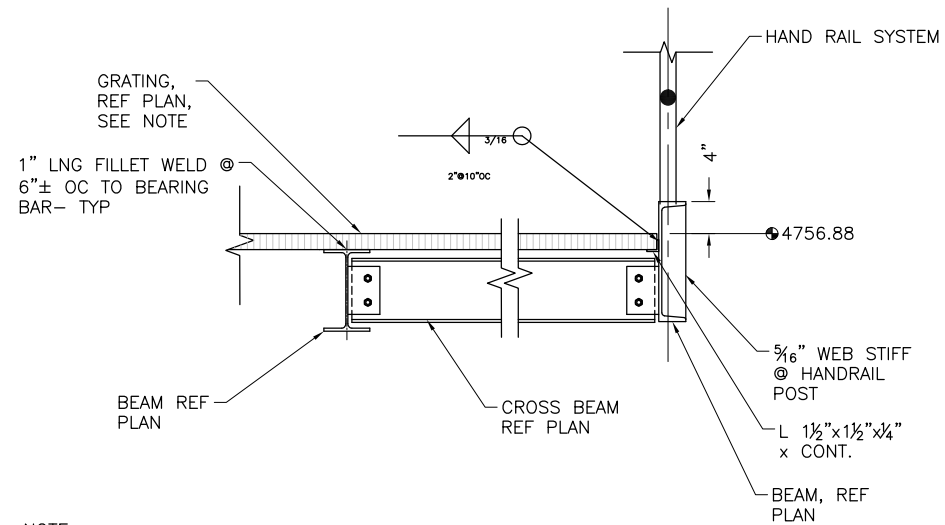


NOTE:
BAR GRATING- GALV.
McNICHOLS GW $\frac{1}{4}$ x $\frac{3}{8}$ "
BEARING BARS @ $1\frac{1}{8}$ "
OC

FLOOR EDGE CHANNEL
OVER TSV

SCALE:1/2" = 1'-0"

2
S-24

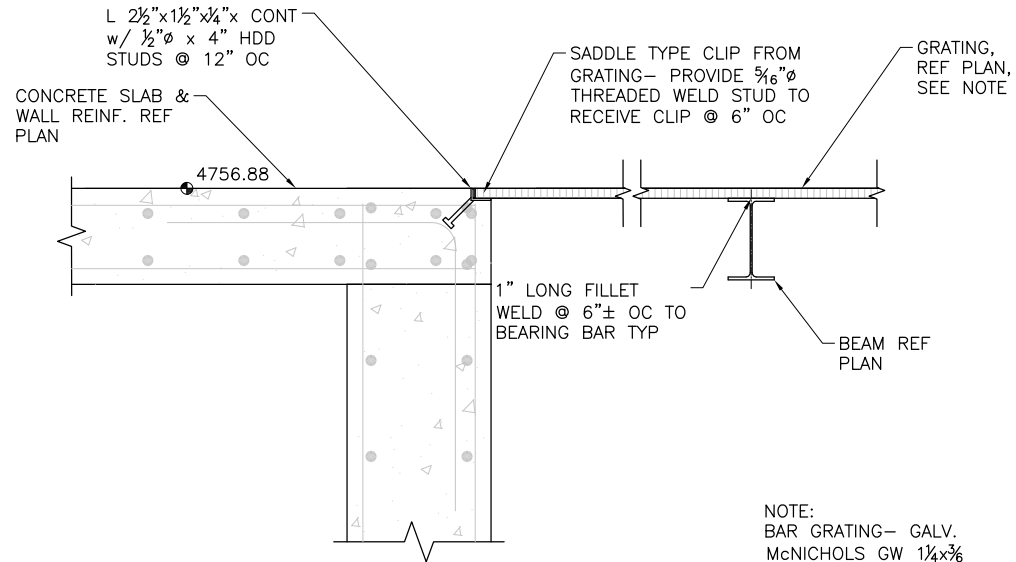

NOTE:
BAR GRATING- GALV.
McNICHOLS GW $\frac{1}{4}$ x $\frac{3}{8}$ "
BEARING BARS @ $1\frac{1}{8}$ "
OC

FLOOR EDGE TO CONCRETE
OVER TSV

SCALE:1/2" = 1'-0"

3
S-24

Mountain States Hydro, LLC

P.O. Box 918
Sunnyside, WA. 98944
Off: (509) 837-6822
Fax: (509) 837-6801



ALWAYS THINK SAFETY

PROJECT
SOUTHEASTERN COLORADO WATER
ACTIVITY ENTERPRISE
PUEBLO DAM HYDROELECTRIC PROJECT
POWERHOUSE STRUCTURAL -
MISC. POWERHOUSE DETAILS


AS CONSTRUCTED 2019

POWERHOUSE STRUCTURAL -
MISC. POWERHOUSE DETAILS

S-24

DATE AND TIME PLOTTED
October 11, 2019 12:25
PLOTTER
MOI


QAD SYSTEM
AUTOCAD
STRUCTURAL 9-27-19 AS CONSTRUCTED

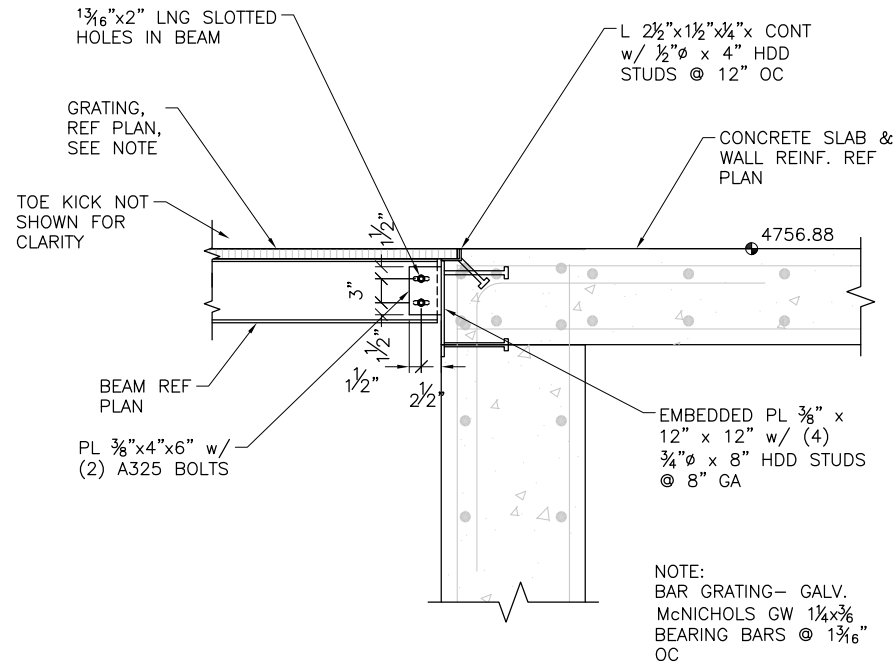

WF BEAM TO CONC. OVER TSV

SCALE: 1/2" = 1'-0"

1
S-25

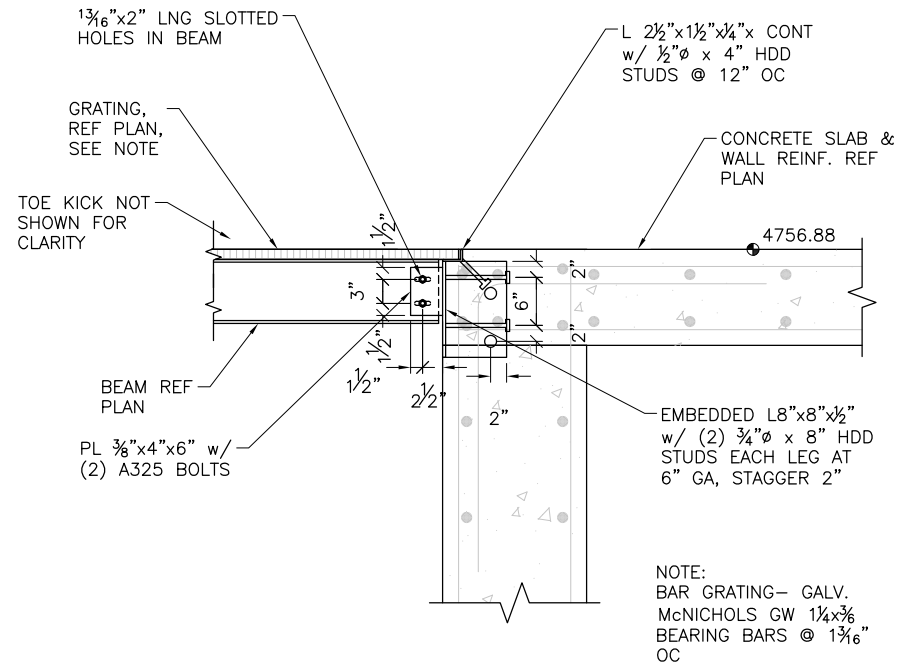

WF BEAM TO CONC. BEAM OVER TSV

SCALE: 1/2" = 1'-0"

2
S-25

Mountain States Hydro, LLC

P.O. Box 918
Sunnyside, WA. 98944
Off: (509) 837-6822
Fax: (509) 837-6801



ALWAYS THINK SAFETY

PROJECT
SOUTHEASTERN COLORADO WATER
ACTIVITY ENTERPRISE
PUEBLO DAM HYDROELECTRIC PROJECT
POWERHOUSE STRUCTURAL -
MISC. POWERHOUSE DETAILS

AS CONSTRUCTED 2019


REV NO YYYY-MM-DD
NAME, PROJ, ASSG.

POWERHOUSE STRUCTURAL -
MISC. POWERHOUSE DETAILS

S-25

DATE AND TIME PLOTTED:
September 27, 2019 17:15
PLOTTED BY:
MUI

QAD SYSTEM
AUTOCAD RELEASE
P-2016 9-27-19.DWG

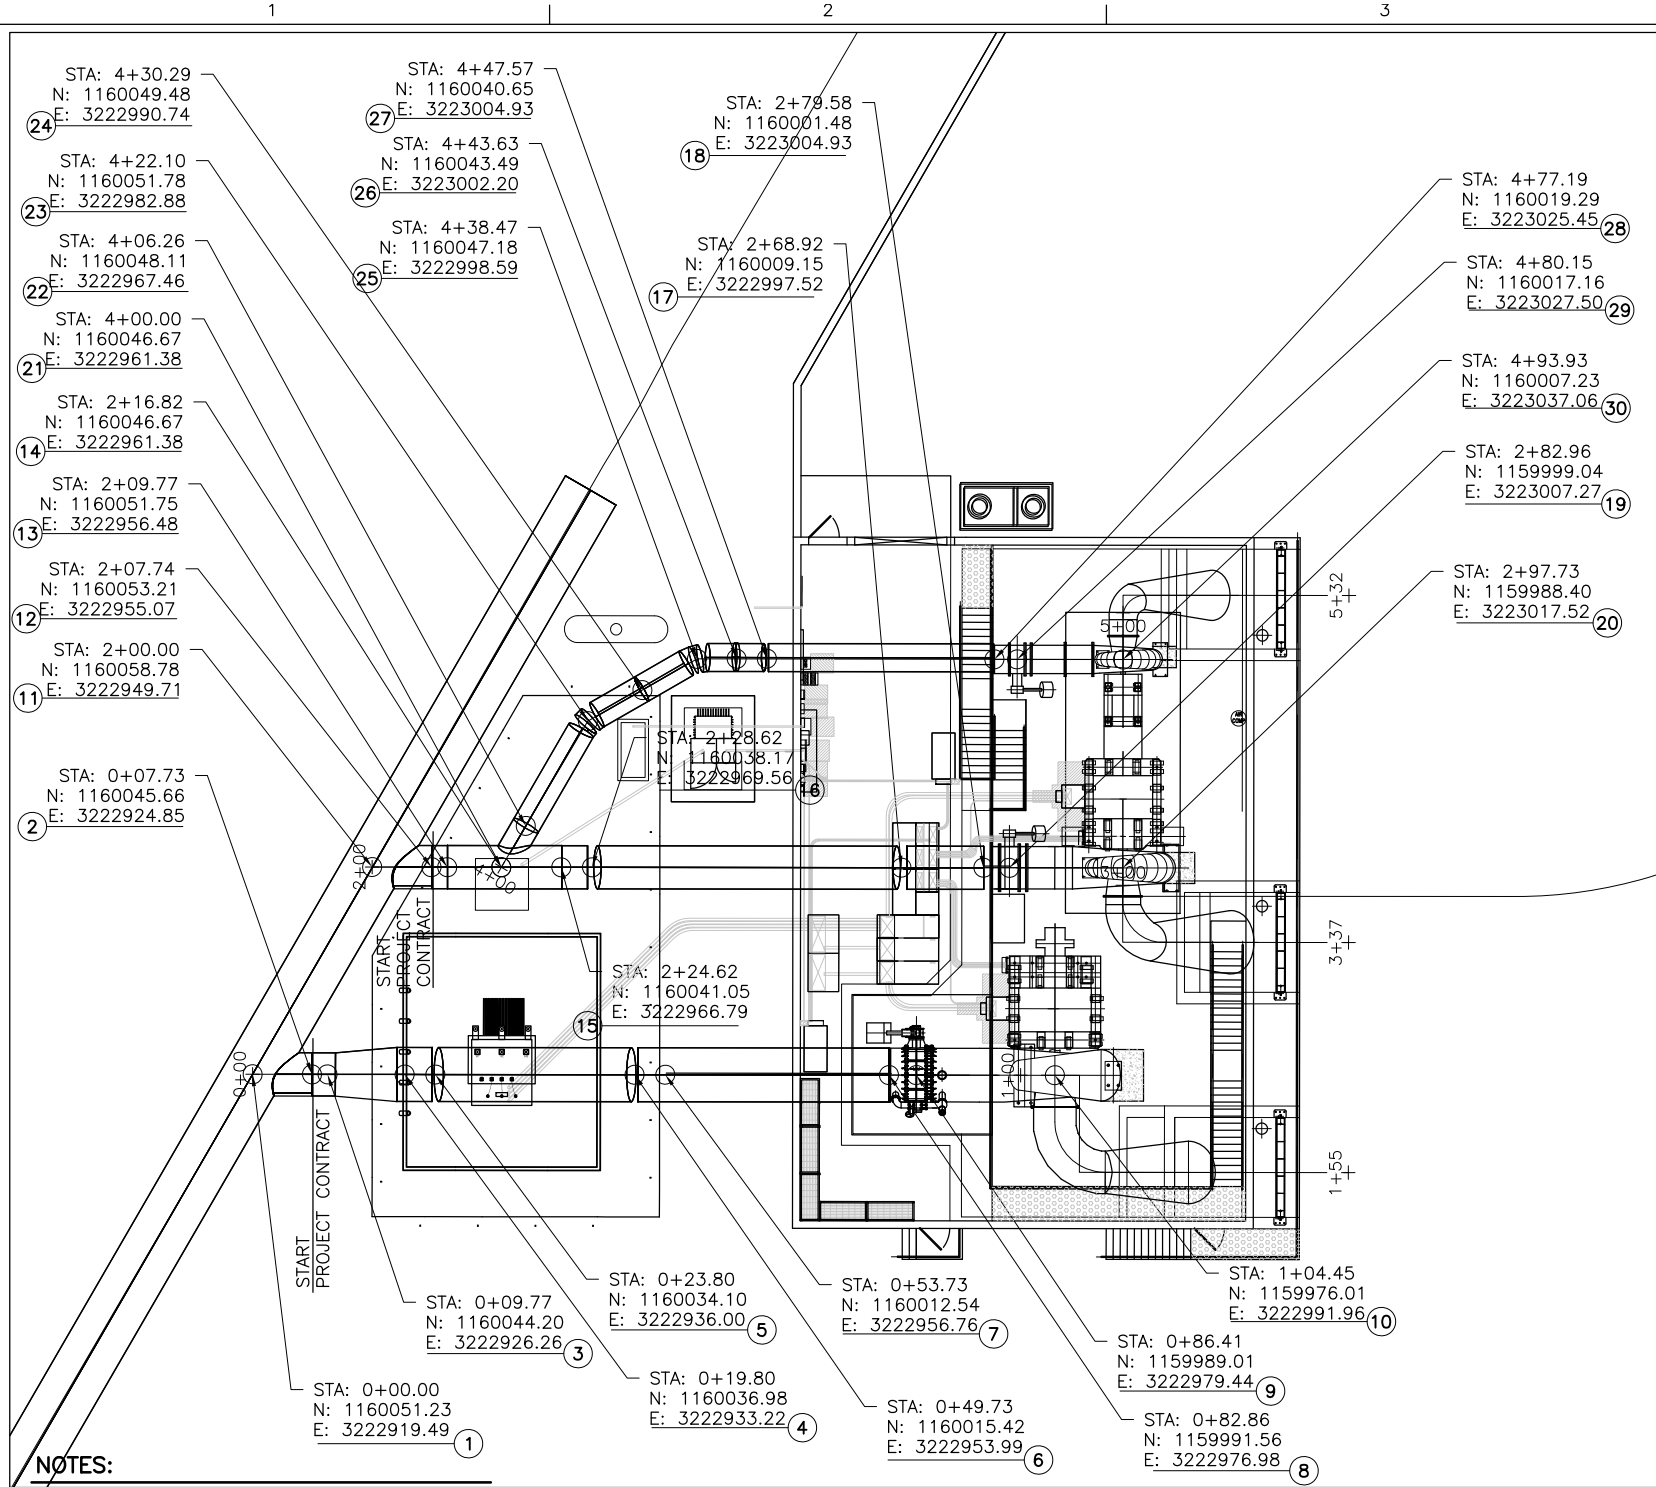

PENSTOCK DEFLECTION POINT TABLE				
84" ID PENSTOCK				
POINT #	STATION	CL EL. (FT)	HORIZ. ∠	VERT. ∠
1	0+00.00	4754.55	NA	NA
2	0+07.73	4754.55	0.00°	0.00°
3	0+09.77	4754.55	0.00°	0.00°
4	0+19.80	4753.84	0.00°	0.00°
5	0+23.80	4753.84	0.00°	0.00°
6	0+49.73	4749.27	0.00°	-10.00°
7	0+53.73	4749.27	0.00°	10.00°
8	0+82.86	4749.27	0.00°	0.00°
9	0+86.41	4749.27	0.00°	0.00°
10	1+04.45	4749.27	0.00°	0.00°
67" ID PENSTOCK				
11	2+00.00	4754.52	NA	NA
12	2+07.74	4754.52	0.00°	0.00°
13	2+09.77	4754.52	0.00°	0.00°
14	2+16.82	4754.52	0.00°	0.00°
15	2+24.62	4754.52	0.00°	0.00°
16	2+28.62	4754.52	0.00°	-10.00°
17	2+68.92	4747.42	0.00°	10.00°
18	2+79.58	4747.42	0.00°	0.00°
19	2+82.96	4747.42	0.00°	0.00°
20	2+97.73	4747.42	0.00°	0.00°
44" ID PENSTOCK				
21	4+00.00	4754.52	NA	NA
22	4+06.26	4753.42	0.00°	-10.00°
23	4+22.10	4750.63	0.00°	0.00°
24	4+30.29	4749.19	-28.15°	0.00°
25	4+38.47	4747.75	0.00°	0.00°
26	4+43.63	4746.83	-28.15°	0.00°
27	4+47.57	4746.14	0.00°	10.00°
28	4+77.19	4746.14	0.00°	0.00°
29	4+80.15	4746.14	0.00°	0.00°
30	4+93.93	4746.14	0.00°	0.00°

BIFURCATION & PENSTOCK
INSTALLATION PLAN

SCALE: 1" = 25'-0"

1
FD-1

1. MANUFACTURING AND TESTING REQUIREMENTS:
- A) ALL WELDING SHALL BE 100% PENETRATION WELDS. POCKETS AND RECESSED AREAS SHALL BE RE-WELDED AND GROUND FLUSH.
- B) THE FABRICATED STRUCTURAL STEEL BIFURCATION WYE SHALL BE FABRICATED AND TESTED IN ACCORDANCE WITH THE AMERICAN WATER WORKS (AWWA) STANDARD SPECIFICATION C200-80 AND MANUAL M11.
- C) NO EXTERIOR FINISH IS REQUIRED IN AREAS THAT ARE TO BE ENCASED IN CONCRETE. FIELD TOUCH UP IN AREAS WHERE FIELD WELDING HAS BEEN ACCOMPLISHED IN ACCORDANCE WITH THE PROJECT SPECIFICATIONS. SEE PENSTOCK DRAWINGS FOR REQ'D EXTERIOR (OD) PAINT LOCATIONS. WHERE REQ'D PAINT A MINIMUM 2 COATES OF CARBOGUARD 60 (8-10 MILLS DFT TOTAL)
- D) INTERIOR PAINTING SHALL BE A MINIMUM OF TWO COATES OF CARBOGUARD 61 FOR 8-10 MILS DFT TOTAL, SSPC-CP10, OR APPROVED EQUAL. INTERIOR SURFACES ARE TO BE SANDBLASTED TO A NEAR WHITE FINISH.
2. ALL WELDING ON THE BIFURCATION, WYES, PENSTOCK, AND MANIFOLD PIPING, BOTH SHOP AND FIELD, SHALL BE ACCOMPLISHED BY AWS QUALIFIED WELDERS. SUBMIT WELDER CERTIFICATIONS AND PRE-QUALIFICATION OF WELDS TO THE ENGINEER PRIOR TO FABRICATION.
3. THE PENSTOCK BIFURCATION ASSEMBLY SHALL BE MANUFACTURED FROM ASTM A36 STEEL PLATE AND PIPE SECTIONS. THE OPTION FOR SUBSTITUTION WITH HIGHER STRENGTH STEEL AS IDENTIFIED IN AWWA C200 WILL NOT BE ALLOWED FOR THE FABRICATION OF THE PENSTOCK BIFURCATION ASSEMBLY.
4. MIL CERTIFICATION FOR THE MATERIALS USED TO FABRICATE THE BIFURCATION WYE SHALL BE PROVIDED TO THE ENGINEER PRIOR TO THE COMMENCEMENT OF FABRICATION. ALL CERTIFICATION SHALL BE IN ACCORDANCE WITH THE AISC MANUAL OF STEEL CONSTRUCTION, LATEST EDITION AND ASTM A6.
5. AFTER THE BIFURCATION ASSEMBLY HAS BEEN COMPLETED AND HYDROSTATIC TESTING OF THE COMPLETED ASSEMBLY UP TO 225 PSI, WELDING ON THE ASSEMBLY WILL NOT BE ALLOWED WITHOUT A COMPLETE RE-TEST IN ACCORDANCE WITH THE PROJECT SPECIFICATIONS AND THE AFOREMENTIONED HYDROSTATIC TEST.
6. HOLD PAINT BACK 2" FROM FIELD JOINTS. COAT SURFACES IN HOLD BACK AREAS W/WELDABLE PRIMER.

Mountain States Hydro, LLC

P.O. Box 918
Sunnyside, WA. 98944
OFF: (509) 837-6822
FAX: (509) 837-6801



ALWAYS THINK SAFETY



SOUTHEASTERN COLORADO WATER
ACTIVITY ENTERPRISE
PUEBLO DAM HYDROELECTRIC PROJECT
FABRICATIONS & PENSTOCKS
GENERAL INSTALLATION PLAN

AS CONSTRUCTED 2019

FABRICATED DETAILS-
BIFURCATIONS & PENSTOCKS
GENERAL INSTALLATION PLAN

FD-1

DATE AND TIME PLOTTED: September 27, 2019 17:14
PLOTTED BY: MDJ
CADD SYSTEM: AutoCAD
CADD FILENAME: FD-PENSTOCK 9-27-19.DWG

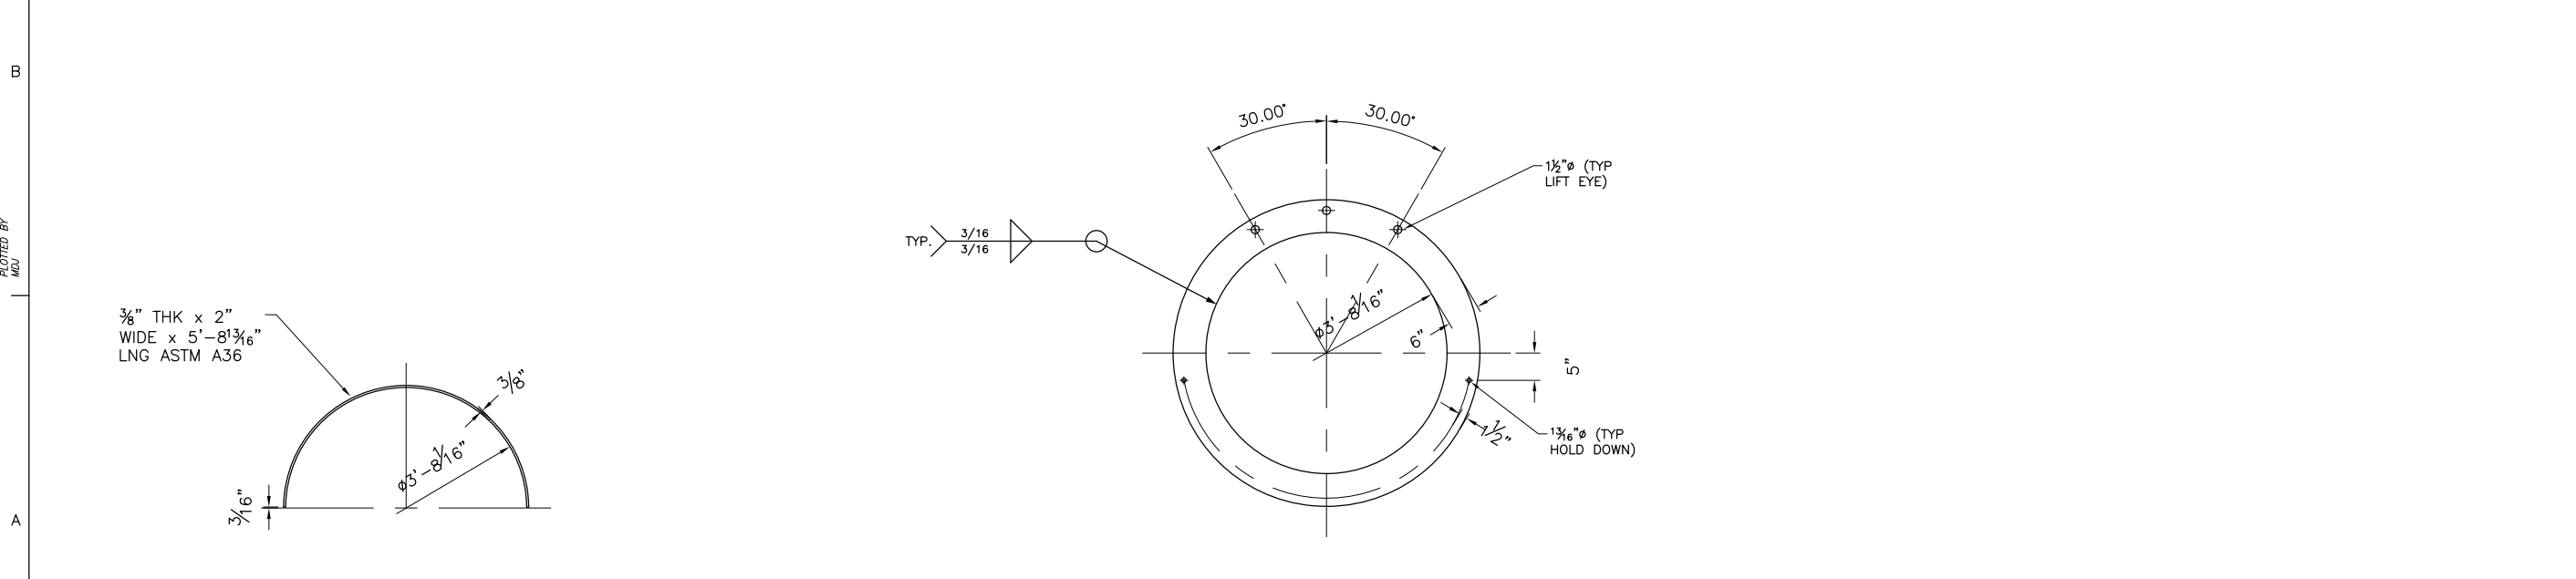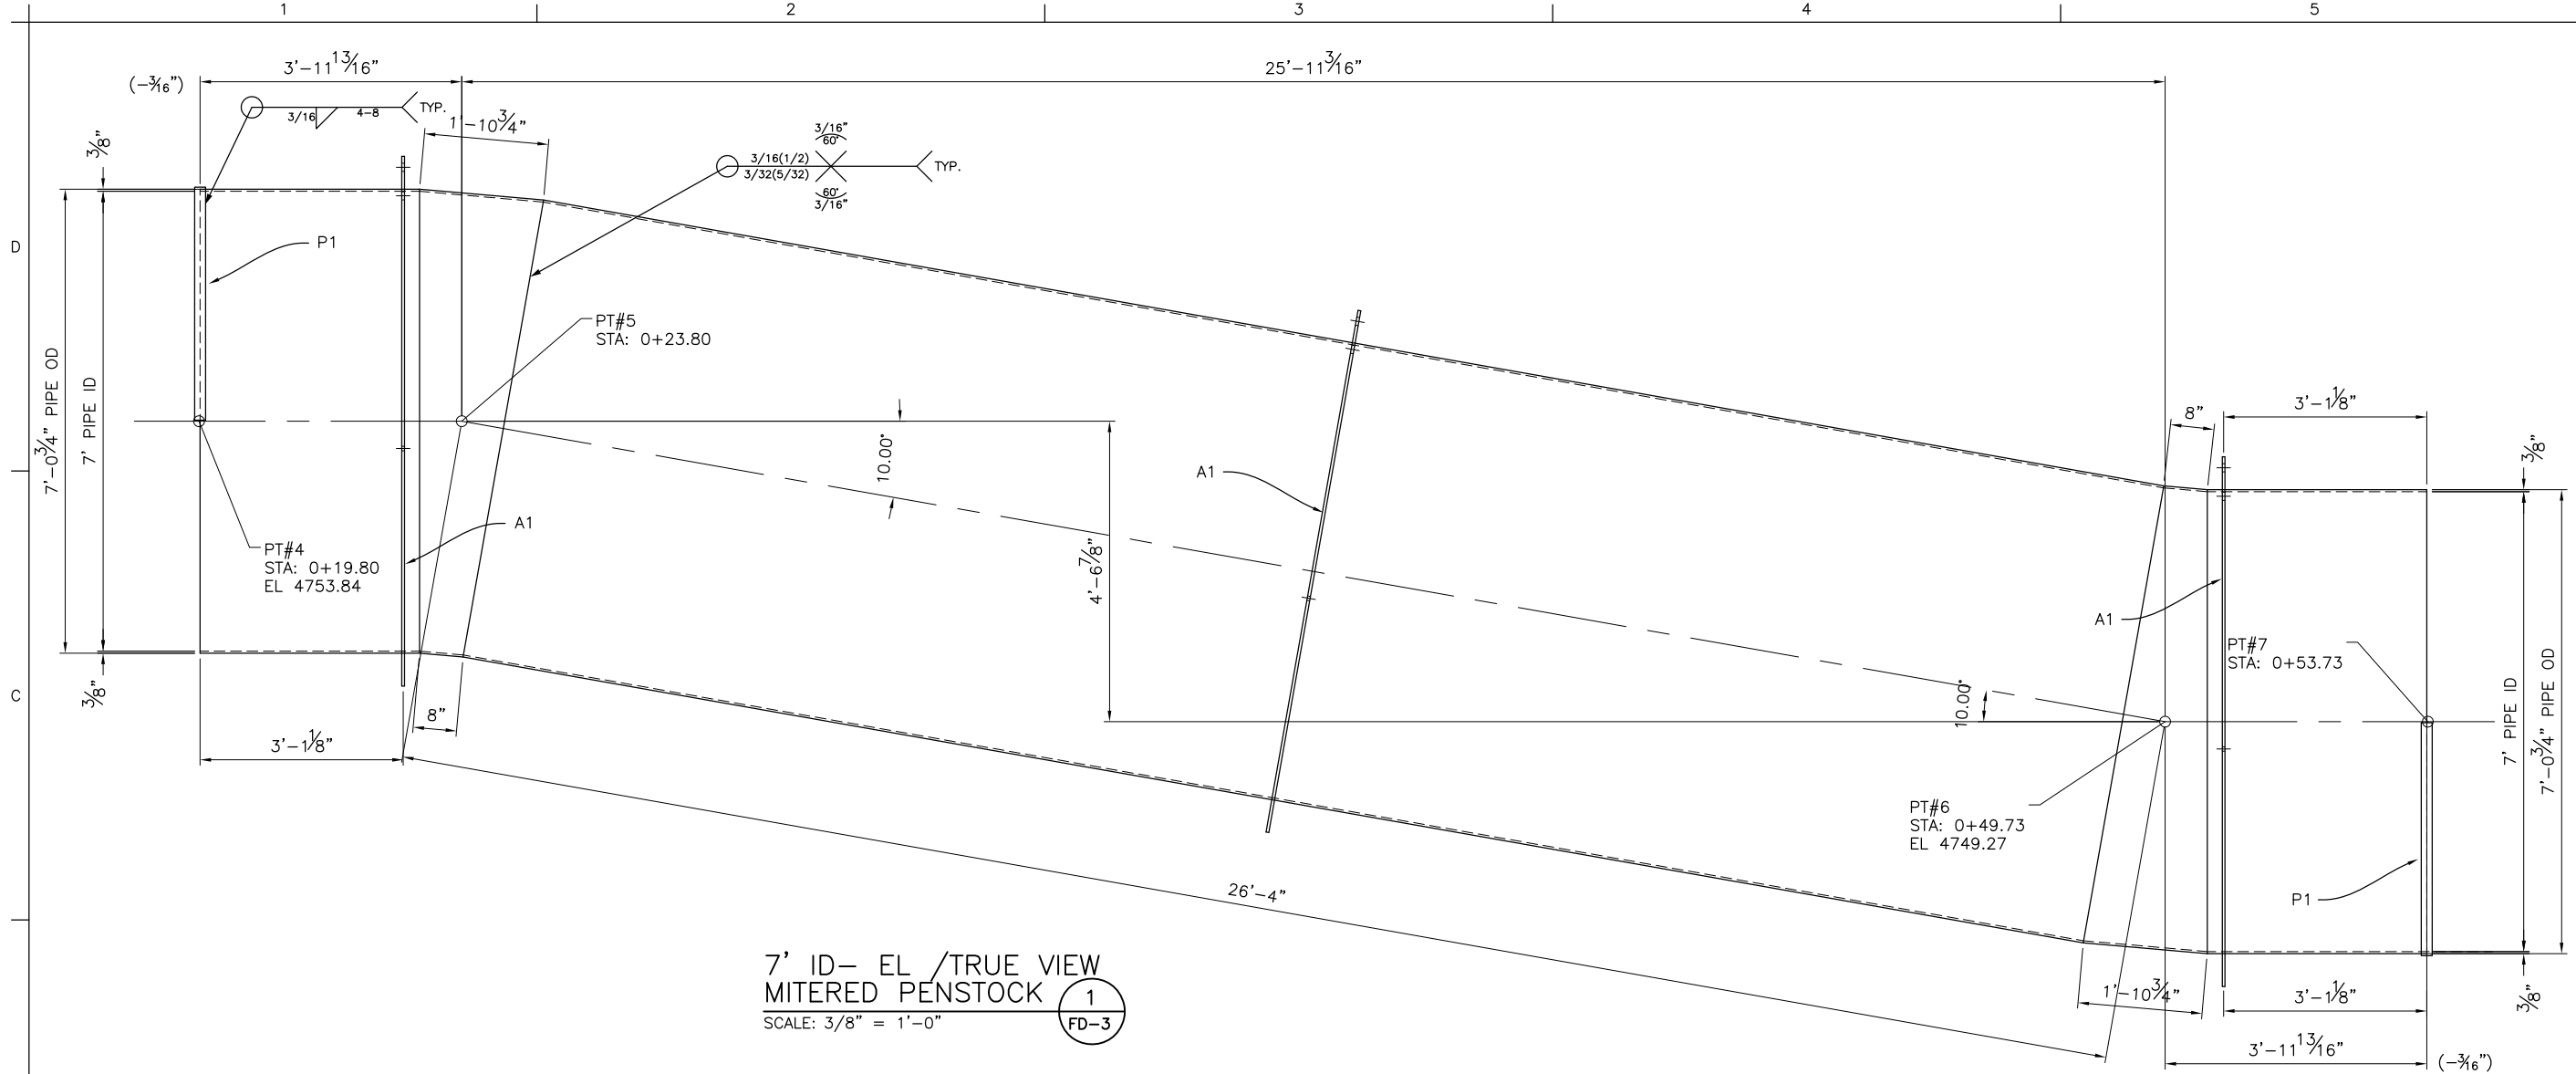

STEEL 3/8" RING BACKING
PLATE DETAIL P5
SCALE: 3/8" = 1'-0"


STEEL 1/2" RING STIFFENER
SECTION DETAIL A5
SCALE: 3/8" = 1'-0"

Mountain States Hydro, LLC
P.O. Box 918
Sunnyside, WA. 98944
OFF: (509) 837-6822
FAX: (509) 837-6801


	PROJECT	DRAWING NUMBER
ALWAYS THINK SAFETY	PROJECT	SOUTHEASTERN COLORADO WATER ACTIVITY ENTERPRISE PUEBLO DAM HYDROELECTRIC PROJECT FABRICATED DETAILS- PENSTOCK MISC. DETAILS
		AS CONSTRUCTED 2019
REV. NO. 1		DESCRIPTION
NAME, DATE, APPR.		
FABRICATED DETAILS- PENSTOCK MISC. DETAILS		
FD-3		

DATE AND TIME PLOTTED
September 27, 2019 17:14
DRAWN BY
MDO


CAD SYSTEM
AUTOCAD
PLOT FILENAME
FD-PENSTOCK 9-27-19.DWG

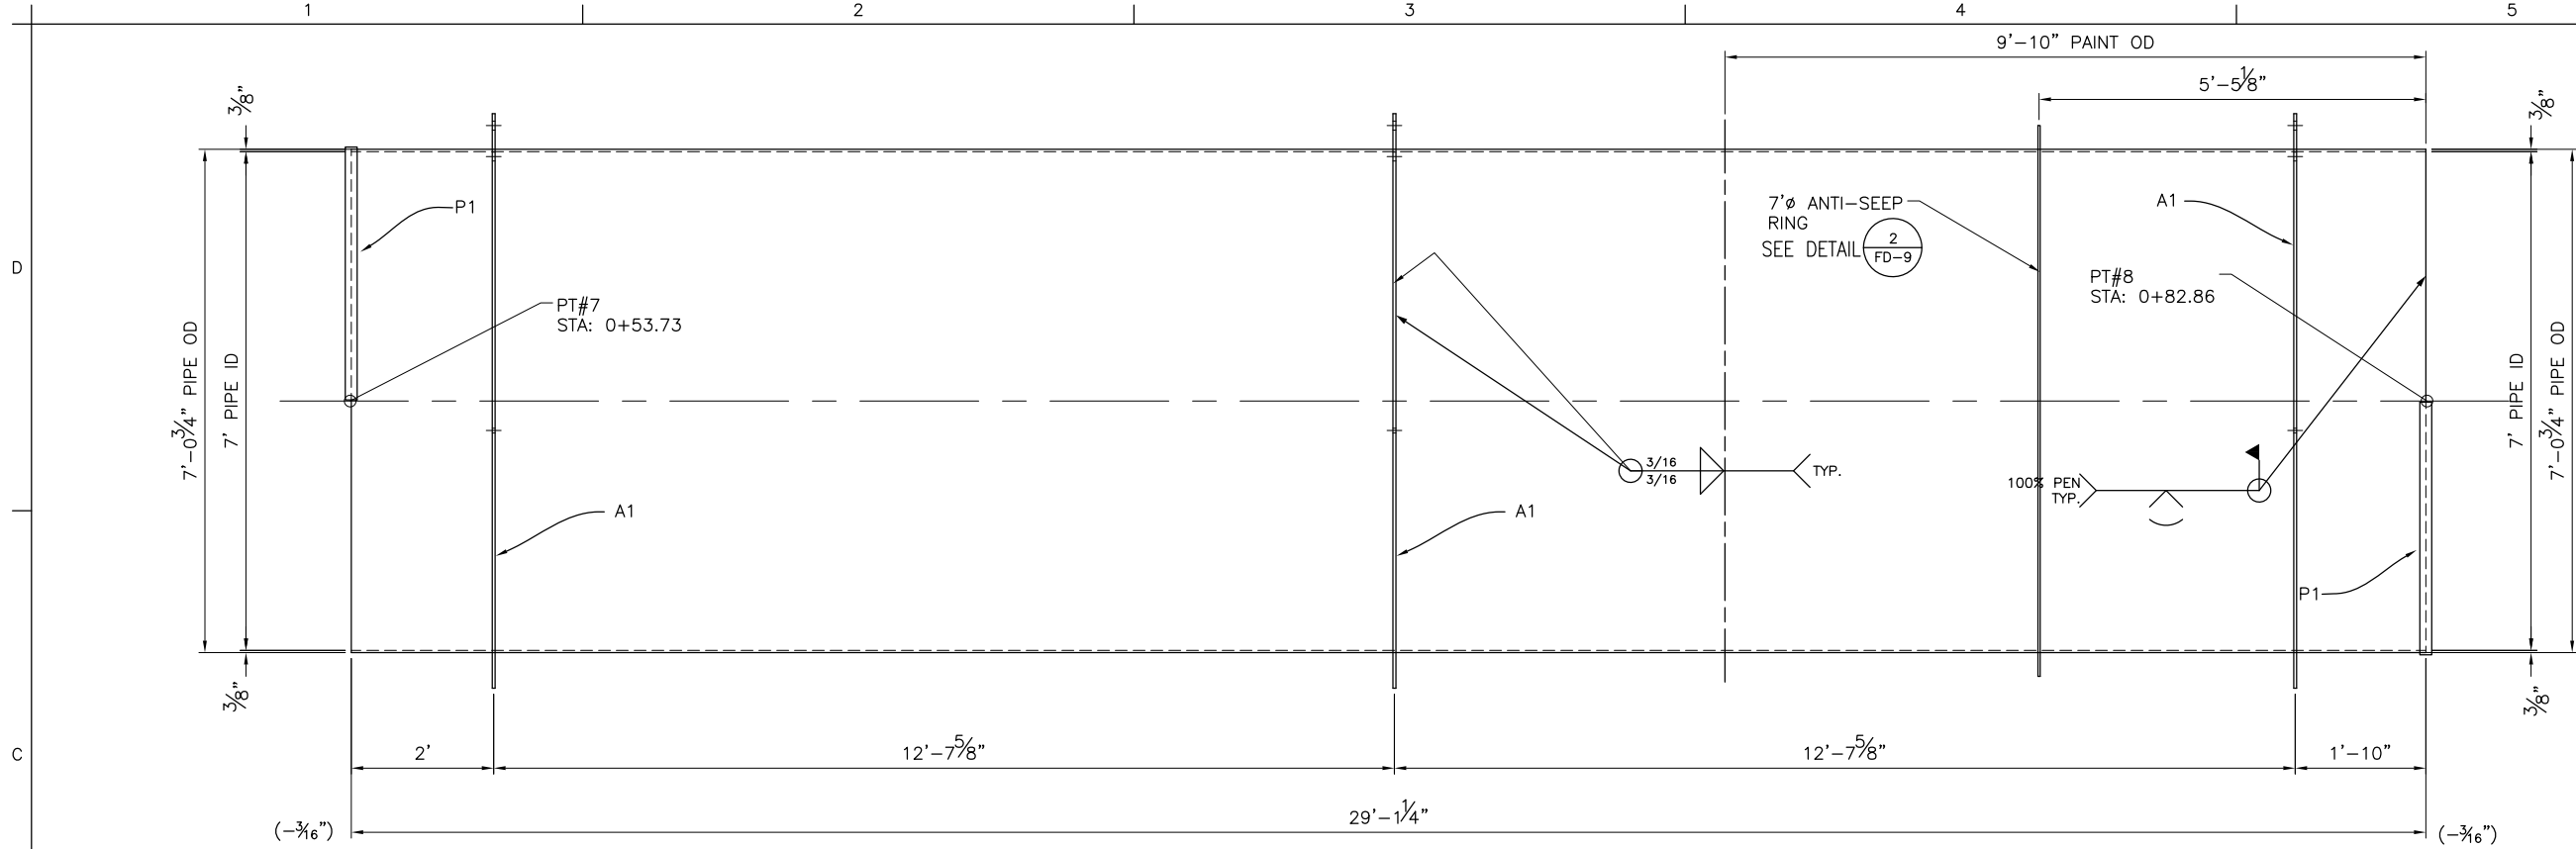


7' ID- EL/TRUE VIEW
PENSTOCK
SCALE: 3/8" = 1'-0"
1
FD-4

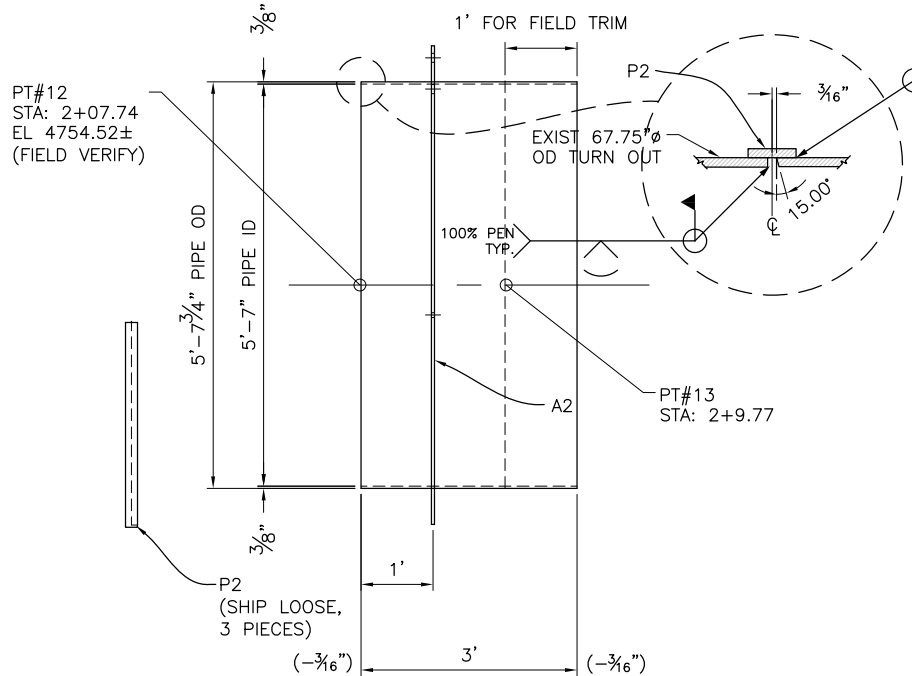

5'-7" ID
PENSTOCK
SCALE: 3/8" = 1'-0"
2
FD-4

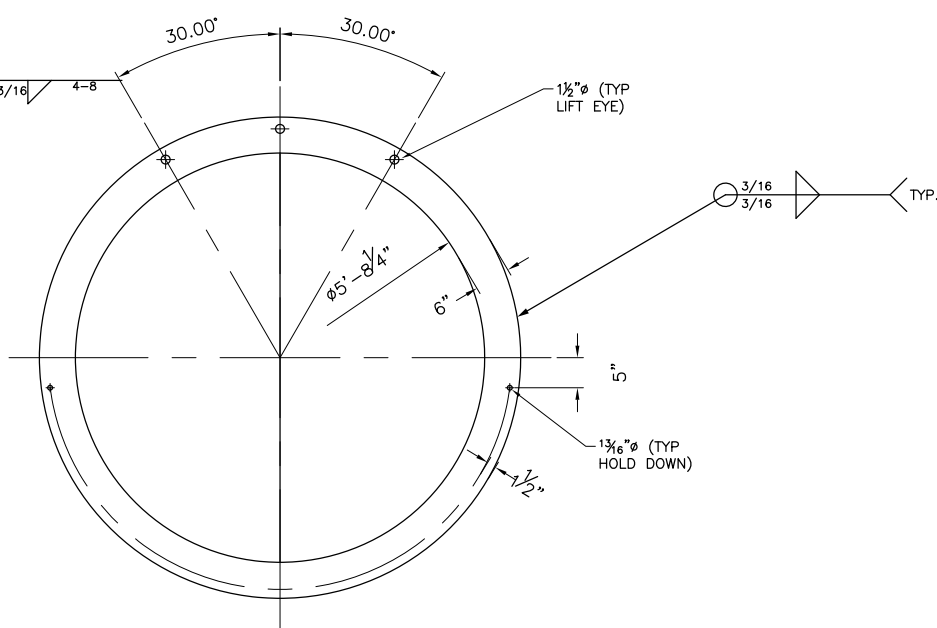

STEEL 1/2" RING STIFFENER
SECTION DETAIL A3
SCALE: 3/8" = 1'-0"
3
FD-4

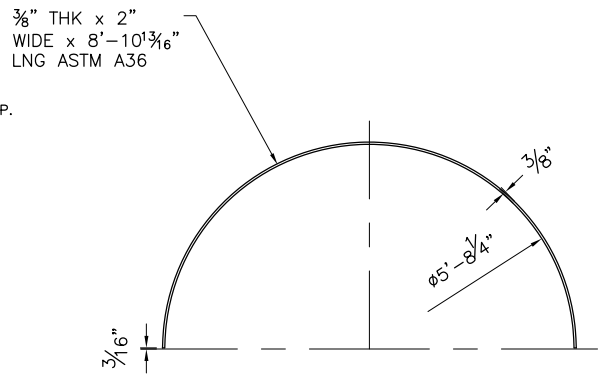

STEEL 3/8" RING BACKING
PLATE DETAIL P3
SCALE: 3/8" = 1'-0"
4
FD-4

Mountain States Hydro, LLC
P.O. Box 918
Sunnyside, WA 98944
OFF: (509) 837-6822
FAX: (509) 837-6801





ALWAYS THINK SAFETY

PROJECT
SOUTHEASTERN COLORADO WATER
ACTIVITY ENTERPRISE
PUEBLO DAM HYDROELECTRIC PROJECT
FABRICATED DETAILS-
PENSTOCK MISC. DETAILS

AS CONSTRUCTED 2019

FABRICATED DETAILS-
PENSTOCK MISC. DETAILS


FD-4

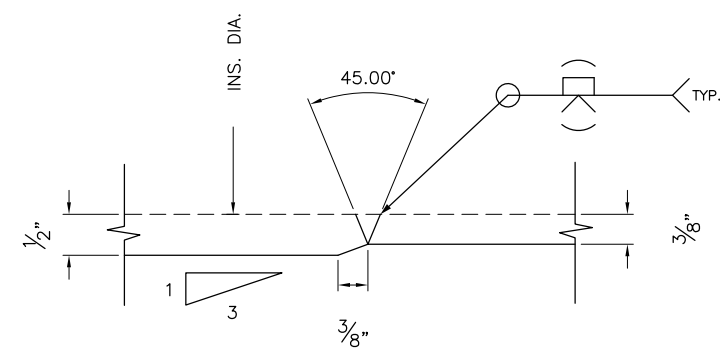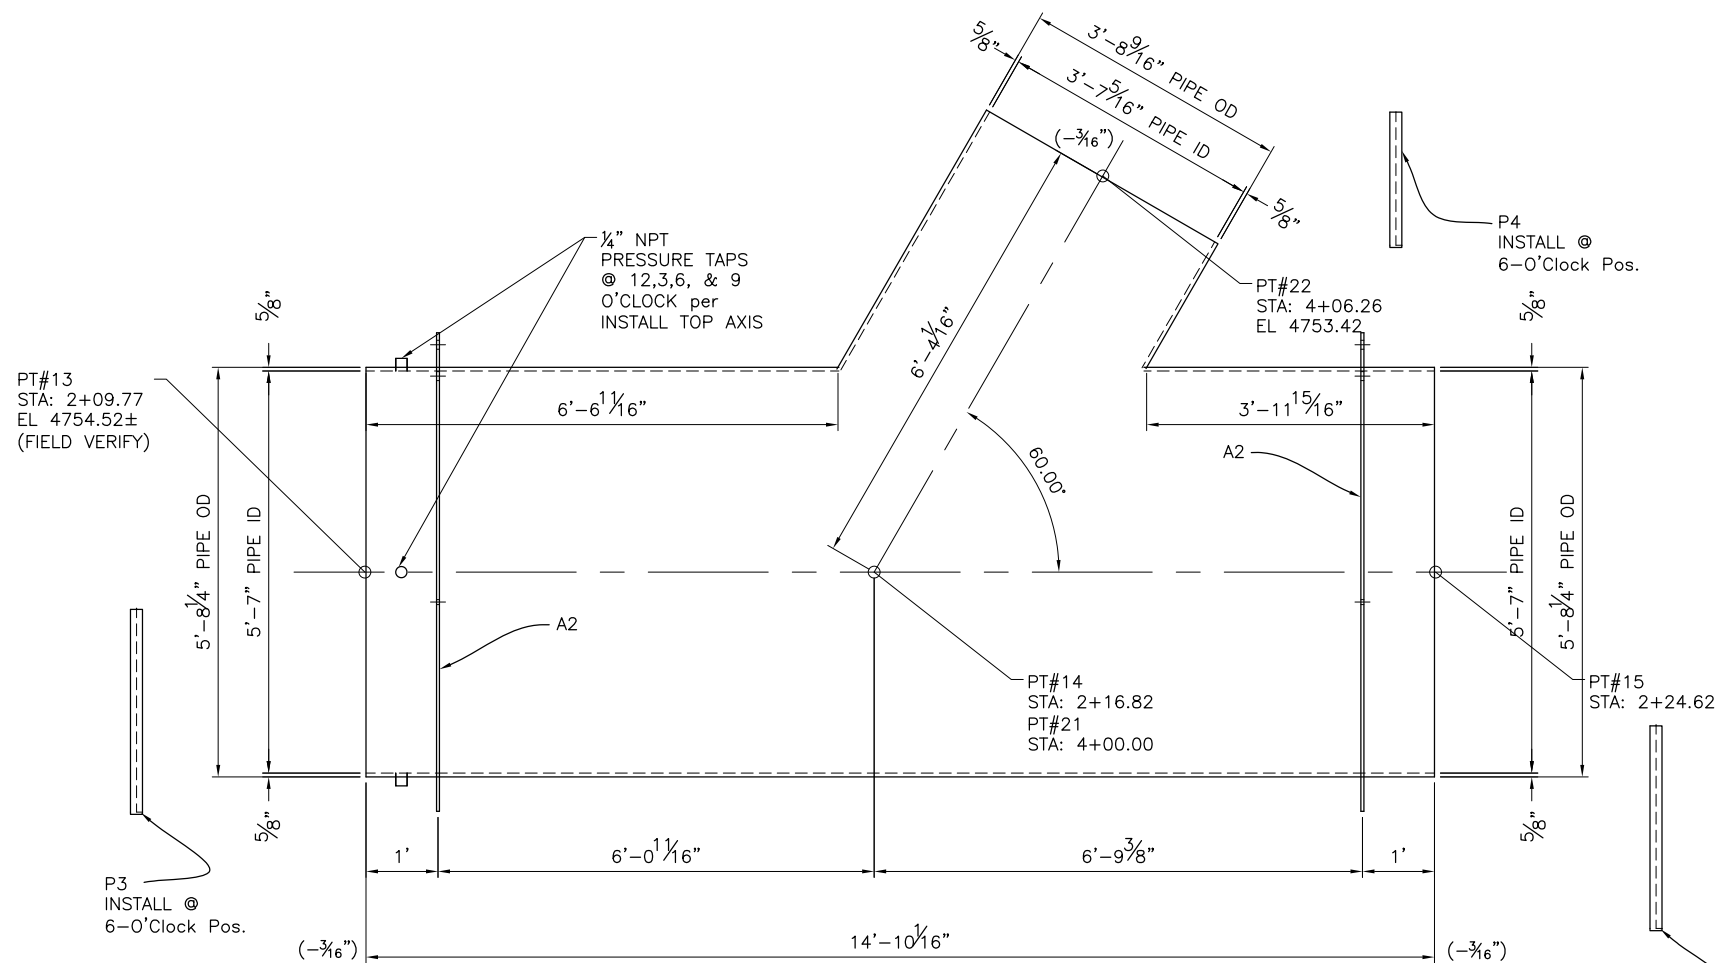

5/8" TO 3/8" TRANSITION
SECTION DETAIL

SCALE: 3/8" = 1'-0"


5'-7" ID x 3'-8" ID
BIFURCATION- TRUE VIEW
SCALE: 3/8" = 1'-0"

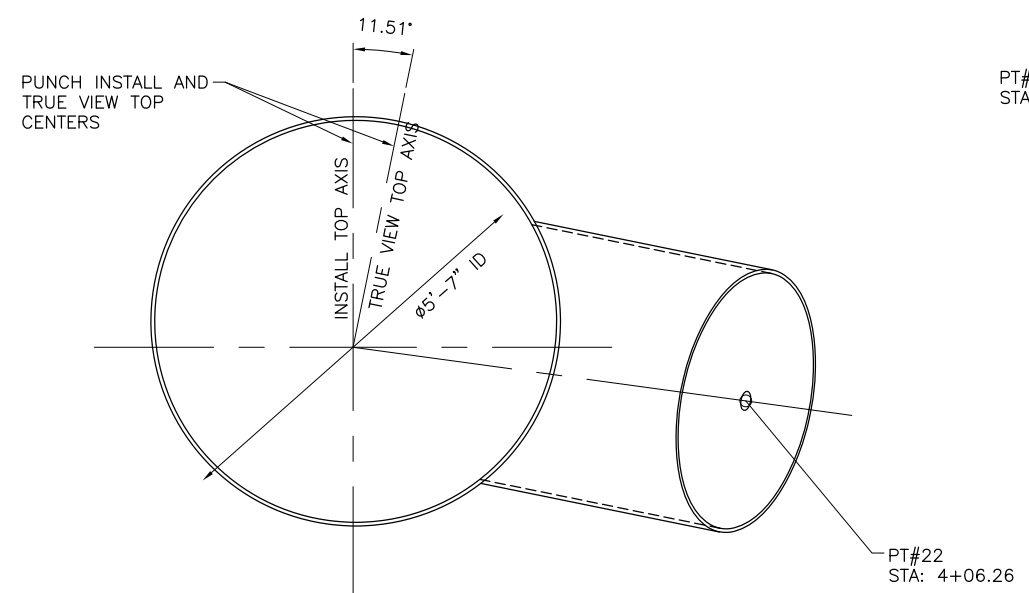

5'-7" ID x 3'-8" ID
BIFURCATION- INSTALL VIEW

SCALE: $\frac{3}{8}" = 1'-0"$


2
FD-5

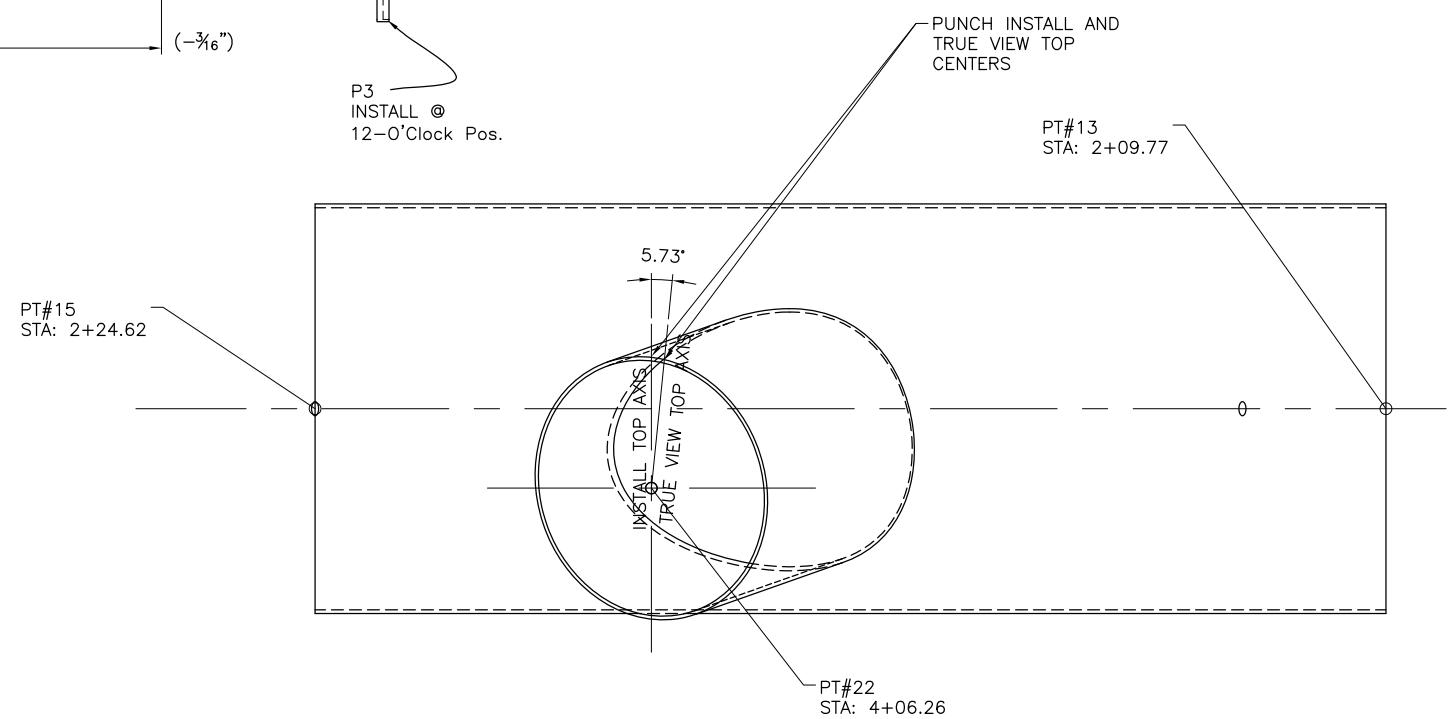

5'-7" ID x 3'-8" ID
BIFURCATION- INSTALL VIEW

SCALE: 3/8" = 1'-0"

3
FD-5

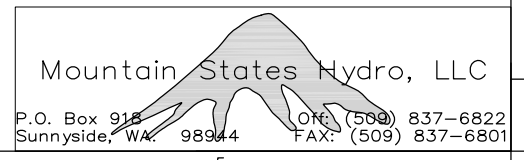

DATE AND TIME PLOTTED
September 27, 2019 17:14
PLOTTED BY
MDJ

CAD SYSTEM
AUTOCAD
CAD FILENAME
FD PENSTOCK 9-27-19.DWG



SORENSEN
ENGINEERING

ALWAYS THINK SAFETY

PROJECT



**SOUTHEASTERN COLORADO WATER
ACTIVITY ENTERPRISE
PUEBLO DAM HYDROELECTRIC PROJECT
FABRICATED DETAILS—
PENSTOCK MISC. DETAILS**

AS CONSTRUCTED 2019

FABRICATED DETAILS—
PENSTOCK MISC. DETAILS

FD-5

CAD SYSTEM
CADD FILENAME
CADD PENSTOCK 9-27-19.DWG
DATE AND TIME PLOTTED
September 27, 2019 17:14
PLOTTED BY
MAD

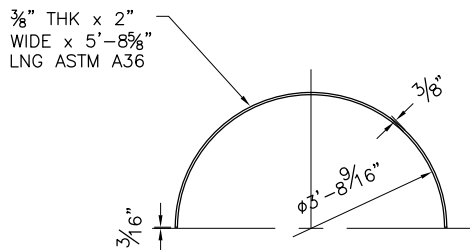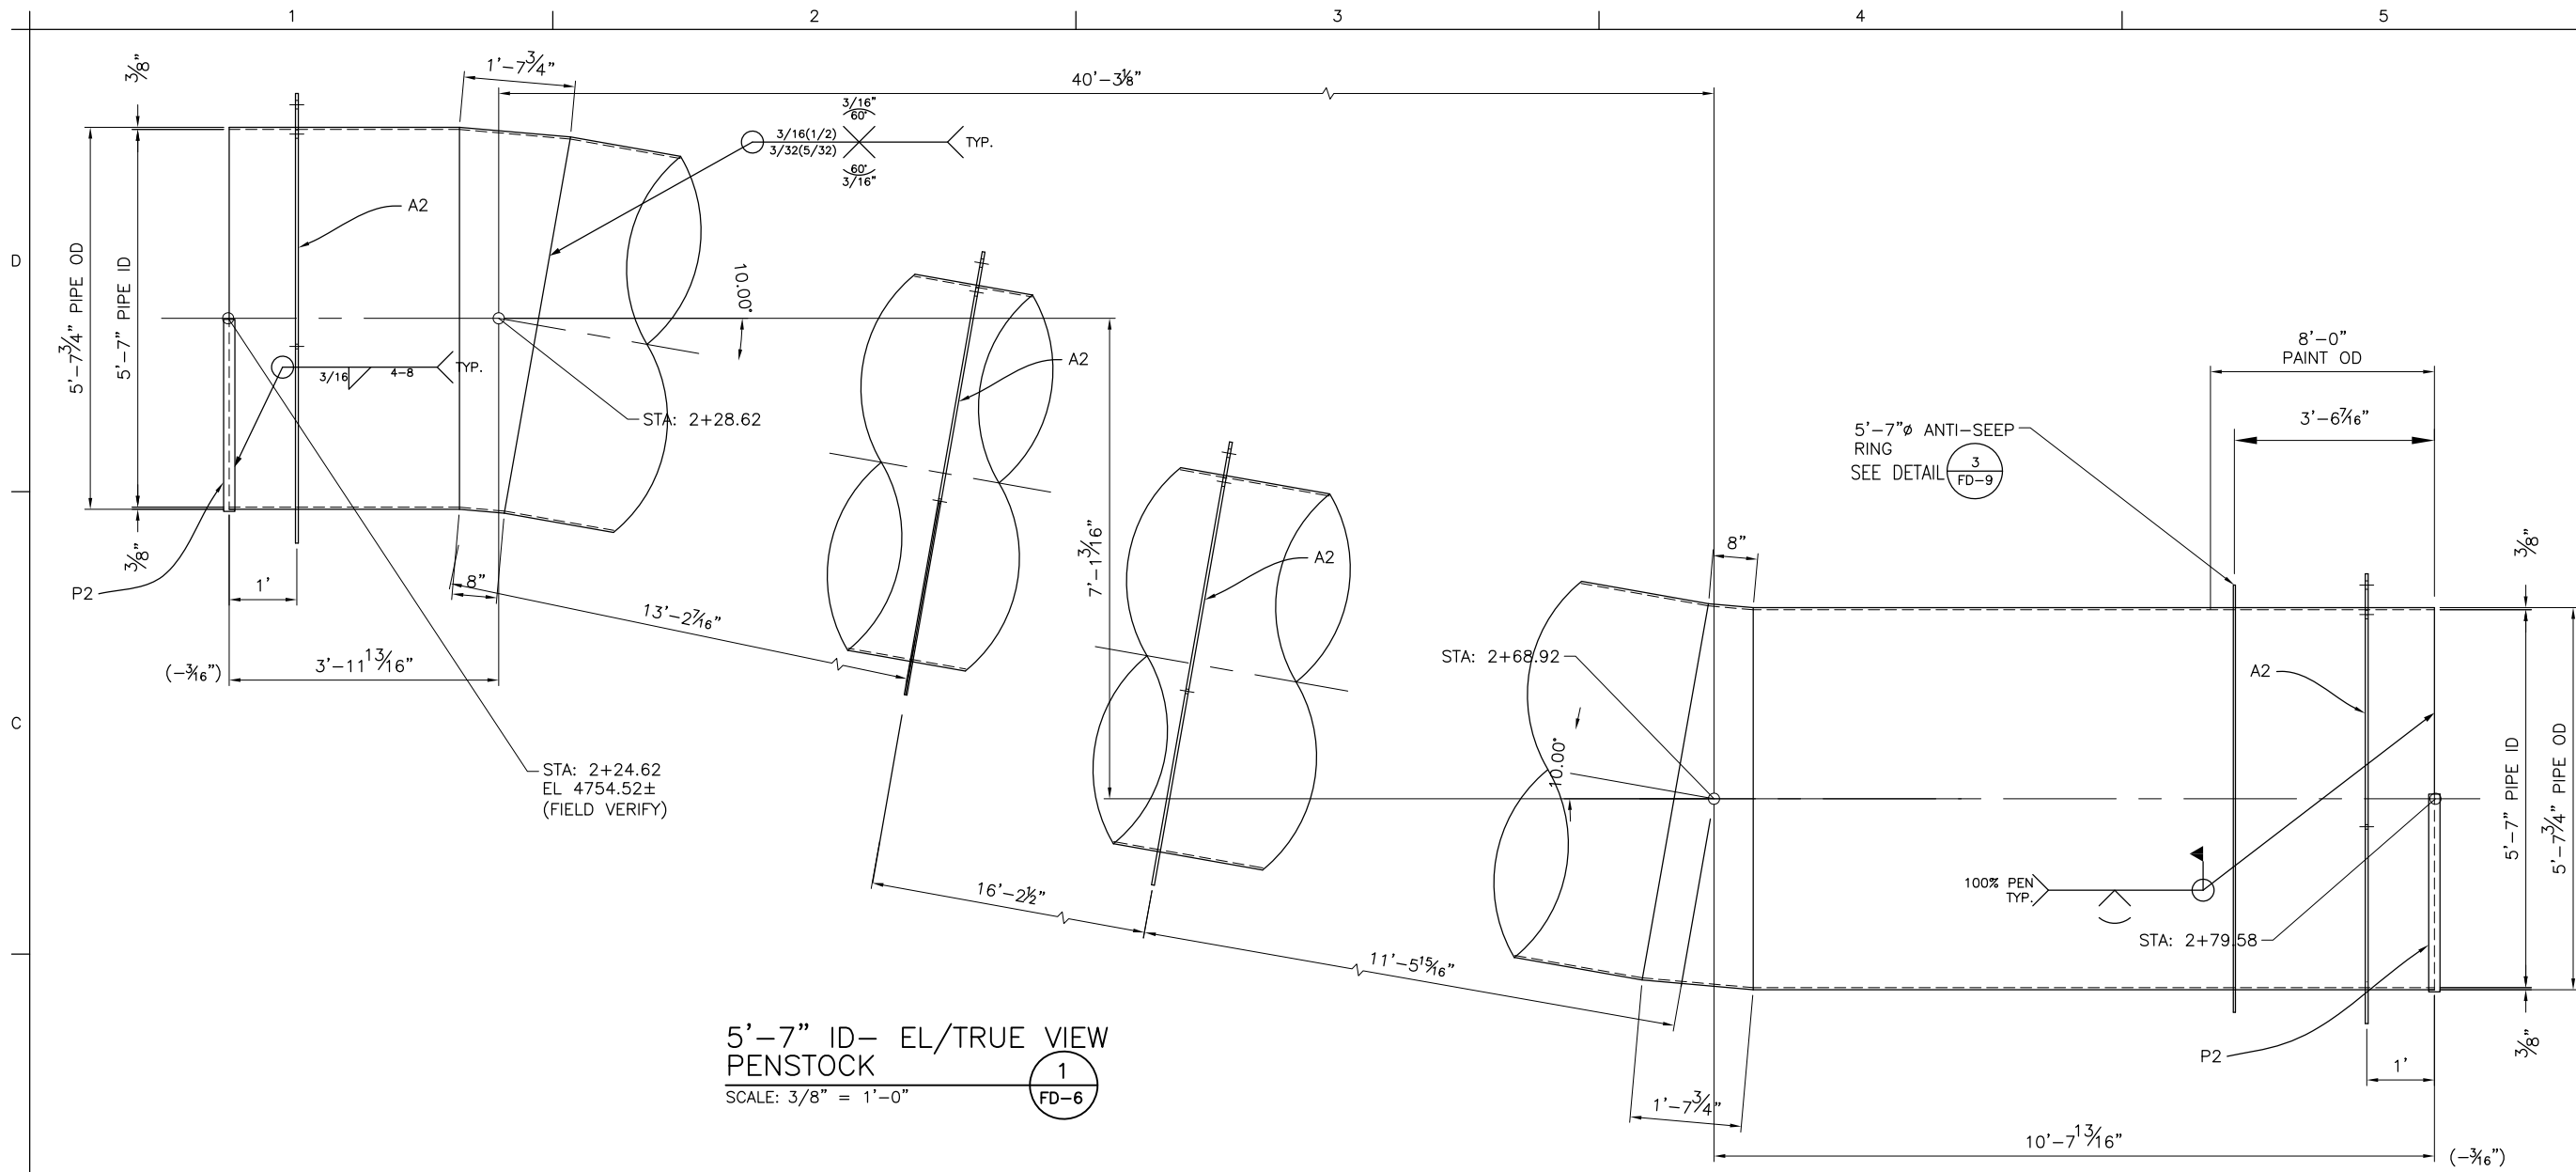


STEEL 3/8" RING BACKING
PLATE DETAIL P4
SCALE: 3/8" = 1'-0"

2
FD-6

Mountain States Hydro, LLC
P.O. Box 918 Sunnyside, WA. 98944
OFF: (509) 837-6822
FAX: (509) 837-6801


SORENSEN ENGINEERING	PROJECT	DRAWING NUMBER
ALWAYS THINK SAFETY	PROJECT	DESCRIPTION
AS CONSTRUCTED 2019	SOUTHEASTERN COLORADO WATER ACTIVITY ENTERPRISE PUEBLO DAM HYDROELECTRIC PROJECT FABRICATED DETAILS- PENSTOCK MISC. DETAILS	NAME, DATE, REVISION
FABRICATED DETAILS- PENSTOCK MISC. DETAILS		FD-6

DATE AND TIME PLOTTED: September 27, 2019 17:14
PLOTTED BY: MJO
CADD SYSTEM: AutoCAD
CADD FILENAME: FD-PENSTOCK 9-27-19.DWG

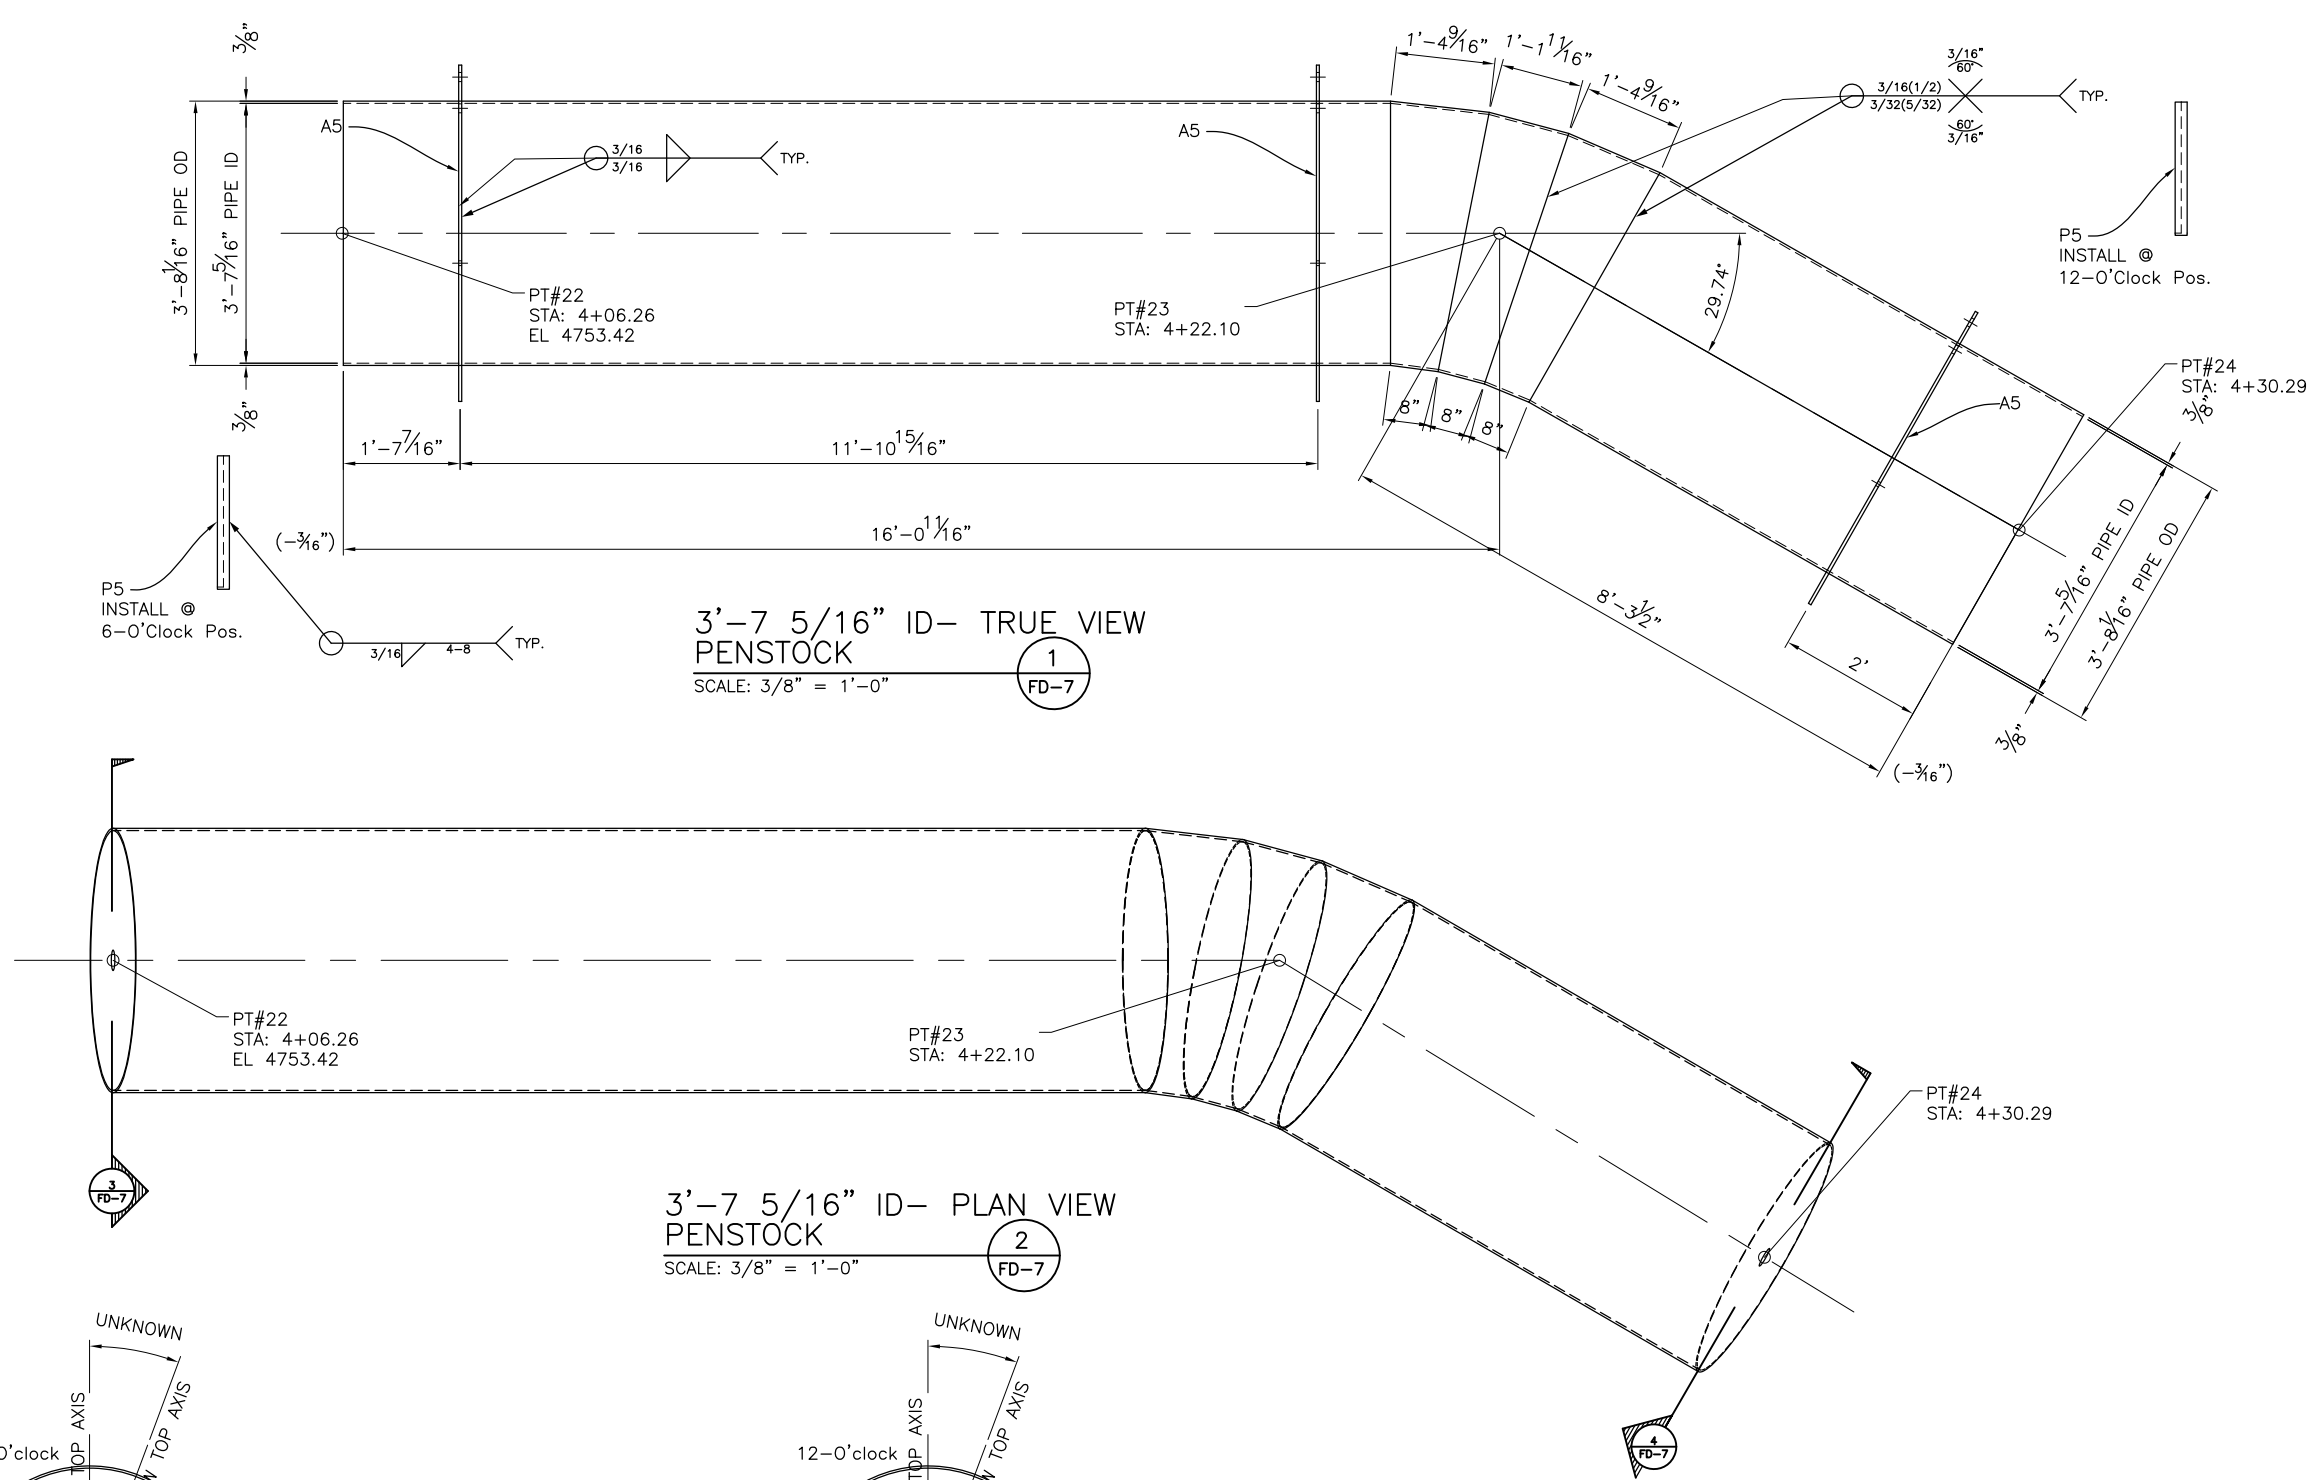


3'-7 5/16" ID- TRUE VIEW
PENSTOCK
SCALE: 3/8" = 1'-0" (1) FD-7

3'-7 5/16" ID- PLAN VIEW
PENSTOCK
SCALE: 3/8" = 1'-0" (2) FD-7

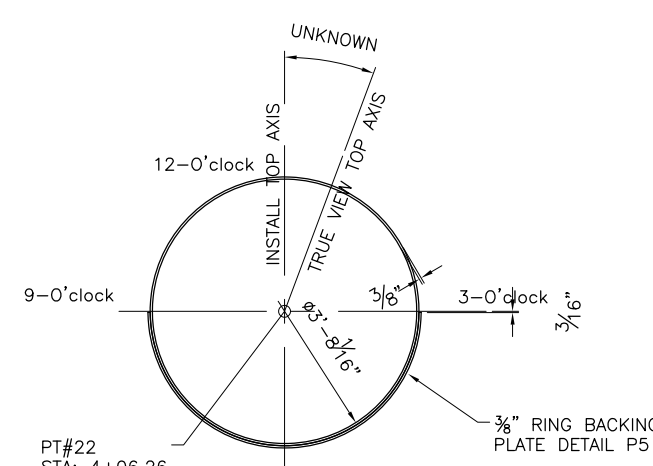


TRUE VIEW
PENSTOCK END
SCALE: 3/8" = 1'-0" (3) FD-7

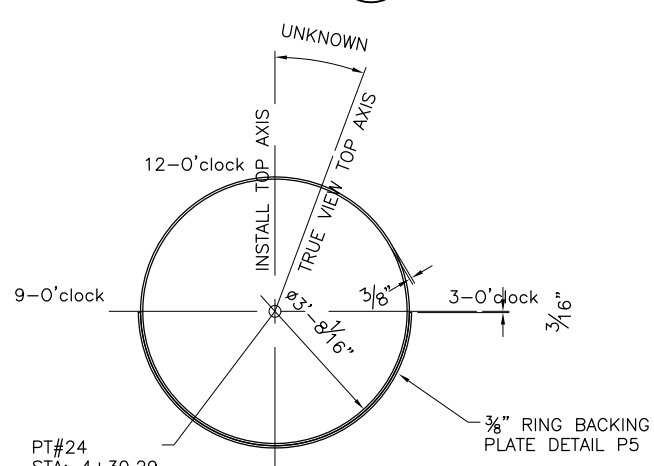

TRUE VIEW
PENSTOCK END
SCALE: 3/8" = 1'-0" (4) FD-7

- NOTE:
1. ORIENT RING STIFFENERS TO MATCH INSTALL TOP AXIS
 2. INSTALL 3/8"x2" WIDE BAKER BARS ACCORDING TO INDICATED POSITION (12-0'clock or 6-0'clock) ALONG THE INSTALL TOP AXIS

Mountain States Hydro, LLC
P.O. Box 918 Sunnyside, WA. 98944
OFF: (509) 837-6822
FAX: (509) 837-6801

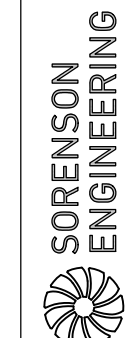

ALWAYS THINK SAFETY


PROJECT
SOUTHEASTERN COLORADO WATER
ACTIVITY ENTERPRISE
PUEBLO DAM HYDROELECTRIC PROJECT
FABRICATED DETAILS-
PENSTOCK MISC. DETAILS

AS CONSTRUCTED 2019

FABRICATED DETAILS-
PENSTOCK MISC. DETAILS

FD-7

CAD SYSTEM
AUTOCAD
DATE AND TIME PLOTTED
September 27, 2019 17:14
PLOTTED BY
MUI

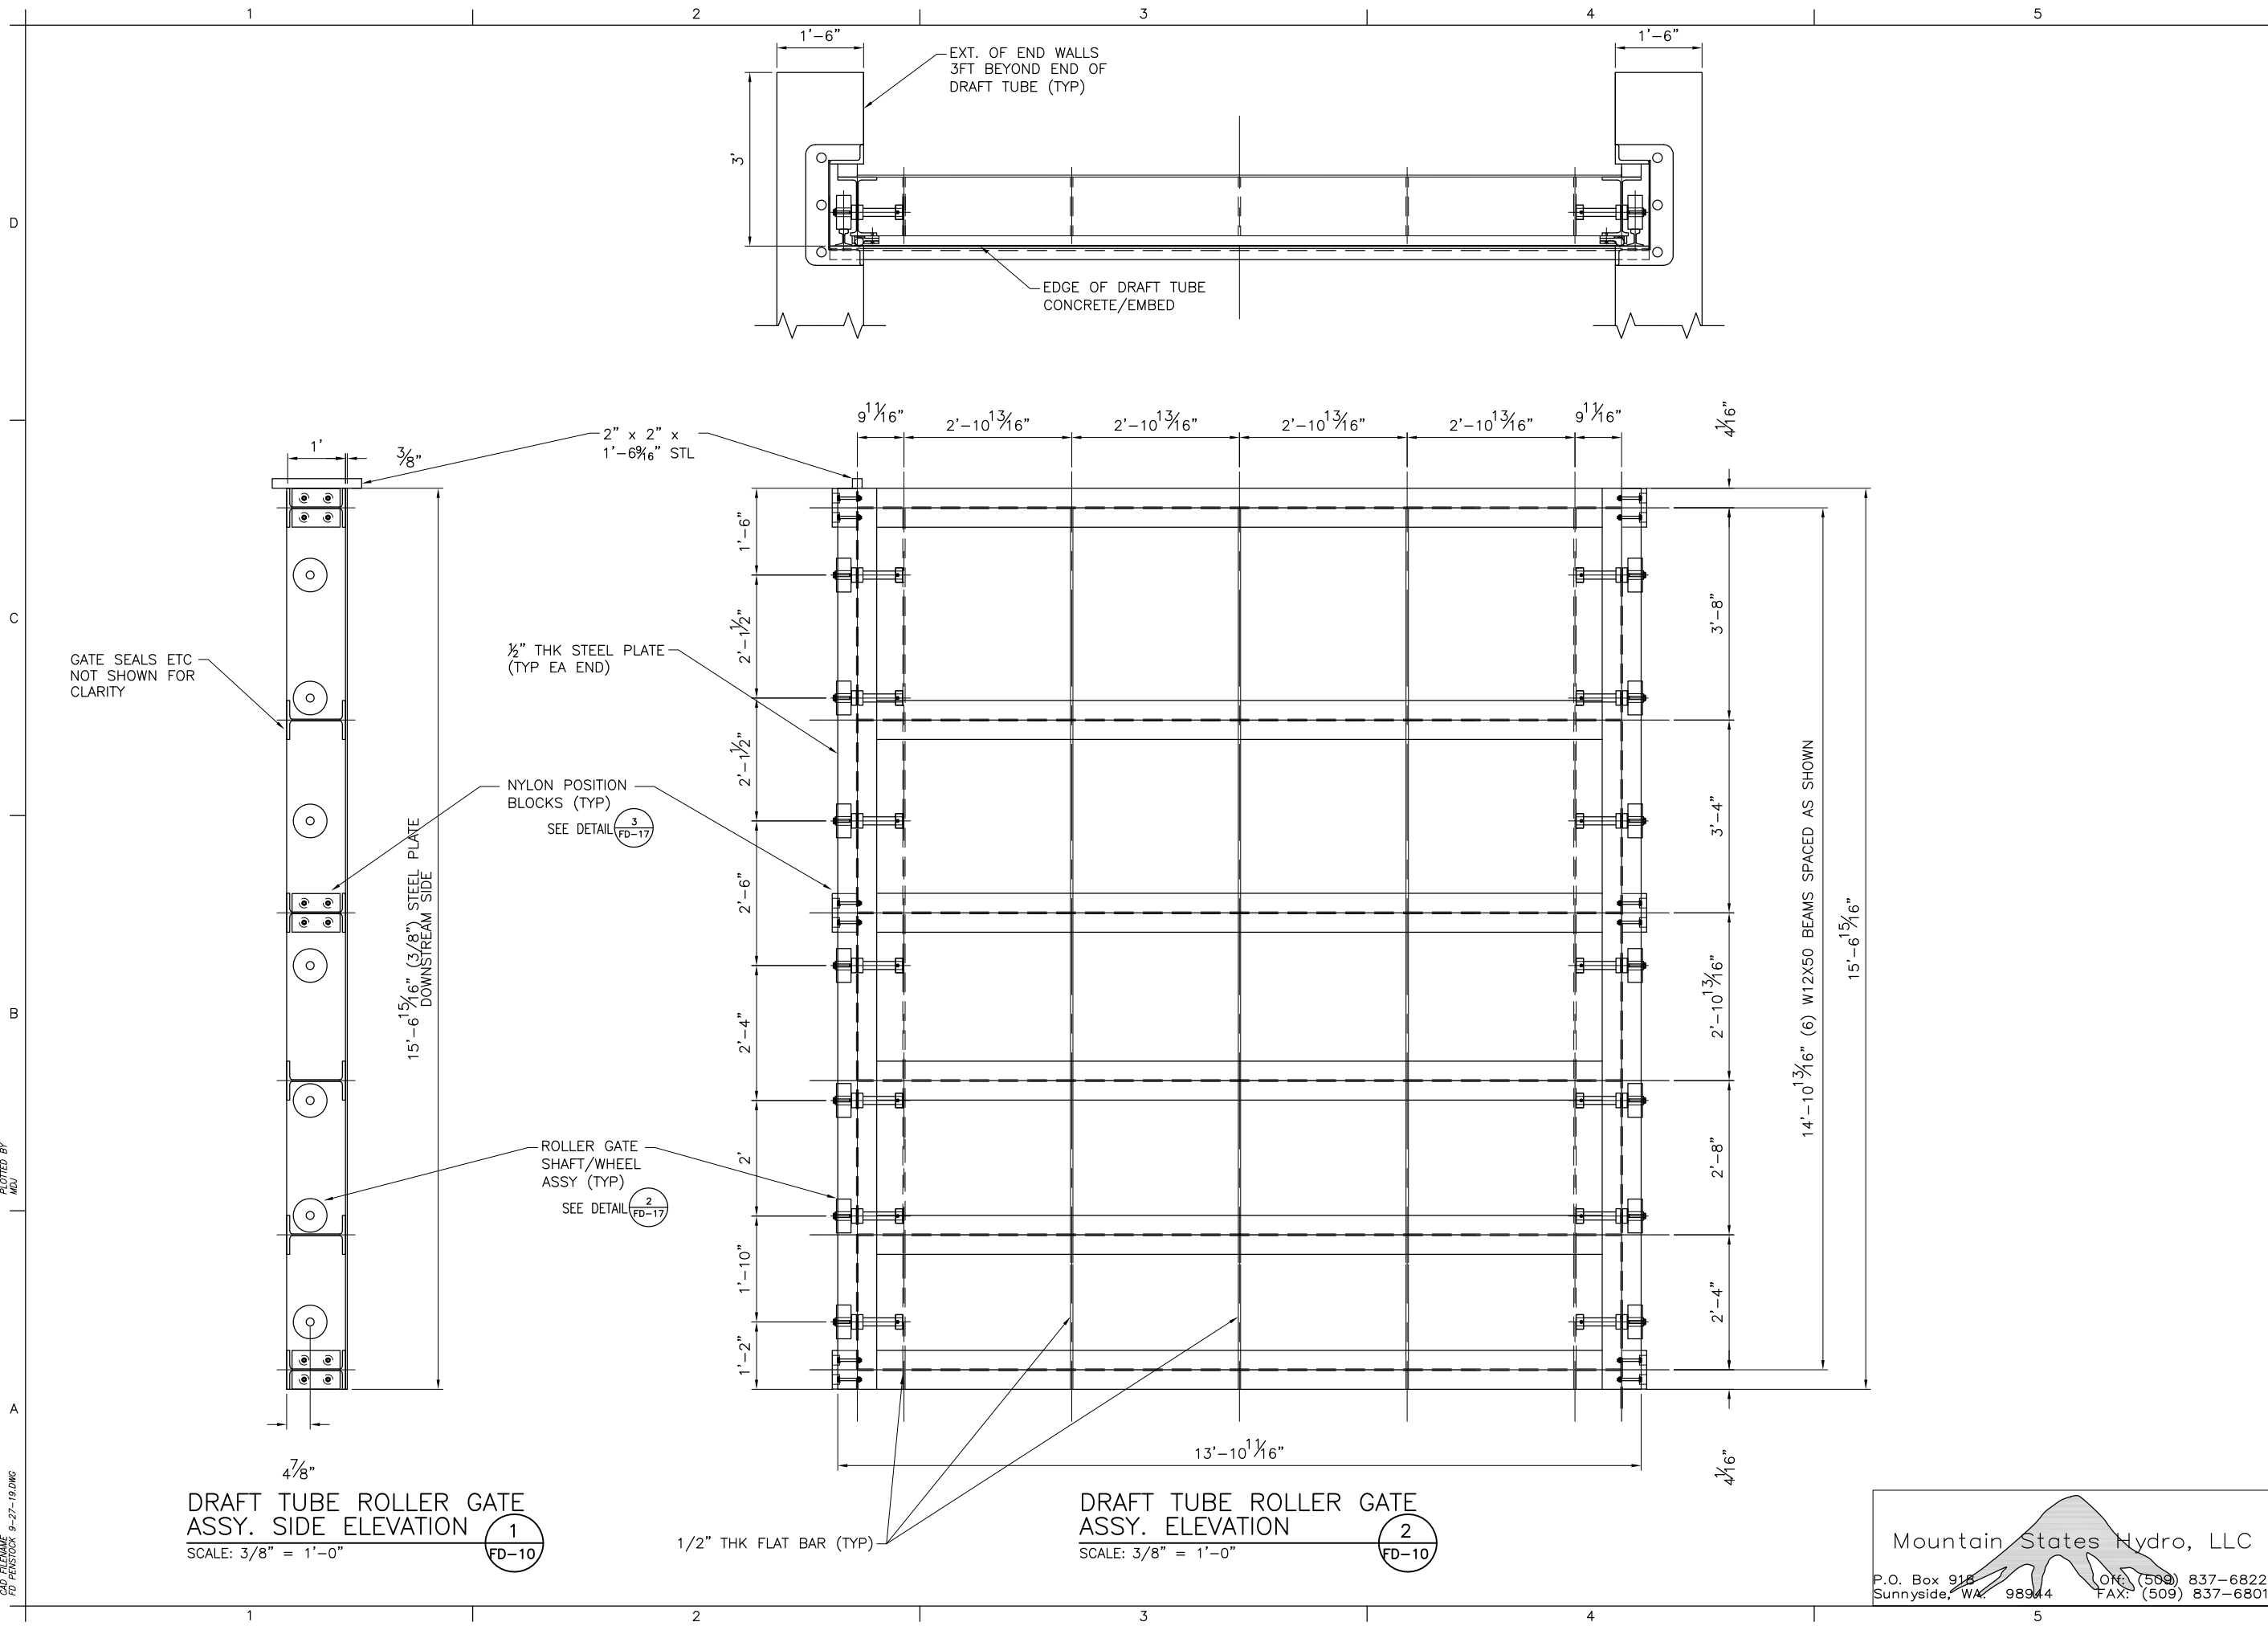

DRAFT TUBE ROLLER GATE
ASSY. SIDE ELEVATION
SCALE: 3/8" = 1'-0"

1
FD-10


DRAFT TUBE ROLLER GATE
ASSY. ELEVATION
SCALE: 3/8" = 1'-0"

2
FD-10

Mountain States Hydro, LLC
P.O. Box 918
Sunnyside, WA. 98944
OFF: (509) 837-6822
FAX: (509) 837-6801

SORENSEN ENGINEERING	PROJECT	DRAWING NUMBER
PROJECT		
ALWAYS THINK SAFETY		
PROJECT		
SOUTHEASTERN COLORADO WATER ACTIVITY ENTERPRISE PUEBLO DAM HYDROELECTRIC PROJECT FABRICATED DETAILS - ROLLER GATE DETAILS		
AS CONSTRUCTED 2019		
REV NO 11/17/19-MH-03 NAME, DATE, APPR.		
DESCRIPTION		
FABRICATED DETAILS - ROLLER GATE DETAILS		
FD-10		

DATE AND TIME PLOTTED: September 27, 2019 17:14
AUTOCAD FILENAME: FD-11.dwg
PLOTTER: HP DesignJet 500
PLOTTER DRIVER: HPGL
PLOTTER MODEL: HP DesignJet 500
PLOTTER SERIAL: 1234567890
PLOTTER STATUS: OK
PLOTTER MESSAGE: PLOTTING SUCCESSFUL

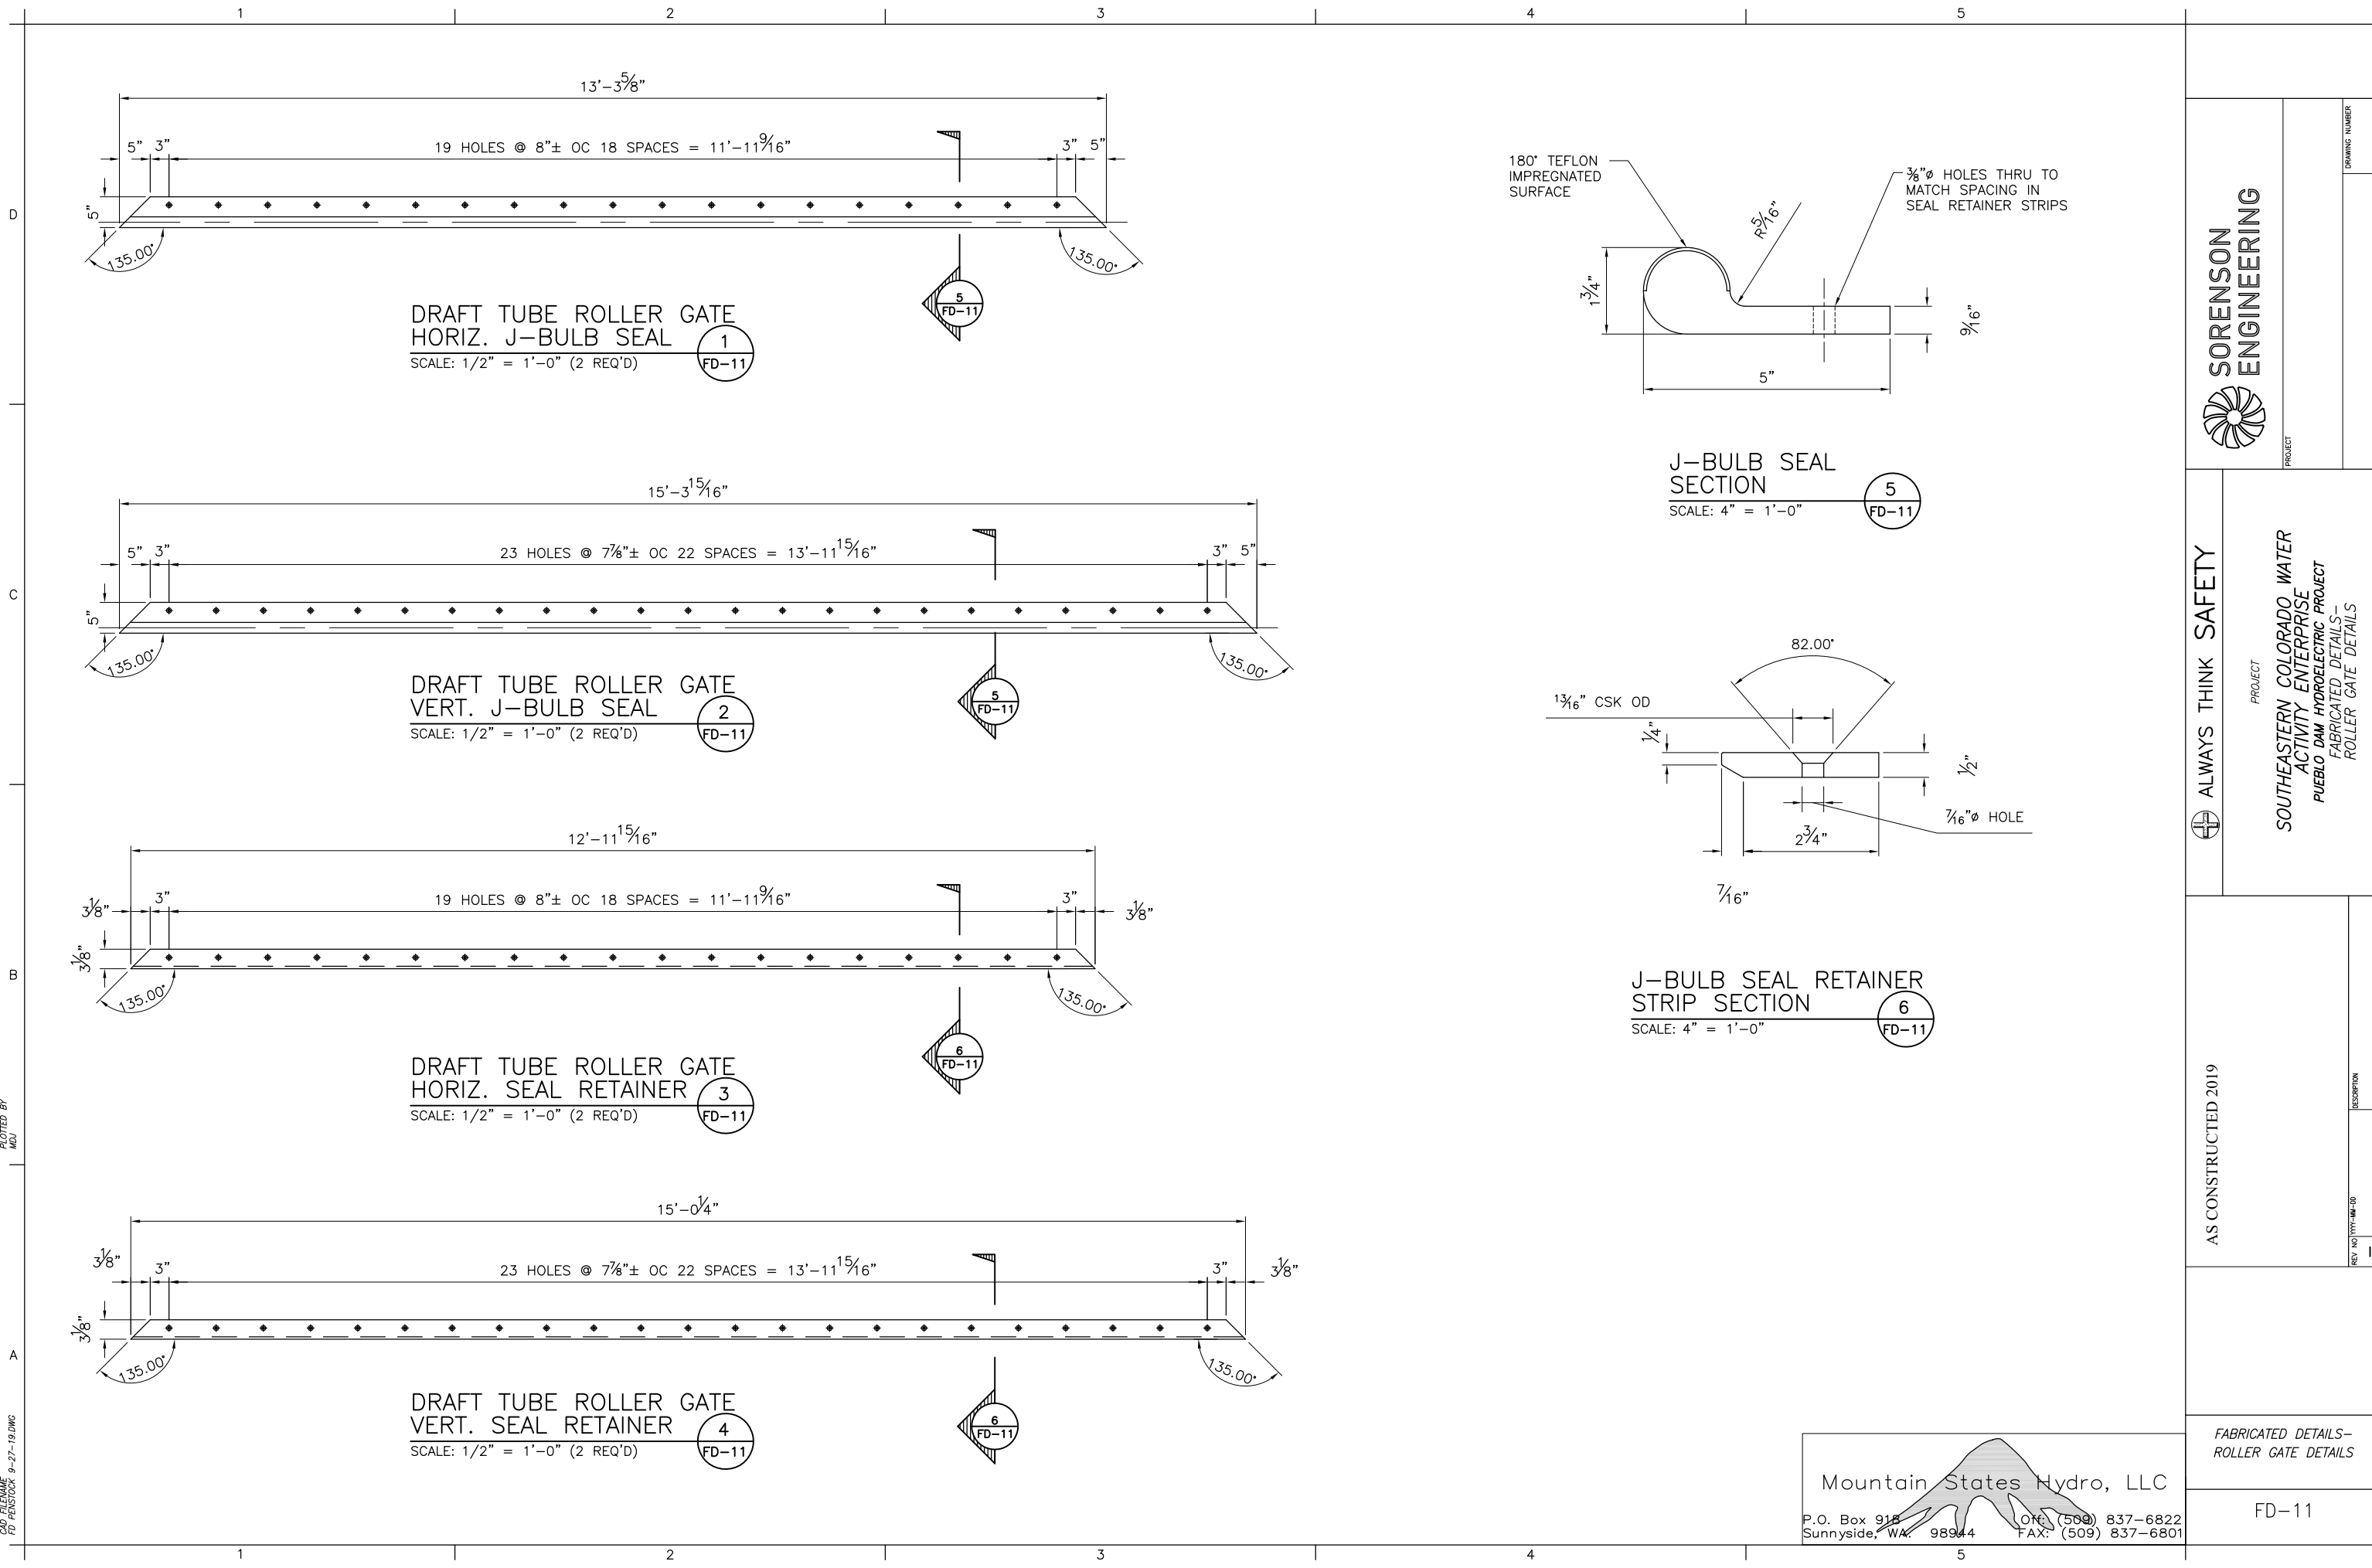

SORENSEN ENGINEERING

ALWAYS THINK SAFETY

PROJECT
SOUTHEASTERN COLORADO WATER
ACTIVITY ENTERPRISE
PUEBLO DAM HYDROELECTRIC PROJECT
FABRICATED DETAILS -
ROLLER GATE DETAILS


AS CONSTRUCTED 2019

FABRICATED DETAILS -
ROLLER GATE DETAILS

FD-11

Mountain States Hydro, LLC
P.O. Box 918
Sunnyside, WA. 98944
OFF: (509) 837-6822
FAX: (509) 837-6801

DATE AND TIME PLOTTED: September 27, 2019 17:14
AUTOCAD FILENAME: FD-12.DWG
PLOTTER: HP DesignJet 500
PLOTTER DRIVER: HP-GL/2
PLOTTER MODEL: 500
PLOTTER SERIAL: 9-27-19.DWG

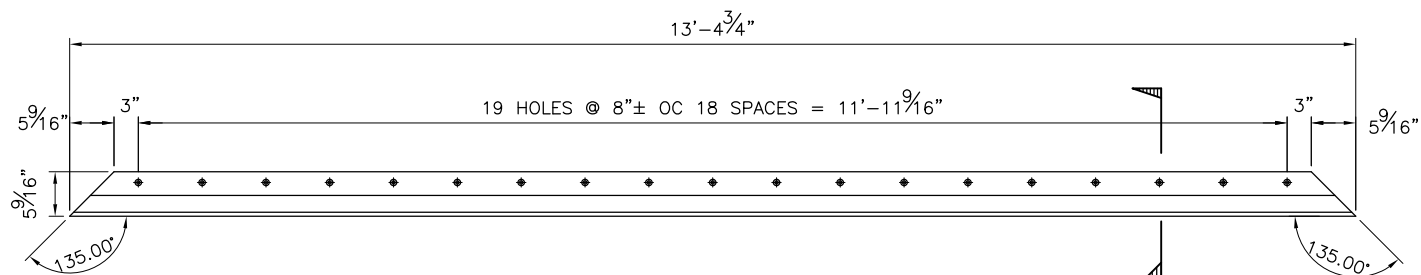


DRAFT TUBE ROLLER GATE
HORIZ. SPACER

1

FD-12

SCALE: 1/2" = 1'-0" (2 REQ'D)

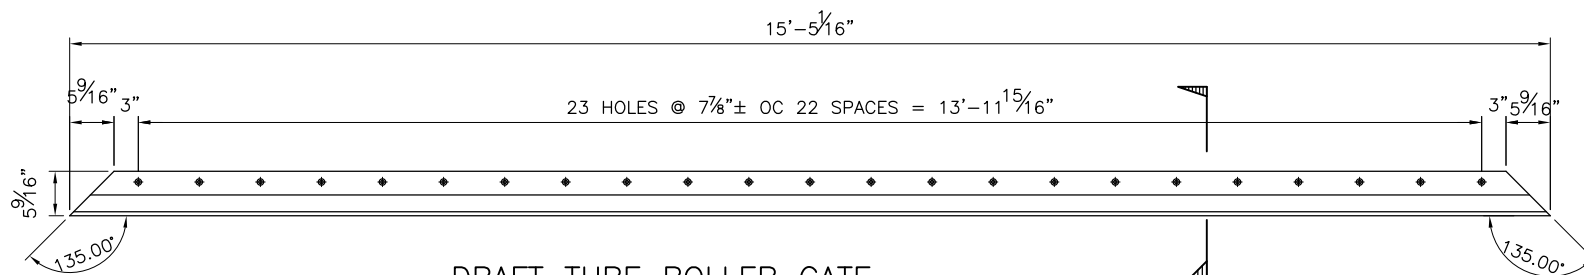


DRAFT TUBE ROLLER GATE
VERT. SPACER

2

FD-12

SCALE: 1/2" = 1'-0" (2 REQ'D)

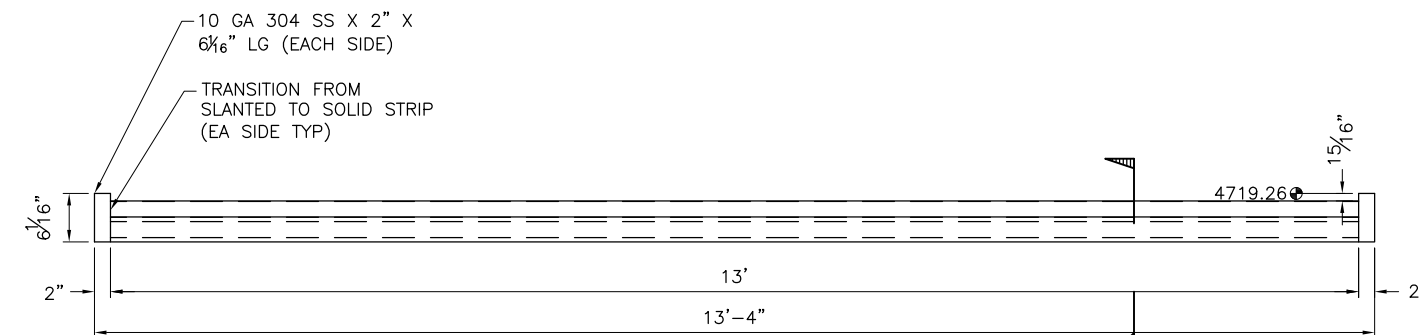


DRAFT TUBE ROLLER GATE
BOTTOM SEAL STRIP

3

FD-12

SCALE: 1/2" = 1'-0" (3 REQ'D)

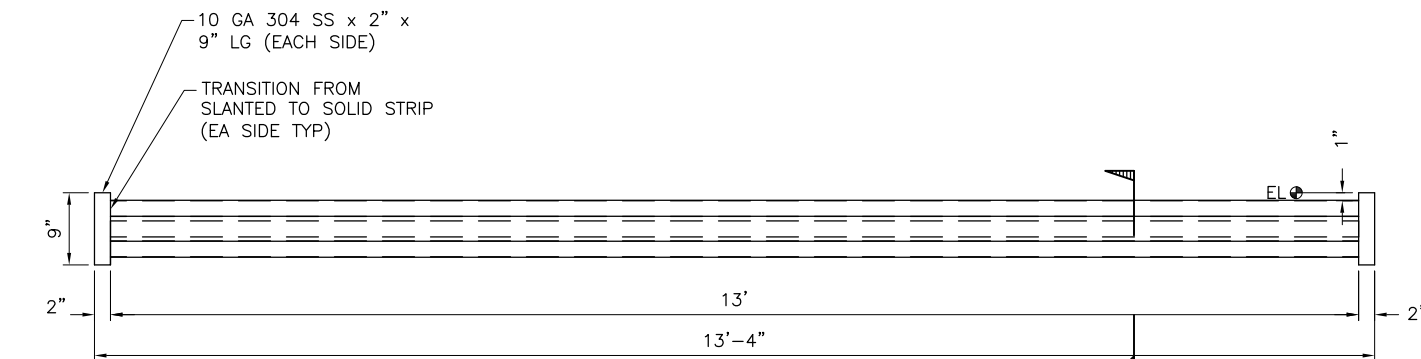


DRAFT TUBE ROLLER GATE
BOTTOM SEAL STRIP

4

FD-12

SCALE: 1/2" = 1'-0" (3 REQ'D)

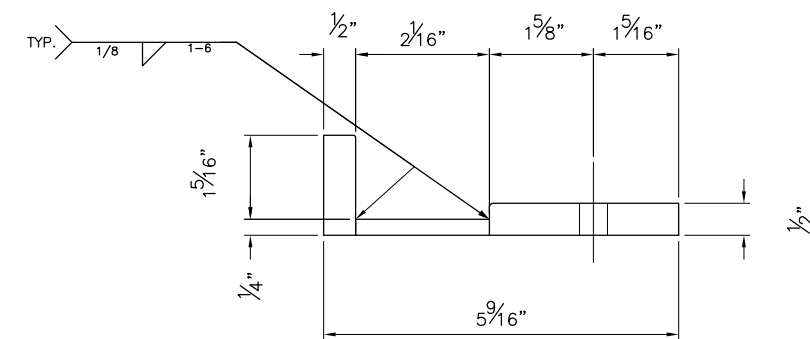


SEAL
SPACER ASSY

5

FD-12

SCALE: 4" = 1'-0"

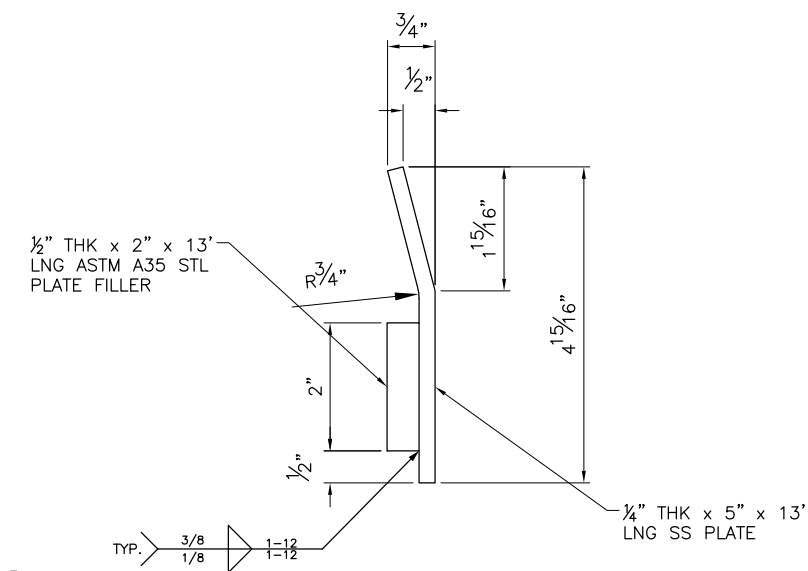


BOTTOM SEAL
SLIDER ASSY

6

FD-12

SCALE: 4" = 1'-0"

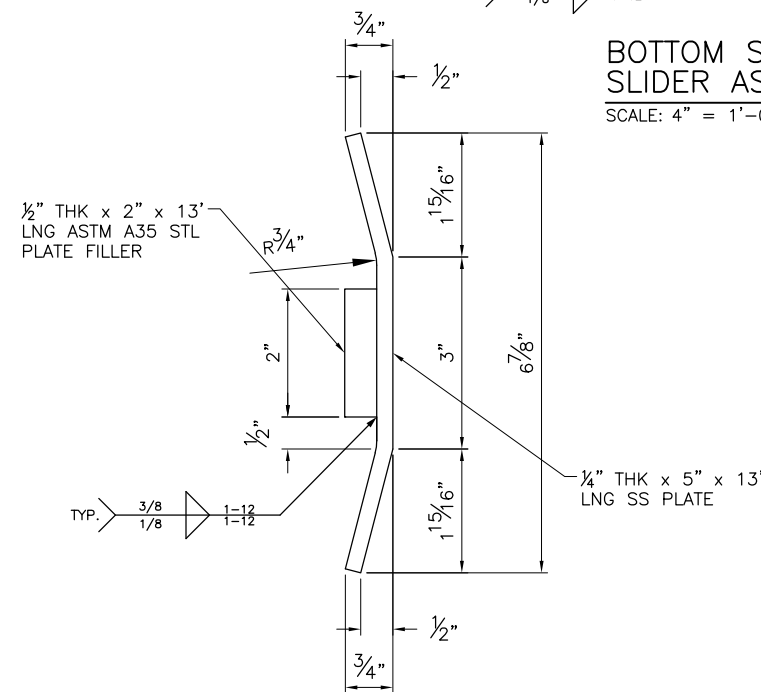

TOP SEAL
SLIDER ASSY

7

FD-12

SCALE: 4" = 1'-0"

Mountain States Hydro, LLC

P.O. Box 918
Sunnyside, WA. 98944

OFF: (509) 837-6822
FAX: (509) 837-6801



ALWAYS THINK SAFETY


PROJECT
SOUTHEASTERN COLORADO WATER
ACTIVITY ENTERPRISE
PUEBLO DAM HYDROELECTRIC PROJECT
FABRICATED DETAILS -
ROLLER GATE DETAILS

AS CONSTRUCTED 2019

DESCRIPTION
NAME, DATE, ASSN.

FABRICATED DETAILS -
ROLLER GATE DETAILS

FD-12

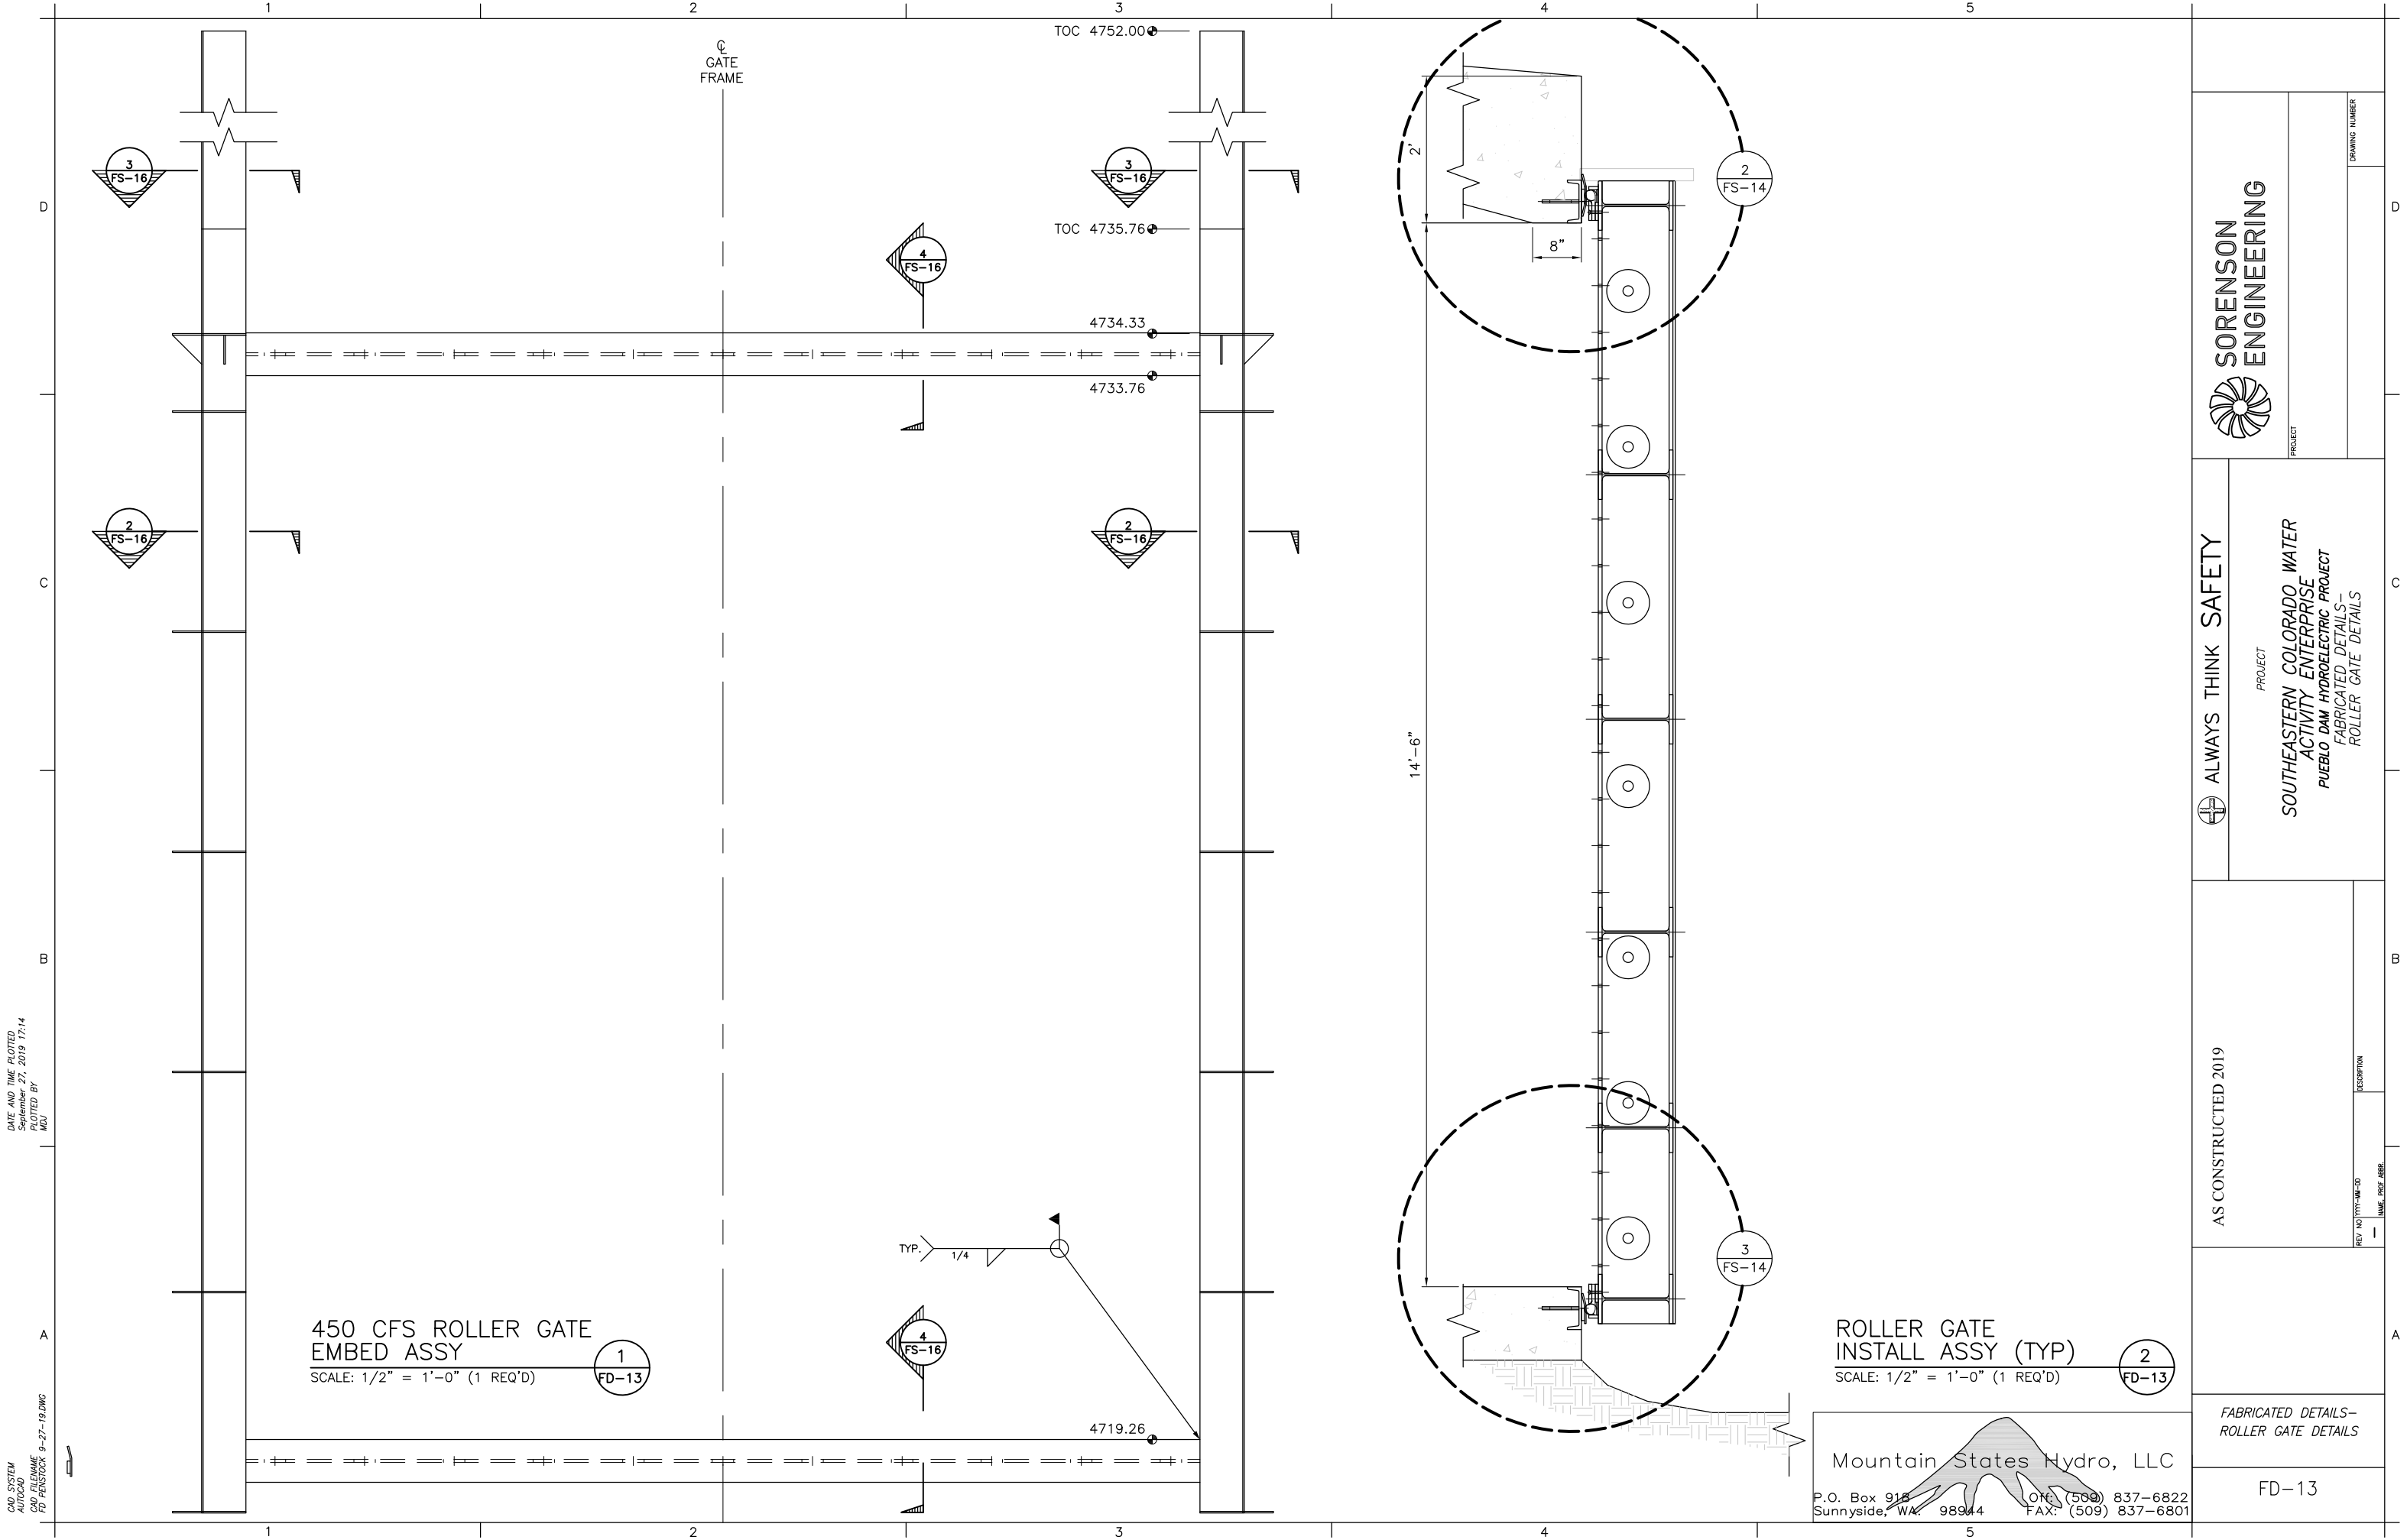

DATE AND TIME PLOTTED: September 27, 2019 17:14
PLOT BY: MUI
CADD SYSTEM: AutoCAD
CADD FILENAME: FD-13.DWG
CADD PLOT: 9-27-19.DWG





PROJECT
SOUTHEASTERN COLORADO WATER
ACTIVITY ENTERPRISE
PUEBLO DAM HYDROELECTRIC PROJECT
FABRICATED DETAILS -
ROLLER GATE DETAILS

AS CONSTRUCTED 2019

Mountain States Hydro, LLC
P.O. Box 918
Sunnyside, WA 98944
OFF: (509) 837-6822
FAX: (509) 837-6801




FABRICATED DETAILS -
ROLLER GATE DETAILS
FD-13

DATE AND TIME PLOTTED: September 27, 2019 17:14
AUTOCAD NAME: FD-14.DWG
PLOT BY: MJO


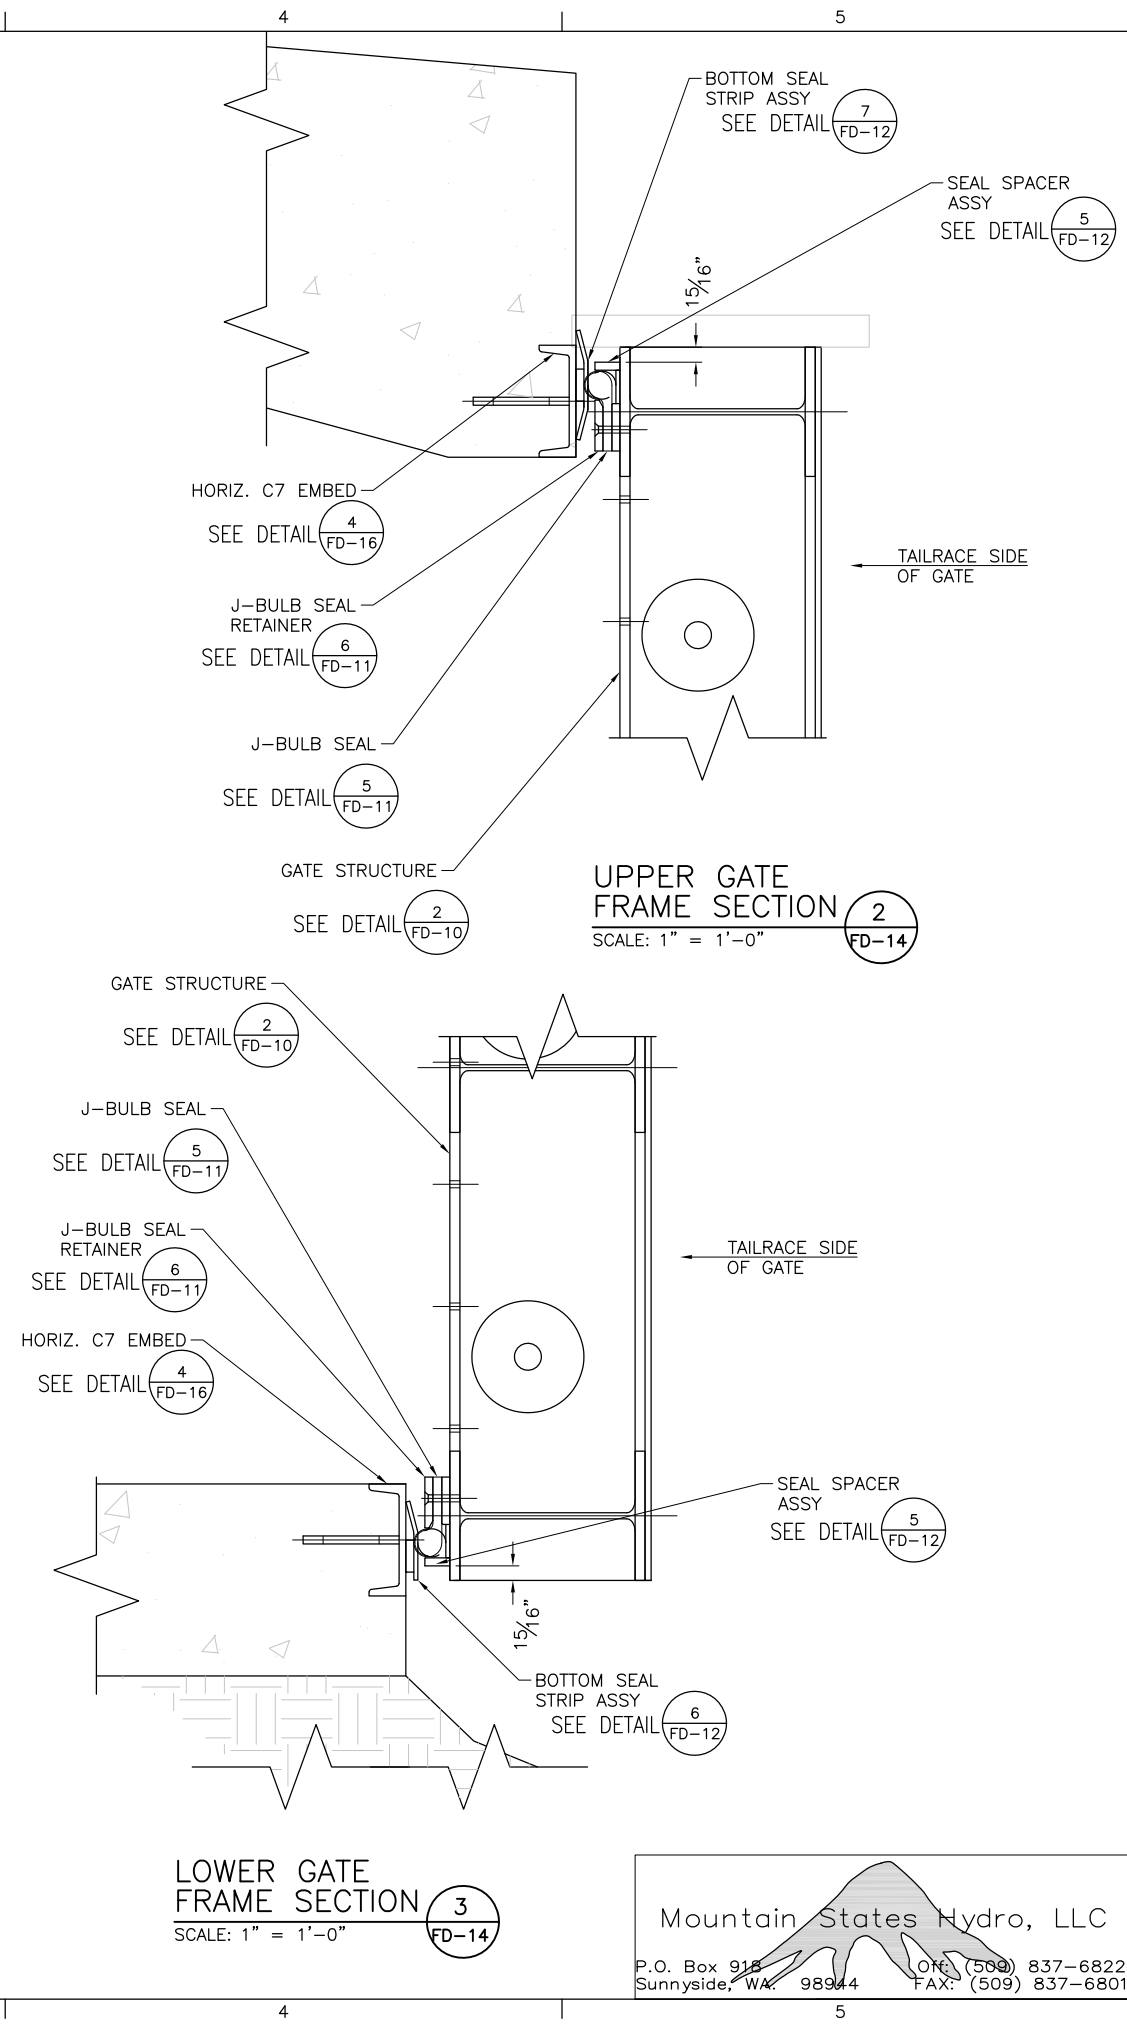
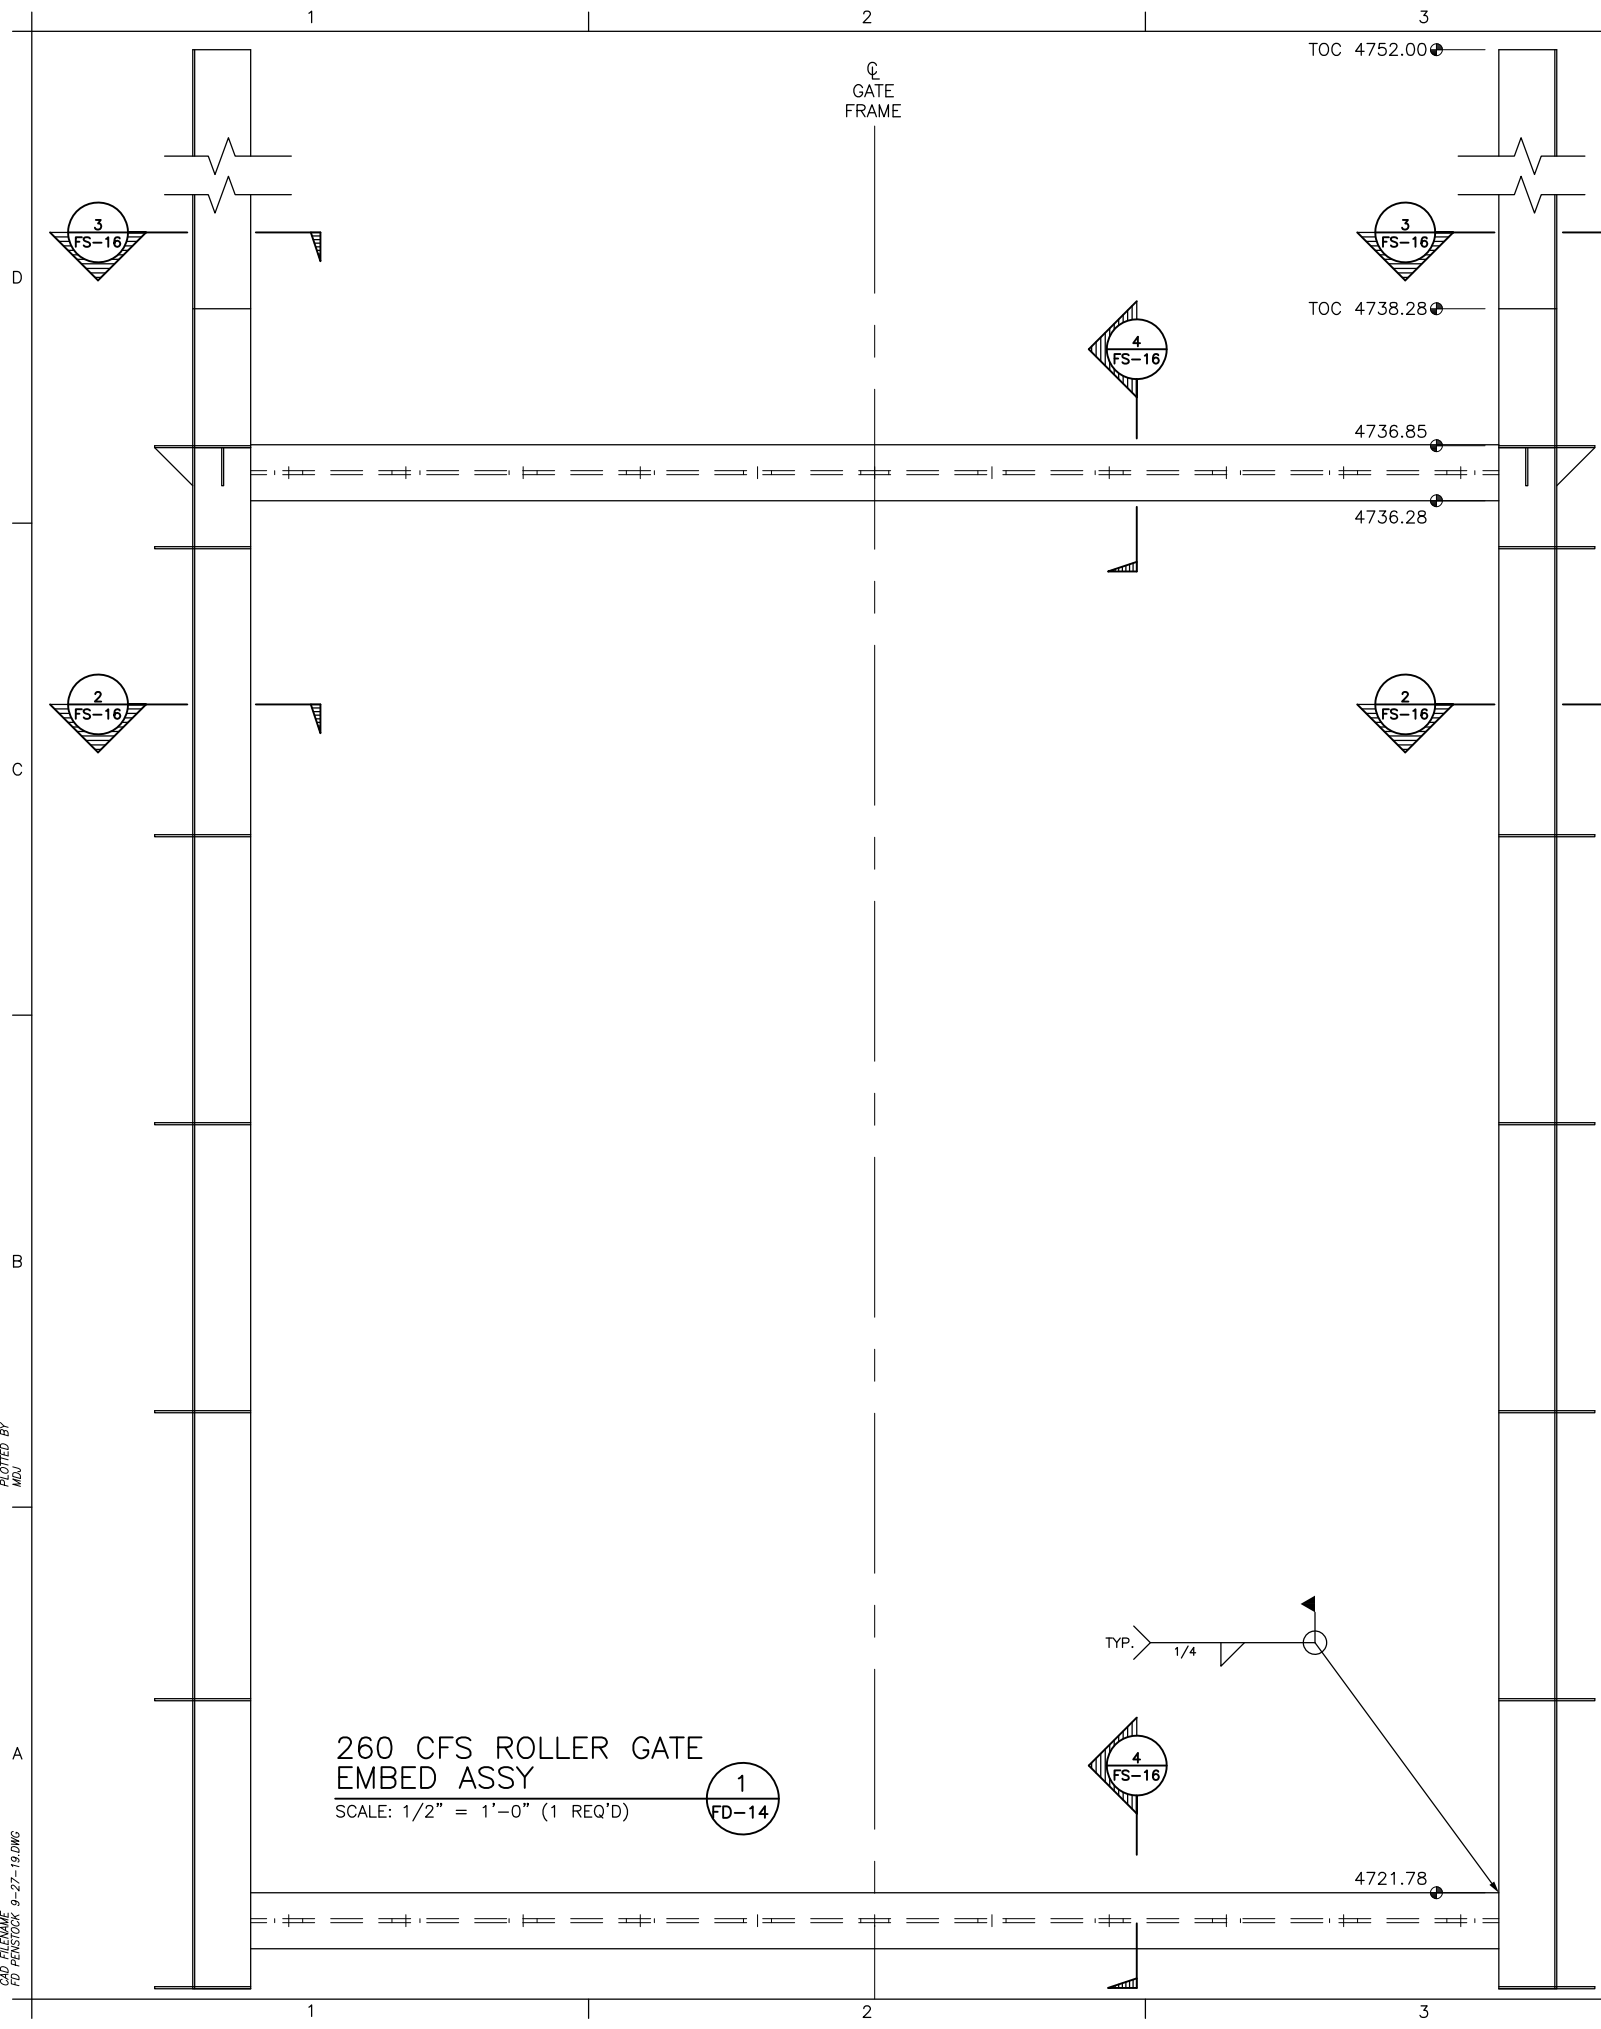


Mountain States Hydro, LLC
P.O. Box 918
Sunnyside, WA 98944
OFF: (509) 837-6822
FAX: (509) 837-6801

SORENSEN ENGINEERING	DRAWING NUMBER	D
ALWAYS THINK SAFETY	PROJECT	C
AS CONSTRUCTED 2019	DESCRIPTION	B
FABRICATED DETAILS- ROLLER GATE DETAILS	NAME, DATE, ASSIGNED	A
FD-14		

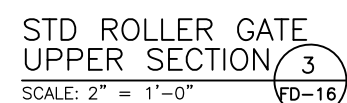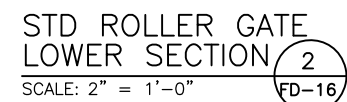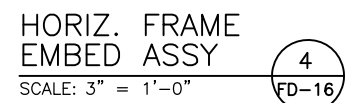



DATE AND TIME PLOTTED: September 27, 2019 17:14
AUTOCALCULATE: YES
PLOT BY: MJO
QAD SYSTEM: 9-27-19.DWG
FD PENSTOCK

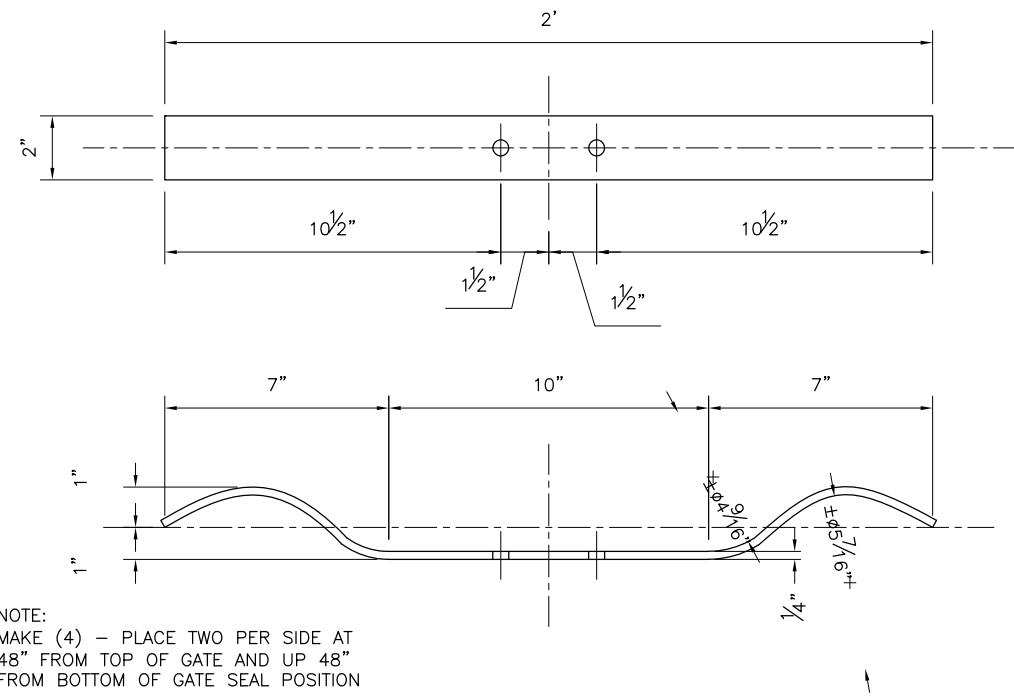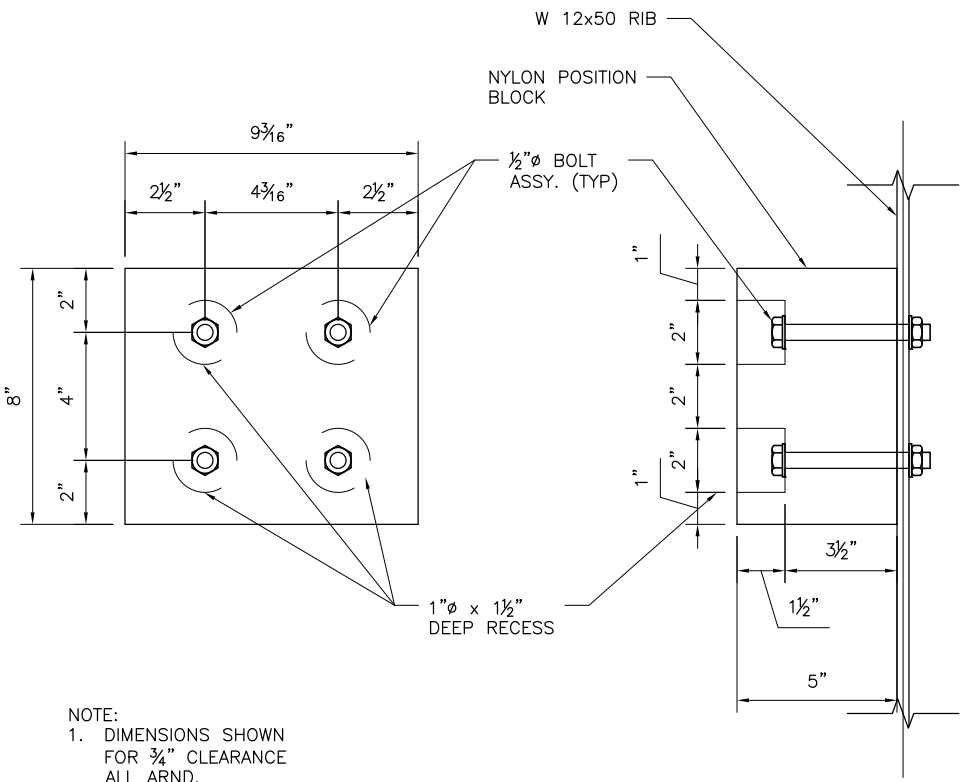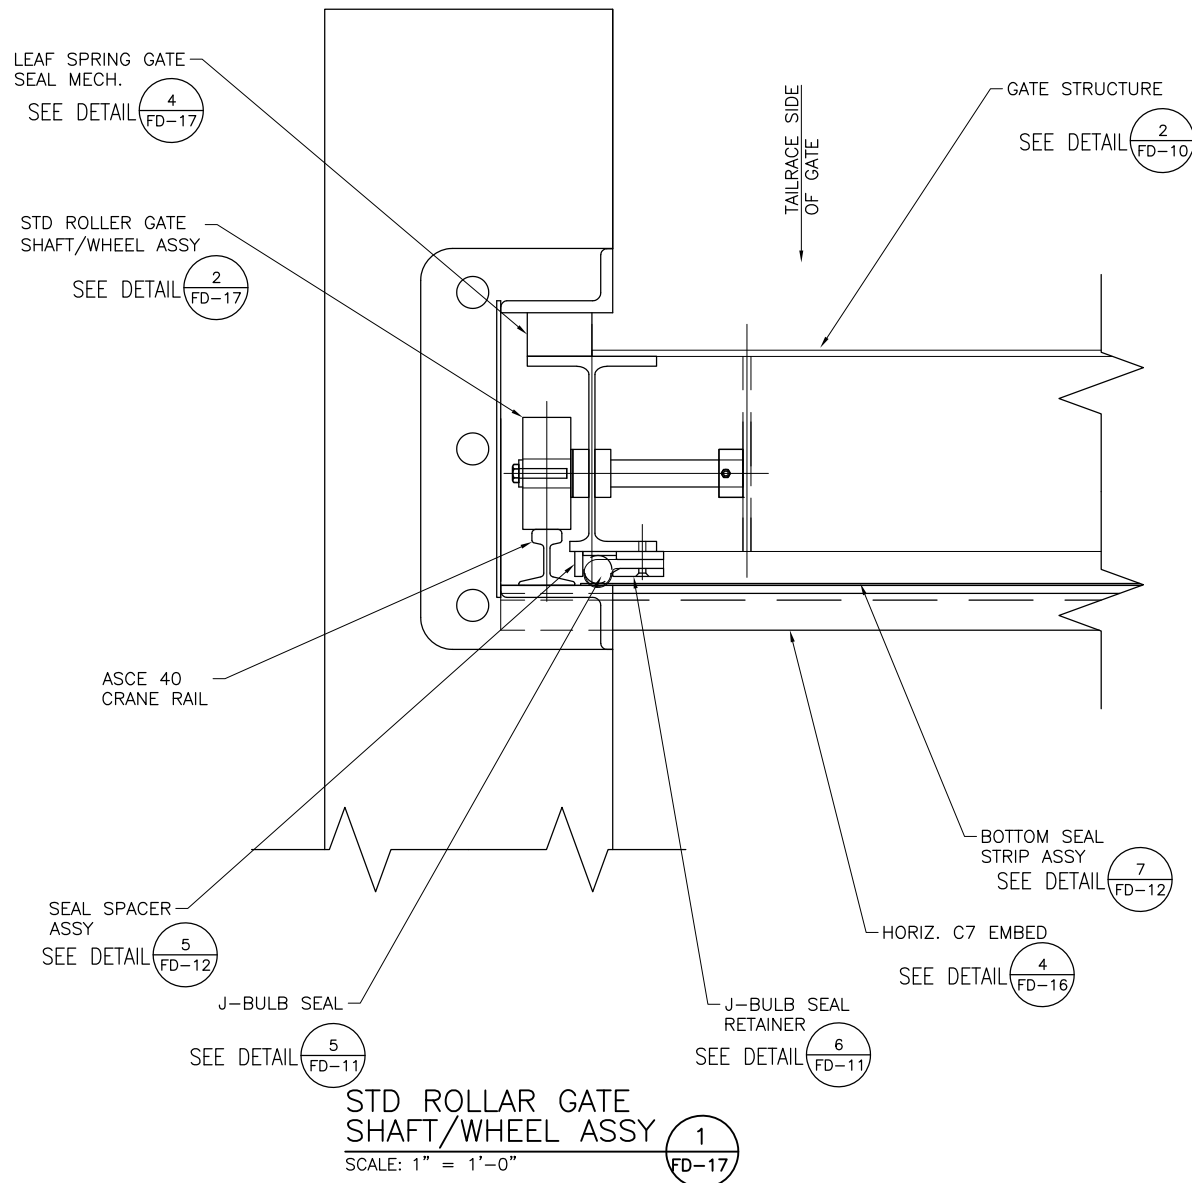

Mountain States Hydro, LLC
P.O. Box 918 Sunnyside, WA. 98944
OFF: (509) 837-6822
FAX: (509) 837-6801

SORENSEN ENGINEERING	PROJECT	DRAWING NUMBER
ALWAYS THINK SAFETY		
PROJECT SOUTHEASTERN COLORADO WATER ACTIVITY ENTERPRISE PUEBLO DAM HYDROELECTRIC PROJECT FABRICATED DETAILS - ROLLER GATE DETAILS		
AS CONSTRUCTED 2019	DESCRIPTION	REV. NO. / DATE / BY
FABRICATED DETAILS - ROLLER GATE DETAILS		
FD-17		

DATE AND TIME PLOTTED
September 27, 2019 17:14
PLOTTER
AUTO
CADD SYSTEM
AUTOCAD
PLOTTERNAME
FD PENSTOCK 9-27-19.DWG

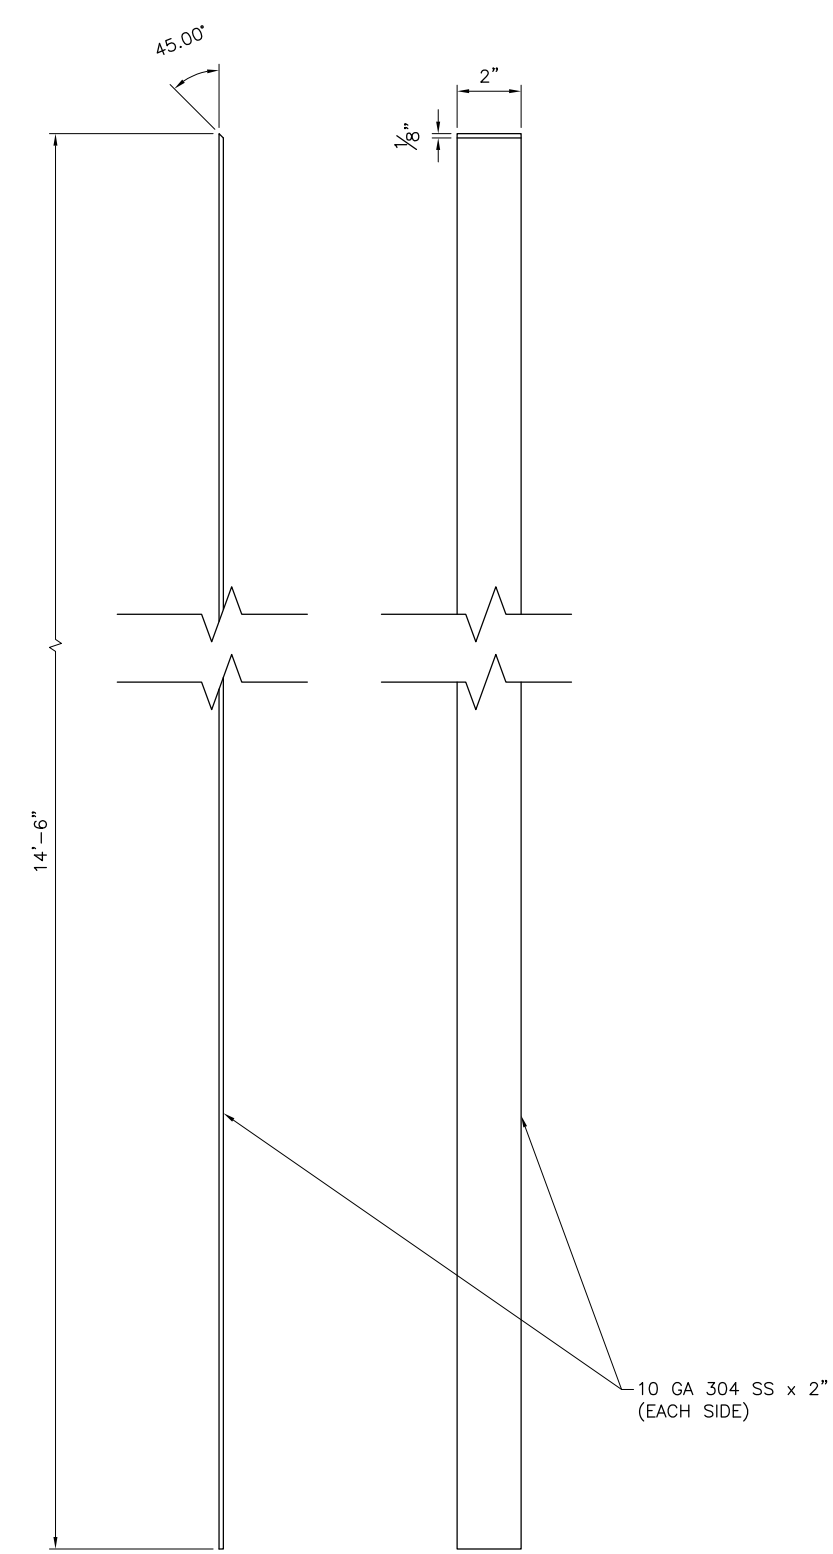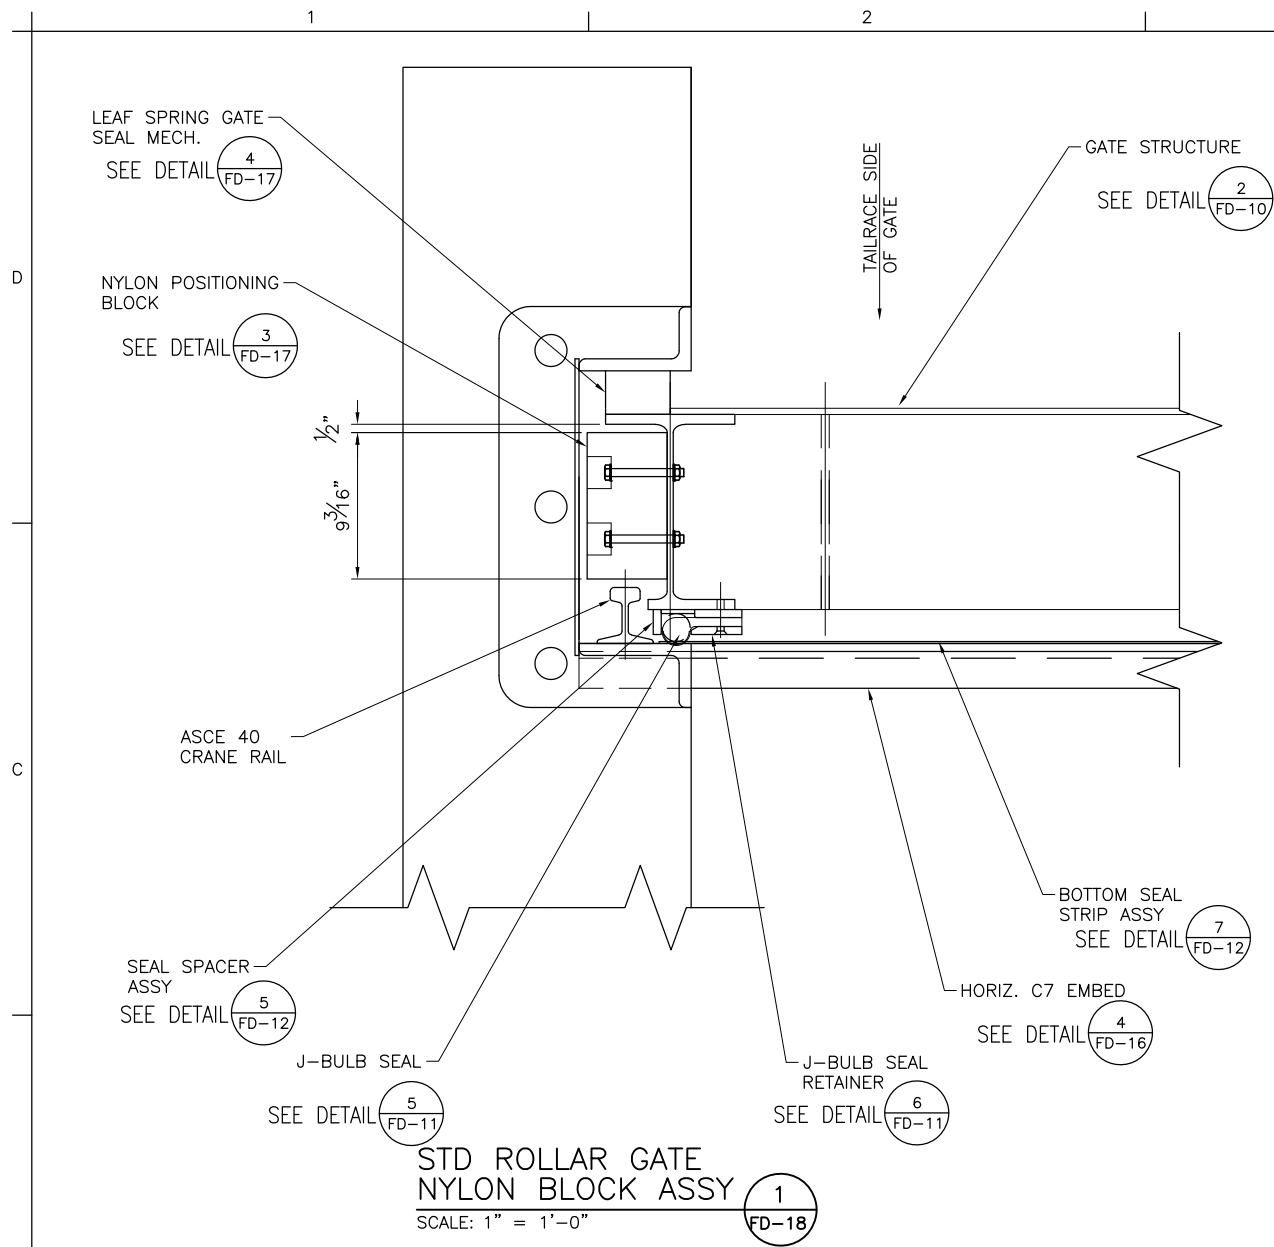

Mountain States Hydro, LLC
P.O. Box 918
Sunnyside, WA. 98944
Off: (509) 837-6822
Fax: (509) 837-6801

 SORENSEN ENGINEERING	PROJECT	DRAWING NUMBER	D
 ALWAYS THINK SAFETY	PROJECT	SOUTHEASTERN COLORADO WATER ACTIVITY ENTERPRISE PUEBLO DAM HYDROELECTRIC PROJECT FABRICATED DETAILS - ROLLER GATE DETAILS	C
AS CONSTRUCTED 2019	DESCRIPTION	REV NO YYYY-MM-DD NAME, PROJ, APPR.	B
FABRICATED DETAILS - ROLLER GATE DETAILS	FD-18	A	