


12596 W. BAYAUD AVE., STE. 300
LAKEWOOD, CO 80228
303.971.0030
LampRynearson.com

FOR CONSTRUCTION

CHWCSD SHEEP MOUNTAIN AUGMENTATION FACILITY
HUIERFANO COUNTY, COLORADO

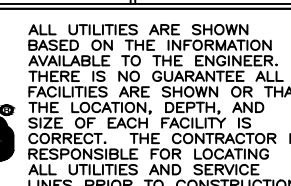

REVISIONS

1. ADDENDUM – 7/16/2020

ISSUED FOR CONSTRUCTION 08-03-2020

DESIGNER / DRAFTER

JPM

DATE 08/07/2000

08/07/2020
PROJECT NUMBER

0414076

BOOK AND PAGE

SHEET

5 OF 13

