

MAC
WHE



COLORADO DIVISION OF RECLAMATION, MINING AND SAFETY

1313 Sherman Street, Room 215, Denver, Colorado 80203 ph(303) 866-3567

TR02

REQUEST FOR TECHNICAL REVISION (TR) COVER SHEET

File No.: M- 1982-086 Site Name: Fairplay Site

County Park TR# _____ (DRMS Use only)

✓ Permittee: Alpine Rock Company

Operator (If Other than Permittee): _____

✓ Annual Fee/Report/Map

Permittee Representative: Mark Martin

✓ Violations

MV1986076 10/29/1986

MV1990064 7/2/1990

Please provide a brief description of the proposed revision: _____

This is not a change in the permit. However, it is updating the Mining Plan map. Ponds on site are pre-1981.

We are also updating the Reclamation Plan leveling the dredged rock to the approximate existing contours of the ground.

As defined by the Minerals Rules, a Technical Revision (TR) is: "a change in the permit or application which does not have more than a minor effect upon the approved or proposed Reclamation or Environmental Protection Plan." The Division is charged with determining if the revision as submitted meets this definition. If the Division determines that the proposed revision is beyond the scope of a TR, the Division may require the submittal of a permit amendment to make the required or desired changes to the permit.

The request for a TR is not considered "filed for review" until the appropriate fee is received by the Division (as listed below by permit type). Please submit the appropriate fee with your request to expedite the review process. After the TR is submitted with the appropriate fee, the Division will determine if it is approvable within 30 days. If the Division requires additional information to approve a TR, you will be notified of specific deficiencies that will need to be addressed. If at the end of the 30 day review period there are still outstanding deficiencies, the Division must deny the TR unless the permittee requests additional time, in writing, to provide the required information.

There is no pre-defined format for the submittal of a TR; however, it is up to the permittee to provide sufficient information to the Division to approve the TR request, including updated mining and reclamation plan maps that accurately depict the changes proposed in the requested TR.


Required Fees for Technical Revision by Permit Type - Please mark the correct fee and submit it with your request for a Technical Revision.

<u>Permit Type</u>	<u>Required TR Fee</u>	<u>Submitted</u> (mark only one)
110c, 111, 112 construction materials, and 112 quarries	\$216	☒
112 hard rock (not DMO)	\$175	☐
110d, 112d(1, 2 or 3)	\$1006	☐

RECEIVED

AUG 27 2015

DIVISION OF RECLAMATION,
MINING AND SAFETY

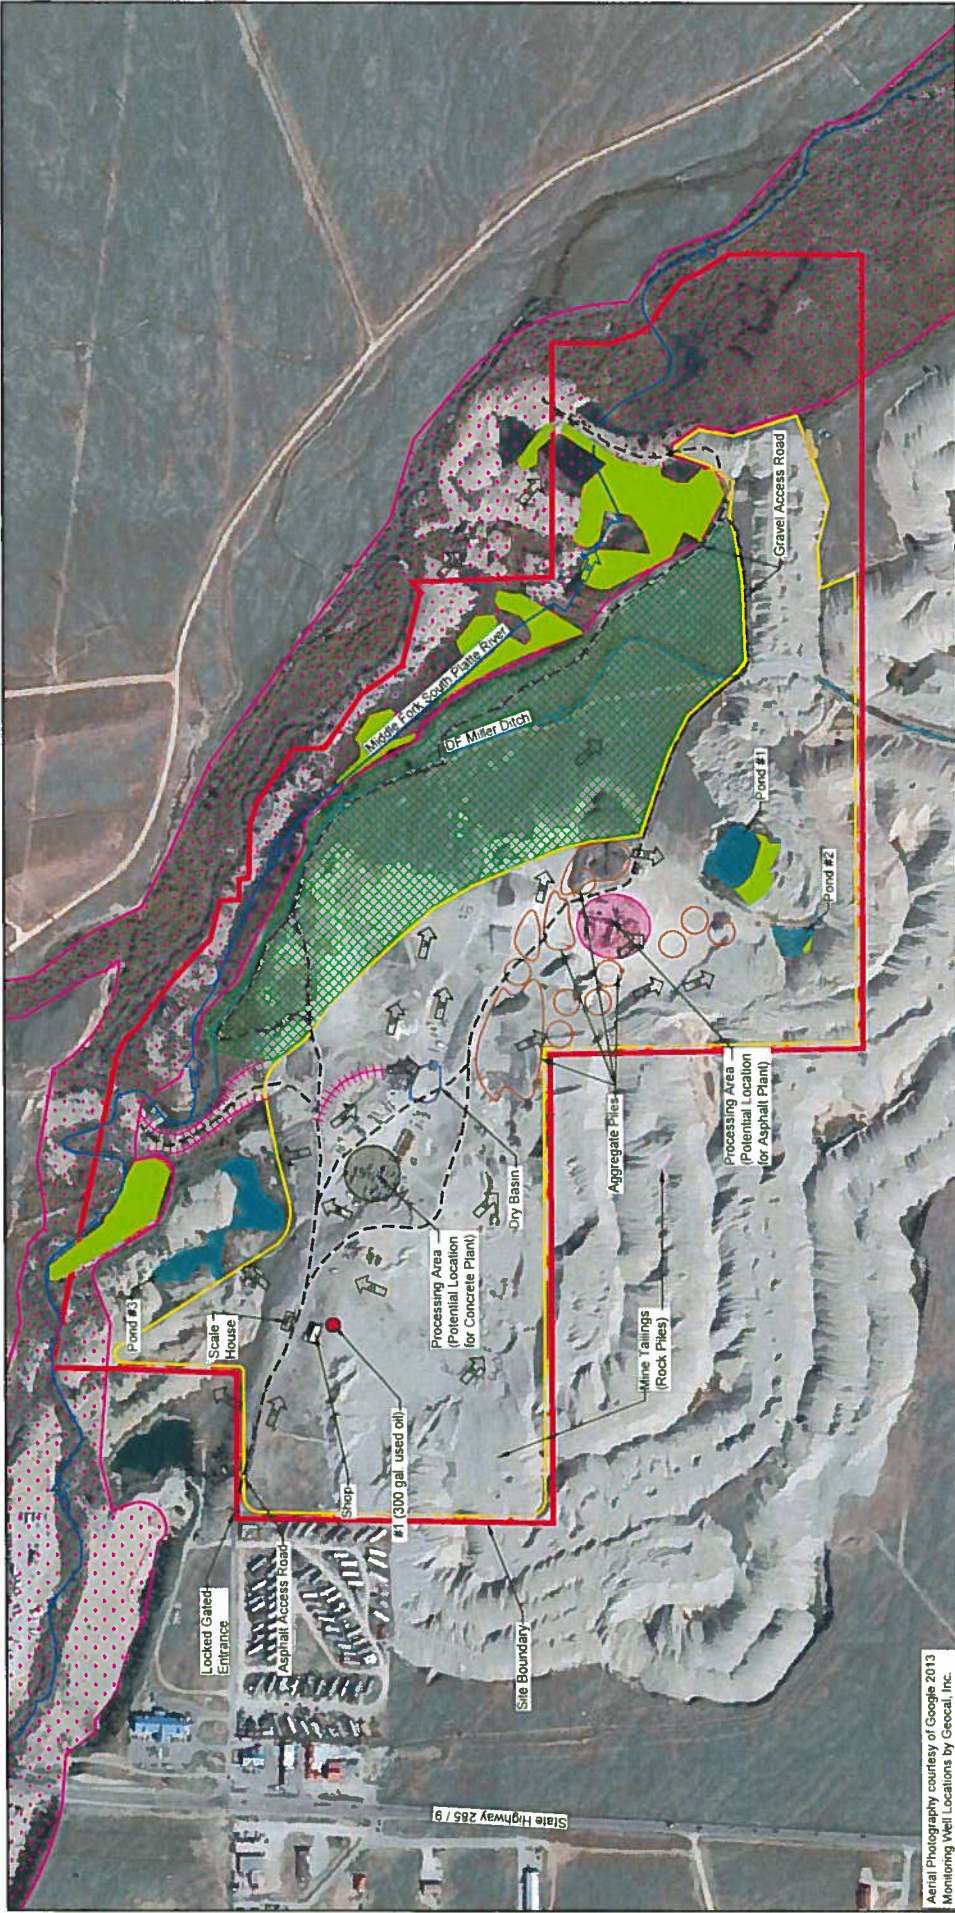

Aerial Photography courtesy of Google 2013
Monitoring Well Locations by Geocal, Inc.

LEGEND

- Site Boundary - 217 Acres
- Mining Boundary - 144 Acres
- Flood Plain Boundary
- Emergent Wetland
- Vegetative Buffer
- Potential Concrete Plant Location
- Middle Fork South Platte River
- DF Miller Ditch
- Rock Berm
- Asphalt Paved Access Road
- Gravel Access Road
- Directional Flow Arrow

Pond Locations - Pre-1981 (All pond locations are pre-1981)

- Aggregate Piles
- Aboveground Storage Tank (AST) Location
- Potential Concrete Plant Location
- Potential Concrete Plant Location

Scale

0 500

Approximate Scale in Feet

Job No. 108-320-01.6314

Reviewed By: KRT

Date: August 18, 2015

Drawn By: AMV

Figure 3

MINING PLAN MAP

Permit # M-1982-086

Fairplay Facility


22254 Highway 285

Fairplay, Colorado

RECEIVED

AUG 27 2015

DIVISION OF RECLAMATION,
MINING AND SAFETY

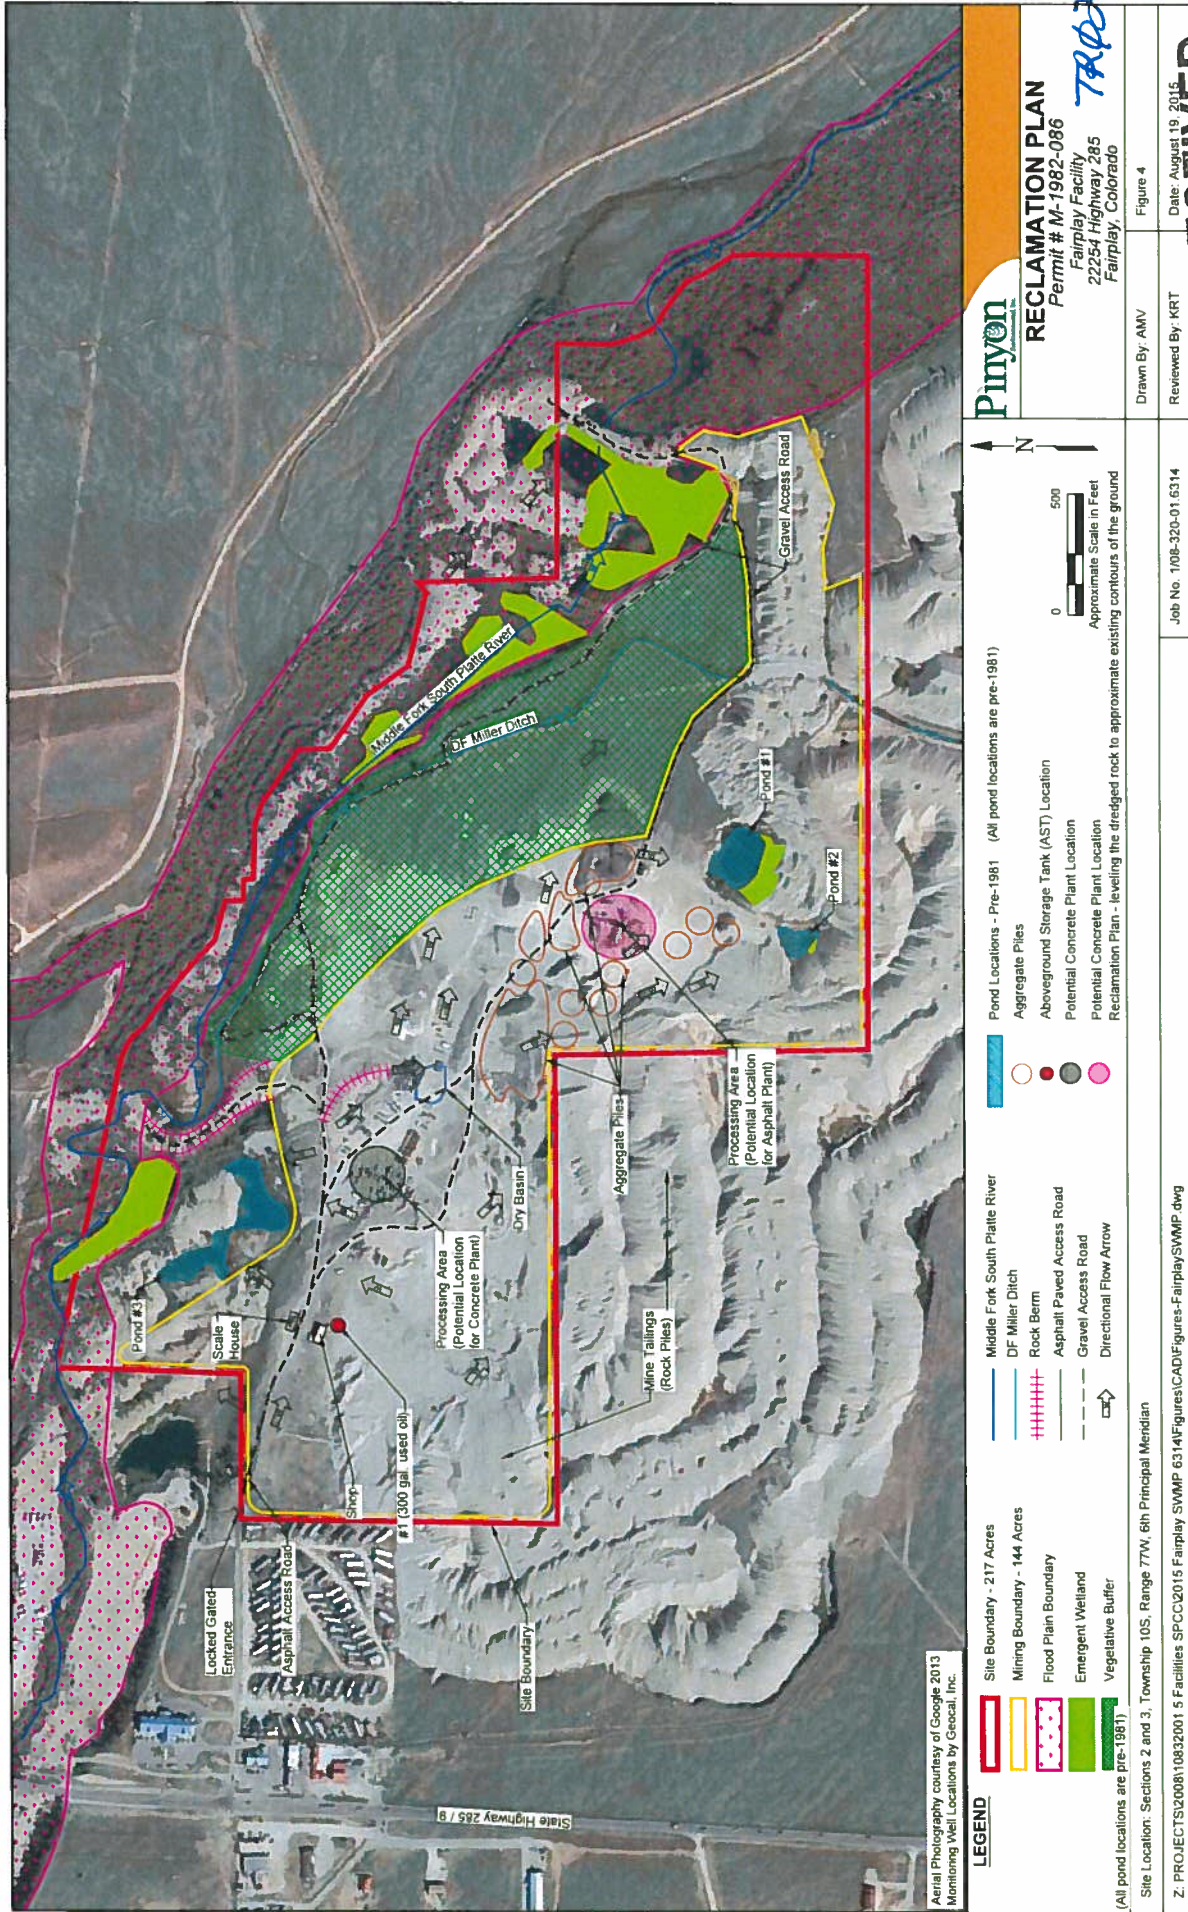

AUG 27 2015

DIVISION OF RECLAMATION,
MINING AND SAFETY

Division of Reclamation, Mining, and Safety

Fee Receipt for M1982086

Alpine Rock Company

000000000

Receipt #: 20160

Date: 08/27/2015

Permit: M1982086

Payment Method	Revenue Code	Fee Description/Notes	Amount
211231 msr	4300-MTR0	Minerals Technical Revision M1982-086 Paid by APC	\$216.00
Receipt Total:			\$216.00