
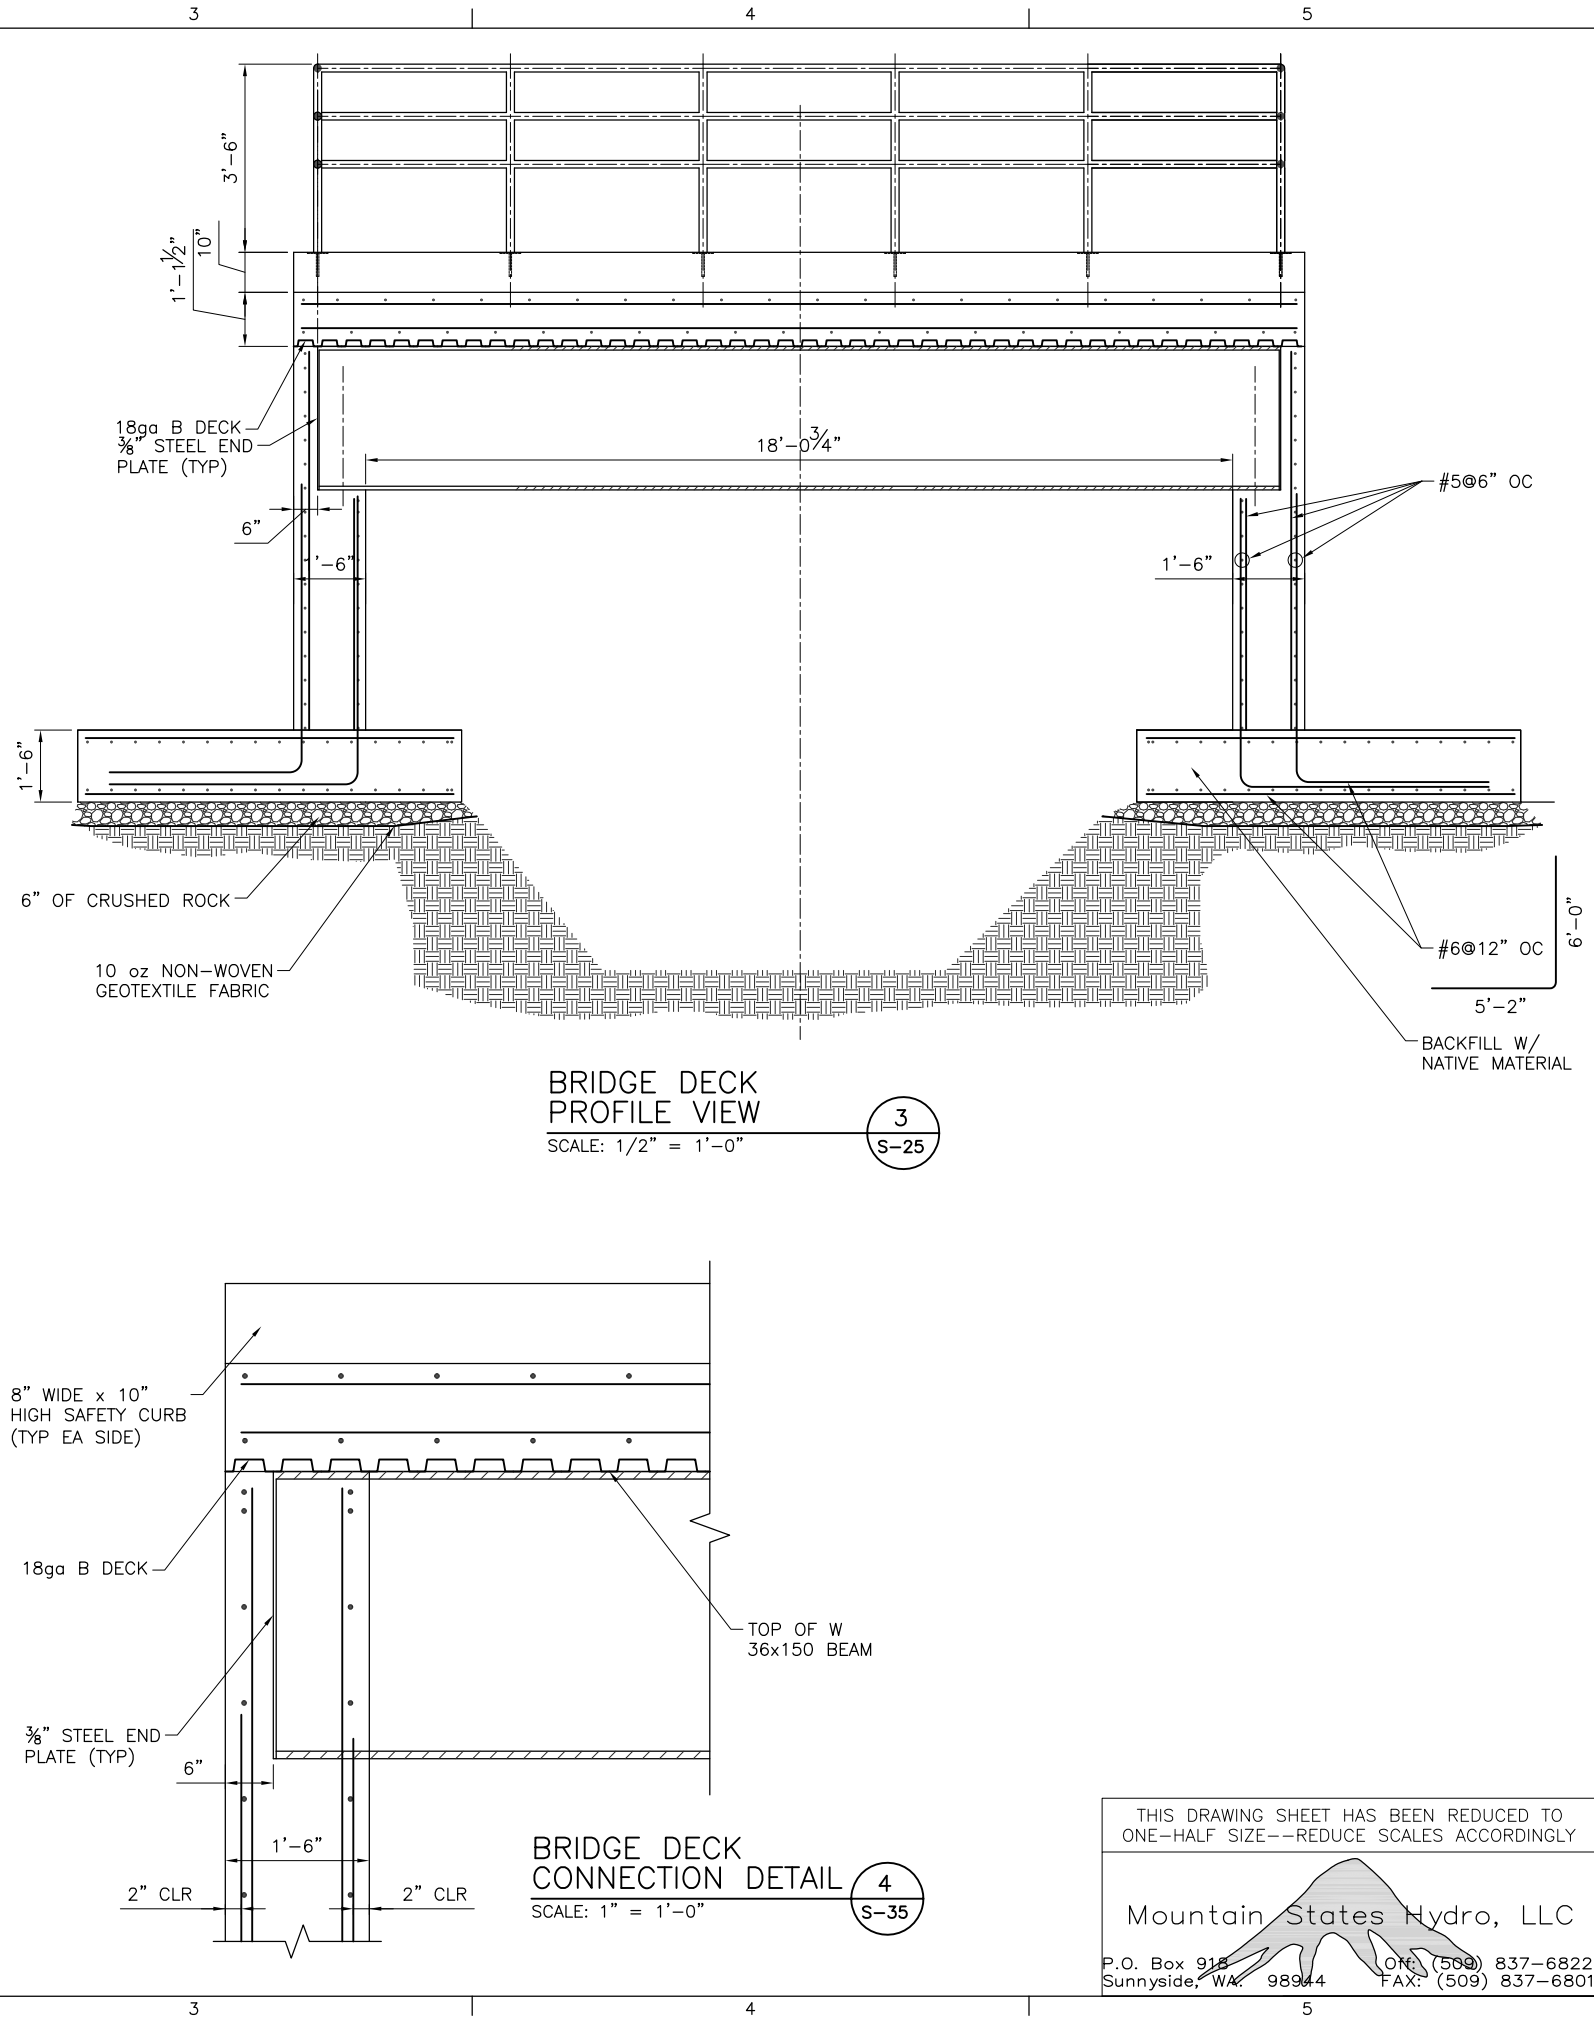


CAD SYSTEM
AUTOCAD
STRUCTURE T2-23-14.DWG
DATE AND TIME PLOTTED
August 10, 2015 13:58
PLOTTED BY
MOJ

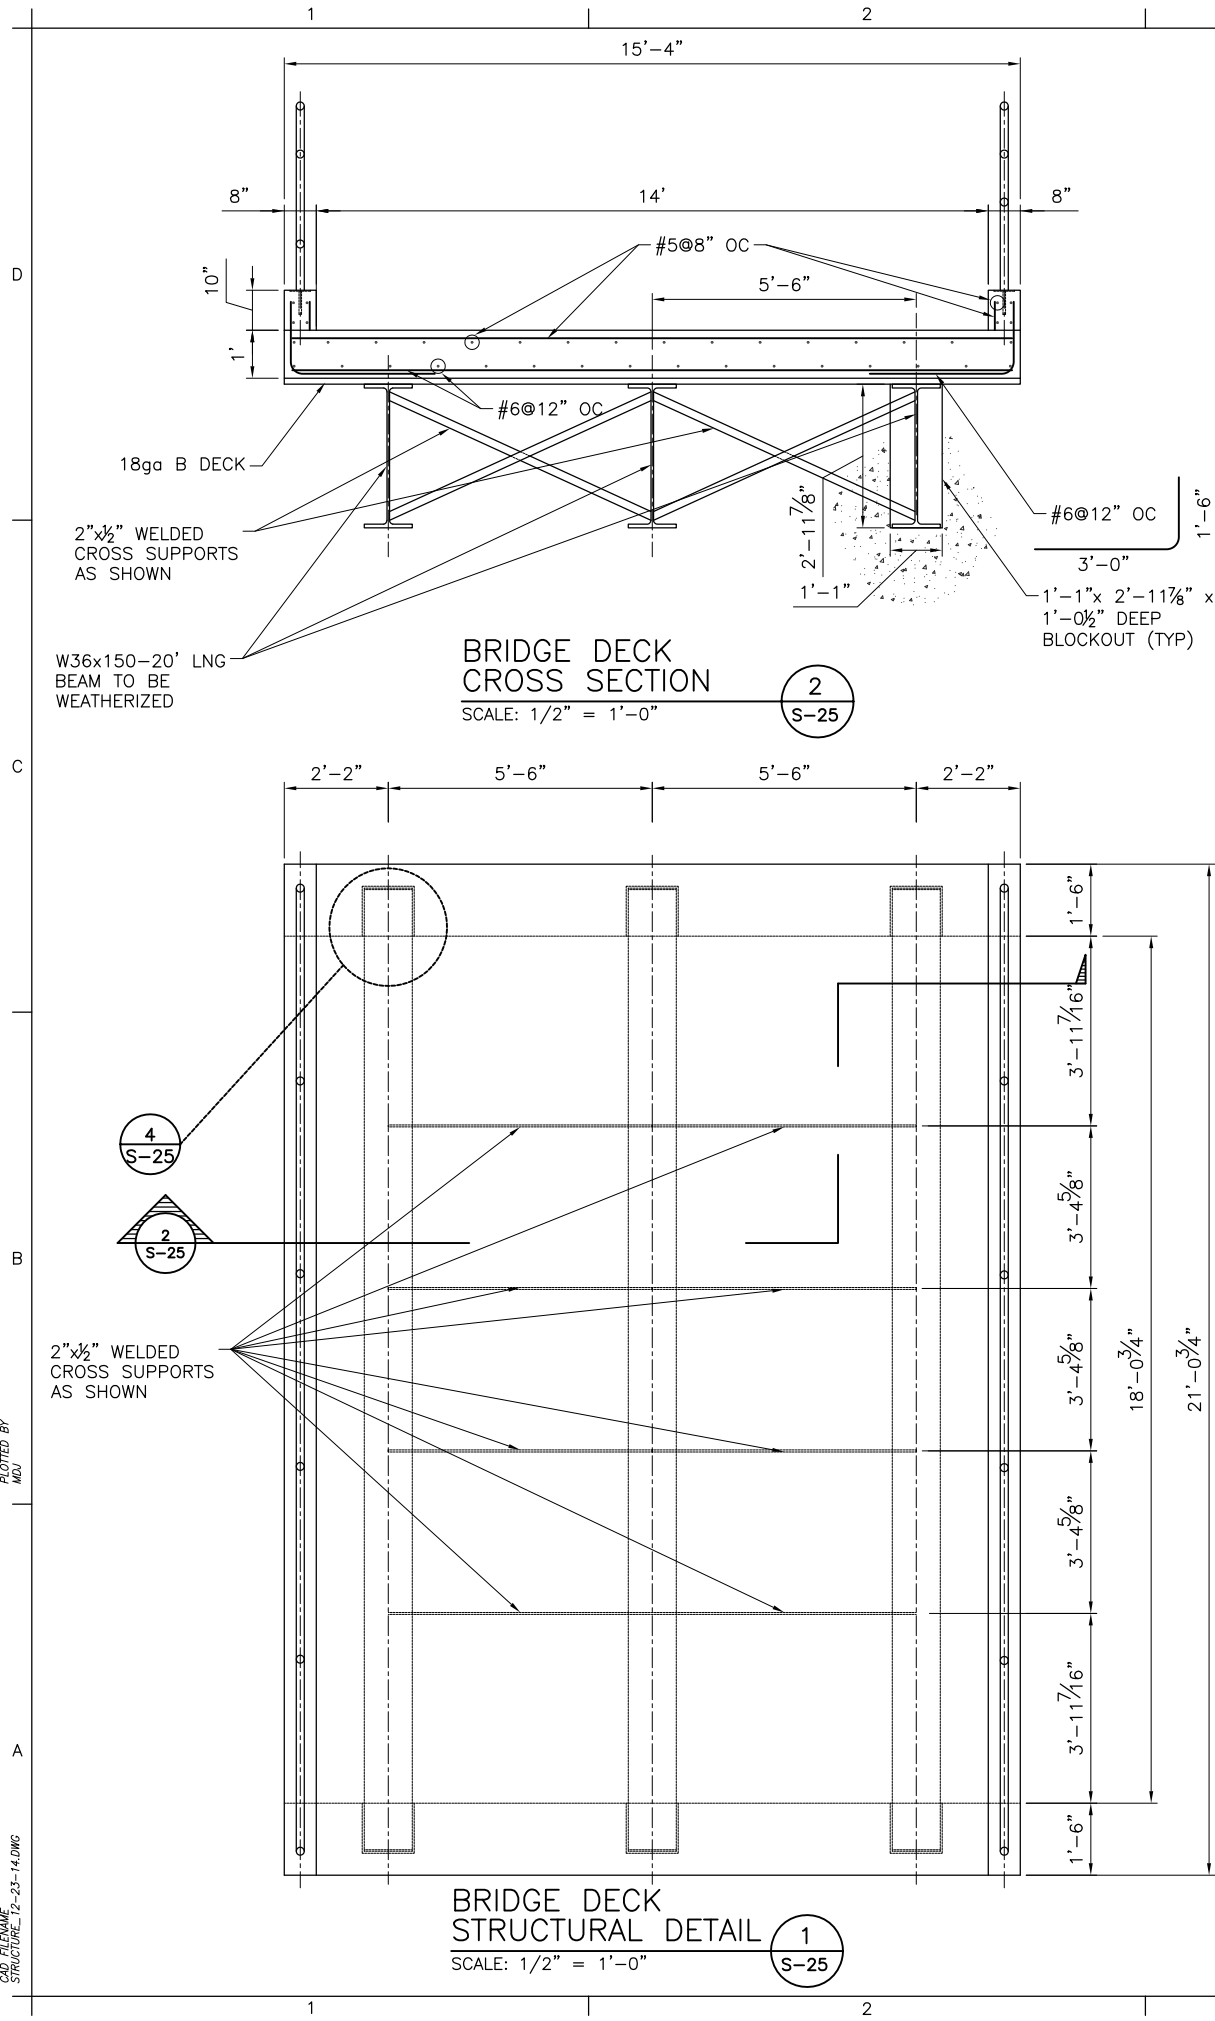

THIS DRAWING SHEET HAS BEEN REDUCED TO
ONE-HALF SIZE--REDUCE SCALES ACCORDINGLY

Mountain States Hydro, LLC

P.O. Box 918
Sunnyside, WA. 98944

OFF: (509) 837-6822
FAX: (509) 837-6801

SORENSEN ENGINEERING CONSULTING ENGINEERS IDAHO FALLS, IDAHO		PROJECT HYDROELECTRIC PROJECT SHAVANO FALLS HYDROELECTRIC FACILITIES	DRAWING NUMBER AS-BUILT AUG. 2015
ALWAYS THINK SAFETY		PROJECT SHAVANO FALLS HYDROELECTRIC PROJECT MOUNTAIN STATES HYDRO HYDROELECTRIC FACILITIES JUTTEN BRIDGE DECK DETAILS	
		DESCRIPTION JUTTEN BRIDGE DECK DETAILS	
		PROFESSIONAL REGISTERED 7-28-14 45130	
		S-25	

DATE AND TIME PLOTTED
August 10, 2015 13:58
PLOTTED BY
MJO


CAD SYSTEM
AUTOCAD
STRUCTURE-T2-23-14.DWG

D

C

B

A

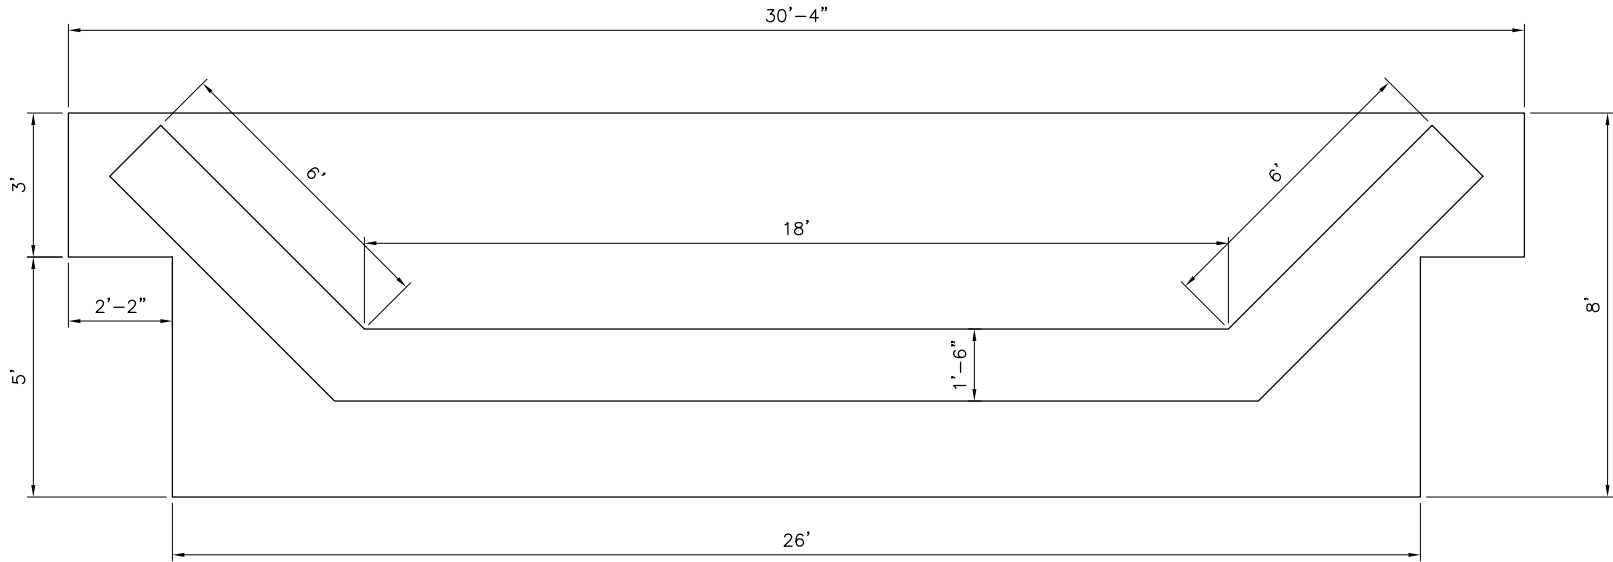

THIS DRAWING SHEET HAS BEEN REDUCED TO
ONE-HALF SIZE--REDUCE SCALES ACCORDINGLY

Mountain States Hydro, LLC

P.O. Box 918 Sunnyside, WA. 98944 OFF: (509) 837-6822 FAX: (509) 837-6801



7-28-14

JUTTEN BRIDGE DECK
DETAILS

S-26



ALWAYS THINK SAFETY

PROJECT
SHAVANO FALLS HYDROELECTRIC PROJECT
MOUNTAIN STATES HYDRO
HYDROELECTRIC FACILITIES
JUTTEN BRIDGE DECK
DETAILS

SORENSEN ENGINEERING
CONSULTING ENGINEERS
IDAHO FALLS, IDAHO

PROJECT
HYDROELECTRIC PROJECT
SHAVANO FALLS
HYDROELECTRIC FACILITIES

AS-BUILT AUG. 2015

DRAWING NUMBER

D

C

B

A