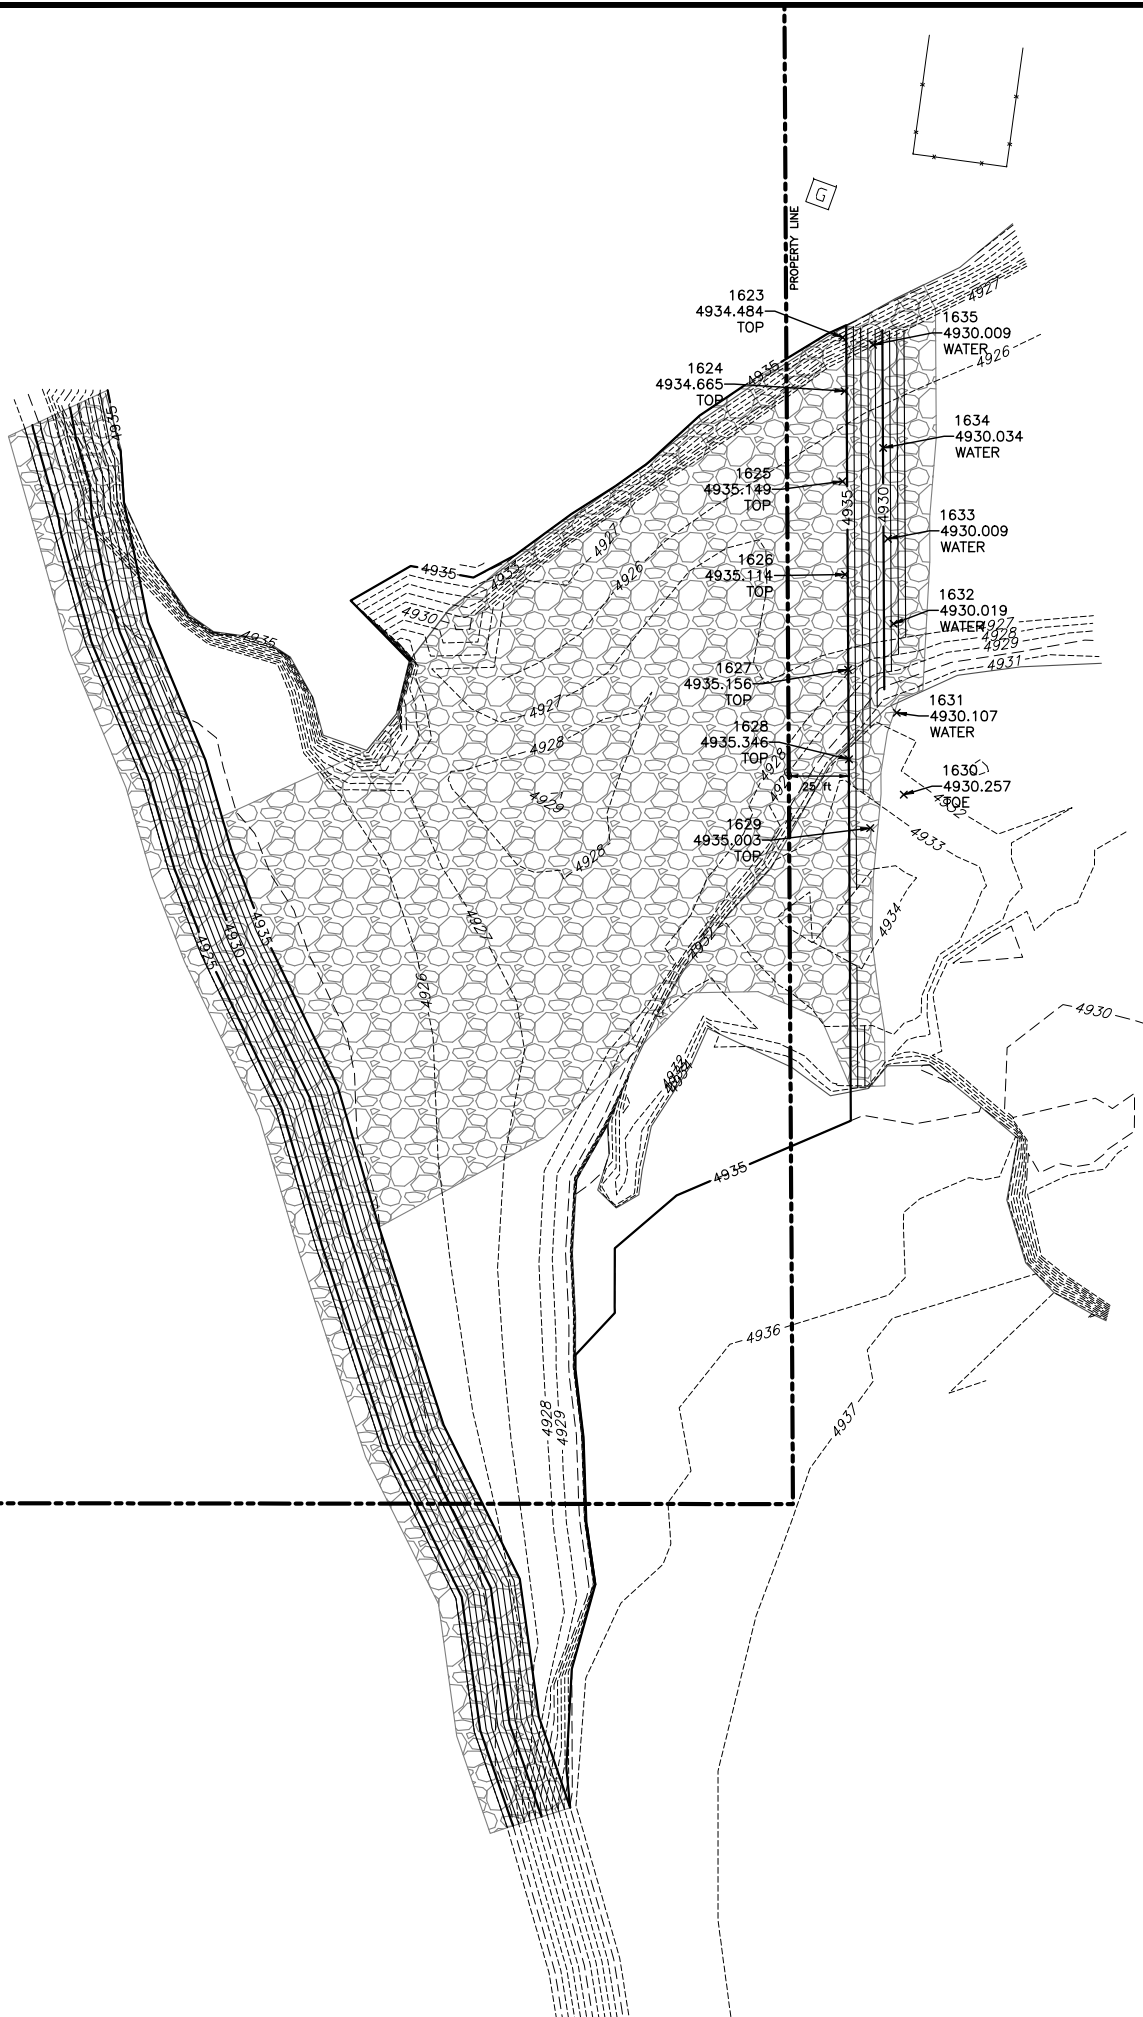
[illegible]

Job #	15127
Date	7.23.15
Drawn By	TPY
Designed By	TPY
Checked By	JCY
File	JT-Platte Breach2
Scale	1"=30'

Sheet: **1** Of: **1**

PERRY PIT

South Platte River East Bank Flood Repair

J&T Consulting, Inc.
305 Denver Avenue - Suite D
Fort Lupton CO 80621
Ph: 303-857-6222 Fax: 303-857-6224
www.jtconsulting.com



Perry Pit Inspection Report 2/24/16

JC York <jcyork@j-tconsulting.com>

Thu, Apr 21, 2016 at 4:13 PM

To: "Hays - DNR, Peter" <peter.hays@state.co.us>

Cc: Chris Zadel <chrisz@ncconstructors.com>

Peter –

Attached is the updated as-built drawing for the breach repair. We had to add some fill to the slope to make the setback the correct width of 25 feet. Please refer to the attached drawing for the dimensions from the property line and also the as-built elevation shots. Let me know if you have any questions.

Regards,

J.C.

J.C. York, P.E.

J&T Consulting, Inc.

305 Denver Avenue, Suite D

Fort Lupton, CO 80621

Office: (303) 857-6222

Mobile: (970) 222-9530

FAX: (303) 857-6224

From: Hays - DNR, Peter [mailto:peter.hays@state.co.us]

Sent: Friday, February 26, 2016 2:10 PM

To: J.C. York, P.E.

Subject: Re: Perry Pit Inspection Report 2/24/16

[Quoted text hidden]



250K