



G:\3174637-01\65CAD\Golden Wonder Mine_As-Built.dwg PLOT DATE 2017-9-28 14:40 SAVED DATE 2017-09-28 14:39 USER: jacarter

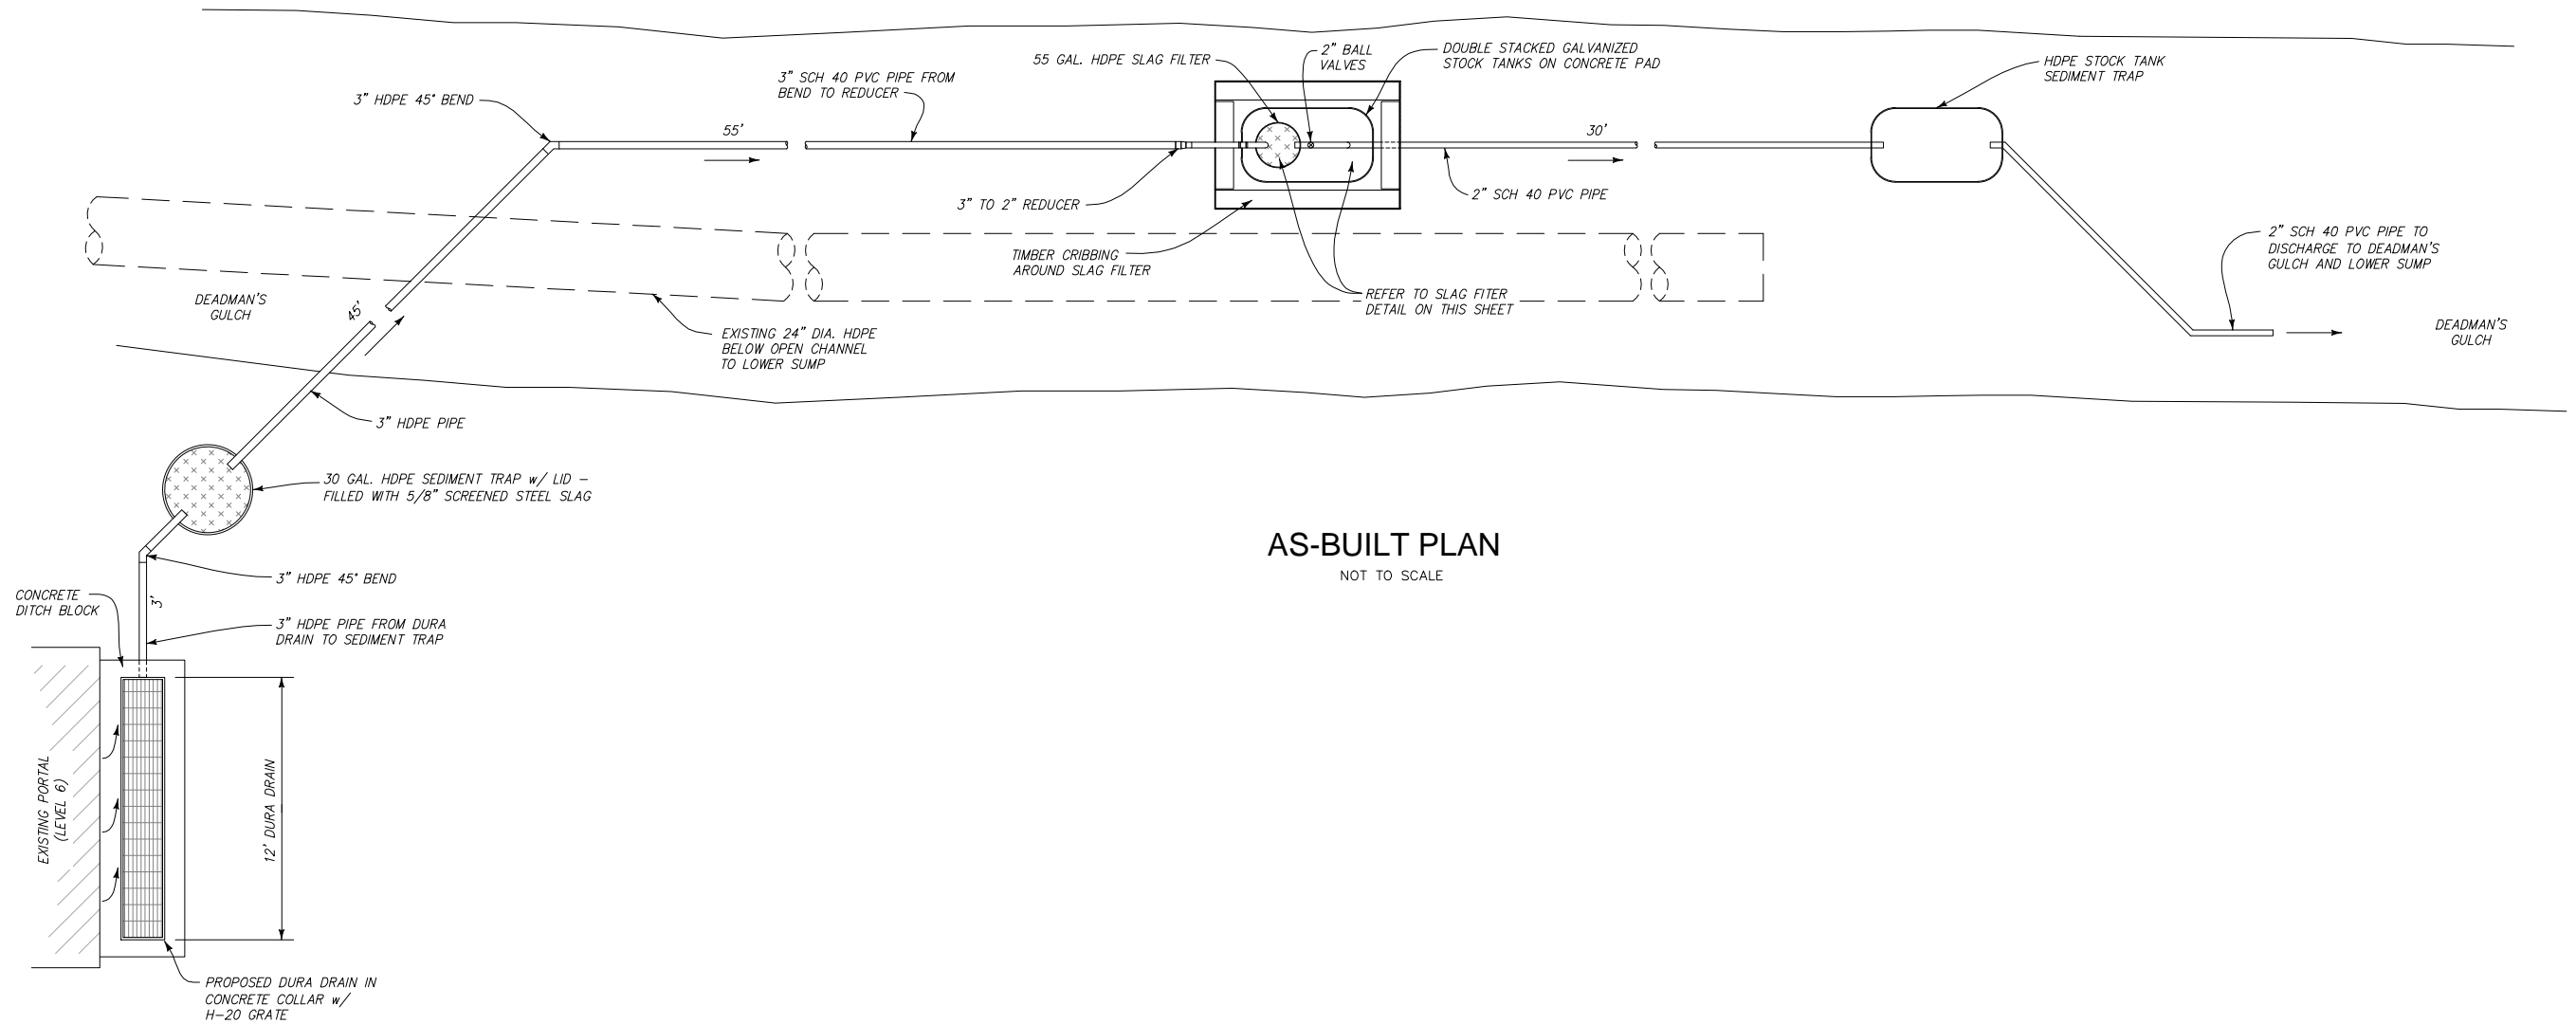

AS-BUILT PLAN
NOT TO SCALE

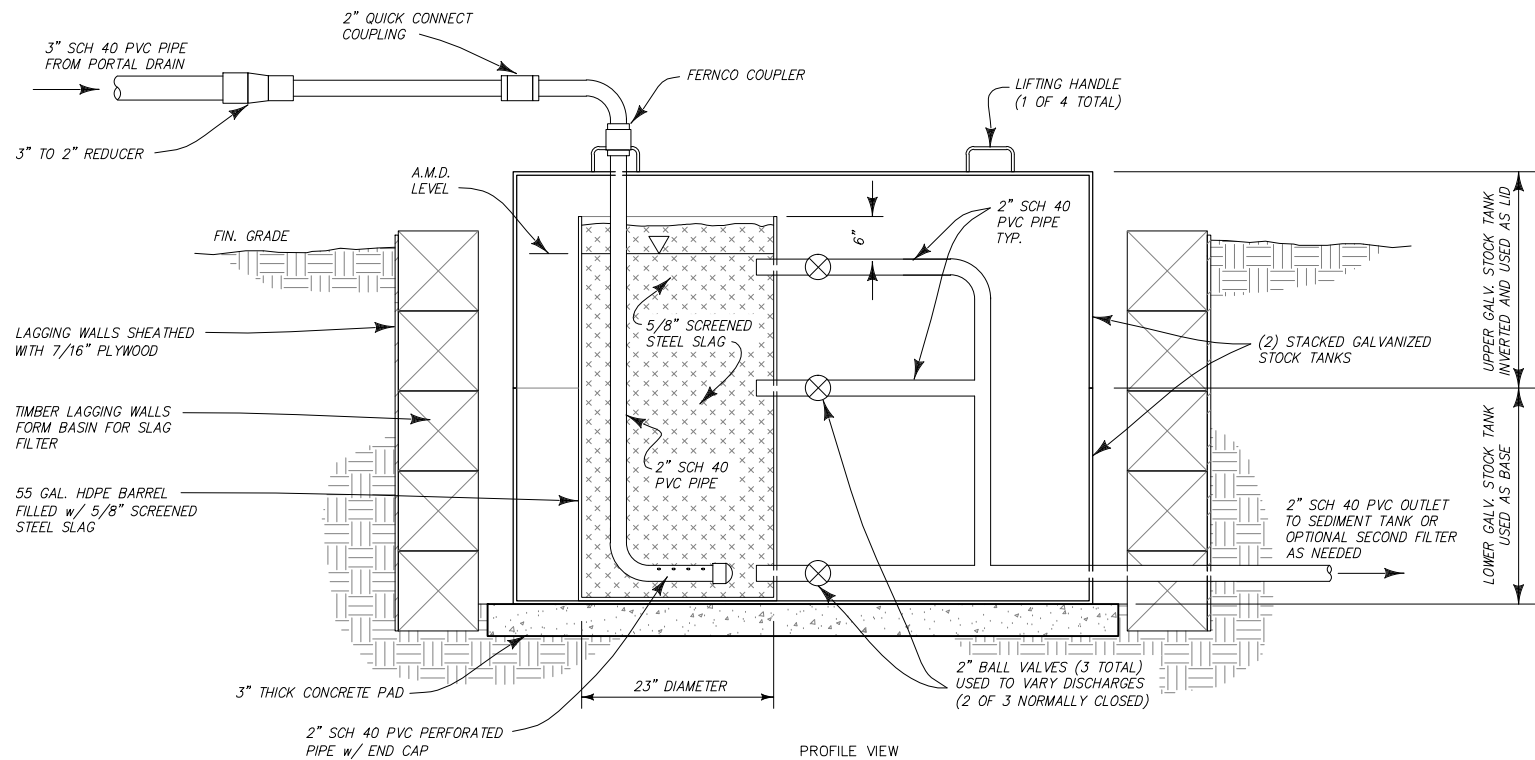


PROFILE VIEW
SLAG FILTER DETAIL
NOT TO SCALE

NOTES :

1. "3/4 INCH" STEEL SLAG FROM HARSCO IS ACTUALLY MATERIAL GREATER THAN 3/4", UP TO 3+ INCHES IN DIAMETER. GOLDEN WONDER STAFF HAS CRUSHED AND SCREENED THE SLAG OVER A 5/8" SCREEN TO PRODUCE A CONSISTENT PRODUCT FOR FILTRATION.

REVISIONS		DESCRIPTION	BY
REV	DATE		

**DOWL**
www.dowl.com
222 South Park Avenue
Montrose, Colorado 81401
970-249-6626

GOLDEN WONDER MINE
SLAG FILTER AND
LOWER SUMP DETAILS

PROJECT 7131.74637.01
DATE 9/28/2017