


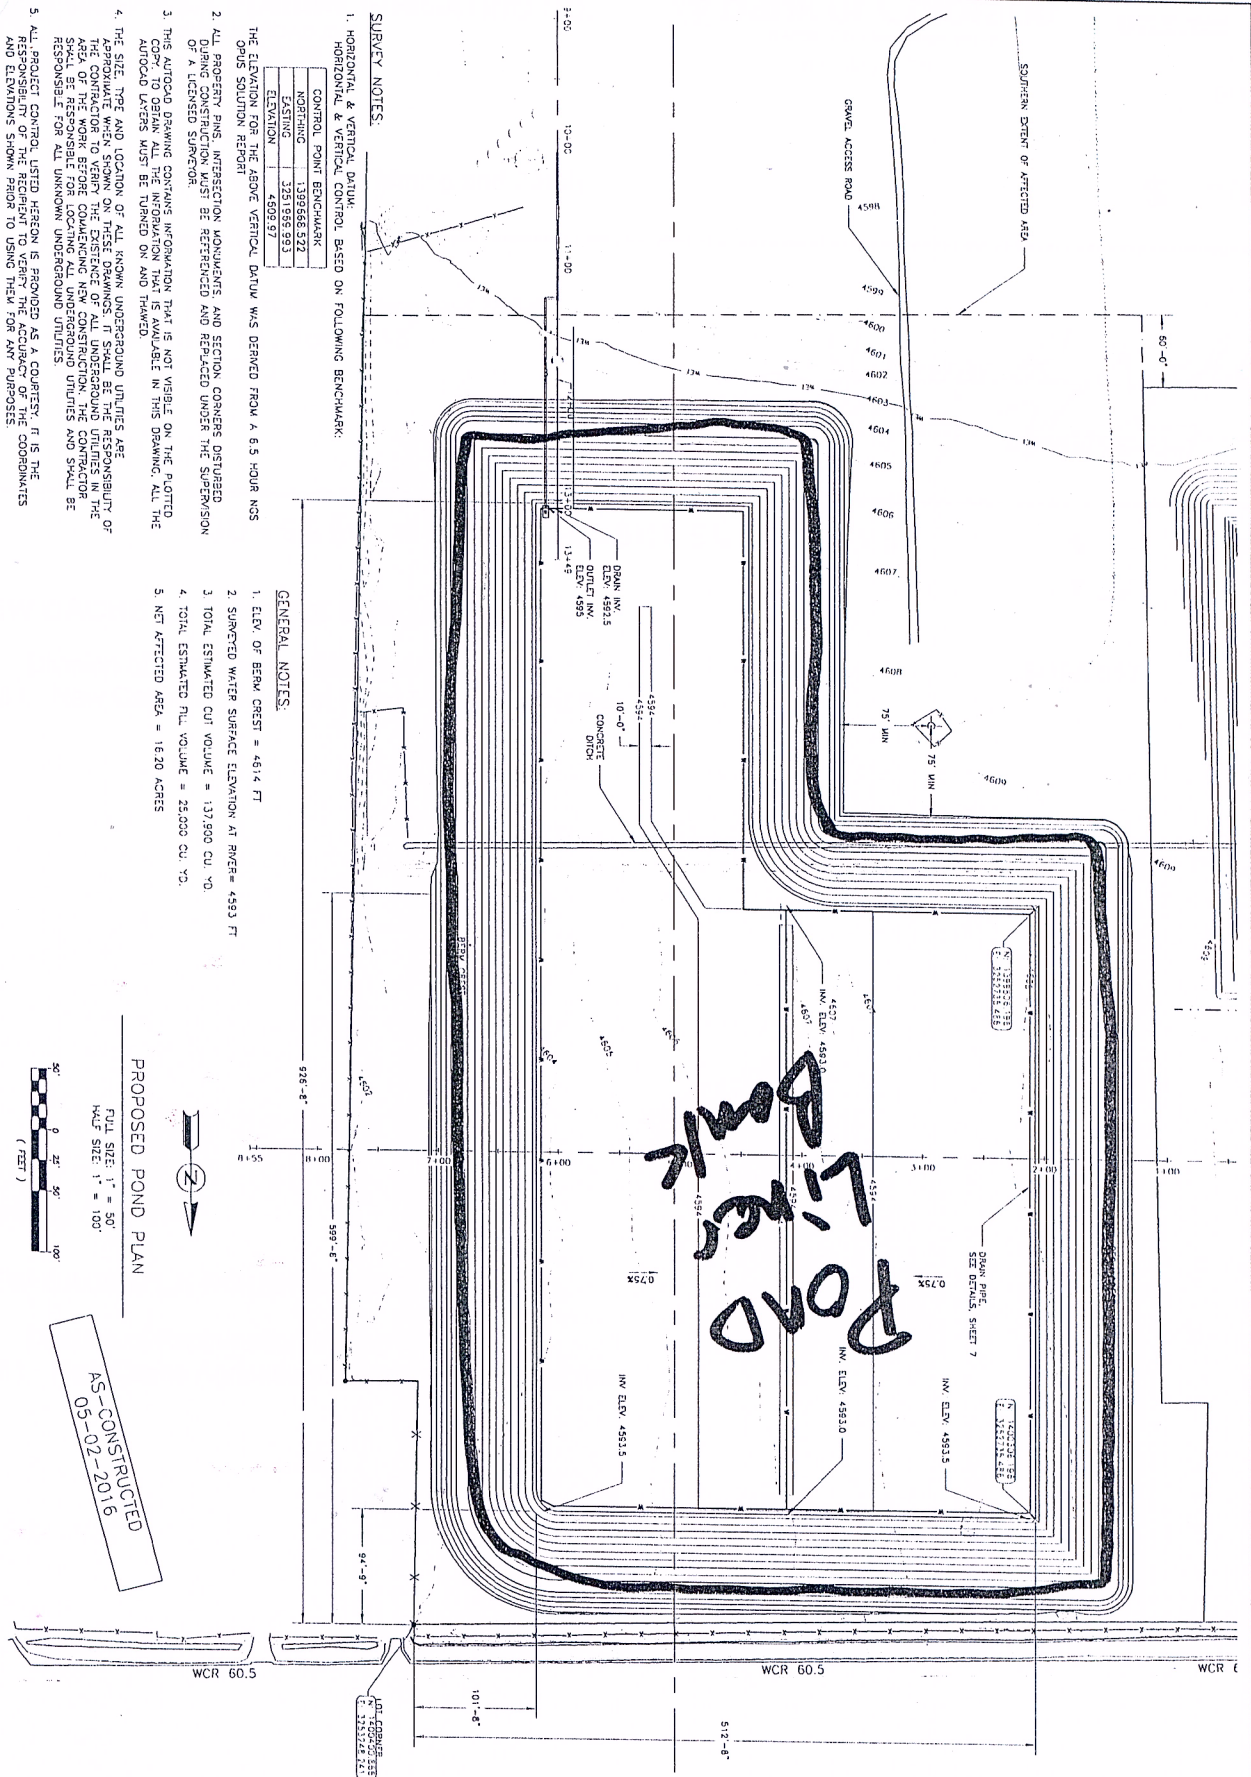

SEEDING AREA
AFFECTED AREA

NEW CACHE AGRICULTURAL POND 1
THE NEW CACHE LA POUDRE IRRIGATING COMPANY

PROPOSED POND PLAN

No.	Revisions	Date	By
1	ISSUE FOR CONSTRUCTION	05-08-15	WHS
2	OUTLET DRAIN REVISION	09-29-15	WHS
3	AS-CONSTRUCTED	05-02-20	WHS



Smith Geological & Engineering Consultants
1225 Red Cedar Circle
Fort Collins, Colorado 80524
(970) 490-2020

Drawn	Check	Design	Approved	Scale	Date	Proj. No.	No. of Sheets
10				1" = 50'	05-02-2016	14-050	1