


Legend

-  Streambank Restoration
-  Streambed
-  MA-1 as Built
-  MA-2 As Built
-  MA-5 As Built
-  Pond A as built
-  2018 mapped wetlands MA3
-  Proposed Future Mitigation

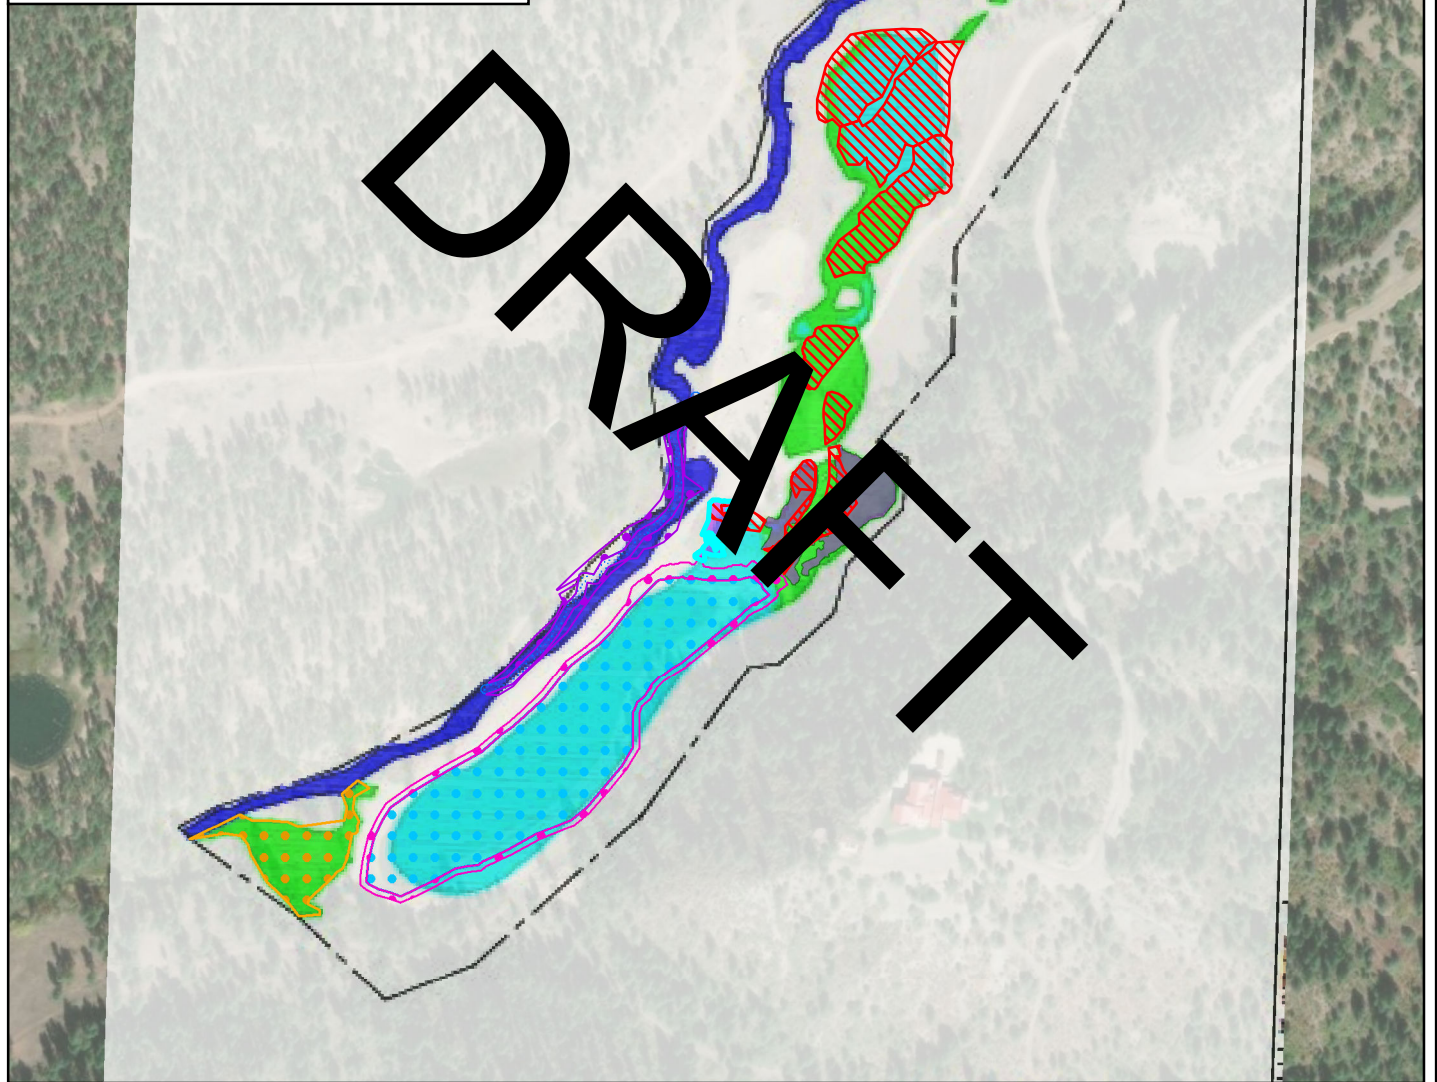

ENVIRONMENTAL CONSULTANTS

679 East 2nd Ave. Unit E2, Durango, Colorado 81301
www.sme-env.com (970) 259-9595

Drawn by:	Rvwd. by:	Project No.:
C. Casey	KZ	060002
Date:	Rsvd. Date:	Scale:
9/2/2019	NA	1" = 417'
 		
Feet		

WORKING MAP

USACE PERMIT MODIFICATION
SPK-2006-75335-DC
KEYAH GRANDE GRAVEL PIT
ARCHULETA COUNTY,
COLORADO

EXHIBIT

A