
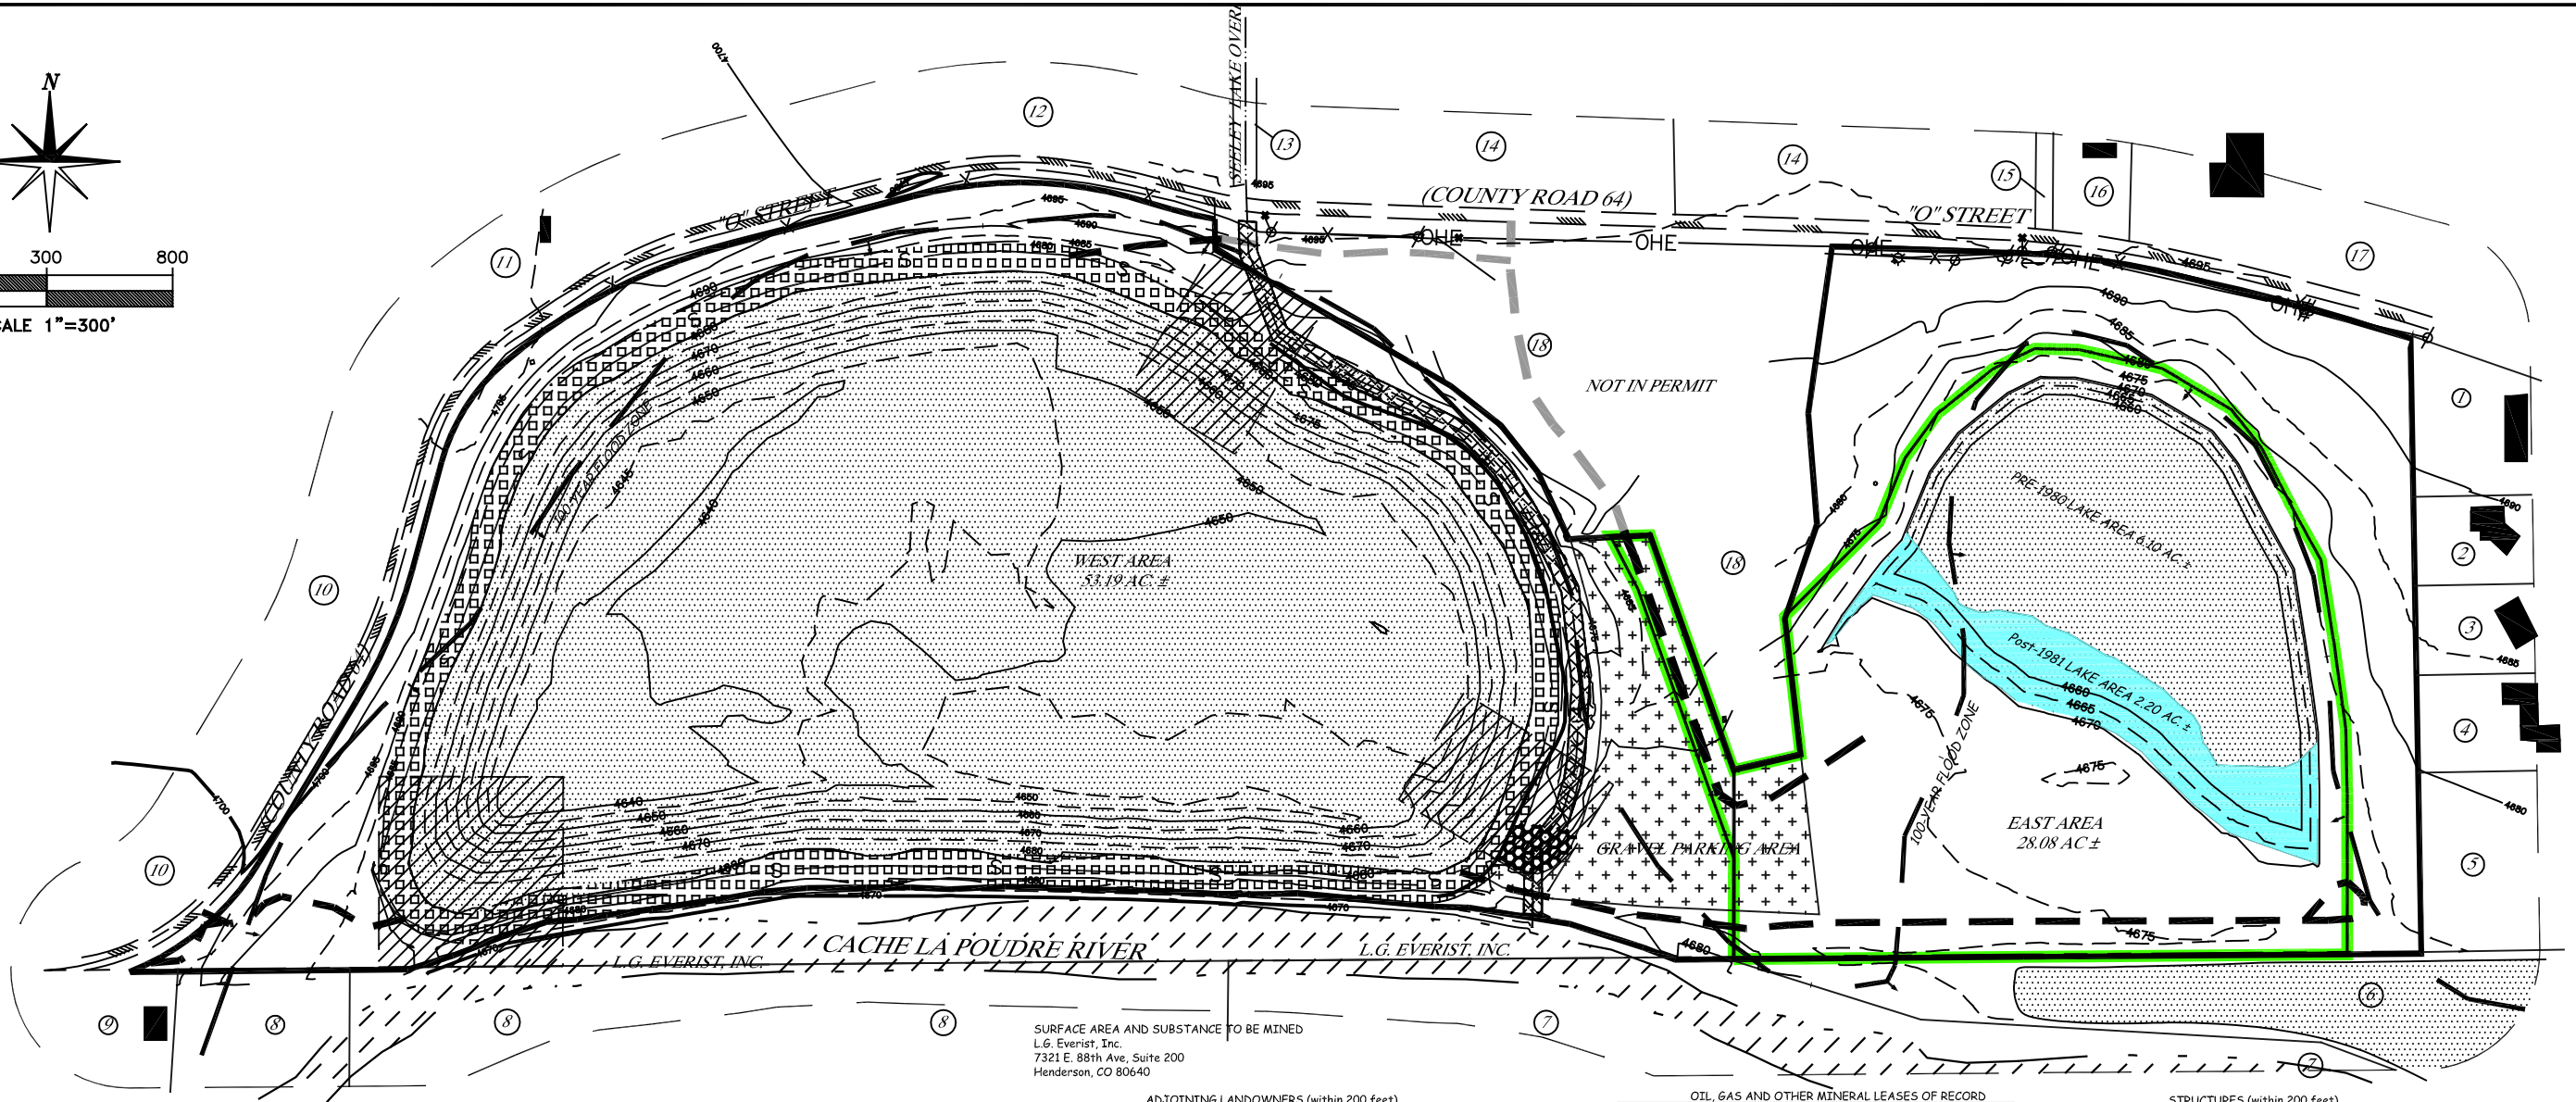


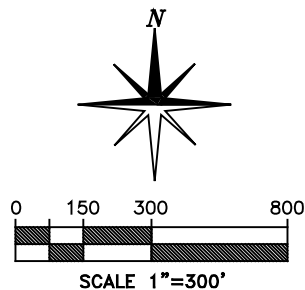

LEGEND

- PERMIT BOUNDARY/AFFECTED LANDS
- NEW PERMIT AREA - 20.1 ACRES ±
- 200 FOOT LIMIT
- FLOOD PLAIN LINE
- STAGE LINE
- TT COMMUNICATION LINES
- OHE OVERHEAD ELECTRIC LINES
- FENCE
- ROADS (OFFSITE)
- ROADS (HAUL, ACCESS) (TYP.)
- TOPO CONTOUR
- STREAM
- APPROXIMATE LOCATION OF SLURRY WALL
- BUILDINGS

- GAS/OIL WELL
- LAKE AREA
- INDUSTRIAL AREA
- OVERFLOW DITCH CORRIDOR
- RIPRAP ARMORING
- RESERVOIR FACILITY ENVELOPES
- GRAVEL PARKING AREA
- WORKING PAD
- BACKFILLED AREA

SURFACE AREA AND SUBSTANCE TO BE MINED
L.G. Everist, Inc.
7321 E. 88th Ave, Suite 200
Henderson, CO 80640

ADJOINING LANDOWNERS (within 200 feet)

- HAMIDEH ABDOLMOHAMMADZADEH & AZIZ ZANDI
1645 N 35TH AVENUE CT
GREELEY CO 806319468
- MARK D & PATRICIA L BECKER
1639 N 35TH AVENUE CT
GREELEY CO 806319468
- KAY R. COLLINS
1631 N 35 AVENUE CT
GREELEY CO 80631
- CINDY & DOUGLAS D York
1627 N 35TH AVENUE CT
GREELEY CO 806319468
- EVELYN GATSIPOPOLOS
1617 N 35TH AVENUE CT
GREELEY CO 806319468
- RIVER VIEW HOMEOWNERS ASSN.
C/O EVELYN GATSIPOPOLOS
1617 N 35TH AVENUE CT
GREELEY CO 806319468
- LAFARGE CORPORATION
C/O BADEN TAX MANAGEMENT
P.O. BOX 8040,
FORT WAYNE IN 46898-8040
- MARTIN MARIETTA MATERIALS INC
C/O BADEN TAX MANAGEMENT
PO BOX 8040,
FORT WAYNE IN 46898-8040
- DEBORAH E & MELVIN D EVERHART
4514 W O ST.
GREELEY CO 80631-9460
- DIANE E. & ELMER E. JR OESTMAN, TRUST,
1685 E 160TH AVE.
BROOMFIELD CO 80020-9116
- VISTA LAND & CATTLE LLC
4343 W O ST
GREELEY CO 80631
- S E 2 LAND LIMITED LIABILITY COMPANY
4627 W 20TH STREET RD STE A
GREELEY CO 806343203
- DEAN R & MARNE J VANDERSON
3755 W O ST
GREELEY CO 806319459
- VETERINARY PROPERTIES LLC
3765 W O ST
GREELEY CO 80631-9459
- ANDRIA L & MIKE W REICHEL
3747 W O ST
GREELEY CO 806319459
- JEFFREY C SCHWARTZ
3737 W O ST
GREELEY CO 806319459
- LINDA KAY DANIEL
2190 UNION DR
LAKEWOOD CO 802151167
- VARRA COMPANIES INC
8120 GAGE ST
FREDERICK CO 805169439

OIL, GAS AND OTHER MINERAL LEASES OF RECORD

Noble Energy
1675 Broadway Suite 2200
Denver, CO 80202

PDC Energy, Inc.
1775 Sherman St Suite 300
Denver, CO 80203

RECORDED ROW's (within 200 feet)

Ogilvy Irrigation and Land Company - ROW.
822 7th Street, Suite 706
Lucerne, CO 80631

Comcast Greeley
5779 W, 10th Street
Greeley, CO 80634

Xcel Energy (PSCO) - ROW
1500 6th Ave.
Greeley, CO 80631

North Weld County Water District
P.O. Box 56
Lucerne, CO 80646

Century Link (Qwest)
1801 California St, Suite 1160
Denver, CO 80202

City of Greeley
City Council
1000 10th St
Greeley, CO 80464

STRUCTURES (within 200 feet)

HAMIDEH ABDOLMOHAMMADZADEH & AZIZ ZANDI - house*
MARK D & PATRICIA L BECKER - house*
KAY R. COLLINS - house*
CINDY & DOUGLAS D York - house*
RIVER VIEW HOMEOWNERS ASSN. - concrete fence*
DEBORAH E & MELVIN D EVERHART - house*
VISTA LAND & CATTLE LLC - wire fence, building*
S E 2 LAND LIMITED LIABILITY COMPANY - pipe fence
VETERINARY PROPERTIES LLC - chain link fence
JEFFREY C SCHWARTZ - house*
LINDA KAY DANIEL - house*
VARRA COMPANIES INC - concrete batch plant & support building,
water well, 4 strand wire fence
L.G. EVERIST INC - 4 wire fence
OGILVY IRRIGATION AND LAND COMPANY - overflow ditch.
XCEL ENERGY - power lines
CENTURY LINK - communication lines
COMCAST - fiber optic line
NORTH WELD COUNTY WATER DISTRICT - water line
CITY OF GREELEY - city street
NOBLE ENERGY - Gas well, Gas line, separator, chain link fence
PDC ENERGY, INC. - Gas well, Gas line (abandoned 4/2014)

* STRUCTURES NOT WITHIN 200 FEET OF MINING AREA.

MAP EXHIBIT F - RECLAMATION PLAN MAP (ASBUILT)

PREPARED BY: **ENVIRONMENT, INC.**
7985 VANCE DR., # 205A
ARVADA, CO 80003
(303) 423-7297
environment_inc@outlook.com

Parts of the SE $\frac{1}{4}$ SE $\frac{1}{4}$, SW $\frac{1}{4}$ SE $\frac{1}{4}$, SE $\frac{1}{4}$ SW $\frac{1}{4}$, & SW $\frac{1}{4}$ SW $\frac{1}{4}$,
Section 26, T-6-N, R-66-W of the 6th P.M., City of
Greeley, County of Weld, State of Colorado

AMENDMENT
FOR
STAR WATER RESOURCE
PERMIT # M-1977-522

REVISIONS:	DATE:
ORIGINAL PERMIT	02/1978
AMENDMENT - AREA INCREASE	07/1994
AMENDMENT - RECLAMATION PLAN CHANGE	03/2014
TECHNICAL REVISION	02/2015
VARRA PROPERTY RELEASE	05/2015
PARTIAL RELEASE TO 6.2 AC.	07/2017



L.G. Everist, Inc.
7321 East 88th Avenue | Henderson, Colorado 80640
phone: (303) 287-4656 | fax: (303) 289-1348

DATE:	5/07/2015
FILE NAME:	SWR-C1-MAP
SCALE:	1"=400'
DRAWN BY:	DF/ENVINC
CHECKED BY:	LMS