



TRI-STATE GENERATION AND TRANSMISSION ASSOCIATION, INC.

HEADQUARTERS: P.O. BOX 33695 DENVER, COLORADO 80233-0695 303-452-6111

April 24, 2020

Mr. Zach Trujillo
Environmental Protection Specialist
Colorado Division of Reclamation, Mining & Safety
Department of Natural Resources
1313 Sherman Street, Room 215
Denver, CO 80203

**RE: Colowyo Coal Company L.P.
Permit No. C-1981-019
Technical Revision No. 137
Stoker Siding Pond**

Dear Mr. Trujillo,

Tri-State Generation and Transmission Association Inc. (Tri-State), is the parent company to Axial Basin Coal Company, which is the general partner to Colowyo Coal Company L.P. (Colowyo). Therefore, Tri-State on behalf of Colowyo technical revision 137 (TR-137) to Permit No. C-1981-019. TR-137 proposes to remove the gate valve on the Stoker Siding Pond.

Included in this technical revision are a revision application, a proposed public notice, and a change of index sheet to ease incorporation of this technical revision into the permit document. If you should have any additional questions or concerns, please feel free to contact Tony Tennyson at (970) 824-1232 at your convenience.

Sincerely,

DocuSigned by:
Daniel Casiraro
B70D69F114324DE...

Daniel J. Casiraro
Senior Manager
Environmental Services

DJC:TT:der

Enclosure

cc: Jennifer Maiolo (BLM-LSFO)
Chris Gilbreath (via email)
Tony Tennyson (via email)
Angela Aalbers (via email)
File: C. F. 1.1.2.126
G471-11.3(21)d



COLORADO DIVISION OF MINERALS AND GEOLOGY

1313 Sherman Street, Room 215, Denver, Colorado 80203, (303) 866-3567

APPLICATION FORM FOR A REVISION TO A COAL MINING AND RECLAMATION PERMIT

This form must be completed and submitted with all requests for minor revisions, as defined in Rule 1.04(73), technical revisions, as defined in Rule 1.04(136), and permit revisions, as defined in Rule 1.04(90). All revisions are to address the requirements of Rule 2.08.4. Three (3) copies of the revision, including maps, must be submitted in order for it to be complete.

All revisions are to be formatted so they can be inserted into the permit to replace the revised sections, maps, tables and/or figures, with a revised table of contents, if necessary. The revision submittal date should be printed in the lower right corner of each revision page. A cover letter to the revision should explain the nature of the revision and reference the specific permit sections being revised.

For federal mines, a copy of the revision application must be submitted to all agencies on the federal mailing list (except OSM) at the same time the application is submitted to the Division, and proof of distribution must be submitted to the Division along with the application. Copies of revision pages modified during the review process must be distributed in the same manner, along with proof of distribution. Proof of distribution must be submitted prior to implementation of the revision.

Permit No.: C - _____ - _____ **Date:** _____ / _____ / _____

Permittee: _____

Street: _____

City: _____

State: _____ **Zip Code:** _____ - _____

Brief Description of Revision: _____

Public Notice Attached: Yes ☐ No ☐ (Required for PRs and TRs)

Bond Increase: Yes ☐ No ☐ **Federal** ☐ **Non-Federal** ☐ **Mine** ☐

Proposed Change in:

Permit Area -

Disturbed (+/-) _____ . _____ Acres

Permit (+/-) _____ . _____ Acres

Affected (+/-) _____ . _____ Acres

Surface Ownership -

Private Land (+/-) _____ . _____ Acres

Federal Land (+/-) _____ . _____ Acres

State Land (+/-) _____ . _____ Acres

Mineral Ownership -

Mineral Private (+/-) _____ . _____ Acres

Mineral Federal (+/-) _____ . _____ Acres

Mineral State (+/-) _____ . _____ Acres

CHANGE SHEET FOR PERMIT REVISIONS, TECHNICAL REVISION, AND MINOR REVISIONS

Mine Company Name: Colowyo Coal Company

Permit Number: **C-1981-019**

Date: **April 23, 2020**

Revision Description: **TR-137 Stoker Siding Pond**

Volume Number	Page, Map or other Permit Entry to be REMOVED	Page, Map or other Permit Entry to be ADDED	Description of Change
1			No Change
2A			No Change
2B			No Change
2C			No Change
2D	Stoker Siding Pond As-Built Drawing (1 page)	Stoker Siding Pond As-Built Drawing (1 page)	Stoker Siding As-Built has been updated.
2E			No Change
3			No Change
4			No Change
4			No Change
5A			No Change
5B			No Change
6			No Change
7			No Change
8			No Change
9			No Change
10			No Change
12			No Change
13			No Change
14			No Change
15			No Change
16			No Change
17			No Change
18A			No Change
18B			No Change
18C			No Change

CHANGE SHEET FOR PERMIT REVISIONS, TECHNICAL REVISION, AND MINOR REVISIONS




Mine Company Name: Colowyo Coal Company

Permit Number: **C-1981-019**

Date: **April 23, 2020**


Revision Description: **TR-137 Stoker Siding Pond**

Volume Number	Page, Map or other Permit Entry to be REMOVED	Page, Map or other Permit Entry to be ADDED	Description of Change
18D			No Change
19			No Change
20			No Change

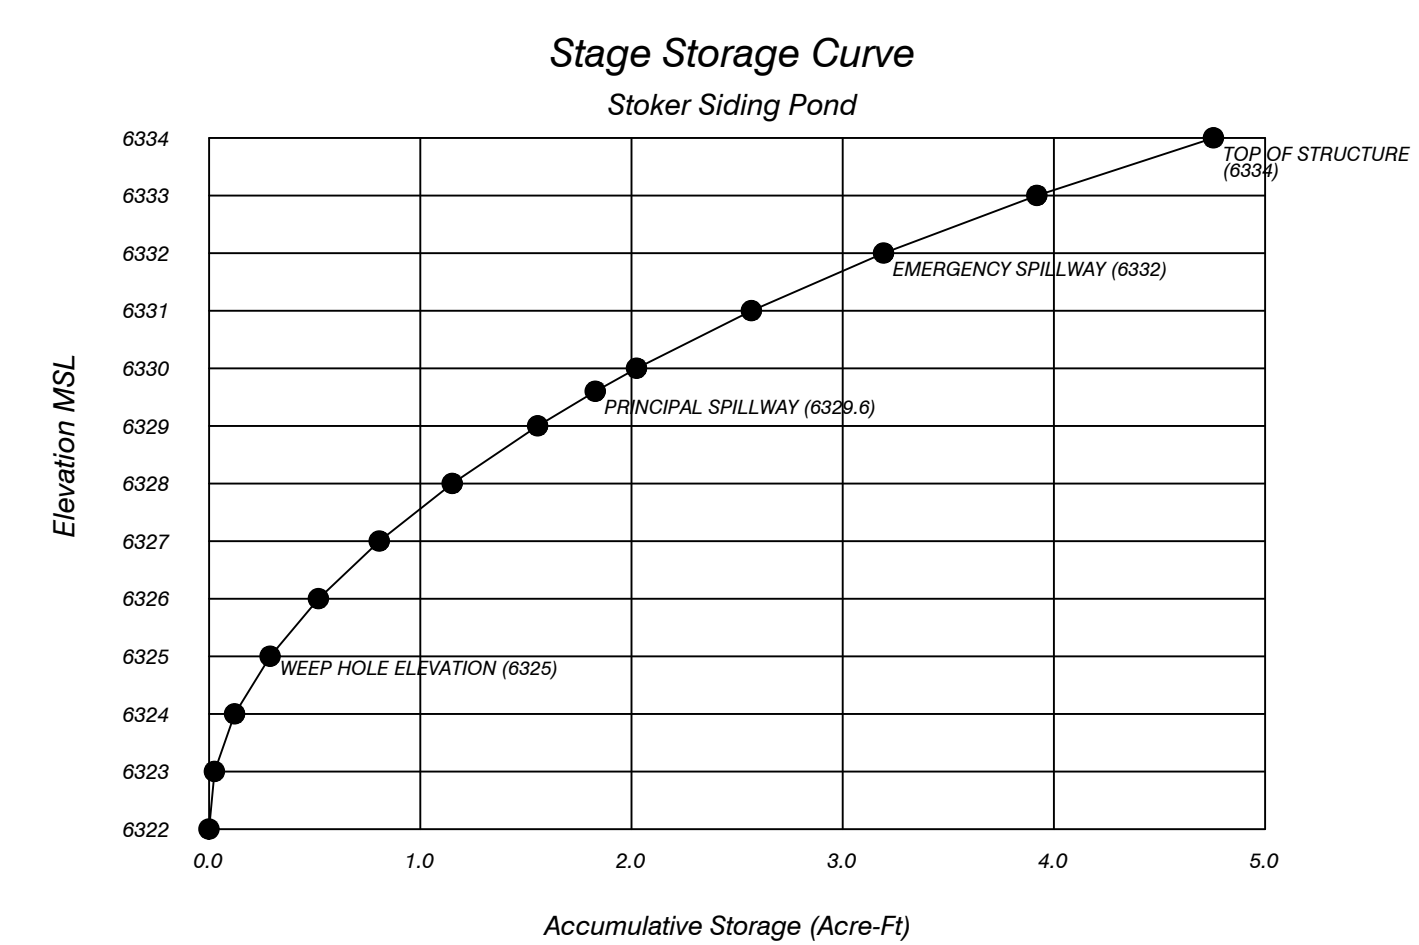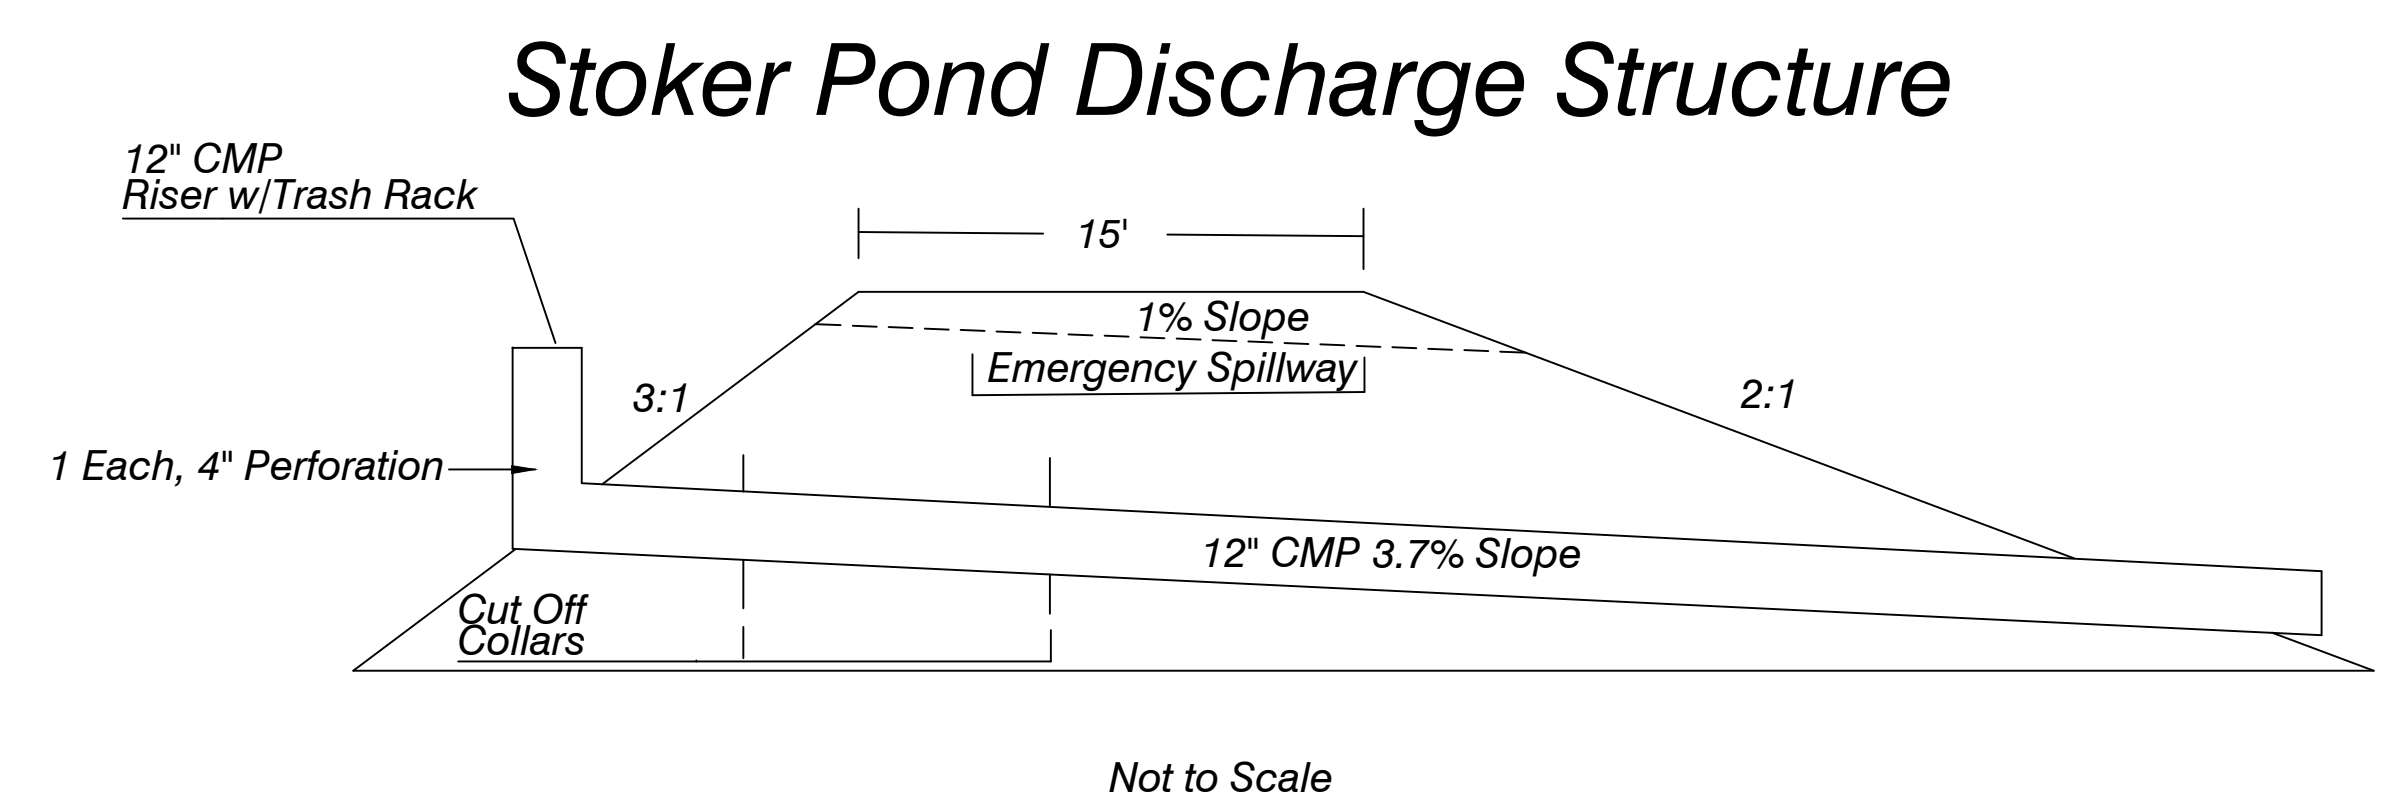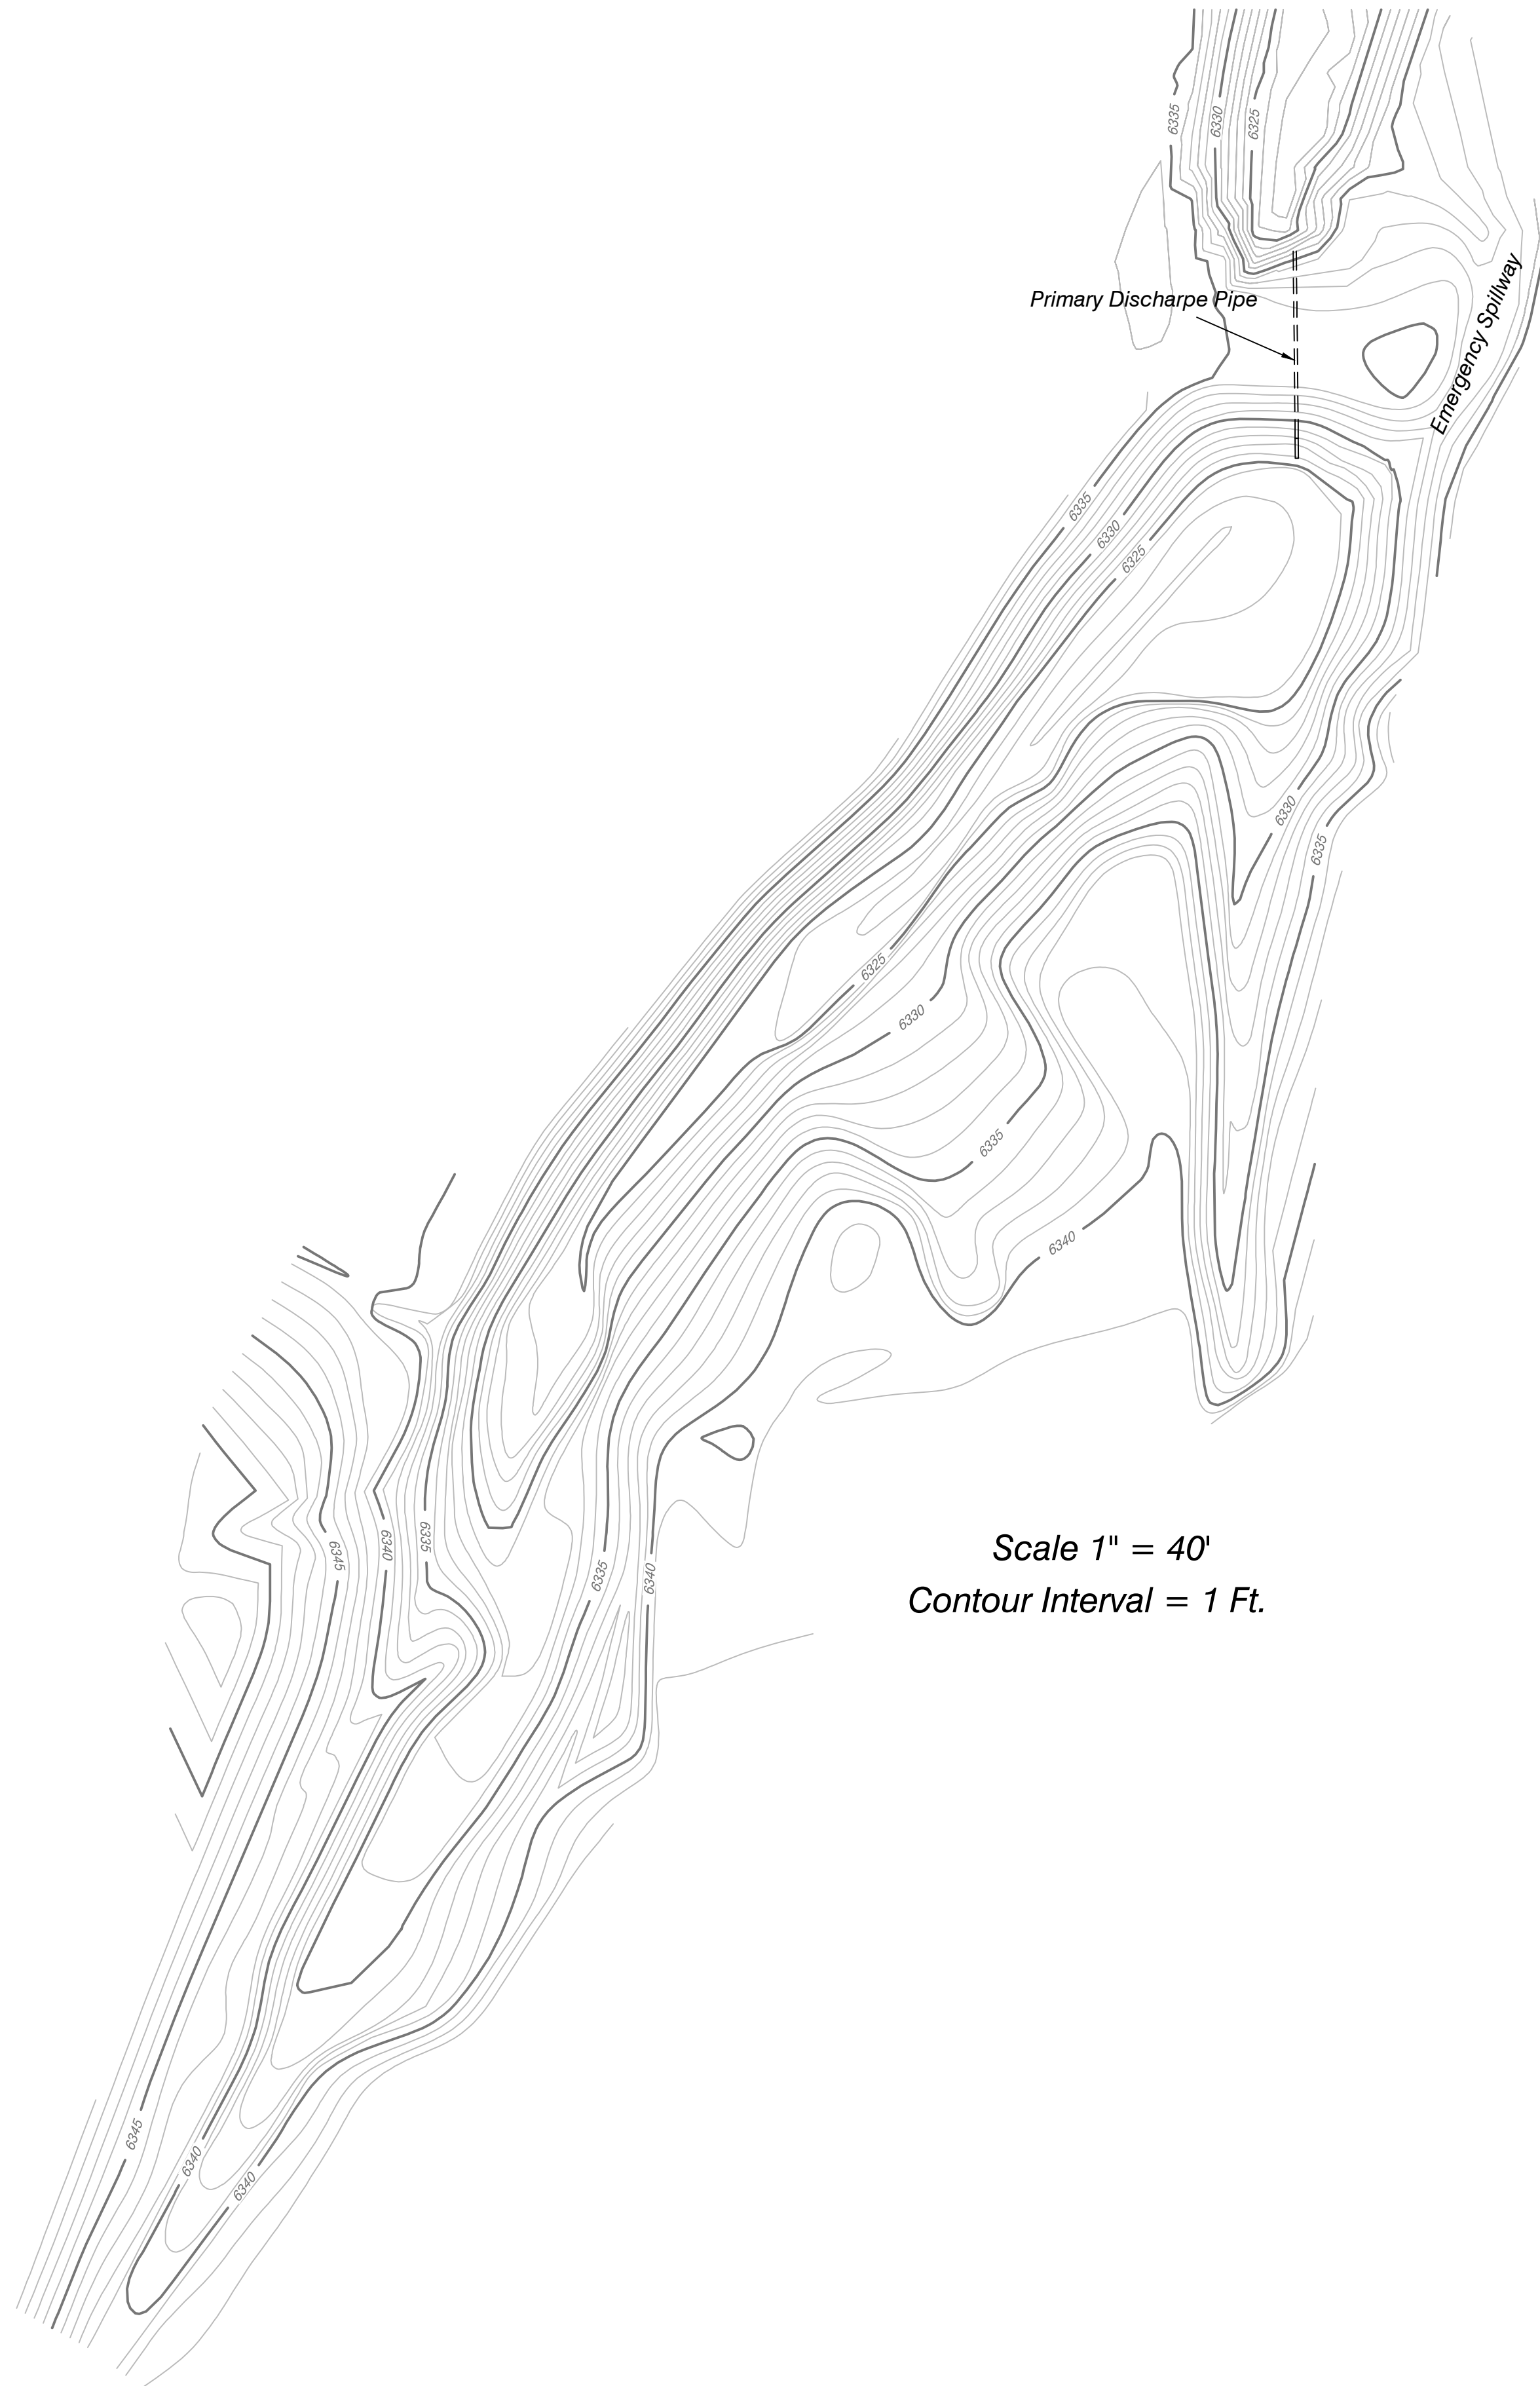

ELEV. (ft)	Width (ft)	LENGTH (ft)	AREA (ac)	AVG. AREA (ac)	INTERVAL (ft)	STORAGE (ac-ft)	ACC. STORAGE (ac-ft)	STAGE INTERVAL (ft)
6322.0	N/A	N/A	0.00	0.03	1.00	0.03	0.03	1.00
6323.0	N/A	N/A	0.05	0.09	1.00	0.10	0.12	2.00
6324.0	N/A	N/A	0.14	0.16	1.00	0.17	0.29	3.00
6325.0	N/A	N/A	0.19	0.22	1.00	0.23	0.52	4.00
6326.0	N/A	N/A	0.26	0.29	1.00	0.29	0.81	5.00
6327.0	N/A	N/A	0.32	0.35	1.00	0.35	1.15	6.00
6328.0	N/A	N/A	0.37	0.40	1.00	0.40	1.56	7.00
6329.0	N/A	N/A	0.44	0.46	0.60	0.27	1.83	7.60
6329.6	N/A	N/A	0.48	0.47	0.40	0.20	2.03	8.00
6330.0	N/A	N/A	0.50	0.54	1.00	0.54	2.57	9.00
6331.0	N/A	N/A	0.58	0.63	1.00	0.63	3.19	10.00
6332.0	N/A	N/A	0.67	0.72	1.00	0.73	3.92	11.00
6333.0	N/A	N/A	0.77	0.83	1.00	0.84	4.76	12.00
6334.0	N/A	N/A	0.89					

ENGINEERS CERTIFICATION
I, BRIAN W. COATES, hereby certify that this map has been reviewed by me and is true and correct to the best of my knowledge and information, relying on information supplied by experts employed by Colowyo Coal Company or qualified consultants working for Colowyo Coal Company, and that I am a Professional Engineer licensed in Colorado as required by the provisions of C.R.S. 12-25-101 through C.R.S. 12-25-119. IN WITNESS WHEREOF, I have hereunder set my hand and affixed my seal.

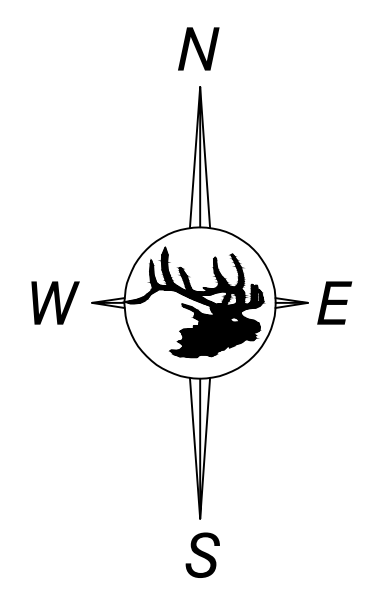

Stoker Siding Pond As-Built

Colowyo Coal Company
5731 State Highway 13
Meeker, Colorado 81641

SCALE: As Shown
DATE: 4/22/08
DRWG. BY: TFS
APPROVED BY: JPG/SRH
DRWG NO.

No.	REVISION	DATE	BY	CHK
1	As-Built	9/21/99	JPG SRH	JPG SRH
TR-137	Updated Entire As-Built Format, Removed Gate Valve Updated Stage Storage Curve	4/23/20	Tony	BC