


CAMILLETTI-MILNER PIT NUMBER TWO AMENDED
COUNTY OF ROUTT, STATE OF COLORADO

[Pink Shaded Area] = Weed spray areas

[Hatched Area] = Reclaimed approx. 3 1/2 acres
01/2020-04/2020

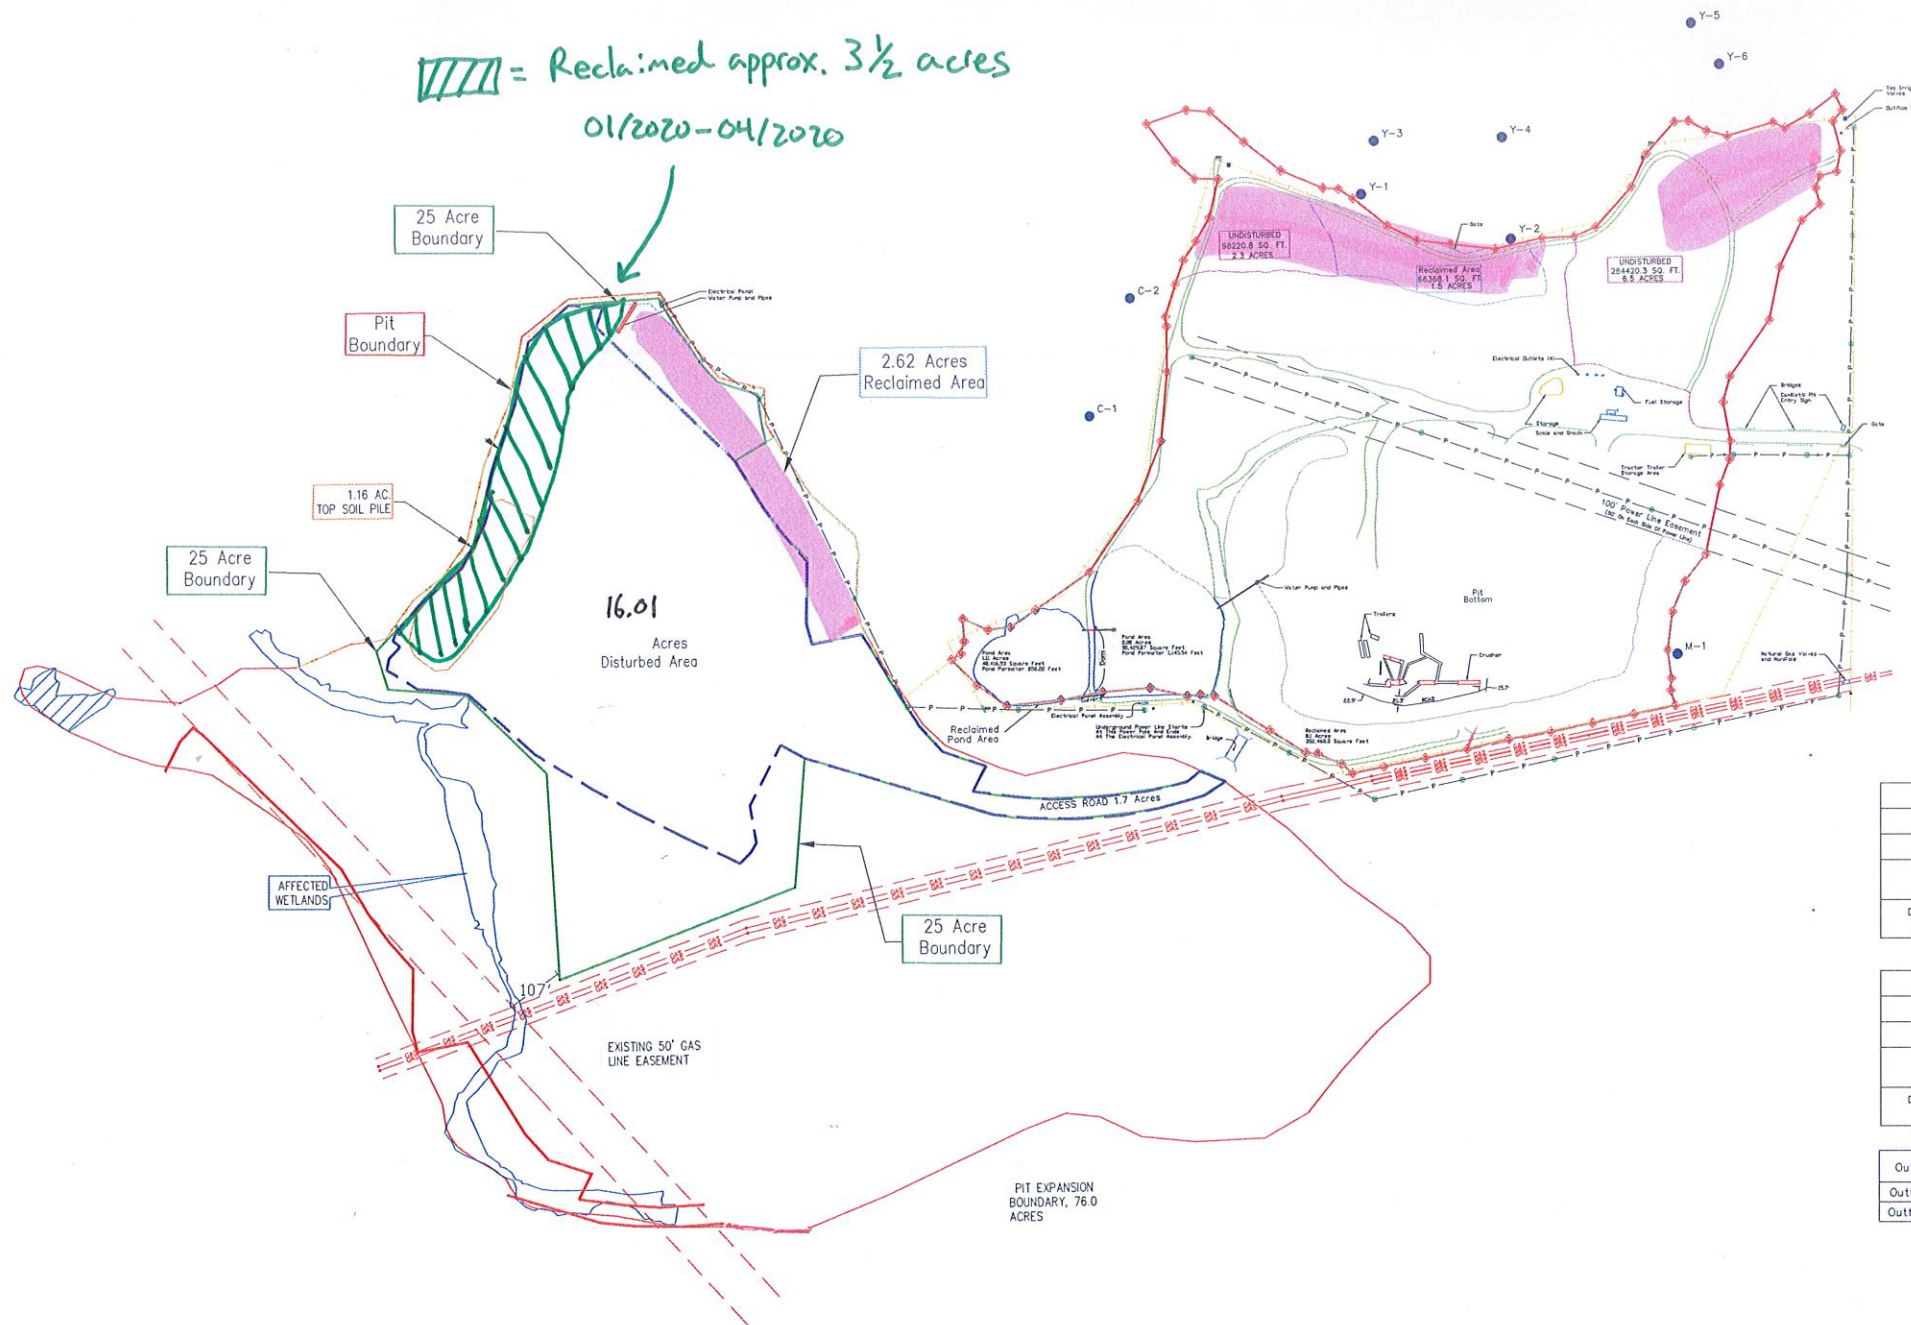

Legend


[Red line with dots]	Pit Boundary
[Red dot]	Pit Boundary Point
[Orange dot]	Pit Control Point
[Yellow line]	Fence Line
[Green line]	Power Pole
[Blue line]	Power Line
[Blue dot]	Power Pole Restraint
[Blue dot]	Outflow Point
[Blue dot]	Irrigation Valve
[Blue dot]	Underground Water Monitoring Well
[Green line]	Pit Road
[Blue line]	Disturbed Area
[Pink line]	Reclaim Area
[Pink line]	Undisturbed Area
[Pink line]	Topsoil

Notes

CAMILLETTI-MILNER PIT NUMBER TWO		
Pit Areas Were Calculated On Dec. 01, 2016.		
Pit Surveyed Nov. 30, 2016.		
Pit Boundary Area 42.35 Acres		
Disturbed Area 23.95 Acres	Undisturbed Area 8.78 Acres	Reclaimed Area 9.62 Acres

CAMILLETTI-MILNER PIT EXPANSION		
Pit Areas Were Calculated On July 29th, 2019.		
Pit Surveyed Nov. 30, 2016.		
Pit Boundary Area 76.00 Acres		
Disturbed Area 16.01 Acres	Undisturbed Area 53.67 Acres	Reclaimed Area 6.12 Acres

Outflow	Latitude	Longitude	Date Measured
Outflow 1	40° 28' 33.16483" N	107° 01' 14.67913" W	3/27/2007
Outflow 2	40° 28' 35.26802" N	107° 00' 42.92658" W	1/25/2007

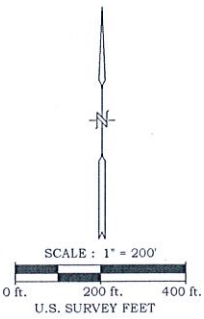

2020 Weed Control

1. Canada Thistle / White Top / Houndstongue / Dalmation Toad Flax
2. Tractor and Spray application
3. Application Rates:
 - > DuPont Telar xP - 1 oz / Acre
 - > 2,4-D 6 lb - 2.5 pints / Acre
 - > Brewer 90-10 - 2.0 pints / Acre

Dates Sprayed

- 5/27/20 - White Top & Thistle
- 6/18/20 - White Top, Thistle, Hounds tongue
- 7/21/20 - Thistle, Common Mullen, Dalmation Toad Flax

PRECISION EXCAVATING, INC. EMAIL: dachner@precisionexcavatinginc.com	REVISIONS	CAMILLETTI-MILNER PIT NUMBER TWO AMENDED COUNTY OF ROUTT, STATE OF COLORADO
	FW 12/01/14	
JOB: 187	DATE: 7/25/19	FW B. MILNER PIT 2014
	DRAFTING: ESE	FIELD: BAY
		SHEET: 1 of 1