


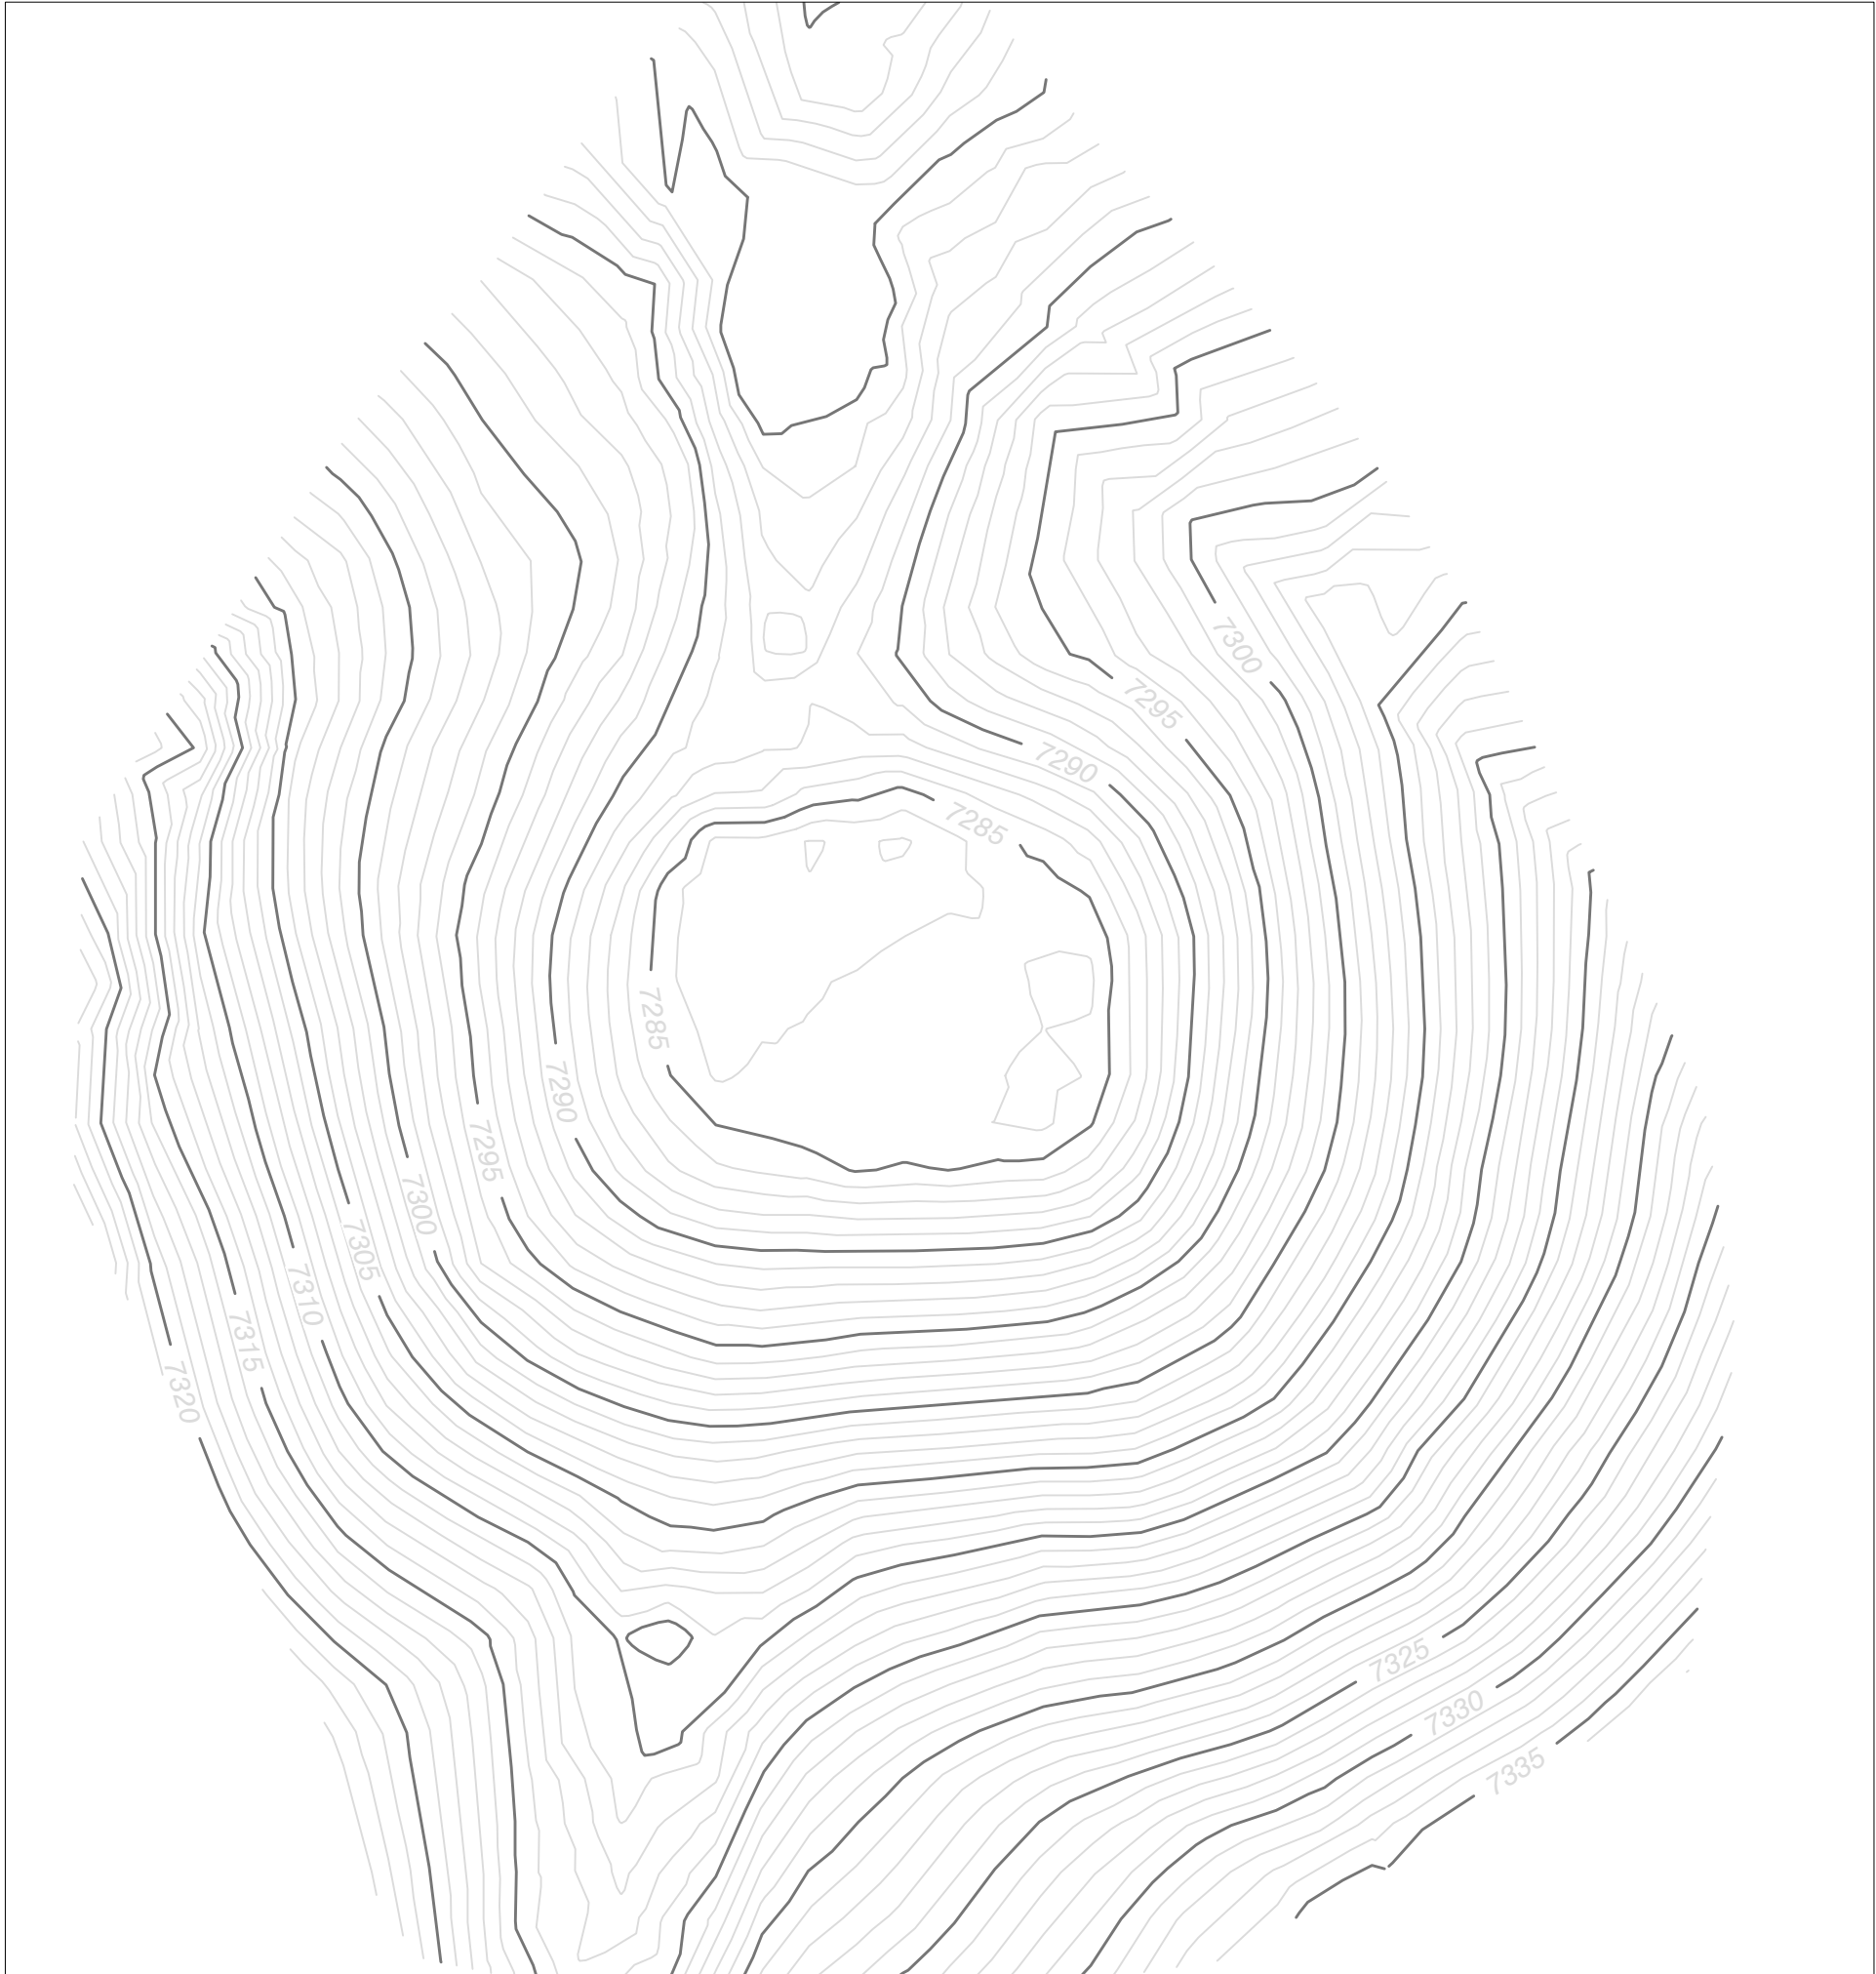


TD-1 - PLAN VIEW  
Scale 1" = 30'  
Contour Interval = 1'

| ELEV.<br>(ft) | AREA<br>(ac) | AVG.<br>AREA<br>(ac) | STORAGE<br>(ac-ft) | ACC.<br>STORAGE<br>(ac-ft) |
|---------------|--------------|----------------------|--------------------|----------------------------|
| 7283.00       | 0.0009       |                      |                    |                            |
| 7284.00       | 0.0588       | 0.0299               | 0.0299             | 0.0299                     |
| 7285.00       | 0.1593       | 0.1090               | 0.1090             | 0.1389                     |
| 7286.00       | 0.1818       | 0.1706               | 0.1706             | 0.3095                     |
| 7287.00       | 0.2128       | 0.1973               | 0.1973             | 0.5068                     |
| 7288.00       | 0.2470       | 0.2299               | 0.2299             | 0.7367                     |




TD-2 - PLAN VIEW  
Scale 1" = 30'  
Contour Interval = 1'

| ELEV.<br>(ft) | AREA<br>(ac) | AVG.<br>AREA<br>(ac) | STORAGE<br>(ac-ft) | ACC.<br>STORAGE<br>(ac-ft) |
|---------------|--------------|----------------------|--------------------|----------------------------|
| 7443.00       | 0.0138       |                      |                    |                            |
| 7444.00       | 0.0499       | 0.0319               | 0.0319             | 0.0319                     |
| 7445.00       | 0.0788       | 0.0644               | 0.0644             | 0.0962                     |
| 7446.00       | 0.1059       | 0.0924               | 0.0924             | 0.1886                     |
| 7447.00       | 0.1333       | 0.1196               | 0.1196             | 0.3082                     |
| 7448.00       | 0.1611       | 0.1472               | 0.1472             | 0.4554                     |
| 7449.00       | 0.1895       | 0.1753               | 0.1753             | 0.6307                     |
| 7450.00       | 0.2186       | 0.2041               | 0.2041             | 0.8348                     |
| 7451.00       | 0.2488       | 0.2337               | 0.2337             | 1.0685                     |
| 7452.00       | 0.2799       | 0.2644               | 0.2644             | 1.3329                     |
| 7453.00       | 0.3128       | 0.2964               | 0.2964             | 1.6293                     |
| 7454.00       | 0.3484       | 0.3306               | 0.3306             | 1.9599                     |
| 7455.00       | 0.3885       | 0.3684               | 0.3684             | 2.3283                     |

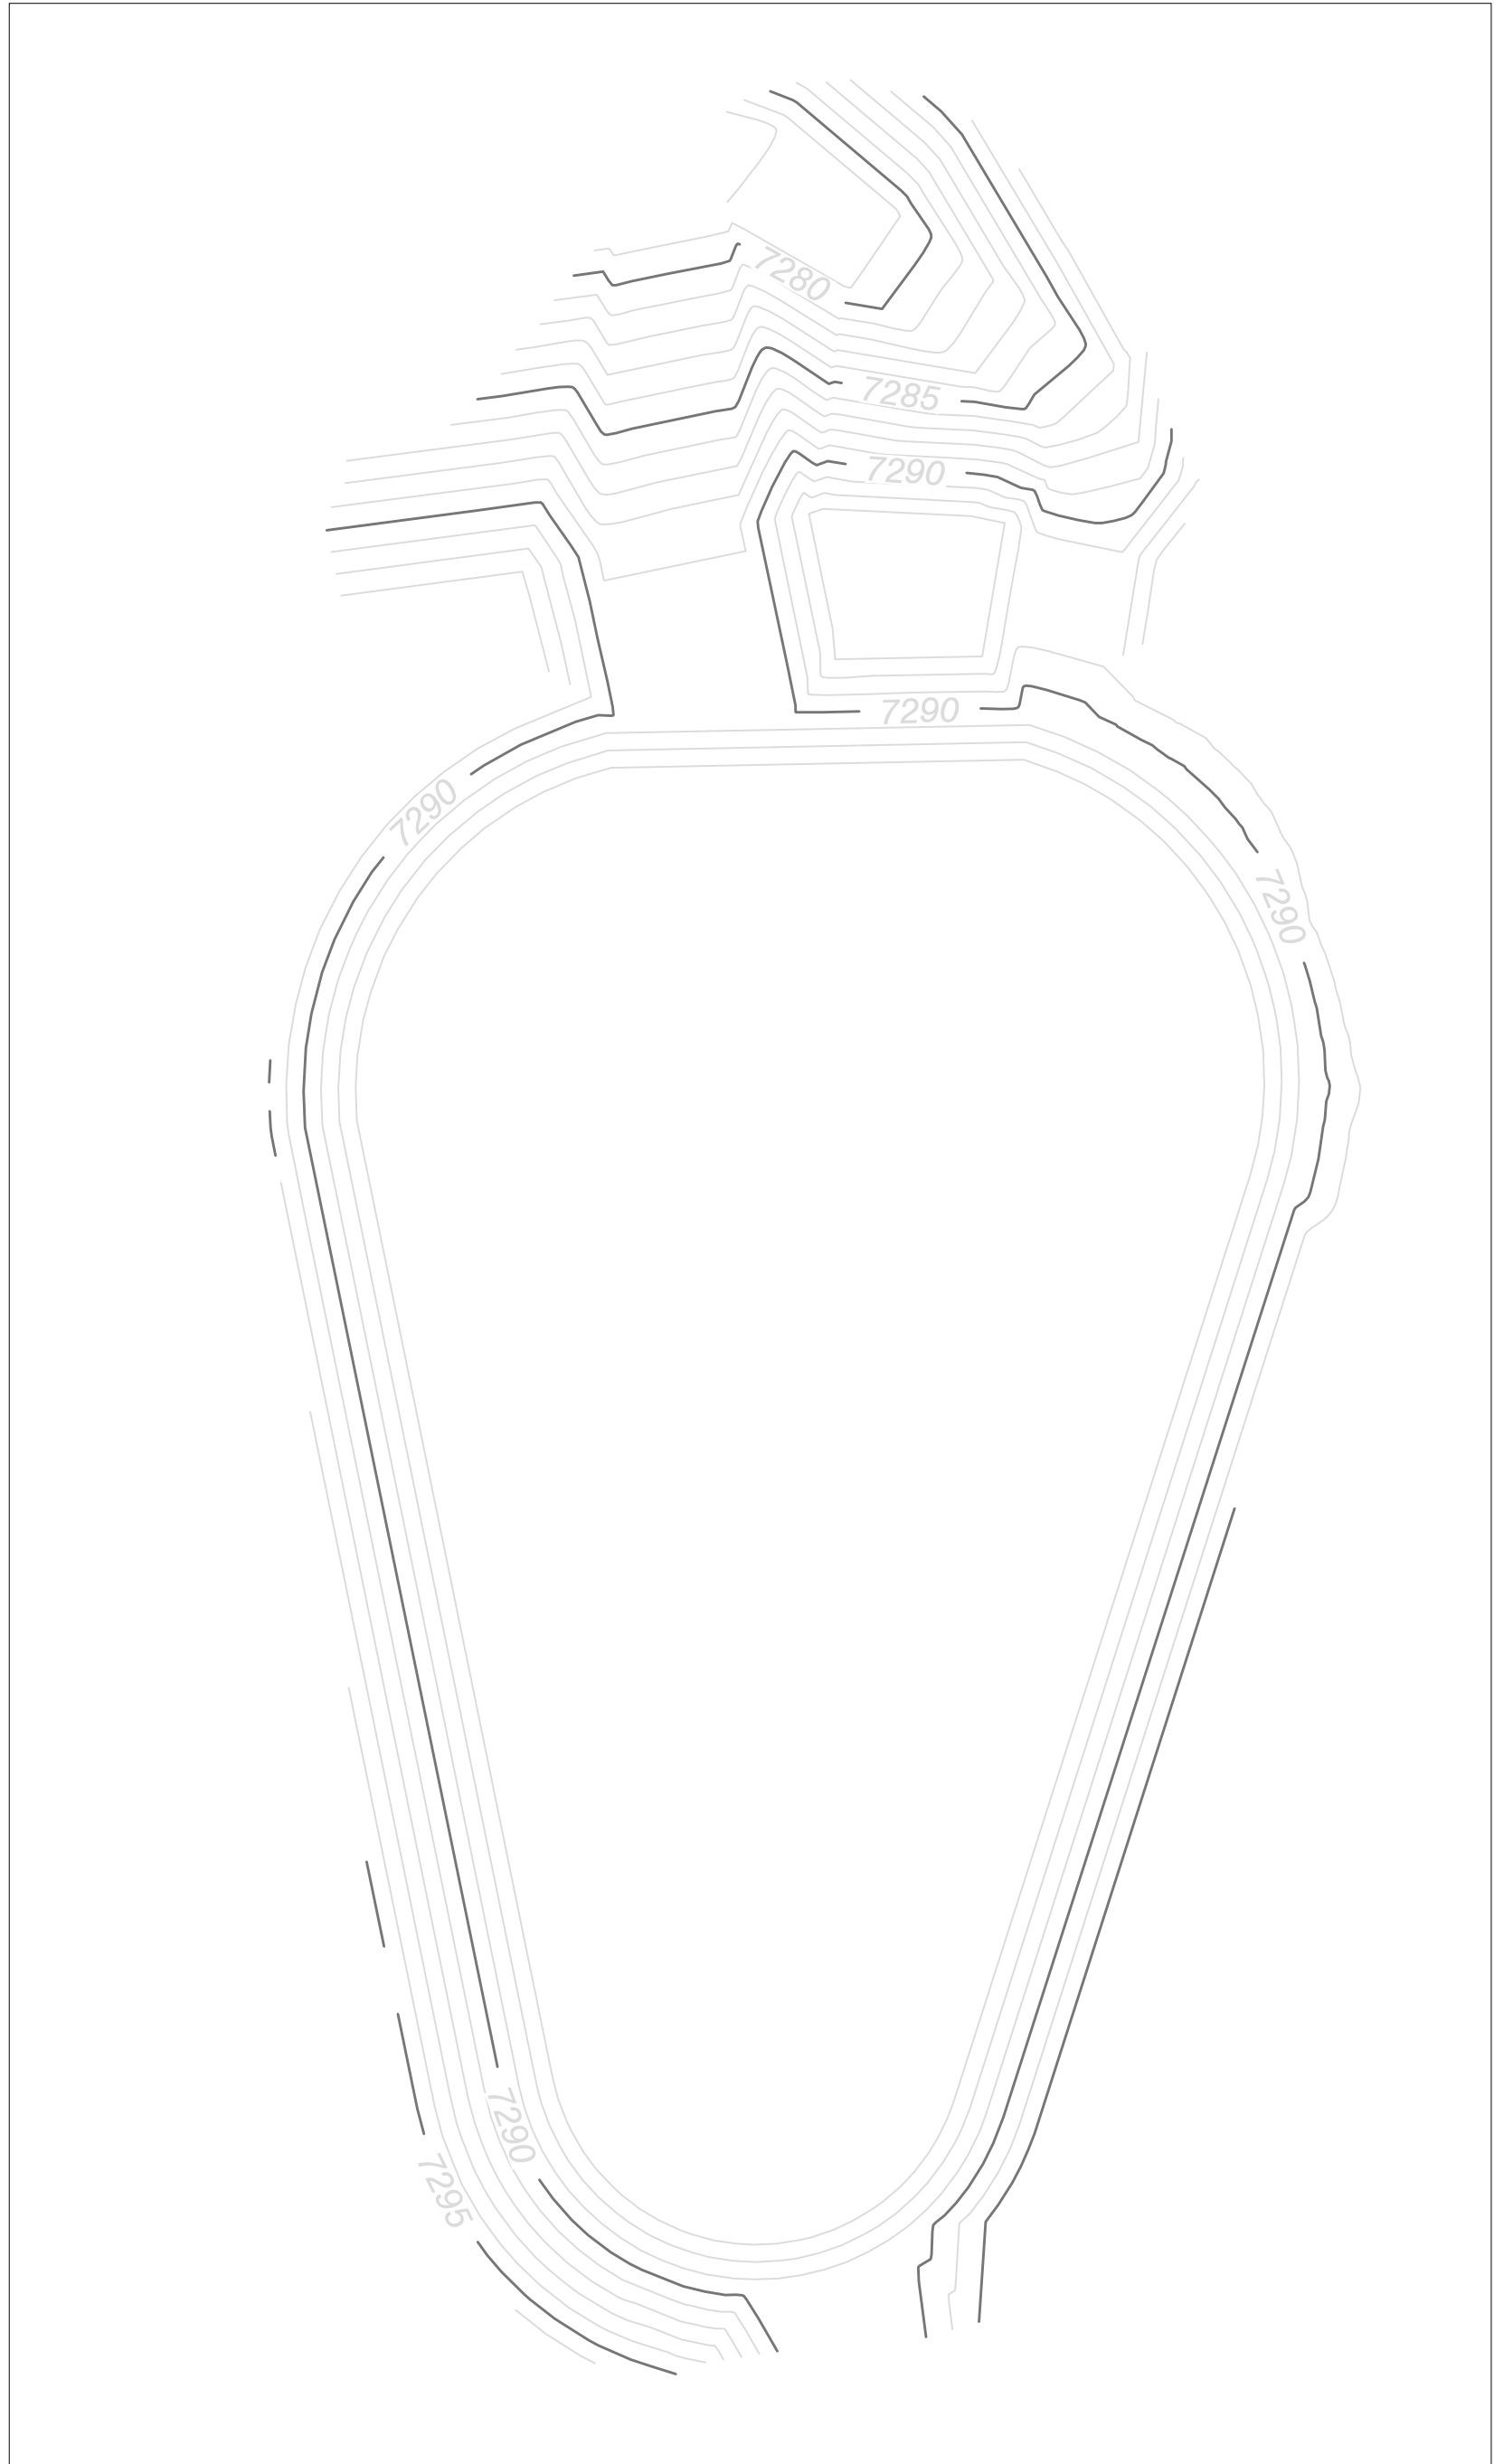


ETD1 - PLAN VIEW  
Scale 1" = 30'  
Contour Interval = 1'

| ELEV.<br>(ft) | AREA<br>(ac) | AVG.<br>AREA<br>(ac) | STORAGE<br>(ac-ft) | ACC.<br>STORAGE<br>(ac-ft) |
|---------------|--------------|----------------------|--------------------|----------------------------|
| 7287.00       | 0.6608       |                      |                    |                            |
| 7288.00       | 0.7080       | 0.6844               | 0.6844             | 0.6844                     |
| 7289.00       | 0.7565       | 0.7323               | 0.7322             | 1.4167                     |
| 7290.00       | 0.7565       | 0.7565               | 0.7565             | 2.1732                     |
| 7291.00       | 0.7565       | 0.7565               | 0.7565             | 2.9298                     |
| 7292.00       | 0.7565       | 0.7565               | 0.7565             | 3.6863                     |
| 7293.00       | 0.7565       | 0.7565               | 0.7565             | 4.4428                     |

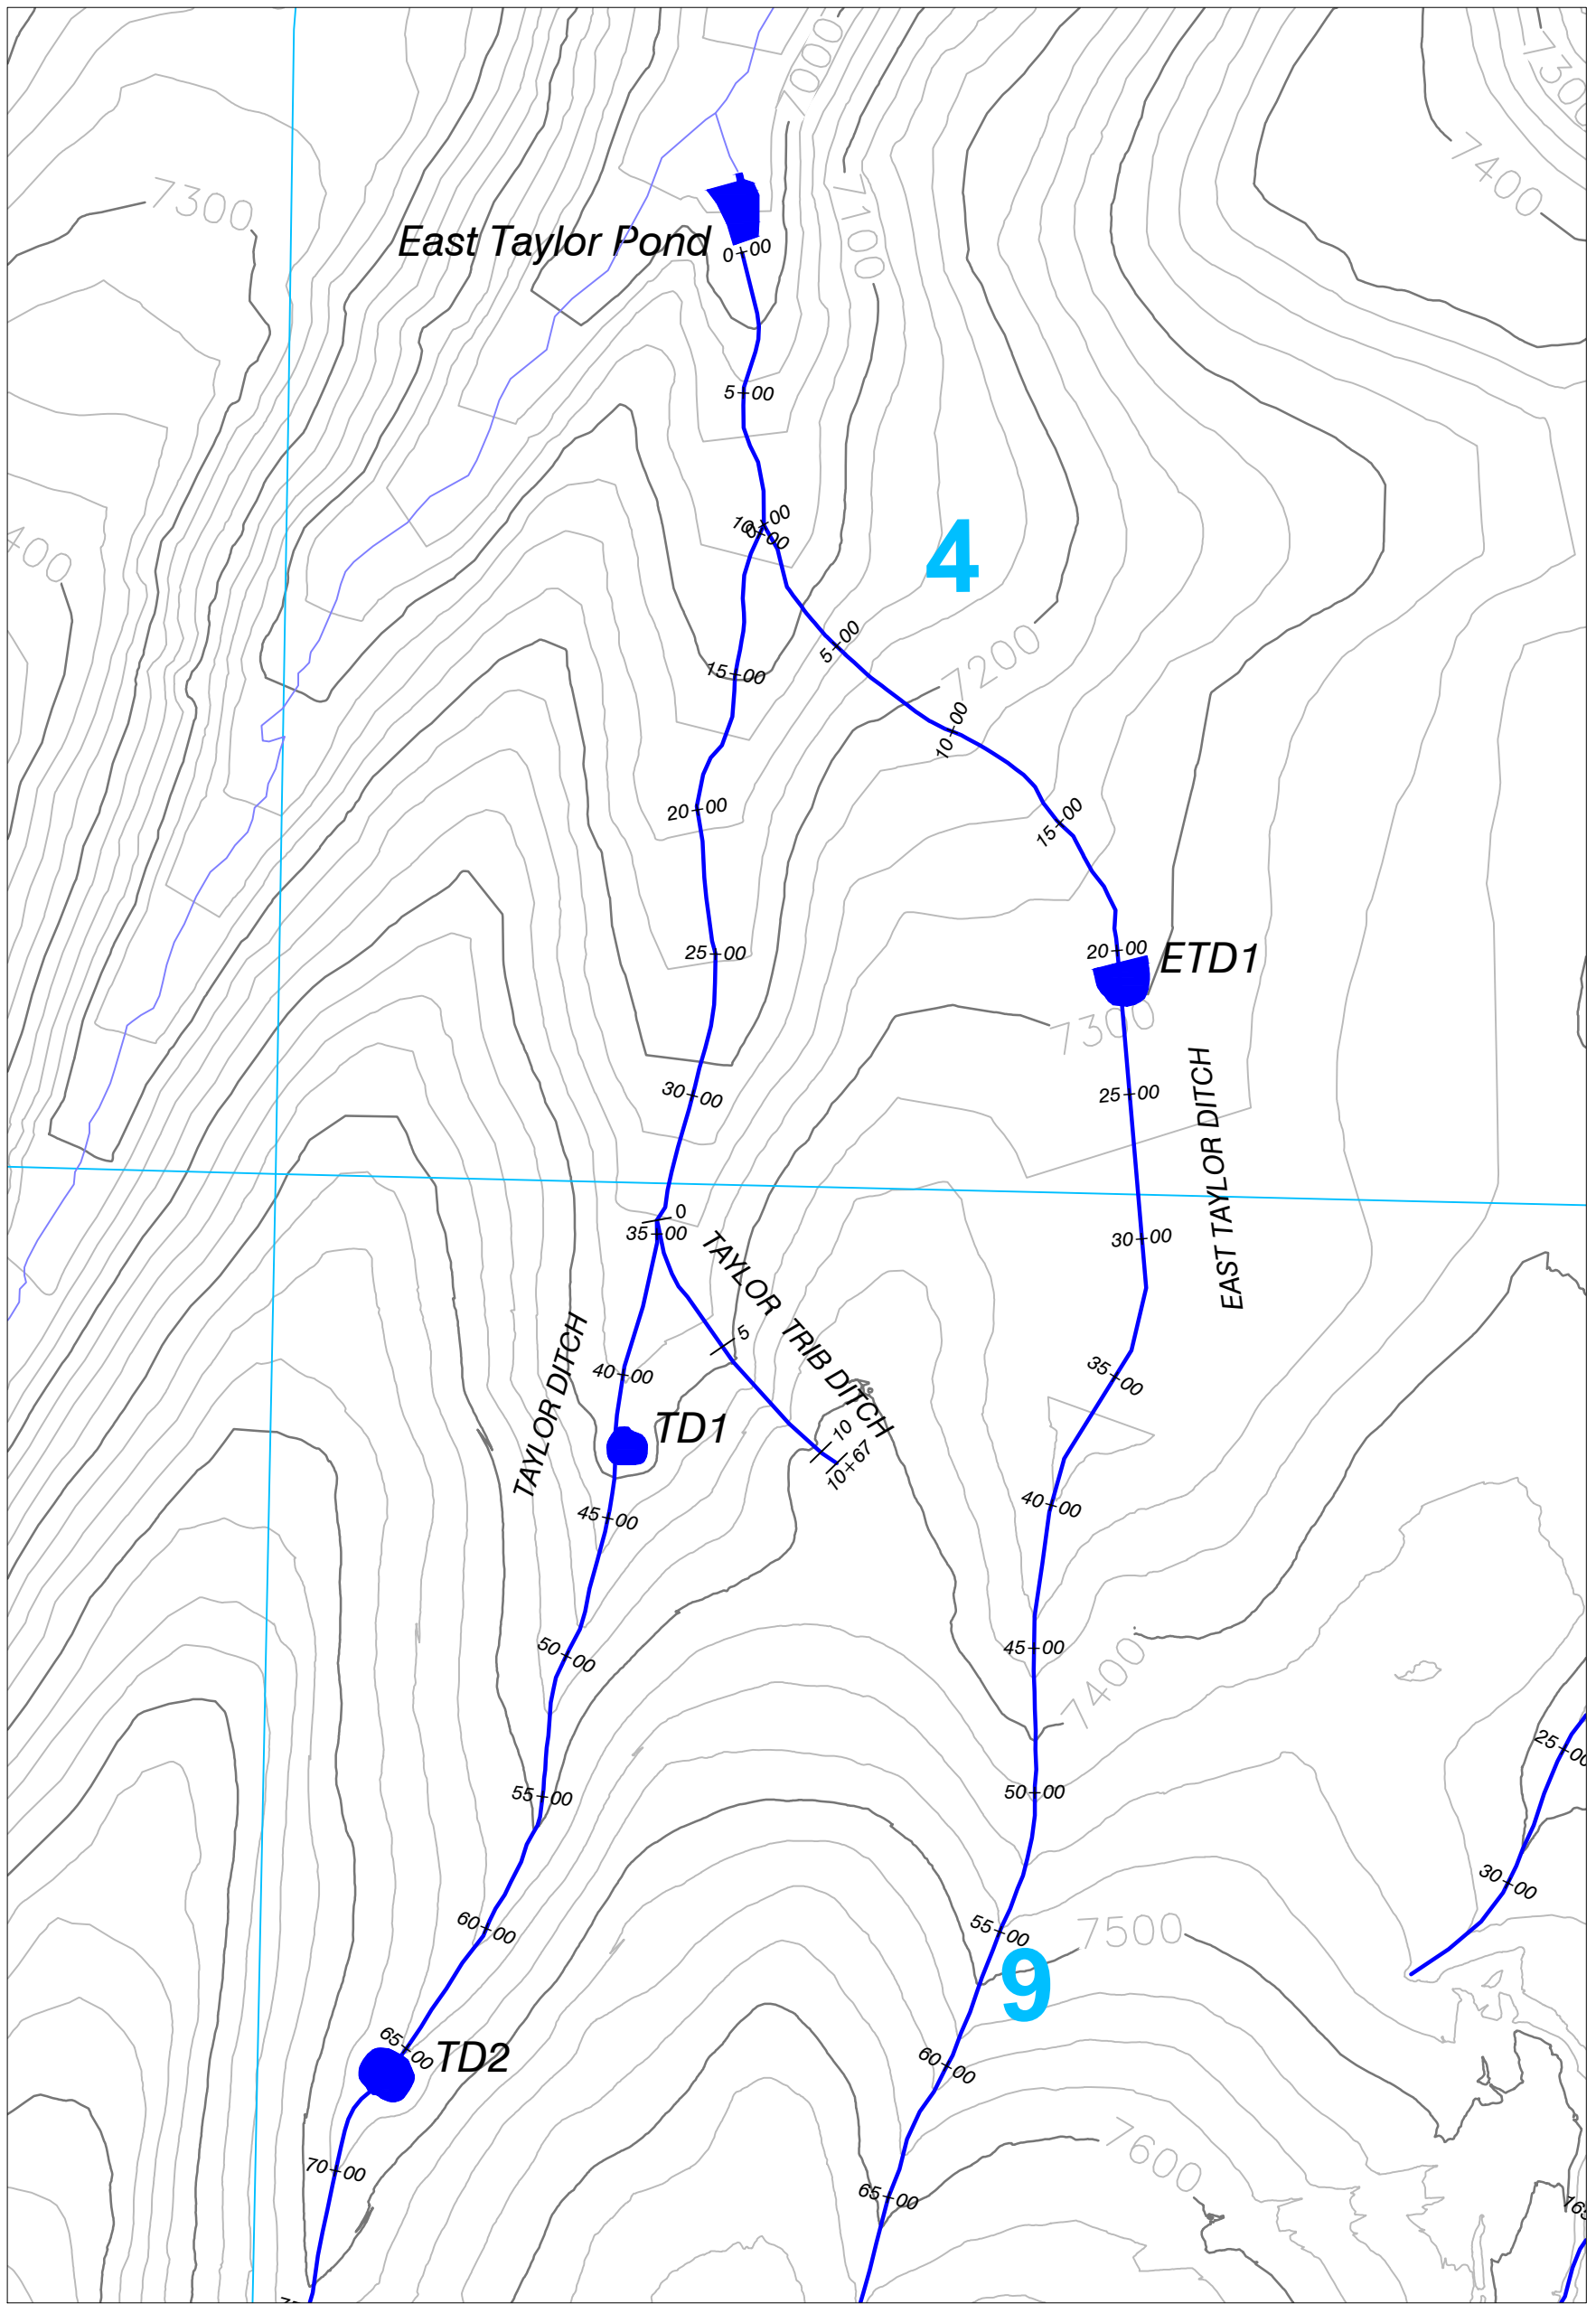

Location Map  
Scale 1" = 600'

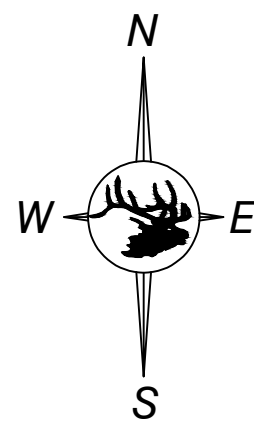

Legend

- Section Line
- Streams
- Post Mine Channel
- Stock Pond/Sediment Pond

ENGINEERS CERTIFICATION  
I, BRIAN W. COATES, hereby certify that this map has been reviewed by me and is true and correct to the best of my knowledge and information, relying on information supplied by experts employed by Colowyo Coal Company or qualified consultants working for Colowyo Coal Company, and that I am a Professional Engineer licensed in Colorado as required by the provisions of C.R.S. 12-25-101 through C.R.S. 12-25-119. IN WITNESS WHEREOF, I have hereunder set my hand and affixed my seal.



Stock Ponds TD-1, TD-2 As-Built  
Stock Ponds ETD-1 Re-Design



SCALE: As Noted  
DATE: 7/27/20  
DRWG. BY: Tony  
APPROVED BY: BC  
DRWG NO.

Figure Exh. 7-14ET-3

| No. | REVISION | DATE | BY | CHK |
|-----|----------|------|----|-----|
|     |          |      |    |     |
|     |          |      |    |     |