




Scale 1" = 30'
Contour Interval = 1 Ft.

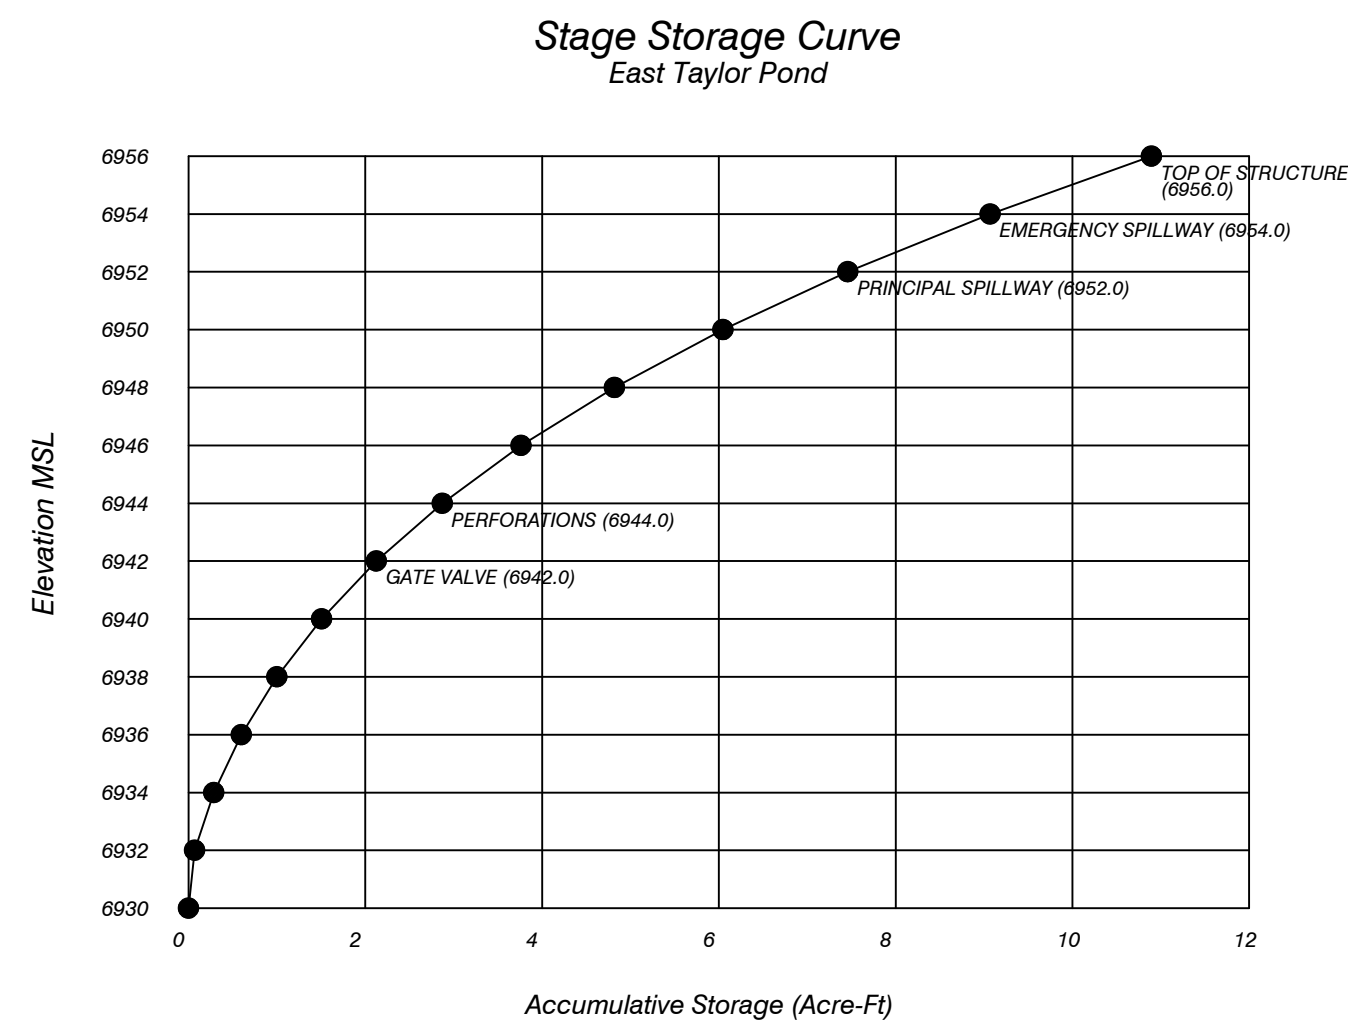

Storage Volume Computations						
ELEV. (ft)	AREA (ac)	AVG. AREA (ac)	INTERVAL (ft)	STORAGE (ac-ft)	ACC. STORAGE (ac-ft)	STAGE INTERVAL (ft)
6930.00	0.0000					
6932.00	0.0762	0.0381	2.00	0.0695	0.0695	2.00
6934.00	0.1343	0.1052	2.00	0.2158	0.2851	4.00
6936.00	0.1782	0.1563	2.00	0.3120	0.5971	6.00
6938.00	0.2250	0.2016	2.00	0.4027	0.9999	8.00
6940.00	0.2805	0.2528	2.00	0.5054	1.5052	10.00
6942.00	0.3392	0.3098	2.00	0.6193	2.1246	12.00
6944.00	0.4087	0.3739	2.00	0.7473	2.8719	14.00
6946.00	0.4847	0.4467	2.00	0.8917	3.7635	16.00
6948.00	0.5705	0.5276	2.00	1.0550	4.8185	18.00
6950.00	0.6597	0.6151	2.00	1.2291	6.0476	20.00
6952.00	0.7539	0.7068	2.00	1.4127	7.4603	22.00
6954.00	0.8561	0.8050	2.00	1.6091	9.0694	24.00
6956.00	0.9692	0.9127	2.00	1.8263	10.8956	26.00

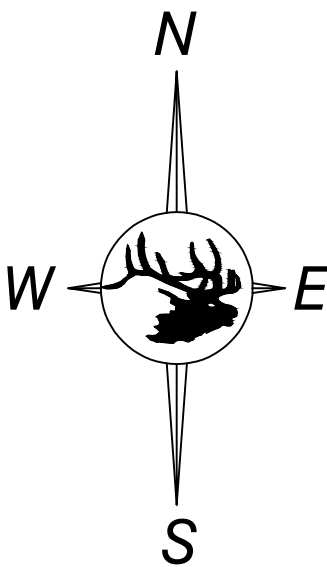


ENGINEERS CERTIFICATION
I, BRIAN W. COATES, hereby certify that this map has been reviewed by me and is true and correct to the best of my knowledge and information, relying on information supplied by experts employed by Colowyo Coal Company or qualified consultants working for Colowyo Coal Company, and that I am a Professional Engineer licensed in Colorado as required by the provisions of C.R.S. 12-25-101 through C.R.S. 12-25-119. IN WITNESS WHEREOF, I have hereunder set my hand and affixed my seal.

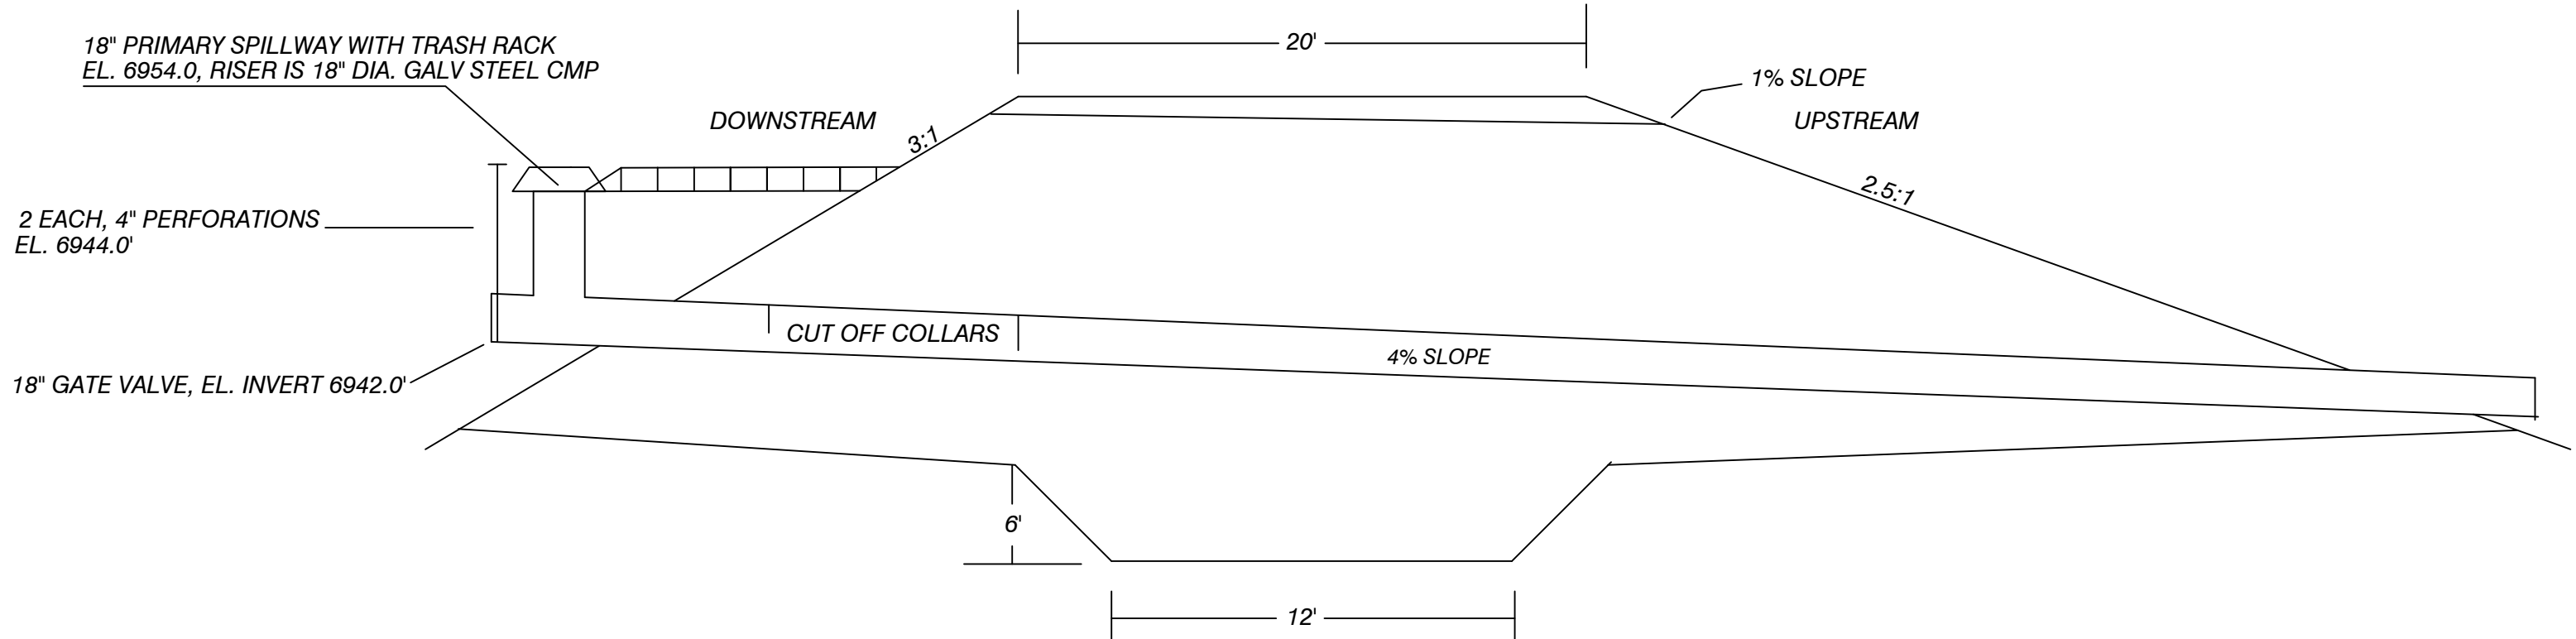

Not to Scale

East Taylor Pond As-Built



Colowyo Coal Company
9731 State Highway 13
Meeker, Colorado 81641

SCALE: As Shown
DATE: 7/28/20
DRWG. BY: Tony
APPROVED BY: BC

DRWG NO.
Figure Exh. 7-14ET-1

No.	REVISION	DATE	BY	CHK
TR-145	Corrected typo	1/20/21	Tony	BC