



Not to Scale

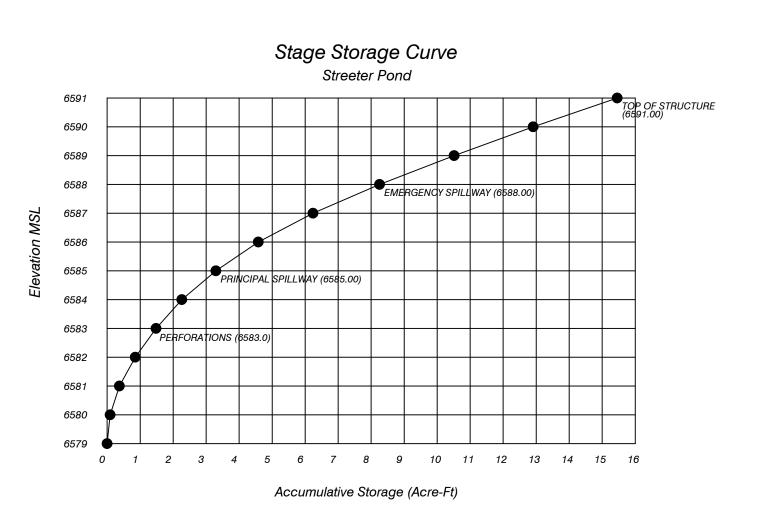

Storage Volume Computations						
ELEV. (ft)	AREA (ac)	AVG. AREA (ac)	INTERVAL (ft)	STORAGE (ac-ft)	ACC. STORAGE (ac-ft)	STAGE INTERVAL
6579.00	0.0453					
6580.00	0.1398	0.0926	1.00	0.0926	0.0926	1.00
6581.00	0.3564	0.2481	1.00	0.2781	0.3706	2.00
6582.00	0.5602	0.4583	1.00	0.4814	0.8520	3.00
6583.00	0.6921	0.6261	1.00	0.6286	1.4806	4.00
6584.00	0.8733	0.7827	1.00	0.7834	2.2640	5.00
6585.00	1.1593	1.0163	1.00	1.0300	3.2940	6.00
6586.00	1.3975	1.2784	1.00	1.2867	4.5807	7.00
6587.00	1.8764	1.6369	1.00	1.6567	6.2374	8.00
6588.00	2.1203	1.9983	1.00	2.0171	8.2545	9.00
6589.00	2.3244	2.2223	1.00	2.2615	10.5160	10.00
6590.00	2.4649	2.3947	1.00	2.3952	12.9112	11.00
6591.00	2.4049 2.6070	2.5360	1.00	2.5440	15.4552	12.00

_ _ _ _ _ _ _ _ _ _ _ _ _ _ _ _ _ _

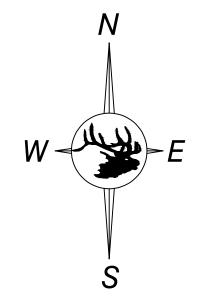

ENGINEERS CERTIFICATION

I, BRIAN W. COATES, hereby certify that this map has been reviewed by me and is true and correct to the best of my knowledge and information, relying on information supplied by experts employed by Colowyo Coal Company or qualified consultants working for Colowyo Coal Company, and that I am a Professional Engineer licensed in Colorado as required by the provisions of C.R.S.

12-25-101 through C.R.S. 12-25-119. IN WITNESS WHEREOF, I have hereunder set my hand and affixed my seal.



