


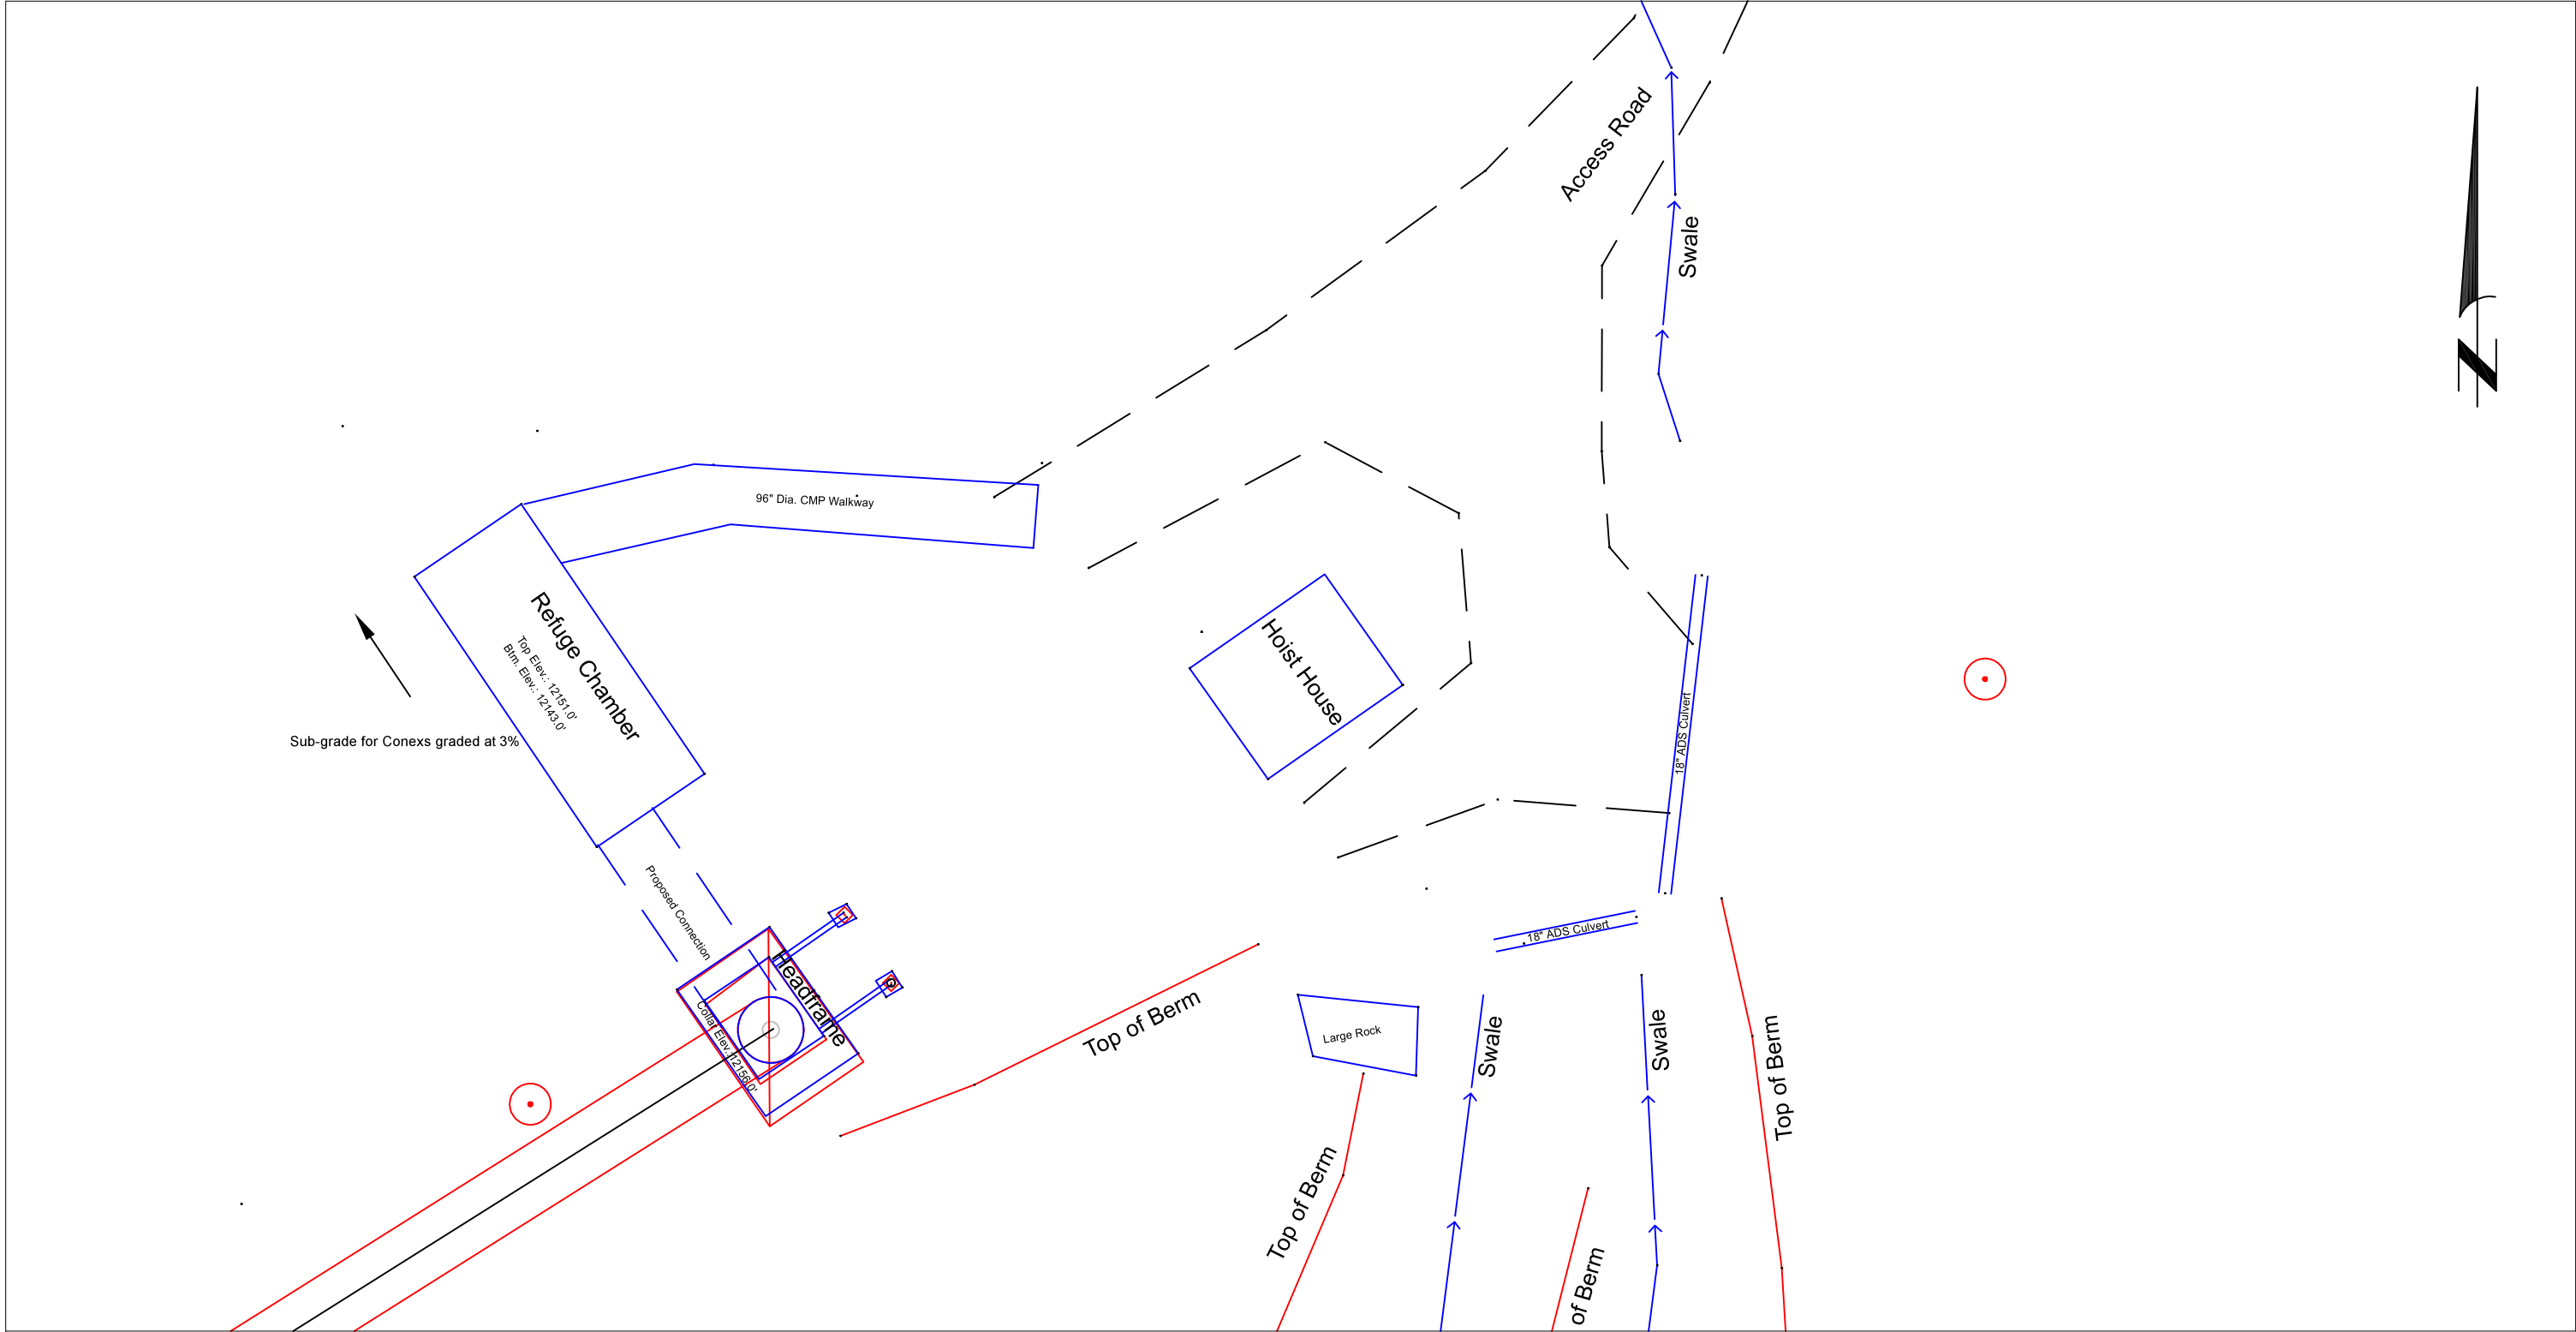

DRAWN	DJD	02/25/21
CHECK	-	-
REV	0	00/00/00

CLIENT	
Ouray Silver Mines Revenue Mine	
PROJECT NAME	
Hubb-Reed Raise	

MERIDIAM PARTNERS, LLC			
P.O. BOX 102380, DENVER COLORADO 80210 TEL: 303-815-9248			
Surface Improvements As-built			
PROJECT NUMBER	SCALE	DRAWING NUMBER	REVISION
21-101	1" = 20'	1 of 1	0