


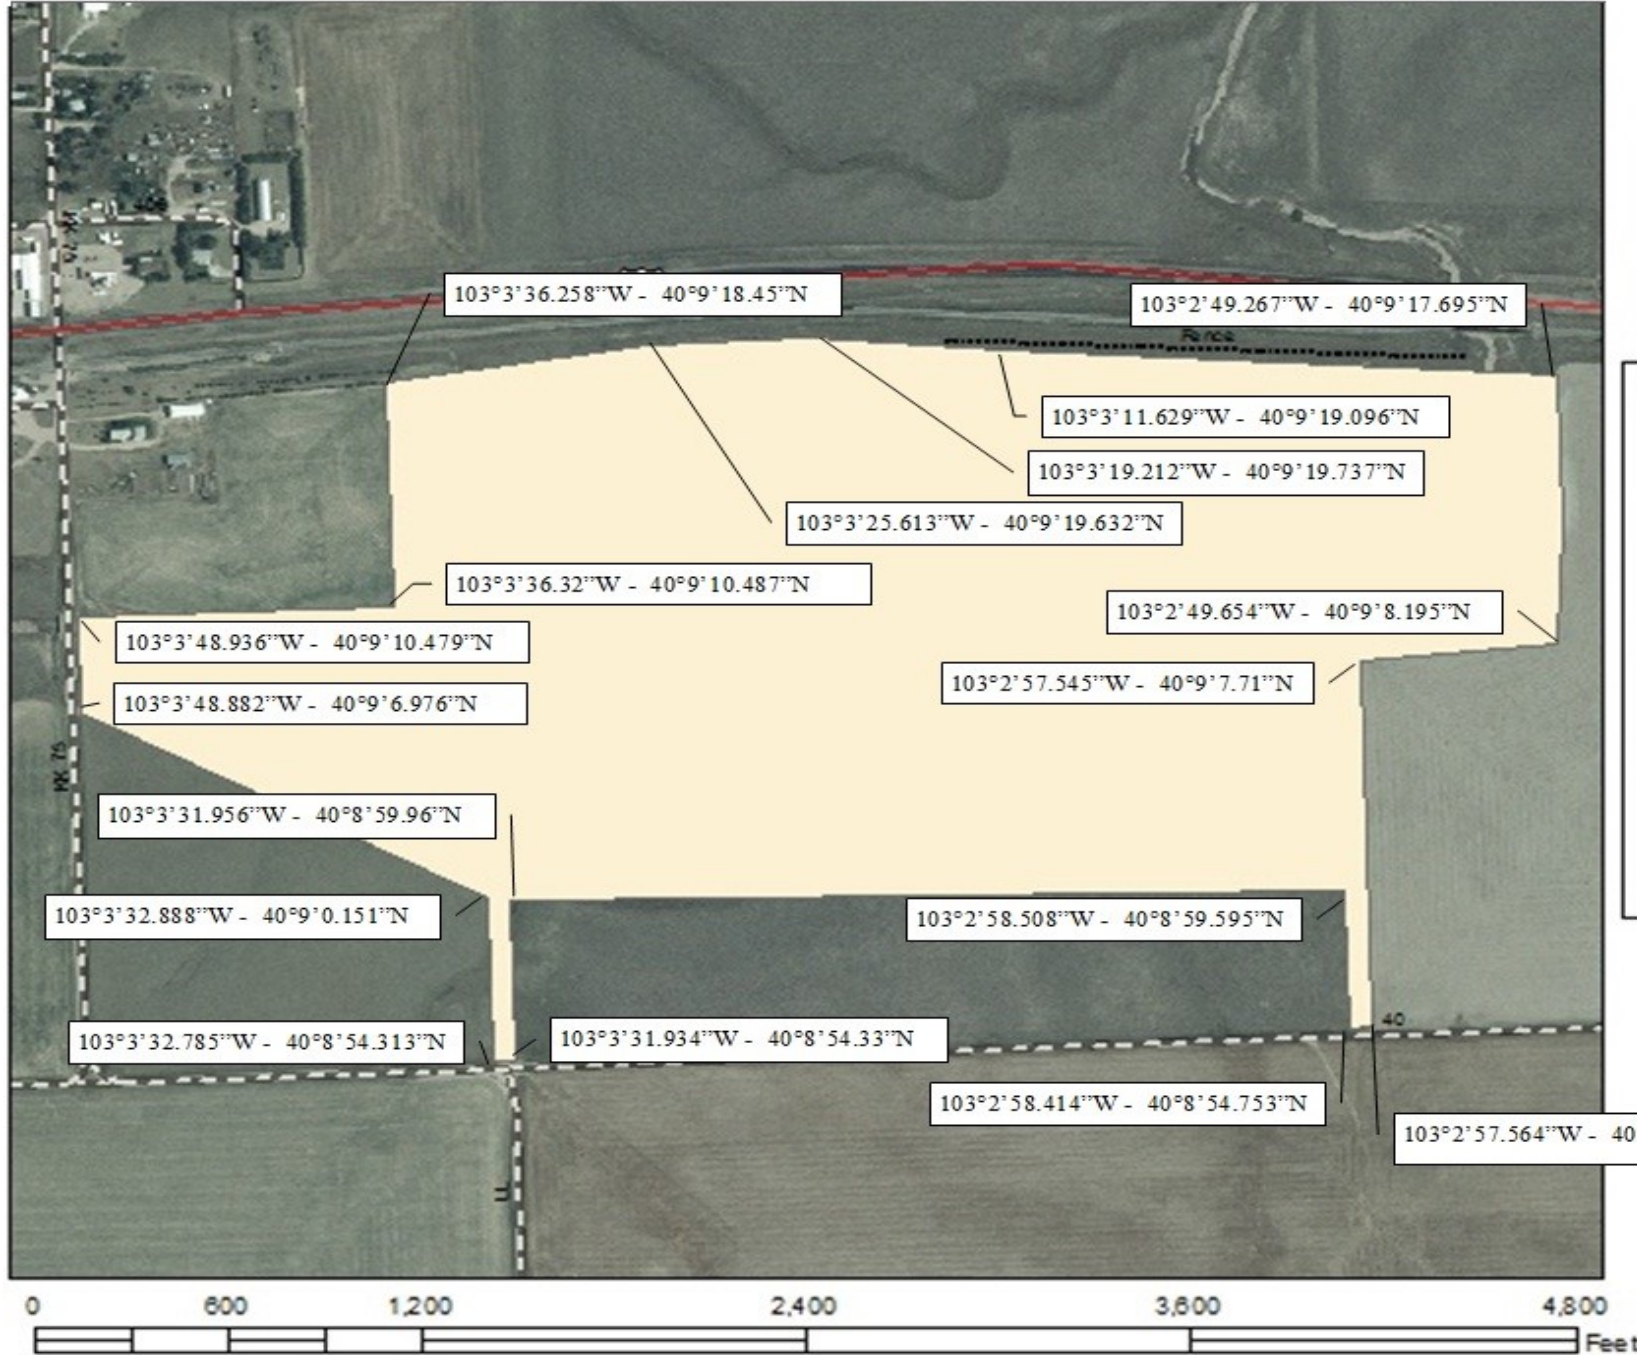

Erick Pit - South of Hwy.34

NAIP Image
RGB

- Red: Band_1
- Green: Band_2
- Blue: Band_3
- Yellow: Erick revised 1
- Blue line: Limited Access
- Red line: Highway
- Orange line: Major Road
- Grey line: Local Road
- Black line: Minor Road
- Dashed line: Other Road
- Thin grey line: Ramp

Map Created by; Robert Frick

Washington GIS Technician Dec. 18, 2021

Applicant Name:
Washington County Road & Bridge, Dist. 2
Total Acres: 15
Township 2 North, Range 51 West
SE 1/4, NW 1/4, Section 11