




Scale 1" = 20'

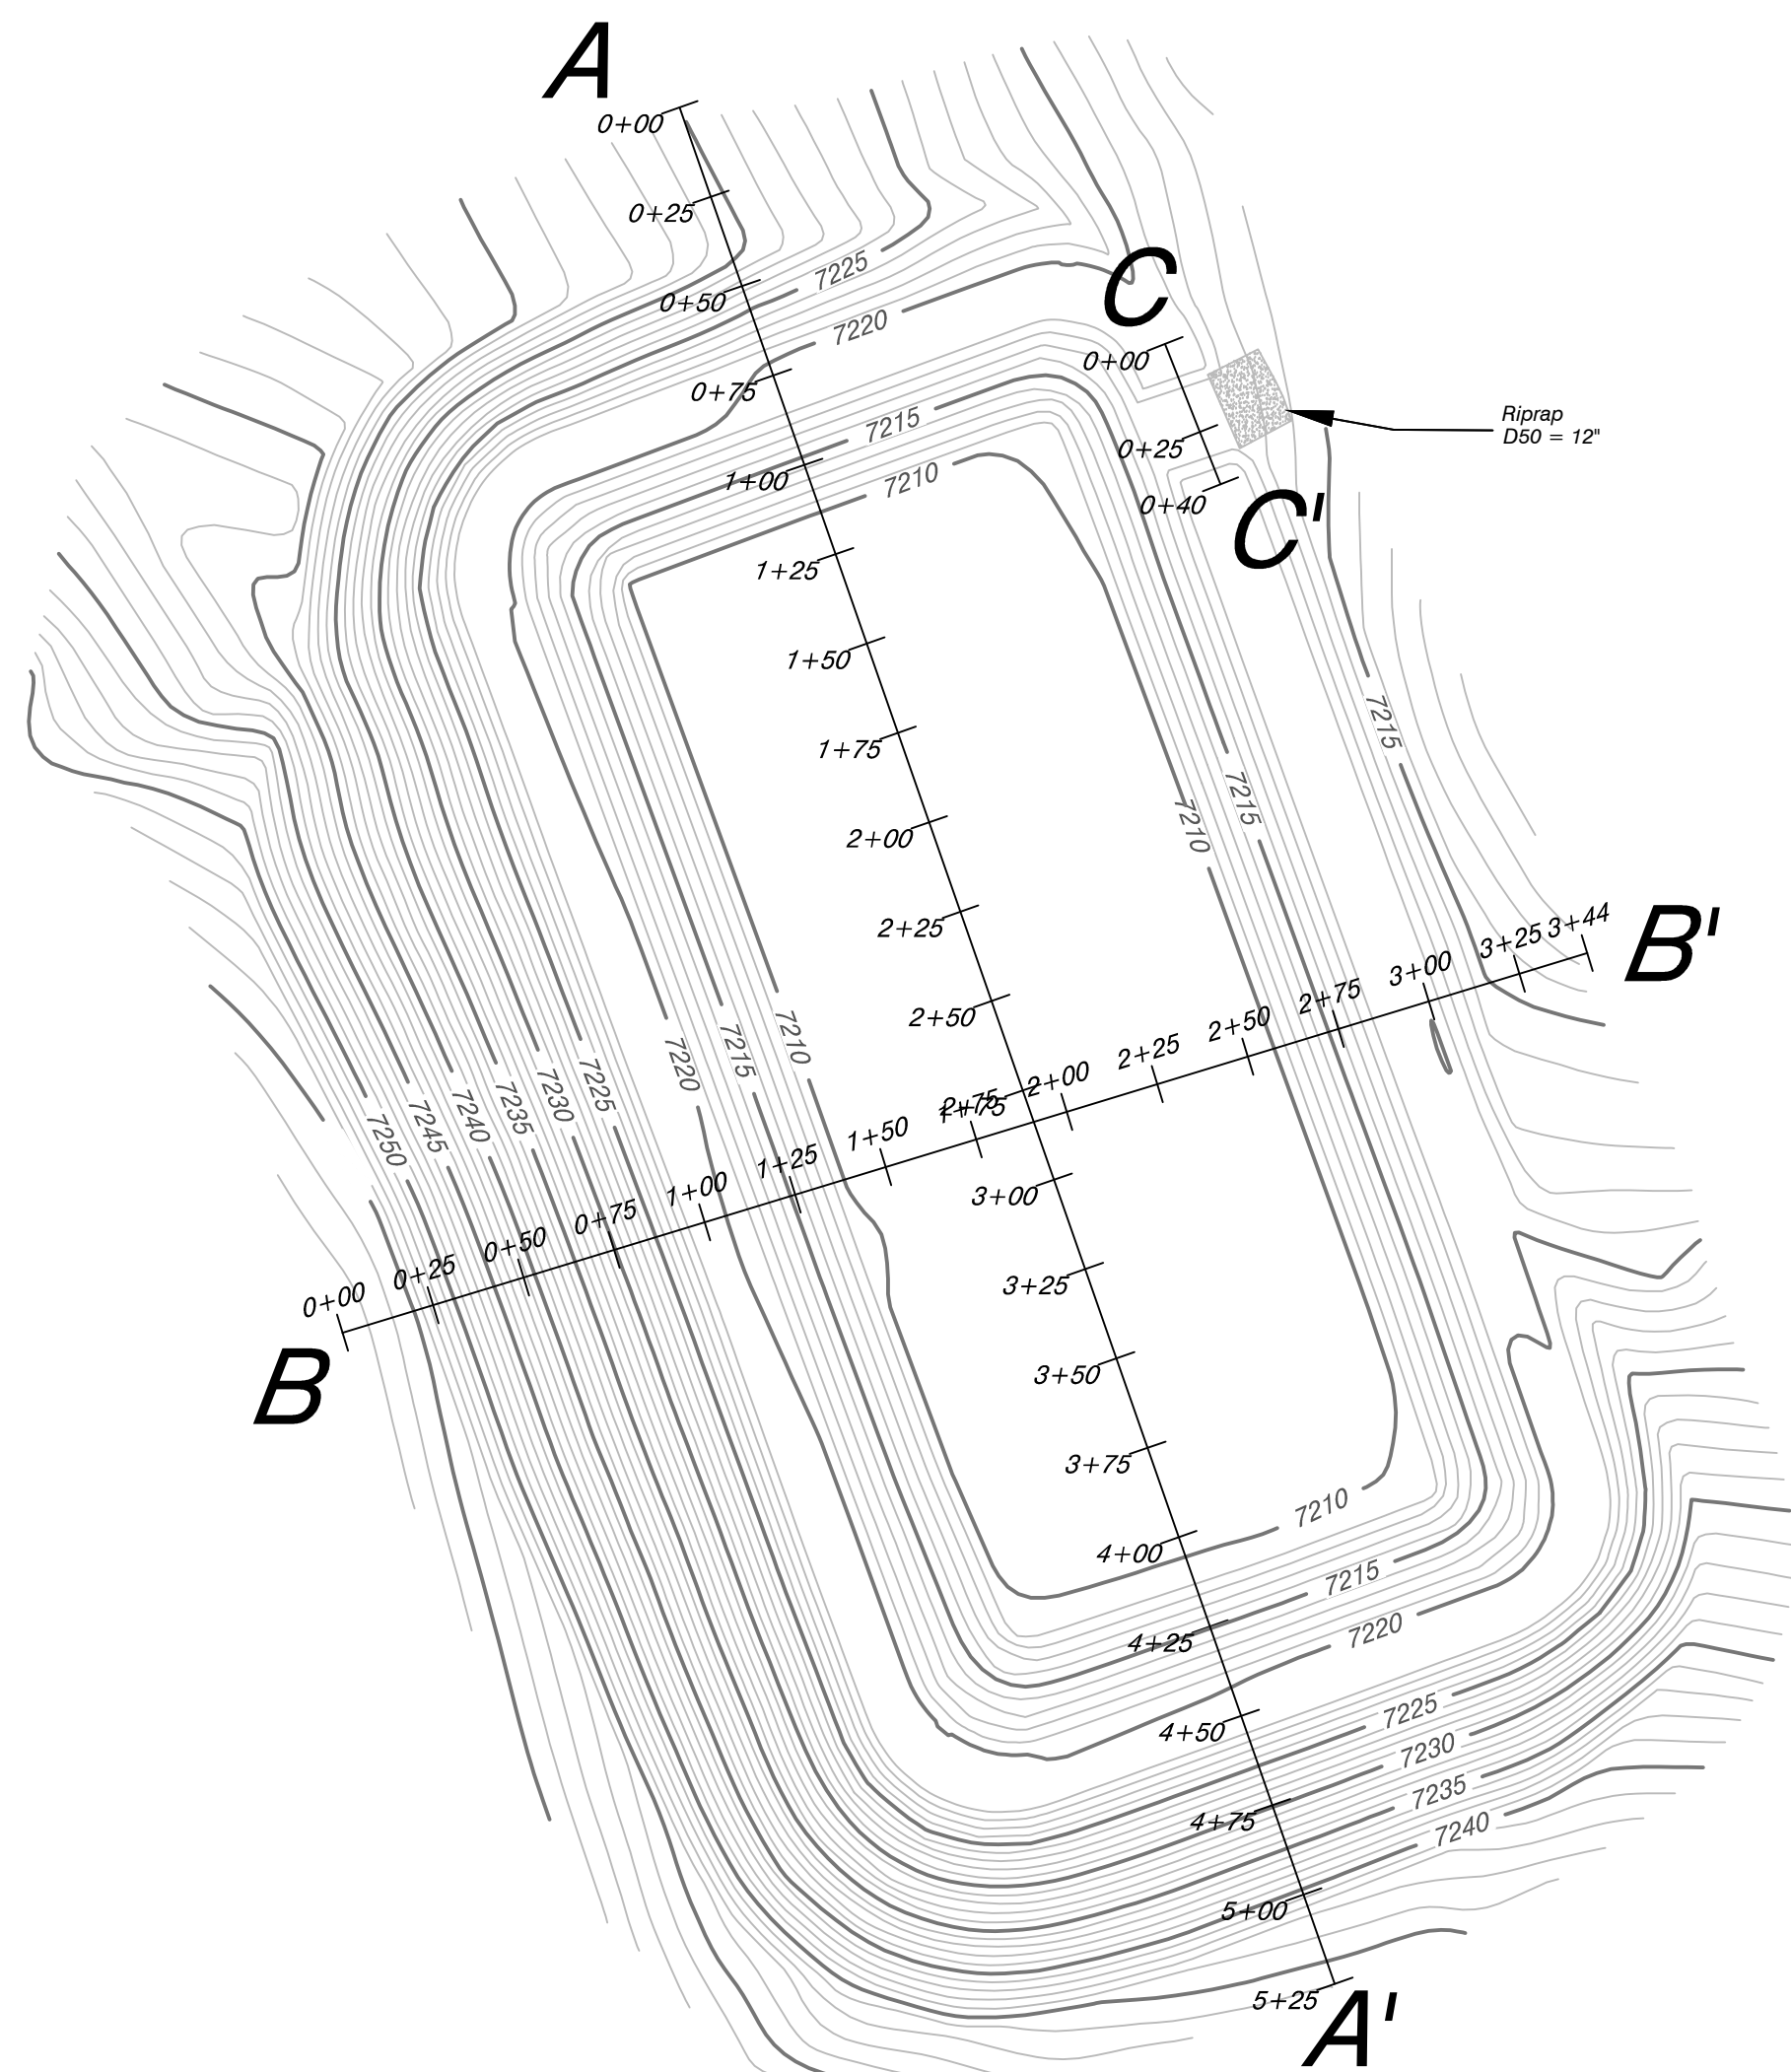


Scale 1" = 50'
Contour Interval = 1 Ft.

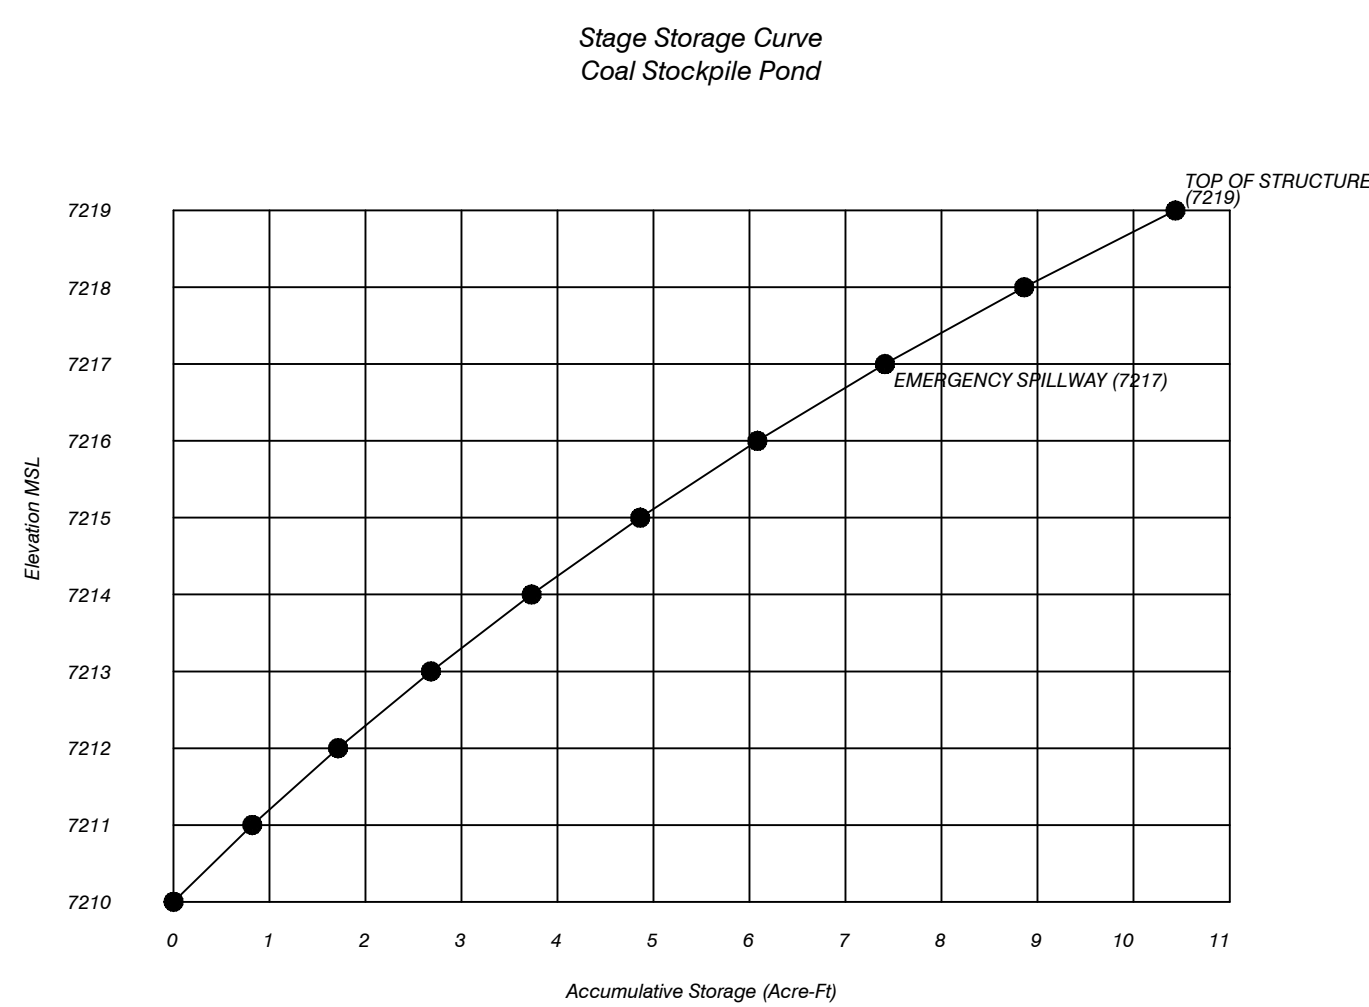

Storage Volume Computations						
ELEV. (ft)	AREA (ac)	AVG. AREA (ac)	INTERVAL (ft)	STORAGE (ac-ft)	ACC. STORAGE (ac-ft)	STAGE INTERVAL (ft)
7210.00	0.7794	0.8196	1.00	0.8196	0.8196	1.00
7211.00	0.8587	0.8940	1.00	0.8939	1.7135	2.00
7212.00	0.9283	0.9677	1.00	0.9673	2.6807	3.00
7213.00	1.0071	1.0487	1.00	1.0483	3.7290	4.00
7214.00	1.0902	1.1326	1.00	1.1321	4.8611	5.00
7215.00	1.1749	1.2214	1.00	1.2208	6.0817	6.00
7216.00	1.2679	1.3290	1.00	1.3280	7.4098	7.00
7217.00	1.3692	1.4514	1.00	1.4504	8.8601	8.00
7218.00	1.5126	1.5725	1.00	1.5754	10.4355	9.00
7219.00	1.6324					

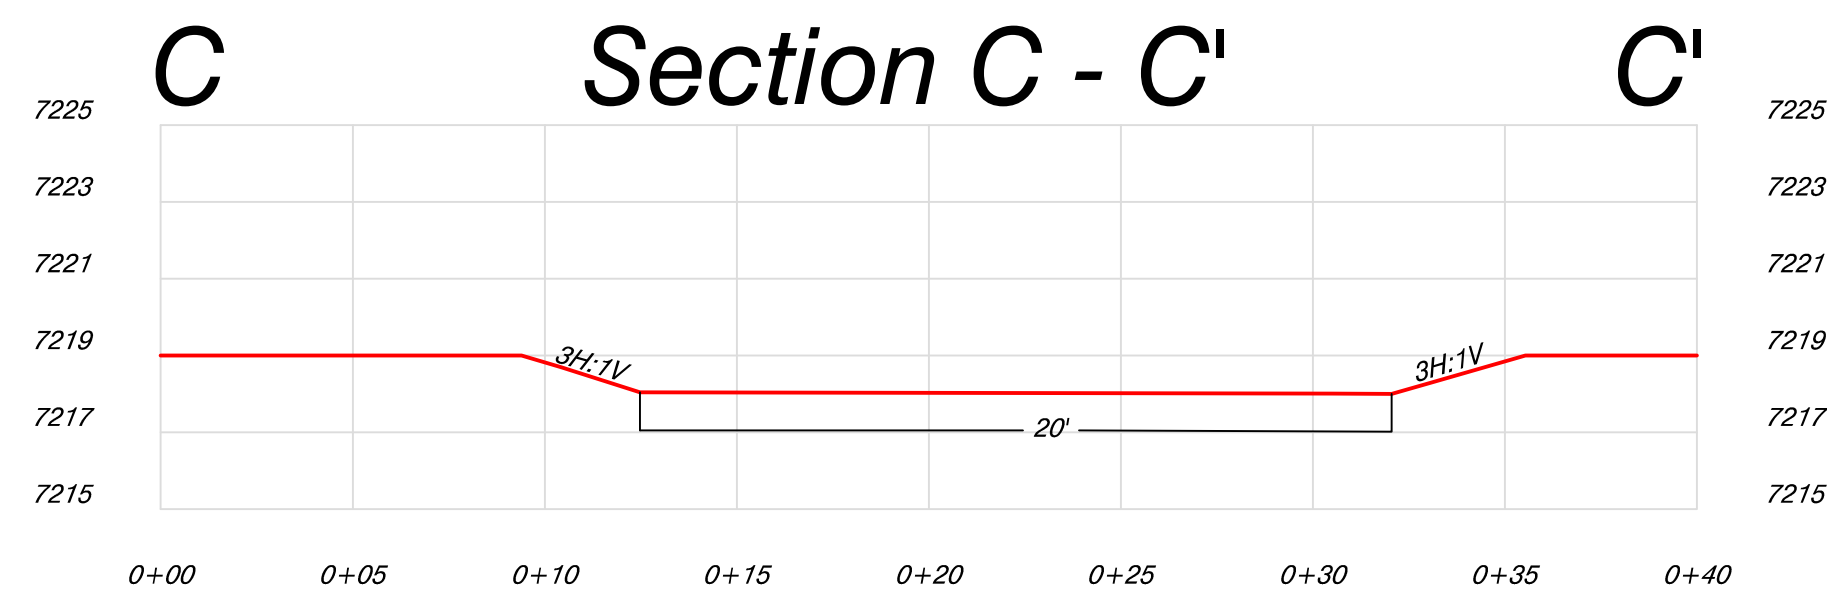

Scale 1" = 5'

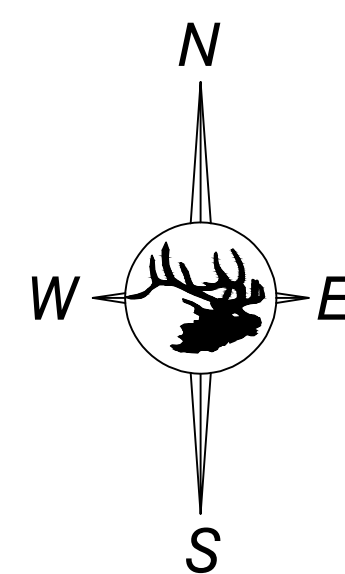

ENGINEERS CERTIFICATION
I, LEE E. SAMPSON, hereby certify that this map has been reviewed by me and is true and correct to the best of my knowledge and information, relying on information supplied by experts employed by Colowyo Coal Company or qualified consultants working for Colowyo Coal Company, and that I am a Professional Engineer licensed in Colorado as required by the provisions of C.R.S. 12-25-101 through C.R.S. 12-25-119. IN WITNESS WHEREOF, I have hereunder set my hand and affixed my seal.

Coal Stockpile Pond As-Built				
		SCALE: As Shown DATE: 4/18/18 DRWG. BY: Tony APPROVED BY: PW		
Colowyo Coal Company 5131 State Highway 13 Meeker, Colorado 81641		Figure 7-26M-1		
No.	REVISION	DATE	BY	CHK
TR-154	Revised Figure Number	4/28/22	Tony	LES