




No Name # 2

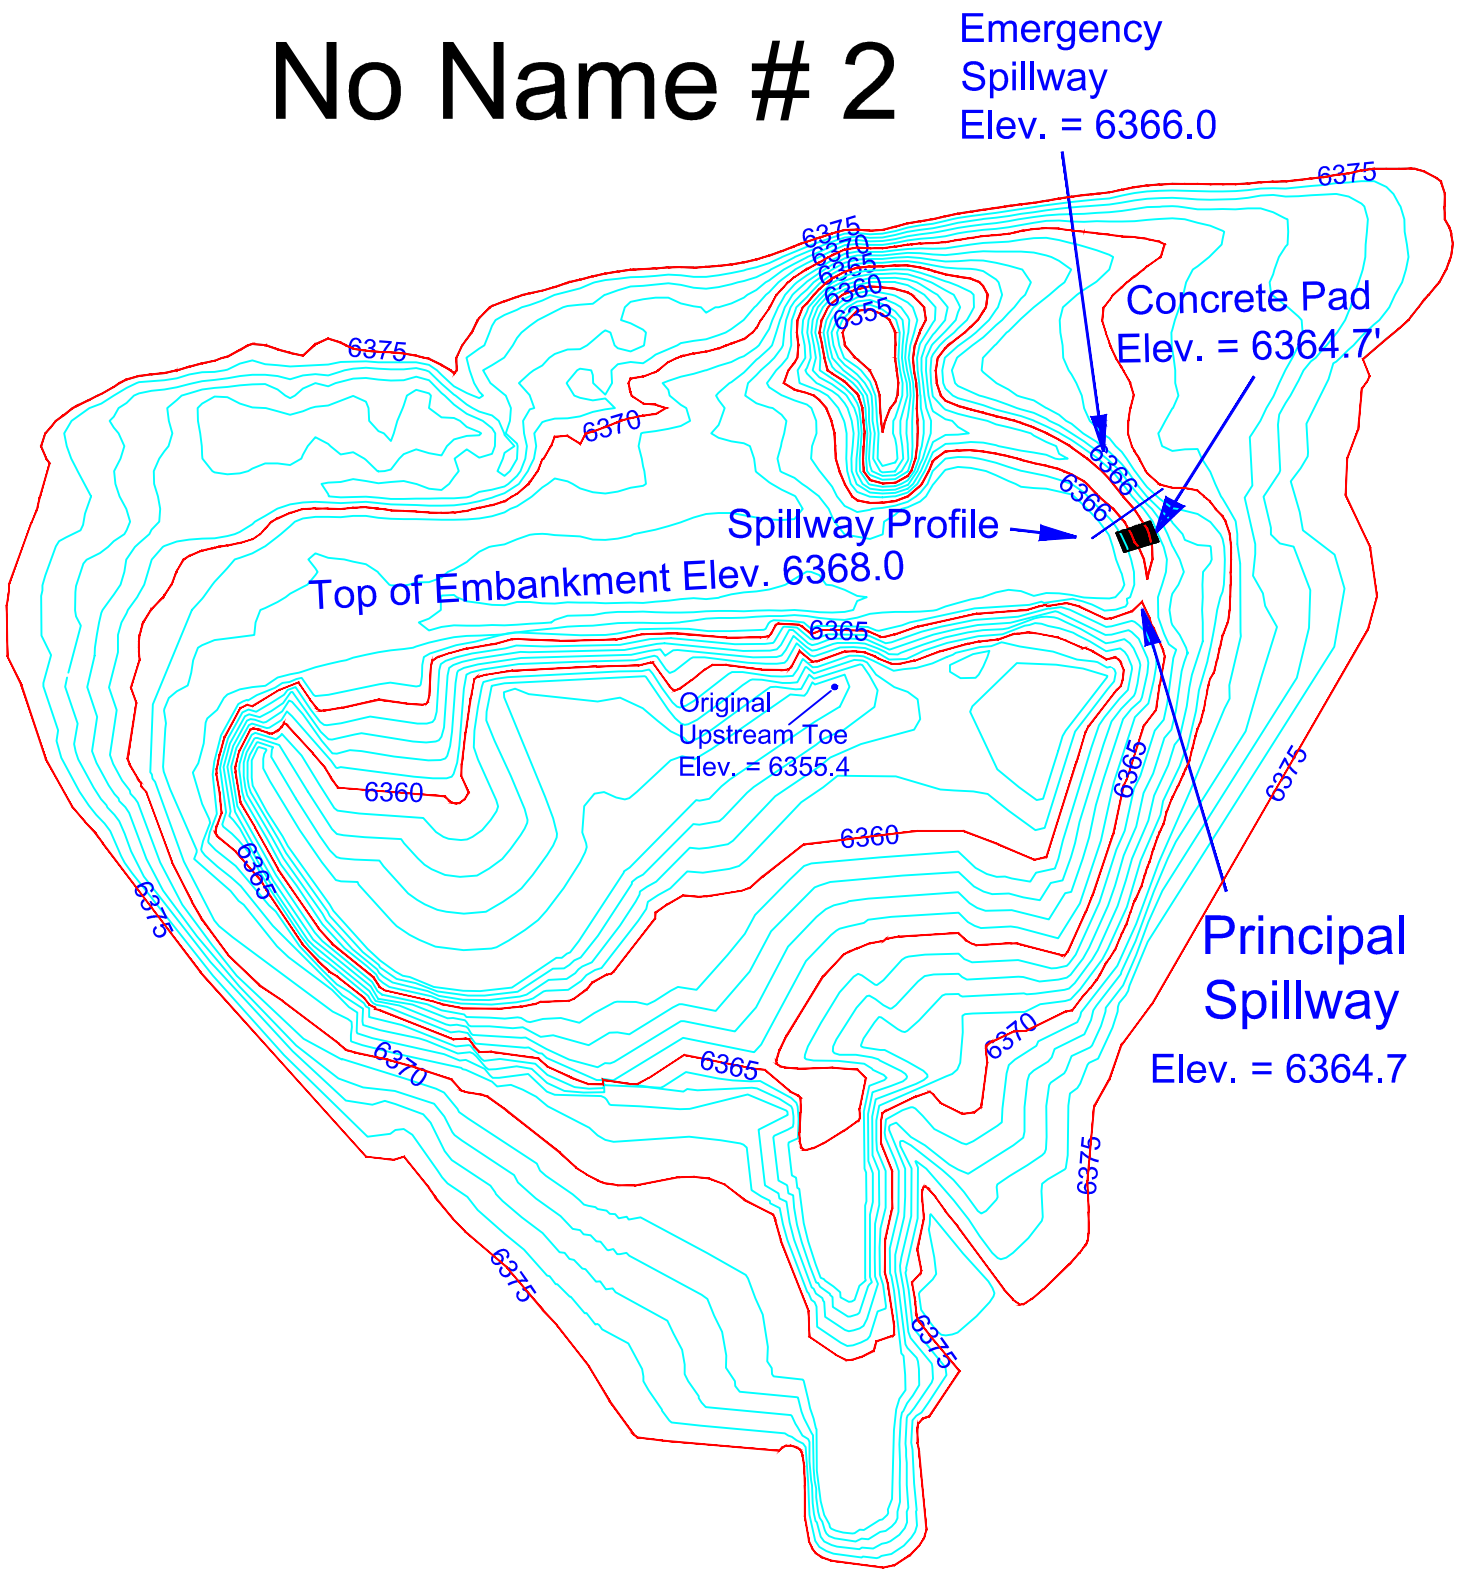

No Name # 2 Spillway Profile

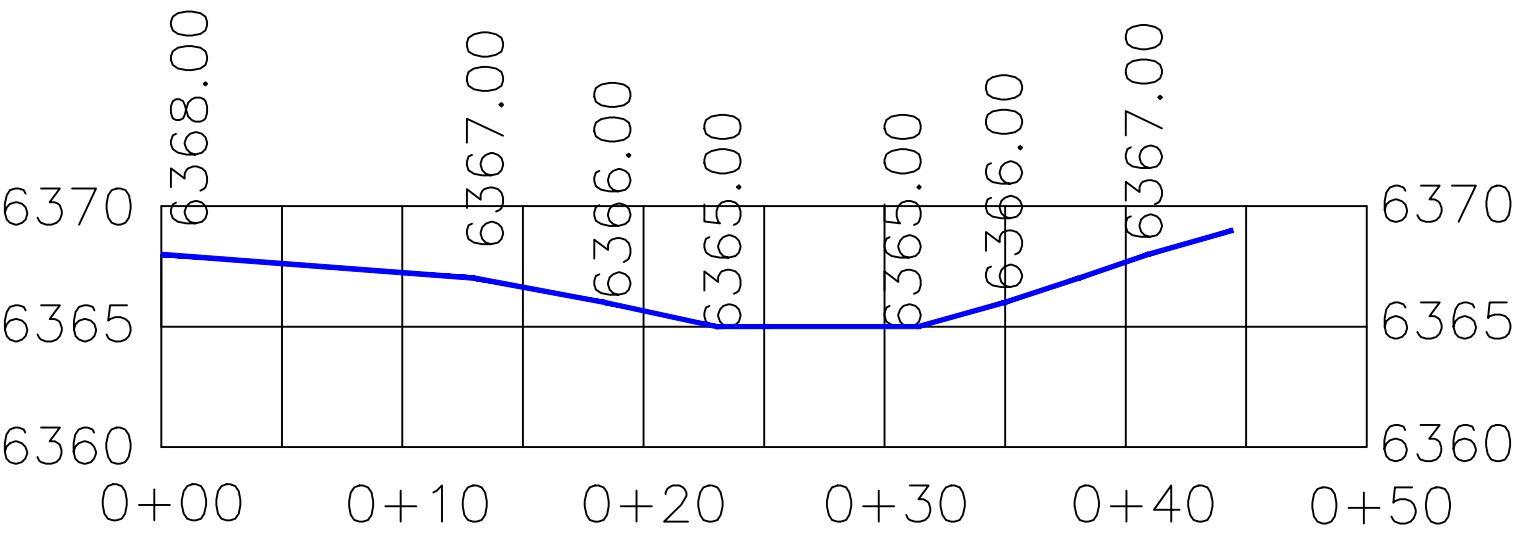

No Name # 2 Stage - Storage

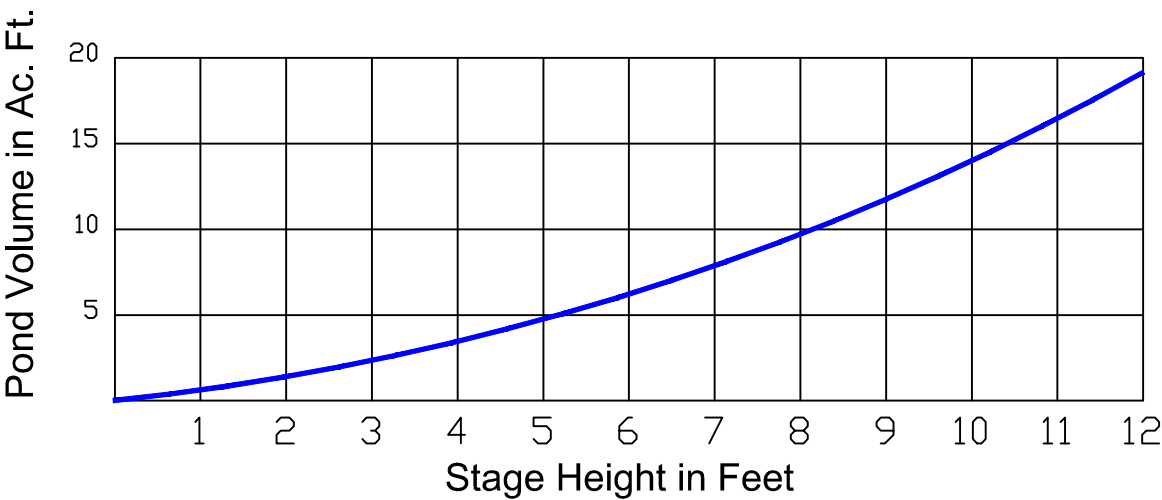


BY CONTOURS, ASBUILT POND CAPACITY IS 19.05 AC. FT.

PROFESSIONAL ENGINEER'S CERTIFICATION

I, Tonia M Perkins, a registered Professional Engineer in the State of Colorado, certify that this drawing has been reviewed by me, and the pond and embankment configuration is true and correct to the best of my knowledge and information.

Date _____

Tonia M. Perkins, CO PE No. 43864

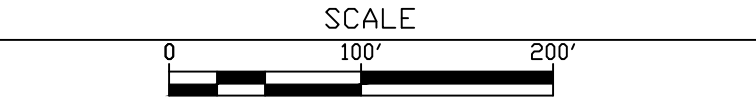

Revision	Date	By	Description
PR9	2/22/18	SH	As-Built
TR-131	5/26/22	WTC	No Name # 2 Spillway Modification
PR11	7/26/22	WTC	No Name # 2 "As-Built" Spillway Modification

TRAPPER MINING INC.

TRAPPER MINECRAIG, CO.

No Name Pond # 2
"As-Built"
Spillway Modification

SCALE: 1" = 100'
DRAWN BY: WTC
DATE: 7/26/2022

Sheet 1 of 1