


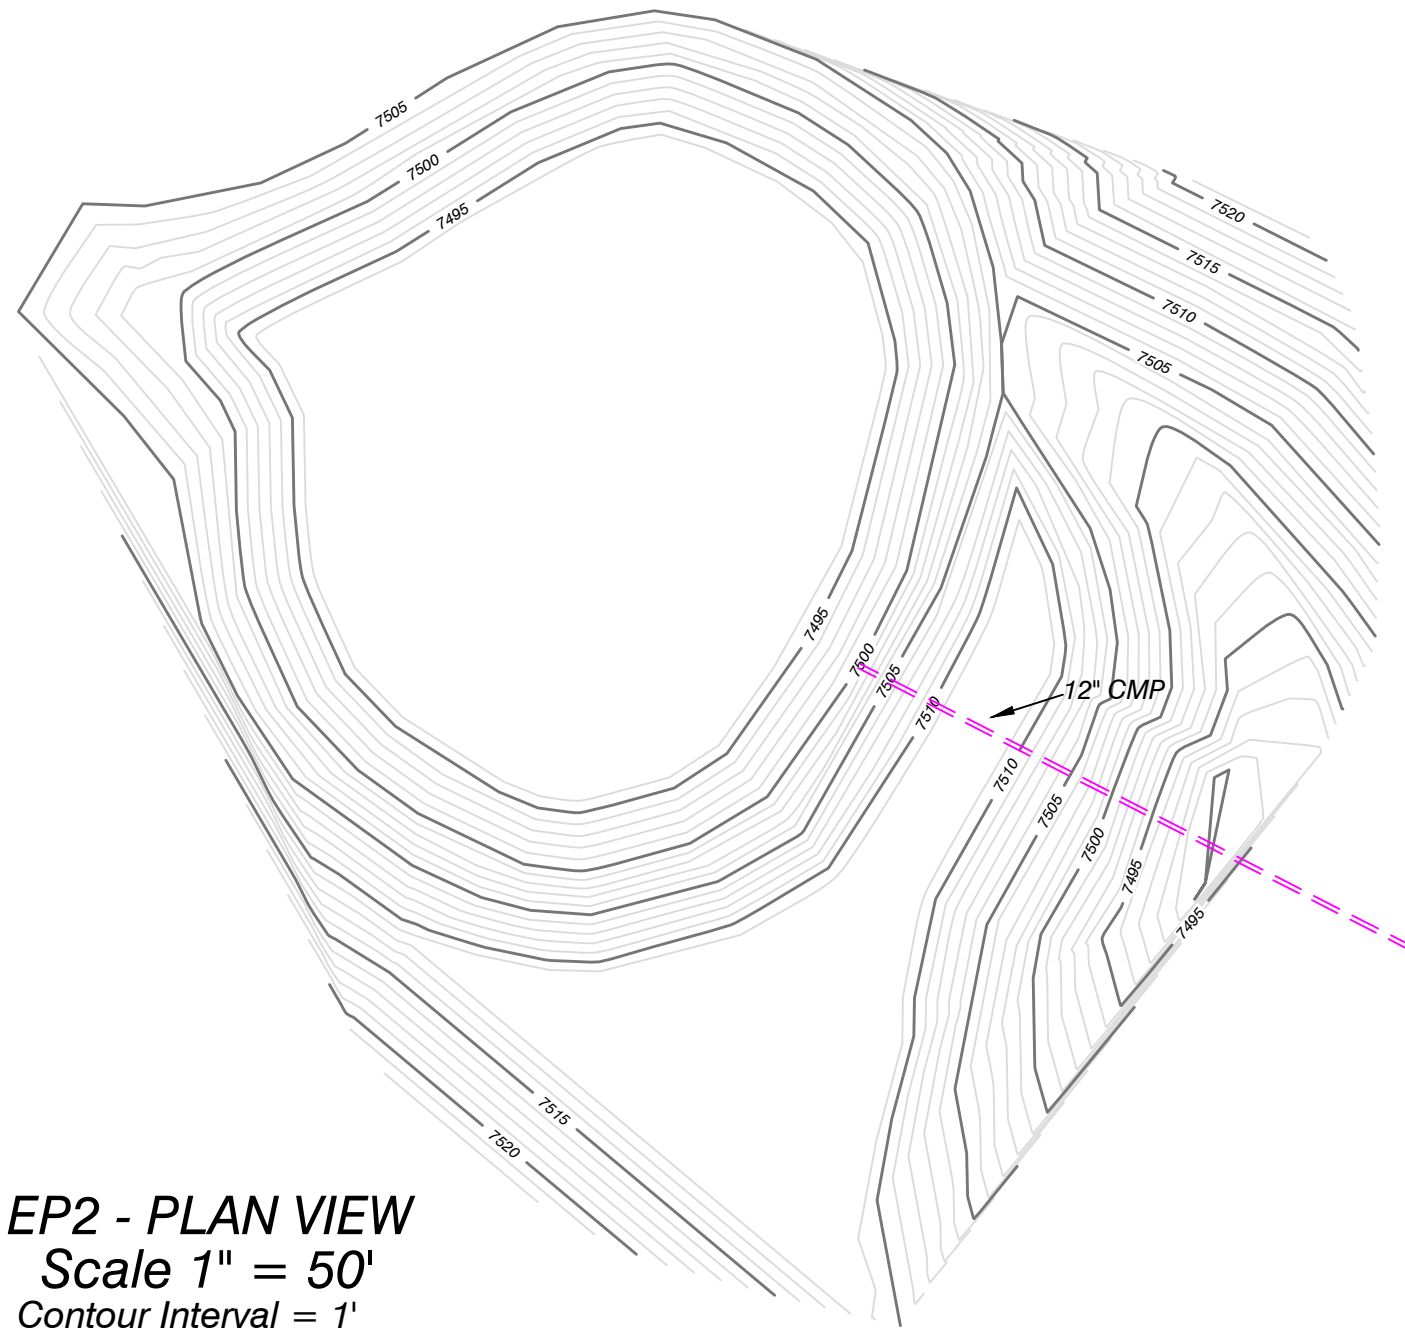

EP2 - PLAN VIEW
Scale 1" = 50'
Contour Interval = 1'


EP2 - Area Capacity Table

ELEV. (ft)	AREA (ac)	AVG. AREA	STORAGE (ac-ft)	ACC. STORAGE
7492.00	0.3851	0.4021	0.4021	0.4021
7493.00	0.4191	0.4367	0.4368	0.8397
7494.00	0.4543	0.4726	0.4724	1.3111
7495.00	0.4909	0.5100	0.5099	1.8211
7496.00	0.5291	0.5487	0.5488	2.3697
7497.00	0.5684	0.5887	0.5888	2.9583
7498.00	0.6090	0.6299	0.6298	3.5881
7499.00	0.6509	0.6724	0.6723	4.2605
7500.00	0.6940	0.7173	0.7184	4.9769
7501.00	0.7407	0.7637	0.7635	5.7424
7502.00	0.7887	0.8105	0.8104	6.5528
7503.00	0.8344	0.8592	0.8590	7.4118
7504.00	0.8839	0.9080	0.9081	8.3209
7505.00	0.9322	0.9322	0.9322	9.2530
7506.00	0.9322	0.9322	0.9322	10.1852
7507.00	0.9322	0.9322	0.9322	11.1174
7508.00	0.9322	0.9322	0.9322	12.0496
7509.00	0.9322	0.9322	0.9322	12.9817
7510.00	0.9322	0.9322	0.9322	12.9817

EP1 - Area Capacity Table

ELEV. (ft)	AREA (ac)	AVG. AREA (ac)	STORAGE (ac-ft)	ACC. STORAGE (ac-ft)
7370.00	0.0000	0.0459	0.0697	0.0697
7371.00	0.0618	0.1050	0.1051	0.1748
7372.00	0.1183	0.1292	0.1290	0.3038
7373.00	0.1402	0.1508	0.1507	0.4545
7374.00	0.1614	0.1727	0.1725	0.6270
7375.00	0.1840	0.1963	0.1962	0.8232
7376.00	0.2086	0.2223	0.2221	1.0454
7377.00	0.2360	0.2588	0.2589	1.3043
7378.00	0.2612	0.3054	0.3054	1.6097
7379.00	0.3297	0.3297	0.3297	1.9394
7380.00	0.3297	0.3297	0.3297	2.2691
7381.00	0.3297	0.3297	0.3297	2.5988
7382.00	0.3297	0.3297	0.3297	2.9285
7383.00	0.3297	0.3297	0.3297	3.2582
7384.00	0.3297	0.3297	0.3297	3.5880
7385.00	0.3297	0.3297	0.3297	3.5880

EP1 - PLAN VIEW
Scale 1" = 30'
Contour Interval = 1'

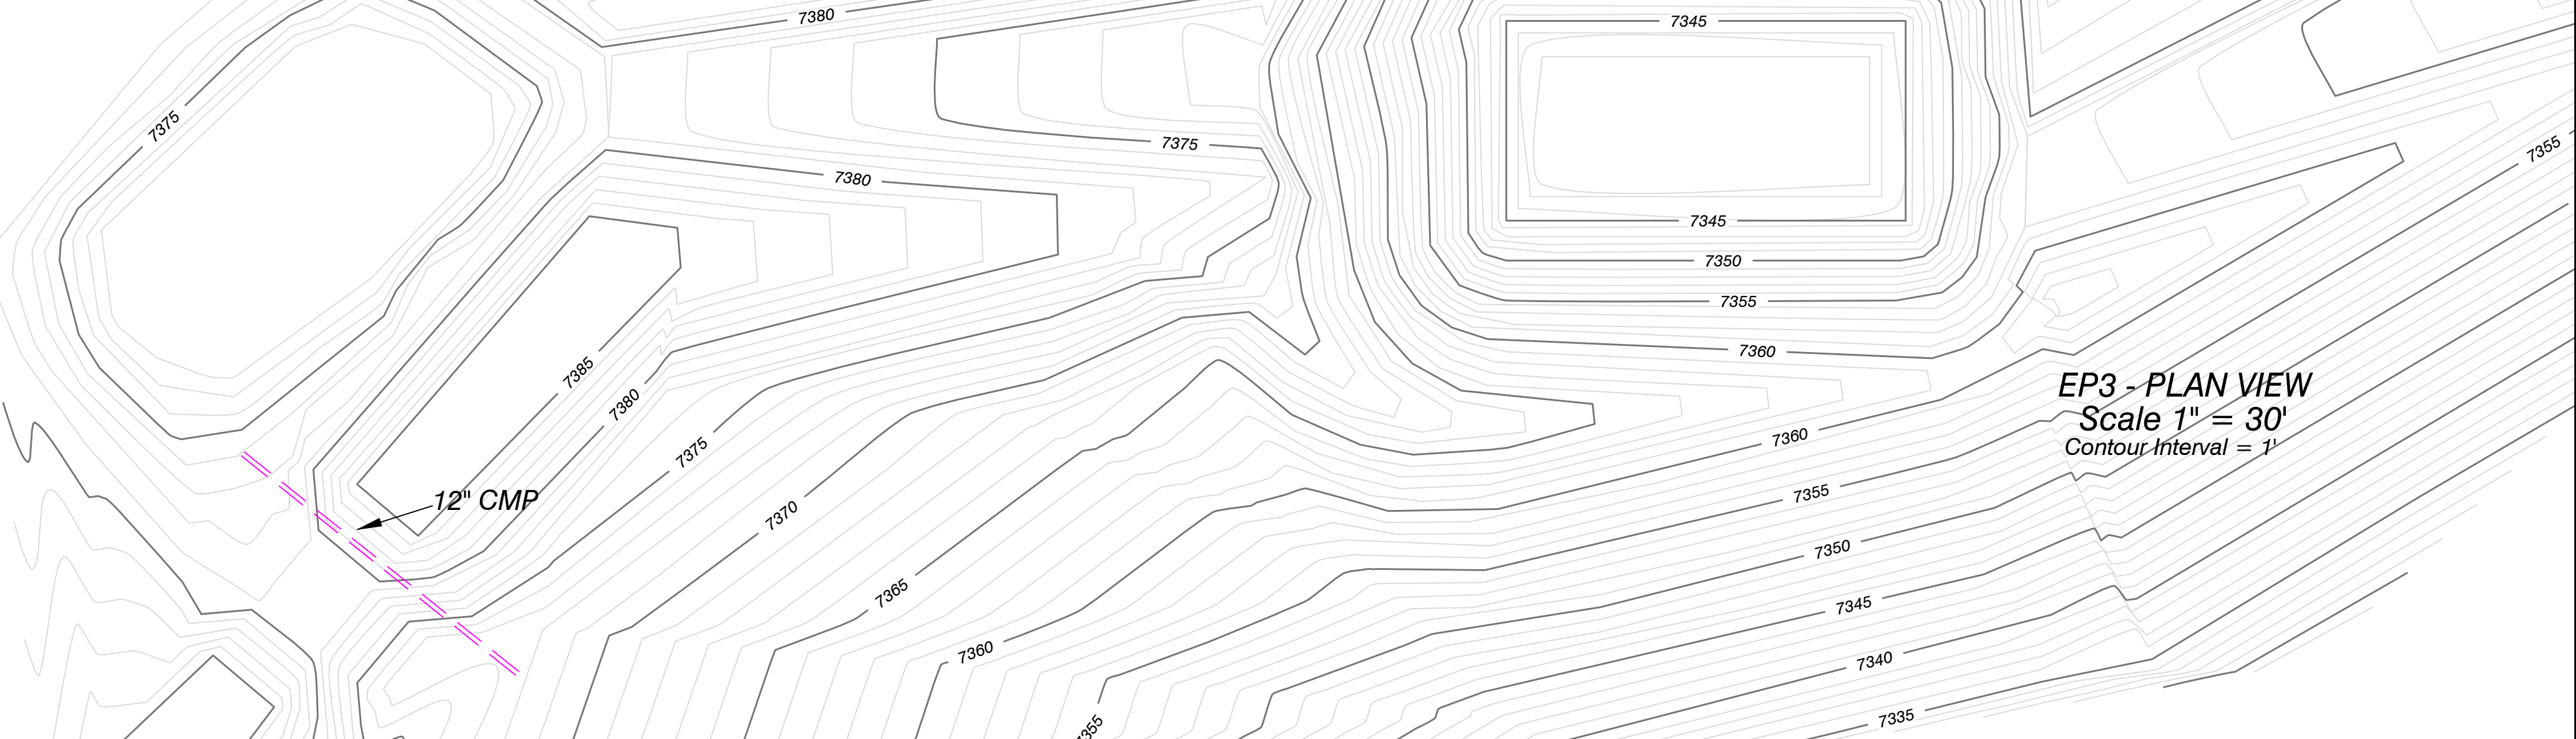

EP3 - PLAN VIEW
Scale 1" = 30'
Contour Interval = 1'

PD1 - Area Capacity Table

ELEVATION (Feet)	AREA (Acres)	AVERAGE AREA (Acres)	CAPACITY INCREMENTAL (Acres-Feet)	CUMULATIVE (Acres-Feet)
7348	0.0307	0.052	0.052	0
7349	0.0740	0.085	0.085	0.138
7350	0.0968	0.108	0.108	0.246
7351	0.1196	0.130	0.130	0.376
7352	0.1398	0.150	0.150	0.525
7353	0.1592	0.169	0.169	0.695
7354	0.1796	0.190	0.190	0.885
7355	0.2008	0.212	0.212	1.097
7356	0.2230			
TOTAL CAPACITY 1.097 ACRE-FEET (AS BUILT)				

PD2 - Area Capacity Table

ELEVATION (Feet)	AREA (Acres)	AVERAGE AREA (Acres)	CAPACITY INCREMENTAL (Acres-Feet)	CUMULATIVE (Acres-Feet)
7556	0.0542	0.070	0.070	0
7557	0.0860	0.096	0.096	0.166
7558	0.1061	0.117	0.117	0.283
7559	0.1272	0.139	0.139	0.421
7560	0.1501	0.162	0.162	0.584
7561	0.1745	0.187	0.187	0.771
7562	0.1999	0.213	0.213	0.984
7563	0.2266	0.240	0.240	1.224
7564	0.2531	0.267	0.267	1.491
7565	0.2803			
TOTAL CAPACITY 1.491 ACRE-FEET (AS BUILT)				

NTEP1 - Area Capacity Table

ELEVATION (Feet)	AREA (Acres)	AVERAGE AREA (Acres)	CAPACITY INCREMENTAL (Acres-Feet)	CUMULATIVE (Acres-Feet)
7378	0.0408	0.056	0.056	0
7379	0.0709	0.083	0.083	0.139
7380	0.0959	0.107	0.107	0.247
7381	0.1190	0.131	0.131	0.378
7382	0.1427	0.155	0.155	0.533
7383	0.1680	0.181	0.181	0.714
7384	0.1936	0.207	0.207	0.921
7385	0.2201	0.234	0.234	1.154
7386	0.2471	0.261	0.261	1.415
7387	0.2749	0.289	0.289	1.705
7388	0.3041	0.321	0.321	2.026
7389	0.3382			
TOTAL CAPACITY 2.026 ACRE-FEET (AS BUILT)				

EP3 - Area Capacity Table

ELEV. (ft)	AREA (ac)	AVG. AREA (ac)	STORAGE (ac-ft)	ACC. STORAGE (ac-ft)
7340.00	0.0319	0.0386	0.0386	0.0386
7341.00	0.0454	0.0528	0.0527	0.0913
7342.00	0.0602	0.0685	0.0684	0.1596
7343.00	0.0768	0.0859	0.0857	0.2454
7344.00	0.0949	0.1049	0.1047	0.3501
7345.00	0.1148	0.1220	0.1220	0.4721
7346.00	0.1292	0.1367	0.1367	0.6087
7347.00	0.1442	0.1520	0.1519	0.7607
7348.00	0.1597	0.1678	0.1677	0.9284
7349.00	0.1758	0.1841	0.1841	1.1125
7350.00	0.1924	0.2010	0.2010	1.3135
7351.00	0.2096	0.2185	0.2184	1.5319
7352.00	0.2273	0.2365	0.2364	1.7683
7353.00	0.2456	0.2550	0.2549	2.0233
7354.00	0.2644	0.2741	0.2740	2.2973
7355.00	0.2838	0.2941	0.2940	2.5912
7356.00	0.3044	0.3133	0.3146	2.9058
7357.00	0.3223	0.3224	0.3225	3.2283
7358.00	0.3225	0.3225	0.3225	3.5509
7359.00	0.3225	0.3225	0.3225	3.8734
7360.00	0.3225	0.3225	0.3225	4.1960

PD1 - PLAN VIEW
Scale 1" = 30'
Contour Interval = 1'

