



- NOTES:
1. ACCORDING TO COLORADO LAW YOU MUST COMMENCE ANY LEGAL ACTION BASED UPON ANY DEFECT IN THIS SURVEY WITHIN THREE YEARS AFTER YOU FIRST DISCOVER SUCH DEFECT. IN NO EVENT MAY ANY ACTION BASED UPON ANY DEFECT IN THIS SURVEY BE COMMENCED MORE THAN TEN YEARS FROM THE DATE OF THE CERTIFICATION SHOWN HEREON.
 2. COORDINATES AND ELEVATIONS SHOWN HEREON ARE BASED UPON EXISTING CONTROL POINT INFORMATION PROVIDED BY NEWMONT AND JHL CONSTRUCTORS, INC. DATED 08/17/2022
 3. ALL DISTANCES SHOWN HEREON, IF ANY, ARE GROUND DISTANCES AND MEASURED IN U.S. SURVEY FEET.
 4. CONTOURS SHOWN HEREON ARE BASED UPON AERIAL SURVEY PERFORMED BY JHL CONSTRUCTORS, INC. ON OCTOBER 24, 2022. KIMLEY-HORN IS NOT RESPONSIBLE FOR THE LOCATION OF ANY IMPROVEMENTS PLACED, OR SITE MODIFICATIONS, AFTER THE DATE OF FINAL FIELD SURVEY.

LEGEND	
	AS-BUILT OF TOP OF SOIL LINER FILL - MAJOR CONTOUR
	AS-BUILT OF TOP OF SOIL LINER FILL - MINOR CONTOUR
	POINT NUMBER
	AS-BUILT HVP - CPEP 4"
	AS-BUILT HVP - CPEP 8"
	AS-BUILT HVP - CPEP 12"
	AS-BUILT HVP - CPEP 18"
	AS-BUILT HVP - CPEP 24"
	AS-BUILT HVP - HDPE 30"
	AS-BUILT SACRIFICIAL PIPE - 12"

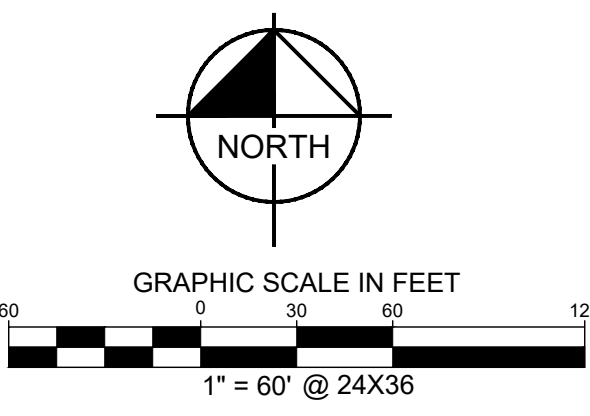

SURVEYOR'S STATEMENT:

I, DARREN R. WOLTERSTORFF, A REGISTERED PROFESSIONAL LAND SURVEYOR IN THE STATE OF COLORADO, DO HEREBY CERTIFY ONLY TO JHL CONSTRUCTORS, INC. AND CRIPPLE CREEK & VICTOR GOLD MINING COMPANY THAT FROM APRIL 2022 THROUGH JANUARY 2023, AS-BUILT SURVEYS WERE CONDUCTED UNDER MY SUPERVISION AND THE MAP HEREIN ACCURATELY REPRESENT SAID SURVEYS TO THE BEST OF MY KNOWLEDGE, INFORMATION AND BELIEF, IS IN ACCORDANCE WITH APPLICABLE STANDARDS OF PRACTICE AND IS NOT A GUARANTY OR WARRANTY, EITHER EXPRESSED OR IMPLIED.

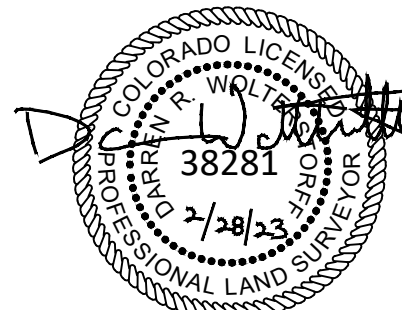

DARREN R. WOLTERSTORFF, PLS 38281
FOR AND ON BEHALF OF KIMLEY-HORN AND ASSOCIATES, INC.

OUTSIDE OF PSSA HIGH VOLUME PIPING
AS-BUILT EXHIBIT
VLF2 PHASE 3
LYING IN SECTIONS 18 AND 19, TOWNSHIP 15 SOUTH,
RANGE 69 WEST OF THE 6TH P.M.,
COUNTY OF TELLER, STATE OF COLORADO

Kimley»Horn

4582 SOUTH ULSTER ST., # 1300
DENVER, COLORADO 80237

Tel. No. (303) 228-2300
www.kimley-horn.com

No.	DATE	REVISION DESCRIPTION

Scale	Drawn by	Checked by	Date	Project No.	Sheet No.
1" = 60'	CAD	DRW	02/28/2023	196346001	12a

DWG NAME: C:\USERS\DARREN.WOLTERSTORFF\ONE DRIVE - KHP\PROJECTS\18034001 NEWMONT JHL CRIPPLE CREEK AS-BUILT DRAWINGS\12 OUTSIDE OF PSSA HIGH VOLUME PIPING AS-BUILT EXHIBIT.DWG PLOTTED BY: WOLTERSTORFF, DARREN 2/28/2023 11:32 AM LAST SAVED: 2/27/2023 12:33 PM

POINT TABLE				
NO.	NORTHING	EASTING	ELEVATION	DESCRIPTION
2000	59094.1640	35846.6870	10000.12	HV 4IN P-1
2001	59101.0490	35915.9960	10000.08	HV 4IN P-2
2002	59108.4310	35984.7920	10000.09	HV 4IN P-3
2003	59146.8340	36043.9740	9999.92	HV 4IN P-4
2004	59145.0890	36044.6510	9999.81	HV 4IN P-5
2005	59147.0950	36044.0160	9999.92	HV 12IN P-1
2006	59177.1260	36043.9450	9999.97	HV 8IN P-1
2007	59184.4730	36043.6380	10000.14	HV 4IN P-7
2008	59240.0680	36034.1650	9999.93	HV 4IN P-8
2009	59162.7210	36011.8910	9988.49	HV 8IN P-2
2010	59332.7920	36007.6370	9999.98	HV 4IN P-9
2011	59405.5590	35988.5320	10000.40	HV 12IN P-2
2012	59472.2710	35963.2150	9999.64	HV 8IN P-3
2013	59473.4780	35963.7780	9999.68	HV 4IN P-10
2014	59473.6850	35963.0170	9999.66	HV 4IN P-11
2015	59479.2930	35966.9220	9999.99	HV 4IN P-12
2016	59490.0330	35963.3900	10000.02	HV 4IN P-13
2017	59558.3860	35896.6910	10000.39	HV 4IN P-14
2018	59592.8310	35829.4510	9994.22	HV 4IN P-15
2019	59542.5530	35765.3320	9958.72	HV 4IN P-16
2020	59401.8320	35692.3570	9954.66	HV 4IN P-17
2021	59402.8210	35631.4440	9951.72	HV 8IN P-4
2022	59399.2490	35820.7620	9961.12	HV 8IN P-5
2023	59493.3380	35813.0000	9960.68	HV 4IN P-18
2024	59400.0700	35764.5870	9958.56	HV 4IN P-19
2025	59384.9660	35914.7320	9966.55	HV 8IN P-6
2026	59384.9150	35914.7600	9966.57	HV 12IN P-3
2027	59384.6290	35914.9990	9966.54	HV 4IN P-20
2028	59363.6860	35921.7180	9967.49	HV 4IN P-21
2029	59363.8330	35893.1610	9964.84	HV 4IN P-22
2030	59364.2250	35892.6670	9964.88	HV 4IN P-23
2031	59330.8220	35819.1750	9961.53	HV 4IN P-24
2032	59331.7050	35771.4300	9959.27	HV 4IN P-25
2033	59331.1300	35770.8670	9959.21	HV 4IN P-26
2034	59297.9070	35823.1990	9962.28	HV 4IN P-27
2035	59297.5430	35823.8280	9962.32	HV 4IN P-28
2036	59295.0780	35820.6310	9962.29	HV 12IN P-4
2037	59294.5970	35820.9090	9962.22	HV 12IN P-5
2038	59295.2350	35935.3250	9967.80	HV 4IN P-29
2039	59262.0960	35864.2580	9964.83	HV 4IN P-30
2040	59228.0770	35910.1610	9967.50	HV 4IN P-31
2041	59226.7460	35968.5360	9970.71	HV 4IN P-32
2042	59191.3910	35959.0890	9970.42	HV 4IN P-33
2043	59180.9860	35974.3800	9971.34	HV 12IN P-6
2044	59294.8700	35820.4460	9962.22	HV 18IN P-1
2045	59376.2980	35711.0110	9955.86	HV 18IN P-2
2046	59385.8320	35681.9930	9954.28	HV 4IN P-34
2047	59222.9800	35662.8730	9960.26	HV 4IN P-35
2048	59207.3930	35655.0240	9968.62	HV 4IN P-36
2049	59216.3700	35664.9460	9961.79	HV 8IN P-7
2050	59313.9810	35633.4370	9952.99	HV 4IN P-37
2051	59284.8830	35618.6120	9958.67	HV 4IN P-38
2052	59356.6670	35579.2960	9951.40	HV 4IN P-39
2053	59405.6580	35604.1340	9950.38	HV 4IN P-40
2054	59411.5370	35602.2700	9950.24	HV 8IN P-8
2055	59418.8830	35582.0430	9949.12	HV 18IN P-3
2056	58848.3670	34751.0800	9949.18	HV 12IN P-7
2057	58873.3250	34820.7200	9960.62	HV 12IN P-8
2058	58879.2080	35019.3770	9999.16	HV 4IN P-43
2059	59014.9070	35026.7210	10012.66	HV 4IN P-44

POINT TABLE				
NO.	NORTHING	EASTING	ELEVATION	DESCRIPTION
2060	58975.1960	35024.2740	10008.49	HV 4IN P-45
2061	59005.2970	35058.1200	10012.48	HV 4IN P-46
2062	58964.4140	35115.6620	10019.60	HV 4IN P-47
2063	58879.1780	35019.4490	9999.11	HV 4IN P-48
2064	59005.3630	35068.4280	10012.62	HV 4IN P-49
2065	59030.5780	35101.9270	10014.57	HV 4IN P-50
2066	58902.3480	35186.4910	10030.37	HV 4IN P-51
2067	58883.5830	35274.8180	10037.43	HV 4IN P-52
2068	58897.4470	35284.0500	10035.31	HV 4IN P-53
2069	58932.6230	35322.7070	10032.22	HV 4IN P-54
2070	58993.4040	35277.2860	10026.16	HV 4IN P-55
2071	58976.0810	35255.3450	10027.19	HV 4IN P-56
2072	59027.6550	35210.7830	10022.03	HV 4IN P-57
2073	59088.5860	35290.2310	10020.19	HV 4IN P-58
2074	59017.8660	35343.6610	10024.63	HV 4IN P-59
2075	59135.3190	35297.1540	10018.33	HV 8IN P-9
2076	58892.4910	35263.5320	10035.88	HV 8IN P-10
2077	58994.1370	35097.4400	10014.90	HV 8IN P-11
2078	59079.4830	35108.1030	10014.55	HV 8IN P-12
2079	58998.9320	35756.4690	9999.92	HV 24IN P-1
2080	59001.6530	35756.9000	9999.88	HV 24IN P-2
2081	59004.3010	35756.8070	10000.01	HV 24IN P-3
2082	59031.7800	35687.0980	9991.03	HV 24IN P-4
2083	59028.9860	35686.5290	9991.32	HV 24IN P-5
2084	59026.7710	35685.9590	9991.76	HV 24IN P-6
2085	59034.8000	35668.6470	9989.27	HV 24IN P-7
2086	59036.9510	35669.6740	9988.97	HV 24IN P-8
2087	59039.7010	35670.5780	9988.93	HV 24IN P-9
2088	59051.3150	35651.9880	9986.12	HV 24IN P-10
2089	59048.9660	35650.9050	9986.27	HV 24IN P-11
2090	59046.8190	35649.6500	9986.36	HV 24IN P-12
2091	59064.9560	35627.1090	9982.80	HV 24IN P-13
2092	59067.8470	35627.7220	9982.62	HV 24IN P-14
2093	59065.8240	35633.7300	9983.29	HV 24IN P-15
2094	59084.4400	35608.8880	9979.60	HV 24IN P-16
2095	59086.1840	35610.7330	9979.54	HV 24IN P-17
2096	59087.2890	35613.1040	9979.65	HV 24IN P-18
2097	59108.0010	35598.3030	9976.50	HV 24IN P-19
2098	59107.0990	35595.7880	9976.49	HV 24IN P-20
2099	59106.0340	35593.4390	9976.44	HV 24IN P-21
2100	59129.5640	35580.8890	9973.17	HV 24IN P-22
2101	59130.9470	35583.3360	9973.10	HV 24IN P-23
2102	59131.5280	35585.7310	9973.19	HV 24IN P-24
2103	59172.0450	35567.1110	9967.90	HV 24IN P-25
2104	59171.3860	35564.4740	9967.86	HV 24IN P-26
2105	59170.2740	35562.2210	9967.81	HV 24IN P-27
2106	59208.2090	35544.5950	9963.11	HV 24IN P-28
2107	59212.2910	35545.6190	9962.56	HV 24IN P-29
2108	59213.3120	35547.8620	9962.49	HV 24IN P-30
2109	59251.7660	35530.2010	9957.53	HV 24IN P-31
2110	59250.6810	35527.8830	9957.47	HV 24IN P-32
2111	59246.1170	35527.1120	9958.06	HV 24IN P-33
2112	59284.1930	35509.5810	9953.27	HV 24IN P-34
2113	59283.6790	35512.4080	9953.16	HV 24IN P-35
2114	59283.4510	35515.3850	9953.32	HV 24IN P-36
2117	58884.0270	35022.8910	9999.05	HV 4IN P-42
2118	58887.5990	35027.1310	9999.16	HV 4IN P-60
2119	58890.9710	35031.2240	9999.28	HV 4IN P-61
2120	59011.6500	35033.4220	10012.63	HV 4IN P-62
2121	59011.2520	35042.5750	10012.62	HV 4IN P-63

POINT TABLE				
NO.	NORTHING	EASTING	ELEVATION	DESCRIPTION
2122	59027.5470	35697.8840	9992.40	HV 4IN P-64
2123	59069.2400	35793.0260	9999.98	HV 4IN P-65
2124	59071.3710	35628.2970	9982.22	HV 4IN P-66
2125	59116.3290	35730.9890	9992.43	HV 4IN P-67
2126	59126.5080	35588.4480	9973.81	HV 4IN P-68
2127	59141.9230	35684.5520	9980.56	HV 4IN P-69
2128	59135.0200	35617.9270	9974.50	HV 4IN P-70
2129	59179.9170	35564.5430	9966.88	HV 4IN P-71
2130	59261.2990	35529.9380	9956.44	HV 4IN P-72
2131	59217.4480	35540.2440	9961.85	HV 4IN P-73
2132	59129.5440	35517.2010	9989.20	HV 4IN P-74
2133	59310.8520	35486.4160	9949.73	HV 4IN P-75
2134	59019.9910	35702.3860	9993.48	HV 4IN P-76
2135	59001.2590	35677.7290	10000.14	HV 4IN P-77
2136	58995.7220	35720.8560	10000.13	HV 4IN P-78
2137	59019.8730	35702.4670	9993.59	HV 8IN P-13
2138	59114.5540	35588.4570	9975.18	HV 8IN P-14
2139	59051.4200	35504.8310	10000.12	HV 8IN P-15
2140	59082.1970	35545.4470	9978.85	HV 4IN P-79
2141	59014.8080	35585.5250	9999.97	HV 4IN P-80
2142	59112.3760	35496.6120	9999.39	HV 4IN P-81
2143	59429.6550	35550.0930	9947.58	HV 18IN P-4
2144	58981.3130	35044.6470	10010.54	HV 4IN P-82
2145	58956.0160	35038.7100	10006.38	HV 4IN P-83
2146	59326.5310	35140.0240	9999.71	HV 8IN P-16
2147	59262.6700	35047.2060	10011.42	HV 4IN P-84
2148	59326.5810	35139.8240	9999.73	HV 4IN P-85
2149	59219.3780	35125.9240	10013.05	HV 4IN P-86
2150	59169.1260	35059.7630	10013.38	HV 4IN P-87
2151	59124.9670	35113.9470	10014.77	HV 4IN P-88
2152	59072.8410	35045.0820	10013.36	HV 4IN P-89
2153	59276.6390	35317.2130	9986.52	HV 8IN P-17
2154	59183.1770	35303.8790	10015.51	HV 4IN P-90
2155	59074.4060	35159.9470	10019.20	HV 4IN P-91
2156	58947.6650	35482.2450	10024.21	HV 4IN P-92
2157	58951.9110	35469.1680	10033.19	HV 4IN P-93
2158	58817.2580	35410.2330	10038.51	HV 4IN P-94
2159	58839.7730	35463.8020	10034.55	HV 4IN P-95
2160	58894.0410	35535.7810	10029.60	HV 4IN P-96
2161	58916.6130	35565.7720	10029.14	HV 4IN P-97
2162	58870.5270	35612.3500	10012.06	HV 4IN P-98
2163	59513.6880	35467.5050	9944.10	HV 4IN P-99
2164	59508.3230	35737.7230	9956.95	HV 4IN P-100
2165	59483.5560	35671.4990	9953.68	HV 4IN P-101
2166	59470.9640	35473.8100	9943.71	HV 4IN P-102
2167	59505.8090	35316.4880	9937.98	HV 4IN P-103
2168	59601.3040	35305.0220	9983.25	HV 4IN P-104
2169	59497.2510	35444.8440	9942.71	HV 24IN P-37
2170	59496.0290	35446.2220	9942.73	HV 24IN P-38
2171	59539.5580	35489.1940	9945.52	HV 24IN P-39
2172	59538.4330	35490.6130	9945.61	HV 24IN P-40
2173	59570.2650	35514.1380	9947.36	HV 8IN P-18
2174	59645.3090	35513.7840	9971.37	HV 8IN P-19
2175	59645.5830	35513.7140	9971.50	HV 4IN P-105
2176	59640.3820	35510.7060	9970.95	HV 4IN P-106
2177	59647.7290	35583.1890	9952.33	HV 4IN P-107
2178	59685.7260	35622.5950	9954.03	HV 24IN P-41
2179	59683.9020	35623.8720	9955.07	HV 24IN P-42
2180	59570.2308	35643.0860	9967.17	HV 4IN P-108
2181	59580.3920	35529.6940	9948.20	HV 4IN P-109