


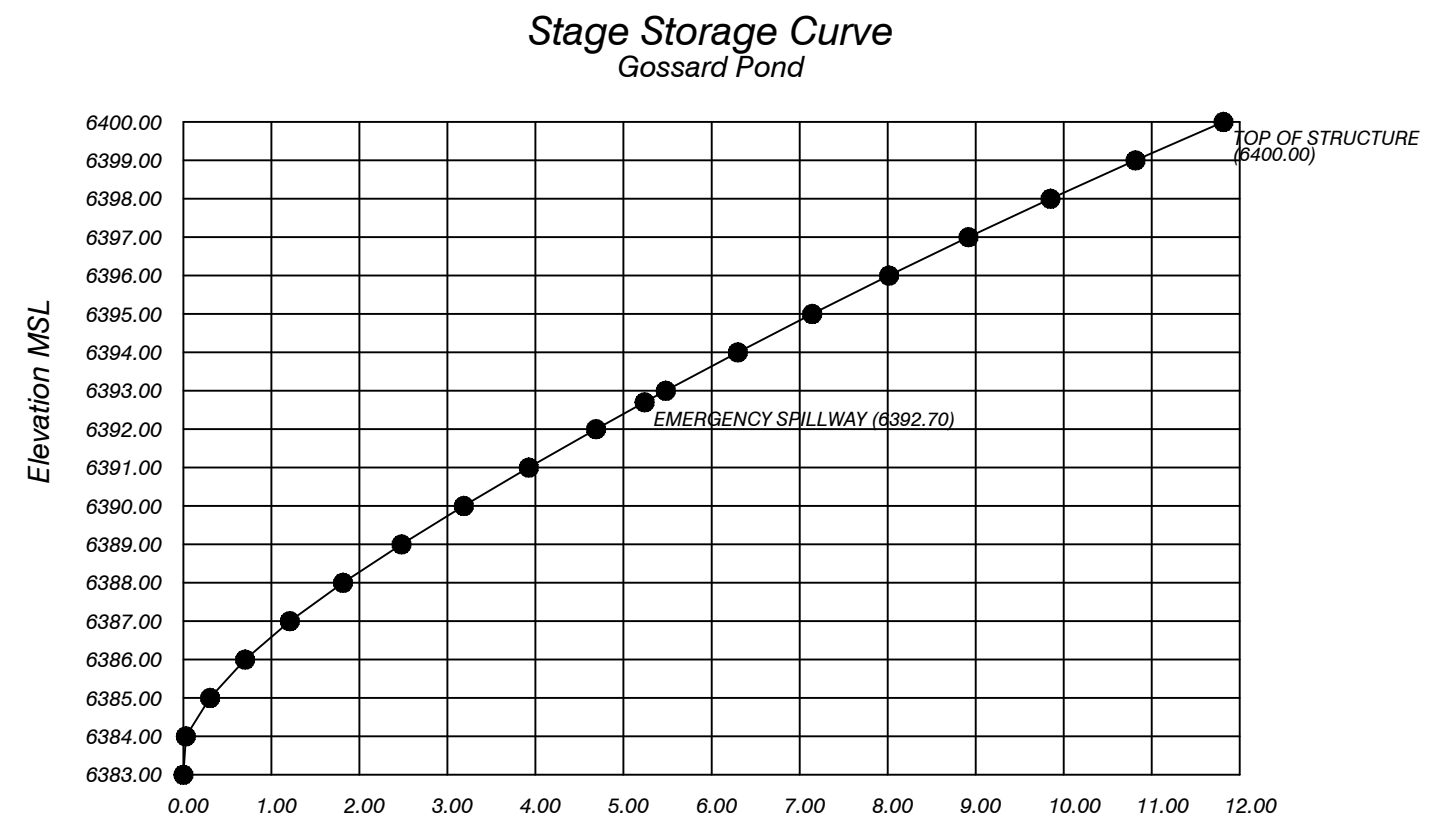


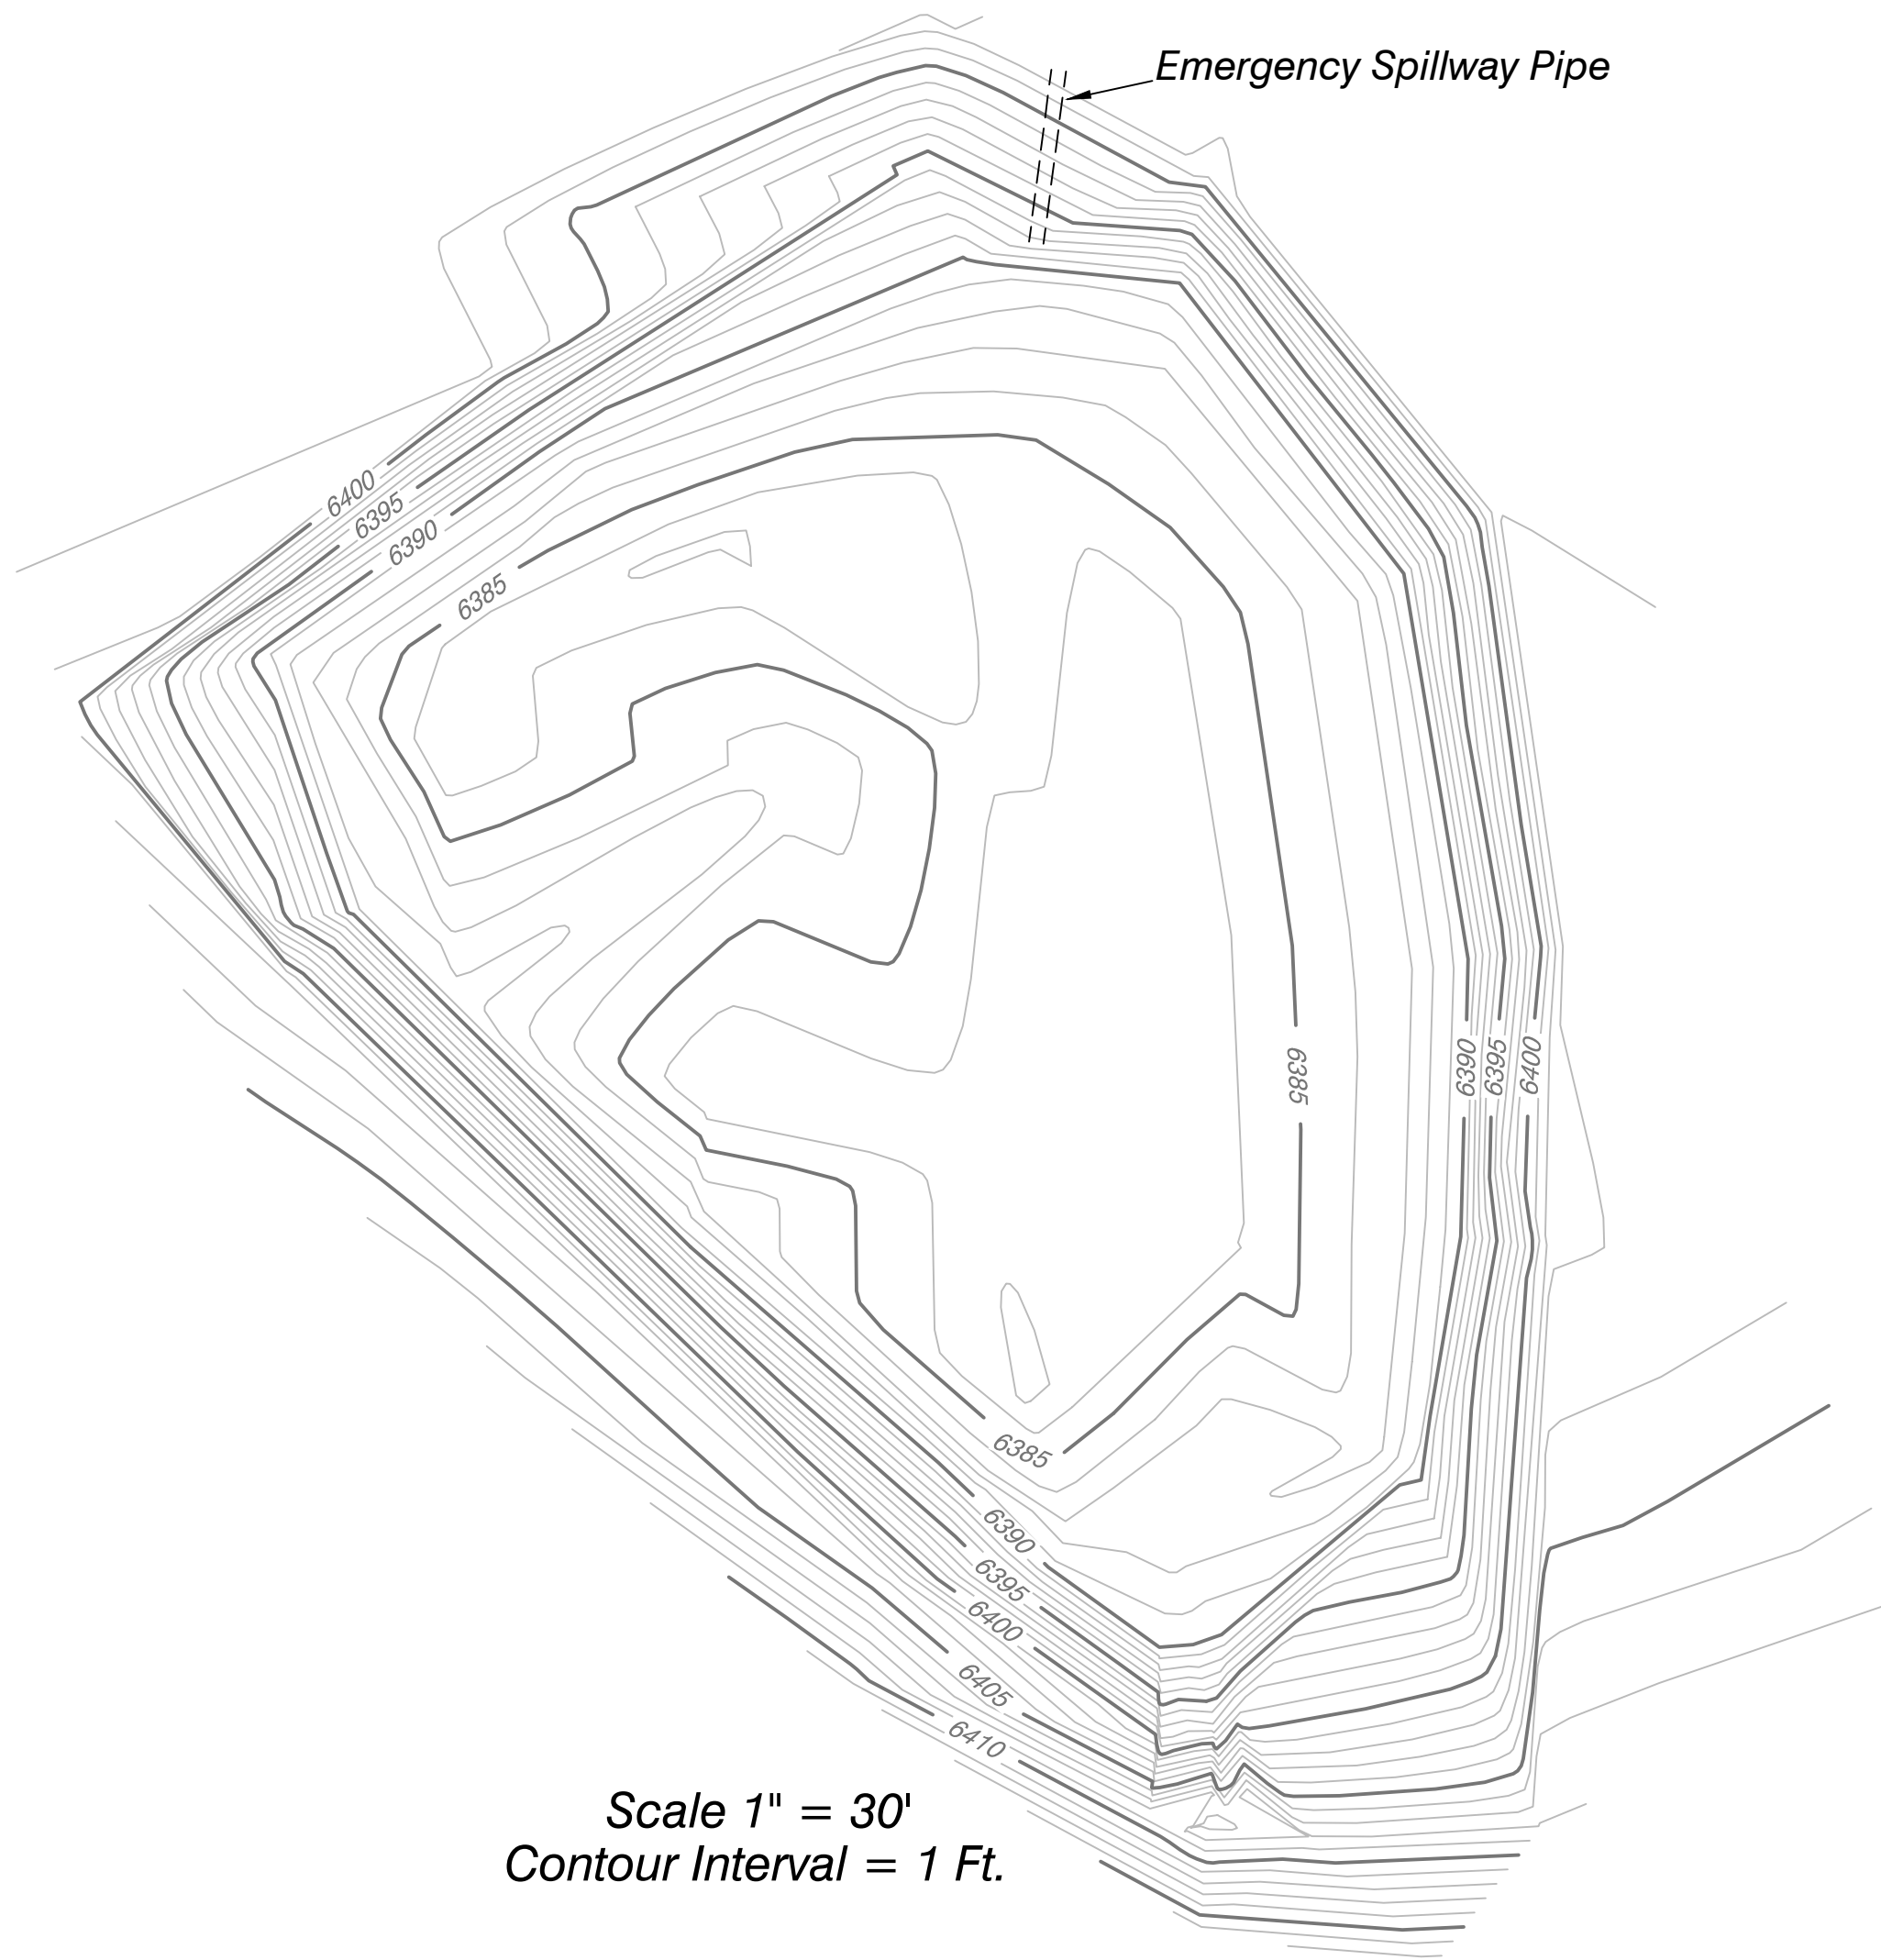

Accumulative Storage (Acre-Ft)								
Storage Volume Computations								
ELEV. (ft)	Width (ft)	LENGTH (ft)	AREA (ac)	AVG. AREA (ac)	INTERVAL (ft)	STORAGE (ac-ft)	ACC. STORAGE (ac-ft)	STAGE INTERVAL (ft)
6383.00	N/A	N/A	0.0000	0.0325	1.00	0.0278	0.0278	1.00
6384.00	N/A	N/A	0.0650	0.2009	1.00	0.2746	0.3024	2.00
6385.00	N/A	N/A	0.3368	0.3972	1.00	0.3984	0.7008	3.00
6386.00	N/A	N/A	0.4576	0.5065	1.00	0.5084	1.2092	4.00
6387.00	N/A	N/A	0.5553	0.5963	1.00	0.6043	1.8135	5.00
6388.00	N/A	N/A	0.6373	0.6634	1.00	0.6649	2.4784	6.00
6389.00	N/A	N/A	0.6895	0.7068	1.00	0.7070	3.1854	7.00
6390.00	N/A	N/A	0.7242	0.7379	1.00	0.7380	3.9234	8.00
6391.00	N/A	N/A	0.7516	0.7649	1.00	0.7648	4.6882	9.00
6392.00	N/A	N/A	0.7782	0.7876	0.70	0.5513	5.2395	9.70
6392.70	N/A	N/A	0.7970	0.7916	0.30	0.2404	5.4799	10.00
6393.00	N/A	N/A	0.8051	0.8182	1.00	0.8182	6.2981	11.00
6394.00	N/A	N/A	0.8314	0.8450	1.00	0.8450	7.1431	12.00
6395.00	N/A	N/A	0.8587	0.8729	1.00	0.8728	8.0158	13.00
6396.00	N/A	N/A	0.8870	0.9021	1.00	0.9021	8.9179	14.00
6397.00	N/A	N/A	0.9171	0.9329	1.00	0.9329	9.8508	15.00
6398.00	N/A	N/A	0.9487	0.9654	1.00	0.9654	10.8161	16.00
6399.00	N/A	N/A	0.9822	0.9980	1.00	0.9986	11.8147	17.00
6400.00	N/A	N/A	1.0139					

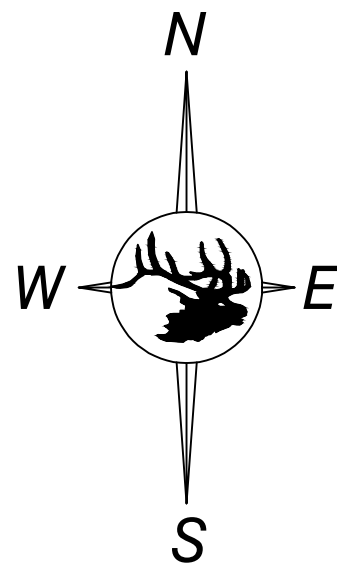

ENGINEERS CERTIFICATION
I, LEE E. SAMPSON, hereby certify that this map has been reviewed by me and is true and correct to the best of my knowledge and information, relying on information supplied by experts employed by Colowyo Coal Company or qualified consultants working for Colowyo Coal Company, and that I am a Professional Engineer licensed in Colorado as required by the provisions of C.R.S. 12-25-101 through C.R.S. 12-25-119. IN WITNESS WHEREOF, I have hereunder set my hand and affixed my seal.

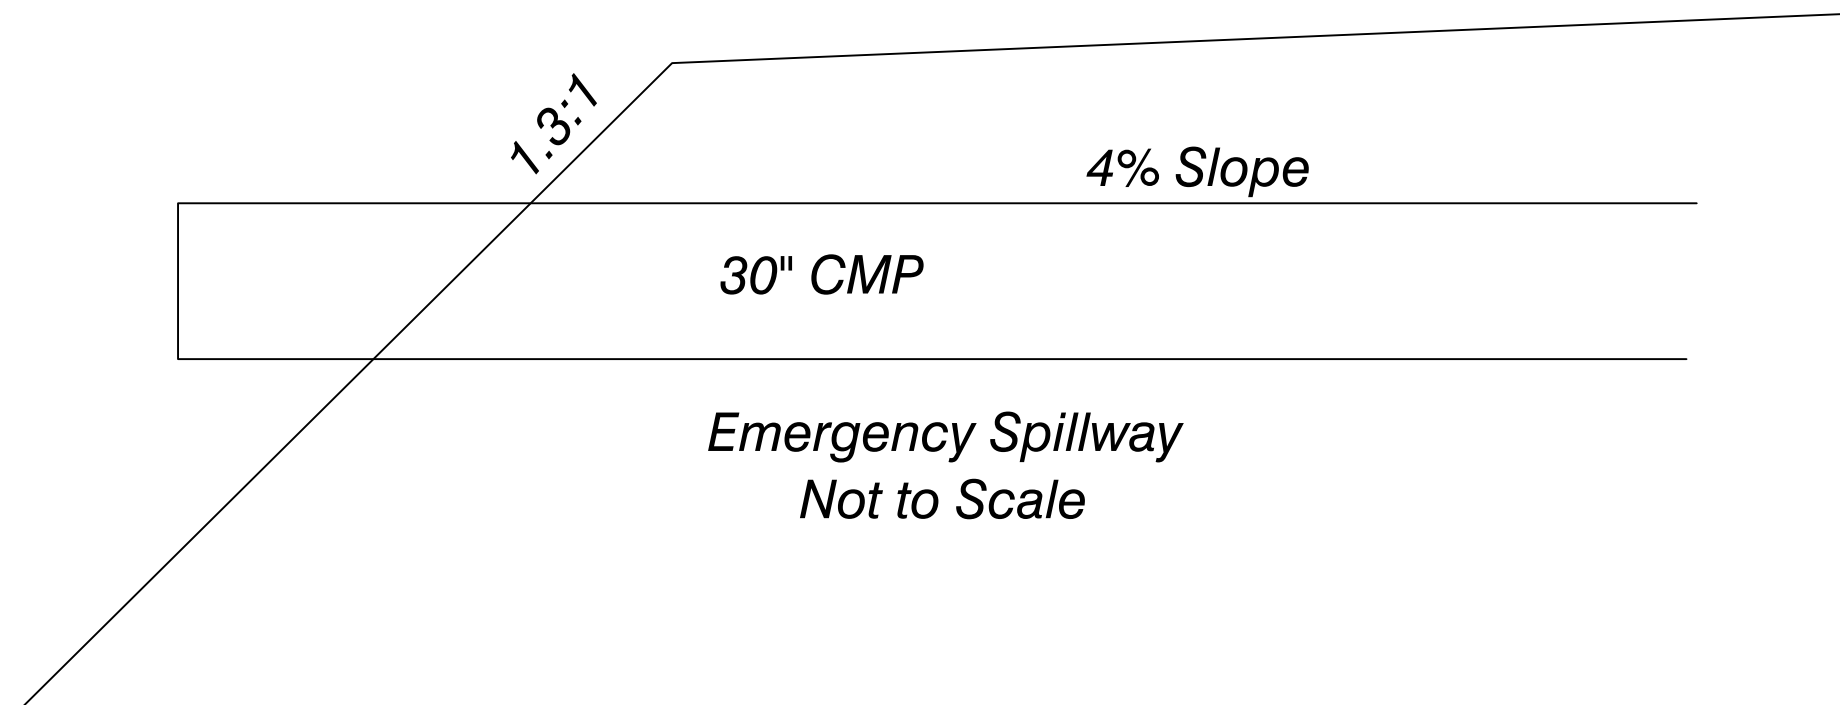

Gossard Pond As-Built



Colowyo Coal Company
5731 State Highway 13
Meeker, Colorado 81641

SCALE: As Shown
DATE: 4/22/98
DRWG. BY: T.E.S. III
APPROVED BY: J.P.G./S.R.H.

DRWG NO.

Figure Exh. 7-14G-2

No.	REVISION	DATE	BY	CHK
1	As-Built	9/21/99	JPG SRH	JPG SRH
TR-138	Removed Primary Spillways, Updated Entire As-Built Format Updated Stage Storage Curves, Revised Drawing Size	4/29/20	Tony	BC
TR-162	Revised Figure Number	2/1/24	Tony	LES