

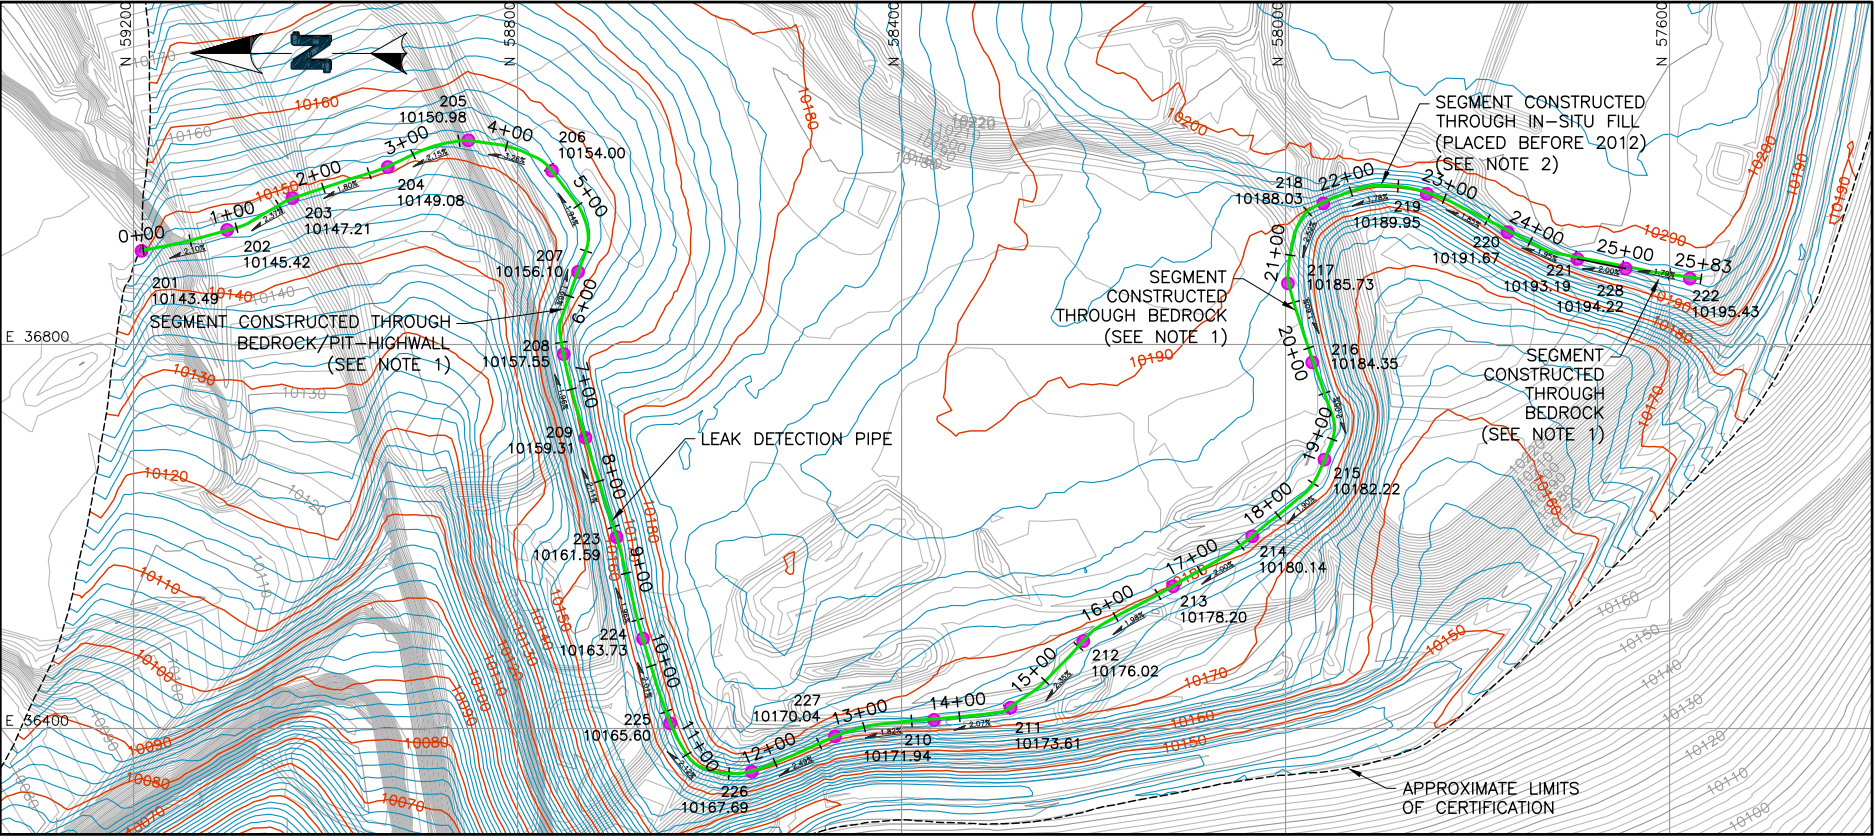


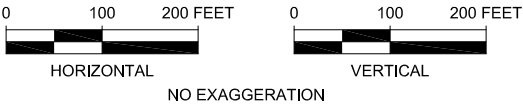



- LEGEND:**
- SEPTEMBER 2021 GROUND CONTOURS
 - STAGE A.2 SUBGRADE AS-BUILT CONTOURS
 - LEAK DETECTION PIPE
 - 202 LEAK DETECTION CERTIFICATION POINT
 - 2.00% SLOPE BETWEEN POINTS

- NOTES:**
1. SEGMENT CONSTRUCTED THROUGH BEDROCK/PIT-HIGHWALL. METHODS NECESSARY FOR FURTHER EXCAVATION, SUCH AS BLASTING, WOULD BE LESS PRECISE AND ULTIMATELY DETRIMENTAL TO THE PROJECT. SETTLEMENT IN THESE AREAS IS UNLIKELY.
 2. SEGMENT CONSTRUCTED THROUGH IN-SITU FILL PLACED BEFORE 2012. SETTLEMENT IN THESE AREAS IS UNLIKELY.
 3. OVERALL SLOPE OF UPPER LEAK DETECTION TRENCH IS 2.06%.

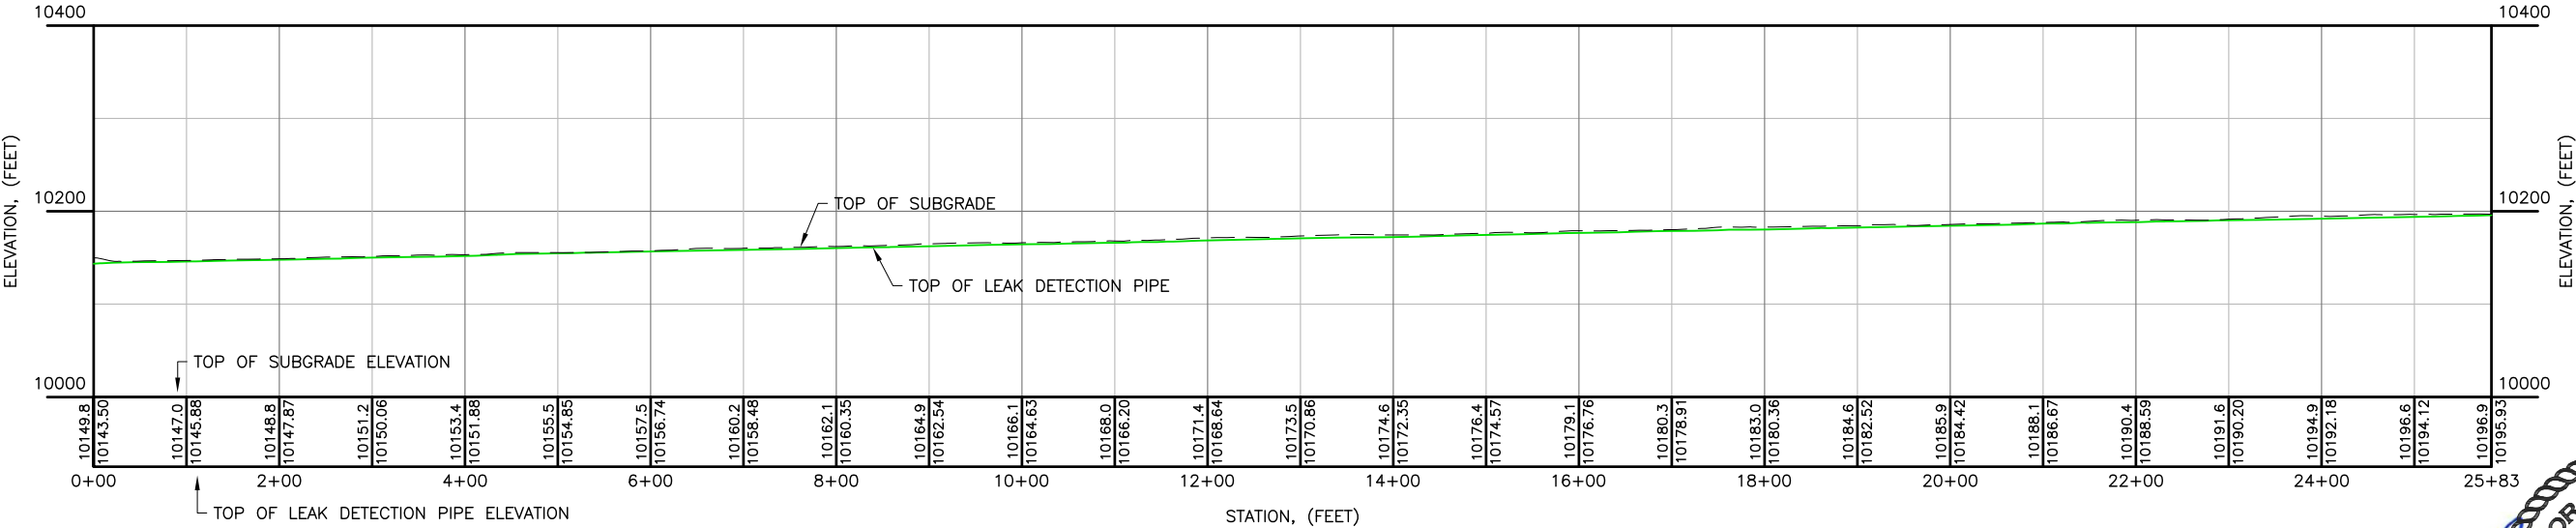

 NewFields		CLIENT CRIPPLE CREEK & VICTOR GOLD MINING COMPANY	
PROJECT		VLF3 PHASE 3 STAGE A.2	
TITLE	LEAK DETECTION TRENCH 2 AS-BUILT PLAN AND PROFILE		FILENAME
			0106.060.064F
			FIGURE NO. REVISION
		6	1

P:\Projects\0106.060 CC&V 2023 Q1 On-Site Support\A-CAD\FIGS\0106.060.064F.dwg-1/22/2024 6:13 PM

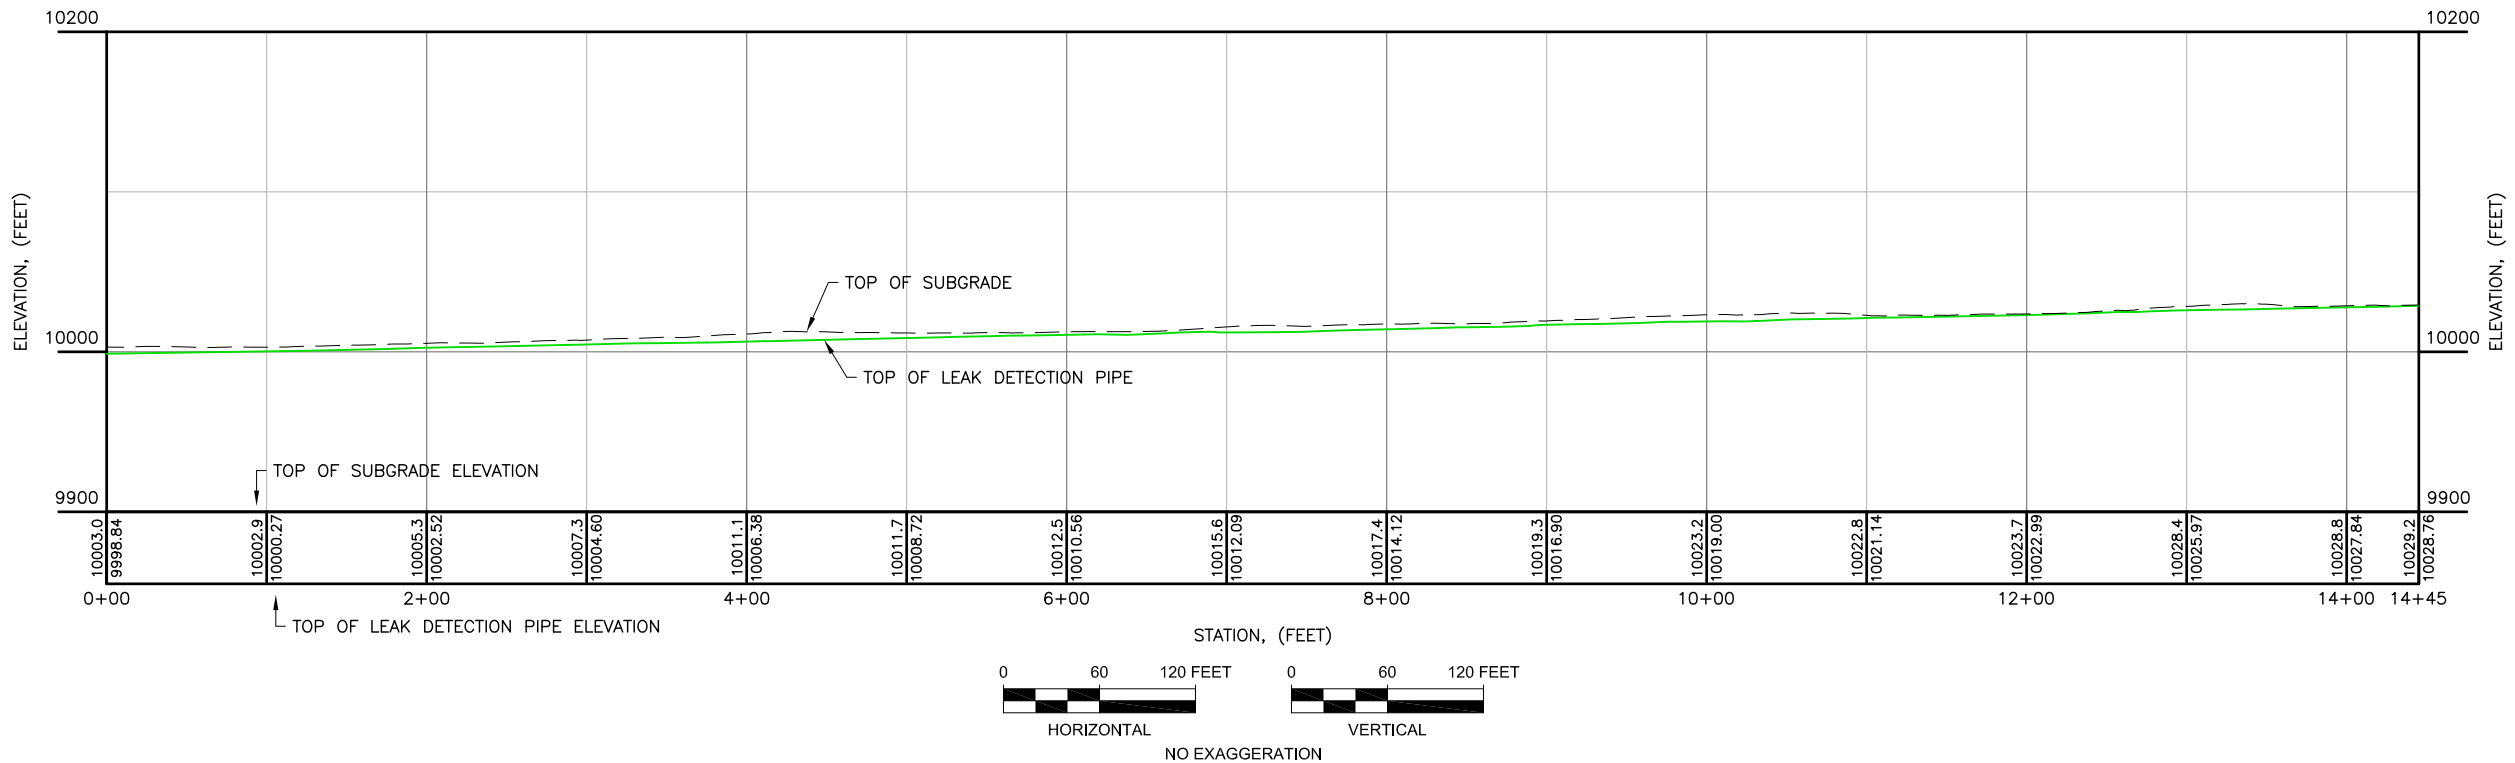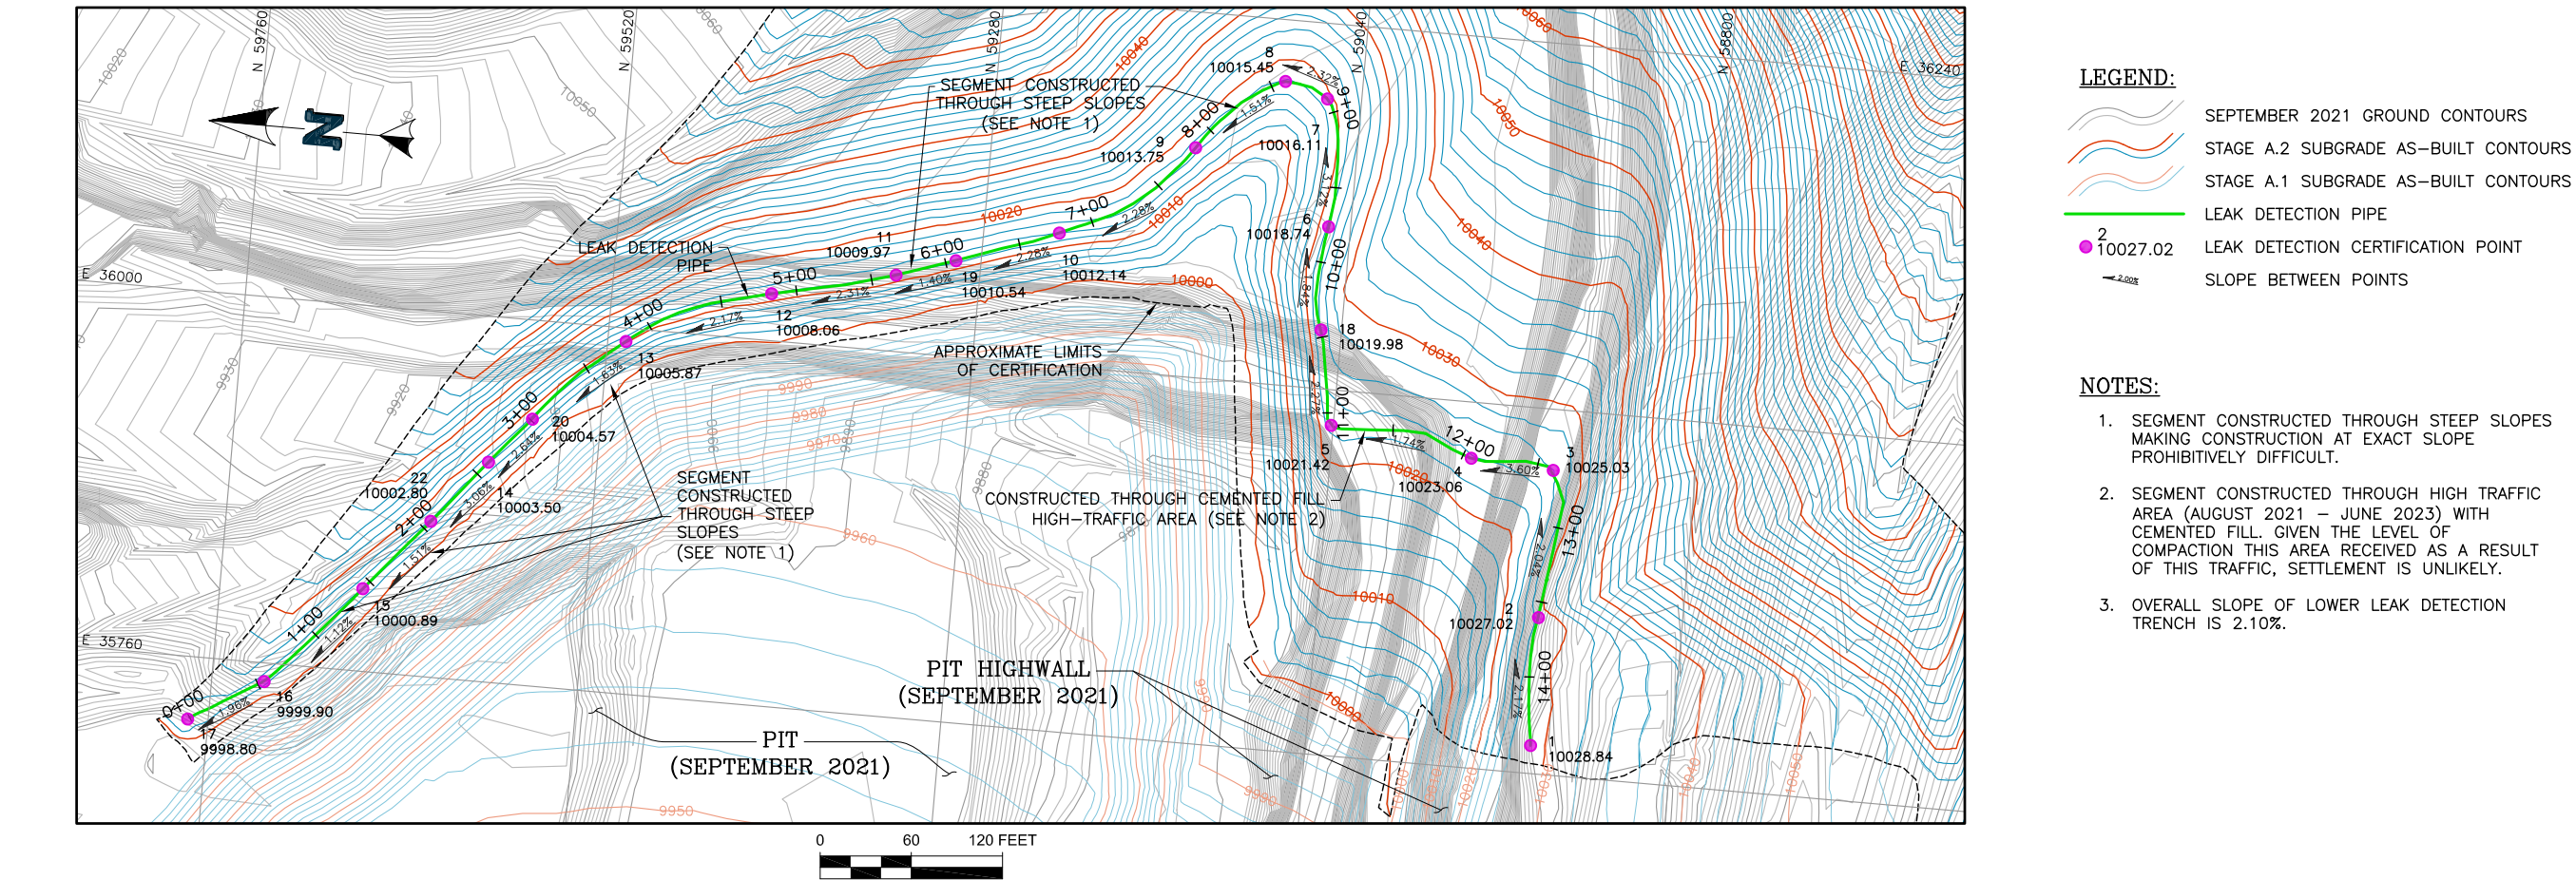

 NewFields		CLIENT CRIPPLE CREEK & VICTOR GOLD MINING COMPANY	
PROJECT		VLF3 PHASE 3 STAGE A.2	
TITLE	LEAK DETECTION TRENCH 1 AS-BUILT PLAN AND PROFILE		FILENAME
			0106.060.064F
			FIGURE NO.
		5	1