



South Cresson Backfill

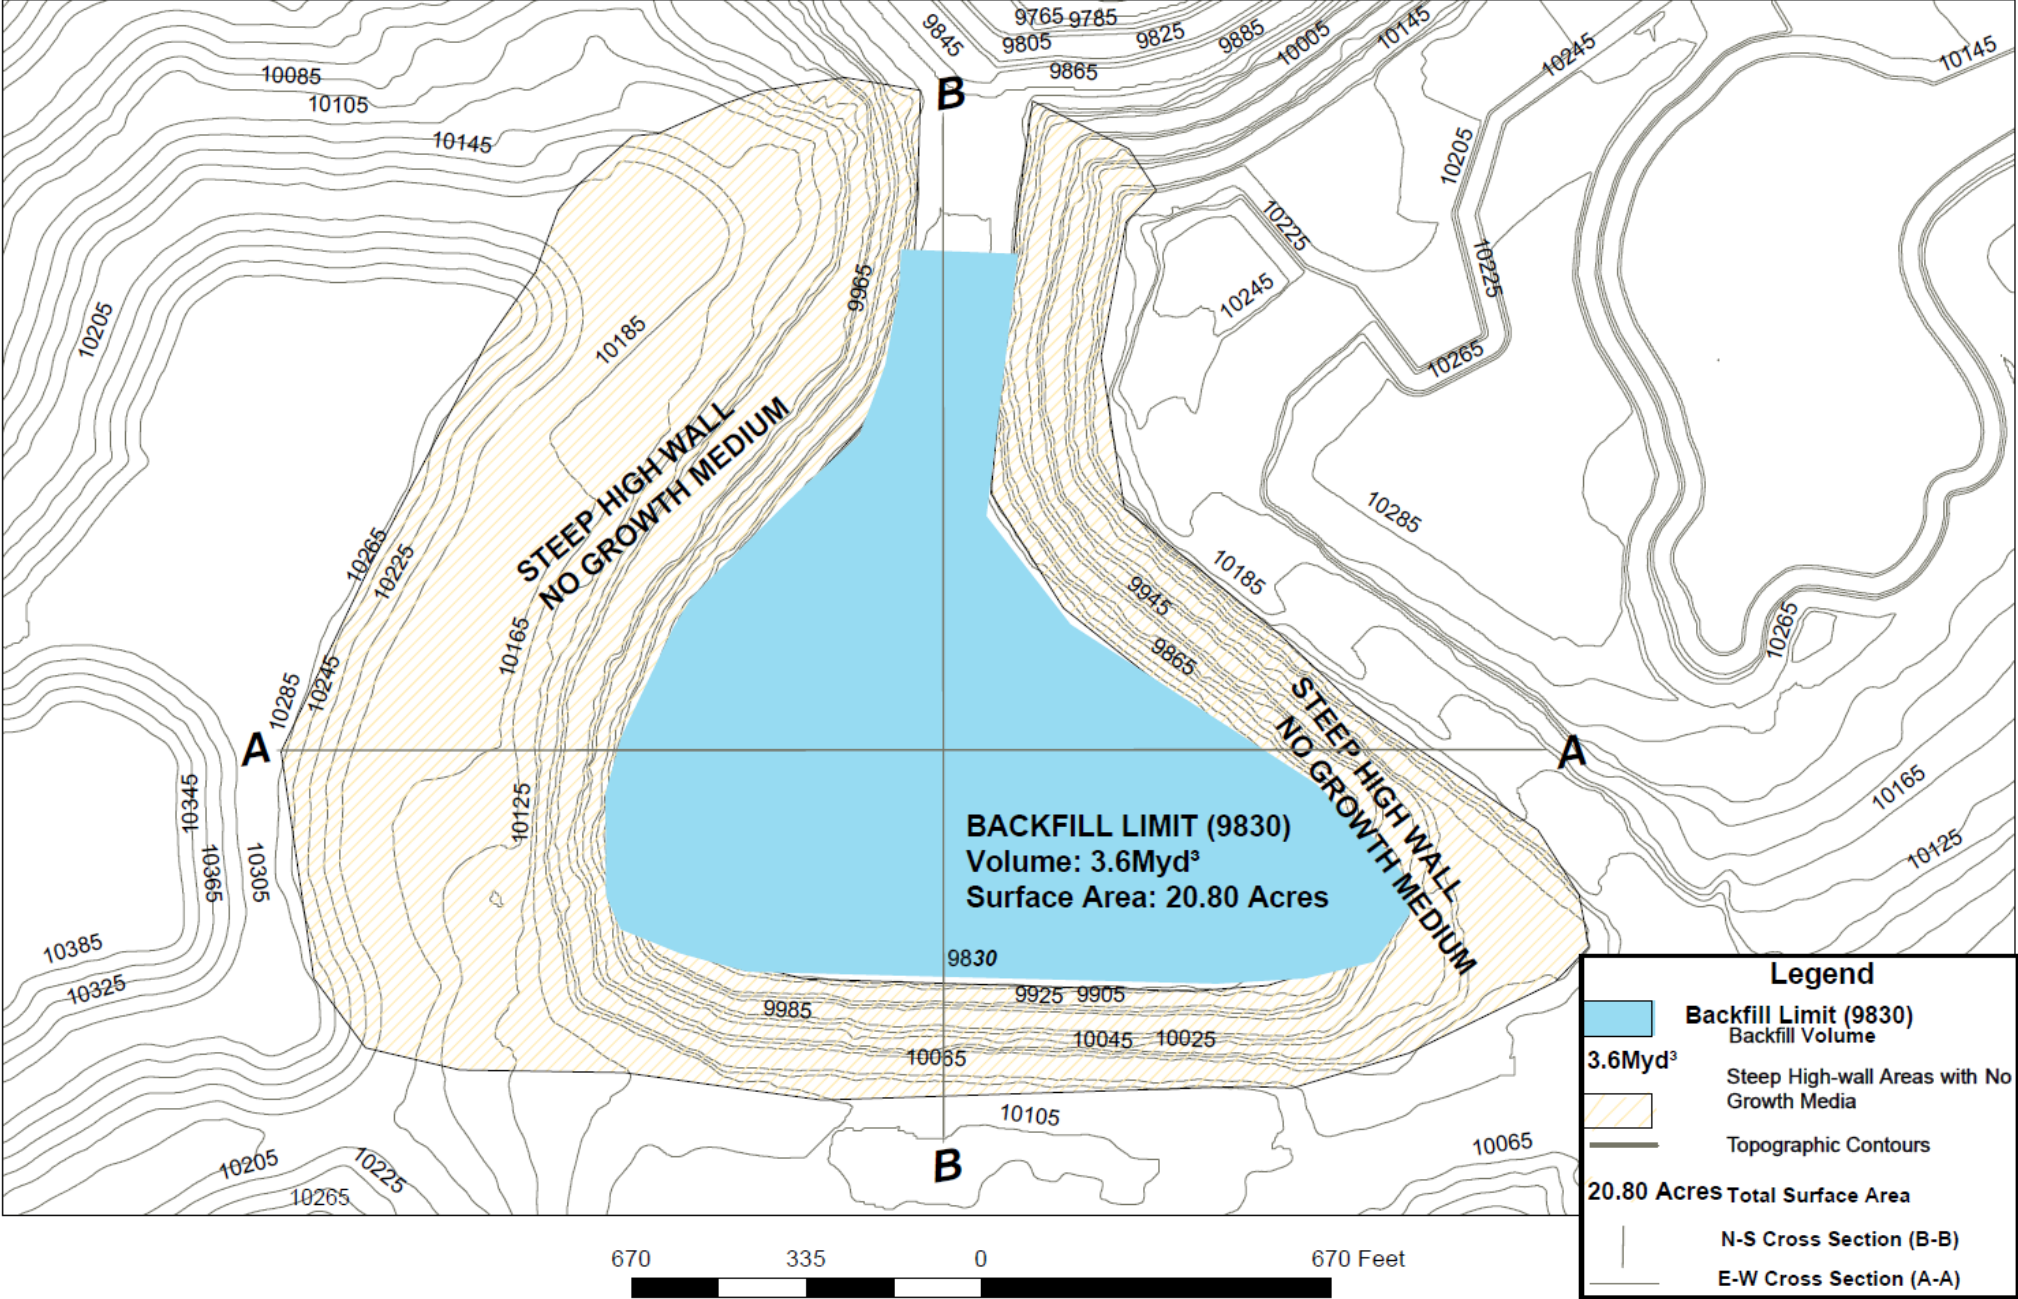


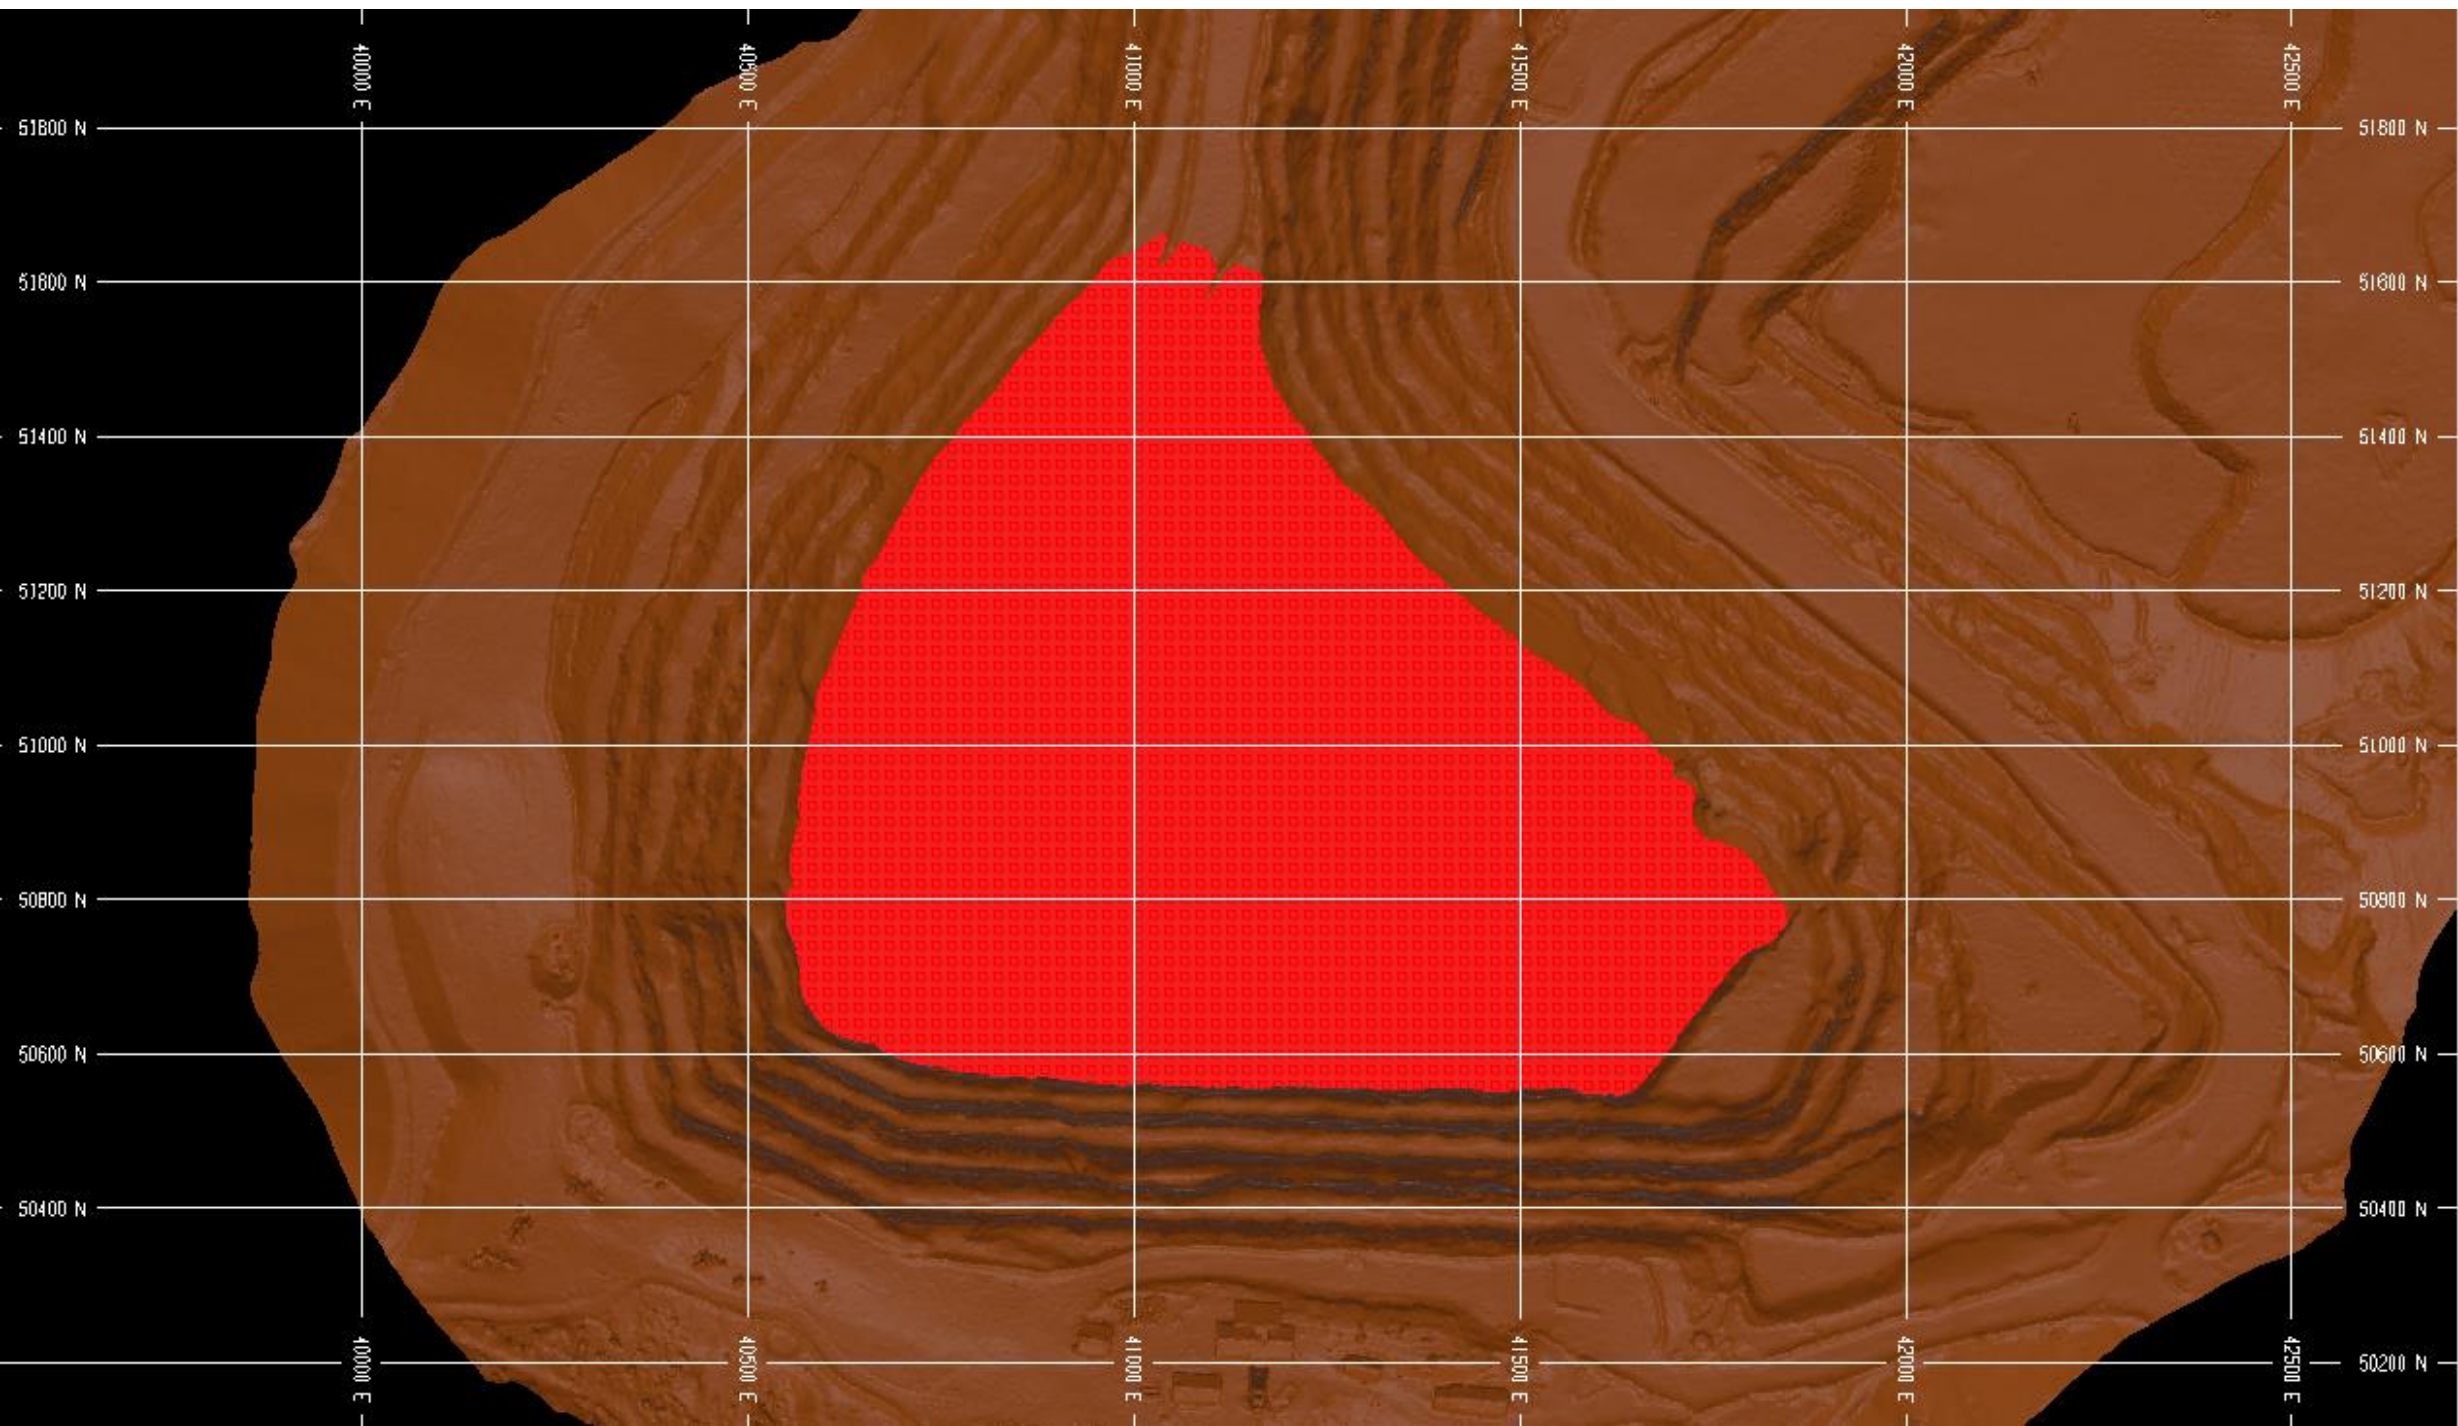

E-W Cross Sectional view of South Cresson Backfill (A-A)

As-built
Topography

Backfill

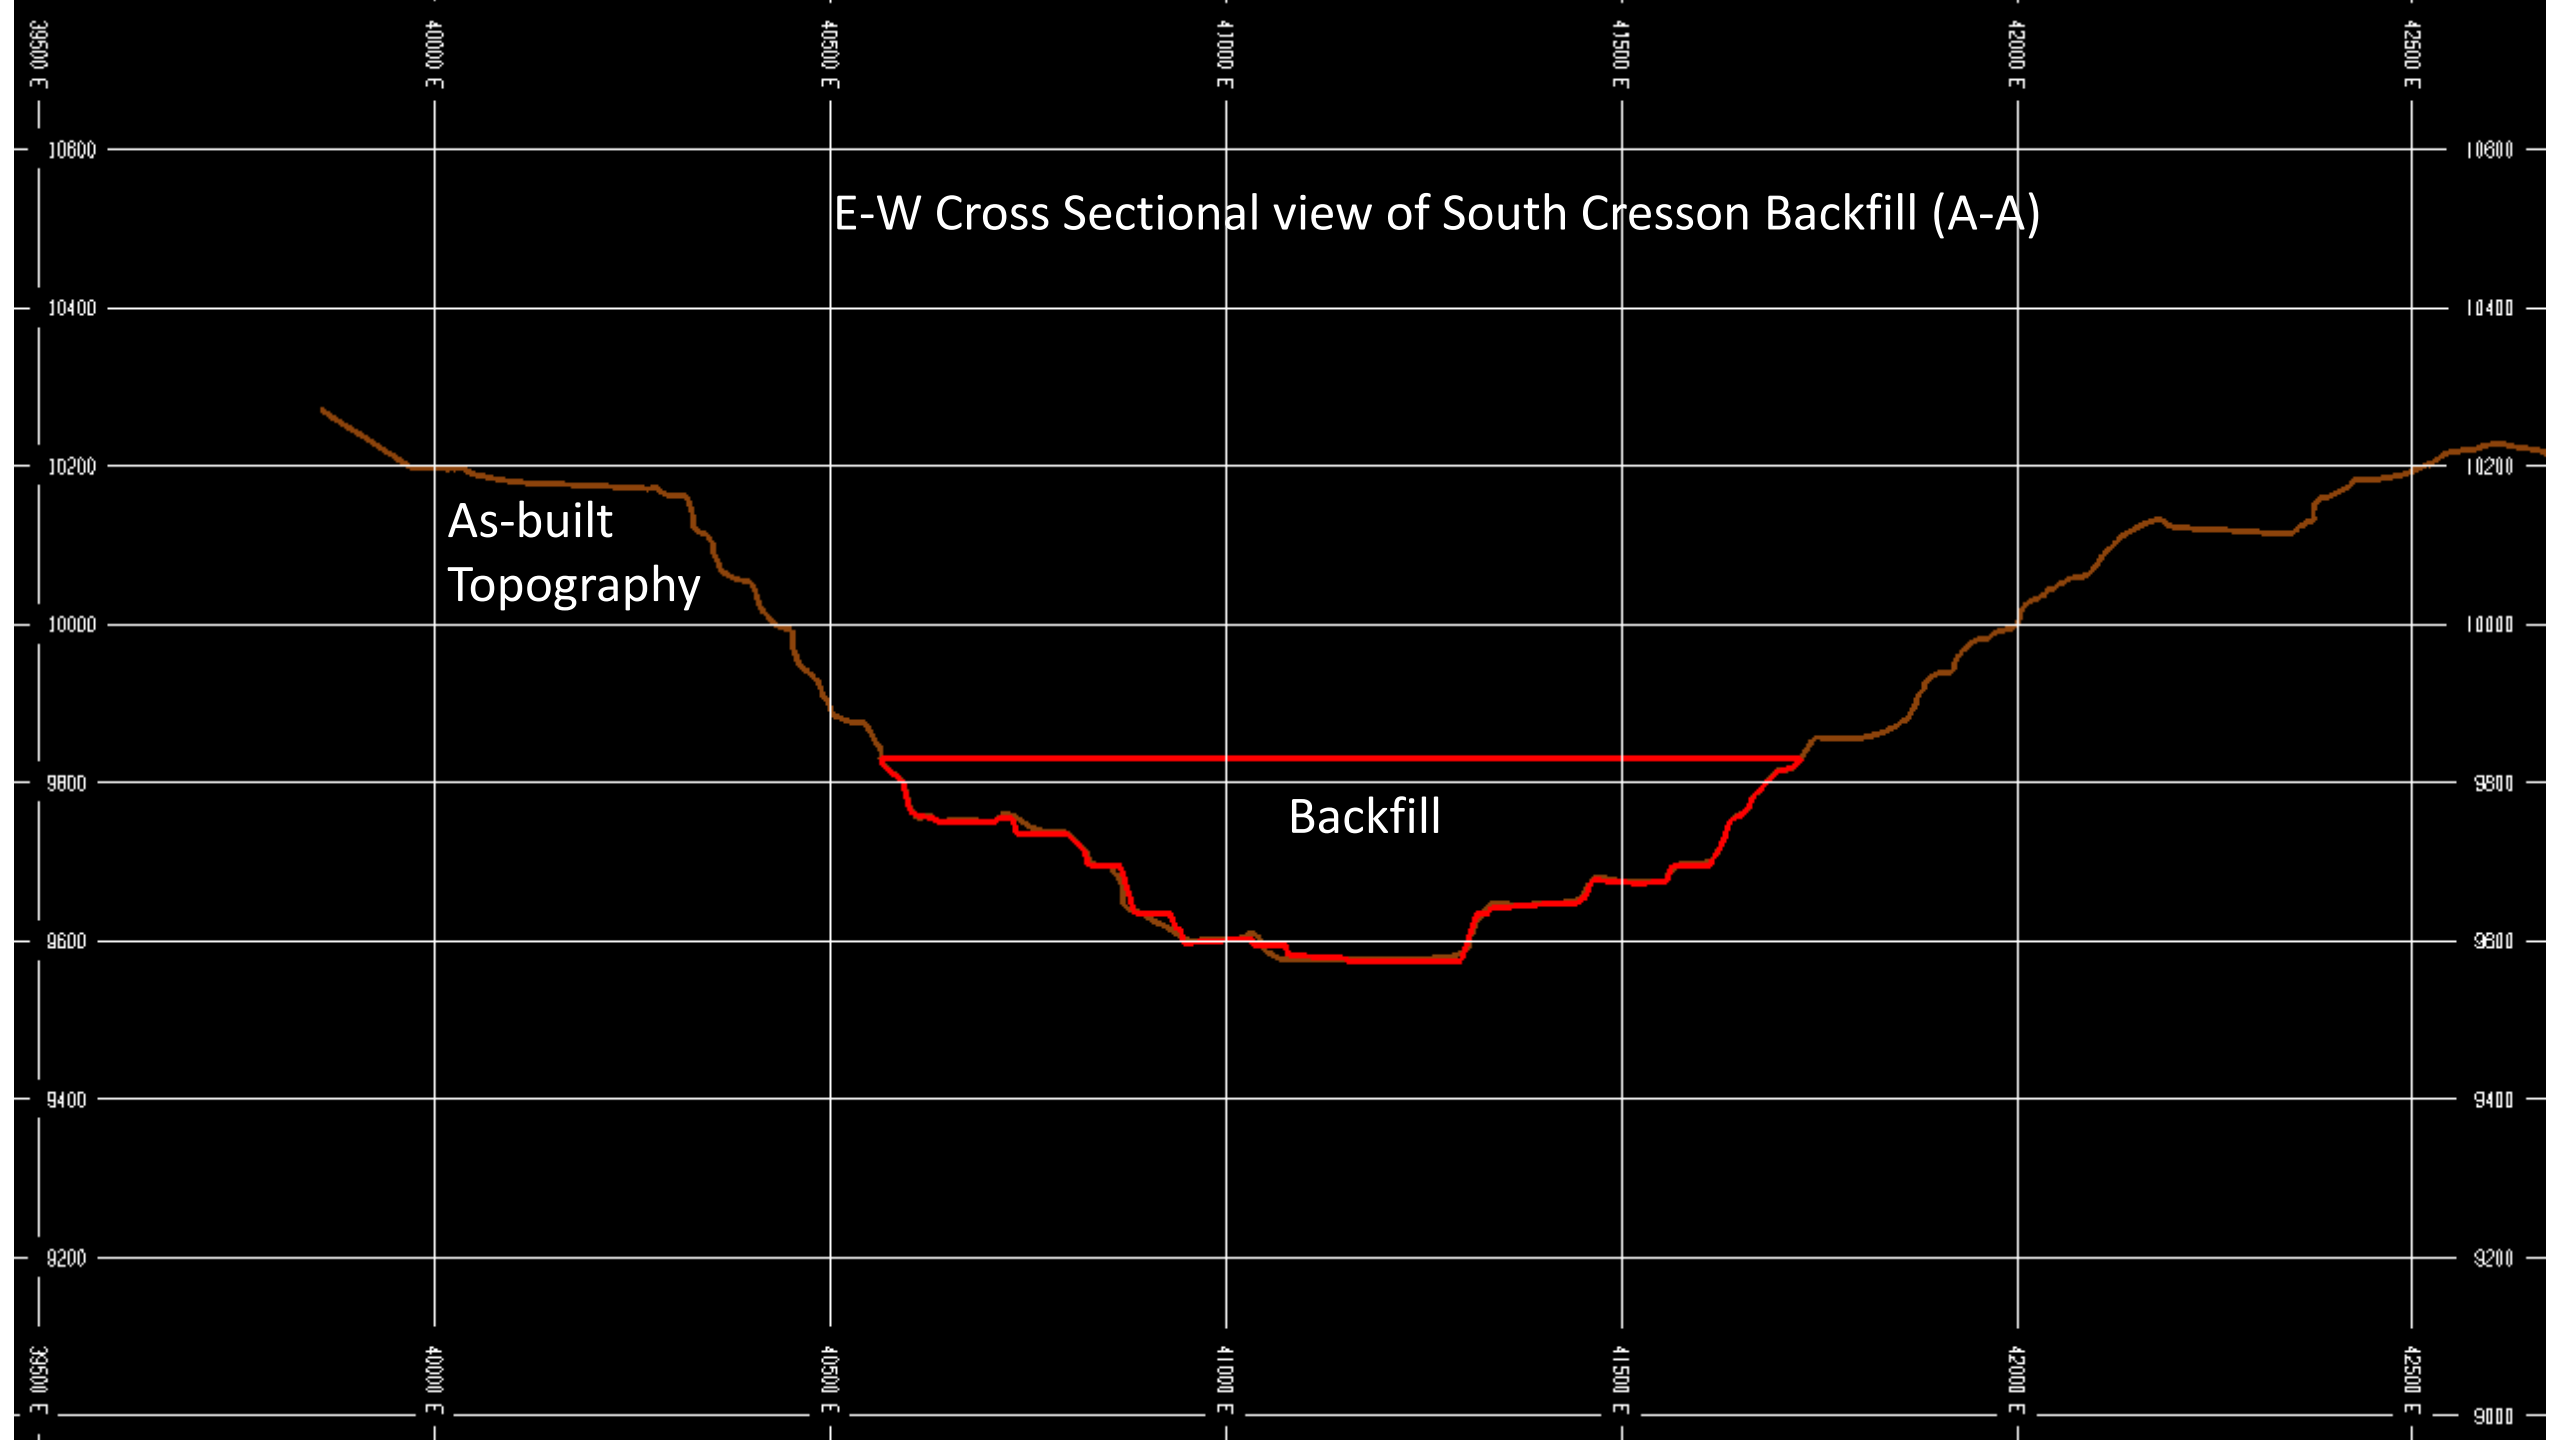

N-S Cross Sectional view of South Cresson Backfill (B-B)

As-built
Topography

Backfill

