


## LEGEND

- | LEGEND   |  |
|--|--|
| PERMIT BOUNDARY                                |  |
| HISTORICAL REVEGETATED AREA                    |  |
| SHRUB CLUMP/Pit ID/Year Constructed<br>SC-D-92 |  |
| 2023 TOPSOIL STRIP                             |  |
| 2023 RETOPSOILED, NOT REVEGETATED              |  |
| 2023 RETOPSOILED AND REVEGETATED AREA          |  |
| 2023 TOPSOIL STRIPPED, RETOPSOILED AND REVEG   |  |
| 2023 TOPSOIL STRIPPED, RETOPSOILED NO REVEG    |  |
| EXISTING TOPSOIL STOCKPILE                     |  |
|  |  |
| 2024 PROPOSED TOPSOIL LAYDOWN                  |  |
| 2024 PROPOSED TOPSOIL STRIP                    |  |
| 2024 PROPOSED TOPSOIL STRIPPING AND LAYDOWN    |  |
| ACCESS CORRIDORS                               |  |
| EXISTING STOCK POND                            |  |
| EXISTING DOZER BASINS                          |  |
| RECONSTRUCTED DRAINAGES                        |  |
| 2023 RECONSTRUCTED DRAINAGES                   |  |
| CONTOUR DITCH                                  |  |

- AS-BUILT HIGHWALL MINING AREA  
PROPOSED TOPSOIL STOCKPILE

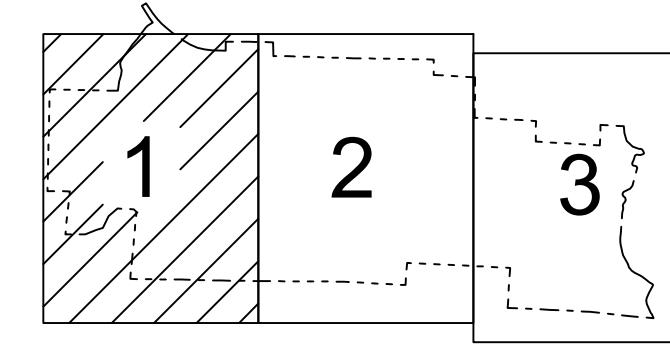

## SHEET LOCATION INDEX

A topographic map section showing contour lines. The vertical axis on the left has a large number '3' and a dashed line. The horizontal axis at the bottom has tick marks and labels: 400, 0, 400, 800. A scale bar above the axis shows four segments, with '0' at the center and '400' at each end. Below the axis, the text 'SCALE: 1 IN = 400 FT' and 'CONTOUR INTERVAL: 10 FEET' is printed.

# TRAPPER MINING INC.

# PERMIT C81-010

## 2023 ANNUAL RECLAMATION

# REPORT MAP