


LEGEND

- PERMIT BOUNDARY
- HISTORICAL REVEGETATED AREA
- SHRUB CLUMP/PIT ID/Year Constructed
- 2023 TOPSOIL STRIP
- 2023 RETOPSOLID, NOT REVEGETATED
- 2023 RETOPSOLID AND REVEGETATED AREA
- 2023 TOPSOIL STRIPPED, RETOPSOLID AND REVEG
- 2023 TOPSOIL STRIPPED, RETOPSOLID NO REVEG
- EXISTING TOPSOIL STOCKPILE
- ASH DUMP STORAGE AREA
- 2024 PROPOSED TOPSOIL LAYDOWN
- 2024 PROPOSED TOPSOIL STRIP
- 2024 PROPOSED TOPSOIL STRIPPING AND LAYDOWN
- ACCESS CORRIDORS
- EXISTING STOCK POND
- EXISTING DOZER BASINS
- RECONSTRUCTED DRAINAGES
- 2023 RECONSTRUCTED DRAINAGES
- CONTOUR DITCH
- APPROVED PHASE III BOND RELEASED BOUNDARY

AS-BUILT HIGHWALL MINING AREA

PROPOSED TOPSOIL STOCKPILE

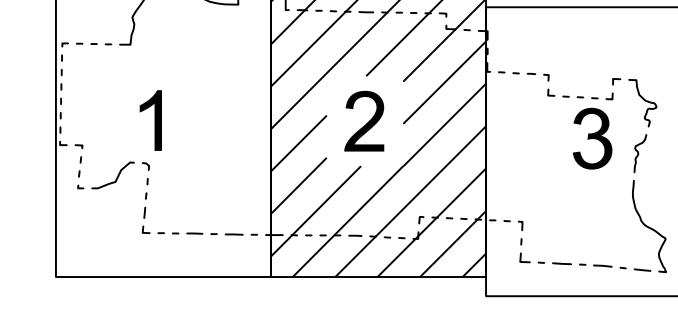

SCALE: 1 IN = 400 FT
CONTOUR INTERVAL: 10 FEET

Topographic Information compiled from aerial photography dated 11/2023
AutoCAD Rev. L: Engineer's Annual Report 2023/MapIndex_Mar_2023.dwg

TRAPPER MINING INC.

CRAIG, CO.

PERMIT C81-010

2023 ANNUAL RECLAMATION
REPORT MAP

Sheet 1 of 3

MAP 1

SHEET 2

