


**COOLEY RESERVOIR AND FULTON WILDLIFE AREA PIT
AMENDMENT NO. 1 - JERONIMUS PROPERTY
M - 1999 - 034, AM-1**

NOTES:
THE BOUNDARY SHOWN HEREON IS APPROXIMATE.

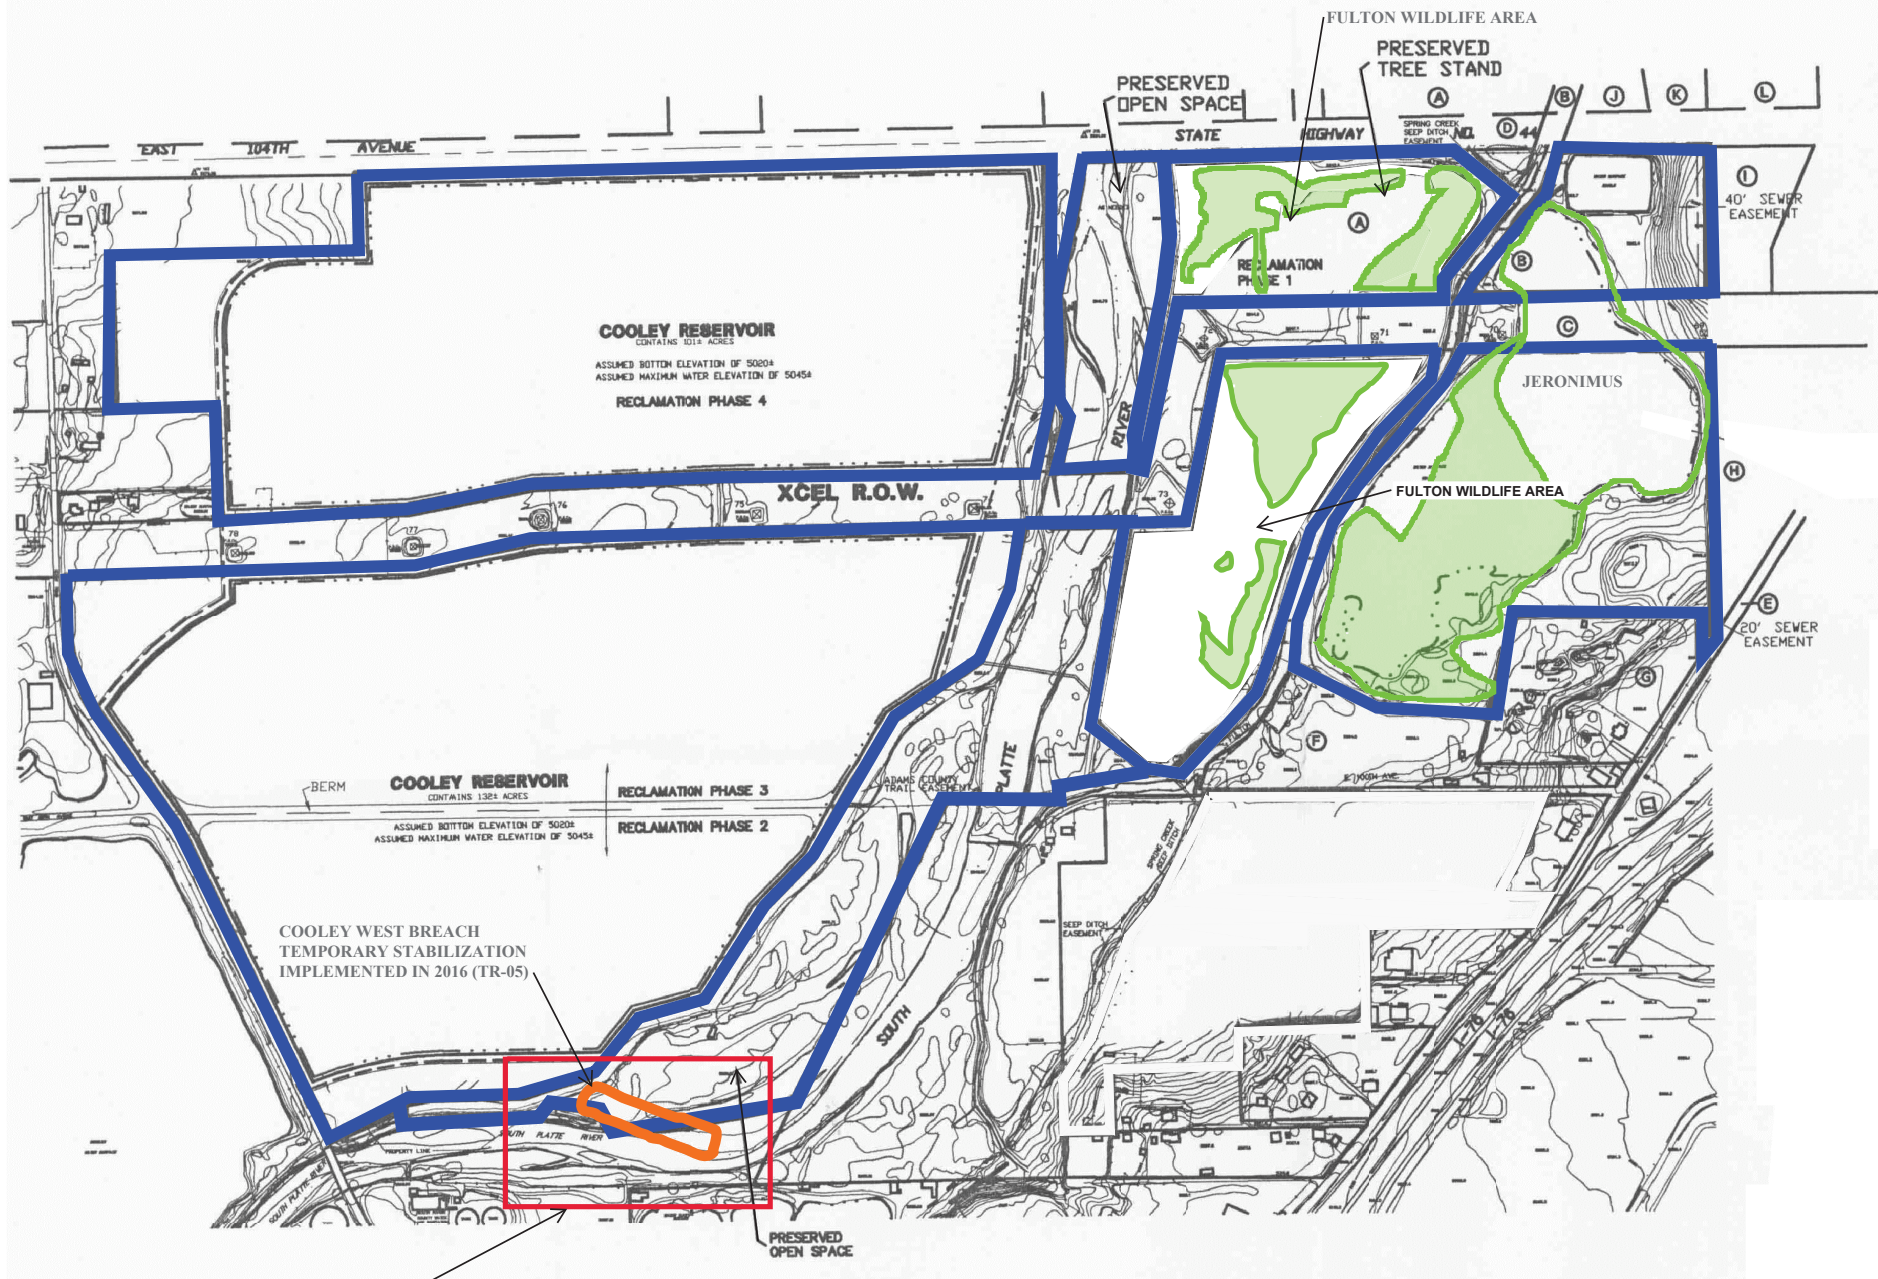


SEE ATTACHED RECORD DRAWING
B-02 FOR MODIFICATIONS
COMPLETED

LEGEND

- DENOTES: UPDATED PERMIT BOUNDARY OF AFFECTED LAND
- DENOTES: APPROX. 2020 WETLAND DELINEATION
- DENOTES: SLURRY WALL
- DENOTES: LIMIT OF EXCAVATION AND PHASES



		MOUNTAIN REGION				
		COOLEY-FULTON EXHIBIT F RECLAMATION PLAN				
Date	Revisions	Scale: 1" = 500'		Job No:		Date: 03/26/2024
		Drawn By:	Design By:	Reviewed By:		Sheet:
		MES	G.A.B	MES		1 of 1
File: M:\MP&G-MOUNTAIN\THONRTON						

