


M1977-484 / Gravel Pit No 7 / Robins Redi Mix, LLC

Red line - 660 Acres Affected Area
Blue line - 17 Acres disturbed Area
Orange line - 2 Acres Reclamation
Yellow line - 450 Feet L Slope Gradient

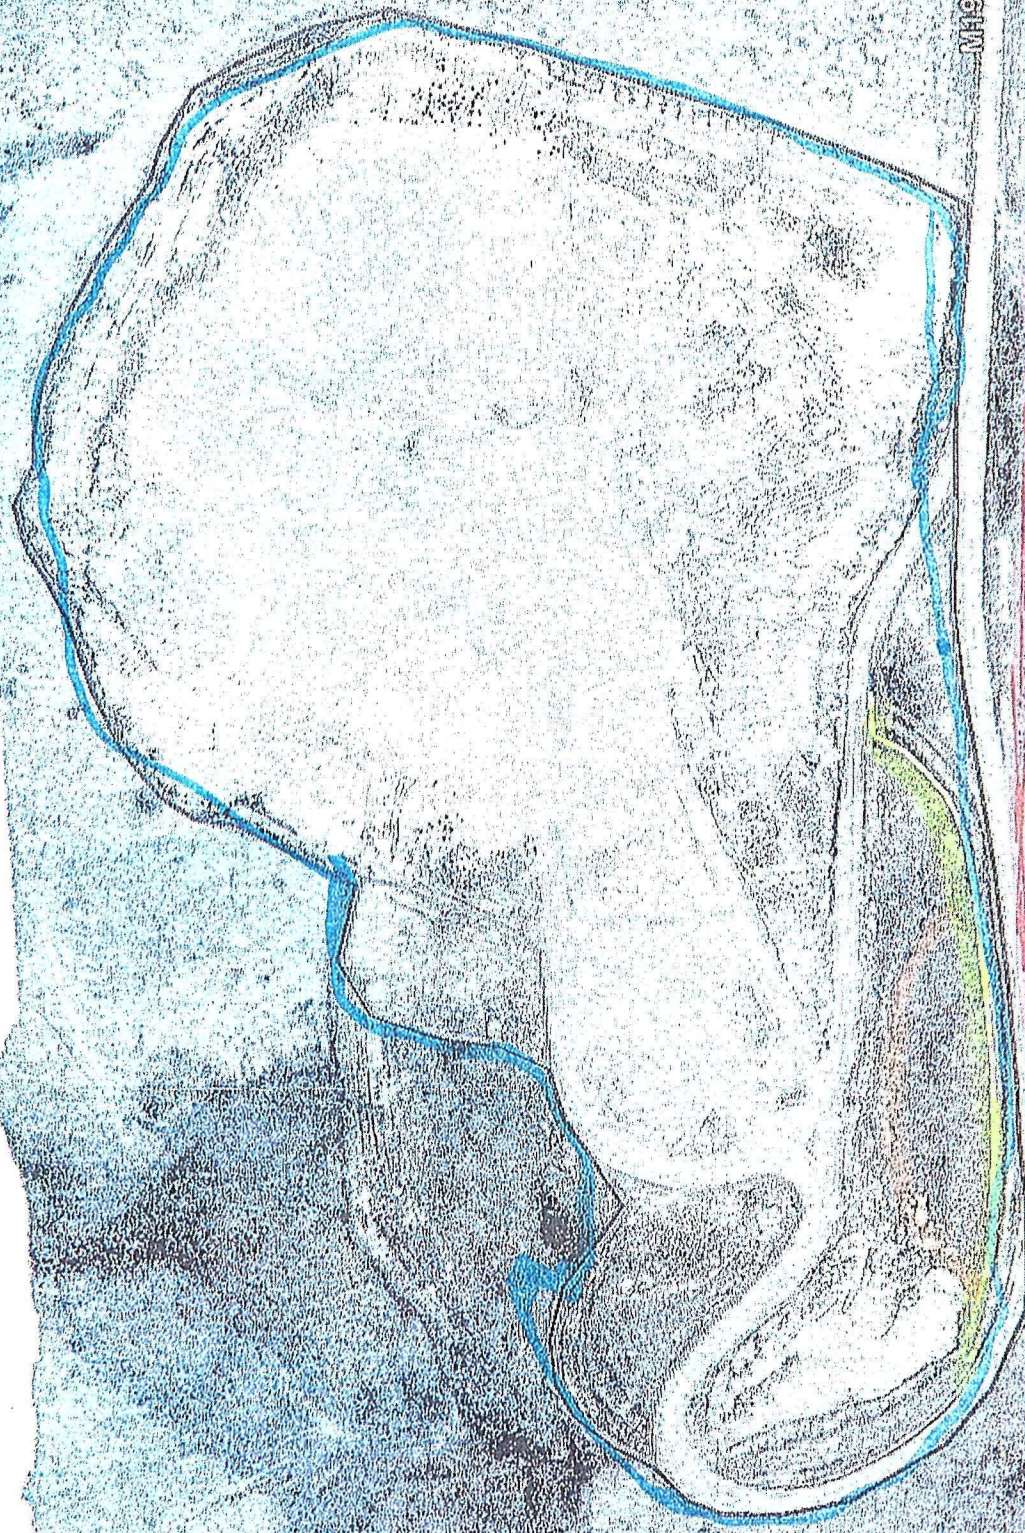

M1977-484

Google earth

© 2015 Google

500 ft

N