

Map showing current conditions on Line Camp.

Red line: current permit boundary (22.6 ac)

Blue dashed hatch: ponds (reclaimed but not released) (10.1 ac)

Green crosshatch: reclaimed and released (0.2 ac)

Green horizontal hatch: reclaimed not released (10.4 ac)

White areas: at final grade but still to have soil replaced and seeded (planned 2025)

Magenta:

Cross-hatch: current processing area. (4.8ac)


Angled hatch: stockpile of finished product and stored soil (partially outside the current boundary)(1.5 ac)

Purple: proposed sequence of mining when expansion is approved, and boundary of expansion area (yellow numbers MXX are annual phases of mining showing sequence). (20.2 ac)

Property Line of Line Camp Parcel



500 feet

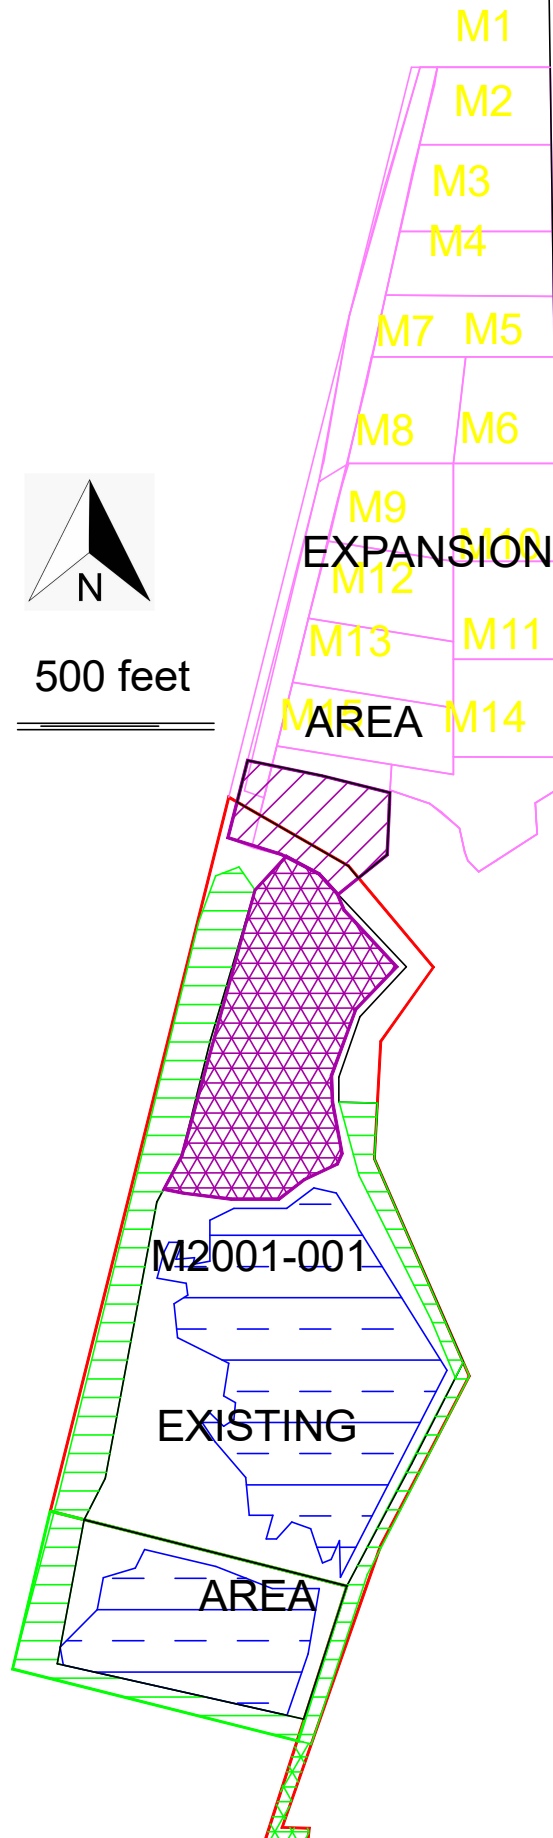

Property Line of Line Camp Parcel

M2001-001
Line Camp Pit
2024 Annual Report
of mining 2023-2024

Drawn by 30 JUL 2024