
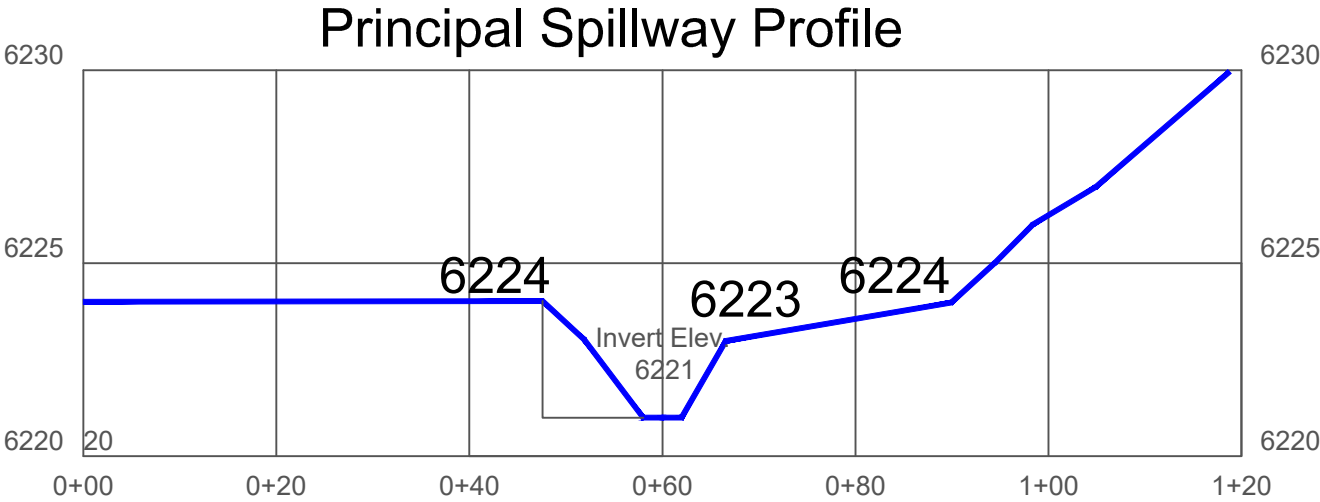
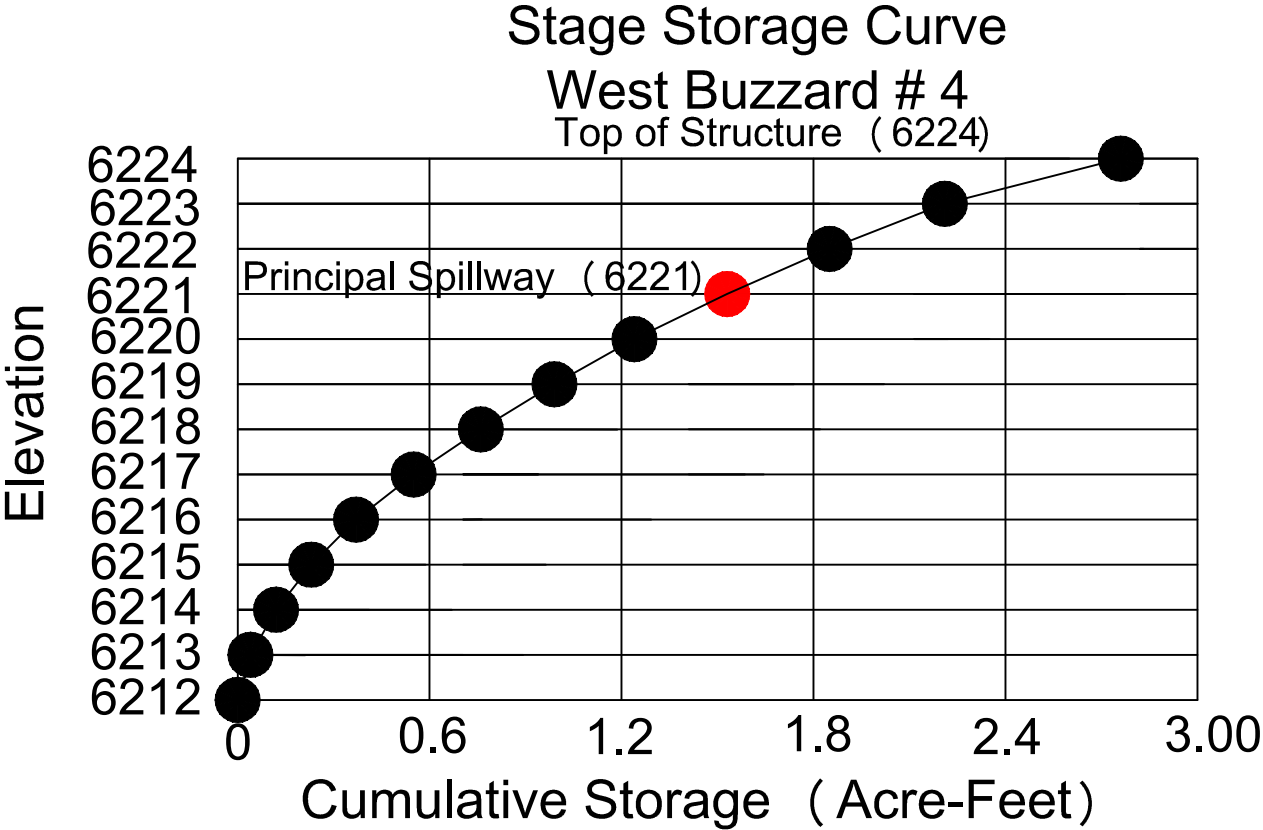


West Buzzard # 4
Impoundment

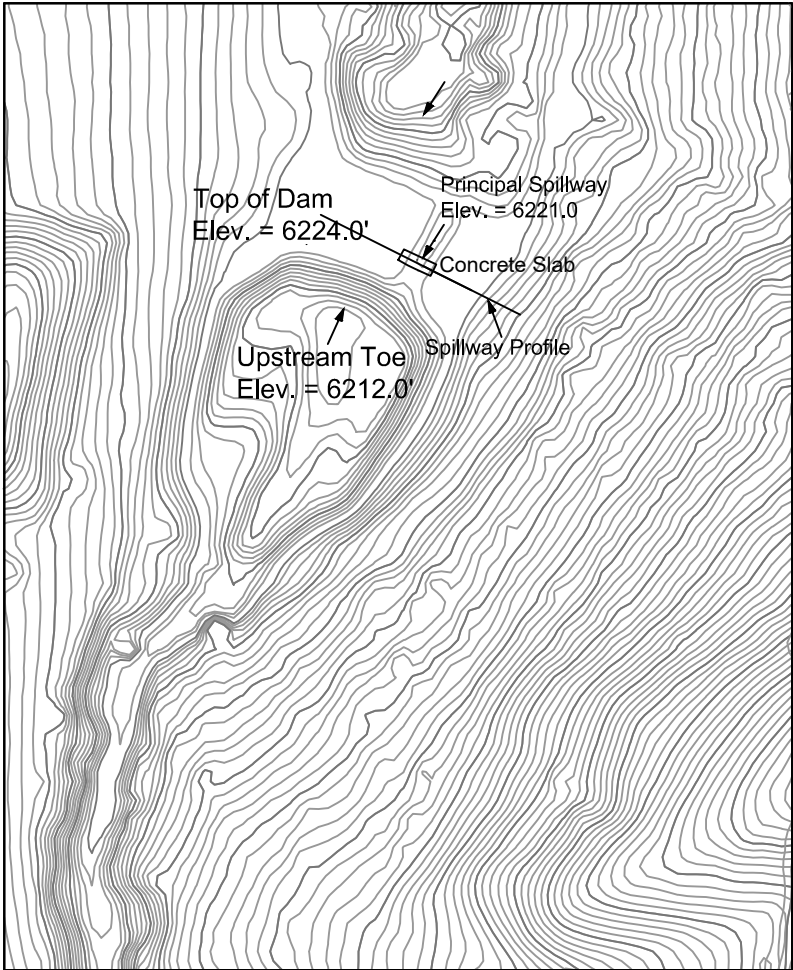


PROFESSIONAL ENGINEER'S CERTIFICATION

I, Tonia Marie Perkins, a registered Professional Engineer in the State of Colorado, certify that this drawing has been reviewed by me and, is true and correct to the best of my knowledge and information.

Tonia Marie Perkins, CO PE No. 43864

Date _____

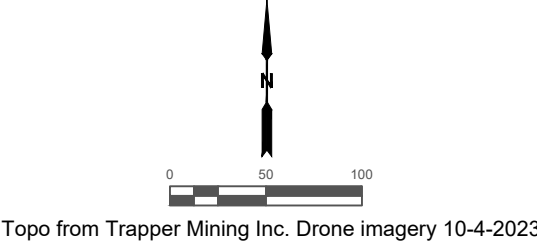

L:Engineer/Ponds/Buzzard Ponds /As-Built Drawings/West Buzzard # 4 As-Built Drawing/West Buzzard # 4 As-Built Drawing.dwg

REVISION	DATE	BY	DESCRIPTION
PR-12	9/30/24	WTC	AS-BUILT

TRAPPER MINING INC.

TRAPPER MINE CRAIG, CO.

West Buzzard # 4
As-Built

SCALE: 1" = 100'

DESIGNED BY: MM

DRAWN BY: WTC

DATE: 5/7/2024