




East Buzzard # 3
Impoundment

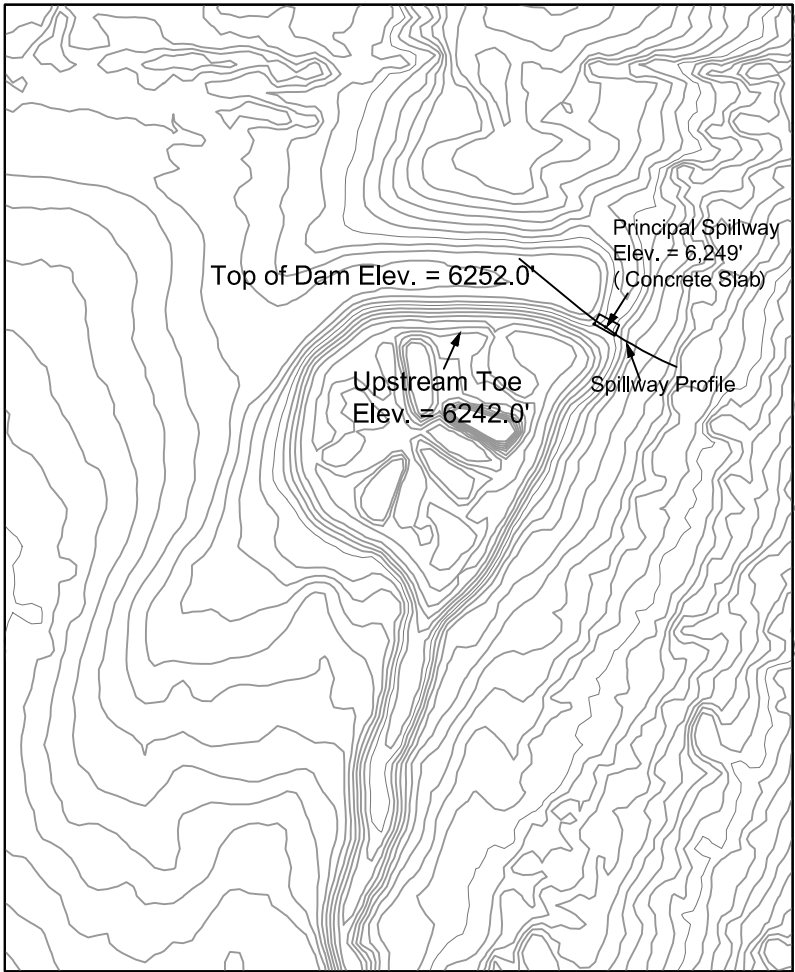

Stage Storage Curve
East Buzzard # 3

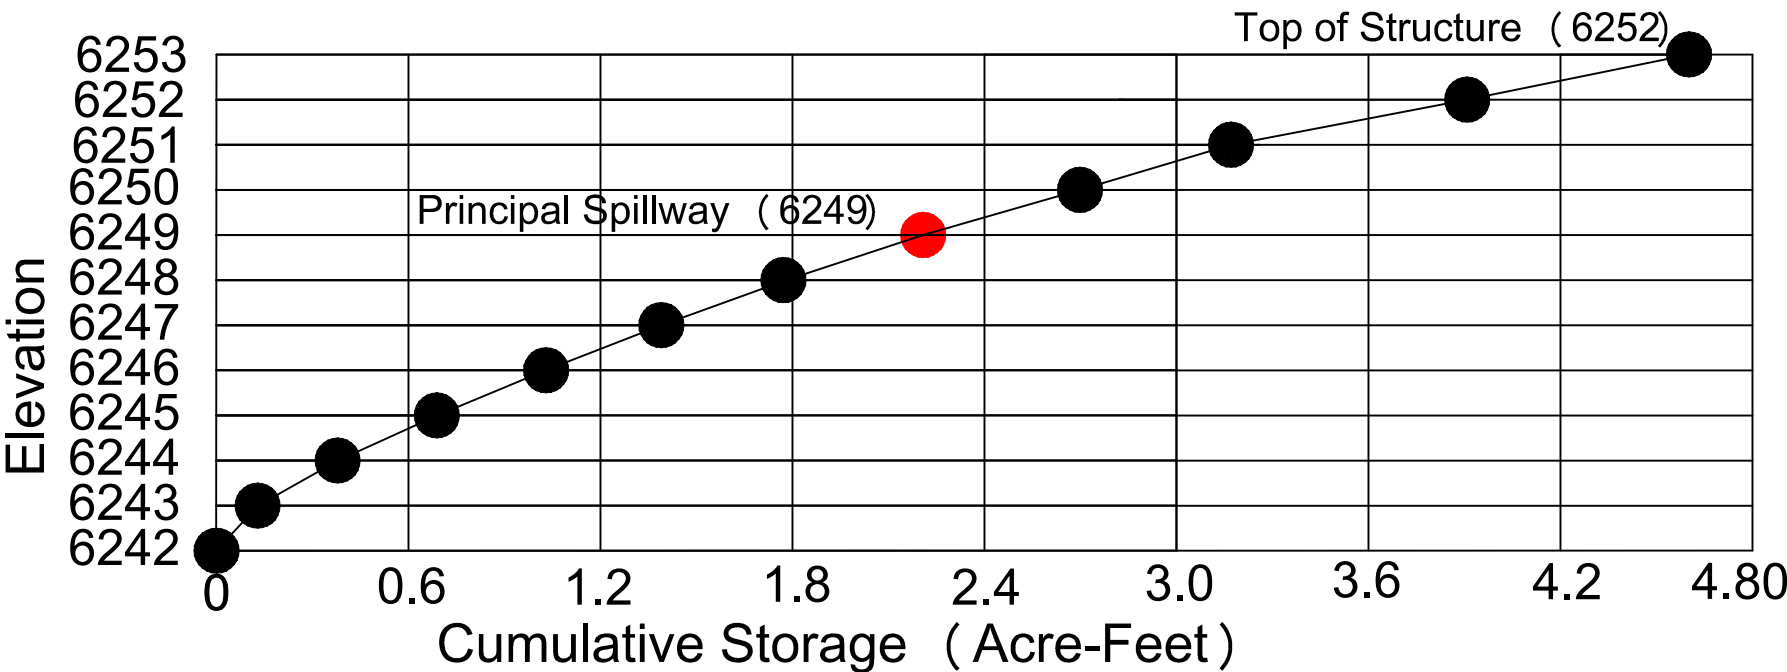

Principal Spillway Profile

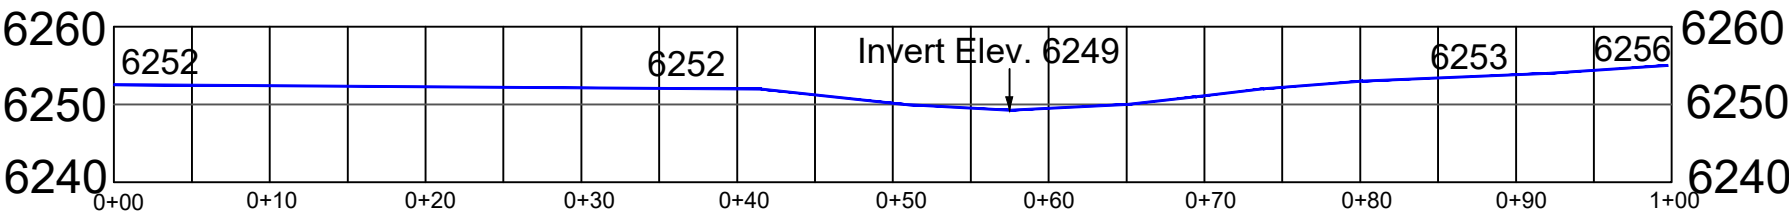


PROFESSIONAL ENGINEER'S CERTIFICATION

I, Tonia Marie Perkins, a registered Professional Engineer in the State of Colorado, certify that this map/drawing has been reviewed by me and, is true and correct to the best of my knowledge and information.

Tonia Marie Perkins, CO PE No. 43864

Date _____

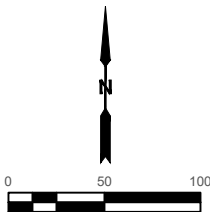

Topo from Trapper Mining Inc. Drone imagery 10-4-2023 and 9-18-2024

L:Engineer/Ponds/Buzzard Ponds/As+Built Drawings/East Buzzard # 3 As-Built Drawing.dwg

REVISION	DATE	BY	DESCRIPTION	TRAPPER MINING INC.		
PR-12	9/30/24	WTC	AS-BUILT	TRAPPER MINE		
				CRAIG, CO.		
				East Buzzard # 3		
				As-Built		
				SCALE: 1" = 100'		
				DESIGNED BY: MM		
				DRAWN BY: WTC		
				DATE: 9/30/2024		