

STATE OF
COLORADO

Lennberg - DNR, Patrick <patrick.lennberg@state.co.us>

Complaint Recieved, CT-3, NCCI Pit #1, M2001-107

JC York <jcyork@j-tconsulting.com>

Thu, Jan 9, 2025 at 12:37 PM

To: "Lennberg - DNR, Patrick" <patrick.lennberg@state.co.us>, Chris Zadel <chrisz@nconconstructors.com>

Patrick –

Attached are the as-built drawings for the drain there are two files (one for each plan and profile sheet). Just wanted to send over so DRMS has them to show the drain construction was completed.

Regards,

J.C.

J.C. York, P.E.

J&T Consulting, Inc.

305 Denver Avenue, Suite D

Fort Lupton, CO 80621

Office: (303) 857-6222

Mobile: (970) 222-9530

From: Lennberg - DNR, Patrick <patrick.lennberg@state.co.us>**Sent:** Friday, December 20, 2024 6:10 AM**To:** Chris Zadel <chrisz@nconconstructors.com>**Cc:** JC York <jcyork@j-tconsulting.com>

[Quoted text hidden]

[Quoted text hidden]




2 attachments**JT-NCC Drain Layout AB 1-P&P 1.8.25.pdf**

204K



JT-NCC Drain Layout AB 2-P&P 1.8.25.pdf


140K

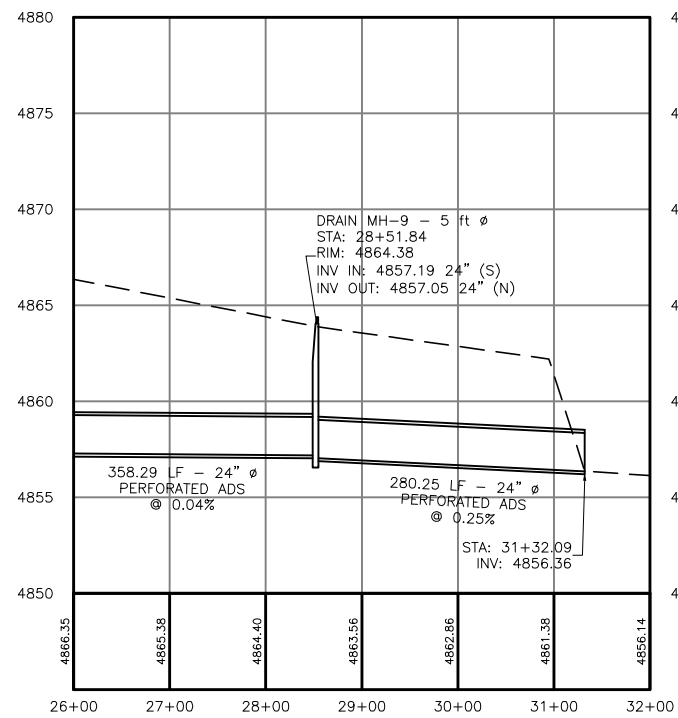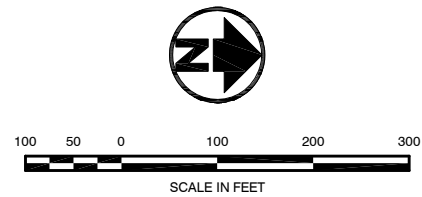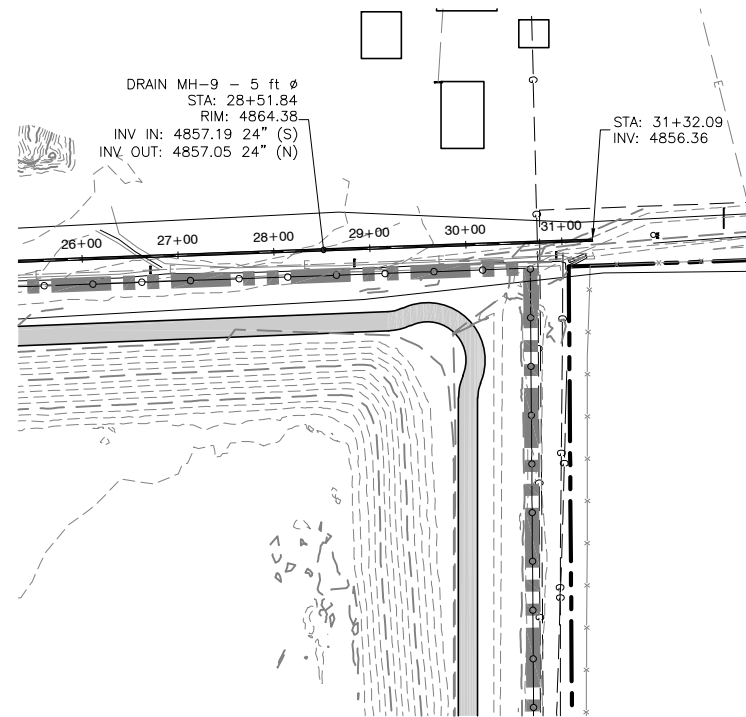

LEGEND:

	PROPERTY LINE
	UNITED ELECTRIC
	EXISTING GAS
	EXISTING FENCE
	EXISTING IRRIGATION PIPE
	EXISTING CONTOURS
	PROPOSED GRAVEL ACCESS ROAD
	PROPOSED FENCE
	PROPOSED GROUNDWATER DRAIN

No	Date	By	Chk	Description
1	06.21.2024	TWT	JCY	Move_MH-5
2	1.8.25	TPY	JCY	LAS-CONSTRUCTED

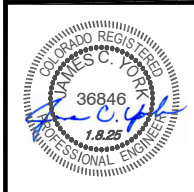

Job #	07121
Date	3.27.24
Drawn By	TWT
Designed By	TWT
Checked By	JCY
File	JT-NCC Drain Layout AB
Scale	1" = 100'h / 5'v

Sheet: **2** Of: **2**

J&T Consulting, Inc.

305 Denver Avenue - Suite D
Fort Lupton, CO 80621
Ph: 303-857-6222 Fax: 303-857-6224
www.j-tconsulting.com

Groundwater Drain

Plan & Profile
Sta 26+00 to 31+32

**Northern Colorado
Constructors, Inc.**

NCC Pit #1