




West Buzzard # 3
Impoundment

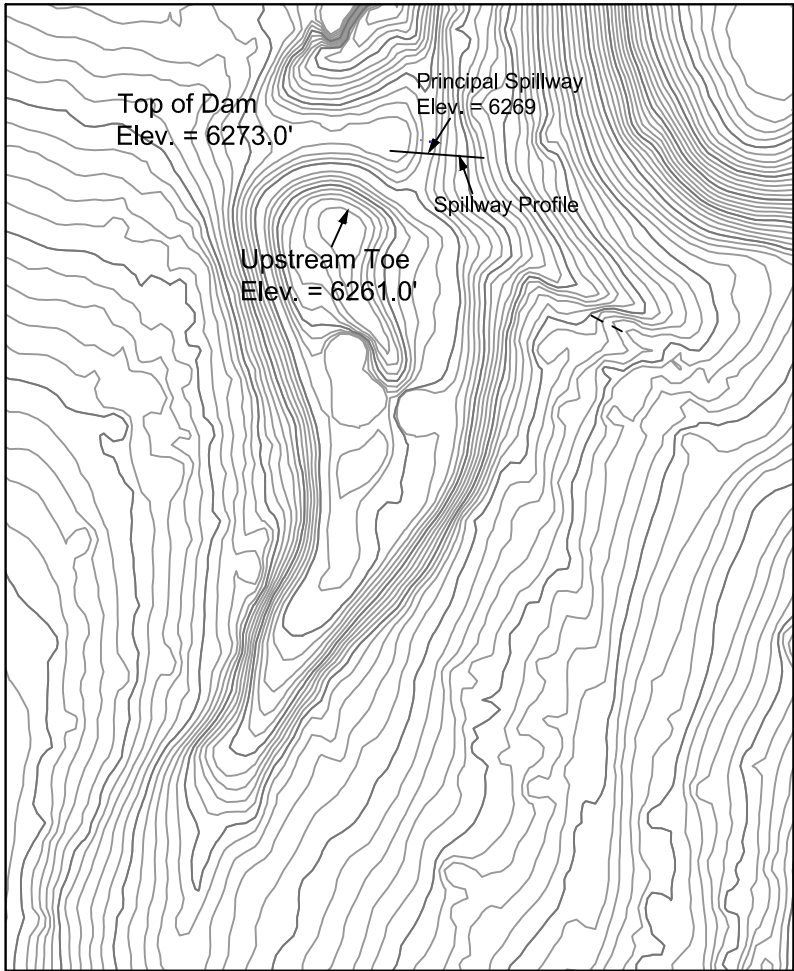

Stage Storage Curve
West Buzzard # 3

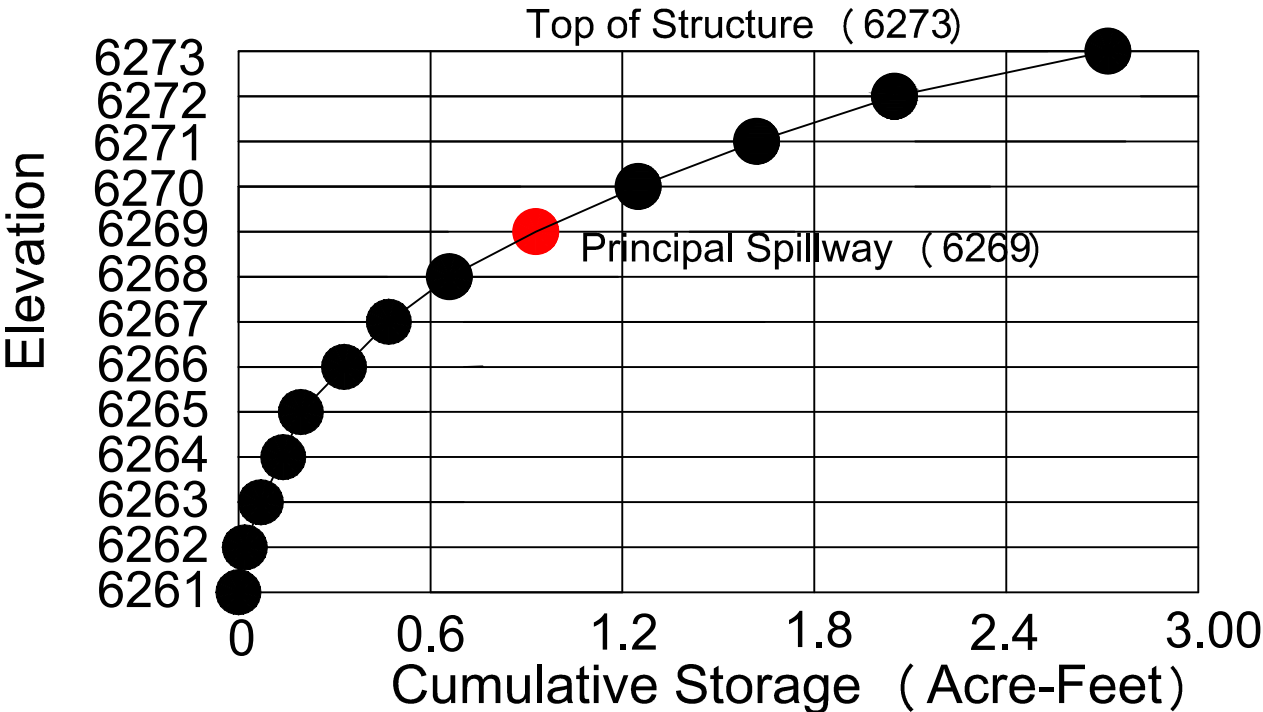

Principal Spillway Profile

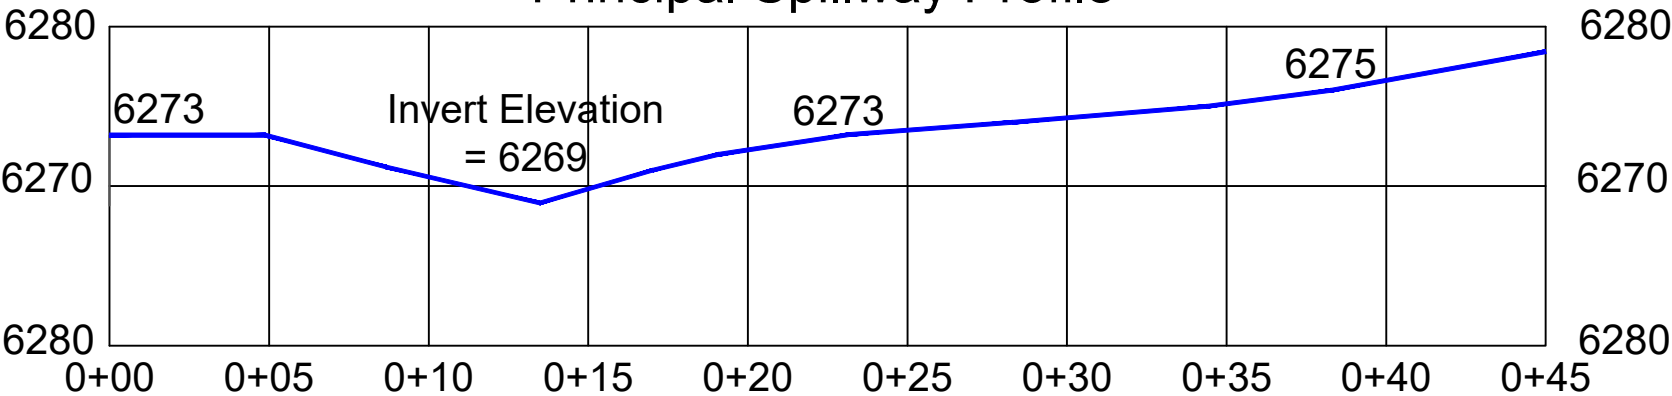


PROFESSIONAL ENGINEER'S CERTIFICATION

I, Tonia Marie Perkins, a registered Professional Engineer in the State of Colorado, certify that this drawing has been reviewed by me and, is true and correct to the best of my knowledge and information.

Tonia Marie Perkins, CO PE No. 43864

Date _____

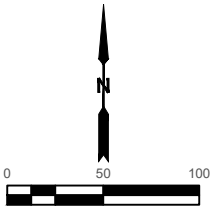

Topo from Trapper Mining Inc. Drone imagery 10-4-2023

REVISION	DATE	BY	DESCRIPTION
PR-12	9/30/24	WTC	AS-BUILT

TRAPPER MINING INC.

TRAPPER MINE

CRAIG, CO.

West Buzzard # 3
As-Built

SCALE: 1" = 100'
DESIGNED BY: MM
DRAWN BY: WTC
DATE: 9/30/2024

