
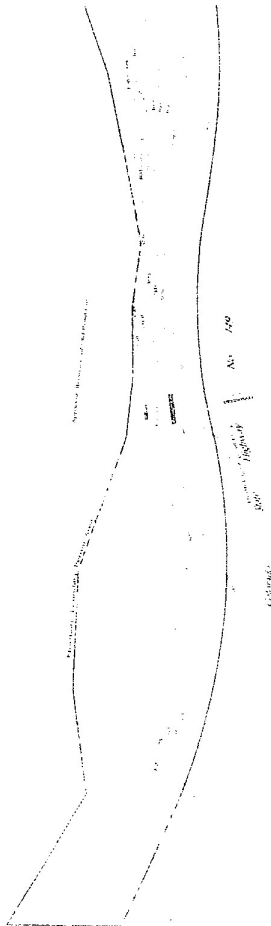
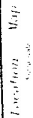


**WILLOW CREEK RESTORATION PHASE 2
BORROW AREA AS-BUILT SURVEY**

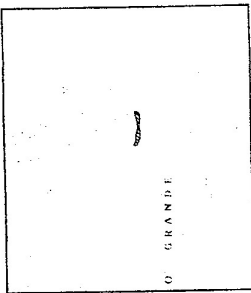

TECHNIQUE

Major Professor David C. Long, University of Tennessee, Knoxville, Tennessee, was the major professor of the author. The author is currently a graduate research assistant at the University of Tennessee, Knoxville, Tennessee.

Editorial assistance was provided by William H. Bland, Jr., Editor, *Journal of Management Education*.

© 1995 by Sage Publications, Inc.

SURVIVORS' NOTES

