
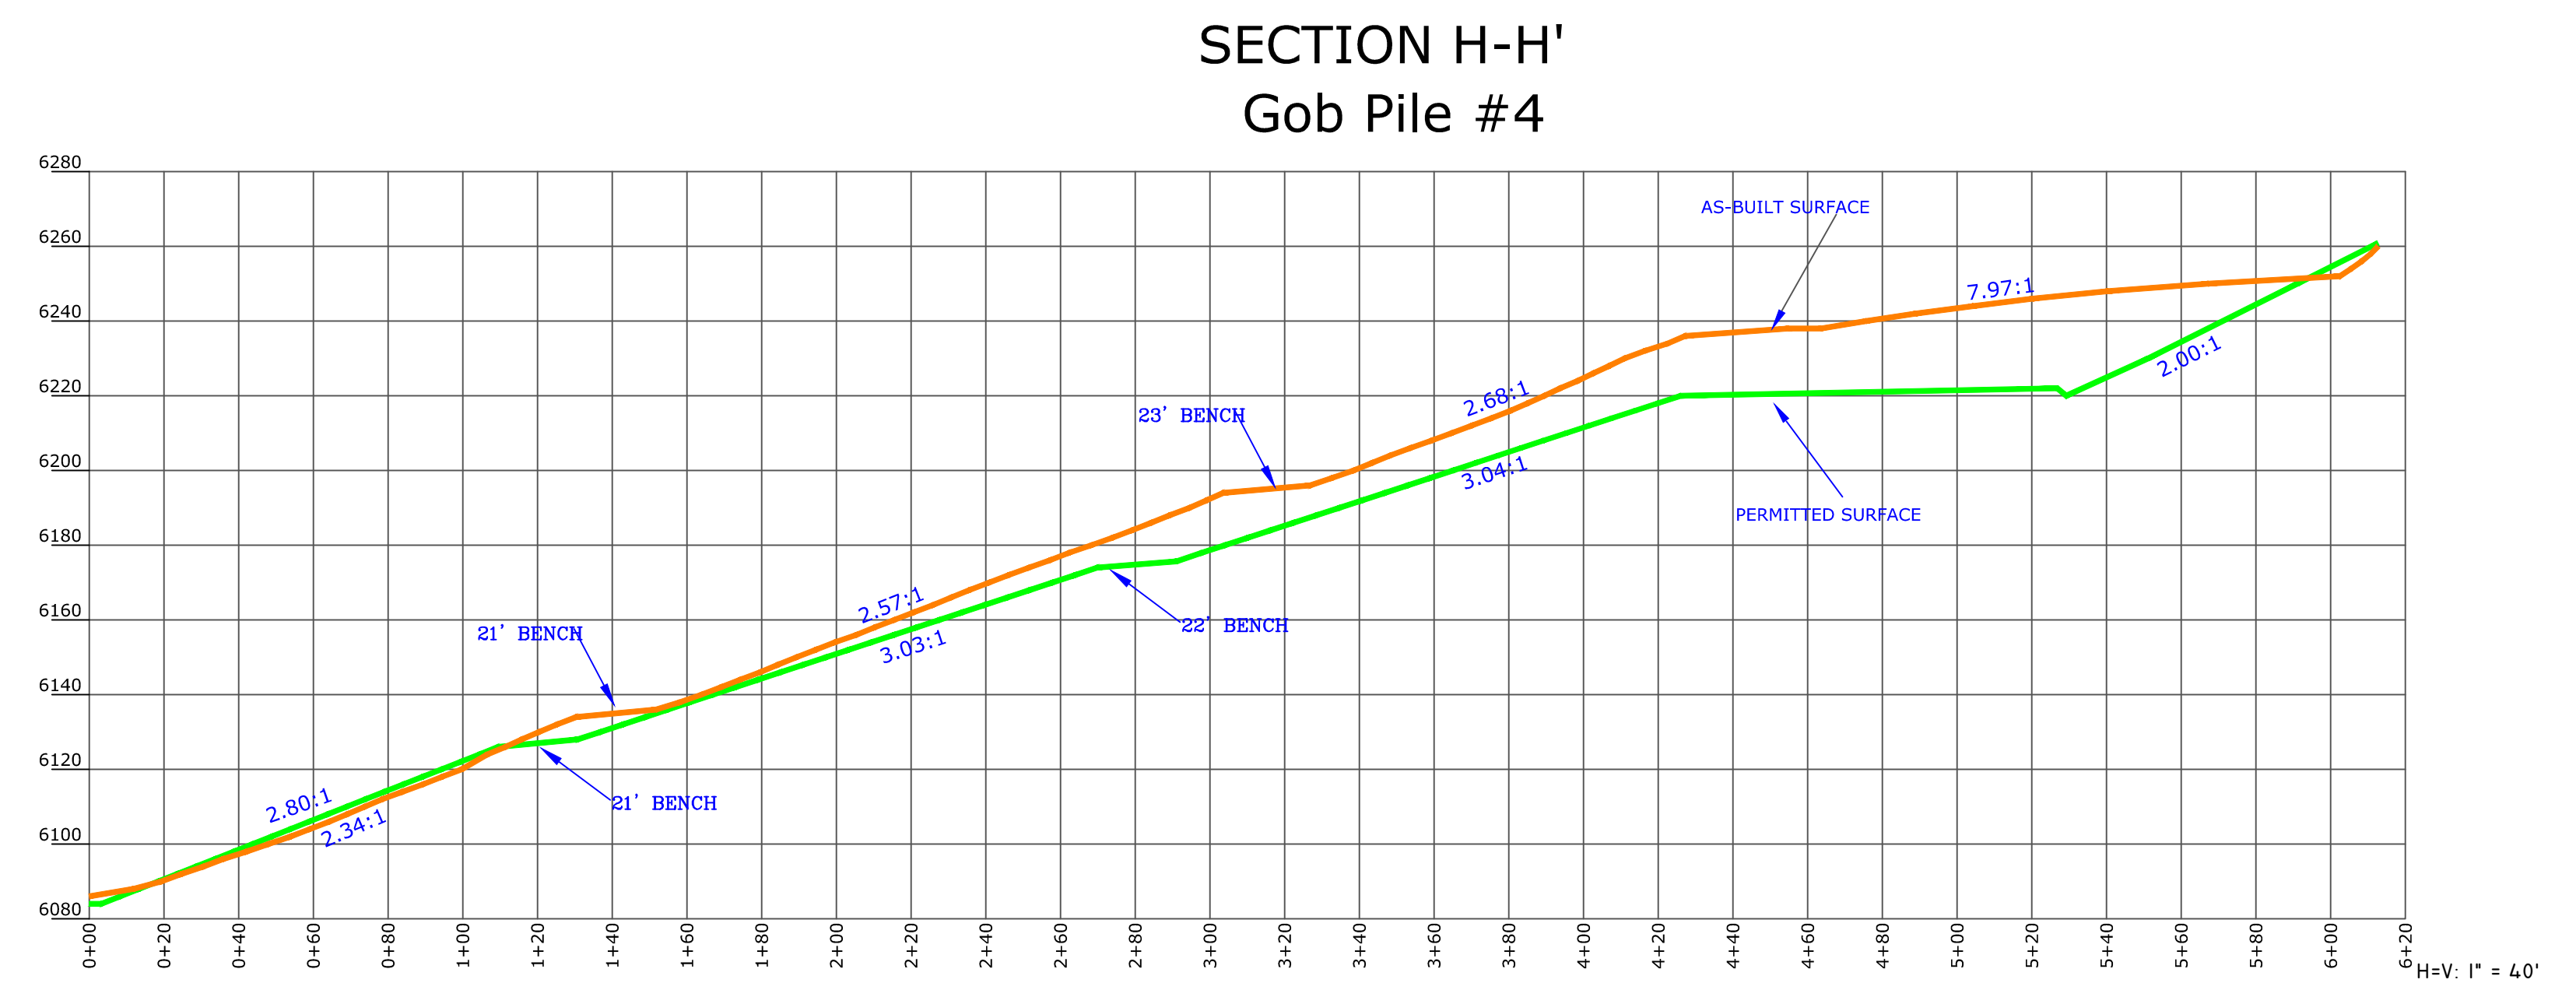
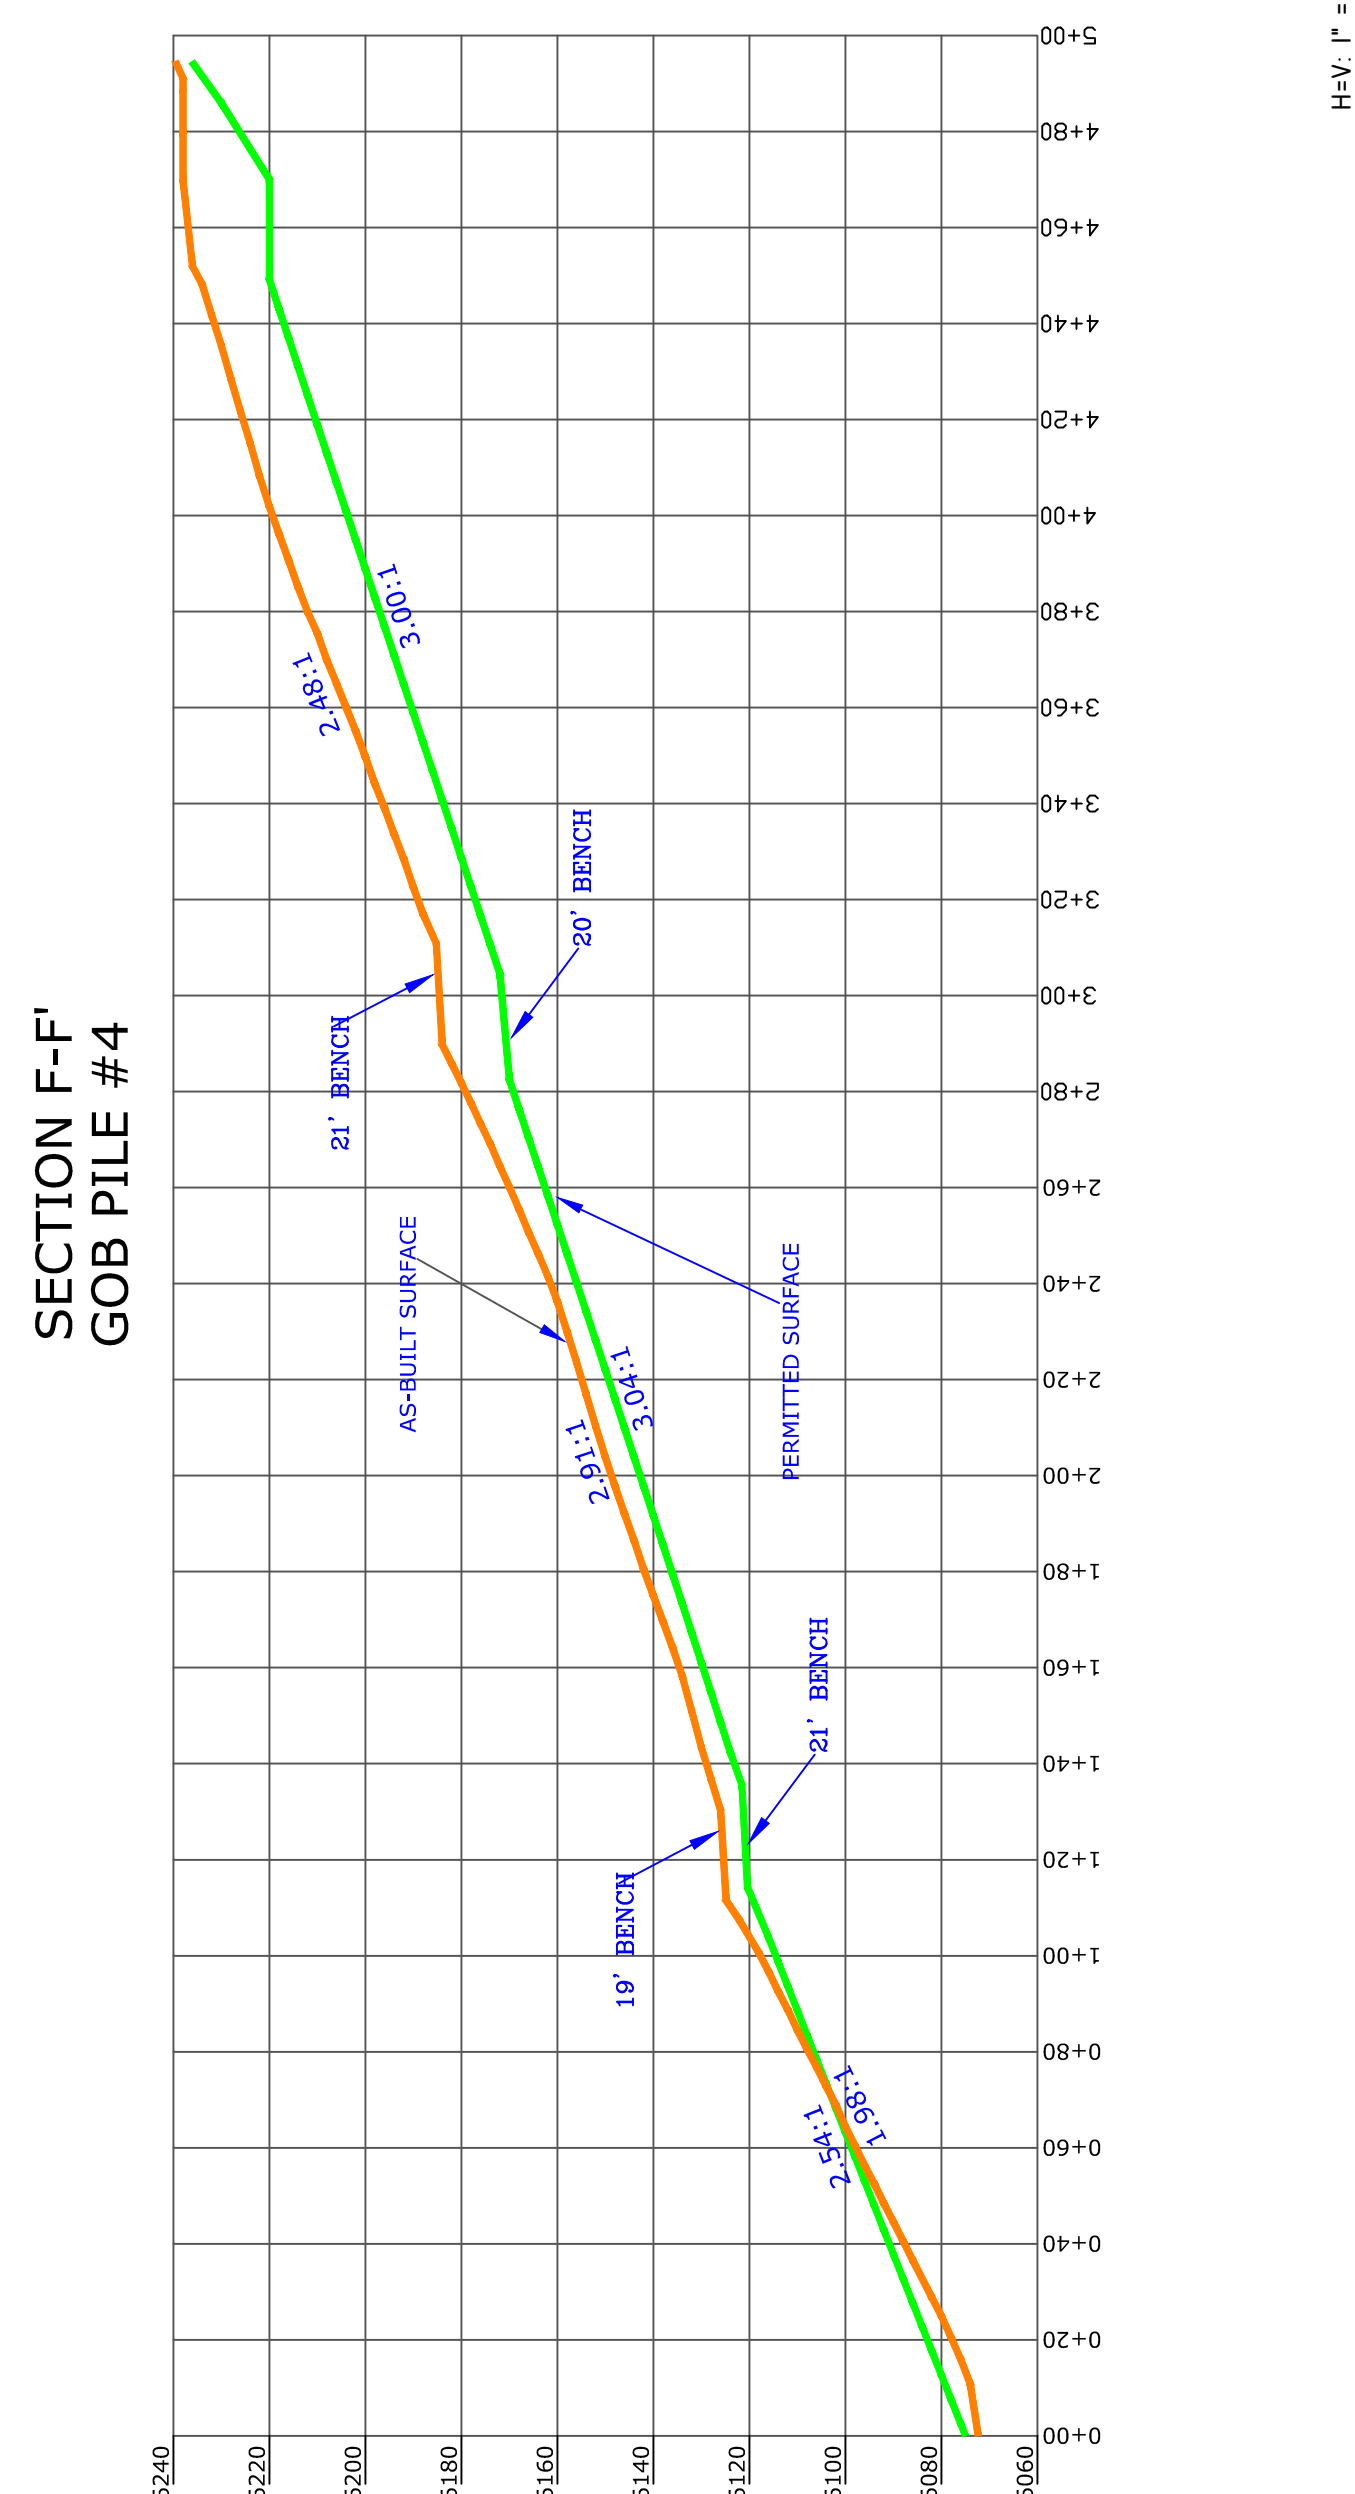
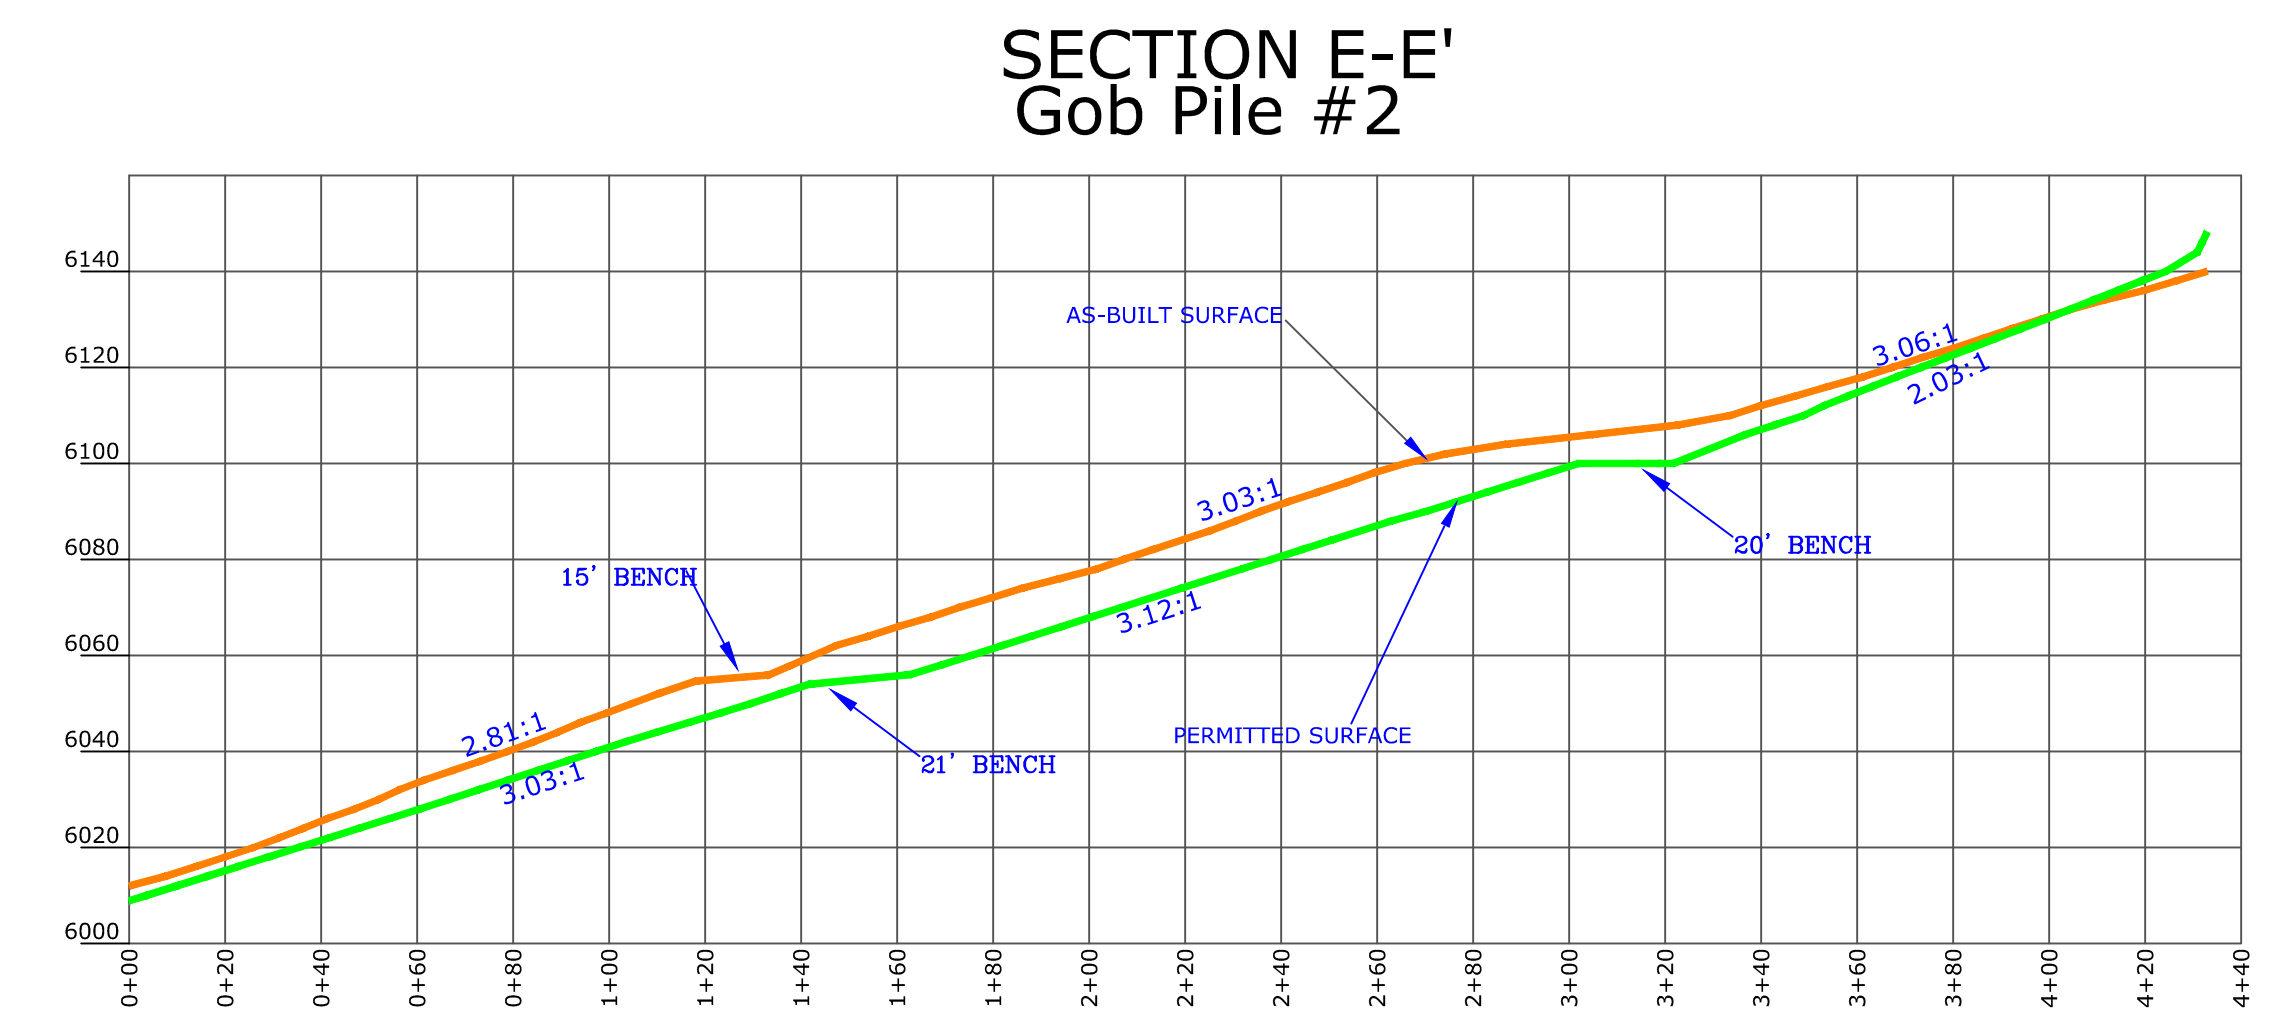
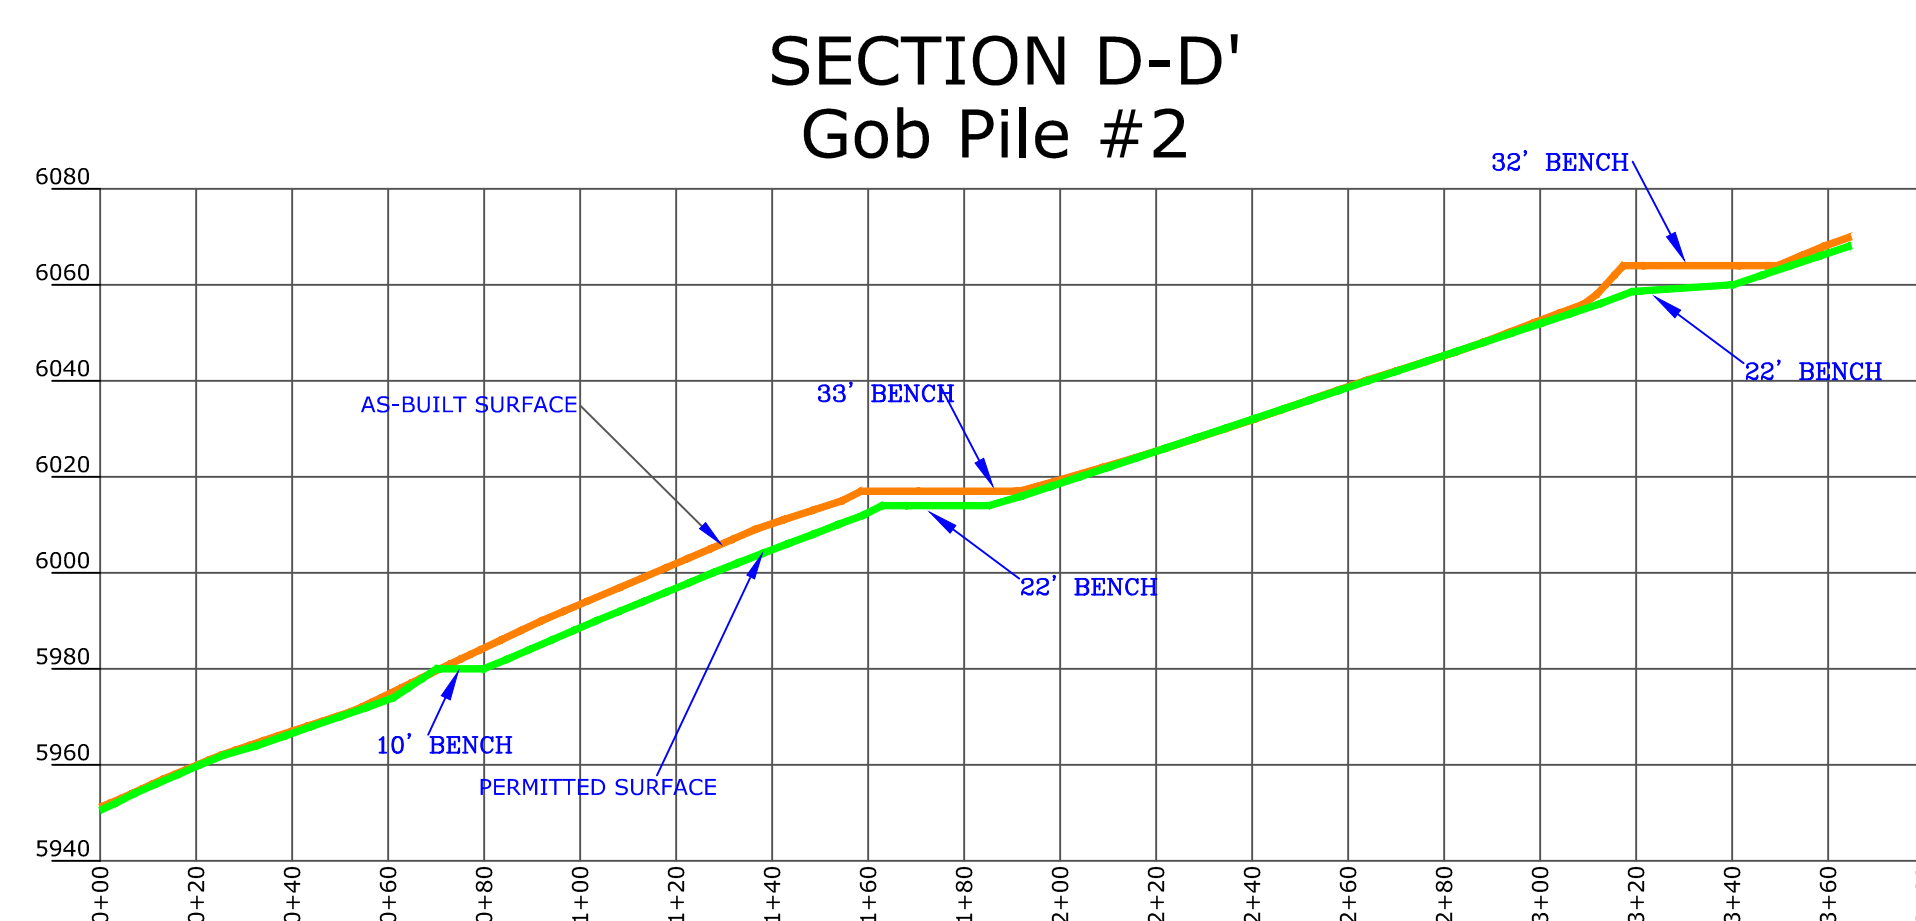
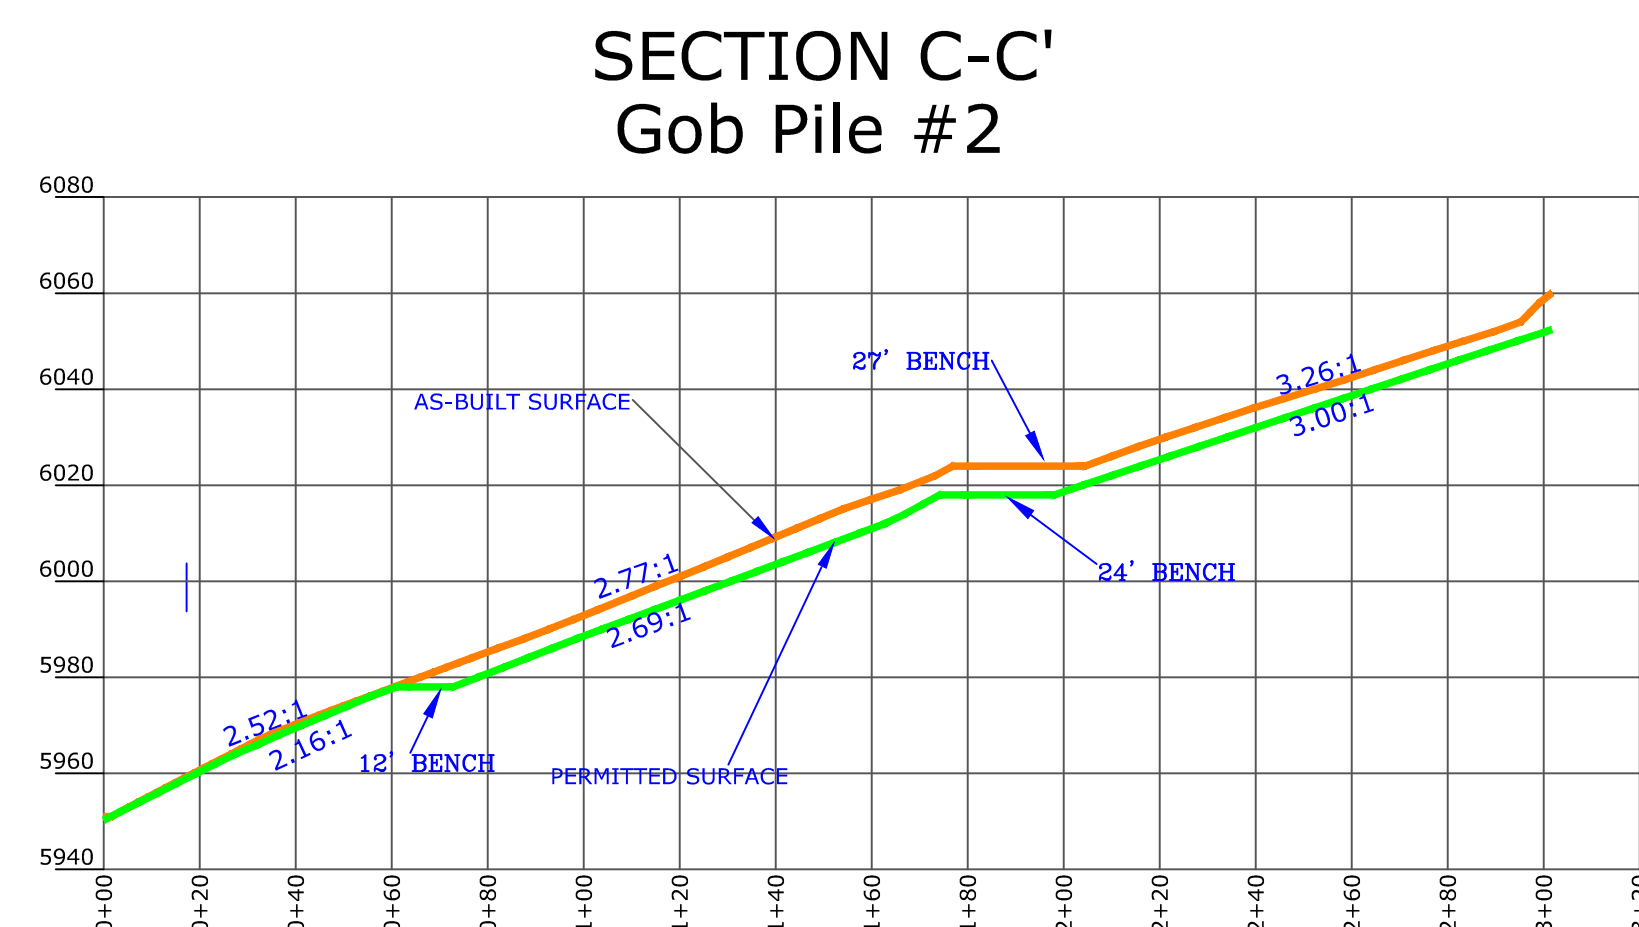
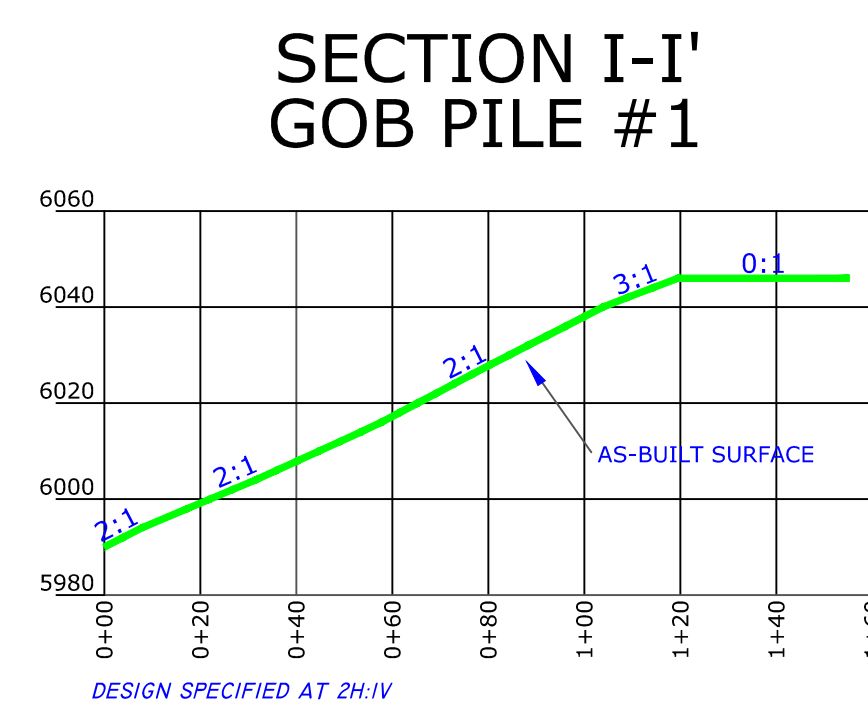
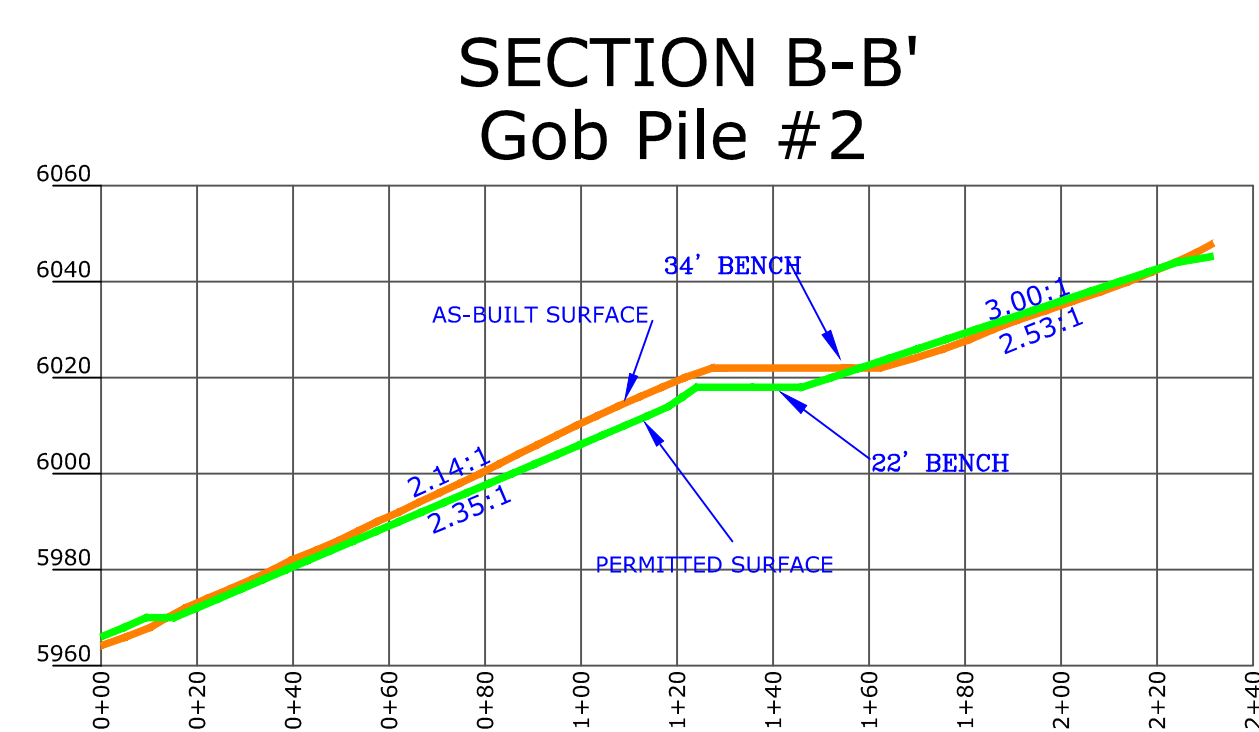


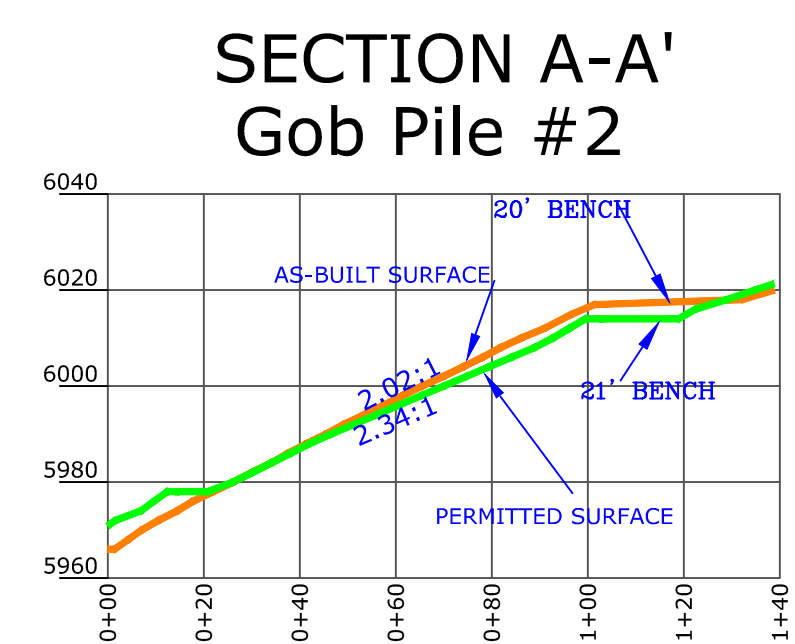

REVISIONS			
No. DESCRIPTION:		BY	DATE
REFERENCES			

LEGEND:

PERMITTED SURFACE

AS-BUILT SURFACE

RIP-RAP CHANNEL

ENGINEERING CERTIFICATION

I hereby certify that the drawing having was done by me or under my direct supervision and that all of the information presented on this drawing is true and correct to the best of my knowledge and belief.



Tammerrin, James R. _____ Date _____
Colorado Professional Engineer

PREPARED FOR:

BRL

BOWIE RESOURCES, LTD.

BOWIE NO. 2 MINE
P.O. BOX 483
PAONIA, COLORADO 81424

PREPARED BY:

TAMME BISHOP
CONSULTING ENGINEER

ONE INCH

DESIGNED BY:
 DRAWN BY: L.K.J. 03

PROJECT:		BOWIE NO. 2 MINE	
TITLE:		GOB PILES #1, 2, 4 - AS BUILT	
DRWS I.D. No.	C - 1996 - 083	DWS. NAME:	
04/03	SCALE: 1" = 200'		FIGURE 1