

REVISIONS				
No. DESCRIPTION:			BY	DATE
REFERENCES				

LEGEND:

	PERMITTED SURFACE
	AS-BUILT SURFACE

ENGINEER'S CERTIFICATION

I hereby certify that this drawing was done by me or under my direct supervision and that all of the information presented on this drawing is 54022 correct to the best of my knowledge and belief.

4-4-75

TAMMERLIN ENGINEERING

Tammerlin Engineering, Inc. Date
Colorado P.E. Special Engineer

PREPARED FOR:


BRL

BOWIE RESOURCES, LTD.

BOWIE NO. 2 MINE
P.O. BOX 483
PAONIA, COLORADO 81429

PREPARED BY:

TAMME BISHOP
CONSULTING ENGINEER

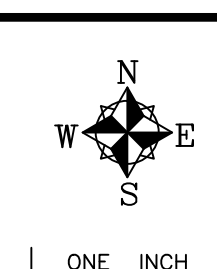

PROJECT:	BOWIE NO. 2 MINE	
TITLE:	GOB PILE #3 AS-BUILT	
DRMS I.D. No.	C - 1996 - 083	DWG. NAME:
SCALE:	1" = 200'	FIGURE 2