


COLORADO DIVISION OF HIGHWAYS
 DOTSERO CINDER PIT
 SE1/4 Sec. 33, T.4 S., R. 86 W., 6th PM.
 NE1/4 Sec. 4, T.5 S., R. 86 W., 6th PM.
 EAGLE COUNTY, COLO.

FEDERAL ROAD DISTRICT NO.	DIVISION	PROJ. NO.	SHEET NO.	TOTAL SHEETS
VIII	COLORADO			
AS CONSTRUCTED				
NO REVISIONS	REVISED	VOID		

Scale 1" = 300'
 Contour Interval = 40'

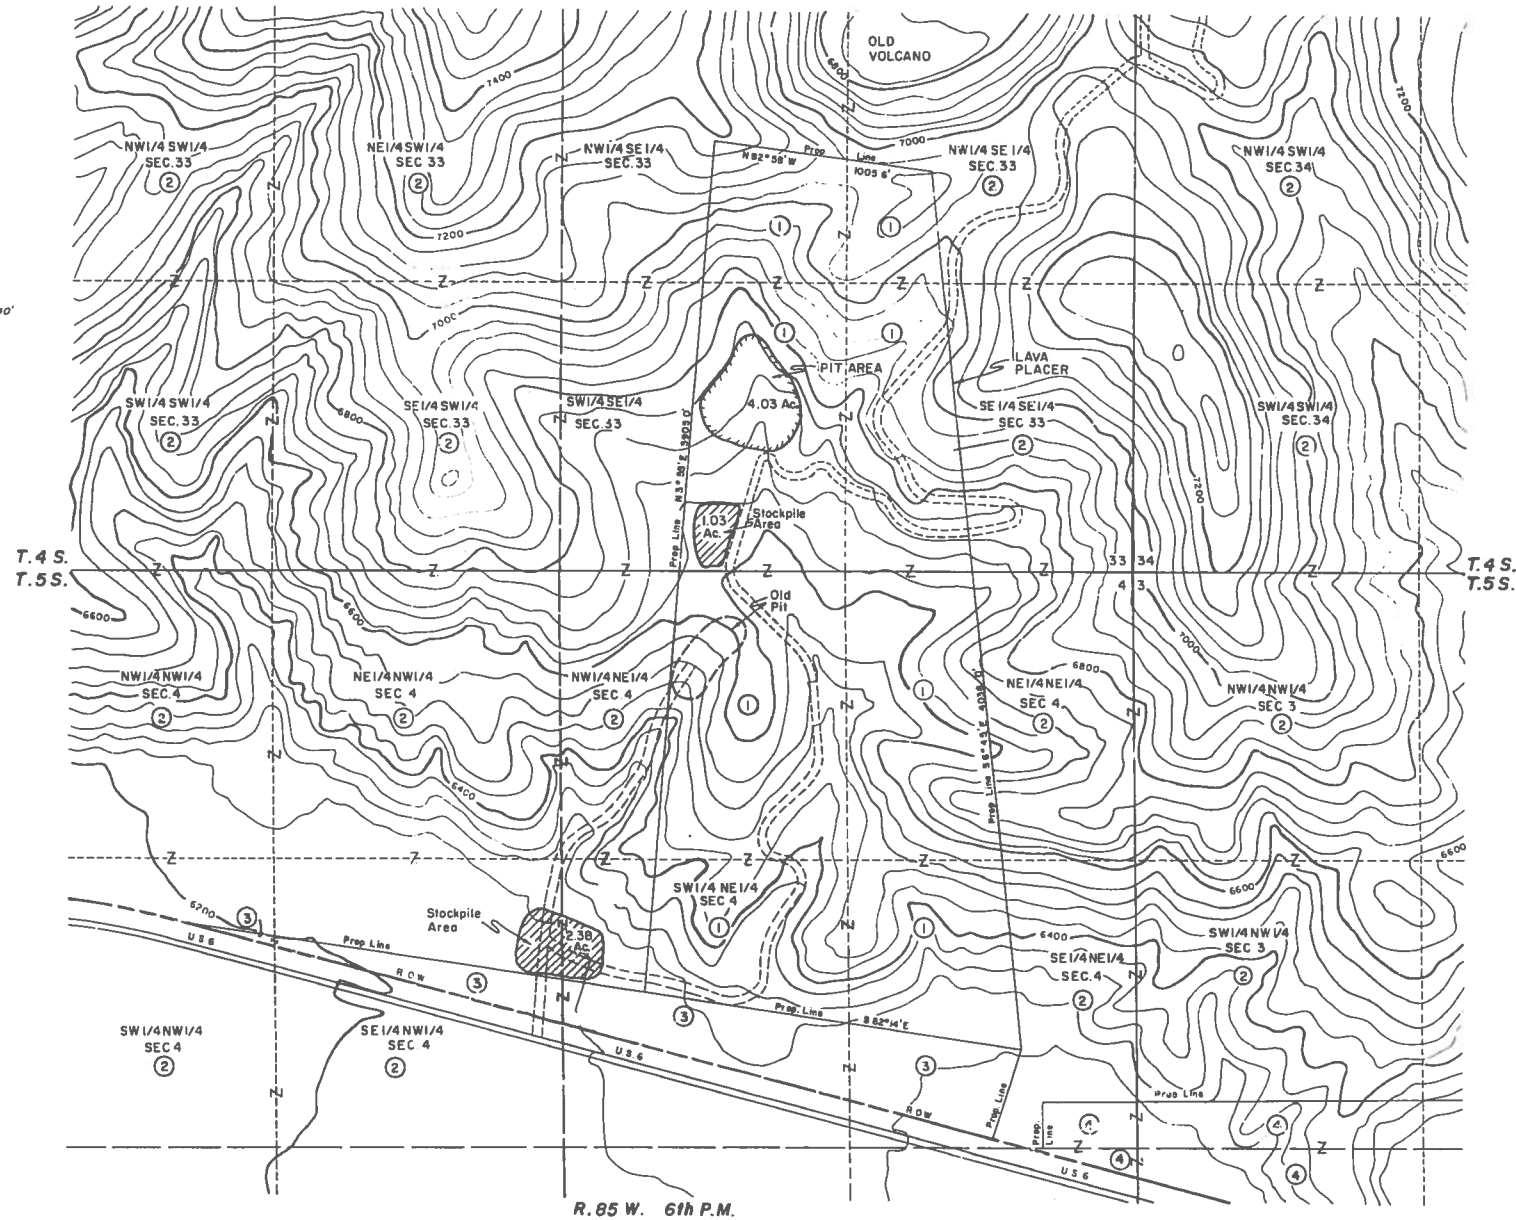

RECEIVED

AUG 08 2012
 GRAND JUNCTION FIELD OFFICE
 DIVISION OF
 RECLAMATION MINING & SAFETY

M 12/11/12
 JCH

OWNERSHIP LEGEND	
PARCEL NO.	OWNER
1	COLORADO DEPARTMENT OF HIGHWAYS
2	BUREAU OF LAND MANAGEMENT
3	DOTSERO BLOCK COMPANY
4	GOTSCHALL, NEVA I.