Appendix O.2

Underground Workings
As-Built Drawing

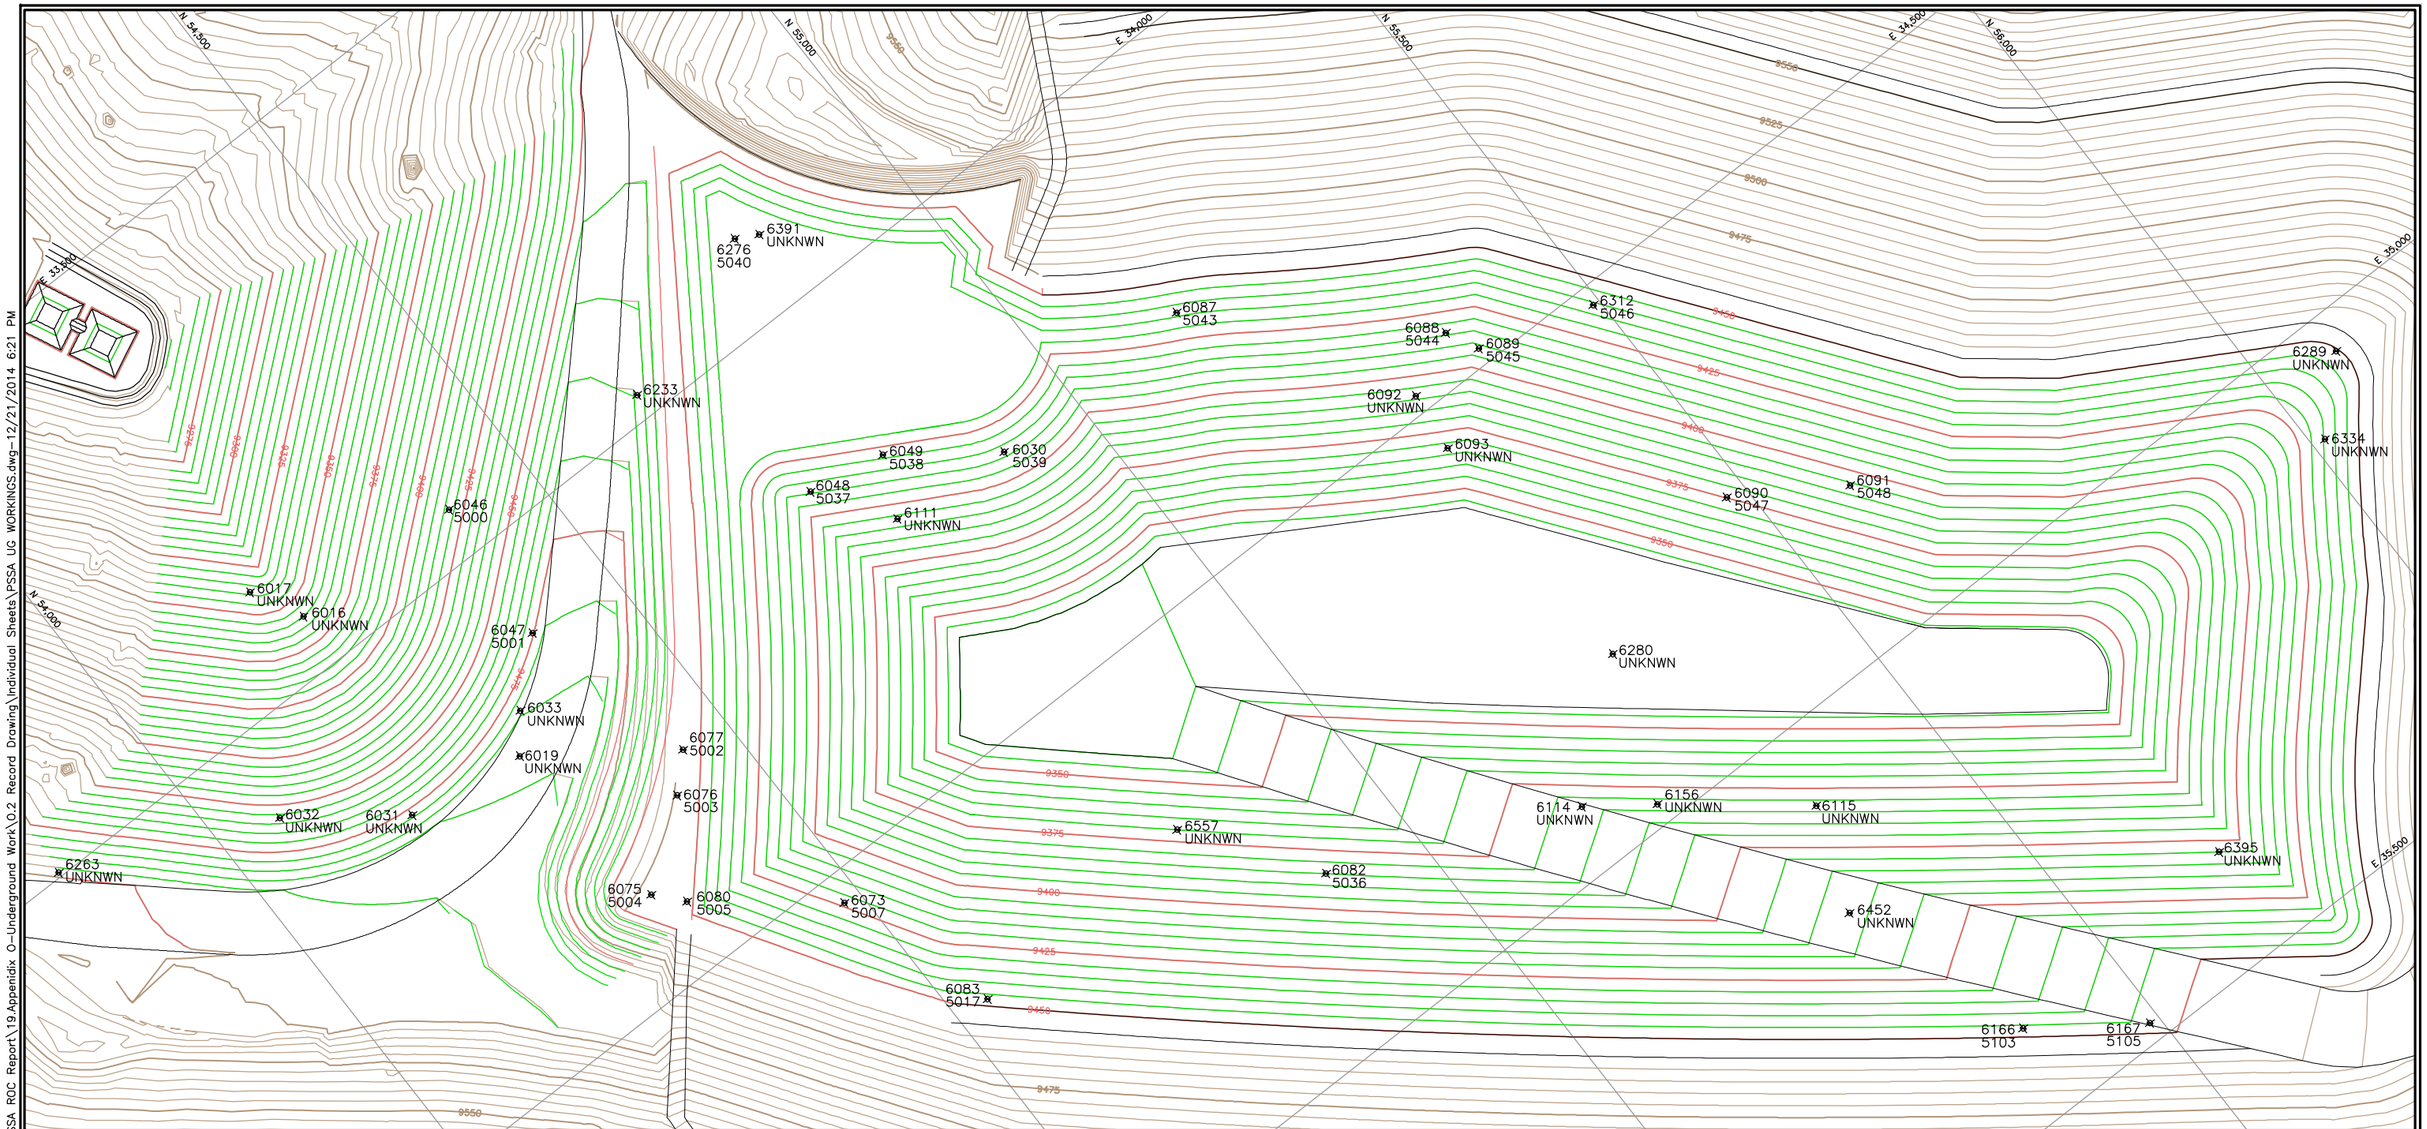

LEGEND

9000 EXISTING CONTOUR, FT

9000 SOIL LINER FILL CONTOUR, FT

AMES ID NO. / CCV ID NO. UNDERGROUND WORKING LOCATION

NOTES:

1. ALL UNDERGROUND WORKINGS REMEDIATED AS PART OF THE PSSA CONSTRUCTION ARE SHOWN ON THIS DRAWING.
2. SEE SUMMARY TABLE IN APPENDIX 0.1 OF RECORD OF CONSTRUCTION REPORT FOR MORE DETAIL.

80 0 80 160 FT

COLORADO LICENSED
ANDREA L. MEDINA
48325
12/19/2014
PROFESSIONAL ENGINEER

REV	DATE	DESCRIPTION	ENGR / CADD
0	12/19/2014	ISSUED FOR RECORD OF CONSTRUCTION	RBR / RBR

CLIENT: CRIPPLE CREEK & VICTOR GOLD MINING COMPANY

DISCLAIMER

AMEC PRODUCED THE INFORMATION PRESENTED ON THIS DRAWING THROUGH THE USE OF TECHNICAL INFORMATION AND PRACTICAL EXPERIENCE SPECIFIC TO ITS EFFORTS. RECEIVING THIS DRAWING DOES NOT GUARANTEE ANY RIGHTS TO SUCH TECHNICAL INFORMATION AND PRACTICAL EXPERIENCE. ANY ALTERATION OR ADAPTATION OF THE DATA OR CONTENTS OF THIS DRAWING SHALL BE AT USER'S SOLE RISK AND WITHOUT ANY LIABILITY OR LEGAL RESPONSIBILITY TO AMEC.

ISSUED FOR: R.O.C.

PROVIDED BY: amec

DATUM:

DRN BY: RBR

DSN BY: RBR

CHK BY: TB

APR BY: RBR

PROJECT: SQUAW GULCH VLF PROCESS SOLUTION STORAGE AREA

TITLE: UNDERGROUND WORKINGS RECORD OF CONSTRUCTION DRAWING

ISSUED DATE: 12/19/2014

PROJECT No.: 74201125

DRAWING No.: 1 OF 1

REV: 0

S:\Projects\1125N Squaw Valley\8.0 Engineer-Design\8.1 Reports-Docs\PSSA ROC Report\19.Appendix O-Underground Work\0.2 Record Drawing\Individual Sheets\PSSA UG WORKINGS.dwg-12/21/2014 6:21 PM