



ELEV. (ft)	AREA (ac)	AVG. AREA (ac)	INTERVAL (ft)	STORAGE (ac-ft)	ACC. STORAGE (ac-ft)	STAGE INTERVAL (ft)
— —— 7455.00	0.0221					
7457.00	0.0425	0.0323	2.00	0.0646	0.0646	2.00
7459.00	0.0662	0.0543	2.00	0.1083	0.1729	4.00
7461.00	0.1030	0.0846	2.00	0.1626	0.3355	6.00
7463.00	0.1619	0.1324	2.00	0.2788	0.6143	8.00
7465.00	0.2125	0.1872	2.00	0.3749	0.9893	10.00
7467.00	0.2789	0.2457	2.00	0.4910	1.4803	12.00
7469.00	0.3602	0.3196	2.00	0.6319	2.1122	14.00
7471.00	0.4298	0.3950	2.00	0.7872	2.8994	16.00
7473.00	0.5028	0.4663	2.00	0.9325	3.8320	18.00
7475.00	0.5028	0.5415	2.00	1.0842	4.9161	20.00
		0.5804	2.00	1.1611	6.0773	22.00
7477.00	0.5806	0.5806	2.00	1.1612	7.2384	24.00
7479.00 7480.00	0.5806 0.5806	0.5806	1.00	0.5806	7.8190	25.00

ENGINEERS CERTIFICATION

I, BRIAN W. COATES, hereby certify that this map has been reviewed by me and is true and correct to the best of my knowledge and information, relying on information supplied by experts employed by Colowyo Coal Company or qualified consultants working for Colowyo Coal Company, and that I am a Professional Engineer licensed in Colorado as required by the provisions of C.R.S.

12-25-101 through C.R.S. 12-25-119. IN WITNESS WHEREOF, I have hereunder set my hand and affixed my seal.

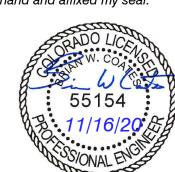

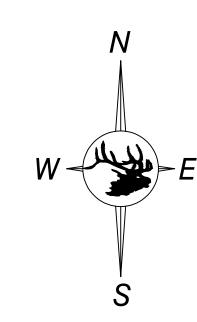

## West Taylor Pond As-Built



DRWG NO. Colowyo Coal Company
5731 State Highway 13
Meeker, Colorado 81641

Figure Exh. 7-20B-1

SCALE: <u>As Shown</u>
DATE: <u>10/28/20</u>

DRWG. BY: <u>Tony</u> APPROVED BY: <u>BWC</u>

Vo.	REVISION	DATE	BY	СНК