


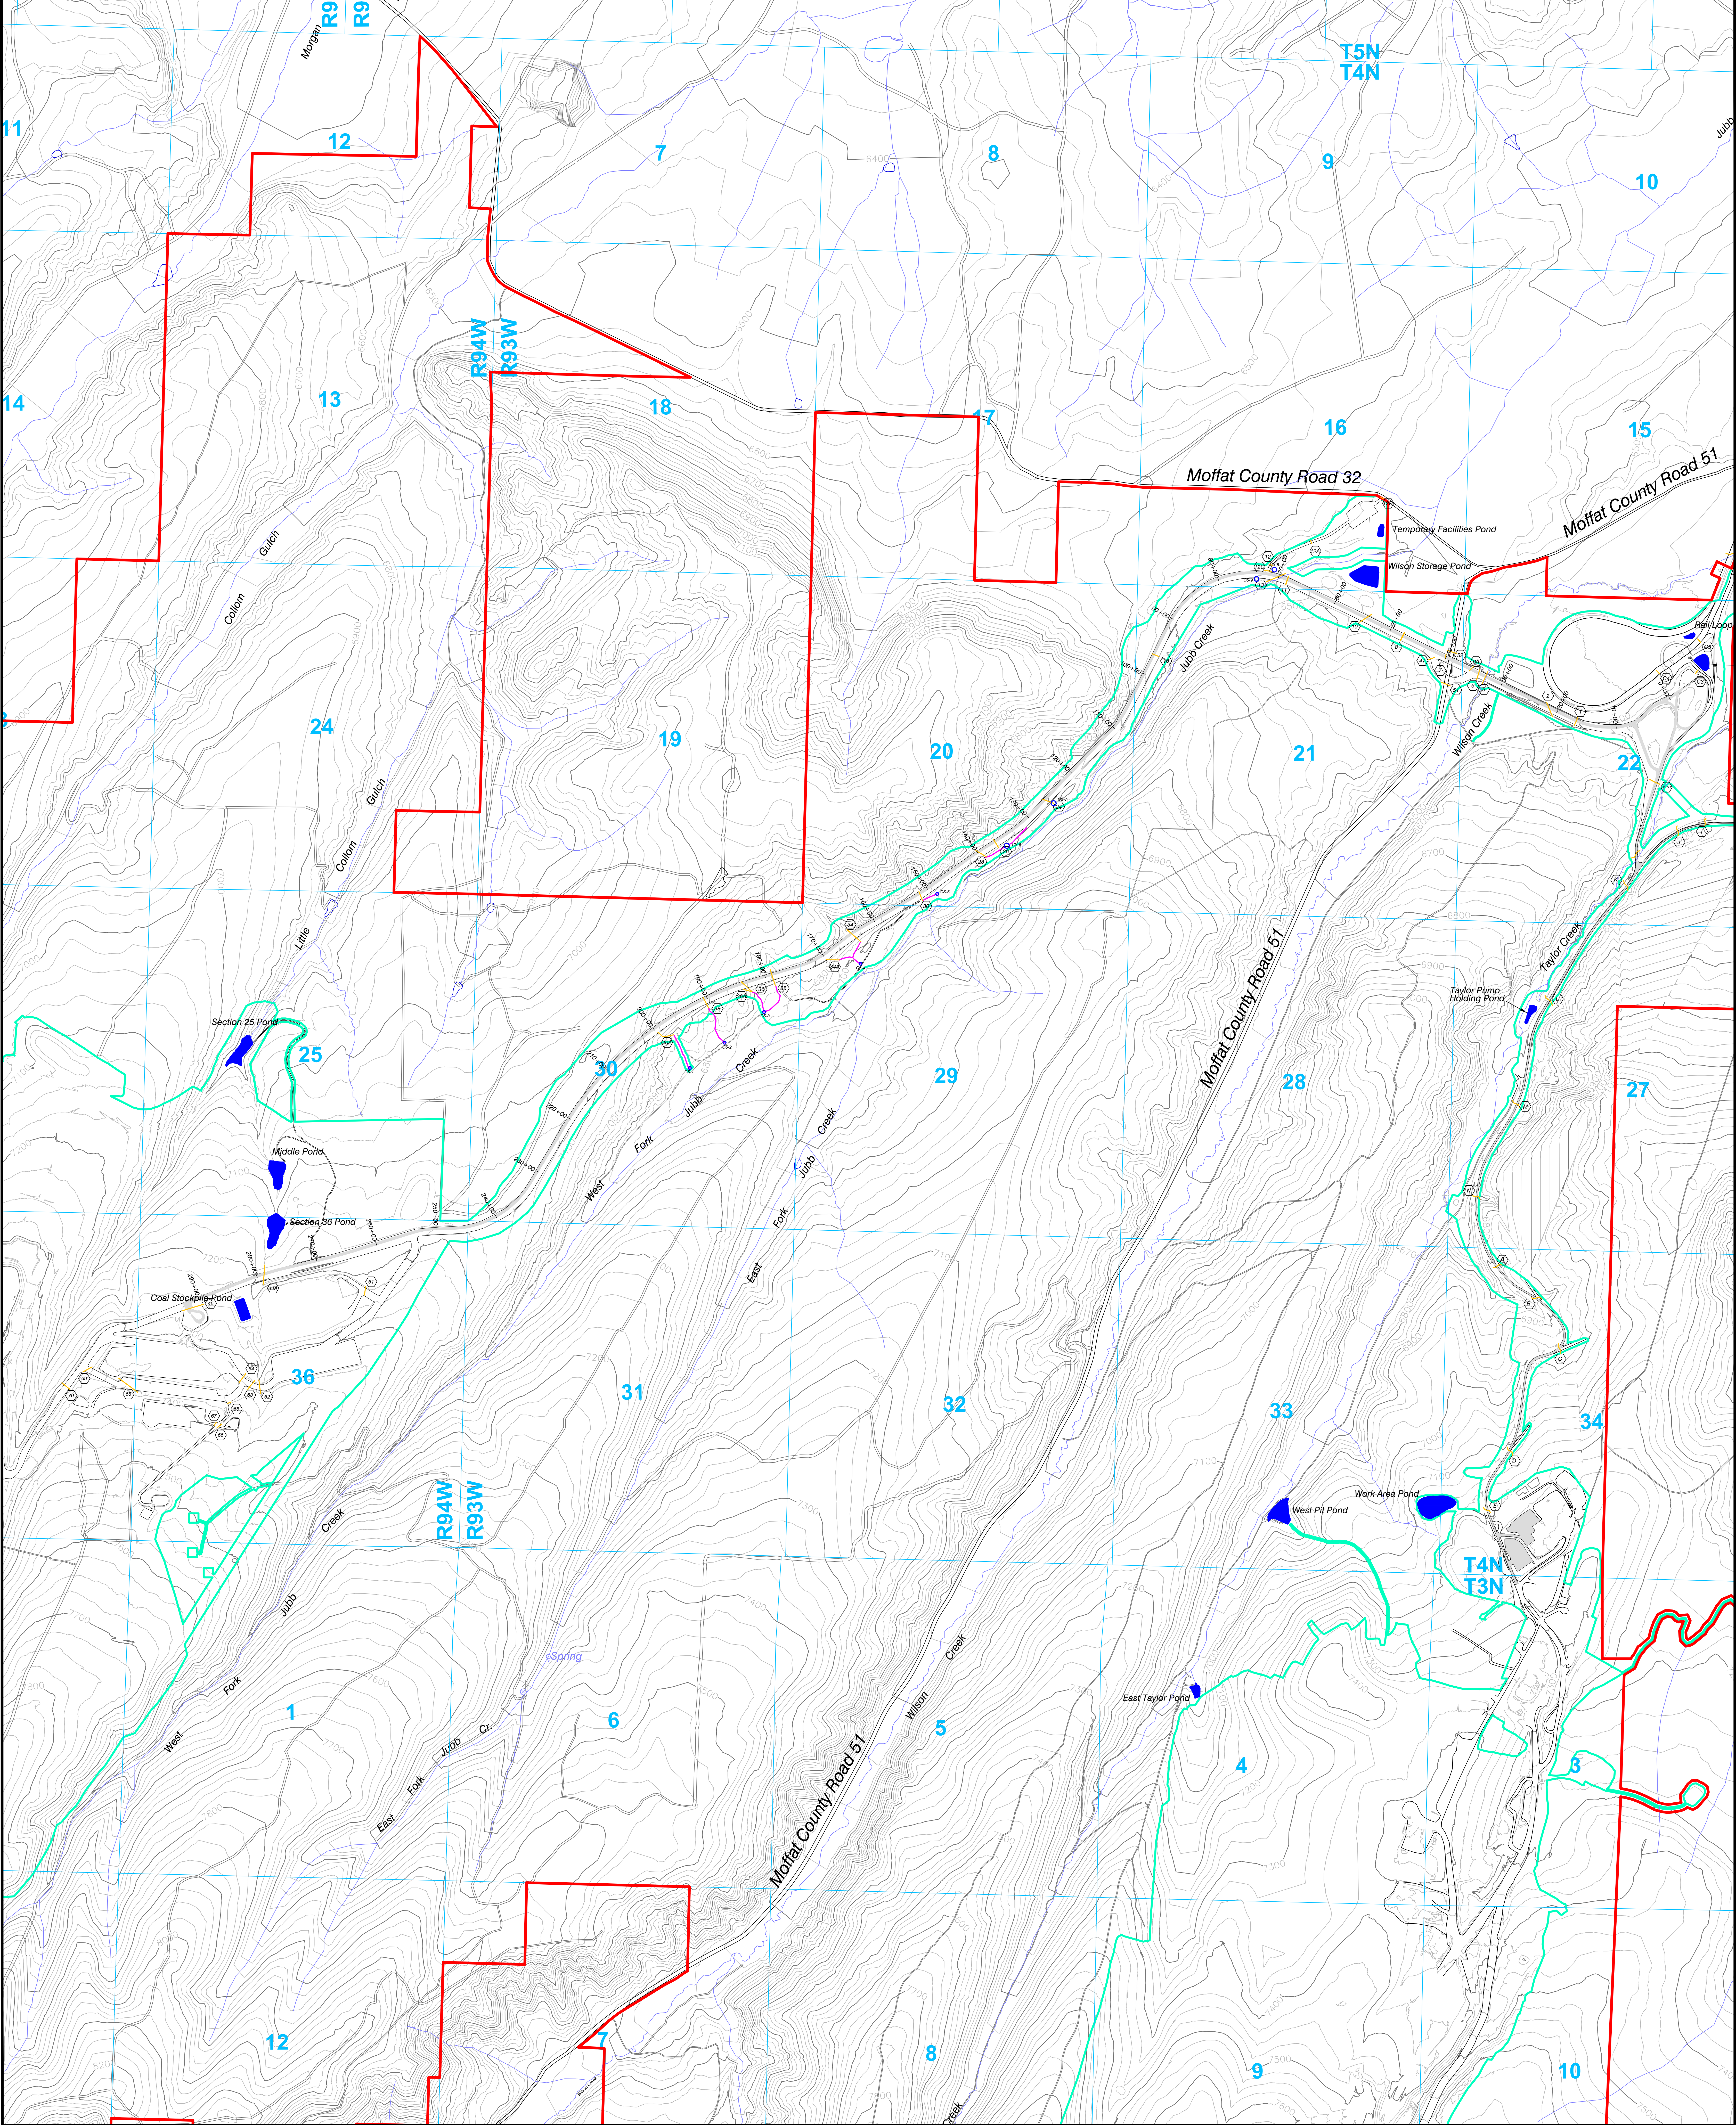

LEGEND

- Permit Boundary
- Disturbance Boundary
- Culvert Locations
- Paved Areas
- Roads
- Channel Locations
- BMP/Sump Locations (Location Only Not Actual Size)
- Sediment Ponds

ENGINEER'S CERTIFICATION

I, Trevor B. Ragsdale, hereby certify that this map has been reviewed by me and is true and correct to the best of my knowledge and information, relying on information supplied by experts employed by Colowyo Coal Company or qualified consultants working for Colowyo Coal Company, and that I am a Professional Engineer licensed in Colorado as required by the provisions of C.R.S. 12-25-101 through C.R.S. 12-25-116. IN WITNESS WHEREOF, I have hereunder set my hand and affixed my seal.

COLOWYO COAL COMPANY
REGISTERED PROFESSIONAL ENGINEER
No. 56735
Exp. 12/31/2025

COLLOM HAUL ROAD
Plan View As-Built

SCALE: 1" = 800'
DATE: 7/20/22
DRAWN BY: Tany
APPROVED BY: DW
DRAWN NO.:
MAP 25E
Sheet 1 of 4

No.	REVISION	DATE	BY	CHK
TR-149	Removed Culverts, Added Ditches & Sumps	6/16/21	Tany	TR

Notes: Please refer to Map 25I for the as-built configuration of the crossing of Moffat County Road 51 at approximately station 40+00.
Please see Volume 18C Exhibit 7, Item 25F for all culvert sizing information