


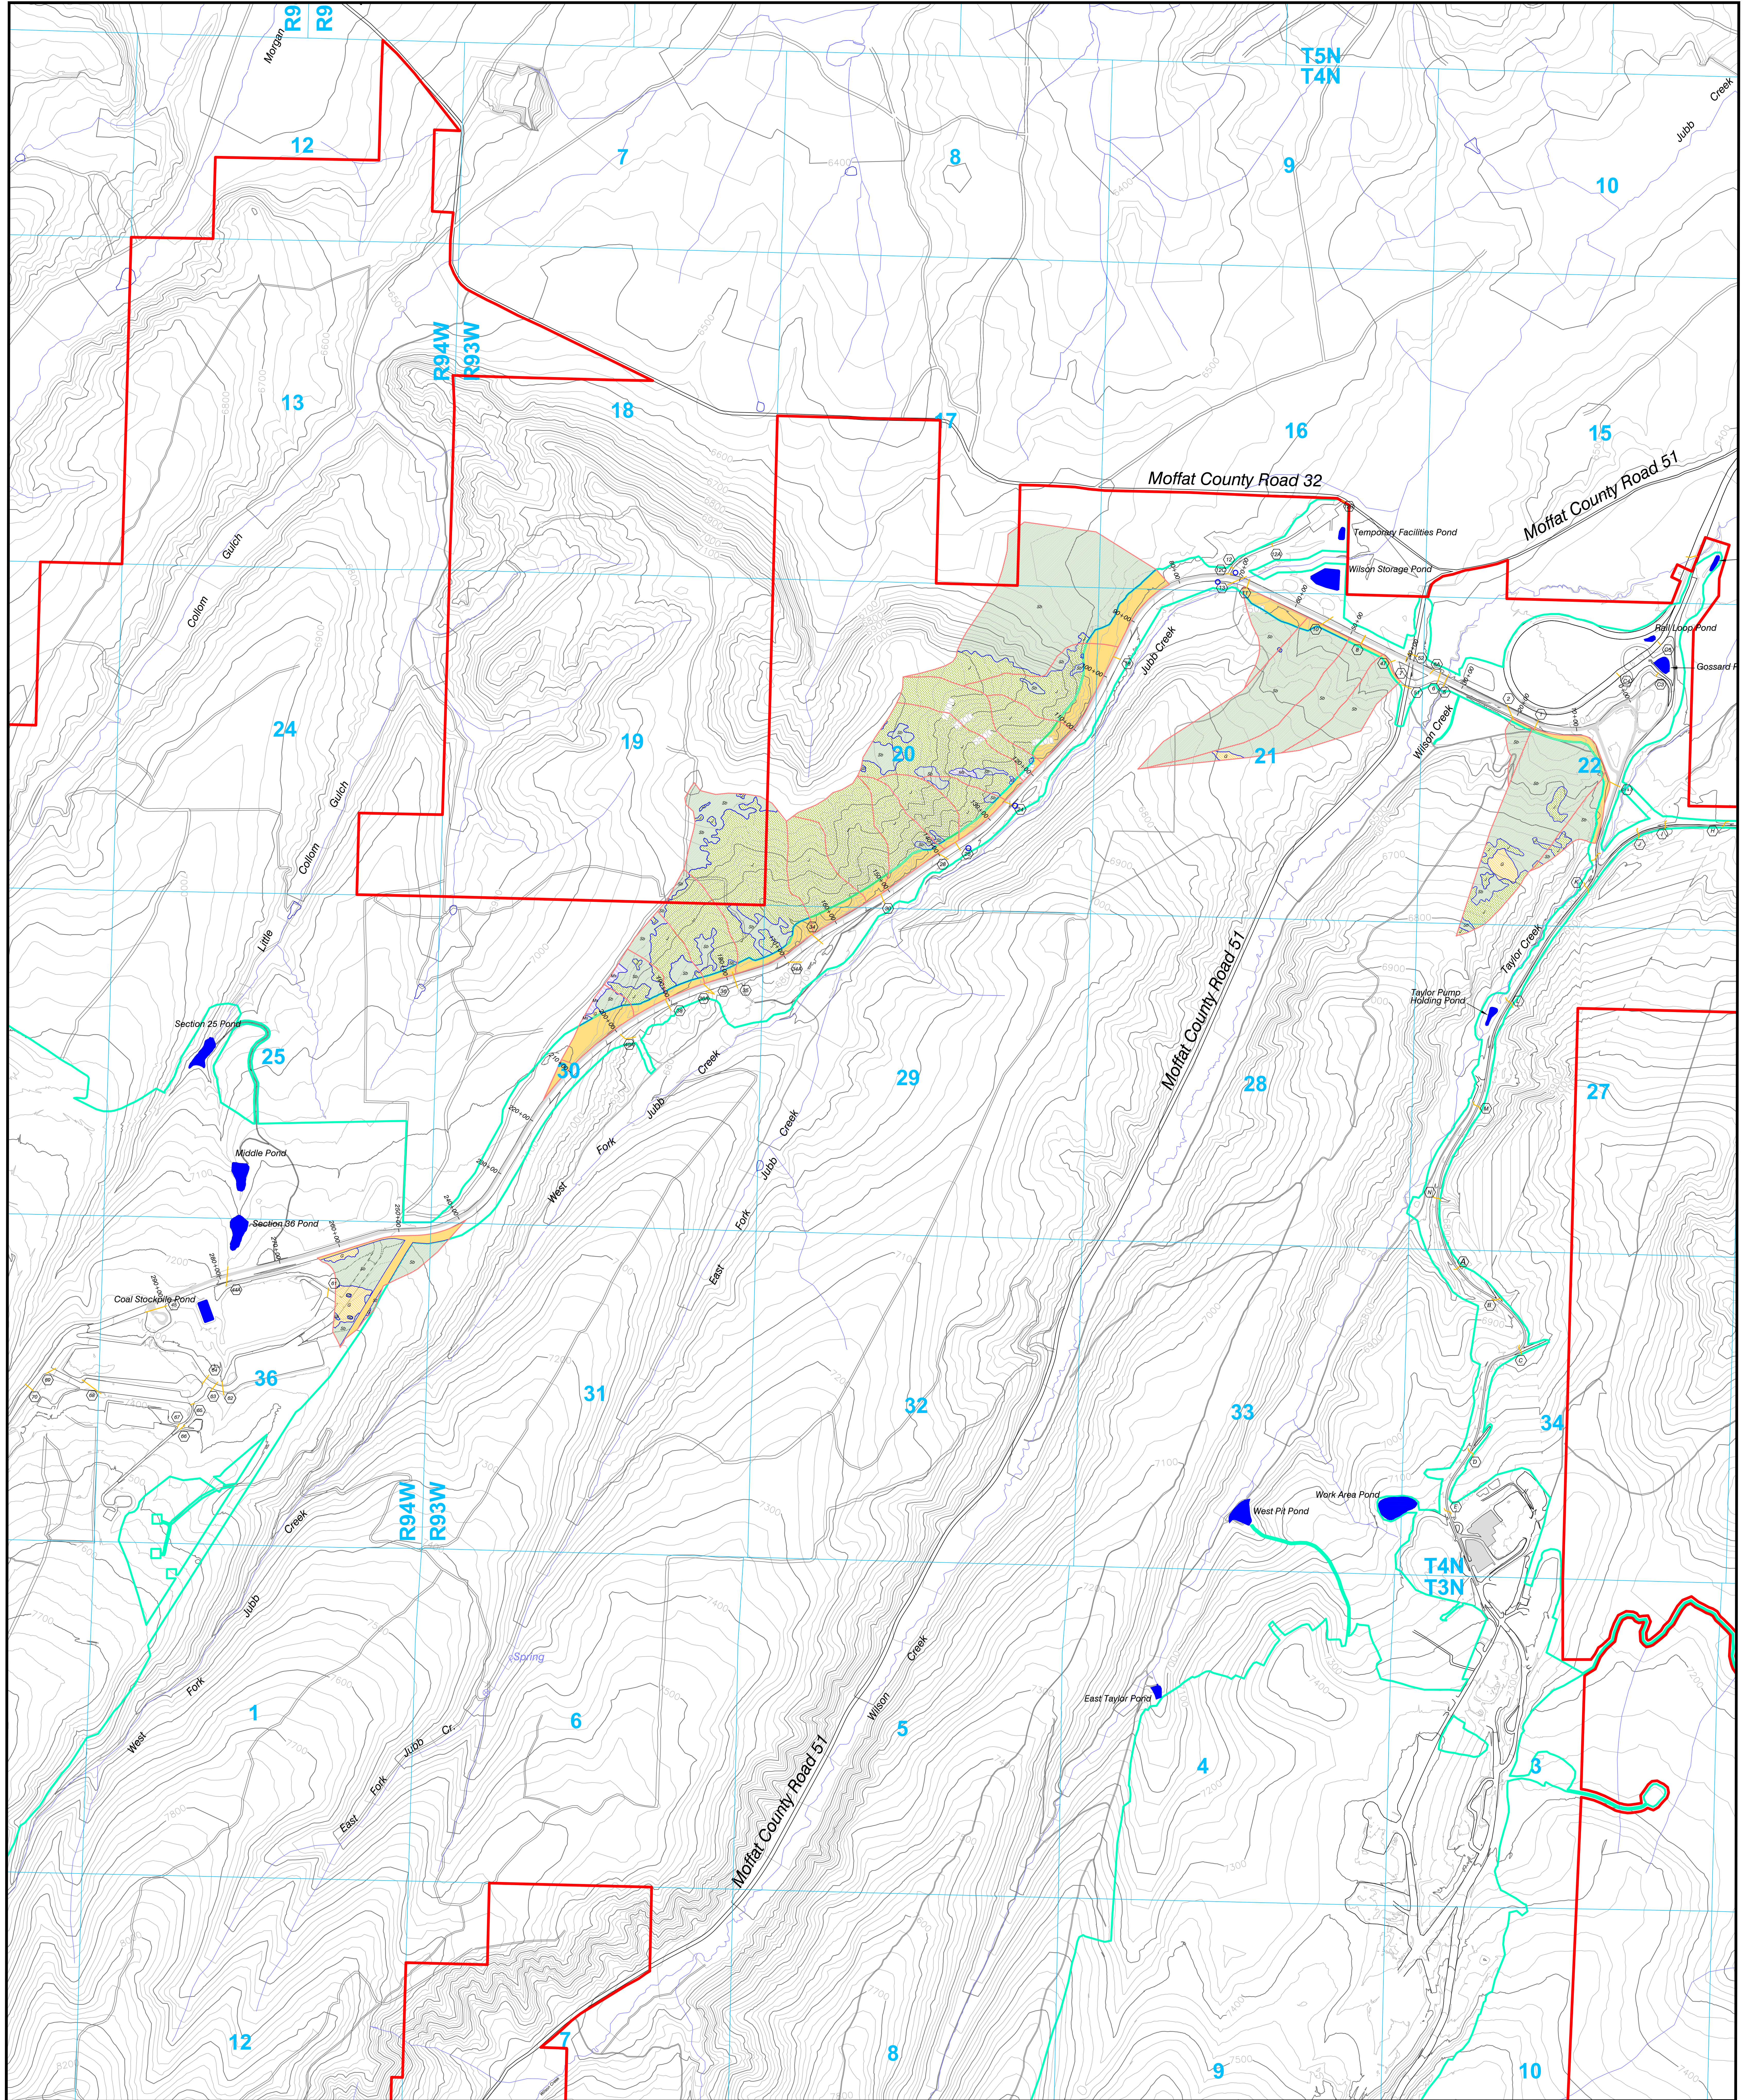

Legend

- Permit Boundary
- Section Lines
- Disturbance Boundary
- Paved Areas
- Culvert Locations
- Culvert Drainage Boundary
- Sediment Pond
- Disturbed Areas

Vegetation Communities (Map 4)

- Bottomland
- Grassland
- Juniper Scrub
- Sagebrush
- Mountain Shrub

Note: See Volume 18C Exhibit 7, Item 25F for all culvert sizing information associated with the Colowyo Haul Road.

0 800 1600 2400

CONTOUR INTERVAL 25 FT.
JUNE 2019 TOPOGRAPHY

COORDINATES OF MAP 25E


ENGINEERS CERTIFICATION

I, Trevor B. Ragsdale, hereby certify that this map has been reviewed by me and is true and correct to the best of my knowledge and information, relying on information supplied by experts employed by Colowyo Coal Company or qualified consultants working for Colowyo Coal Company, and that I am a Professional Engineer licensed in Colorado as required by the provisions of C.R.S. 12-25-101 through C.R.S. 12-25-119. IN WITNESS WHEREOF, I have hereunder set my hand and affixed my seal.

56735
6/16/21
PROFESSIONAL ENGINEER

COLLOM HAUL ROAD Drainage Design As-Built

Colowyo Coal Company

SCALE: 1" = 800'

DATE: 7/28/21

DRAWN BY: J. Toney

APPROVED BY: J. DW

DRWG NO.

MAP 25E
Sheet 2 of 4

No.	REVISION	DATE	BY	CHK
TR-142	Consolidated Sagebrush and Mountain Shrub	6/15/21	Toney	Toney