WILLOW CREEK RESTORATION PHASE 2
BORROW AREA AS-BUILT SURVEY

LOCATED IN A FRACTION OF LOT 6 AND THE NORTHEAST QUARTER OF THE SOUTHWEST QUARTER (NE¼SW¼) OF SECTION 6, TOWNSHIP 41 NORTH, RANGE 1 EAST, NEW MEXICO PRINCIPAL MERIDIAN, CITY OF CREEDE, MINERAL COUNTY, COLORADO

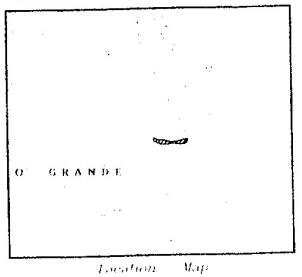

Location Map

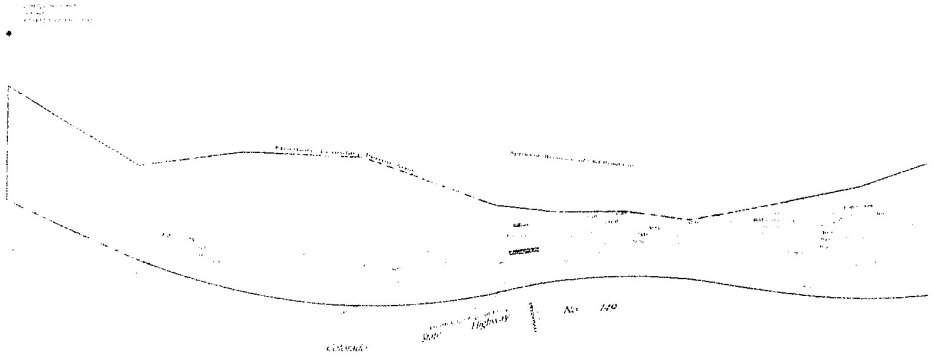

GRAPHIC SCALE

LEGEND

SURVEYOR'S STATEMENT

SURVEYOR'S NOTES

WILLOW CREEK RESTORATION PHASE 2
BORROW AREA AS-BUILT SURVEY

RHC 3/3