


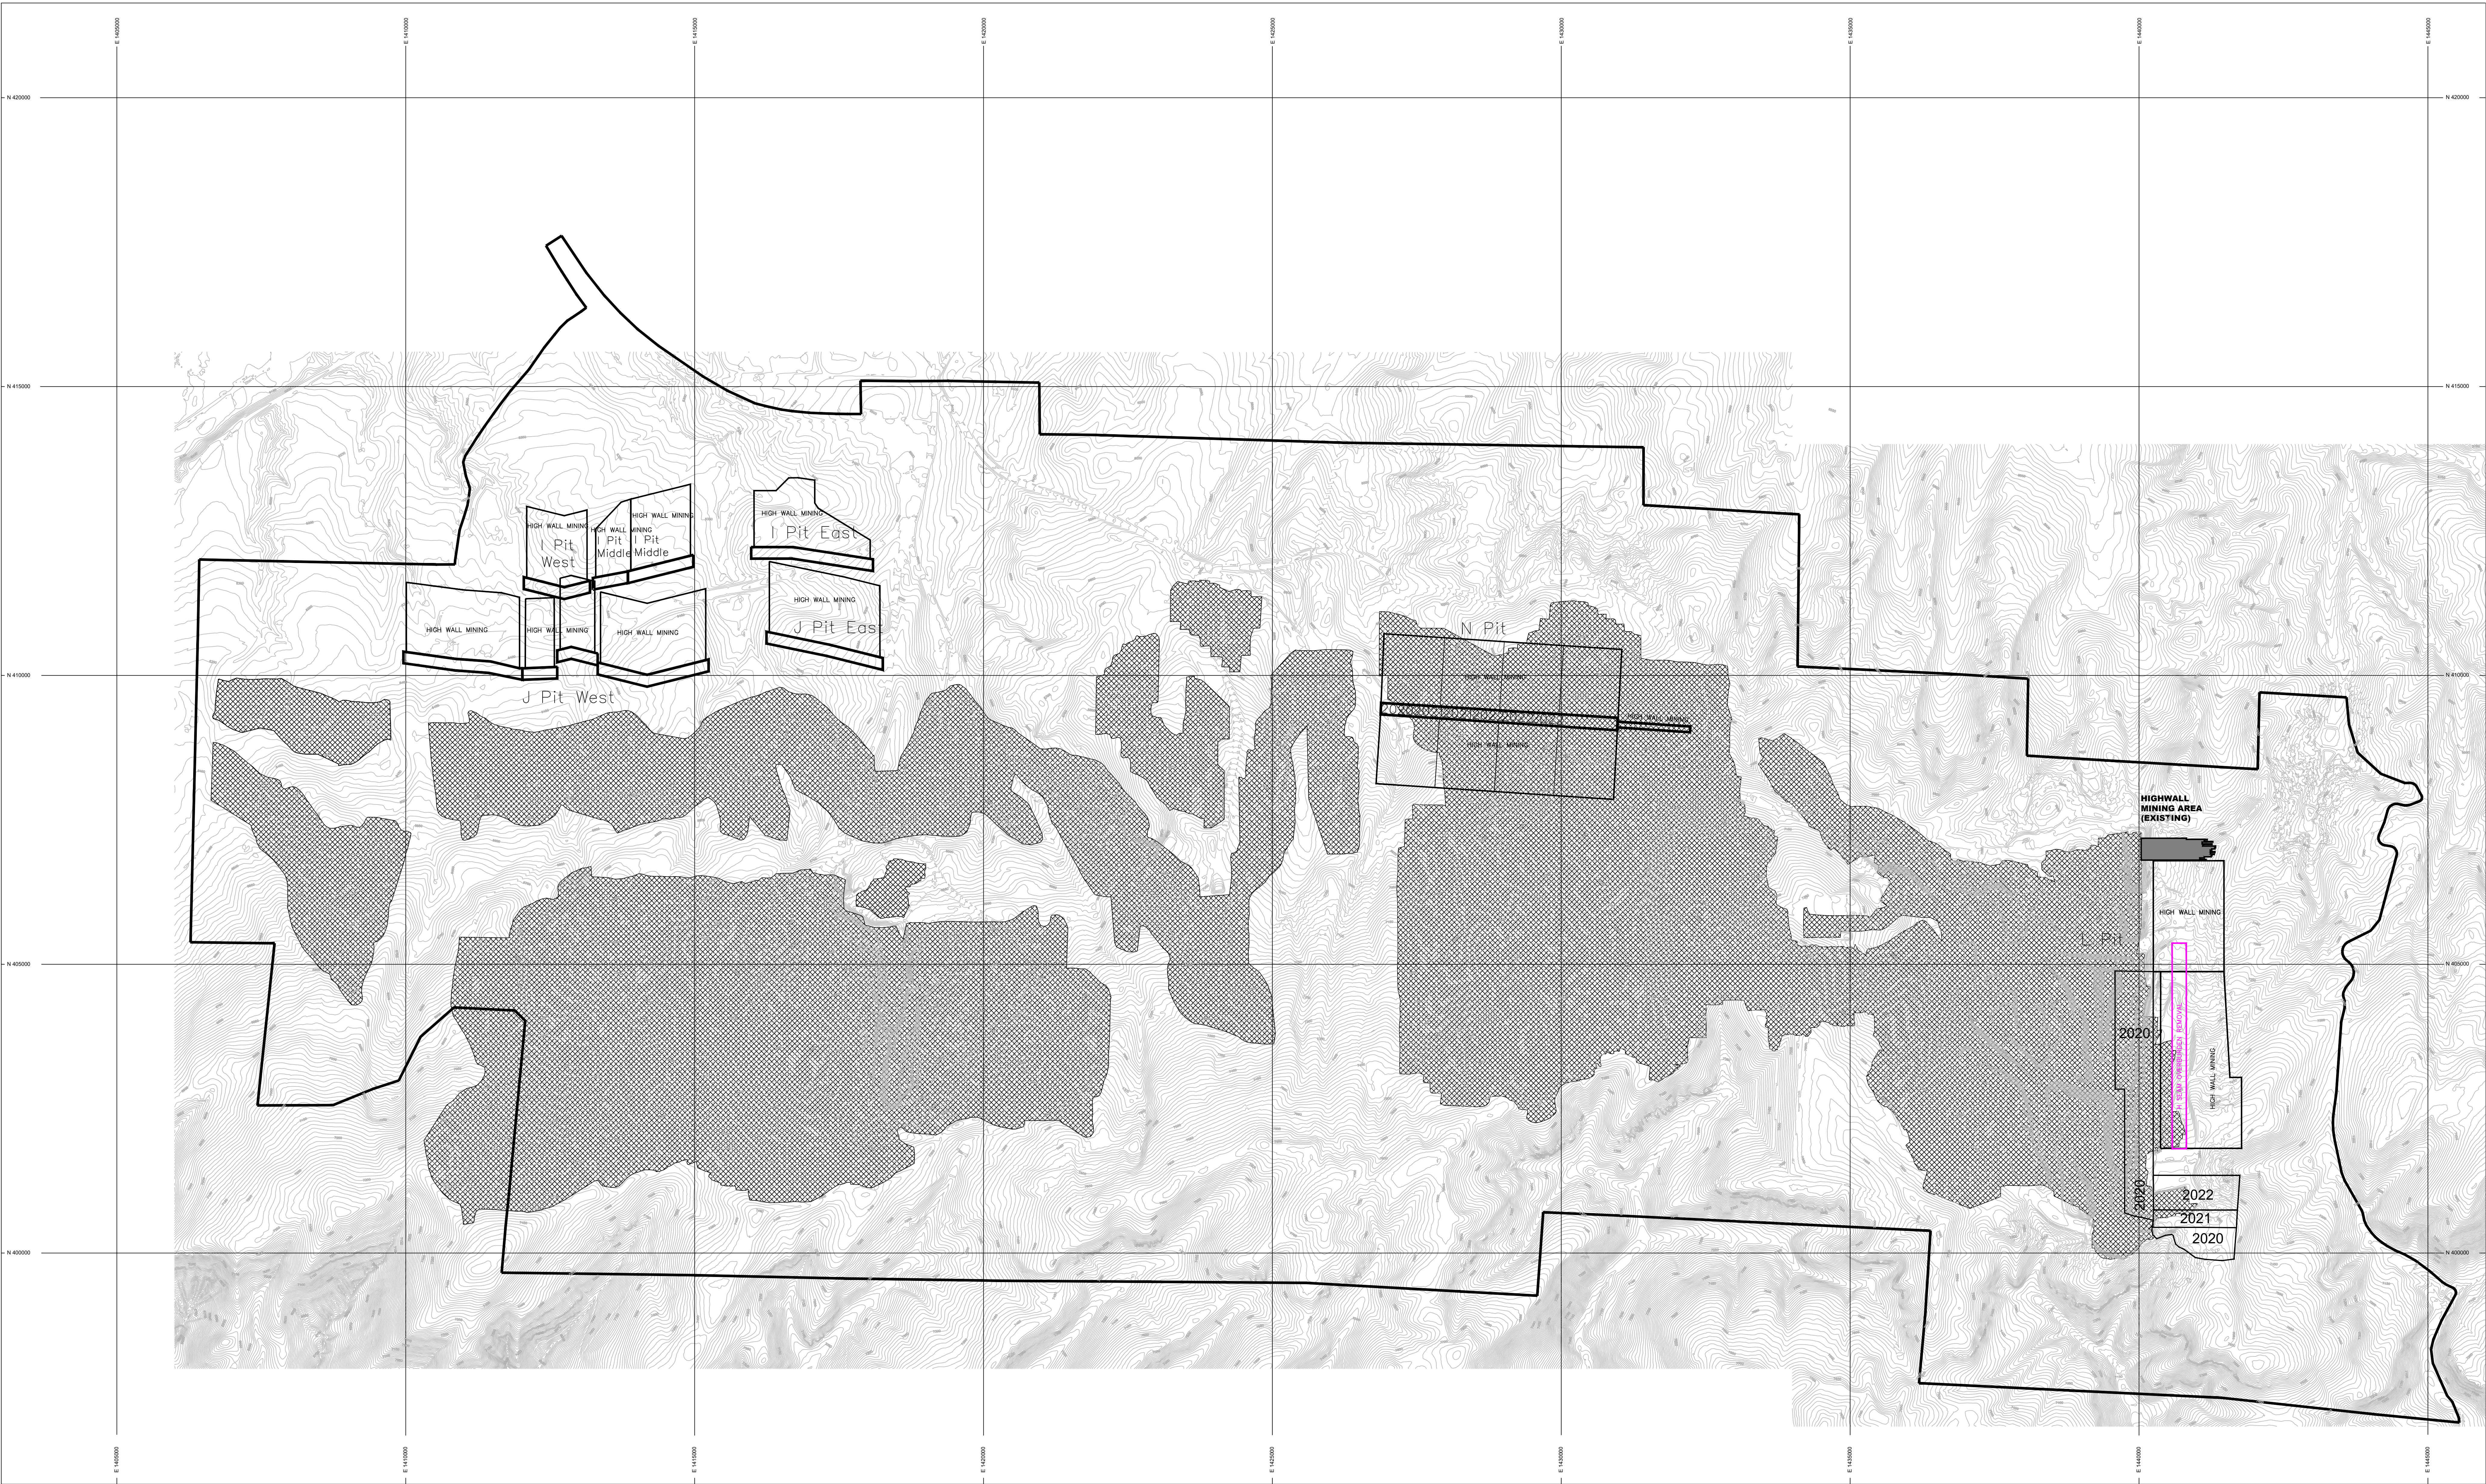

- LEGEND
- PERMIT BOUNDARY
 - MINING LIMIT (years as shown)
 - MINING PRIOR TO 2020
 - H Seam Overburden Removal for Reclamation



SCALE: 1 IN = 1000 FT
CONTOUR INTERVAL: 10 FEET
TOPOGRAPHIC INFORMATION IS COMPILED FROM
AERIAL SURVEYS BY (AEROGRAPHICS - OCTOBER
16, 2017) AND
TRAPPER DRONE SURVEYS THROUGH NOVEMBER,
2019

L:\Engineer\Permits\TR-130\Maps\M4_TR130.dwg

Revision	Date	By	Description
PR-9	04/27/20	WTC	Permit Revision
PR-10	05/14/20	WTC	Permit Revision
TR-128	08/23/21	ARB/CJB	PT LIMIT UPDATE, COPIES AS-BUILT AND TEXT UPDATES
TR-130	03/30/22	CJB	PT LIMIT UPDATE -HPT

TRAPPER MINING INC.
TRAPPER MINE
CRAIG, CO

LIFE OF MINE PLAN

SCALE: 1" = 1000'
DESIGNED BY: RDH
DRAWN BY: WTC
DATE: 04/27/2020

Sheet 1 of 1

M4

