AS CONSTRUCTED SLURRY WALL ALIGNMENT POINT LIST

POINT #	NORTHING	EASTING	ELEVATION
100	3494.07	4732.24	4789.6
101	3479.69	4709.41	4790.0
102	3457.93	4680.64	4789.1
103	3424.24	4509.34	4789.6
104	3423.10	4271.66	4790.6
105	3424.71	4021.50	4790.5
106	3423.06	3865.73	4790.9
107	3423.59	3813.10	4790.9
108	3487.91	3789.81	4790.8
109	3511.91	3784.76	4791.8
110	3546.62	3781.12	4791.1
111	3634.30	3776.01	4791.0
112	3754.96	3774.56	4790.9
113	4084.36	3772.80	4790.7
114	4169.59	3770.22	4791.4
115	4355.13	3770.27	4790.2
116	4412.01	3769.74	4790.3
117	4568.43	3768.87	4789.4
118	4625.95	3769.69	4789.5
119	4850.35	3769.31	4790.3
120	4926.78	3766.79	4789.8
121	4955.29	3832.48	4790.0
122	4962.68	3858.34	4789.9
123	4964.31	3930.60	4789.3
124	4964.29	3992.17	4789.3
125	4965.44	4052.00	4789.9
126	4963.49	4086.63	4788.7
127	4965.98	4114.59	4788.4
128	4966.11	4174.04	4788.2
129	4966.28	4263.05	4789.3
130	4968.58	4358.33	4789.2
131	4969.23	4411.88	4787.6
132	4966.54	4443.16	4788.5
133	4968.08	4475.27	4788.6
134	4967.60	4568.83	4787.9
135	4968.75	4599.22	4788.6
136	4967.67	4653.10	4788.6
137	4969.72	4718.42	4786.0
138	4969.29	4744.41	4787.3
139	4970.73	4771.95	4786.3
140	4972.08	4832.64	4787.1
141	4969.82	4891.32	4786.8
142	4969.10	4978.38	4786.7
143	4964.98	5071.90	4786.8
144	4966.68	5100.76	4787.4
145	4965.66	5133.63	4787.3
146	4964.20	5190.88	4785.8
147	4966.19	5249.00	4786.8
148	4963.94	5286.25	4785.9
149	4963.73	5345.82	4786.5
150	4838.77	5349.92	4785.8
151	4646.24	5351.63	4785.5
152	4434.36	5351.07	4785.3
153	4439.28	5419.25	4785.4
154	4438.97	5576.93	4785.0
155	4440.75	5619.72	4786.3
156	4279.01	5620.86	4784.8
157	4059.70	5621.72	4784.7
158	3831.86	5623.00	4785.4
159	3718.53	5623.66	4785.3
160	3639.19	5621.77	4785.8
161	3599.35	5605.89	4786.2
162	3595.57	5552.23	4786.2
163	3593.91	5464.44	4786.7
164	3592.62	5403.35	4787.1
165	3590.05	5348.24	4787.5
166	3591.29	5283.98	4786.3
167	3586.03	5188.46	4788.1
168	3588.02	5162.23	4787.9
169	3586.54	5103.54	4788.4
170	3586.85	5072.91	4788.3
171	3585.35	5013.35	4789.1
172	3587.24	4954.13	4789.1
173	3579.17	4891.14	4788.6
174	3573.41	4865.20	4789.0
175	3560.78	4829.02	4788.4
176	3520.82	4769.60	4789.0

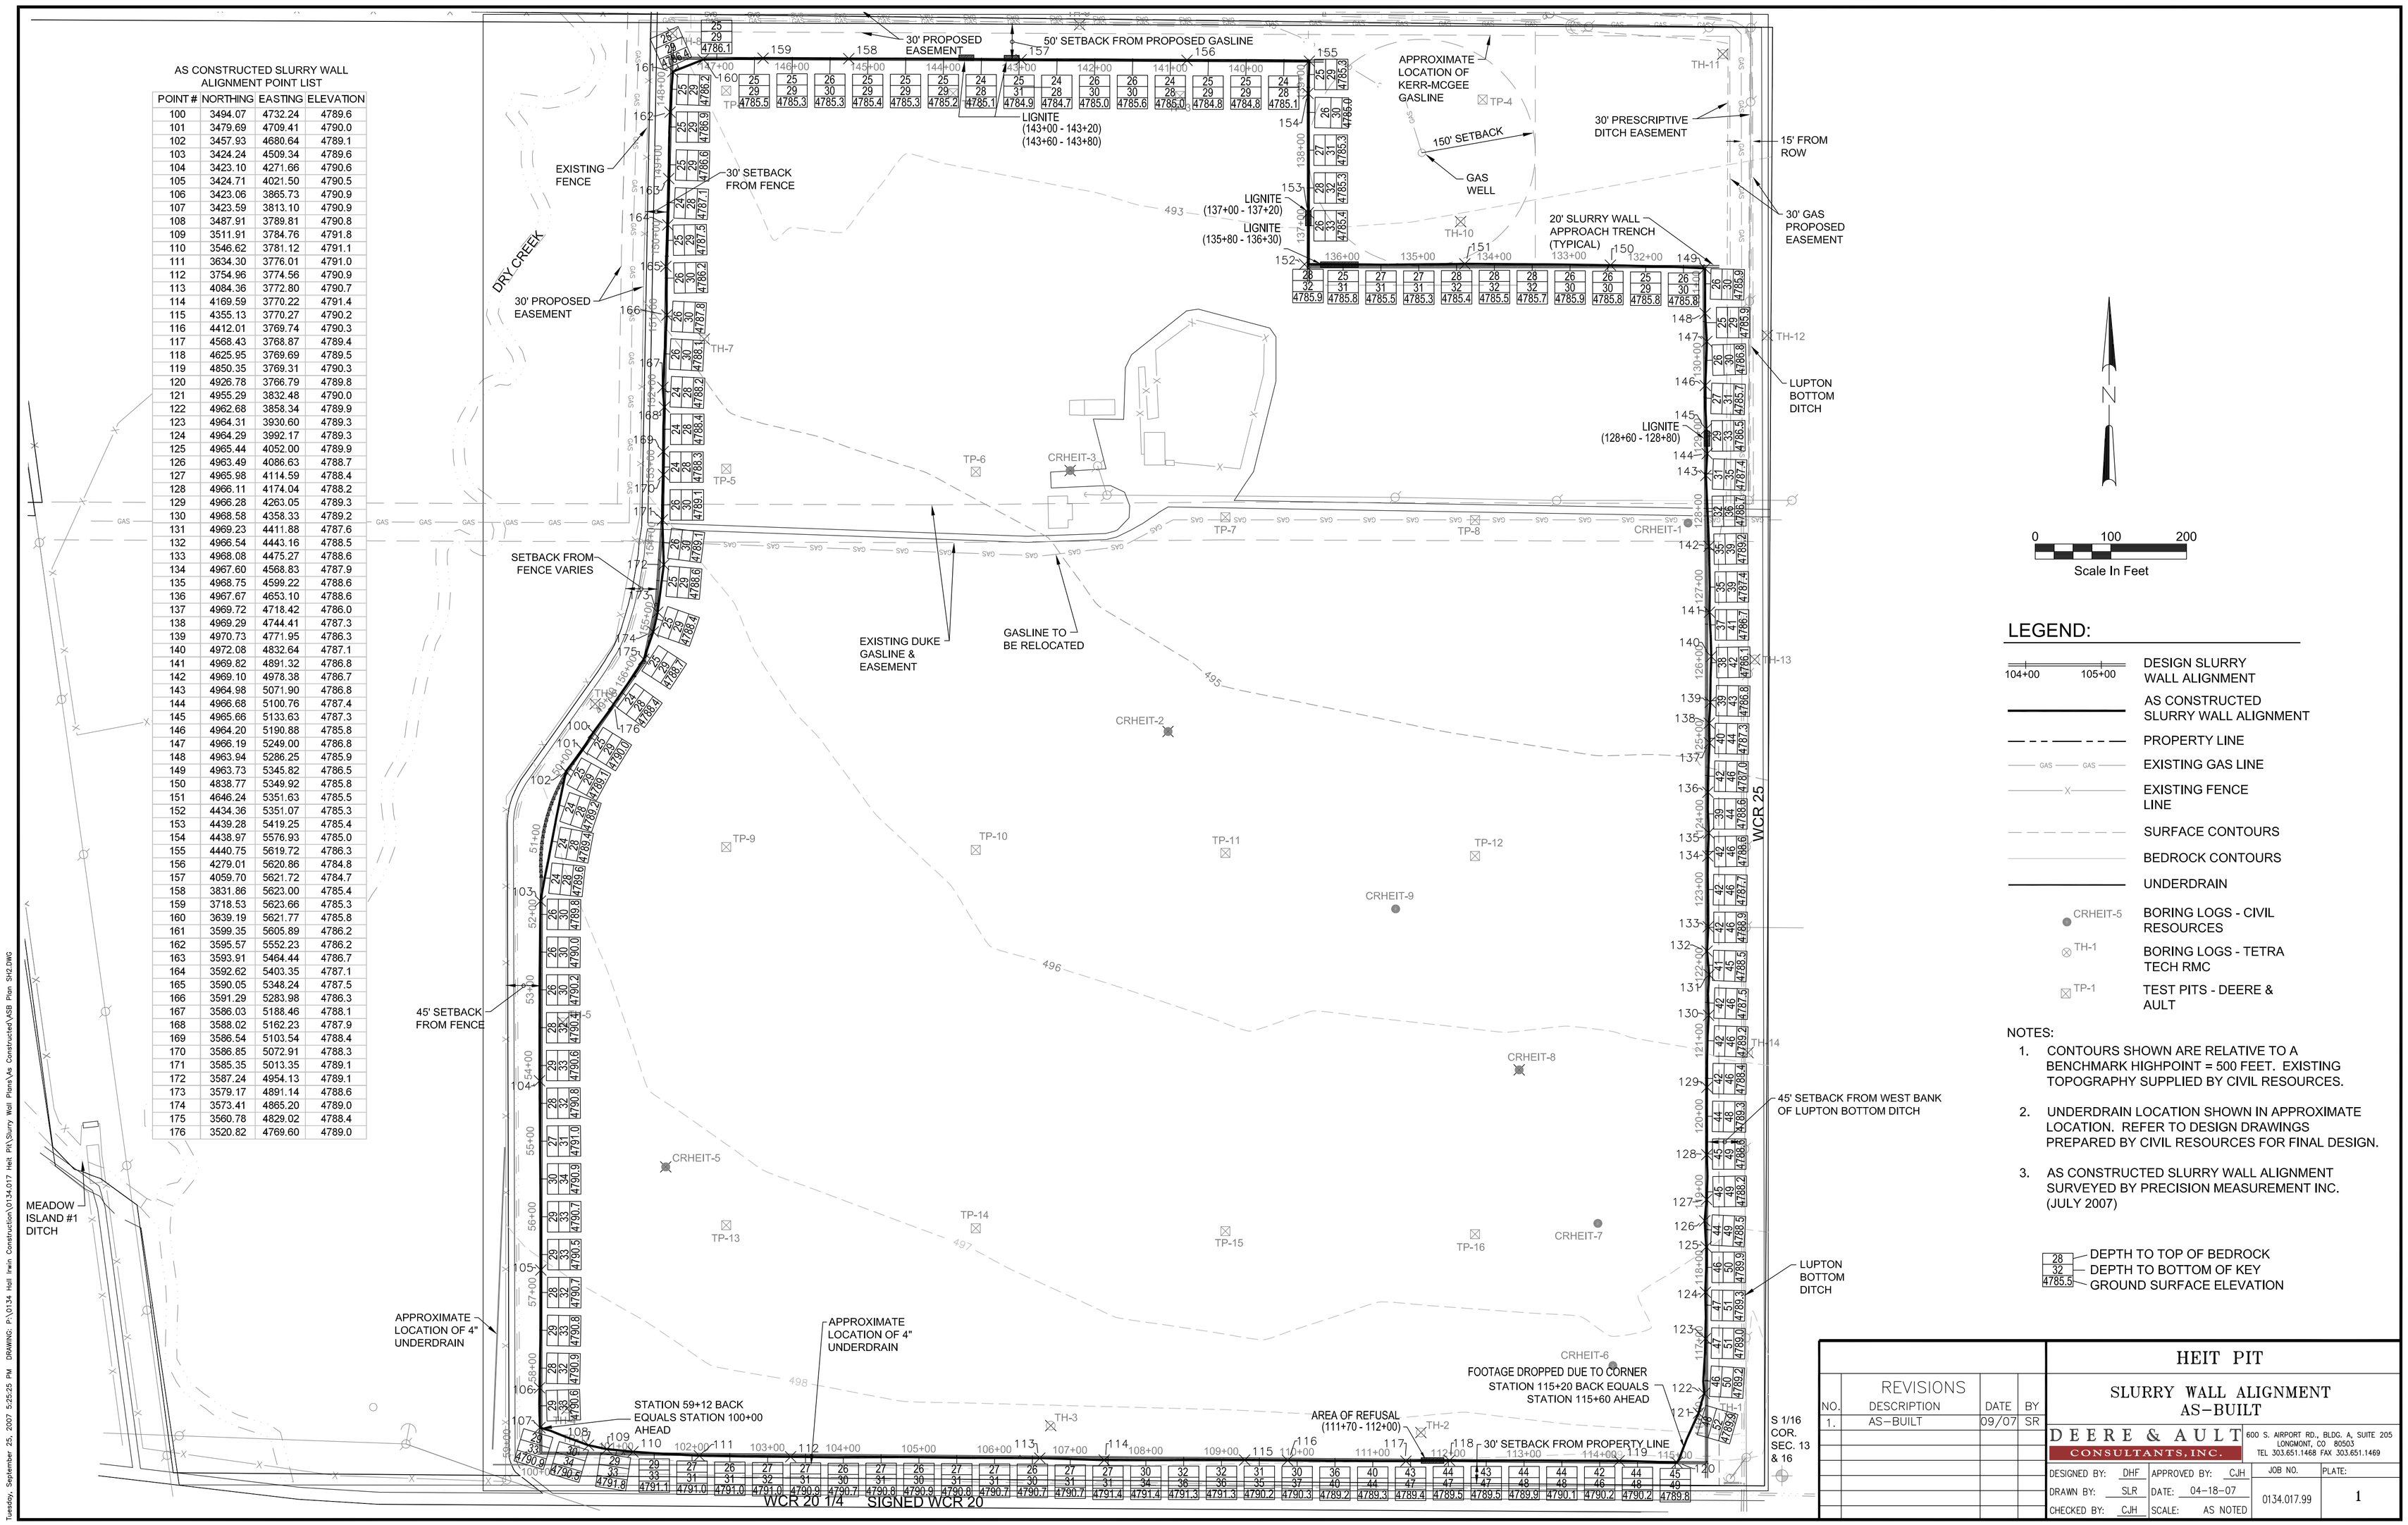

LEGEND:

- DESIGN SLURRY WALL ALIGNMENT (104+00 105+00)
- AS CONSTRUCTED SLURRY WALL ALIGNMENT
- PROPERTY LINE
- EXISTING GAS LINE
- EXISTING FENCE LINE
- SURFACE CONTOURS
- BEDROCK CONTOURS
- UNDERDRAIN
- CRHEIT-5 — BORING LOGS - CIVIL RESOURCES
- TH-1 — BORING LOGS - TETRA TECH RMC
- TP-1 — TEST PITS - DEERE & AULT

NOTES:

1. CONTOURS SHOWN ARE RELATIVE TO A BENCHMARK HIGHPOINT = 500 FEET. EXISTING TOPOGRAPHY SUPPLIED BY CIVIL RESOURCES.
2. UNDERDRAIN LOCATION SHOWN IN APPROXIMATE LOCATION. REFER TO DESIGN DRAWINGS PREPARED BY CIVIL RESOURCES FOR FINAL DESIGN.
3. AS CONSTRUCTED SLURRY WALL ALIGNMENT SURVEYED BY PRECISION MEASUREMENT INC. (JULY 2007)

28 — DEPTH TO TOP OF BEDROCK
32 — DEPTH TO BOTTOM OF KEY
4785.5 — GROUND SURFACE ELEVATION

REVISIONS

NO.	DESCRIPTION	DATE	BY
1.	AS-BUILT	09/07	SR

HEIT PIT

SLURRY WALL ALIGNMENT AS-BUILT

DEERE & AULT CONSULTANTS, INC.
600 S. AIRPORT RD., BLDG. A, SUITE 205
LONGMONT, CO 80503
TEL 303.651.1468 FAX 303.651.1469

DESIGNED BY: DHF	APPROVED BY: CJH	JOB NO.	PLATE:
DRAWN BY: SLR	DATE: 04-18-07	0134.017.99	1
CHECKED BY: CJH	SCALE: AS NOTED		

Tuesday, September 25, 2007 2:22:25 PM DRAWING: P:\0134 Heit Inv. Construction\0134.017 Heit Pit\Slurry Wall Plans\As Constructed\ASB Plan SHEET.DWG