


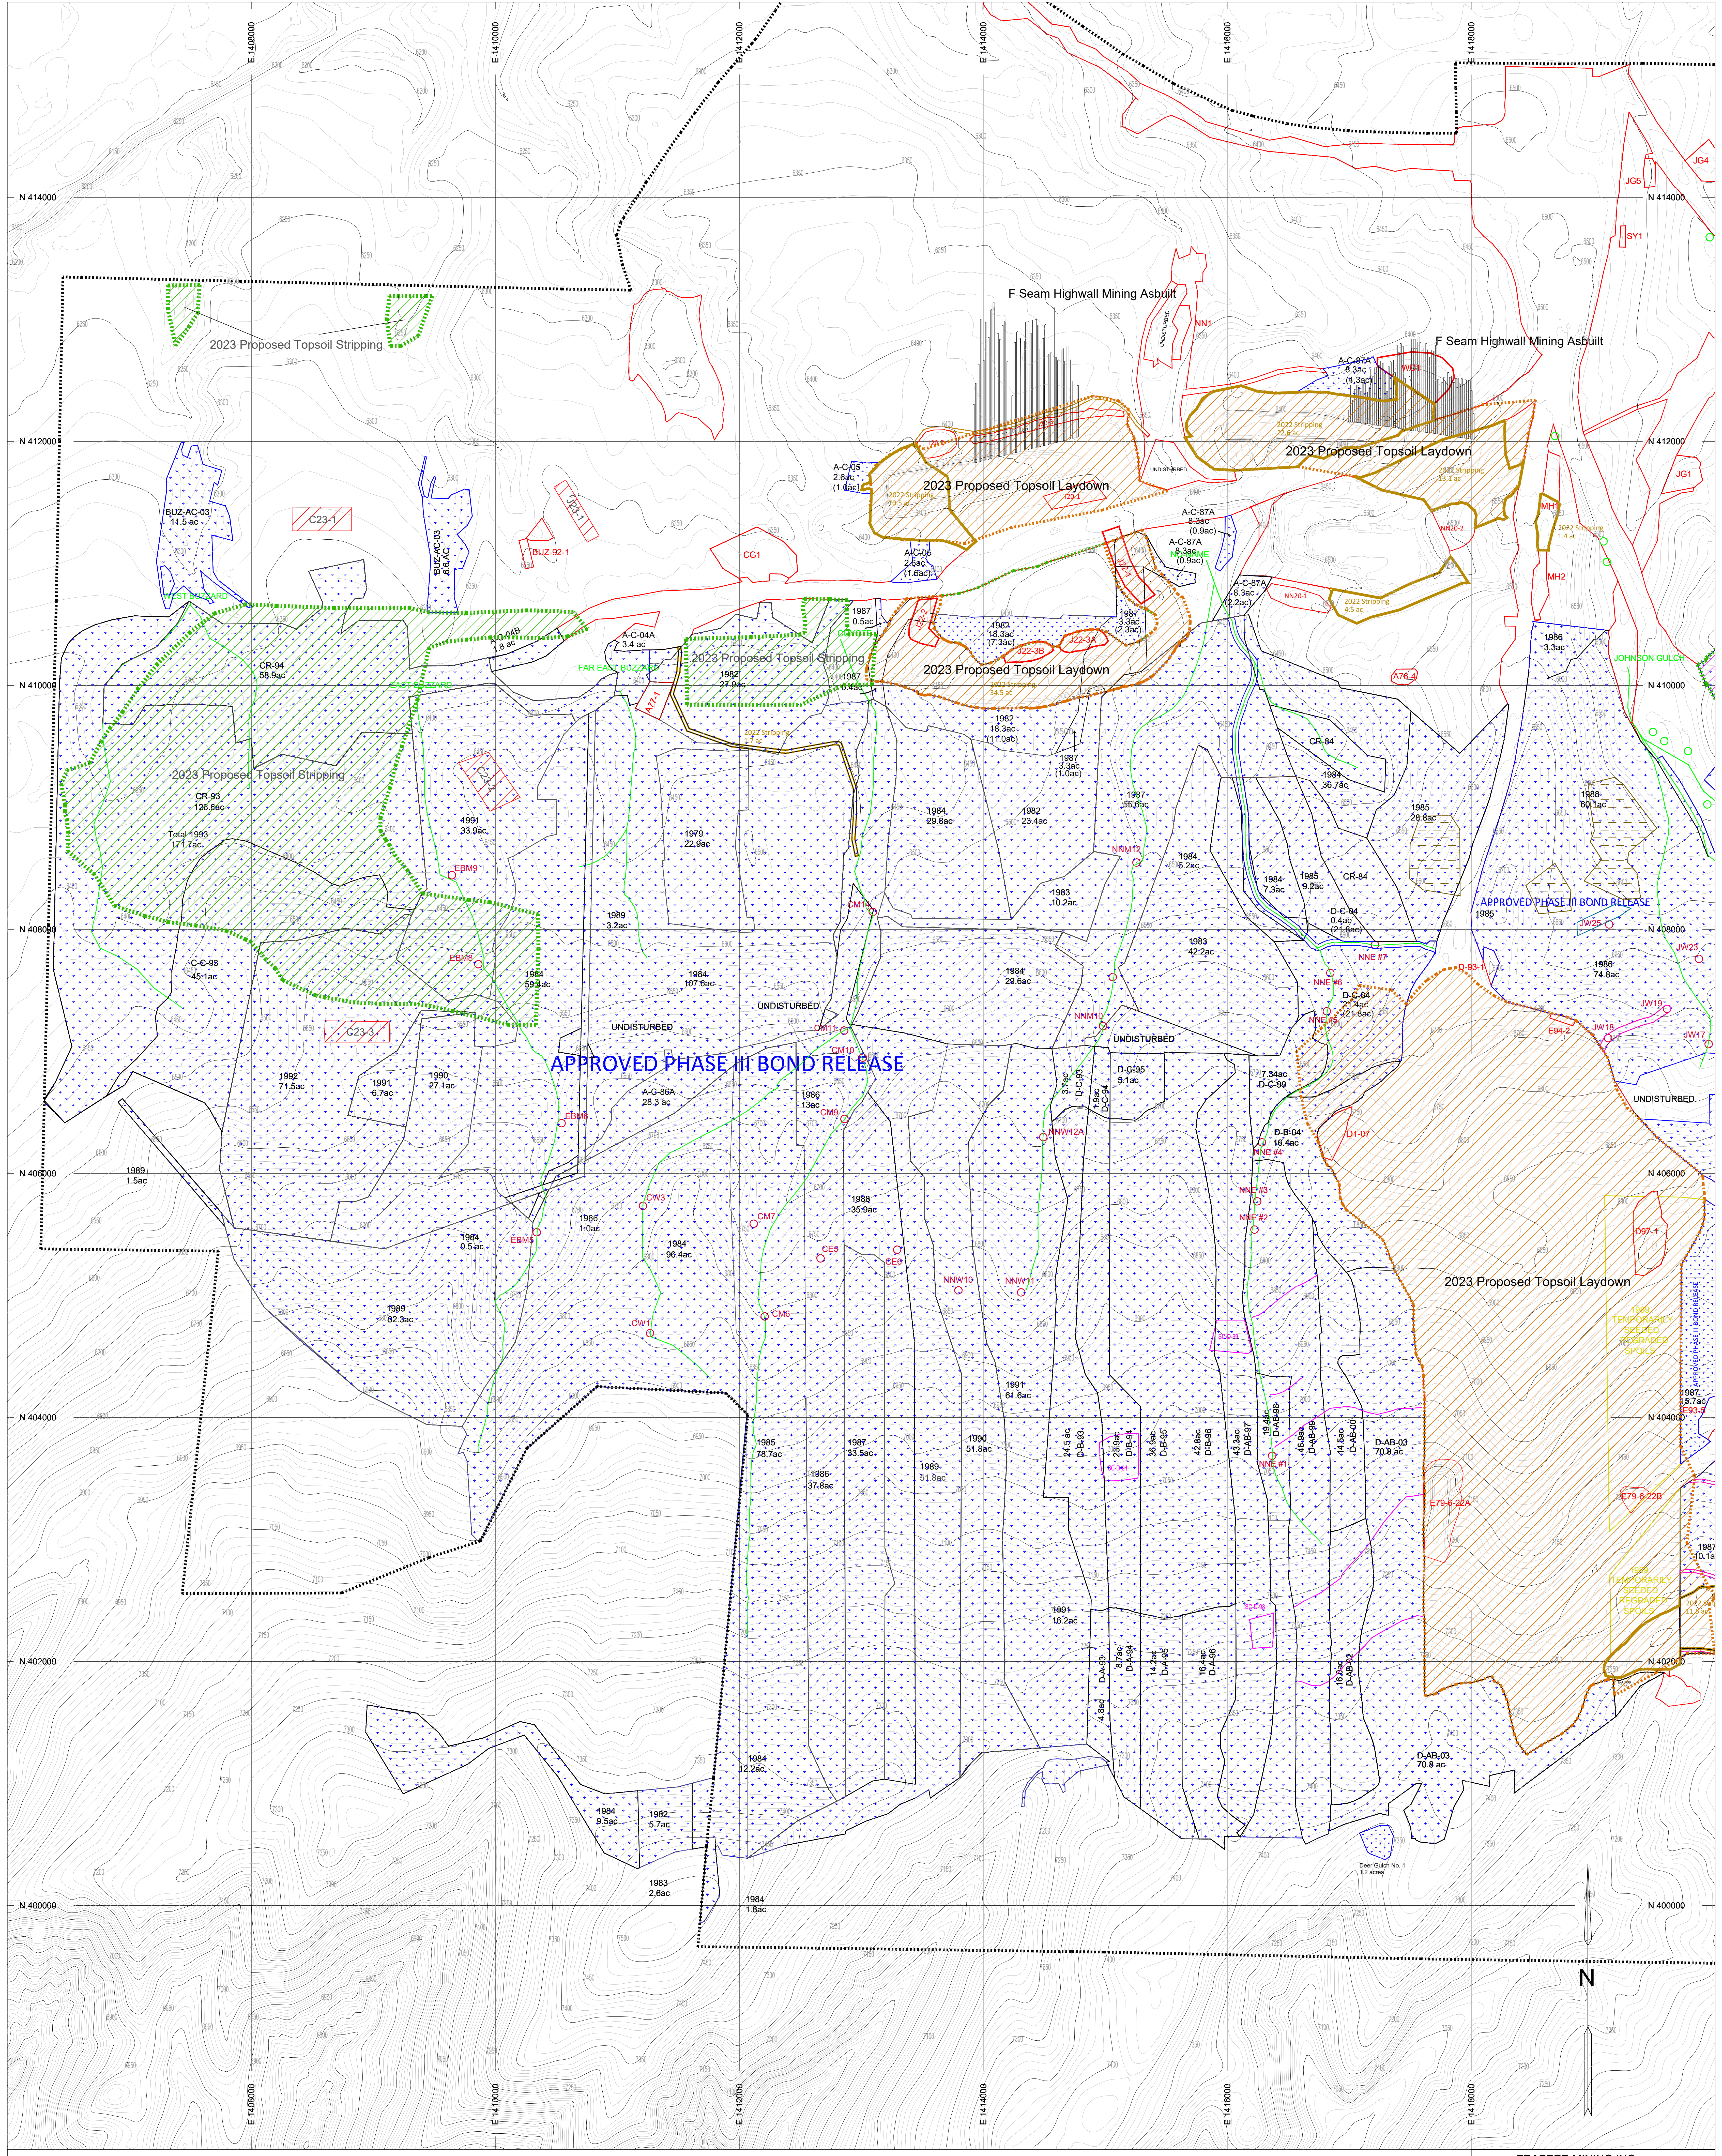

LEGEND

	PERMIT BOUNDARY		2023 PROPOSED TOPSOIL LAYDOWN
	HISTORICAL REVEGETATED AREA		2023 PROPOSED TOPSOIL STRIP
	SHRUB CLUMP/PI/I/D/Year Constructed		2023 PROPOSED TOPSOIL STRIPPING AND LAYDOWN
	2022 FINAL REGRADE AREA		ACCESS CORRIDORS
	2022 RETOPSOILED AND REVEGETATED AREA		EXISTING STOCK POND
	EXISTING TOPSOIL STOCKPILE		EXISTING DOZER BASINS
	PROPOSED TOPSOIL STOCKPILE		RECONSTRUCTED DRAINAGES
	ASH DUMP STORAGE AREA		2022 RECONSTRUCTED DRAINAGES
	2022 TOPSOIL STRIP		CONTOUR DITCH
	AS-BUILT HIGHWALL MINING AREA		APPROVED PHASE III BOND RELEASED BOUNDARY

SHEET LOCATION INDEX

SCALE

1" = 400'

DESIGNED BY: JMM

DATE: 5/1/23

TRAPPER MINING INC.

TRAPPER MINE CRAIG, CO.

PERMIT C81-010

2022 ANNUAL RECLAMATION REPORT MAP

SCALE: 1" = 400'

DESIGNED BY: JMM

DATE: 5/1/23

MAP 1

SHEET 1