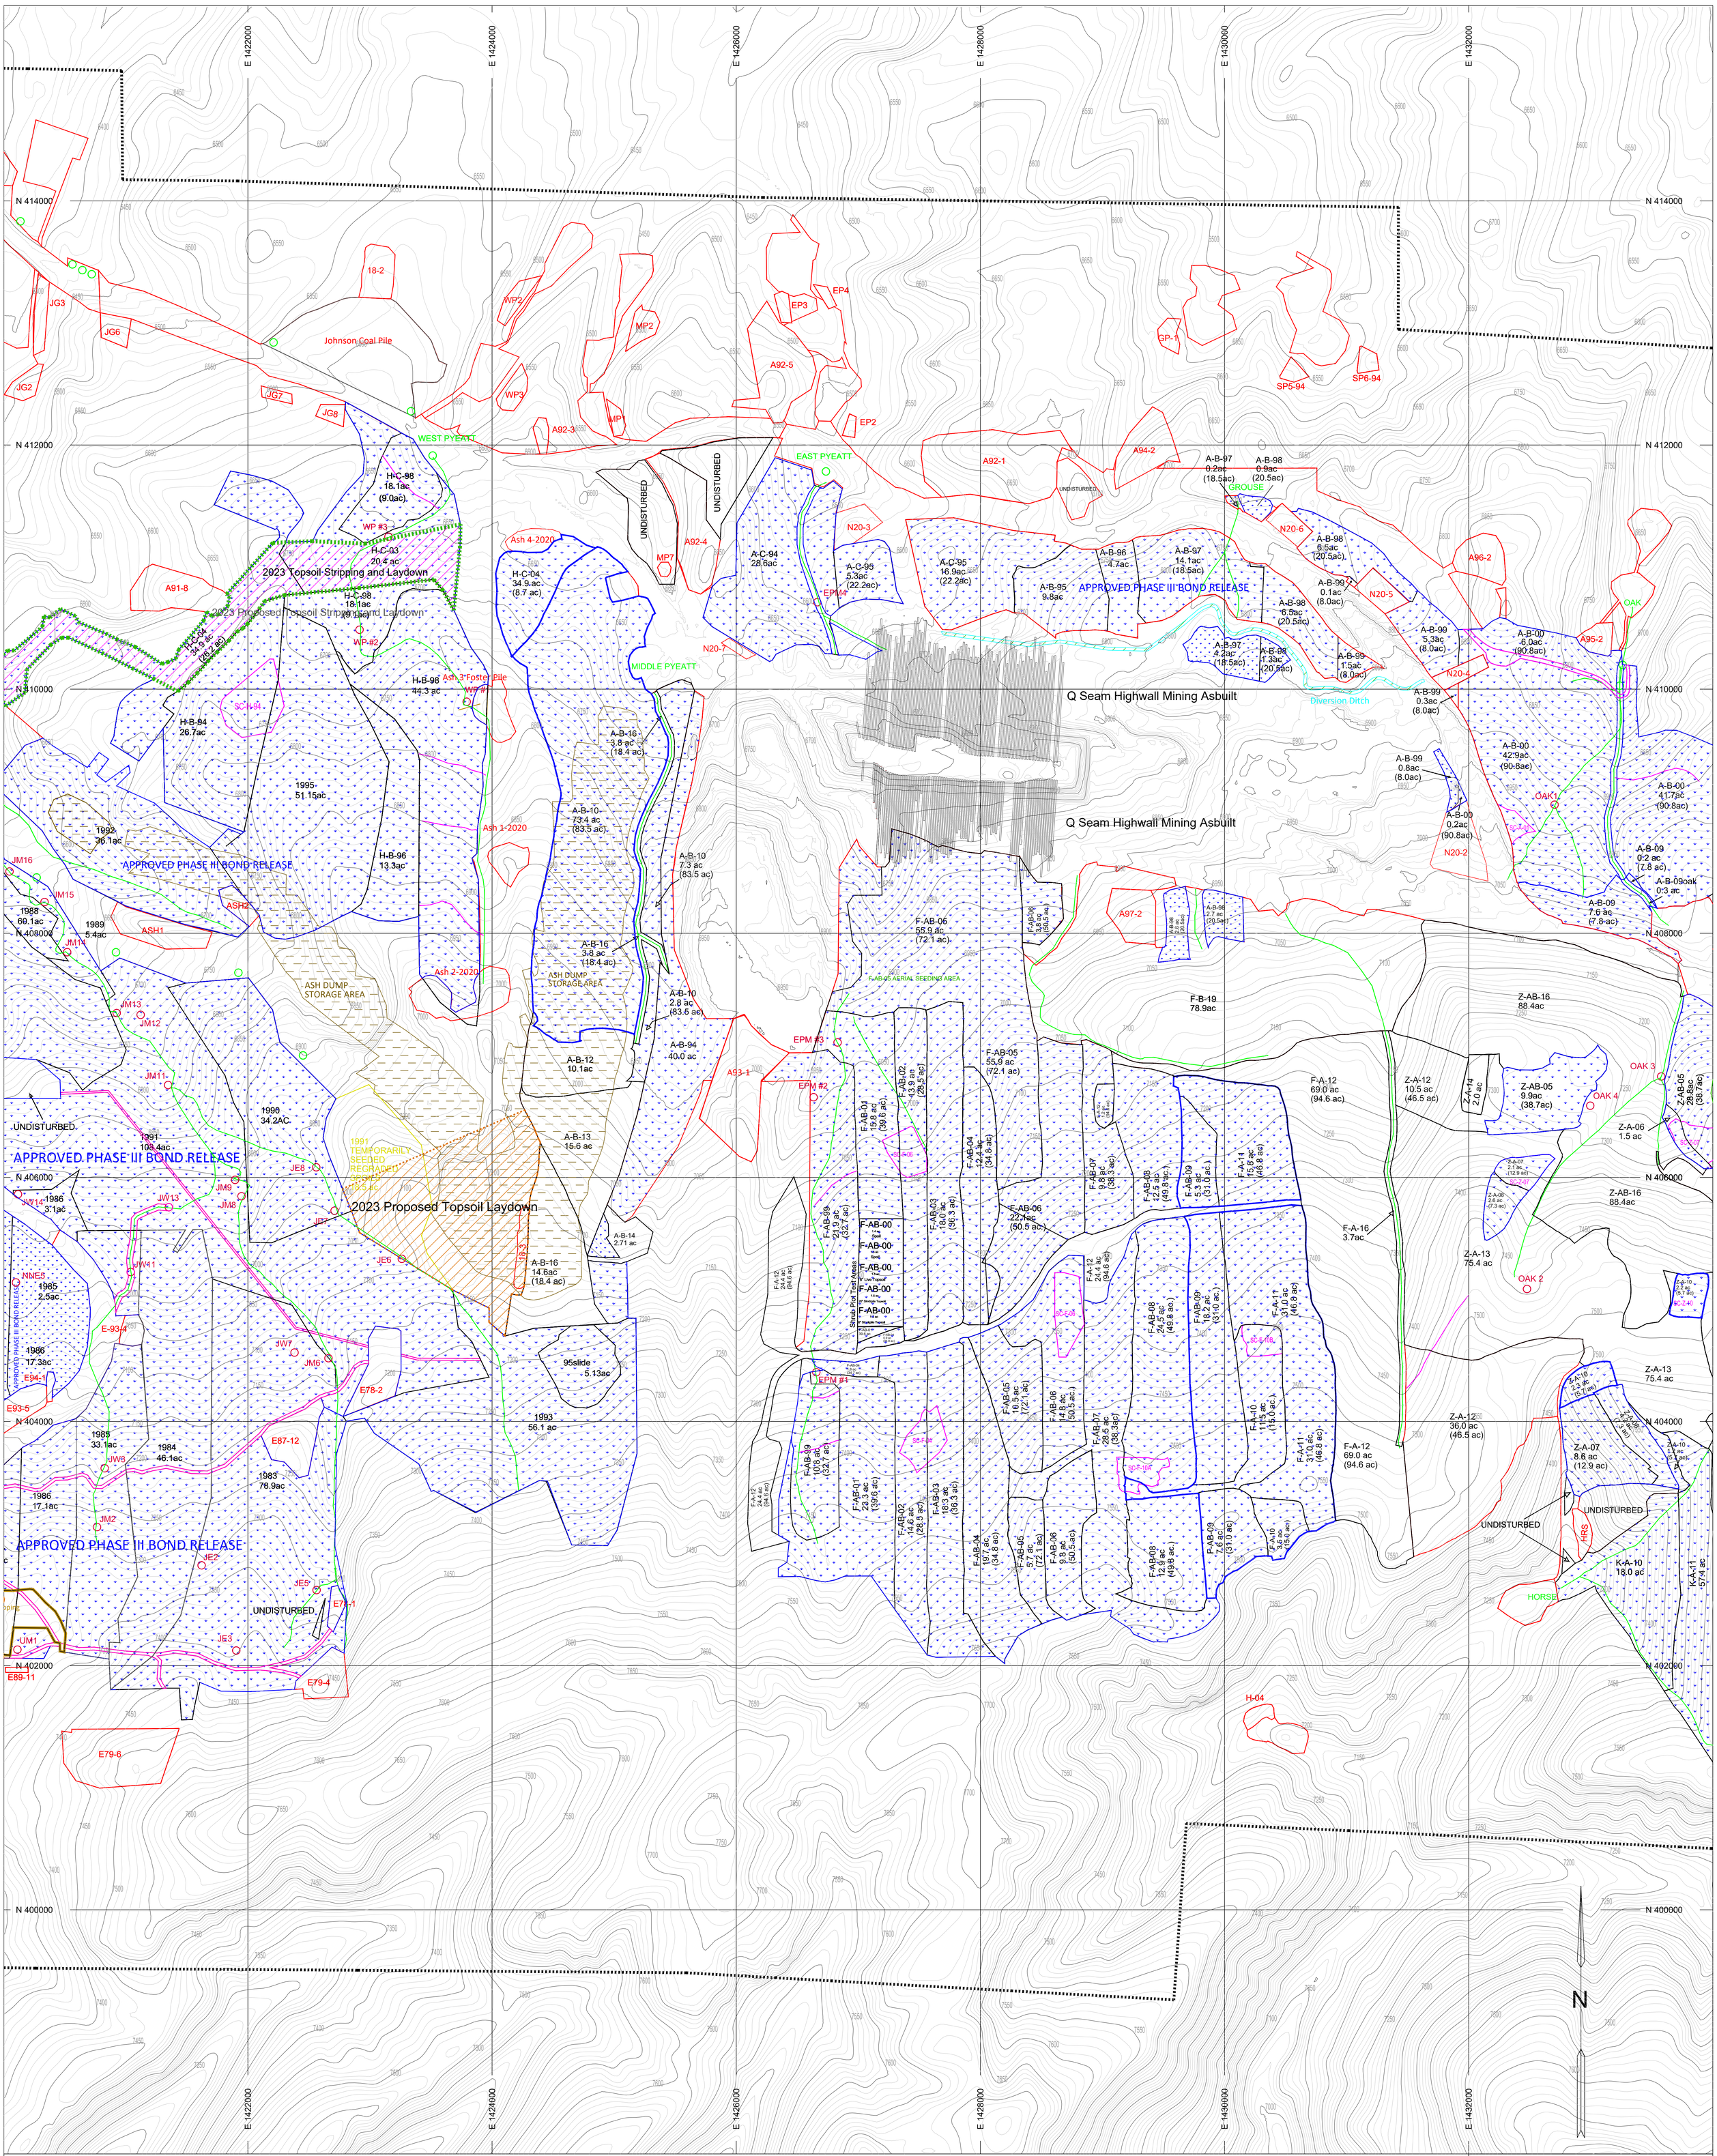

LEGEND

- PERMIT BOUNDARY
- HISTORICAL REVEGETATED AREA
- SC-D-92 — SHRUB CLUMP/Pit ID/Year Constructed
- 2022 FINAL REGRADE AREA
- 2022 RETOPSOILED AND REVEGETATED AREA
- EXISTING TOPSOIL STOCKPILE
- PROPOSED TOPSOIL STOCKPILE
- ASH DUMP STORAGE AREA
- 2022 TOPSOIL STRIP
- AS-BUILT HIGHWALL MINING AREA
- 2023 PROPOSED TOPSOIL LAYDOWN
- 2023 PROPOSED TOPSOIL STRIP
- 2023 PROPOSED TOPSOIL STRIPPING AND LAYDOWN
- ACCESS CORRIDORS
- EXISTING STOCK POND
- EXISTING DOZER BASINS
- RECONSTRUCTED DRAINAGES
- 2022 RECONSTRUCTED DRAINAGES
- CONTOUR DITCH
- APPROVED PHASE III BOND RELEASED BOUNDARY

TRAPPER MINING INC.

TRAPPER MINE — CRAIG, CO.

PERMIT C81-010

2022 ANNUAL RECLAMATION REPORT MAP

SCALE: 1 in = 400 ft
DESIGNED BY:
DRAWN BY: JMM
DATE: 3/7/23

Sheet 2 of 3

MAP 1

SHEET 2