


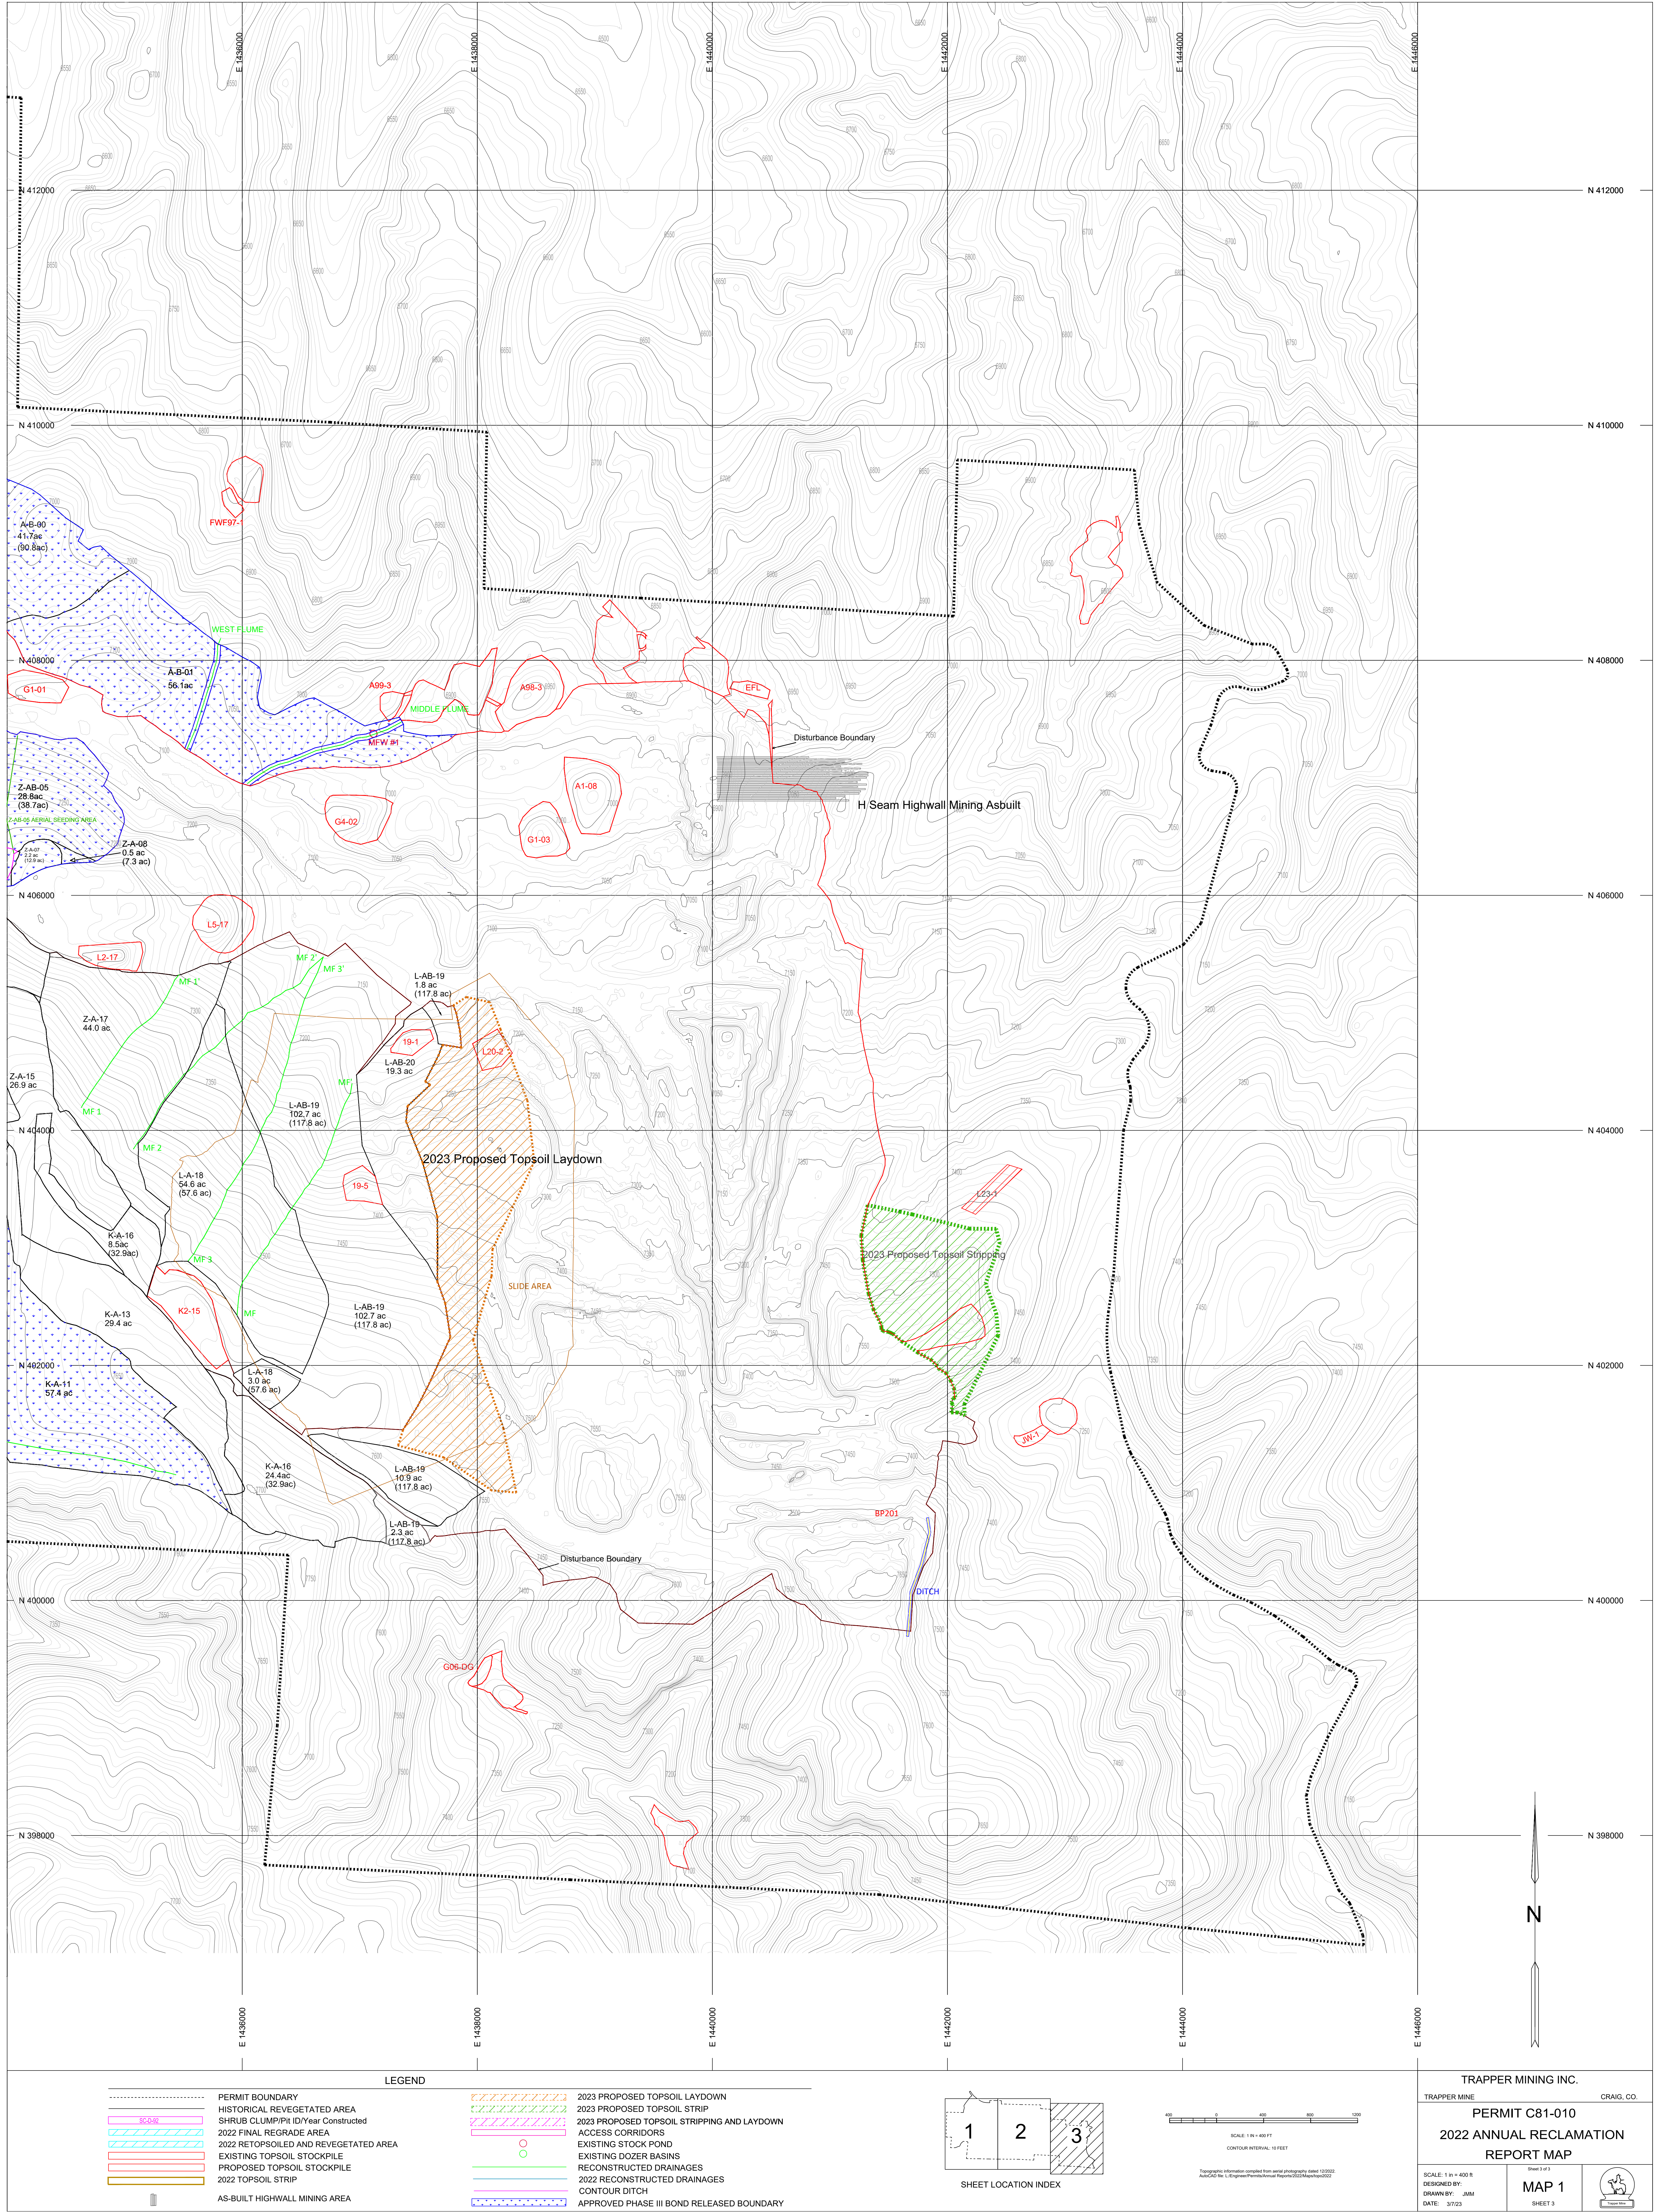

LEGEND		SHEET LOCATION INDEX		TRAPPER MINING INC.	
-----	PERMIT BOUNDARY	[Pattern]	2023 PROPOSED TOPSOIL LAYDOWN	TRAPPER MINE CRAIG, CO.	
[Pattern]	HISTORICAL REVEGETATED AREA	[Pattern]	2023 PROPOSED TOPSOIL STRIP	PERMIT C81-010	
[Pattern]	SHRUB CLUMP/PII ID/Year Constructed	[Pattern]	2023 PROPOSED TOPSOIL STRIPPING AND LAYDOWN	2022 ANNUAL RECLAMATION	
[Pattern]	2022 FINAL REGRADE AREA	[Pattern]	ACCESS CORRIDORS	REPORT MAP	
[Pattern]	2022 RETOPSOILED AND REVEGETATED AREA	[Pattern]	EXISTING STOCK POND	SCALE: 1" = 400'	
[Pattern]	EXISTING DOZER BASINS	[Pattern]	EXISTING STOCK POND	DESIGNED BY: JMM	
[Pattern]	RECONSTRUCTED DRAINAGES	[Pattern]	2022 RECONSTRUCTED DRAINAGES	DRAWN BY: JMM	
[Pattern]	2022 TOPSOIL STOCKPILE	[Pattern]	CONTOUR DITCH	DATE: 3/7/23	
[Pattern]	2022 TOPSOIL STRIP	[Pattern]	APPROVED PHASE III BOND RELEASED BOUNDARY	MAP 1 SHEET 3	
[Pattern]	AS-BUILT HIGHWALL MINING AREA				